

CUY-6-1456

PHYSICAL CONDITION REPORT ROUTINE FRACTURE CRITICAL INSPECTION VETERANS MEMORIAL/DETROIT-SUPERIOR BRIDGE OVER THE CUYAHOGA RIVER SFN: 1800930



Inspection Date:
October 22-26, 2018
Routine and Fracture Critical Inspection

Submitted to:

Ohio Department of Transportation
District 12
5500 Transportation Boulevard
Garfield Heights, OH 44125
United States of America



Inspection Team:

Dustin W. Noel, P.E.
Randall S. Fabyanic, P.E.
Andrew D. Zwolinski, P.E.
Frank J Novak, E.I.
Michael S. O'Hara, E.I.



2/8/2019

Dustin W. Noel, P.E.

PHYSICAL CONDITION REPORT

Bridge Number: CUY-6-1456
SFN: 1800930
Inspection Date: October 22-26, 2018

TABLE OF CONTENTS


Location Map	2
General Description	3
Top of Deck and Elevation Photos	5
Construction and Maintenance History	7
Inspection Procedure	8
Condition and Element Rating Guidelines	9
Plan and Elevation Drawings	10
Inspection Findings	13
Recommendations	43
Deck Photos	44
Superstructure Photos	54
Substructure Photos	64
West and East Abutment Chamber Photos	70
Open Spandrel Arch and Truss Spans CADD Drawings and Deficiencies	74
West and East Abutment Chamber CADD Drawings and Deficiencies	186



PHYSICAL CONDITION REPORT

Bridge Number: CUY-6-1456
SFN: 1800930
Inspection Date: October 22-26, 2018

LOCATION MAP

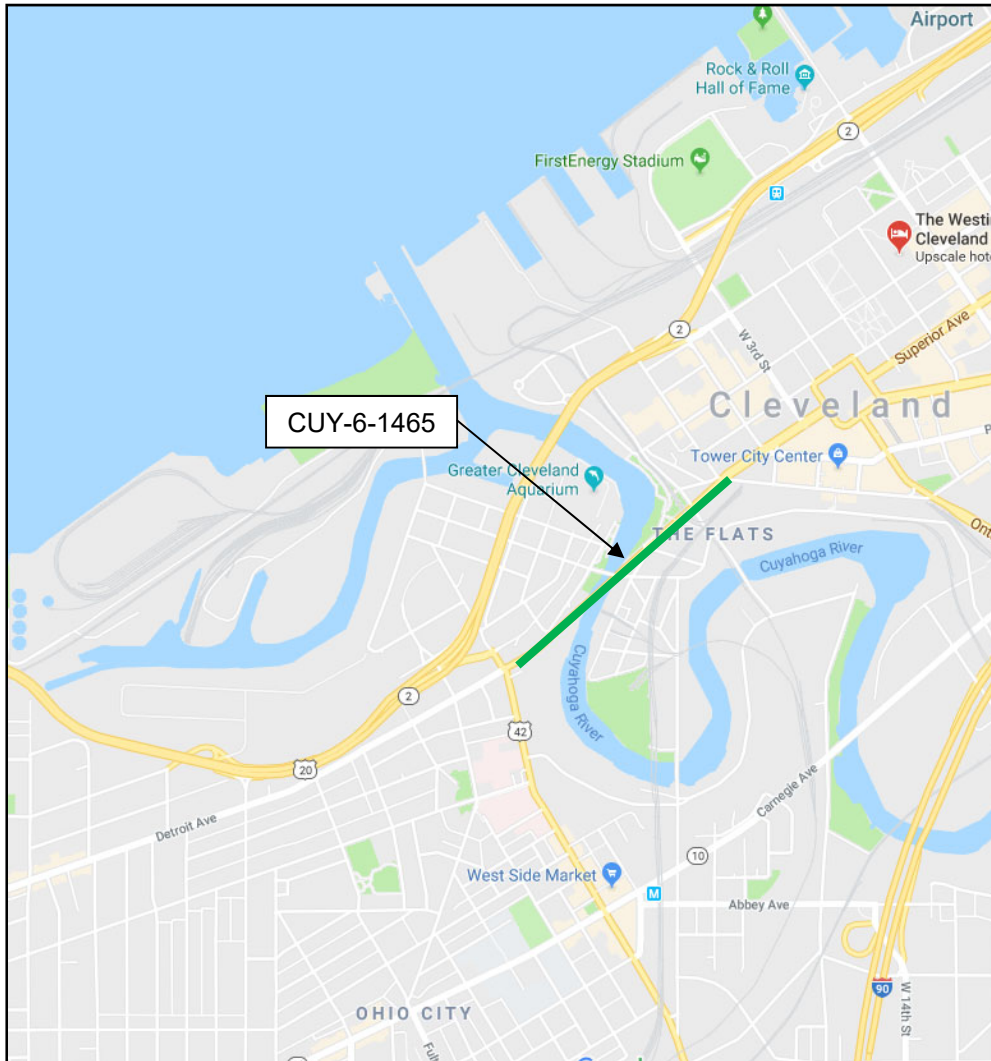

Structure: CUY-6-1456
Veterans Memorial/Detroit-Superior over Cuyahoga River
Cleveland, Ohio



PHYSICAL CONDITION REPORT

Bridge Number: CUY-6-1456
SFN: 1800930
Inspection Date: October 22-26, 2018

GENERAL DESCRIPTION

The Veterans Memorial/Detroit-Superior Bridge (CUY-6-1456, SFN 1800930) carries three lanes of traffic and one lane of bike traffic over the Cuyahoga River Valley, local streets, and RTA railroad tracks. The bridge is approximately 2,880 feet long, including 1,673 feet of subway tunnel that is linked by the lower deck. The bridge was constructed from 1914 to 1917.

The upper deck was opened to vehicular traffic in November 1917 and currently carries three lanes of traffic over the Cuyahoga River Valley. The lower deck was designed for four streetcar lines with room for an additional two lines that were active from January 1918 to 1953. On January 18, 1974 the bridge was added to the National Register of Historic Places. On Veterans Day November 11, 1989 the bridge was renamed the Veterans Memorial Bridge.

The bridge has undergone two major rehabilitation projects from 1967 to 1970 and 1995 to 1997. Work included replacing and widening the deck, updating safety features, improving the drainage system, installing new floor system members, and strengthening or replacing deteriorated sections.

The Detroit-Superior Bridge consists of three (3) units of varying structure types within each section.

Unit I -	West Approach
Unit II -	Main Unit Spans
Unit III -	East Station

Plan views of the Veterans Memorial/Detroit-Superior Bridge with the units and sections identified are shown in Drawings 1 through 3 (pages 11-13).

Unit I – West Approach

The West Approach section consists of the West Station area spanning a total of 350 feet west of Tower A and two abandoned subway tunnels: the Detroit Avenue Tunnel (660 feet long) and the West 25th Street Tunnel (480 feet long). There are several utilities that pass through the west station and tunnels. The West Station has been open to the public for tours and festivals since the 1980s.

Unit II – Main Unit Spans

The Main Unit is comprised of Spans 1A, 1B, and Spans 1 through 13. Spans 1A and 1B are transition structures from the underground West Station to the approach and main spans. These two concrete cellular spans total 220 feet long and have an enclosed cellular construction below the lower deck referred to as the catacombs. Spans 1 through 13 are the main spans of the bridge with a double deck design. Spans 1 through 3, 5 through 11, and 13 are concrete open spandrel arches. Span 12 is a concrete encased steel half through arch. Span 4 is a 591 foot, three-hinged steel half through arch truss in a Pratt configuration. The upper deck is used for vehicular and pedestrian traffic and the lower deck is used for utilities and maintenance access. Occasional tours and festivals take place on the lower deck.



PHYSICAL CONDITION REPORT

Bridge Number: CUY-6-1456

SFN: 1800930

Inspection Date: October 22-26, 2018

Unit III – East Station

The East Station is a concrete cellular span that extends 165 feet past the East Abutment. A three panel long, cellular construction is present under the East Station lower deck immediately behind the East Abutment.



Infrastructure Engineers, LLC.
9902 Carver Rd.
Suite 201
Cincinnati, OH 45242

www.consoreng.com

PHYSICAL CONDITION REPORT

Bridge Number: CUY-6-1456
SFN: 1800930
Inspection Date: October 22-26, 2018



East end view looking west



West end view looking east



Infrastructure Engineers, LLC.
9902 Carver Rd.
Suite 201
Cincinnati, OH 45242

www.consoreng.com

PHYSICAL CONDITION REPORT

Bridge Number: CUY-6-1456
SFN: 1800930
Inspection Date: October 22-26, 2018



South elevation



North elevation



Infrastructure Engineers, LLC.
9902 Carver Rd.
Suite 201
Cincinnati, OH 45242

www.consoreng.com

PHYSICAL CONDITION REPORT

Bridge Number: CUY-6-1456
SFN: 1800930
Inspection Date: October 22-26, 2018

Construction and Maintenance History

The following is a summary of significant events in the history of the Detroit-Superior Bridge:

- 1914-1917: Construction of the Detroit Superior High Line Bridge
- November 1917: Bridge opened up to vehicular and pedestrian traffic.
- January 1918: Bridge opened up to streetcar traffic.
- 1953: Streetcar lines abandoned.
- 1967-70 Major Rehabilitation
 - Removal of the original upper deck consisting of four vehicular lanes and two 15-foot wide sidewalks.
 - Strengthening or replacement of all upper deck concrete floorbeams.
 - Span 4: Erection of new steel floorbeam cantilevers.
 - Construction of the new upper deck with six vehicular lanes and two 5-foot wide sidewalks.
- January 18, 1974: Bridge was added to the National Register of Historic Places
- November 11, 1989: Bridge was renamed the Veterans Memorial Bridge.
- 1995-97 Major Rehabilitation
 - Replacement of the upper and lower deck floors.
 - Replacement of select upper and lower concrete floorbeams, columns, jack arches and pier shafts.
 - Application of epoxy-urethane or non-epoxy sealer to most exposed concrete surfaces.
 - Span 4: Replacement of all steel hangers, Panel Points 6 through 6'.
 - Span 4: Replacement of upper deck and lower deck Floorbeams 5 through 5' and the corresponding stringers.
 - Painting of all steel superstructure components.
 - Installation of new drainage system.
 - Installation of architectural lighting.
- 2003 North Sidewalk Linear Park Conversion.
 - Conversion of vehicular traffic to two westbound and one eastbound lane between the steel trusses and on eastbound lane on the Span 4 south cantilever.
 - Widening of the north sidewalk with longitudinal trench drainage.
 - Installation of public art and benches along the modified north sidewalk.
- 2014-Present
 - Span 1A through Span 13: Patching deficient upper deck wearing surface areas.
 - Patch deficient concrete super and substructure components in West Station, Detroit Avenue Tunnel, West 25th Street Tunnel and Spans 1-3 and 5-13. (Note: In Spans 1-3 and 5-13, the patching below the lower deck was later restricted to areas adjacent to and over public areas.)
 - Span 4: Zone painting of primary and secondary truss members between upper and lower decks.
 - Install hanger caps at hanger opening in upper deck, Panel Points 6 through 6'.
 - Repaired spalled wearing surface in Span 9.
 - Pipe cleanout for pedestrian tunnels in the west and east station. (This task was performed but not successful.)
 - South vehicular eastbound lane converted into bike lane.



PHYSICAL CONDITION REPORT

Bridge Number: CUY-6-1456
SFN: 1800930
Inspection Date: October 22-26, 2018

INSPECTION PROCEDURE

Infrastructure Engineers, LLC. conducted a Routine/Fracture Critical inspection on the structural elements of Units I, II, and III using a combination of equipment and industrial rope access techniques. The inspection was performed by a crew of five (5) members recording inspection notes and verifying any new or previously reported areas of deterioration or structural distress.

From the 1995-97 bridge rehabilitation up until the 2015 Routine inspection, a different bridge nomenclature system had been used. With the original construction and rehabilitation drawings included as a significant element of the bridge record, and past FHWA policy of recommending that original member identification system be followed, this inspection therefore followed the structure's original member identification. This practice ensures that this inspection will at a minimum, conform with the original shop drawings and documentation for the prior bridge rehabilitation.



PHYSICAL CONDITION REPORT

Bridge Number: CUY-6-1456
SFN: 1800930
Inspection Date: October 22-26, 2018

Condition and Element Rating Guidelines


The table below contains the bridge inspection rating matrix established by the Federal Highway Administration (FHWA), using a 0-Failure through 9-Excellent scale, and used by the Ohio Department of Transportation (ODOT). In this report, component conditions will generally be discussed based on the ODOT rating guidelines for individual components, 1-Good through 4-Critical.

The General Appraisal, the Deck, Superstructure, Substructure, Channel and Approach Summaries, and the Protective Coating System rating will follow the NBIS/ODOT 0 through 9 rating guidelines.



Individual Items (ODOT)	Summary Items (NBIS)	Condition	Defect
1 GOOD	9	Excellent	Excellent condition.
	8	Very Good	No problems noted.
	7	Good	Some minor problems
2 FAIR	6	Satisfactory	Structural elements show some minor deterioration.
	5	Fair	All primary structural elements are sound but may have minor section loss, cracking, spalling, or scour.
3 POOR	4	Poor	Advanced section loss, deterioration, spalling, or scour.
	3	Serious	Loss of section, deterioration, spalling or scour has seriously affected primary structural components. Local failures are possible. Fatigue cracks in steel or shear cracks in concrete may be present.
4 CRITICAL	2	Critical	Advanced deterioration of primary structural elements, Fatigue cracks in steel or shear cracks in concrete may be present or scour may have removed substructure report. Unless closely monitored it may be necessary to close the bridge until corrective action is taken.
	1	"Imminent Failure"	Major deterioration or section loss present in critical structural components or obvious vertical or horizontal movement affecting structure stability. Bridge is closed to traffic, but corrective action may be put it back in light service.
	0	Failed	Out of service – beyond corrective action.


Manual of Bridge inspection, Ohio Department of Transportation (ODOT), 2014
Bridge Inspector's Reference Manual, Federal Highway Administration (FHWA), 2015
Manual for Condition Evaluation of Bridges, 2nd Edition, AASHTO, 2010 (rev 2011)
National Bridge Inspection Standards, U.S. Department of Transportation, 2004
Inspection of Fracture Critical Bridge Members, U.S. Department of Transportation, 1986



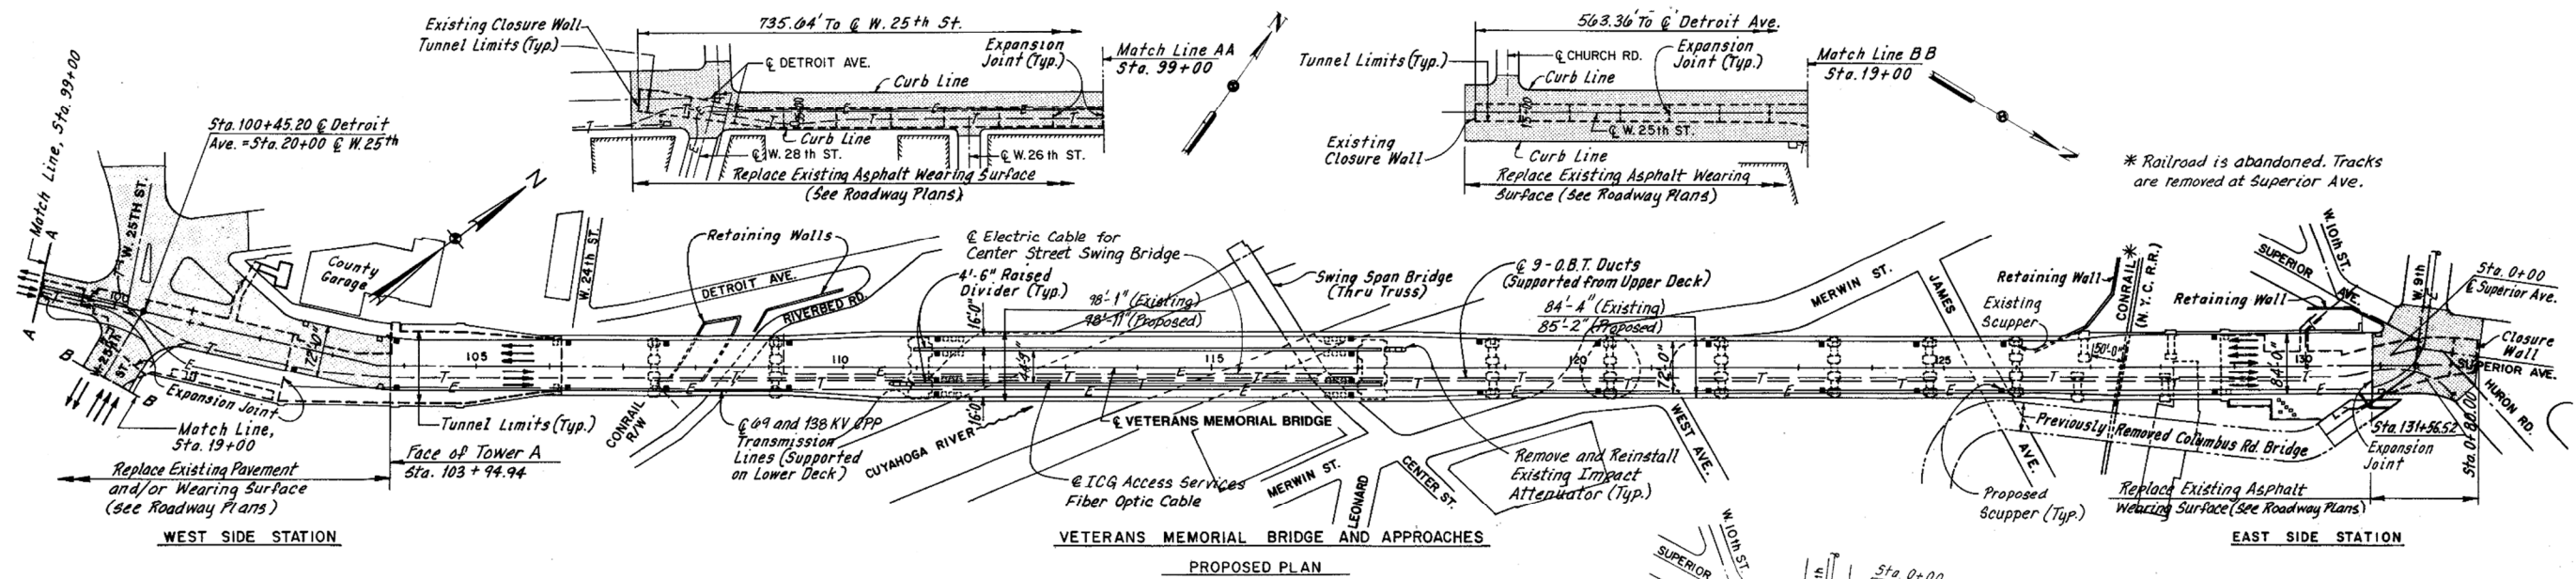


* Railroad is abandoned. Tracks are removed at Superior Ave.

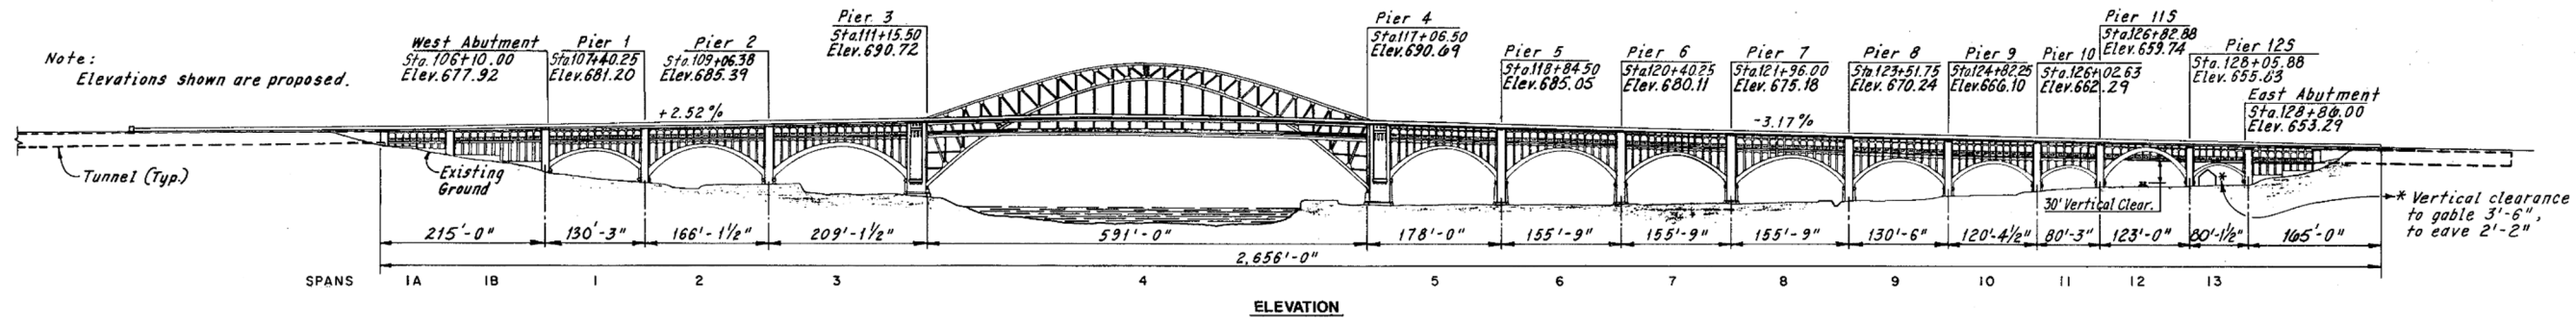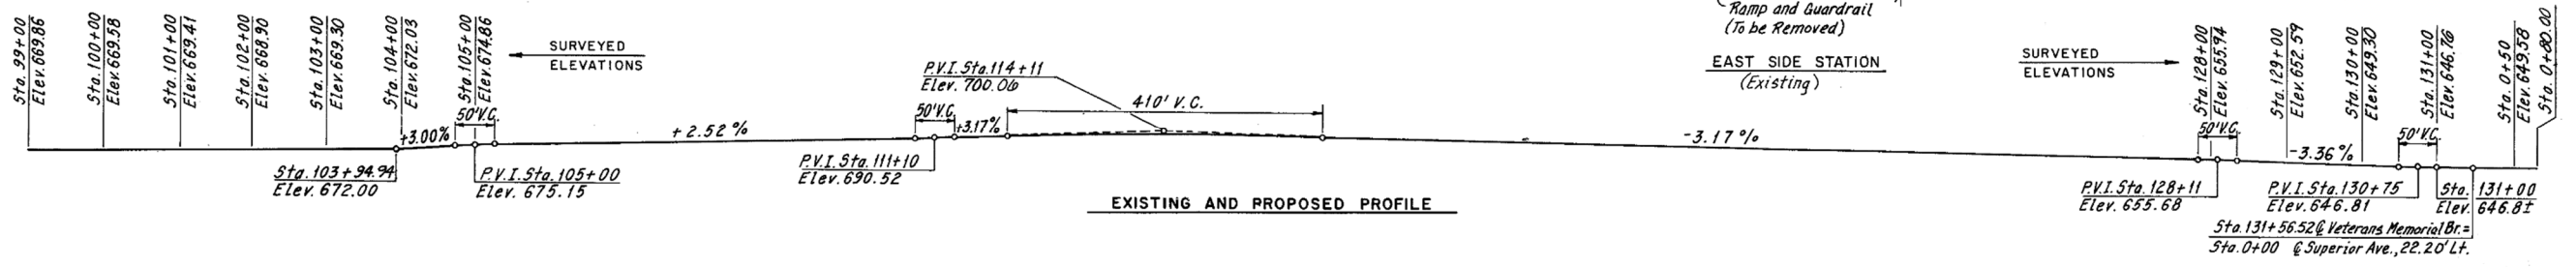

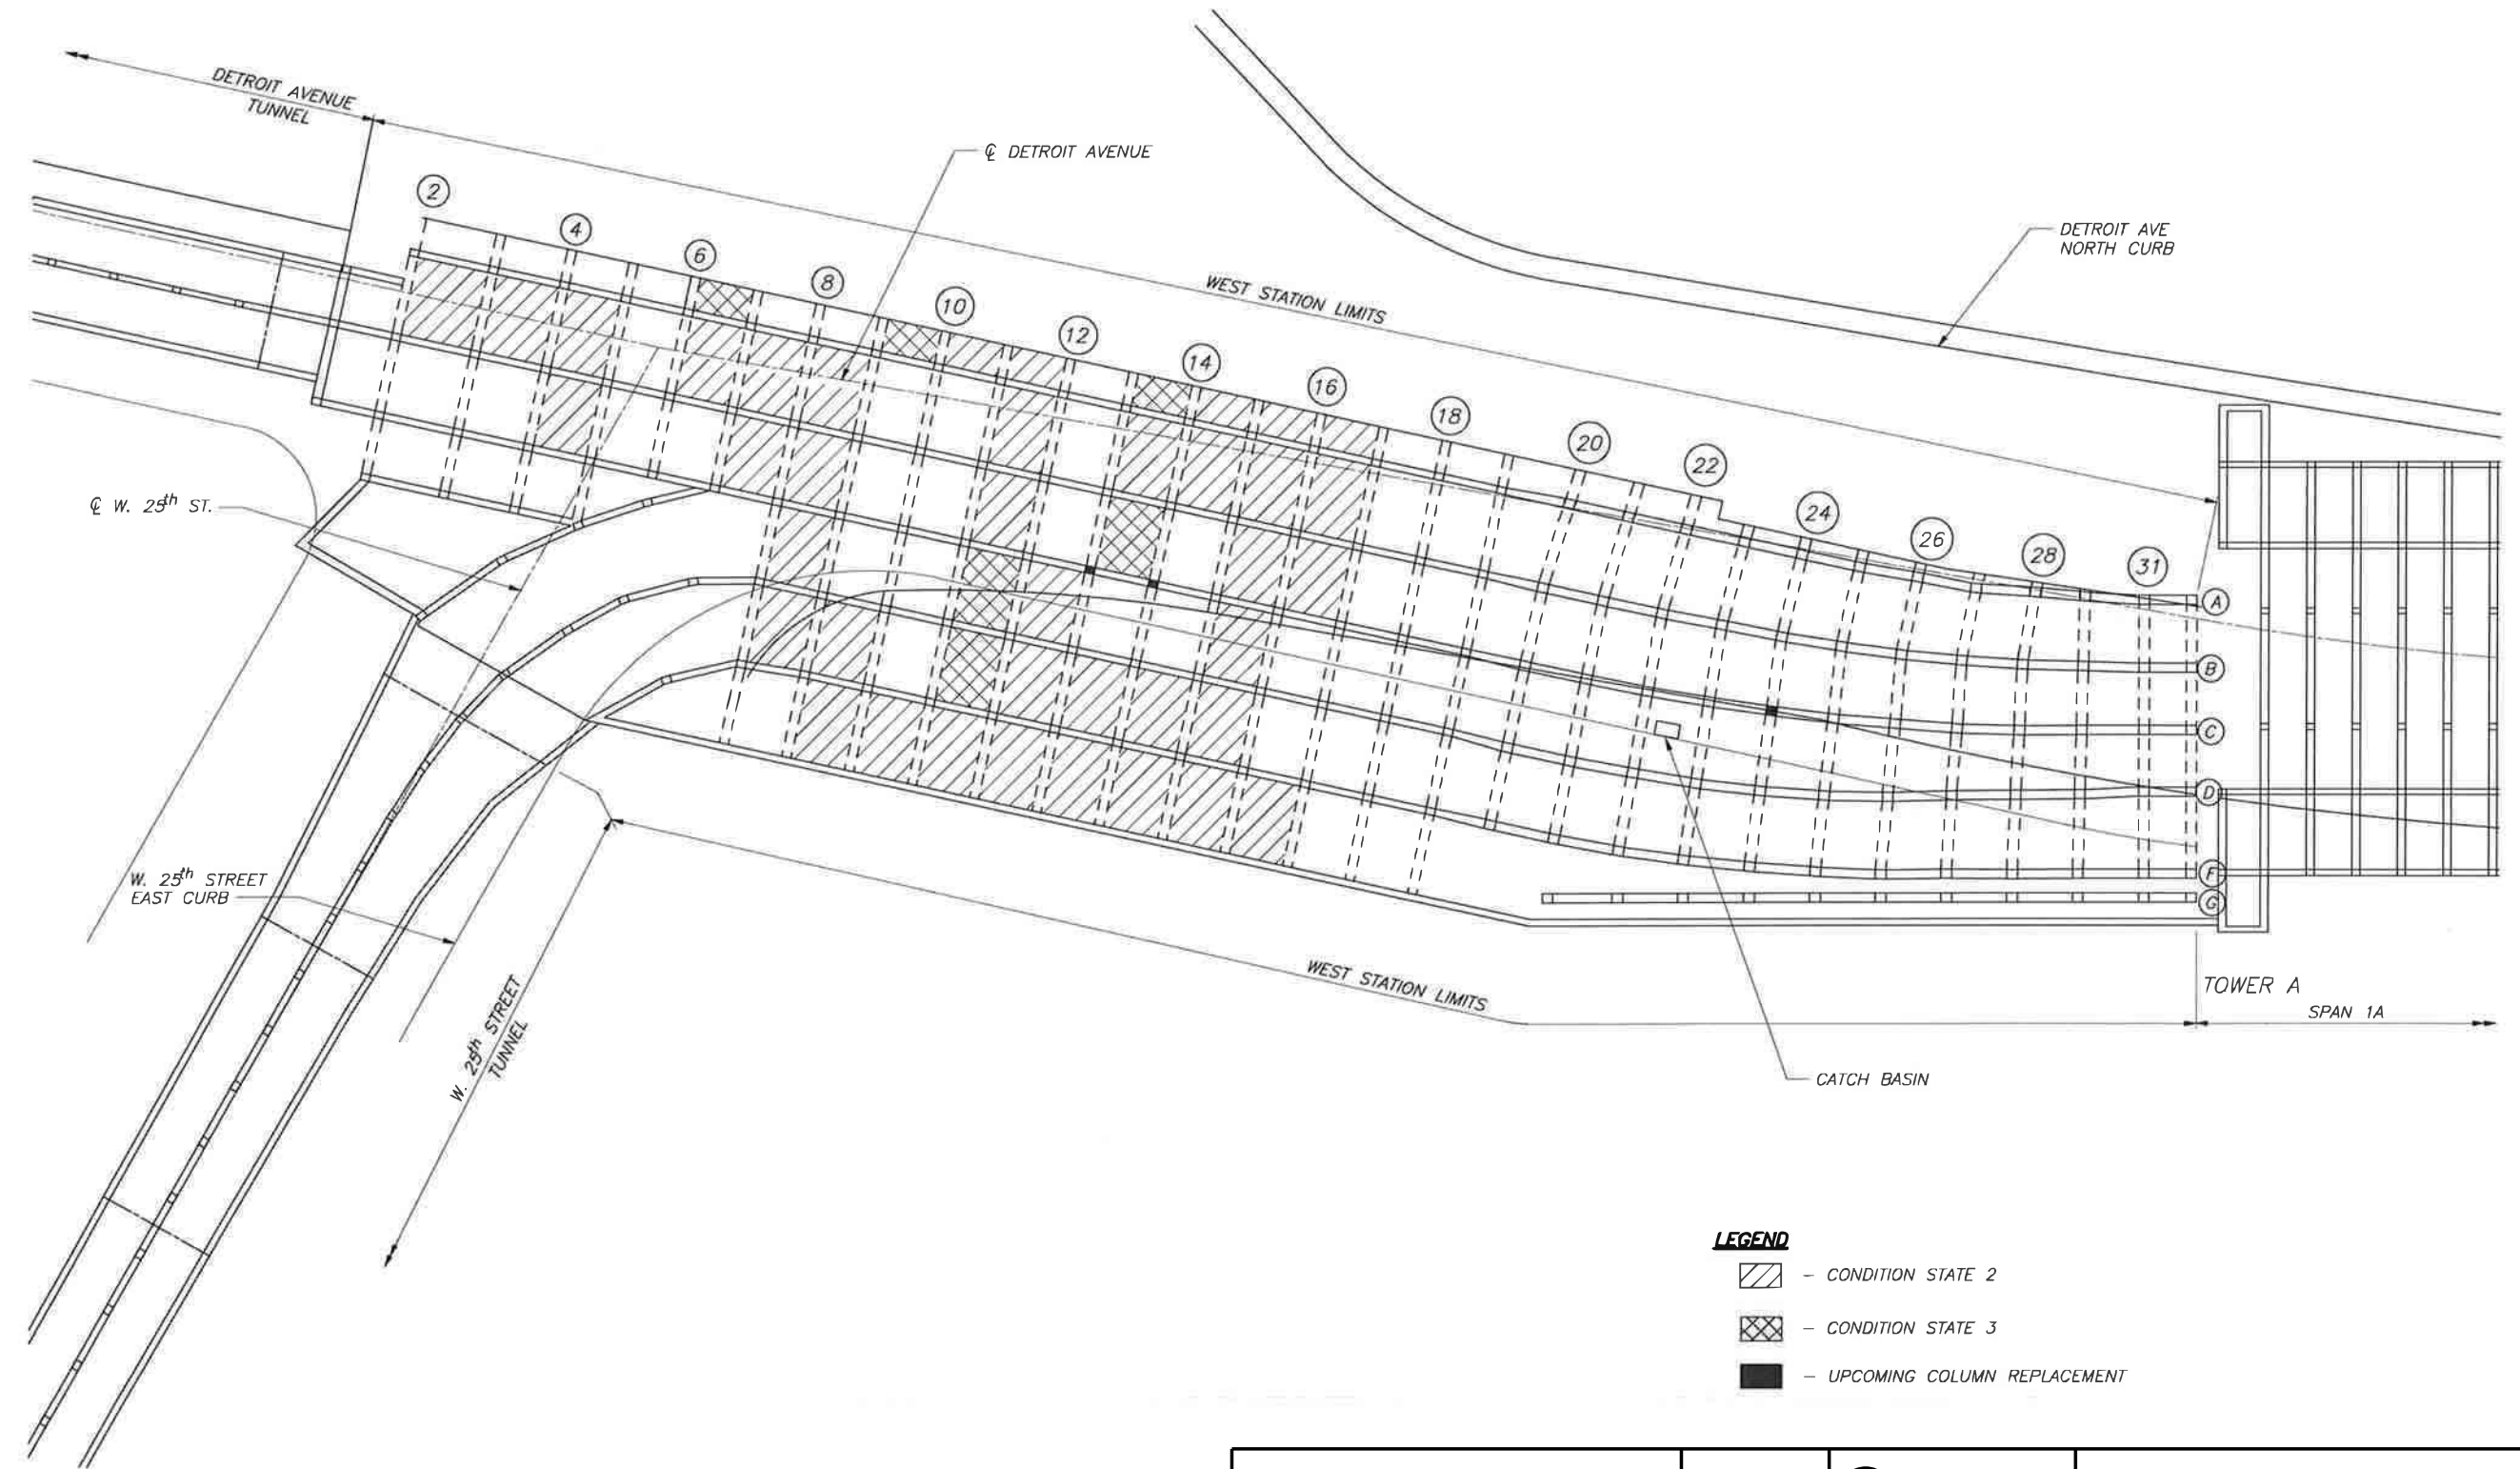

- LEGEND**
- CONDITION STATE 2
 - CONDITION STATE 3
 - UPCOMING COLUMN REPLACEMENT

GRAPHIC SCALE MEASURED IN FEET	DATE	 <small>300 East Business Way Suite 200 Cincinnati, OH 45241 PH.: 614.699.5000</small>	DETROIT-SUPERIOR BRIDGE OVER CUYAHOGA RIVER BRIDGE NO. CUY-6-1456	PAGE
NOT TO SCALE	NOV, 2017	INFRASTRUCTURE ENGINEERS, INC.	WEST STATION PLAN	D-2

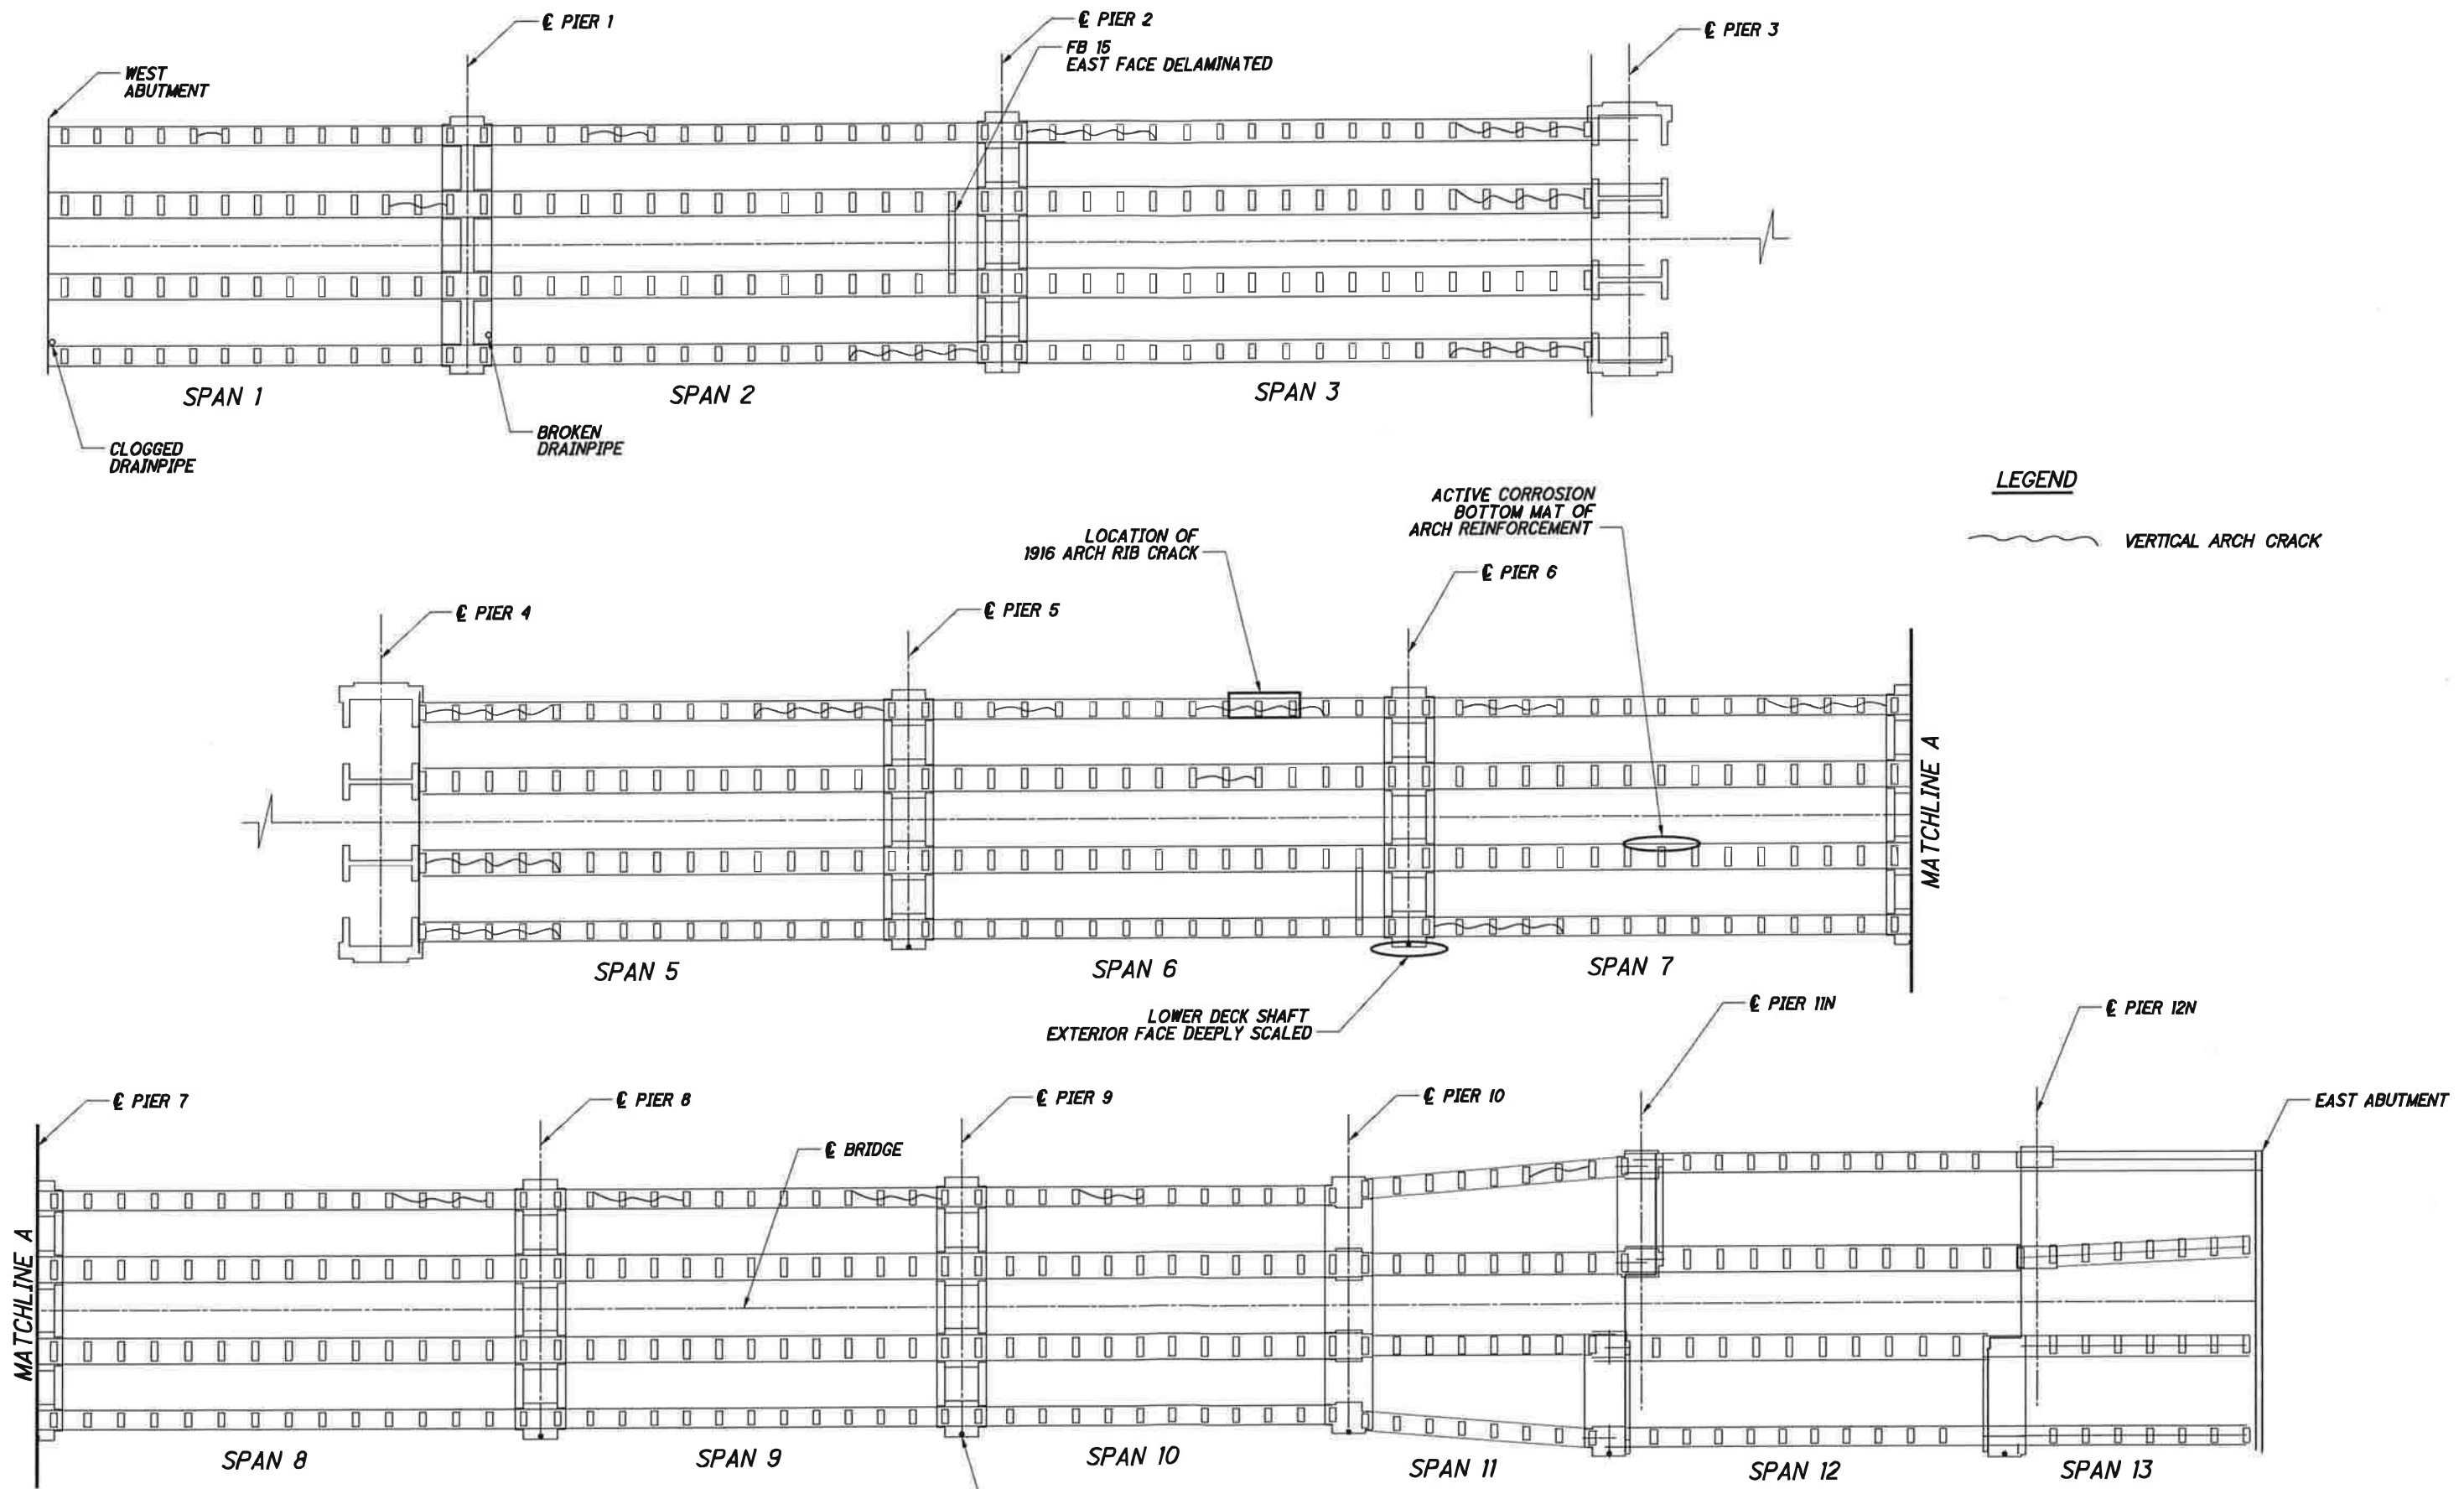

LEGEND
 ~~~~~ VERTICAL ARCH CRACK

|                                                    |                     |                                                                                                                                                                                                                |                                                                      |  |
|----------------------------------------------------|---------------------|----------------------------------------------------------------------------------------------------------------------------------------------------------------------------------------------------------------|----------------------------------------------------------------------|--|
| GRAPHIC SCALE MEASURED IN FEET<br><br>NOT TO SCALE | DATE<br>NOV, 2017   |  300 East Business Way<br>Suite 200<br>Cincinnati, OH 45241<br>PH.: 614.699.5000<br><b>INFRASTRUCTURE ENGINEERS, INC.</b> | DETROIT-SUPERIOR BRIDGE OVER CUYAHOGA RIVER<br>BRIDGE NO. CUY-6-1456 |  |
|                                                    | SUPERSTRUCTURE PLAN |                                                                                                                                                                                                                | PAGE<br>D-3                                                          |  |

# PHYSICAL CONDITION REPORT

Bridge Number: CUY-6-1456  
SFN: 1800930  
Inspection Date: October 22-26, 2018

## Inspection Findings:

### Item N58 – Deck (6, Satisfactory Condition)

The deck is in overall **Satisfactory** condition, a rating of a 6 on the NBIS condition rating guidelines.

The deck findings and summary of deck conditions for individual deck items are as follows:

### Item 7.1 – Floor - Upper Deck (2, Fair Condition)

The upper deck floor is in **Fair** condition.

| Section              | Total Quantity | CS 1       | CS 2      | CS 3   | CS 4 | Transition Rating |
|----------------------|----------------|------------|-----------|--------|------|-------------------|
| Detroit Ave. Tunnel  | 17,950 SF      | 9,950 SF   | 8000      |        |      | 1.55              |
| West 25th St. Tunnel | 13,750 SF      | 12,650 SF  | 1000 SF   | 100 SF |      | 1.22              |
| West Station         | 37,800 SF      | 26,600 SF  | 10,350 SF | 850 SF |      | 1.62              |
| Spans 1A, 1B, 1-13   | 232,250 SF     | 220,638 SF | 11,612 SF |        |      | 1.07              |
| East Station         | 31,150 SF      | 31,150 SF  |           |        |      | 1.00              |
| Total Structure      | 332,900 SF     | 300,988 SF | 30,962 SF | 950 SF |      | 1.18              |

*Detroit Avenue Tunnel:* The Detroit Avenue tunnel slab was retrofitted during the 1995-1997 rehabilitation; a new reinforced concrete slab was placed on top of the original slab. The new slab was designed for HS20 live load with the original slab offering no structural support. The top and bottom surfaces for the new slab is not visible and assumed to be in good condition despite the poor and critical conditions of the original tunnel slab beneath.

*West 25th Street Tunnel:* The West 25th Street tunnel floor is in good condition and exhibits isolated delaminated areas and shallow spalling.

*West Station:* The West Station Floor is in fair condition and exhibits areas of spalling, cracking and efflorescence, active water infiltration, and exposed reinforcing steel. The most significant areas of deterioration are adjacent to the restored floor joints and in Bays A and B.

*Spans 1A, 1B, and 1 through 13:* The upper deck floor in the main spans is in fair condition with isolated cracks with and without efflorescence. There are numerous sound and unsound patches and spalls, some with exposed reinforcing. During the inspection, cold patches were performed, however, in a very poor



# PHYSICAL CONDITION REPORT

**Bridge Number:** CUY-6-1456  
**SFN:** 1800930  
**Inspection Date:** October 22-26, 2018

manner which will likely not be sufficient.

*East Station:* The East Station floor is in good condition with no significant deficiencies.

*Lower Deck:* Not considered in this quantity was the lower deck floor. The lower deck is in good condition. The lower deck is reinforced concrete with stay in place (SIP) forms in Spans 1 through 3, and Spans 5 through 13. In Span 4 the lower deck is a combination of an interior vehicular steel grid deck and exterior pedestrian fiberglass grating. In the center bay of Panel 15 in Span 2 the SIP forms exhibit severe corrosion that is staining the west face of Pier 2. The South Bay in Span 1B has spalling up to 4-inches deep that exposed the top mat of reinforcing in the 12-inch thick slab.

**Item 7.2 – Edge of Floor – Upper Deck (2, Fair Condition)**

The edge of floor is in *Fair* condition.

| Total Quantity | CS 1     | CS 2 | CS 3 | CS 4 | Transition Rating |
|----------------|----------|------|------|------|-------------------|
| 5,312 LF       | 5,312 LF |      |      |      | 1.00              |

**Item 8 – Wearing Surface (2, Fair Condition)**

The concrete wearing surface is in *Fair* condition.

| Total Quantity | CS 1       | CS 2     | CS 3     | CS 4 | Transition Rating |
|----------------|------------|----------|----------|------|-------------------|
| 191,232 SF     | 186,717 SF | 2,785 SF | 1,730 SF |      | 1.17              |

The asphalt wearing surface above the West Station exhibits heavy cracking and patching throughout. The deterioration above the West Station is more prominent in the eastbound lanes. The concrete wearing surface exhibits delaminations, large asphalt patches, and deteriorating asphalt patches. The bike lane along the south side of the bridge in Span 4 has multiple asphalt and concrete patches throughout with wide spread map cracking. Not considered in this quantity was the lower deck wearing surface.

**Item 9 – Curb and Sidewalk (2, Fair Condition)**

The curb and sidewalks are in *Fair* condition.

| Total Quantity | CS 1     | CS 2     | CS 3 | CS 4 | Transition Rating |
|----------------|----------|----------|------|------|-------------------|
| 5,312 LF       | 3,872 LF | 1,062 LF | 378  |      | 1.95              |

The curbs and sidewalks exhibit random cracking, isolated spalls, and delaminations.



# PHYSICAL CONDITION REPORT

**Bridge Number:** CUY-6-1456  
**SFN:** 1800930  
**Inspection Date:** October 22-26, 2018

## Item 10 and Item 11 – Median and Railing (1, Good Condition)

The concrete median and railings are in **Good** condition.

| Component | Total Quantity | CS 1     | CS 2  | CS 3 | CS 4 | Transition Rating |
|-----------|----------------|----------|-------|------|------|-------------------|
| Median    | 674 LF         | 635 LF   | 39 LF |      |      | 1.08              |
| Railing   | 5,312 LF       | 5,308 LF | 4 LF  |      |      | 1.00              |

The median exhibits shallow spalls. The southwest impact attenuator in Span 3 exhibits minor impact damage. In Span 5 the south railing aluminum fence has a 2-foot long damaged section. The south railing at Tower A is misaligned 7/8-inch vertically. The south railing at Tower B is vertically misaligned 1/4-inch vertically.

The entire length of concrete railing on the bridge was considered in this item. There was also Type 5 railing on the north side of Span 4 protecting the bridge truss and hangers. All concrete railing was in good condition with minor cracking, staining, and isolated distress. In Span 5 the south railing aluminum fence has a 2-foot long damaged section.

## Item 12 – Drainage (2, Fair Condition)

The deck drainage is in **Fair** condition.

| Total Quantity | CS 1  | CS 2 | CS 3 | CS 4 | Transition Rating |
|----------------|-------|------|------|------|-------------------|
| 28 EA          | 22 EA | 1 EA | 1 EA | 4 EA | 3.25              |

The West Abutment, south downspout is completely clogged at the base of the catch basin. At Pier 1 there is a 15-foot section of PVC pipe missing from the south drain on the east face of the pier. The north catch basin at Pier 1 is missing the catch basin grate. At Piers 8 and 9, the south catch basin is clogged. The Pier 9 south catch basin concrete frame has shifted to the west. The north sidewalk longitudinal trench drains are filled with debris and not functioning.

## Item 13 – Expansion Joints (2, Fair Condition)

The expansion joints are in **Fair** condition.

| Total Quantity | CS 1 | CS 2    | CS 3  | CS 4 | Transition Rating |
|----------------|------|---------|-------|------|-------------------|
| 2579 LF        |      | 2538 LF | 40 LF |      | 2.09              |

The Tower B expansion joint in the westbound lane exhibits broken fillet welds attaching the joint extrusion to the joint armor due to the formation of pack rust between the components. Snow plow damage is also present on the Tower B expansion joint in the westbound lane due to the west armor sitting 1/2-inch higher than the east armor. Joints are typically filled with debris and have edge spalls along the joint armor.





# PHYSICAL CONDITION REPORT

**Bridge Number:** CUY-6-1456  
**SFN:** 1800930  
**Inspection Date:** October 22-26, 2018

Deck deficiencies and specific locations are noted in the following table:

| Deck Notes       |              |              |                                                                                                                          |       |
|------------------|--------------|--------------|--------------------------------------------------------------------------------------------------------------------------|-------|
| Unit             | Span         | Drawing Note | Note                                                                                                                     | Photo |
| Sidewalk         | 1A           |              | South sidewalk has a 4' L x 4" W x 1" D spall.                                                                           |       |
| Railing          | Tower A      |              | South top railing; vertically misaligned 7/8" at railing joint.                                                          | 7     |
| Upper Deck       | West tunnels |              | Heavy efflorescence, cracking, delaminations, and spalls with corroded reinforcing throughout the underside of the deck. | 8     |
| Wearing Surface  | West Station |              | Heavy cracking and patching throughout asphalt wearing surface. This is more prominent in the eastbound lanes.           | 9     |
| Expansion Joints | Tower B      |              | Left westbound lane; pack rust has broken fillet welds. Snow plow damage is present.                                     | 10    |
| Railing          | Tower B      |              | South top railing; vertically misaligned 1/4" at railing joint.                                                          |       |
| Railing          | 1A           |              | South parapet has an open electrical box.                                                                                |       |
| Lower Deck       | 1B           |              | South Bay; exposed top mat of reinforcement.                                                                             |       |
| Drainage         | West Abut.   |              | South downspout is completely clogged at the bottom.                                                                     |       |
| Lighting         | 1            |              | The light pole base on the north sidewalk in Span 1 is broken.                                                           |       |
| Wearing Surface  | 1            | 5            | 8' L x 3' W x 1" D spalling patch.                                                                                       |       |
| Wearing Surface  | 1            | 6            | 6' Diameter spalling patch.                                                                                              |       |
| Wearing Surface  | 1            | 7            | 6' L x 3' W x 1" D spalling patch.                                                                                       |       |
| Drainage         | Pier 1       |              | South drain pipe is missing a 15' long section of PVC.                                                                   | 11    |
| Drainage         | Pier 1       |              | The north drain pipe catch basin grate is missing.                                                                       |       |
| Lower Deck       | 2            |              | Panel 15, Center Bay; SIP forms have severe corrosion that is staining the west face of Pier 2.                          | 12    |
| Median           | 3            |              | Southwest attenuator has minor impact damage.                                                                            | 13    |
| Wearing Surface  | 3            | 10           | 1' Diameter x 2" D spall with exposed reinforcing.                                                                       |       |
| Wearing Surface  | 3            | 12           | 12' L x 2' W patch with minor spalls along the edge of the joint armor.                                                  |       |
| Wearing Surface  | 4            | 14           | 4' Diameter deteriorating patch.                                                                                         |       |
| Sidewalk         | 4            | 15           | 5-1/2' L x 8" W x 2" D spall in sidewalk.                                                                                |       |
| Curb             | 4            | 18           | 3' L x 7" W x 2" D spall in top edge of curb.                                                                            |       |
| Curb             | 4            | 19           | 1-1/2' L x 8" W x 2" D spall in top edge of curb.                                                                        |       |
| Curb             | 4            | 20           | 3' L x 6" W x 2" D spall in top edge of curb.                                                                            |       |



Infrastructure Engineers, LLC.  
 9902 Carver Rd.  
 Suite 201  
 Cincinnati, OH 45242

[www.consoreng.com](http://www.consoreng.com)

# PHYSICAL CONDITION REPORT

**Bridge Number:** CUY-6-1456  
**SFN:** 1800930  
**Inspection Date:** October 22-26, 2018

| Deck Notes       |      |              |                                                                                                                         |       |
|------------------|------|--------------|-------------------------------------------------------------------------------------------------------------------------|-------|
| Unit             | Span | Drawing Note | Note                                                                                                                    | Photo |
| Curb             | 4    | 21           | 2' L x 7" W x 2" D spall in top edge of curb.                                                                           |       |
| Sidewalk         | 4    | 23           | 2' L x 1'-7" W x 2" D spall in sidewalk.                                                                                |       |
| Curb             | 4    | 24           | Three (3) 2' L x 6" W up to 1" D spalls in top of curb.                                                                 |       |
| Wearing Surface  | 4    | 25           | 12' L x 18' W x 1" D spalling patch.                                                                                    | 14    |
| Curb             | 4    | 26           | 2' L x 1' W x 1" D spall in top edge of curb.                                                                           |       |
| Wearing surface  | 4    | 27           | Pier 4 west joint has intermittent spalling along the west armor plate up to 1" D.                                      |       |
| Concrete Railing | 4    | 29           | North and south Concrete railing has a 1'-10" H x 8" W x 3" D spall.                                                    |       |
| Joint            | 4    |              | The 10 bolts that secure the joint cover over the Pier 4 west joint on the south sidewalk have sheared heads.           |       |
| Wearing Surface  | 4    | 31           | Pier 4 east joint has intermittent spalling along the west armor plate up to 1" D.                                      |       |
| Sidewalk         | 4    | F1           | North sidewalk has a 1' L x 3' W x up to 2" D spall/delamination.                                                       |       |
| Sidewalk         | 4    | F2           | North sidewalk has intermittent spalling over a 100' L x 18" W x up to 1-1/2" D.                                        |       |
| Wearing Surface  | 4    | F3           | Intermittent spalling along either side of joint at Panel Point 5' in the travel lanes and north sidewalk up to 1/2" D. |       |
| Sidewalk         | 4    | F4           | Intermittent spalling along either side of joint at Panel Point 5 in the travel lanes and north sidewalk up to 1/2" D.  |       |
| Sidewalk         | 4    | F5           | North sidewalk has intermittent spalling over a 50' L x 18" W x up to 1-1/2" D.                                         |       |
| Sidewalk         | 4    | F6           | Pier 3 east joint at the north sidewalk has a 15' L x 3' W x 2" D spalling.                                             |       |
| Wearing Surface  | 5    |              | Panel 2; large delamination.                                                                                            |       |
| Railing          | 5    | 1            | South railing fence has a 2' L damaged section.                                                                         |       |
| Lighting         | 5    |              | Base of light pole on the north sidewalk over Pier 5 is broken.                                                         |       |
| Wearing Surface  | 5    | 2            | 2' L x 3' W spalling patch.                                                                                             |       |
| Wearing Surface  | 5    | 3            | Two (2) 1' Diameter spalling patches.                                                                                   |       |
| Wearing Surface  | 5    | 4            | Intermittent spalling along either side of joint over Pier 5 for full width of bridge up to 1/2" D.                     |       |
| Wearing Surface  | 5    | 5            | 3' Diameter spalling patch.                                                                                             |       |
| Wearing Surface  | 5    | 8            | Intermittent spalling along either side of joint over west side of Pier 6 joint in the travel lanes up to 1/2" D.       |       |



# PHYSICAL CONDITION REPORT

**Bridge Number:** CUY-6-1456  
**SFN:** 1800930  
**Inspection Date:** October 22-26, 2018

| Deck Notes      |        |              |                                                                                                                                                      |       |
|-----------------|--------|--------------|------------------------------------------------------------------------------------------------------------------------------------------------------|-------|
| Unit            | Span   | Drawing Note | Note                                                                                                                                                 | Photo |
| Upper Deck      | 7      |              | Panel 4, Center Bay; local area of efflorescence on deck underside.                                                                                  | 15    |
| Wearing Surface | 7      | 10           | 15' L x 8' W deteriorating patch.                                                                                                                    |       |
| Curb            | 7      | 11           | 2' L x 8" W x 2" D spall in top edge of curb.                                                                                                        |       |
| Railing         | 7      | 12           | South metal railing has damage over a 1' Length.                                                                                                     |       |
| Wearing Surface | 7      | 13           | 4' x 4' x 1" D spalling patch.                                                                                                                       |       |
| Wearing Surface | 8      | 14           | 5' W x 4' L x up to 2" D spalling patch.                                                                                                             |       |
| Wearing Surface | 8      | 15           | 3' L x 2' W deteriorating patch.                                                                                                                     |       |
| Wearing Surface | 8      | 16           | 12' L x 10' W x 1" D spalling patch.                                                                                                                 |       |
| Wearing Surface | 8      | 17           | 8' L x 4' W x 1" D spalling patch.                                                                                                                   |       |
| Wearing Surface | 8      | 18           | 25' L x 7' x 3" D spalling patch with exposed reinforcing.                                                                                           | 16    |
| Wearing Surface | 8      | 19           | 15' L x 24' W x up to 4" D spalling patch with exposed reinforcing.                                                                                  |       |
| Wearing Surface | 8      | 20           | 6' W x 57' L delaminated patch.                                                                                                                      |       |
| Drainage        | Pier 8 |              | The South drain pipe catch basin is clogged.                                                                                                         |       |
| Wearing Surface | 9      | 21           | 15' L x 7' W x up to 1" D spalling patch.                                                                                                            |       |
| Wearing Surface | 9      | 23           | 5' Diameter x up to 2" D spalling patch.                                                                                                             |       |
| Drainage        | Pier 9 |              | The South drain pipe catch basin is completely clogged and concrete frame is shifted to the west. North drain pipe catch basin is partially clogged. |       |
| Wearing Surface |        | 22           | Intermittent spalling along either side of joint over west side of Pier 9 joint in the travel lanes up to 1/2" D.                                    |       |
| Wearing Surface |        | 24           | 10' L x 5' W x up to 1" D spalling patch.                                                                                                            |       |
| Wearing Surface |        | 25           | 2' L x 3' W x up to 1" D spalling patch.                                                                                                             |       |
| Wearing Surface | 10     | 26           | 8' L x 6" W spalling patch.                                                                                                                          |       |
| Wearing Surface | 11     | 27           | Intermittent spalling along either side of joint over west side of Pier 10 joint in the travel lanes up to 1/2" D.                                   |       |



# PHYSICAL CONDITION REPORT

**Bridge Number:** CUY-6-1456  
**SFN:** 1800930  
**Inspection Date:** October 22-26, 2018

| Deck Notes      |      |              |                                                                                                       |       |
|-----------------|------|--------------|-------------------------------------------------------------------------------------------------------|-------|
| Unit            | Span | Drawing Note | Note                                                                                                  | Photo |
| Lighting        | 11   |              | The light pole base on the north sidewalk in Span 11 is broken                                        | 17    |
| Wearing Surface | 12   | 28           | 6' x 6' x 1" D spalling patch.                                                                        |       |
| Wearing Surface | 12   | 29           | 3' L x 6' W x 1" D spalling patch.                                                                    |       |
| Wearing Surface | 12   | 30           | 1' L x 2' W deteriorating patch.                                                                      |       |
| Sidewalk        | 12   | 31           | 2' L x 7" W x 2" D spall in top edge of sidewalk.                                                     |       |
| Wearing Surface | 13   | 32           | Intermittent spalling along either side of joint over Pier 12 joint in the travel lanes up to 1/2" D. |       |
| Wearing Surface | 13   | 33           | Intermittent spalling along either side of joint over east abutment in the travel lanes up to 1/2" D. |       |
| Upper Deck      | 18   |              | South Bay, Panel 3; 2' Diameter area of map cracking and efflorescence                                |       |

## Item N59 – Superstructure (5, Fair Condition)

The superstructure is overall **Fair** condition, or 5 on the NBIS condition rating guidelines.

The superstructure findings and summary of conditions for individual items are as follows:

### Item 14 – Alignment of Members (1, Good Condition)

The alignment of the primary superstructure members is **Good**.

| Total Quantity | CS 1  | CS 2 | CS 3 | CS 4 | Transition Rating |
|----------------|-------|------|------|------|-------------------|
| 40 EA          | 40 EA |      |      |      | 1.00              |

## Concrete Superstructure

### Item 27 – Concrete Arch (2, Fair Condition)

The concrete arches are in **Fair** condition.

| Total Quantity | CS 1     | CS 2     | CS 3  | CS 4 | Transition Rating |
|----------------|----------|----------|-------|------|-------------------|
| 8,040 LF       | 6,540 LF | 1,475 LF | 25 LF |      | 1.30              |

The concrete arches typically exhibit cracking, spalls with and without exposed reinforcing, and



# PHYSICAL CONDITION REPORT

**Bridge Number:** CUY-6-1456  
**SFN:** 1800930  
**Inspection Date:** October 22-26, 2018

delaminations throughout. Some of the previous spalling has been repaired particularly over public areas and parking lots. The repairs appear to be sound. See the “Open Spandrel Arch and Truss Spans CADD Drawings and Deficiencies” section showing all concrete arch deficiencies (Photos 18- through 20).

**Item 28 – Concrete Arch Columns/Hanger (2, Fair Condition)**

The concrete arch columns are in **Fair** condition.

| Total Quantity | CS 1   | CS 2  | CS 3  | CS 4 | Transition Rating |
|----------------|--------|-------|-------|------|-------------------|
| 747 EA         | 672 EA | 50 EA | 25 EA |      | 1.54              |

The concrete arch columns exhibit up to full height corner cracking and up to full height shallow spalls with exposed reinforcing steel. Previously patched columns exhibit delaminated areas adjacent to the patched concrete. Concrete arches connecting the columns just below the upper deck exhibit spalls with exposed reinforcing steel, cracks, and delaminated areas. See the “Open Spandrel Arch and Truss Spans CADD Drawings and Deficiencies” section showing all the concrete arch column deficiencies (Photos 21 and 22).

**Item 15.1 Beams - Concrete (3, Poor Condition)**

The beams are in overall **Poor** condition. This element consists of the longitudinal beams in the Detroit Tunnel, West 25th Street Tunnel, and West Station.

| Total Quantity | CS 1     | CS 2     | CS 3     | CS 4 | Transition Rating |
|----------------|----------|----------|----------|------|-------------------|
| 7,394 LF       | 3,698 LF | 1,848 LF | 1,848 LF |      | 2.56              |

The concrete beams in the West Station, Detroit Tunnel, and West 25th Street Tunnel are in poor condition due to extensive spalling with and without exposed reinforcing, delaminations, and efflorescence. The previous report mentioned these spalls were to be repaired at the conclusion of the current rehabilitation in Spring 2016, however these spalls still exist. See the attached drawings showing all the concrete beam deficiencies.

**Item 18 – Floorbeams - Concrete (2, Fair Condition)**

The floorbeams are in overall **Fair** condition.

| Total Quantity | CS 1      | CS 2      | CS 3     | CS 4 | Transition Rating |
|----------------|-----------|-----------|----------|------|-------------------|
| 33,543 LF      | 10,000 LF | 16,543 LF | 7,000 LF |      | 2.48              |

The concrete floorbeams in Spans 1A, 1B, 1 through 3, and Spans 5 through 13 are in **Satisfactory** condition. The floorbeams exhibit isolated spalls with exposed reinforcing, cracking, and delaminations. See the “Open Spandrel Arch and Truss Spans CADD Drawings and Deficiencies” section for the concrete floorbeam deficiencies (Photos 23 through 25).



# PHYSICAL CONDITION REPORT

**Bridge Number:** CUY-6-1456  
**SFN:** 1800930  
**Inspection Date:** October 22-26, 2018

The lower deck floorbeams in the East Station have the bottom mat of reinforcing steel exposed. This deterioration has changed little since the 1980's and with no live load carried by these floorbeams, no repairs are recommended.

The lower deck corbels appear to be architectural elements however they are actually cantilevered ends to the floor beams, directly supporting the exterior upper deck column loads above. Many of the corbels were patched or replaced in the 1995 and 2014 rehabilitations. Additional cracks, delaminations, and spalls are present on multiple lower deck corbels due to the corrosion of the compressive diagonal reinforcing steel in the corbel.

## Steel Superstructure (Span 4)

The load bearing components (web plates and flange angles) of the primary truss members and gusset plates are composed of nickel steel, an early high strength steel also known for its corrosion resistant properties (Photos 26 and 27). The original hangers, composed of nickel steel, were replaced with 50 ksi steel. All lacing member components of the primary truss members, upper and lower deck floorbeams, lateral and longitudinal bracing and sway bracing are composed of 30 ksi carbon steel.

### Item 17 – Stringers (1, Good Condition)

The stringers are in **Good** condition. All of the upper deck stringers have shear studs welded to the top flange providing composite action with the deck. The upper and lower deck stringers in Panels 4, 5, 5', and 4' were replaced in 1995.

| Total Quantity | CS 1      | CS 2 | CS 3 | CS 4  | Transition Rating |
|----------------|-----------|------|------|-------|-------------------|
| 10,638 LF      | 10,615 LF | 1 LF | 2 LF | 20 LF | 1.10              |

The upper deck stringers are in good condition. The original curb stringers of Lines 5 and 14 exhibit light pitting on the bottom flanges. The stringers supporting the outer pedestrian fiber glass grid deck are also in good condition.

The lower deck stringers supporting the steel grid deck are in good condition. Lower deck stringers supporting only their own dead weight often exhibit advanced corrosion at the saddle bearings.

### Item 18 – Floorbeams - Steel (1, Good Condition)

The steel floorbeams in Span 4 are in **Good** condition.

| Total Quantity | CS 1     | CS 2 | CS 3  | CS 4  | Transition Rating |
|----------------|----------|------|-------|-------|-------------------|
| 3,925 LF       | 3,871 LF | 2 LF | 10 LF | 42 LF | 1.52              |

Random upper deck floorbeams have painted over perforations at the ends, some of which have repair plates welded in place. See attached deficiencies table and drawings for specific locations.



# PHYSICAL CONDITION REPORT

**Bridge Number:** CUY-6-1456  
**SFN:** 1800930  
**Inspection Date:** October 22-26, 2018

The lower deck floorbeams exhibit light active corrosion below the truss lines. Knife edging on lower deck Floorbeams 5 and 5' was cleaned and painted during the 1995 rehabilitation.

**Item 19 – Truss Verticals (1, Good Condition)**

The truss verticals are in **Good** condition.

| Total Quantity | CS 1  | CS 2  | CS 3 | CS 4 | Transition Rating |
|----------------|-------|-------|------|------|-------------------|
| 50 EA          | 38 EA | 12 EA |      |      | 1.32              |

Local perforations are present on diaphragm plates located between the upper and lower decks and minor corrosion of the lacing bars below the lower deck.

**Item 20 – Truss Diagonals (1, Good Condition)**

The truss diagonals are in **Good** condition with isolated areas of pack rust and pitting.

| Total Quantity | CS 1   | CS 2 | CS 3  | CS 4 | Transition Rating |
|----------------|--------|------|-------|------|-------------------|
| 268 EA         | 253 EA | 4 EA | 11 EA |      | 1.57              |

The truss diagonal stay plates below the lower deck exhibit minor pitting. Random lacing bars above the upper deck exhibit painted over corrosion holes.

**Item 21 – Truss Upper Chord (1, Good Condition)**

The truss upper chords are in **Good** condition with isolated areas of pack rust and pitting.

| Total Quantity | CS 1  | CS 2 | CS 3 | CS 4 | Transition Rating |
|----------------|-------|------|------|------|-------------------|
| 48 EA          | 47 EA |      |      | 1 EA | 1.83              |

The truss upper chord members exhibit isolated rust staining with negligible section loss. North U12U11' exhibits pack rust between the hinge cover plate and the truss top flange resulting in a 1/8-inch Diameter corrosion hole in the cover plate.

**Item 22 – Truss Lower Chord (2, Fair Condition)**

The truss lower chords are in **Fair** condition with isolated areas of pack rust and pitting.

| Total Quantity | CS 1  | CS 2  | CS 3 | CS 4 | Transition Rating |
|----------------|-------|-------|------|------|-------------------|
| 48 EA          | 36 EA | 12 EA |      |      | 1.33              |



# PHYSICAL CONDITION REPORT

**Bridge Number:** CUY-6-1456  
**SFN:** 1800930  
**Inspection Date:** October 22-26, 2018

**Item 23 – Truss Gusset Plates (2, Fair Condition)**

The truss gusset plates are in **Fair** condition.

| Total Quantity | CS 1  | CS 2  | CS 3 | CS 4 | Transition Rating |
|----------------|-------|-------|------|------|-------------------|
| 104 EA         | 75 EA | 25 EA | 4 EA |      | 1.74              |

The lower chord gusset plates exhibit minor corrosion above the top of the lower chord members. The south face of the south gusset plate at North L2 and both gusset plates at L3 exhibit pitting up to 1/4-inch deep with reactivating corrosion along the interior face of the gusset plates above the lower chord. The rest of the gusset plates below the lower deck exhibit areas of surface corrosion on the interior faces of the gusset plates.

**Item 24 – Lateral Bracing (1, Good Condition)**

The lateral bracing is in **Good** condition with isolated areas of minor surface corrosion and pack rust below the lower deck.

| Total Quantity | CS 1  | CS 2 | CS 3 | CS 4 | Transition Rating |
|----------------|-------|------|------|------|-------------------|
| 36 EA          | 30 EA |      | 6 EA |      | 2.29              |

**Item 25 – Sway Bracing (1 Good Condition)**

The sway bracing is in **Good** condition with isolated areas of pack rust and pitting.

| Total Quantity | CS 1  | CS 2 | CS 3 | CS 4 | Transition Rating |
|----------------|-------|------|------|------|-------------------|
| 28 EA          | 21 EA | 2 EA | 5 EA |      | 2.35              |

Isolated perforations were noted at the connections to the truss vertical members below the lower deck.

**Item 26 – Bearing Devices (2, Fair Condition)**

The bearings are in **Fair** condition with surface corrosion noted on the interior faces of all four bearing castings.

| Total Quantity | CS 1 | CS 2 | CS 3 | CS 4 | Transition Rating |
|----------------|------|------|------|------|-------------------|
| 4 EA           |      | 4 EA |      |      | 2.00              |

The non-structural bearing pin cover plates exhibit cracks up to 7-inches long at L0 and L0' on both trusses. The north pin cover at L0 on the north truss has fallen off. Steel shot blasting material from the 1997 painting operation has accumulated within the casting chambers.

**Item 30 – Protective Coating System (2, Fair Condition)**





# PHYSICAL CONDITION REPORT

**Bridge Number:** CUY-6-1456  
**SFN:** 1800930  
**Inspection Date:** October 22-26, 2018

The protective coating system (PCS) is in **Fair** condition.

| Total Quantity | CS 1      | CS 2     | CS 3   | CS 4 | Transition Rating |
|----------------|-----------|----------|--------|------|-------------------|
| 14,469 LF      | 12,869 LF | 1,200 LF | 400 LF |      | 1.49              |

Areas of corrosion and failed paint are present on the main truss members below the lower deck. The structural steel between the upper and lower decks was repainted in 2014-2015 and is in very good condition. Blast material not contained during the 2014-2015 painting operation has accumulated on bracing and gusset connections. The top coat of the protective coating system above the upper deck has oxidized with minor rust staining.

**Item 31 – Pins, Hangers and Hinges (1, Good Condition)**

The pins, hangers and hinges are in **Good** condition with no significant deficiencies noted. Minor painted over pitting was noted on random eye-bars below the upper deck.

| Total Quantity | CS 1  | CS 2 | CS 3 | CS 4 | Transition Rating |
|----------------|-------|------|------|------|-------------------|
| 30 EA          | 28 EA | 2 EA |      |      | 1.10              |

**Item 32 – Fatigue Prone Details (1, Good Condition)**

The fatigue prone details are in **Good** condition.

| Total Quantity | CS 1      | CS 2 | CS 3 | CS 4 | Transition Rating |
|----------------|-----------|------|------|------|-------------------|
| 14,469 LF      | 14,469 LF |      |      |      | 1.00              |

Steel superstructure deficiencies and specific locations are in the following tables and attached drawings.

| Span 4, North Truss Deficiencies |             |                  |        |          |                                                                                                                                                         |       |
|----------------------------------|-------------|------------------|--------|----------|---------------------------------------------------------------------------------------------------------------------------------------------------------|-------|
| Drawing Note                     | Member Type | Upper/Lower Deck | Member | Location | Deficiency                                                                                                                                              | Photo |
|                                  | Lower Chord |                  | L0-L5  |          | L0-L5 uphill transverse angles have water and debris accumulation causing pitting and perforations of the diaphragm plates and transverse angles.       |       |
| 1                                | Vertical    |                  | L0-U0  | U0       | Stiffener plate between the north and south gusset plates at U0 has a 1" Diameter painted corrosion hole with surrounding 3/16" D painted over pitting. |       |



# PHYSICAL CONDITION REPORT

Bridge Number: CUY-6-1456

SFN: 1800930

Inspection Date: October 22-26, 2018

| Span 4, North Truss Deficiencies |              |                  |        |          |                                                                                                                                                                                                                                                                                                                                                                                                           |       |
|----------------------------------|--------------|------------------|--------|----------|-----------------------------------------------------------------------------------------------------------------------------------------------------------------------------------------------------------------------------------------------------------------------------------------------------------------------------------------------------------------------------------------------------------|-------|
| Drawing Note                     | Member Type  | Upper/Lower Deck | Member | Location | Deficiency                                                                                                                                                                                                                                                                                                                                                                                                | Photo |
| 1                                | Floorbeam    | UD               | FB0    |          | Painted over section loss to the north knee brace for the upper deck floorbeam.                                                                                                                                                                                                                                                                                                                           |       |
| 2                                | Floorbeam    | LD               | FB1    |          | Painted over 10% section loss to the top and bottom east flanges of the lower deck floorbeam.                                                                                                                                                                                                                                                                                                             |       |
| 3                                | Vertical     |                  | L0-U0  |          | Full height of vertical has peeling paint and flowering rivets due to leaking joint.                                                                                                                                                                                                                                                                                                                      |       |
| 4                                | Bearings     |                  |        | L0       | North decorative pin plate cover is not present.                                                                                                                                                                                                                                                                                                                                                          |       |
| 5                                | Diagonal     |                  | U0-L1  |          | Reactivating corrosion along lacing bars/channel webs due to leaking joint.                                                                                                                                                                                                                                                                                                                               |       |
| 6                                | Vertical     |                  | L1-U1  |          | Reactivated laminar corrosion along full height of vertical at lacing bar connections, lower deck and lower strut connections.                                                                                                                                                                                                                                                                            |       |
| 7                                | Lower Chord  |                  | L0-L1  | L1       | The strut at L1 bottom west angle leg has a 1" L x 4" H corrosion hole at the gusset plate connection to the truss.                                                                                                                                                                                                                                                                                       |       |
| 8                                | Gusset Plate |                  |        | L2       | North gusset plate exhibits 2' L x 3" H x up to 1/8" D reactivating pitting at the lower chord interface on the south face and 2' L x up to 3" H x up to 1/4" D pitting on the north face. The south gusset plate exhibits 30" L x up to 4" H x up to 3/8" D pitting on the south face with reactivating corrosion and 2' L x up to 3" H x up to 1/4" D pitting on the north face. Original plate 3/4" T. | 28    |
| 9                                | Diagonal     |                  | U1-L2  | L2       | The lower batten plate has a 12" H x Full Width area of 100% section loss.                                                                                                                                                                                                                                                                                                                                | 29    |
| 10                               | Floorbeam    | LD               | FB2    |          | 100% painted over corrosion hole to bottom batten plates at floorbeam connection to vertical.                                                                                                                                                                                                                                                                                                             |       |
| 10                               | Gusset Plate |                  | L2-L3  | L3       | South face of the south gusset plate has up to 1' H x 2" W x up to 3/16" D painted over pitting along the west edge of floorbeam connection angle. There is active laminar corrosion and pitting up to 3/16" D x 8" H along the lower chord interface of L2-L3. The north face of the                                                                                                                     | 30    |



Infrastructure Engineers, LLC.  
9902 Carver Rd.  
Suite 201  
Cincinnati, OH 45242

www.consoreng.com

# PHYSICAL CONDITION REPORT

Bridge Number: CUY-6-1456

SFN: 1800930

Inspection Date: October 22-26, 2018

| Span 4, North Truss Deficiencies |              |                  |          |          |                                                                                                                                                                                                             |       |
|----------------------------------|--------------|------------------|----------|----------|-------------------------------------------------------------------------------------------------------------------------------------------------------------------------------------------------------------|-------|
| Drawing Note                     | Member Type  | Upper/Lower Deck | Member   | Location | Deficiency                                                                                                                                                                                                  | Photo |
|                                  |              |                  |          |          | south gusset plate has a 6' L x up to 6" H area of active laminar corrosion.                                                                                                                                |       |
| 10                               | Floorbeam    | LD               |          | FB3      | End 3' L on both sides have up to 1/4" D painted over pitting on the webs and bottom flanges.                                                                                                               |       |
| 11                               | Sway Bracing |                  | L3-U3    |          | Upper lateral bracing connections to vertical have reactivating corrosion and pack rust.                                                                                                                    |       |
| 12                               | Eyebar       | LD               |          | LD4      | Bottom head of east eye bar has up to 3/16" D painted over pitting around the pin. Stiffening plates on floorbeam web exhibit up to 100% painted over corrosion holes, but the floorbeam web appears sound. |       |
| 13                               | Diagonal     |                  | U5-L6    | L6       | The south gusset plate at L6 has four bolts welded to the south face.                                                                                                                                       |       |
| 13                               | Lower Chord  |                  | L5-L6    | L6       | The south top flange of the lower chord at L6 has reactivating corrosion.                                                                                                                                   |       |
| 14                               | Upper chord  |                  | U8-U9    | U8       | Missing rivet in the top hip plate at U8.                                                                                                                                                                   |       |
| 15                               | Floorbeam    | UD               |          | FB10     | There is a 4" W x 1-1/8" H hole in the floorbeam web north of the first interior stringer from the panel point.                                                                                             |       |
| 16                               | Floorbeam    | LD               |          | FB10     | 3-3/4" L crack along the weld of stiffening plate welded to floorbeam top flange, east face of floorbeam.                                                                                                   |       |
| 17                               | Upper Chord  |                  | U12-U11' | U12      | Up to 5/8" T pack rust between hinge cover plate and truss top flange resulted in a 1/8" Diameter corrosion hole in the cover plate.                                                                        |       |
| 18                               | Lower chord  |                  | L11-L12  | L12      | The north pin plate has a 1-5/8" gap between it and the north face of L11L12 lower chord. The south pin plate has a 1-7/8" gap between it and the south face of L11L12 lower chord.                         |       |
| 19                               | Floorbeam    | UD               |          | FB12     | There is a 7-1/4" W x 4" H corrosion hole in the floorbeam web north of the first interior stringer from the panel point.                                                                                   |       |
| 20                               | Stringer     | LD               |          | FB12     | The north connection angle for the second stringer from the south, on the                                                                                                                                   |       |



Infrastructure Engineers, LLC.  
9902 Carver Rd.  
Suite 201  
Cincinnati, OH 45242

[www.consoreng.com](http://www.consoreng.com)

# PHYSICAL CONDITION REPORT

Bridge Number: CUY-6-1456

SFN: 1800930

Inspection Date: October 22-26, 2018

| Span 4, North Truss Deficiencies |             |                  |          |          |                                                                                                                                                                                                            |       |
|----------------------------------|-------------|------------------|----------|----------|------------------------------------------------------------------------------------------------------------------------------------------------------------------------------------------------------------|-------|
| Drawing Note                     | Member Type | Upper/Lower Deck | Member   | Location | Deficiency                                                                                                                                                                                                 | Photo |
|                                  |             |                  |          |          | west side of FB12 has a 4-1/2" H x 3-1/2" W area of 3/8" D pitting.                                                                                                                                        |       |
| 21                               | Lower chord |                  | L12-L11' | L11'     | The west pin nut appears to be new with surface corrosion and no paint.                                                                                                                                    |       |
| 22                               | Floorbeam   | UD               |          | FB11'    | There is a 3-1/2" W x 2-1/2" H hole in the floorbeam web north of the first interior stringer from the panel point.                                                                                        |       |
| 23                               | Floorbeam   | LD               |          | FB11'    | 2-7/8" crack along weld of stiffening plate welded to floorbeam top flange, east face of floorbeam.                                                                                                        |       |
| 24                               | Floorbeam   | UD               |          | FB10'    | There is a 7" W x 2-1/4" H and a 4-1/4" Diameter corrosion hole in the floorbeam web north of the first interior stringer from the panel point.                                                            | 31    |
| 25                               | Floorbeam   | LD               |          | LD10'    | 3-5/16" L crack along weld of stiffening plate welded to floorbeam top flange, west face of floorbeam.                                                                                                     |       |
| 26                               | Floorbeam   | UD               |          | FB8'     | There is a 5-1/2" W x 11-1/2" H corrosion hole in the floorbeam web north of the first interior stringer from the panel point.                                                                             | 32    |
| 27                               | Vertical    |                  | L7'-U7'  | L7'      | Moderate painted over pitting on both faces of vertical L7'-U7' and along the top flange of the floorbeam. Reinforcement plates have been added, but also exhibit painted over losses.                     |       |
| 27                               | Floorbeam   | LD               |          | FB7'     | 2' H X 2' W area of average 1/4" D painted pitting with two corrosion holes in the web of the floorbeam between the strut and stringer, west face.                                                         |       |
| 28                               | Diagonal    |                  | L6'-U5'  | L6'      | The south gusset plate at L6' has four bolts welded to the south face.                                                                                                                                     |       |
| 29                               | Floorbeam   | UD               |          | FB6'     | Up to 1/8" D pitting on the eyebar face around the lower portion of the pin. There is a 6-1/2" L x 1-1/2" H corrosion hole in the floorbeam web north of the first interior stringer from the panel point. |       |
| 30                               | Floorbeam   | LD               |          | FB6'     | Cracked perimeter along weld of stiffening plate welded to floorbeam top flange, west face of floorbeam.                                                                                                   |       |
|                                  | Lower Chord |                  | L5'-L0'  |          | L5'-L0' uphill transverse angles have water and debris accumulation causing                                                                                                                                |       |



Infrastructure Engineers, LLC.  
9902 Carver Rd.  
Suite 201  
Cincinnati, OH 45242

www.consoreng.com

# PHYSICAL CONDITION REPORT

**Bridge Number:** CUY-6-1456

**SFN:** 1800930

**Inspection Date:** October 22-26, 2018

| Span 4, North Truss Deficiencies |              |                  |         |          |                                                                                                                                                                                                                                                                                                                                                                                                                                         |       |
|----------------------------------|--------------|------------------|---------|----------|-----------------------------------------------------------------------------------------------------------------------------------------------------------------------------------------------------------------------------------------------------------------------------------------------------------------------------------------------------------------------------------------------------------------------------------------|-------|
| Drawing Note                     | Member Type  | Upper/Lower Deck | Member  | Location | Deficiency                                                                                                                                                                                                                                                                                                                                                                                                                              | Photo |
|                                  |              |                  |         |          | pitting and corrosion holes of the diaphragm plates and transverse angles.                                                                                                                                                                                                                                                                                                                                                              |       |
| 31                               | Gusset Plate | UD               |         | UD5'     | The vertical gusset plates at the lower chord to lower vertical connection has four plug welds on each plate.                                                                                                                                                                                                                                                                                                                           |       |
| 32                               | Diagonal     |                  | L5'-U4' | L5'      | The baton plate on the underside of L5'U4' at L5' has a 1" Diameter painted over corrosion hole.                                                                                                                                                                                                                                                                                                                                        |       |
| 33                               | Lower Chord  |                  | L5'-L4' | L4'      | Areas of reactivated surface corrosion on the truss lower chord components.                                                                                                                                                                                                                                                                                                                                                             |       |
| 33                               | Floorbeam    | UD               |         | FB4'     | Corrosion holes in the web below the upper deck lateral bracing gusset plate.                                                                                                                                                                                                                                                                                                                                                           |       |
| 33                               | Diagonal     |                  | L4'-U3' | L4'      | Typical areas of painted over pitting and isolated corrosion holes throughout the lower 2' of the diagonal and lower baton plates.                                                                                                                                                                                                                                                                                                      |       |
| 34                               | Vertical     |                  | L4'-U4' | LD4'     | Typical areas of painted over pitting within the vertical web plates at the eyebar connection.                                                                                                                                                                                                                                                                                                                                          |       |
| 35                               | Floorbeam    | LD               |         | FB4'     | There are numerous painted over corrosion holes within the bottom flange of the floorbeam adjacent the sway bracing connection. Areas of reactivated surface corrosion were noted throughout the top and bottom flanges. The sway bracing on the east side also exhibits reactivated surface corrosion in the end 6'.                                                                                                                   |       |
| 36                               | Stringer     | LD               |         | LD3'     | The stringer to floorbeam bearing on the west side of the floorbeam exhibits painted over pack rust, missing anchor bolt and corrosion holes. Typical on both stringers on each side of the vertical connection. This note is typical at the south truss. The north stringer to the south truss vibrates under live load due to 100% section loss of the bottom flange. There is no connection of the stringer to the bearing assembly. |       |
| 36                               | Sway Bracing | LD               |         | LD3'     | The majority of the original steel components at the lower deck                                                                                                                                                                                                                                                                                                                                                                         |       |



Infrastructure Engineers, LLC.  
9902 Carver Rd.  
Suite 201  
Cincinnati, OH 45242

[www.consoreng.com](http://www.consoreng.com)

# PHYSICAL CONDITION REPORT

Bridge Number: CUY-6-1456

SFN: 1800930

Inspection Date: October 22-26, 2018

| Span 4, North Truss Deficiencies |             |                      |         |          |                                                                                                                                                                                                                                                                                                         |       |
|----------------------------------|-------------|----------------------|---------|----------|---------------------------------------------------------------------------------------------------------------------------------------------------------------------------------------------------------------------------------------------------------------------------------------------------------|-------|
| Drawing Note                     | Member Type | Upper/<br>Lower Deck | Member  | Location | Deficiency                                                                                                                                                                                                                                                                                              | Photo |
|                                  |             |                      |         |          | connection above L3' exhibit areas of painted over pitting with corrosion holes and knife edging.                                                                                                                                                                                                       |       |
| 36                               | Diagonal    |                      | U4'-L3' | L3'      | Typical areas of painted over pitting and isolated corrosion holes along lower 2' of the diagonal and lower baton plates.                                                                                                                                                                               |       |
| 36                               | Floorbeam   | LD                   |         | FB3'     | The floorbeam cantilever exhibits an area of painted over pitting and a 1/2" Diameter hole adjacent the vertical connection.                                                                                                                                                                            |       |
| 37                               | Lower Chord |                      | L3'-L2' |          | The diaphragm plate in the middle of the lower chord has a 6" diameter corrosion hole and moderate surface corrosion full height.                                                                                                                                                                       | 33    |
| 38                               | Vertical    |                      | L2'-U2' | U2'      | Northeast flange at U2'; missing two rivets.                                                                                                                                                                                                                                                            |       |
| 39                               | Diagonal    |                      | L2'-U1' | L2'      | Two lacing bars are missing and/or broken due to section loss.                                                                                                                                                                                                                                          |       |
| 40                               | Diagonal    |                      | L1'-U0' |          | One lacing bar has 100% section loss with two others having 1-2" Diameter corrosion holes at the flange connections. Lower batten plates for the diagonal exhibits up to 100% section loss along the lower 12'. Baton plate below the deck upper strut exhibits two 12" L x up to 3" W corrosion holes. |       |
| 41                               | Floorbeam   | LD                   |         | FB0'     | The lower deck floorbeam also exhibits typical painted over pitting up to 1/8" D with 100% section loss to the west bottom flange of the cantilevered portion.                                                                                                                                          |       |
| 42                               | Bearings    |                      | L0'     |          | Cracks up to 7" L on the non-structural bearing pin cover plates at L0' on both trusses.                                                                                                                                                                                                                |       |



# PHYSICAL CONDITION REPORT

Bridge Number: CUY-6-1456

SFN: 1800930

Inspection Date: October 22-26, 2018

| Span 4, South Truss Deficiencies |              |                  |        |          |                                                                                                                                                                                                                                                                                                 |       |
|----------------------------------|--------------|------------------|--------|----------|-------------------------------------------------------------------------------------------------------------------------------------------------------------------------------------------------------------------------------------------------------------------------------------------------|-------|
| Drawing Note                     | Member Type  | Upper/Lower Deck | Member | Location | Deficiency                                                                                                                                                                                                                                                                                      | Photo |
|                                  | Lower Chord  |                  | L0-L5  |          | L0-L5 uphill transverse angles have water and debris accumulation causing pitting and perforations of the diaphragm plates and transverse angles.                                                                                                                                               |       |
| 1                                | Floorbeam    | UD               |        | U0       | Exterior and interior west knee brace has an 18" L x up to 4" W area of painted over corrosion holes. The west web plates also have up to 18" H x 12" W L-shaped painted over corrosion holes in the upper corners.                                                                             |       |
| 1                                | Vertical     | UD               | L0-U0  | U0       | Top two lacing bars have up to 100% painted over section loss and are completely severed.                                                                                                                                                                                                       |       |
| 1                                | Diagonal     | UD               | U0-L1  | U0       | Full length flaking paint with laminar corrosion throughout. The top face top batten plate has a 14" L x 3" W corrosion hole.                                                                                                                                                                   |       |
| 2                                | Floorbeam    | LD               | FB0    |          | End 3' of the web has painted over corrosion holes.                                                                                                                                                                                                                                             |       |
| 3                                | Bearings     |                  |        | L0       | L0 inboard pin plate has a 5-3/4" L crack with a 4-3/4" L crack that propagates off of the other crack that extends to the end of the plate. The outboard pin plate has a vertical 7" L crack extending upward from the nut and a 1-1/2" L vertical crack that extending downward from the nut. | 34    |
| 4                                | Lower Chord  |                  | L0-L1  |          | The second top transverse lacing channel from L0 has a 5" H x 3/4" W and a 1/2" Diameter corrosion hole. The fourth lacing channel from L0 has a 6" L x 2" W corrosion hole.                                                                                                                    |       |
| 4                                | Lower Chord  |                  | L0-L1  |          | Sheared bolt on top lacing channel connection along the top flange. There is also a fractured bolt in the end of the batten plate.                                                                                                                                                              | 35    |
| 5                                | Gusset Plate | LD               | L1-U1  | L1       | Gusset plate - exterior and interior gusset plates below the horizontal member have painted over pitting with corrosion holes.                                                                                                                                                                  |       |
| 6                                | Lower Chord  |                  | L0-L1  | L1       | Four corrosion holes in diaphragm for L0-L1 south truss near L1.                                                                                                                                                                                                                                |       |
| 6                                | Gusset       |                  | L1-L3  | L1, L2,  | Gusset plate - East face fill plate between                                                                                                                                                                                                                                                     |       |



Infrastructure Engineers, LLC.  
9902 Carver Rd.  
Suite 201  
Cincinnati, OH 45242

www.consoreng.com

# PHYSICAL CONDITION REPORT

Bridge Number: CUY-6-1456

SFN: 1800930

Inspection Date: October 22-26, 2018

| Span 4, South Truss Deficiencies |              |                  |         |          |                                                                                                                                                                                                                                                                                                                                                                                                                                                 |       |
|----------------------------------|--------------|------------------|---------|----------|-------------------------------------------------------------------------------------------------------------------------------------------------------------------------------------------------------------------------------------------------------------------------------------------------------------------------------------------------------------------------------------------------------------------------------------------------|-------|
| Drawing Note                     | Member Type  | Upper/Lower Deck | Member  | Location | Deficiency                                                                                                                                                                                                                                                                                                                                                                                                                                      | Photo |
|                                  | Plate        |                  |         | L3       | gusset plates has corrosion holes, some of which are painted over.                                                                                                                                                                                                                                                                                                                                                                              |       |
|                                  | Lower Chord  |                  | L0-L5   |          | Uphill transverse angles have water and debris causing pitting and perforations of the diaphragm plates and transverse angles.                                                                                                                                                                                                                                                                                                                  |       |
| 7                                | Lower Chord  |                  | L1-L2   |          | Bottom face channel lacing have 100% section loss to the vertical legs adjacent to the lower chord web plates.                                                                                                                                                                                                                                                                                                                                  |       |
| 8                                | Gusset Plate |                  |         | L2       | Gusset Plate - L2 north gusset plate above L2-L3 exhibits 2' L x 2" H x up to 1/8" D pitting on the south face and 1' L x up to 2" H x up to 1/8" D pitting on the north face with reactivating laminar corrosion. L2 south gusset plate above L2-L3 exhibits 30" L x up to 3" H x up to 1/4" D pitting on the south face with reactivating corrosion and 2' L x up to 2" H x up to 1/8" D pitting on the north face. Original plate is 3/4" T. |       |
| 8                                | Floorbeam    |                  |         | L2       | The south diagonal floorbeam support has a 7" H x 7" W area of holes in the web near the L2 connection.                                                                                                                                                                                                                                                                                                                                         |       |
| 9                                | Stringer     | LD               |         | FB3      | Second stringer from the south, east face of LDFB3 has a 12" L x 3" H area of painted over pitting with a 6" L x 3" H corrosion hole in the bottom of the web. The north bottom flange has a 10" L x 4" W corrosion hole at the end.                                                                                                                                                                                                            |       |
| 9                                | Floorbeam    | LD               |         | FB3      | The east face bottom flange at the L3 connection has a 10" L x 4" W hole.                                                                                                                                                                                                                                                                                                                                                                       |       |
| 10                               | Eyebar       | LD               |         | LD4      | UD4-LD4 east eyebar has up to 1/4" D painted over pitting along the south half of the pin nut for 2" W.                                                                                                                                                                                                                                                                                                                                         |       |
| 11                               | Vertical     | LD               | LD9-UD9 | LD9      | LD9 has painted over corrosion holes above the floorbeam top flange.                                                                                                                                                                                                                                                                                                                                                                            |       |
| 12                               | Lower Chord  |                  | L9-U9   | L9       | The south and north fill plate at L9 has a full height x 10" L area of 100% painted over section loss.                                                                                                                                                                                                                                                                                                                                          |       |
| 13                               | Stringer     | LD               |         | LD10     | Second stringer from the south, west and east face of FB10 has a 12" L x 2" W                                                                                                                                                                                                                                                                                                                                                                   |       |



Infrastructure Engineers, LLC.  
9902 Carver Rd.  
Suite 201  
Cincinnati, OH 45242

[www.consoreng.com](http://www.consoreng.com)



# PHYSICAL CONDITION REPORT

Bridge Number: CUY-6-1456

SFN: 1800930

Inspection Date: October 22-26, 2018

| Span 4, South Truss Deficiencies |             |                  |           |          |                                                                                                                                                                                                                                                                                         |       |
|----------------------------------|-------------|------------------|-----------|----------|-----------------------------------------------------------------------------------------------------------------------------------------------------------------------------------------------------------------------------------------------------------------------------------------|-------|
| Drawing Note                     | Member Type | Upper/Lower Deck | Member    | Location | Deficiency                                                                                                                                                                                                                                                                              | Photo |
|                                  |             |                  |           |          | Painted over hole at the end of both south and north top flanges.                                                                                                                                                                                                                       |       |
| 14                               | Stringer    | LD               |           | LD11     | Second stringer from the south, west face of FB11 has a 12" L x 3" W painted over corrosion hole at the end of both south and north top flanges.                                                                                                                                        |       |
| 15                               | Upper Chord |                  | U11-U12   | U12      | The top plate at U12 has up to 3/4" T pack rust between it and the upper chord. The plate on the south face of the upper chord at U12 is bent outward up to 3-7/8" with the bottom angle having 50% section loss. The inside of the south web at U12 has 12" L x 4" H x 1/8" D pitting. |       |
| 16                               | Lower Chord |                  | L11-L12   | L12      | The south pin plate at L12 is bent outward 2" due to pack rust. The north pin plate at L12 is bent 3/4" outward due to pack rust.                                                                                                                                                       |       |
| 17                               | Vertical    | LD               | LD12-UD12 | LD12     | LD12 has painted over corrosion holes above the floorbeam top flange.                                                                                                                                                                                                                   |       |
| 17                               | Stringer    | LD               |           | LD12     | Second stringer from the south, west and east face of FB12 has a 12" L x 1" W painted over corrosion hole at the end of both south and north top flanges.                                                                                                                               |       |
| 18                               | Stringer    | LD               |           | LD11'    | Third stringer from the south, east face of FB11'; 12" L x 2" W painted over corrosion hole at the end of the south and north top flanges.                                                                                                                                              |       |
| 18                               | Stringer    | LD               |           | LS11'    | Second stringer from the south, west face of FB11' has a 12" L x 3" W painted over corrosion hole at the end of both south and north top flanges.                                                                                                                                       |       |
| 18                               | Stringer    | LD               |           | LD11'    | The south stringer, east face of FB11' has a 12" L x 2" H area of pitting with a 2" Diameter corrosion hole.                                                                                                                                                                            |       |
| 19                               | Stringer    | LD               |           | LD10'    | Second stringer from the south at FB10' has a 12" L x 2" W painted over corrosion hole at the end of both south and north top flanges.                                                                                                                                                  |       |
| 20                               | Stringer    | LD               |           | FB8'     | Second stringer from the south, west face of FB8' has a 6" L x 3" W painted over corrosion hole on the south top flange.                                                                                                                                                                |       |



Infrastructure Engineers, LLC.  
9902 Carver Rd.  
Suite 201  
Cincinnati, OH 45242

[www.consoreng.com](http://www.consoreng.com)

# PHYSICAL CONDITION REPORT

Bridge Number: CUY-6-1456

SFN: 1800930

Inspection Date: October 22-26, 2018

| Span 4, South Truss Deficiencies |             |                  |         |          |                                                                                                                                                                                                                                                                                                                                                                                                                                                   |       |
|----------------------------------|-------------|------------------|---------|----------|---------------------------------------------------------------------------------------------------------------------------------------------------------------------------------------------------------------------------------------------------------------------------------------------------------------------------------------------------------------------------------------------------------------------------------------------------|-------|
| Drawing Note                     | Member Type | Upper/Lower Deck | Member  | Location | Deficiency                                                                                                                                                                                                                                                                                                                                                                                                                                        | Photo |
|                                  |             |                  |         |          | The east face of FB8' has a 3" L x 1" W painted over corrosion hole on the north top flange.                                                                                                                                                                                                                                                                                                                                                      |       |
| 20                               | Stringer    | LD               |         | FB8'     | 2' from east face of FB8' south top flange has a 2" L x 1" W painted over corrosion hole                                                                                                                                                                                                                                                                                                                                                          |       |
| 21                               | Upper Chord |                  | U9'-U8' | U8'      | There is a missing rivet at U8' on the north lower angle.                                                                                                                                                                                                                                                                                                                                                                                         |       |
| 22                               | Stringer    | LD               |         | FB7'     | Second stringer from the south, west and east face of FB7' has a 10" L x 1" W painted over corrosion hole on both north and south top flanges. Third stringer from the south, east face of FB7' has a 12" L x 1" W painted over corrosion hole on the north and south top flange.                                                                                                                                                                 |       |
| 23                               | Upper Chord |                  | U6'-U5' | U5'      | The bracing gusset plate at U5' is bent upward and has a 1" L tear.                                                                                                                                                                                                                                                                                                                                                                               |       |
|                                  | Lower Chord |                  | L5'-L0' |          | L5'-L0' uphill transverse angles have water and debris accumulation causing pitting and perforations of the diaphragm plates and transverse angles.                                                                                                                                                                                                                                                                                               |       |
| 24                               | Eyebar      | UD               |         | UD5'     | The eyebar heads exhibit painted over pitting around the full perimeter of the pin nut.                                                                                                                                                                                                                                                                                                                                                           |       |
| 25                               | Stringer    | LD               |         | LD3'     | The stringer to floorbeam bearing on the west side of the floorbeam exhibits painted over pack rust, missing anchor bolt and corrosion holes. Typical condition to both stringers on each side of the vertical connection. This note is typical at the south truss. The north stringer to the south truss vibrates under live load due to 100% section loss of the bottom flange. There is no connection of the stringer to the bearing assembly. |       |
| 25                               | Bracing     | LD               |         | LD3'     | Typical corrosion holes along the bottom 6" portions of vertical bracing connections to floorbeam flanges at the vertical connection                                                                                                                                                                                                                                                                                                              |       |
| 25                               | Bracing     | LD               |         | LD3'     | The lower deck bracing connection to the arch strut at LD3' has up to 4" of pack                                                                                                                                                                                                                                                                                                                                                                  |       |



Infrastructure Engineers, LLC.  
9902 Carver Rd.  
Suite 201  
Cincinnati, OH 45242

[www.consoreng.com](http://www.consoreng.com)

# PHYSICAL CONDITION REPORT

**Bridge Number:** CUY-6-1456

**SFN:** 1800930

**Inspection Date:** October 22-26, 2018

| Span 4, South Truss Deficiencies |              |                  |         |          |                                                                                                                                                                                                                                                                                                                            |       |
|----------------------------------|--------------|------------------|---------|----------|----------------------------------------------------------------------------------------------------------------------------------------------------------------------------------------------------------------------------------------------------------------------------------------------------------------------------|-------|
| Drawing Note                     | Member Type  | Upper/Lower Deck | Member  | Location | Deficiency                                                                                                                                                                                                                                                                                                                 | Photo |
|                                  |              |                  |         |          | rust to the upper connection.                                                                                                                                                                                                                                                                                              |       |
| 25                               | Sway Bracing | LD               |         | LD3'     | The majority of the original steel components at the lower deck connection above L3' exhibit areas of painted over pitting with corrosion holes and knife edging.                                                                                                                                                          |       |
| 26                               | Diagonal     |                  | L3'-U2' |          | Moderate surface corrosion at the upper deck opening.                                                                                                                                                                                                                                                                      |       |
| 27                               | Lower Chord  |                  | L3'-L2' |          | 3" Diameter hole in the channel lacing bar of the lower chord.                                                                                                                                                                                                                                                             |       |
| 28                               | Vertical     |                  | L2'-U2' | L2'      | Moderate surface corrosion to components below the lower deck with minor pack rust typical between lacing bars. There are a number of replaced lacing bars at the Lower deck connection to the vertical. Areas throughout the lower floorbeam connection have painted over pitting and missing batten plates and/or holes. |       |
| 28                               | Diagonal     |                  | L2'-U1' | L2'      | The lower batten plate for the diagonal exhibits up to 100% section loss along the lower 12". The upper batten plate is almost 100% gone and there are four lacing bars with holes up to 2" Diameter.                                                                                                                      |       |
| 29                               | Vertical     |                  | L2'-U2' |          | Moderate pack rust and surface corrosion on the lacing bars with up to 20% section loss on the lacing bars. Isolated areas of up to 1/4" T pack rust typical at the bracing gusset connections to the vertical.                                                                                                            |       |
| 30                               | Lower Chord  |                  | L2'-L1' |          | Typical minor surface corrosion with isolated corrosion holes noted throughout the lower chord diaphragm plates                                                                                                                                                                                                            |       |
| 31                               | Diagonal     |                  | L1'-U0' | L1'      | Lower batten plate for the diagonal exhibits up to 100% section loss along the lower 12'. The lower two lacing bars exhibit up to 75% section loss at the connections to the flanges and one has a 2" Diameter hole.                                                                                                       |       |
| 32                               | Lower Chord  |                  | L1'-L0' |          | Typical minor surface corrosion with isolated corrosion holes noted throughout                                                                                                                                                                                                                                             |       |



Infrastructure Engineers, LLC.  
9902 Carver Rd.  
Suite 201  
Cincinnati, OH 45242

[www.consoreng.com](http://www.consoreng.com)

# PHYSICAL CONDITION REPORT

**Bridge Number:** CUY-6-1456

**SFN:** 1800930

**Inspection Date:** October 22-26, 2018

## Span 4, South Truss Deficiencies

| Drawing Note | Member Type | Upper/<br>Lower Deck | Member  | Location | Deficiency                                                                               | Photo |
|--------------|-------------|----------------------|---------|----------|------------------------------------------------------------------------------------------|-------|
|              |             |                      |         |          | the lower chord diaphragm plates                                                         |       |
| 33           | Vertical    |                      | L0'-U0' |          | Moderate surface corrosion with minor pack rust typical between lacing bars.             |       |
| 34           | Bearings    |                      | L0'     |          | Cracks up to 7" L on the non-structural bearing pin cover plates at L0' on both trusses. |       |



# PHYSICAL CONDITION REPORT

Bridge Number: CUY-6-1456  
SFN: 1800930  
Inspection Date: October 22-26, 2018

## Item N60 – Substructure (6, Satisfactory Condition)

The substructure is in overall **Satisfactory** condition, or 6 on the NBIS condition rating guidelines.

The substructure findings and summary of conditions for individual items are as follows:

### Item 33 – Abutment Walls (2, Fair Condition)

The abutment walls are in **Satisfactory** condition. The abutment walls consist of the West and East Abutments and the walls of the Detroit Avenue and West 25<sup>th</sup> Street Tunnels (Photos 36 through 39).

| Total Quantity | CS 1    | CS 2    | CS 3   | CS 4 | Transition Rating |
|----------------|---------|---------|--------|------|-------------------|
| 3459 LF        | 1689 LF | 1600 LF | 170 LF |      | 1.97              |

The abutments exhibit map cracking throughout with minor moisture staining. Some staining appears to be superficial due to leaking deck joints above.

At the east end, the tunnel continues to the east and is flooded with water. The pedestrian stairwell along the south wall is visible, but holds water up to the second step from the top.

The West Abutment walls typically exhibit deep spalling and delaminations throughout with a 1/4" W vertical crack below the south exterior arch.

### Item 36 – Pier Walls (2, Fair Condition)

The pier walls at Piers 1, 3 and 4 are in **Fair** condition.

| Total Quantity | CS 1   | CS 2  | CS 3  | CS 4 | Transition Rating |
|----------------|--------|-------|-------|------|-------------------|
| 200 LF         | 100 LF | 50 LF | 50 LF |      | 2.56              |

The west face of Pier 1 is primarily covered by fill. The exposed portions of the pier walls exhibit map cracking with minor corrosion staining as well as graffiti.

The east face of Pier 3 is covered with painted murals which hides surface flaws. The areas around the murals exhibit map cracking with corrosion staining. The west face of Pier 3 also exhibits map cracking and corrosion staining throughout.

The west face of Pier 4 is on the edge of the Cuyahoga River with sloped fill along the north end. The bottom quarter of the pier exhibits map cracking. Near the water surface, the edge of the sealant was visible. An underwater inspection was not performed during this inspection. The west face of the pier wall is against higher fill while the exposed portion exhibits minor map cracking.



# PHYSICAL CONDITION REPORT

**Bridge Number:** CUY-6-1456  
**SFN:** 1800930  
**Inspection Date:** October 22-26, 2018

## Item 38 – Pier Columns/Bents (2, Fair Condition)

The pier columns are in **Fair** condition.

| Total Quantity | CS 1  | CS 2 | CS 3  | CS 4 | Transition Rating |
|----------------|-------|------|-------|------|-------------------|
| 40 EA          | 25 EA | 5 EA | 10 EA |      | 2.53              |

The reinforced concrete pier columns exhibit map cracking with moisture staining throughout. Below leaking joints or faulty downspouts, superficial staining is common on the surfaces as well. See “Open Spandrel Arch and Truss Spans CADD Drawings and Deficiencies” section showing all substructure deficiencies (Photos 38 and 40 through 45).

Deep spalling, up to 10” D with exposed reinforcement was noted throughout. Some of these instances exist over areas that are accessible to the public. The west station columns and arches have heavy deterioration with exposed reinforcing and efflorescence.

The South wall at Tower B, 5, 6, and 7 are all rotated to the south. Towers 5, 6, and 7 were measured from the inside face of the south exterior tower wall to the vertical concrete edge of the adjacent span on both the east and west side of the towers. Tower B was measured from the inside face of the south exterior tower wall to the south face of the tower core wall. The “Tower Wall Rotation Measurements” table below shows the measurements for each tower.

| Tower Wall Rotation Measurements |                  |                  |       |
|----------------------------------|------------------|------------------|-------|
| Tower                            | East Measurement | West Measurement | Photo |
| B                                | 6”               | 5-2/16”          |       |
| 5                                | 14-11/16”        | 15-2/16”         | 44    |
| 6                                | 16”              | 16”              |       |
| 7                                | 15”              | 14-13/16”        |       |

## Item 39 – Backwalls (1, Good Condition)

The backwalls are in **Good** condition.

| Total Quantity | CS 1   | CS 2 | CS 3 | CS 4 | Transition Rating |
|----------------|--------|------|------|------|-------------------|
| 263 LF         | 263 LF |      |      |      | 1.00              |

The abutment backwalls do not exist at the West and East Abutments due to the continuation of the tunnels. At the east tunnel, the backwall acts as a closure panel.



# PHYSICAL CONDITION REPORT

**Bridge Number:** CUY-6-1456  
**SFN:** 1800930  
**Inspection Date:** October 22-26, 2018

**Item 40 – Wingwalls (3 Poor Condition)**

The wingwalls are in **Poor** condition.

| Total Quantity | CS 1 | CS 2 | CS 3  | CS 4 | Transition Rating |
|----------------|------|------|-------|------|-------------------|
| 12 EA          |      |      | 12 EA |      | 3.00              |

The wingwalls along Spans 1A and 1B and the East Station exhibit cracking and spalling with exposed reinforcement throughout.

The south wall at Tower B continues to exhibit movement spanning over the past 10 years. The tower currently resides with an outward measurement of 4-3/4" at the lower deck level. On the interior, the top of the tower is spalled and cracked due to contact with the soffit of the upper level sidewalk.

**Item 42 – Scour (1, Good Condition)**

The scour is in **Good** condition. Sea walls are present along both river banks, providing protection for Pier 8 and 9. No underwater inspection is required for this structure.

| Total Quantity | CS 1 | CS 2 | CS 3 | CS 4 | Transition Rating |
|----------------|------|------|------|------|-------------------|
| 2 EA           | 2 EA |      |      |      | 1.00              |

**Item 43 – Slope Protection (1, Good Condition)**

The concrete slope protection is in **Good** condition.

| Total Quantity | CS 1 | CS 2 | CS 3 | CS 4 | Transition Rating |
|----------------|------|------|------|------|-------------------|
| 2 EA           | 2 EA |      |      |      | 1.00              |

Substructure deficiencies and specific locations are noted in the following table:

| Substructure Deficiencies |                |               |                                                                                                                                                 |       |
|---------------------------|----------------|---------------|-------------------------------------------------------------------------------------------------------------------------------------------------|-------|
| Main Unit                 | Secondary Unit | Item          | Deficiency                                                                                                                                      | Photo |
| Substructure              | Piers          | All piers     | The up-lighting brackets attached to the north and south faces of the piers are corroding.                                                      | 41    |
| Substructure              | Abutment Walls | Tunnel Walls  | Spalls with exposed reinforcing.                                                                                                                |       |
| Substructure              | West Abutment  | West Abutment | West Abutment below the southeast arch; there is a 1/4" W vertical crack. The southeast corner of the abutment is delaminated and breaking off. | 39    |



# PHYSICAL CONDITION REPORT

**Bridge Number:** CUY-6-1456

**SFN:** 1800930

**Inspection Date:** October 22-26, 2018

| Substructure Deficiencies |                    |                 |                                                                                                                                              |       |
|---------------------------|--------------------|-----------------|----------------------------------------------------------------------------------------------------------------------------------------------|-------|
| Main Unit                 | Secondary Unit     | Item            | Deficiency                                                                                                                                   | Photo |
| Substructure              | Pier Columns/Bents | West Station    | Numerous columns and arches far into the west stationing tunnel are in need of repair, most of the heavily deteriorated sections are marked. | 38    |
| Safety                    | Fencing            | Safety          | Fence that keeps area enclosed below Spans 1A, 1B, and 1 has an open gate allowing access at Pier 1.                                         |       |
| Approaches                | Embankment         | 3               | Sloped banks below Span 3.                                                                                                                   |       |
| Substructure              | Navigation Lights  | 4               | Navigation lights are nonfunctional.                                                                                                         |       |
| Substructure              | Per Column         | Pier 5          | North exterior column, southwest corner; 10' H x 6" D corner spall with exposed rebar.                                                       | 43    |
| Substructure              | Pier Column        | Pier 5          | South exterior column, east face; 6' H x 4' W x 8" D spall with exposed rebar under bottom deck overhang.                                    |       |
| Substructure              | Pier Column        | Pier 6          | South exterior column, south face; widespread spalling and delaminations throughout middle 1/3.                                              |       |
| Substructure              | Pier Columns/Bents | Pier 6          | South exterior lower deck shaft - deep scaling over the surface, fractured concrete at the interface with the lower deck corbels.            |       |
| Substructure              | Pier Column        | Pier 8          | South exterior column, east face; 6' H x 3' W delamination above parked cars.                                                                |       |
| Substructure              | Pier Column        | Pier 8          | South exterior column, west face; 4' x 4' x 10" D under bottom deck overhang.                                                                | 45    |
| Substructure              | Pier Column        | Pier 10         | South exterior column, west Face; 4' H x 2' W x 4" D spall with exposed rebar under bottom deck overhang.                                    |       |
| Substructure              | South Tower        | Tower B         | Interior section at Tower B, south, is fractured at the interface with the upper deck.                                                       | 42    |
| Approaches                | Embankment         | Tower A/Span 1A | Heavy erosion up to 2' H around manhole basin with missing manhole cover at south side of Tower A and along south side of Span 1A.           |       |





# PHYSICAL CONDITION REPORT

Bridge Number: CUY-6-1456  
SFN: 1800930  
Inspection Date: October 22-26, 2018

## Channel (7, Good Condition)

The channel is in **Good** condition, or a 7 on the NBIS condition rating guidelines.

The channel findings and summary of conditions for individual items are as follows:

### Item 51 – Alignment (1, Good Condition)

The alignment is in **Good** condition.

| Total Quantity | CS 1   | CS 2 | CS 3 | CS 4 | Transition Rating |
|----------------|--------|------|------|------|-------------------|
| 200 LF         | 200 LF |      |      |      | 1.00              |

### Item 52 – Protection (2, Fair Condition)

The channel protection is in **Fair** condition.

| Total Quantity | CS 1 | CS 2   | CS 3 | CS 4 | Transition Rating |
|----------------|------|--------|------|------|-------------------|
| 200 LF         |      | 200 LF |      |      | 2.00              |

### Item 53 – Hydraulic Opening (1, Good Condition)

The hydraulic opening is in **Good** condition.

| Total Quantity | CS 1 | CS 2 | CS 3 | CS 4 | Transition Rating |
|----------------|------|------|------|------|-------------------|
| 1 EA           | 1 EA |      |      |      | 1.00              |

### Item 54 – Navigation Lights (2, Fair Condition)

The six (5) navigation lights are in **Fair** condition and were not functioning at the time of the inspection.

## Item 6 – Approaches Summary (6, Satisfactory Condition)

The approaches are in **Satisfactory** condition, or a 6 on the NBIS condition rating guidelines.

The approach findings and summary of conditions for individual items are as follows:

### Item 1 – Approach Wearing Surface (2, Fair Condition)

The approach wearing surfaces are in **Fair** condition.

| Total Quantity | CS 1 | CS 2 | CS 3 | CS 4 | Transition Rating |
|----------------|------|------|------|------|-------------------|
| 2 EA           |      | 2 EA |      |      | 2.00              |



# PHYSICAL CONDITION REPORT

**Bridge Number:** CUY-6-1456  
**SFN:** 1800930  
**Inspection Date:** October 22-26, 2018

The east and west approaches exhibit moderate map cracking throughout and the west approach exhibits isolated spalls.

**Item 4 – Embankment (2, Fair Condition)**

The approach embankments are in **Fair** condition.

| Total Quantity | CS 1 | CS 2 | CS 3 | CS 4 | Transition Rating |
|----------------|------|------|------|------|-------------------|
| 4 EA           | 3 EA |      | 1 EA |      | 2.50              |

The embankment under Span 3 exhibits several slope depressions. This embankment was primarily loose soil placed over demolition debris. Beneath this fill is a concrete strut between piers 2 and 3 used as a means of structure stability during construction. This strut is preventing portions of the fill from sliding into the Cuyahoga River. This embankment is being monitored with slope inclinometers. Tower B is also being monitored due to its rotation to the south which is being monitored via crack gauges.

**Item 5 –Guardrail (1, Good Condition)**

The approach guardrail is in **Good** condition.

| Total Quantity | CS 1 | CS 2 | CS 3 | CS 4 | Transition Rating |
|----------------|------|------|------|------|-------------------|
| 4 EA           | 3 EA | 1 EA |      |      | 1.33              |

There are minor scrapes and gouges due to impact along the concrete approach railings.

## Utility Items

**Item 56 – Utilities (2 Fair Condition)**

The utilities are in **Fair** condition.

| Total Quantity | CS 1 | CS 2     | CS 3 | CS 4 | Transition Rating |
|----------------|------|----------|------|------|-------------------|
| 4,553 LF       |      | 4,553 LF |      |      | 2.00              |

The lower deck telephone junction chamber in Spans 2 and 13 are severely corroded and lacking security due to salt water infiltration through the manhole above.

The lighting on the bridge is in fair condition. The upper deck architectural light pole bases on the north sidewalk in Spans 1 and 11 have cracked and are broken. All of the exterior pier shaft light brackets exhibit paint failure and corrosion with minor section loss present.

Architectural lighting was installed throughout the bridge in 1996 for the City of Cleveland.



# PHYSICAL CONDITION REPORT

**Bridge Number:** CUY-6-1456  
**SFN:** 1800930  
**Inspection Date:** October 22-26, 2018

---

## Security Items

There are locations where the structure and structure right of way can be accessed by non-bridge personnel. Security fencing installed around Piers 2 and 3 can easily be surpassed by vagrants. The fence running from Tower A South to Pier 1 which encloses the land between Span 1 and along Spans 1A and 1B is accessible due to an unlocked gate on the southeast end of Pier 1. Due to the unlocked gate there are multiple homeless camps set up beneath the spans. Preventative access steel mesh installed outside Span 1A near Tower A to prevent access appears formidable, however, plastic steps located adjacent to this area indicate opportunities have been taken to gain access.

A chain link enclosure for the Center Street bridge operator's vehicle on the west side of Pier 4 allows vandals to climb the fencing cover to access the sway bracing. From here the vandals have vandalized Pier 4 and have access to the truss lower chord and lower deck.

## West and East Abutment Chambers

The chambers below the west and east approach were inspected, however, are not included in any of the quantities within this report. Crack gauges are in place in a number of cells within the west chambers to monitor shifting. There are large spalls with exposed and corroded reinforcing on the walls and ceilings of most of the cells. Horizontal, vertical, diagonal and map cracking with efflorescence and moisture staining are also present throughout all cells. The floors are typically covered in dirt and construction debris. The "Open Spandrel Arch and Truss Spans CADD Drawings and Deficiencies" section shows all the deficiencies within the chambers (Photos 46 through 49).

The east abutment chambers typically have large spalls with exposed and corroded reinforcing and exposed reinforcing ties protruding from chamber walls. The floors are typically covered in dirt and construction debris. The "Open Spandrel Arch and Truss Spans CADD Drawings and Deficiencies" section shows all the deficiencies within the chambers (Photos 50 and 51).



# PHYSICAL CONDITION REPORT

**Bridge Number:** CUY-6-1456  
**SFN:** 1800930  
**Inspection Date:** October 22-26, 2018

---

## Recommendations

The Veterans Memorial/Detroit-Superior Bridge over the Cuyahoga River is in overall Fair condition, or 5 on the NBIS rating guideline.

### High:

- Pier 8 South exterior column; Remove loose concrete and repair spalled area

### Immediate:

- Repair and clean areas of the deteriorated concrete deck
- Clean and Repair the drainage catch basins
- Repair areas of the deteriorated and leaking joints with dislodged joint materials
- Repair and clean areas of the deteriorated concrete arch superstructure
- Repair and clean areas of the deteriorated concrete stringer superstructure
- Repair and clean areas of the deteriorated concrete floor beam superstructure
- Repair and clean areas of the deteriorated steel superstructure
- Spot paint areas of the deteriorated steel components
- Repair and clean areas of the deteriorated substructure concrete
- Repair and/or replace the navigation lights
- Repair areas of the deteriorated approach wearing surfaces
- Repair the embankment in Span 3
- Secure all access points to the structure
- Drain water from the East Tunnels and stop the source of water infiltration so a full inspection can be completed



# PHYSICAL CONDITION REPORT

Bridge Number: CUY-6-1456  
SFN: 1800930  
Inspection Date: October 22-26, 2018

---

## Deck Photos



Infrastructure Engineers, LLC.  
9902 Carver Rd.  
Suite 201  
Cincinnati, OH 45242

[www.consoreng.com](http://www.consoreng.com)

# PHYSICAL CONDITION REPORT

Bridge Number: CUY-6-1456

SFN: 1800930

Inspection Date: October 22-26, 2018



Photo 1 – Typical lower deck soffit West Approach



Photo 2 – Typical upper deck soffit Span 2



# PHYSICAL CONDITION REPORT

Bridge Number: CUY-6-1456  
SFN: 1800930  
Inspection Date: October 22-26, 2018



Photo 3 – Typical upper deck soffit Span 4



Photo 4 – Typical upper deck wearing surface condition



Infrastructure Engineers, LLC.  
9902 Carver Rd.  
Suite 201  
Cincinnati, OH 45242

[www.consoreng.com](http://www.consoreng.com)

# PHYSICAL CONDITION REPORT

Bridge Number: CUY-6-1456  
SFN: 1800930  
Inspection Date: October 22-26, 2018



Photo 5 – Typical bridge rail condition



Photo 6 – Typical expansion joint condition



Infrastructure Engineers, LLC.  
9902 Carver Rd.  
Suite 201  
Cincinnati, OH 45242

[www.consoeng.com](http://www.consoeng.com)



# PHYSICAL CONDITION REPORT

Bridge Number: CUY-6-1456  
SFN: 1800930  
Inspection Date: October 22-26, 2018



Photo 7 – South top railing at Tower A; vertically misaligned 7/8” at railing joint



Photo 8 – West tunnels upper deck with heavy efflorescence, cracking, delaminations, and spalls with corroded reinforcing steel



Infrastructure Engineers, LLC.  
9902 Carver Rd.  
Suite 201  
Cincinnati, OH 45242

[www.consoreng.com](http://www.consoreng.com)

# PHYSICAL CONDITION REPORT

Bridge Number: CUY-6-1456

SFN: 1800930

Inspection Date: October 22-26, 2018



Photo 9 – West Station wearing surface; heavy map cracking and patching throughout



Photo 10 – Tower B expansion joint, left westbound lane; pack rust has broken fillet welds. Snow plow damage is present.



Infrastructure Engineers, LLC.  
9902 Carver Rd.  
Suite 201  
Cincinnati, OH 45242

[www.consoreng.com](http://www.consoreng.com)

# PHYSICAL CONDITION REPORT

Bridge Number: CUY-6-1456  
SFN: 1800930  
Inspection Date: October 22-26, 2018

---



Photo 11 – Pier 1 south downspout; missing 15' section of PVC pipe



Photo 12 – Span 2, Panel 15 center bay; SIP forms exhibit severe corrosion that is staining the west face of Pier 2



# PHYSICAL CONDITION REPORT

Bridge Number: CUY-6-1456  
SFN: 1800930  
Inspection Date: October 22-26, 2018



Photo 13 – Span 3 south attenuator; minor impact damage



Photo 14 – East end of Span 4; deteriorating 12' L x 18' W x 1" D patch



Infrastructure Engineers, LLC.  
9902 Carver Rd.  
Suite 201  
Cincinnati, OH 45242

[www.consoreng.com](http://www.consoreng.com)

# PHYSICAL CONDITION REPORT

Bridge Number: CUY-6-1456  
SFN: 1800930  
Inspection Date: October 22-26, 2018

---



Photo 15 – Upper Deck, Span 7, Panel 4 center bay; local area of efflorescence



Photo 16 – Span 8 eastbound lane; 25' L x 7' W x up to 3" D spalling patch with exposed reinforcing



Infrastructure Engineers, LLC.  
9902 Carver Rd.  
Suite 201  
Cincinnati, OH 45242

[www.consoreng.com](http://www.consoreng.com)

# PHYSICAL CONDITION REPORT

Bridge Number: CUY-6-1456

SFN: 1800930

Inspection Date: October 22-26, 2018



Photo 17 – Span 11, north sidewalk; broken light pole base



# PHYSICAL CONDITION REPORT

Bridge Number: CUY-6-1456  
SFN: 1800930  
Inspection Date: October 22-26, 2018

---

## Superstructure Photos



Infrastructure Engineers, LLC.  
9902 Carver Rd.  
Suite 201  
Cincinnati, OH 45242

[www.consoreng.com](http://www.consoreng.com)

# PHYSICAL CONDITION REPORT

Bridge Number: CUY-6-1456  
SFN: 1800930  
Inspection Date: October 22-26, 2018

---



Photo 18 – Span 5 North Exterior Arch Rib, Panel 14; longitudinal through crack that has propagated into several spandrel columns



Photo 19 – Span 7 South Interior Arch Rib; lower north corner near apex has an unrepaired spall with exposed reinforcing





# PHYSICAL CONDITION REPORT

Bridge Number: CUY-6-1456  
SFN: 1800930  
Inspection Date: October 22-26, 2018

---



Photo 20 – Span 11 North Exterior Arch, south face; crack extending from Pier 11 up 1/4 length of the arch



Photo 21 – Span 2 North Exterior lower columns 3 and 4; south faces have up to full height spalling with corroded reinforcing



# PHYSICAL CONDITION REPORT

Bridge Number: CUY-6-1456  
SFN: 1800930  
Inspection Date: October 22-26, 2018



Photo 22 – Span 8 North Interior Upper Column 2; 4' H x 4" D corner spall on the northeast corner of the column with exposed reinforcing



Photo 23 – Span 5 Upper Deck Floorbeam 11 west face between interior arches; Full Height x 3' W x 4" D spall with exposed rebar



Infrastructure Engineers, LLC.  
9902 Carver Rd.  
Suite 201  
Cincinnati, OH 45242

[www.consoreng.com](http://www.consoreng.com)

# PHYSICAL CONDITION REPORT

Bridge Number: CUY-6-1456  
SFN: 1800930  
Inspection Date: October 22-26, 2018

---



Photo 24 – Span 12, lower deck floorbeams; multiple floorbeams have spalled concrete with exposed, painted over reinforcing



Photo 25 – Span 3 North Interior Arch between upper deck Columns 10 & 11; arch is cracked and delaminated with efflorescence



# PHYSICAL CONDITION REPORT

Bridge Number: CUY-6-1456  
SFN: 1800930  
Inspection Date: October 22-26, 2018

---



Photo 26 – Typical superstructure condition



Photo 27 – Typical truss condition



# PHYSICAL CONDITION REPORT

Bridge Number: CUY-6-1456  
SFN: 1800930  
Inspection Date: October 22-26, 2018



Photo 28 – Span 4 North Truss L2 South Gusset, North Face; 2' L x up to 3" H x up to 1/4" D pitting with reactivating laminar corrosion



Photo 29 – Span 4 North Truss L2 lower batten plate; 20" L x Full Width corrosion hole



# PHYSICAL CONDITION REPORT

Bridge Number: CUY-6-1456

SFN: 1800930

Inspection Date: October 22-26, 2018



Photo 30 – Span 4 North Truss L3 south gusset above L2L3; Active laminar corrosion and pitting up to 3/16" D



Photo 31 – Span 4 Upper Deck Floorbeam 10'; web corrosion hole north of the first interior stringer from the panel point



Infrastructure Engineers, LLC.  
9902 Carver Rd.  
Suite 201  
Cincinnati, OH 45242

[www.consoreng.com](http://www.consoreng.com)

# PHYSICAL CONDITION REPORT

Bridge Number: CUY-6-1456

SFN: 1800930

Inspection Date: October 22-26, 2018



Photo 32 – Span 4 Upper Deck Floorbeam 8'; corrosion hole below the upper deck lateral bracing gusset plate on the north arch



Photo 33 – Span 4 North Truss L3'L2' diaphragm; corrosion hole



# PHYSICAL CONDITION REPORT

Bridge Number: CUY-6-1456  
SFN: 1800930  
Inspection Date: October 22-26, 2018



Photo 34 – Span 4 South Truss L0 Inboard Pin Cover Plate; non-structural plate with two cracks



Photo 35 – Span 4 South Truss L0L1 near L0; fractured bolt on top lacing channel connection along top flange





# PHYSICAL CONDITION REPORT

Bridge Number: CUY-6-1456  
SFN: 1800930  
Inspection Date: October 22-26, 2018

---

## Substructure Photos



Infrastructure Engineers, LLC.  
9902 Carver Rd.  
Suite 201  
Cincinnati, OH 45242

[www.consoreng.com](http://www.consoreng.com)

# PHYSICAL CONDITION REPORT

Bridge Number: CUY-6-1456  
SFN: 1800930  
Inspection Date: October 22-26, 2018

---



Photo 36 – East Abutment typical condition



Photo 37 – West Abutment typical condition



Infrastructure Engineers, LLC.  
9902 Carver Rd.  
Suite 201  
Cincinnati, OH 45242

[www.consoreng.com](http://www.consoreng.com)

# PHYSICAL CONDITION REPORT

Bridge Number: CUY-6-1456  
SFN: 1800930  
Inspection Date: October 22-26, 2018



Photo 38 – West 25<sup>th</sup> Street Columns and Arches; heavily deteriorated with exposed reinforcing and efflorescence



Photo 39 – West Abutment Below South Exterior Arch; 1/4" W vertical crack



# PHYSICAL CONDITION REPORT

Bridge Number: CUY-6-1456  
SFN: 1800930  
Inspection Date: October 22-26, 2018



Photo 40 – Pier, typical condition



Photo 41 –Typical architectural lighting brackets on pier are corroding



# PHYSICAL CONDITION REPORT

Bridge Number: CUY-6-1456  
SFN: 1800930  
Inspection Date: October 22-26, 2018

---



Photo 42 – Tower B South side; rotated outwards and fractured at the interface with the upper deck



Photo 43 – Pier 5 North Exterior Column; 10' H x 6" D corner spall with exposed reinforcing



# PHYSICAL CONDITION REPORT

Bridge Number: CUY-6-1456  
SFN: 1800930  
Inspection Date: October 22-26, 2018

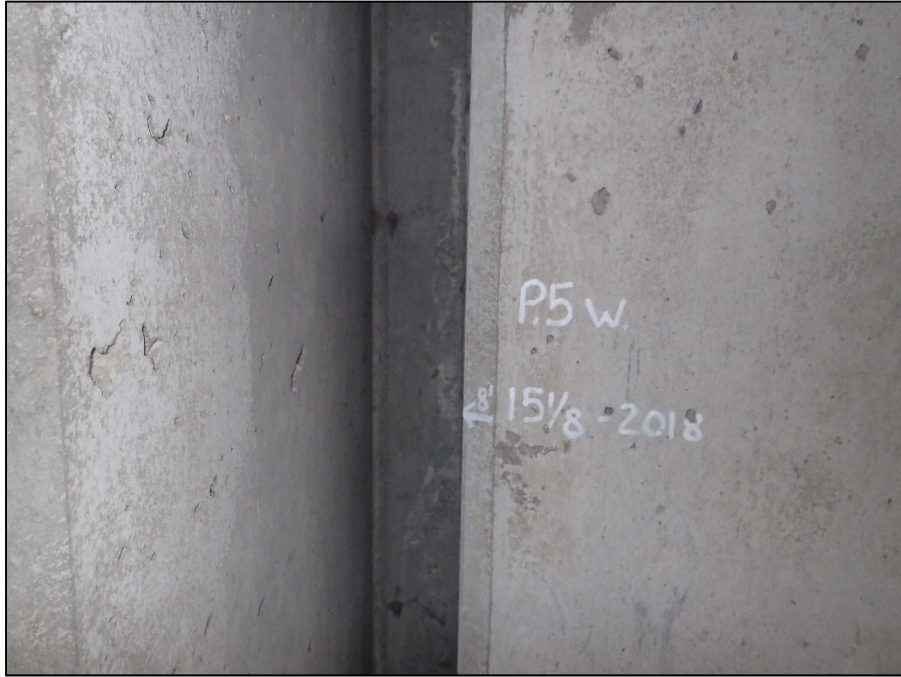


Photo 44 – Pier 5, west side of south wall; 15-2/16” measurement of tower rotation



Photo 45 – Pier 8 South Exterior Column, west Face; 4' H x 4' W x 10" D spall



# PHYSICAL CONDITION REPORT

Bridge Number: CUY-6-1456  
SFN: 1800930  
Inspection Date: October 22-26, 2018

---

## West and East Abutment Chamber Photos



Infrastructure Engineers, LLC.  
9902 Carver Rd.  
Suite 201  
Cincinnati, OH 45242

[www.consoreng.com](http://www.consoreng.com)

# PHYSICAL CONDITION REPORT

Bridge Number: CUY-6-1456  
SFN: 1800930  
Inspection Date: October 22-26, 2018



Photo 46 – West Abutment, Chamber 9S, south wall; 1-1/2” rotation towards the south



Photo 47 – West Abutment, Chamber 6S, west wall; crack gauge





# PHYSICAL CONDITION REPORT

Bridge Number: CUY-6-1456  
SFN: 1800930  
Inspection Date: October 22-26, 2018

---



Photo 48 – West Abutment, Chamber 1S, ceiling; typical cracks with efflorescence and moisture



Photo 49 – West Abutment, Chamber 7, west wall; 4' L x 20" H x 1" D spall with exposed reinforcing



# PHYSICAL CONDITION REPORT

Bridge Number: CUY-6-1456  
SFN: 1800930  
Inspection Date: October 22-26, 2018

---



Photo 50 – East Abutment, North Chamber ceiling; bottom of floor beam spalled full length with exposed reinforcing



Photo 51 – East Abutment, South Chamber, west wall; vertical spalls with exposed reinforcing



# PHYSICAL CONDITION REPORT

Bridge Number: CUY-6-1456

SFN: 1800930

Inspection Date: October 22-26, 2018


---

## OPEN SPANDREL ARCH SPANS, TRUSS SPAN, AND DECK CADD DRAWINGS AND DEFICIENCIES




Infrastructure Engineers, LLC.  
9902 Carver Rd.  
Suite 201  
Cincinnati, OH 45242

[www.consoreng.com](http://www.consoreng.com)

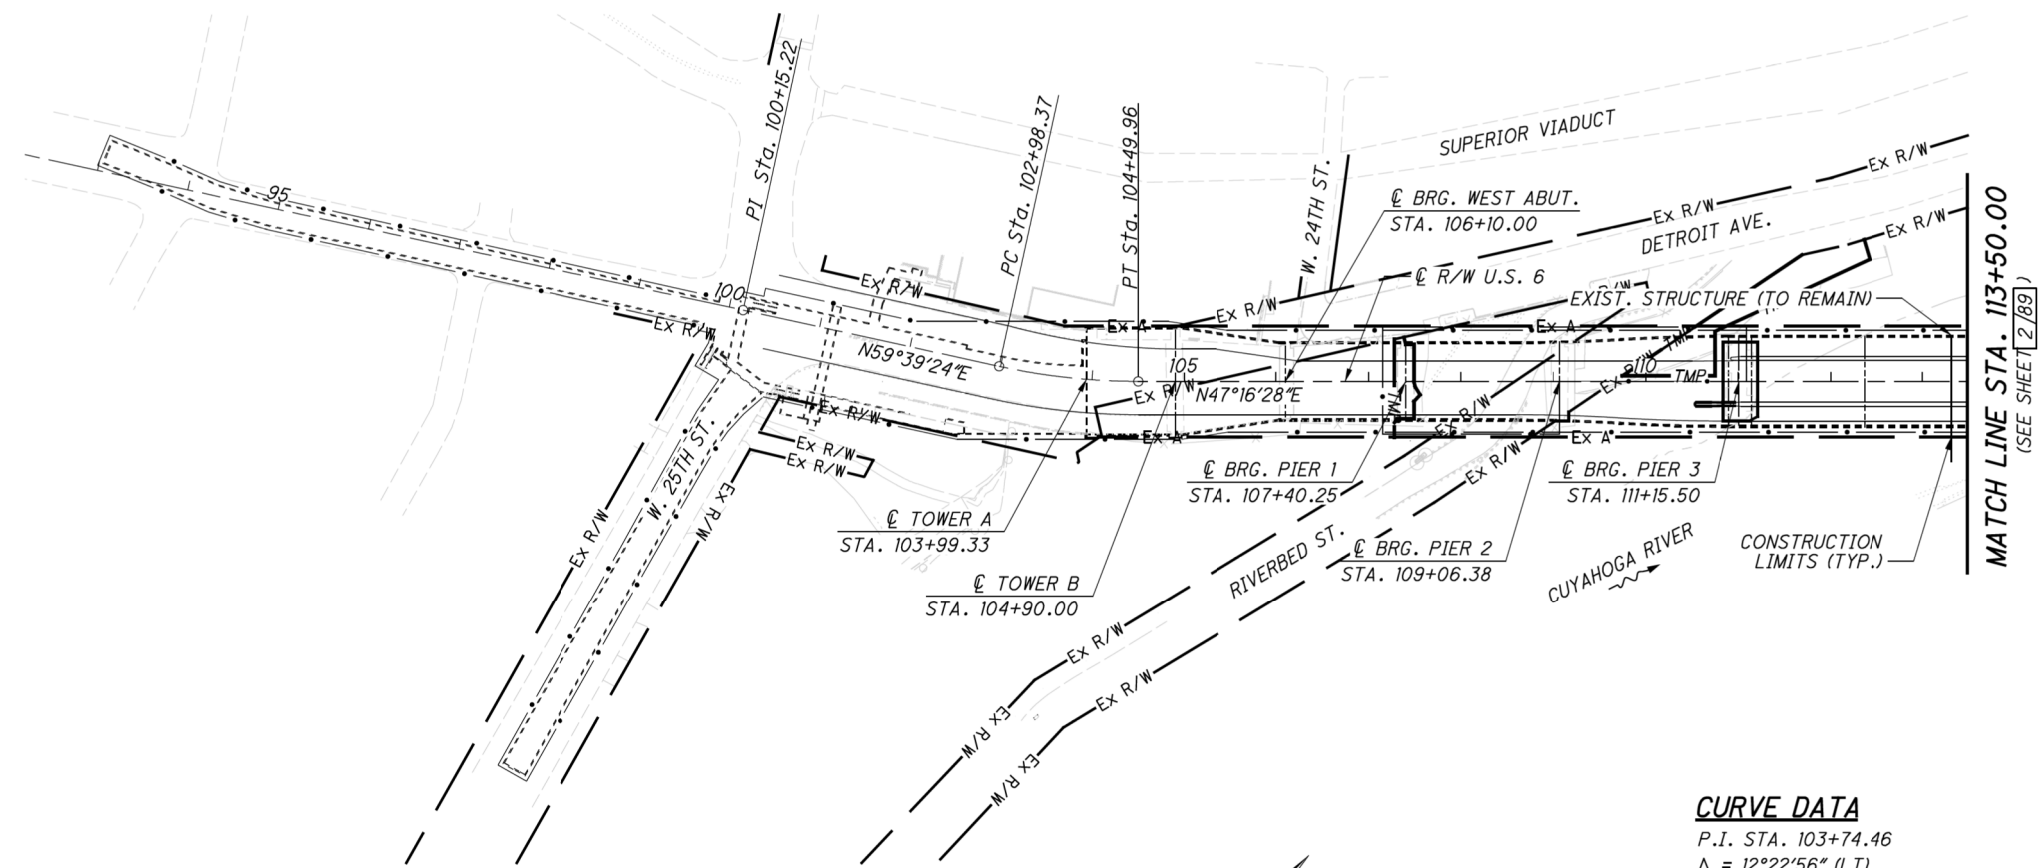


**CURVE DATA**  
 P.I. STA. 103+74.46  
 $\Delta = 12^{\circ}22'56''$  (LT)  
 $D_c = 8^{\circ}10'07''$   
 $R = 701.42'$   
 $T = 76.09'$   
 $L = 151.58'$   
 $E = 4.11'$   
 $C = 151.29'$   
 $C.B. = N 53^{\circ}27'56'' E$

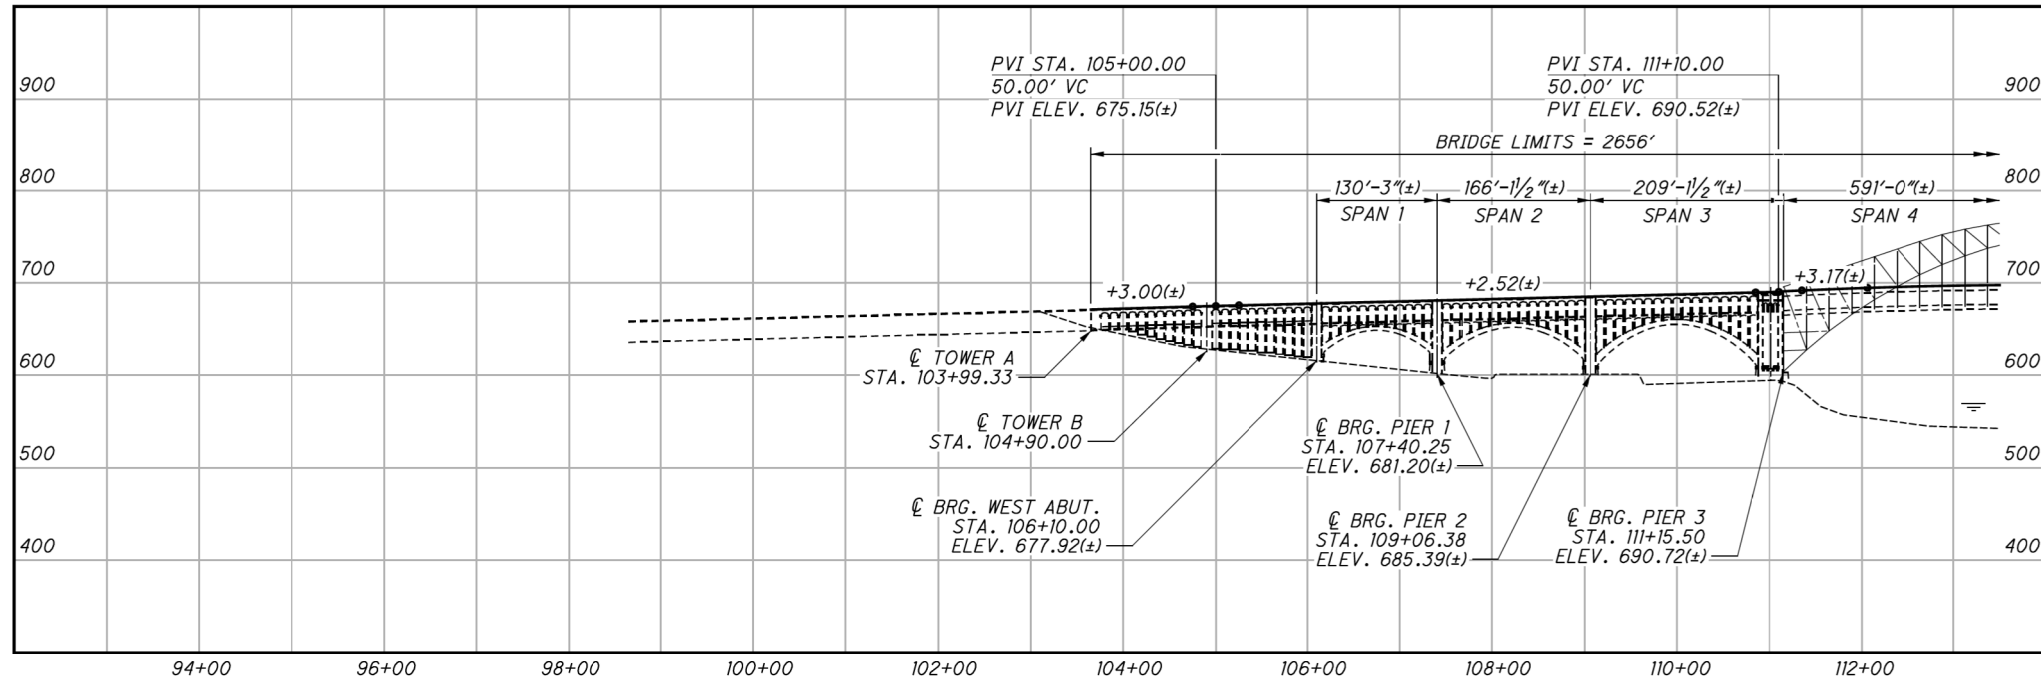

PROFILE ALONG C R/W U.S. 6

|                                |           |                                                                                                                                                                     |                                                                      |                          |
|--------------------------------|-----------|---------------------------------------------------------------------------------------------------------------------------------------------------------------------|----------------------------------------------------------------------|--------------------------|
| GRAPHIC SCALE MEASURED IN FEET | DATE      | <br>9902 Carver Road<br>Suite 201<br>Cincinnati, OH 45242<br>PH.: 614.699.5000 | DETROIT-SUPERIOR BRIDGE OVER CUYAHOGA RIVER<br>BRIDGE NO. CUY-6-1465 |                          |
|                                | NOV, 2018 |                                                                                                                                                                     | INFRASTRUCTURE ENGINEERS, INC.                                       | GENERAL PLAN & ELEVATION |
| NOT TO SCALE                   |           |                                                                                                                                                                     |                                                                      |                          |

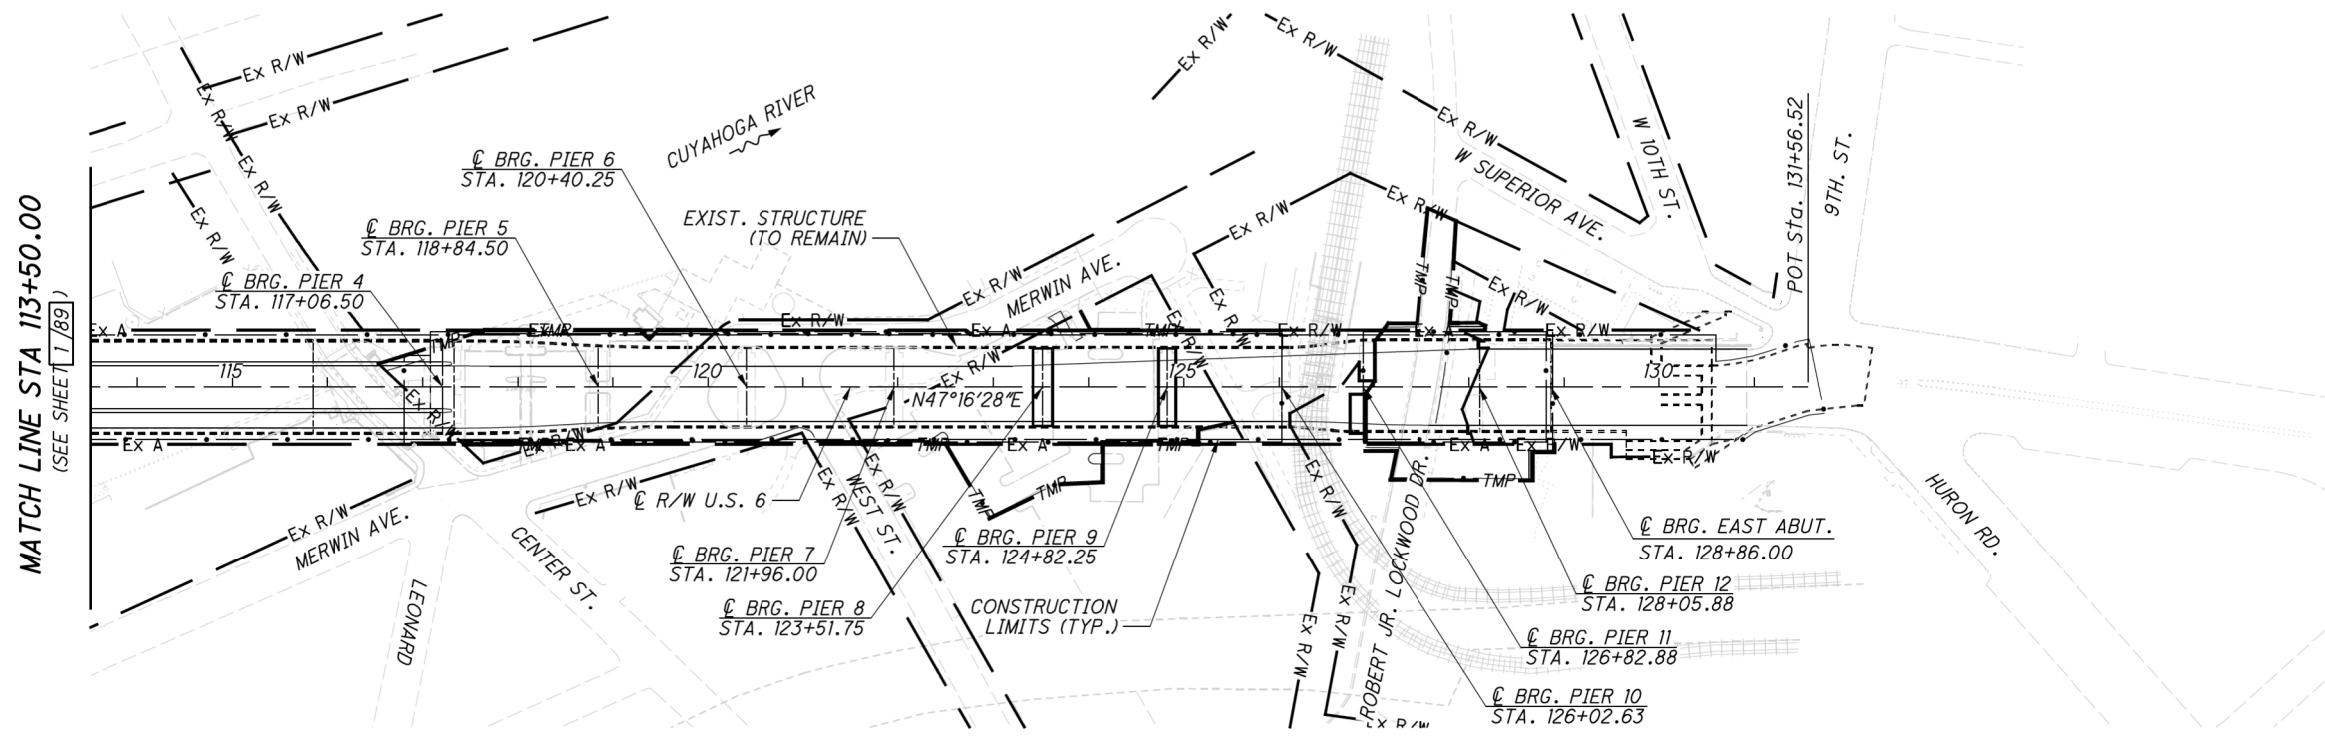


PLAN




NOTES

1. UTILITIES NOT SHOWN FOR CLARITY. ALL EXISTING UTILITIES ARE TO REMAIN UNLESS NOTED OTHERWISE.

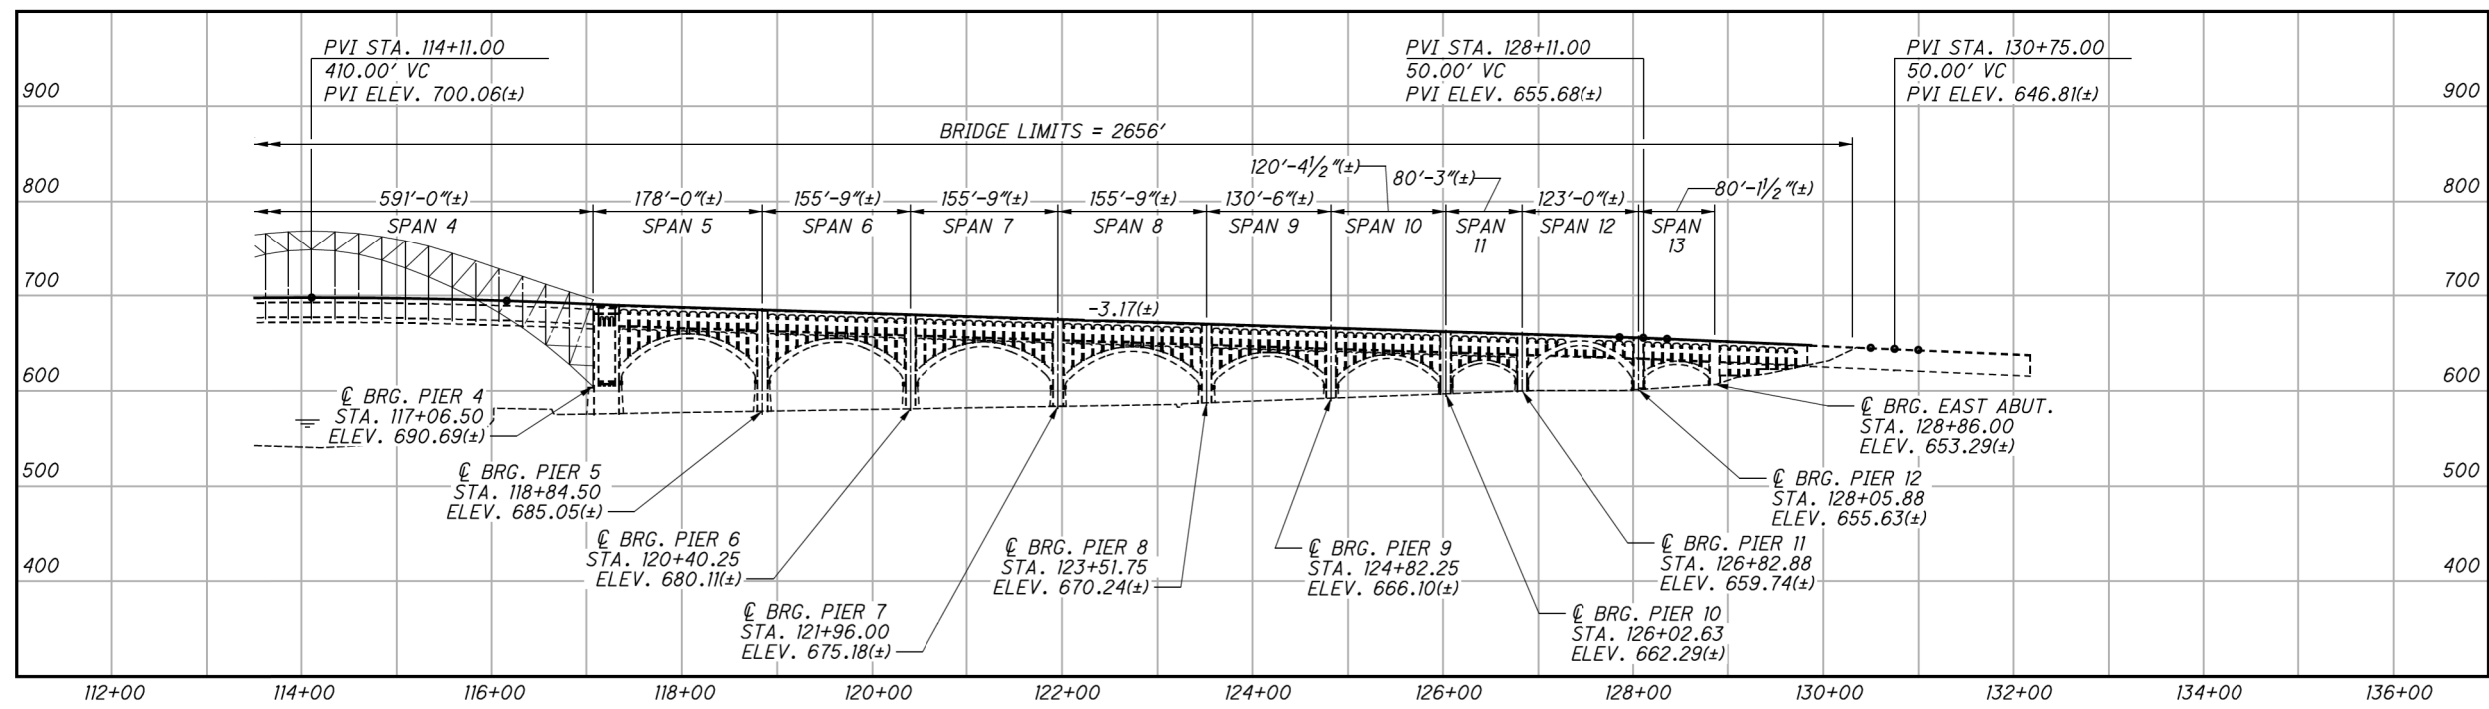

PROFILE ALONG C R/W U.S. 6

|                                |              |                                                                                                                                                                  |                                                                      |                                |
|--------------------------------|--------------|------------------------------------------------------------------------------------------------------------------------------------------------------------------|----------------------------------------------------------------------|--------------------------------|
| GRAPHIC SCALE MEASURED IN FEET | DATE         |  9902 Carver Road<br>Suite 201<br>Cincinnati, OH 45242<br>PH.: 614.699.5000 | DETROIT-SUPERIOR BRIDGE OVER CUYAHOGA RIVER<br>BRIDGE NO. CUY-6-1465 |                                |
|                                | NOT TO SCALE |                                                                                                                                                                  | NOV, 2018                                                            | INFRASTRUCTURE ENGINEERS, INC. |
|                                |              |                                                                                                                                                                  |                                                                      | PAGE<br>A-2                    |

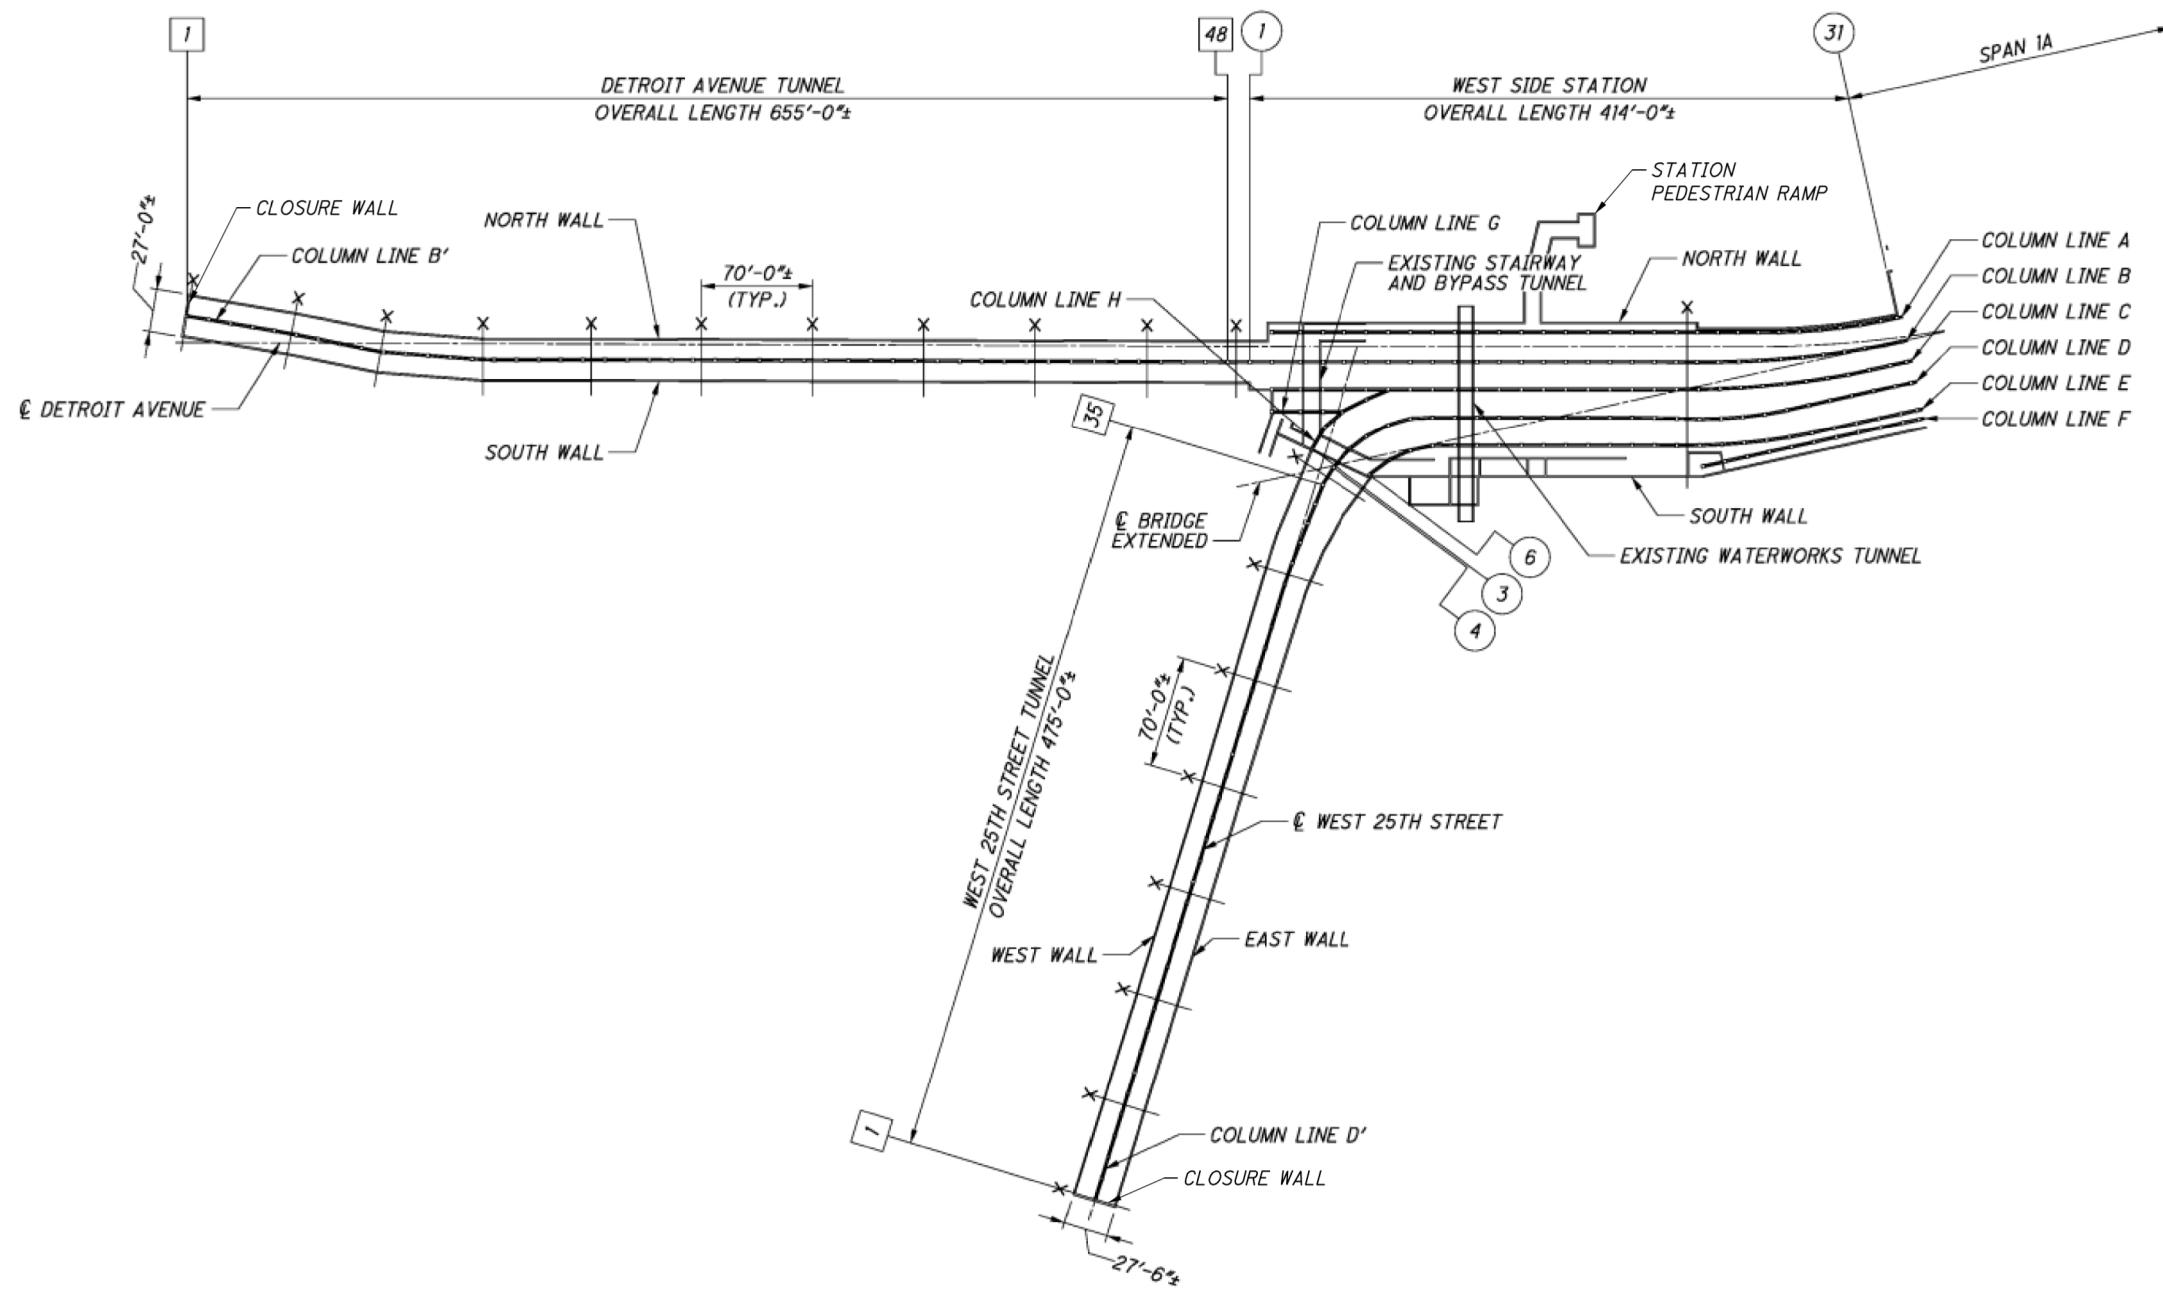

**PLAN**




**LEGEND:**

- # TUNNEL COLUMN NUMBER
- ⊕ WEST STATION COLUMN NUMBER
- × CONSTRUCTION JOINT

**NOTES:**


1. NO PROPOSED WORK SHOWN ON THIS SHEET.
2. FOR STRUCTURE GENERAL NOTES, SEE SHEETS 5/89 TO 9/89
3. ALL DIMENSIONS ARE HORIZONTAL.

|                                |           |                                                                                                                                                                  |                                                                      |             |
|--------------------------------|-----------|------------------------------------------------------------------------------------------------------------------------------------------------------------------|----------------------------------------------------------------------|-------------|
| GRAPHIC SCALE MEASURED IN FEET | DATE      |  9902 Carver Road<br>Suite 201<br>Cincinnati, OH 45242<br>PH.: 614.699.5000 | DETROIT-SUPERIOR BRIDGE OVER CUYAHOGA RIVER<br>BRIDGE NO. CUY-6-1465 |             |
| NOT TO SCALE                   | NOV, 2018 | INFRASTRUCTURE<br>ENGINEERS, INC.                                                                                                                                | MEMBER IDENTIFICATION PLAN                                           | PAGE<br>A-3 |

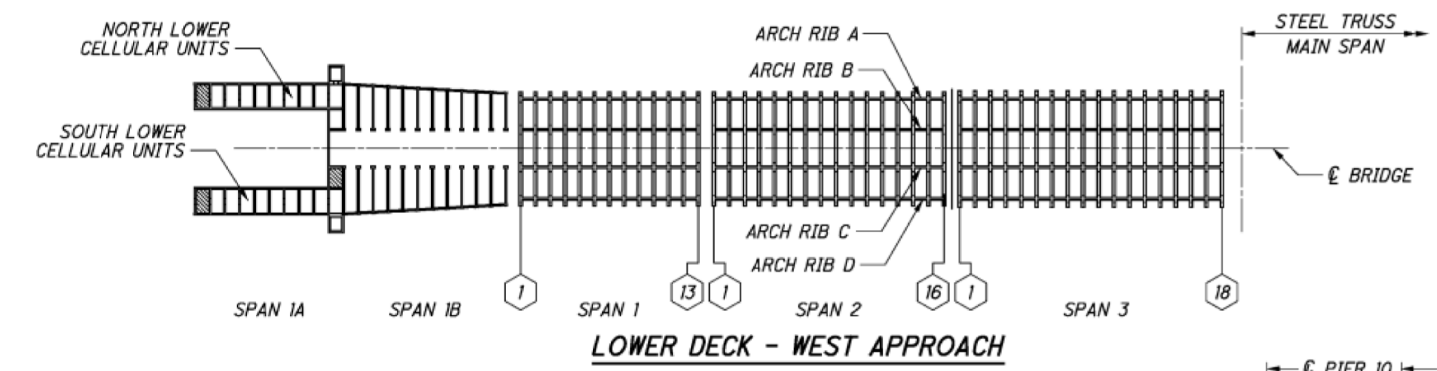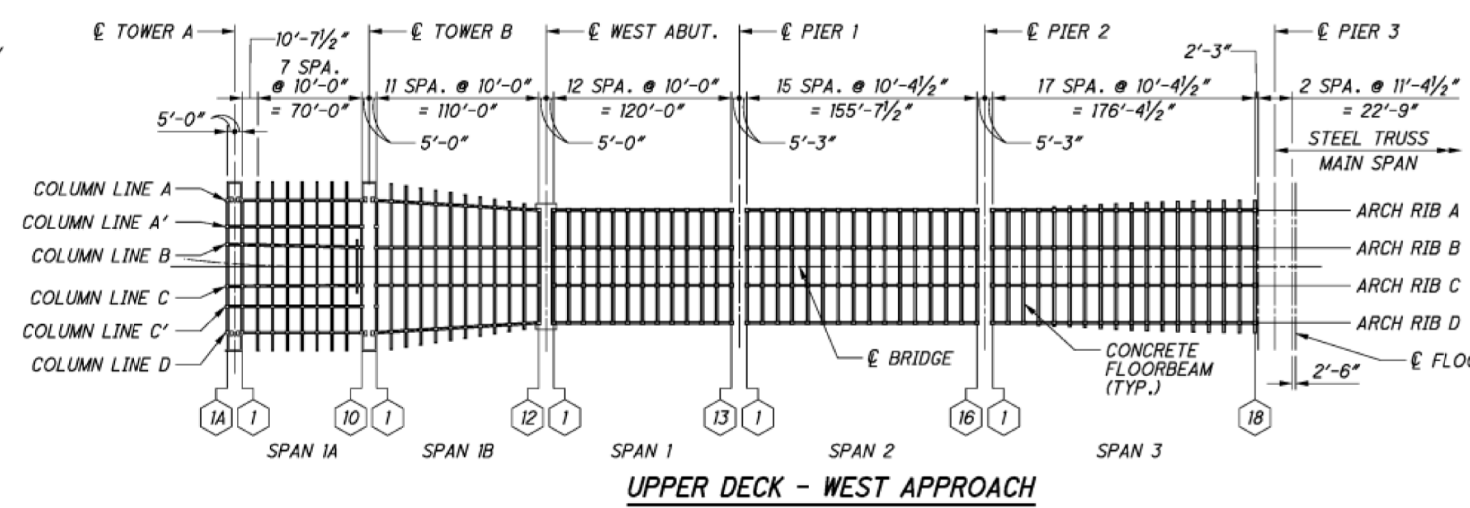
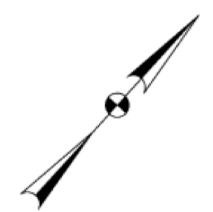


**LEGEND:**  
 # FLOORBEAM LINE NUMBER & COLUMN LINE NUMBER

**NOTES:**  
 1. NO PROPOSED WORK SHOWN ON THIS SHEET.  
 2. FOR STRUCTURE GENERAL NOTES, SEE SHEETS 5/89 TO 9/89  
 3. ALL DIMENSIONS ARE HORIZONTAL AND (±).

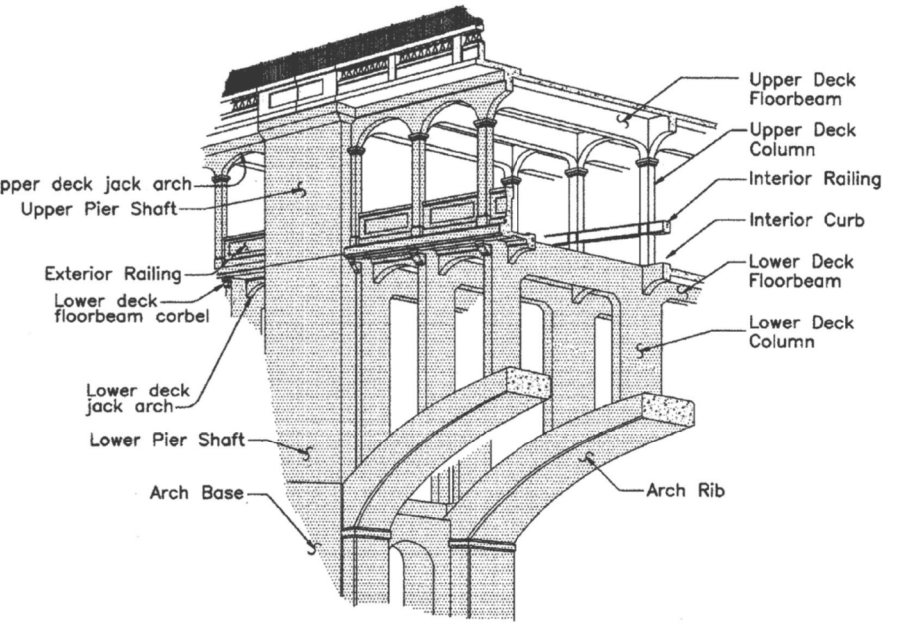


**SECTION A-A**  
 SHOWING UPPER & LOWER DECK ELEMENT NOMENCLATURE

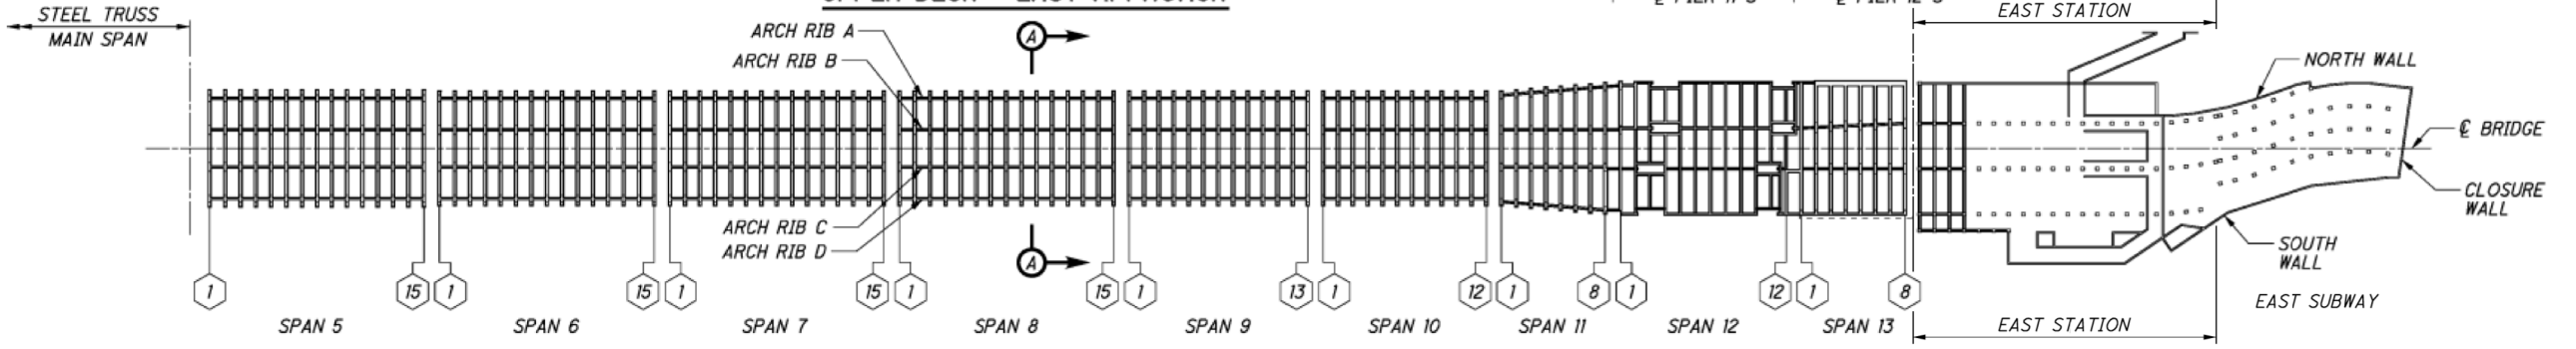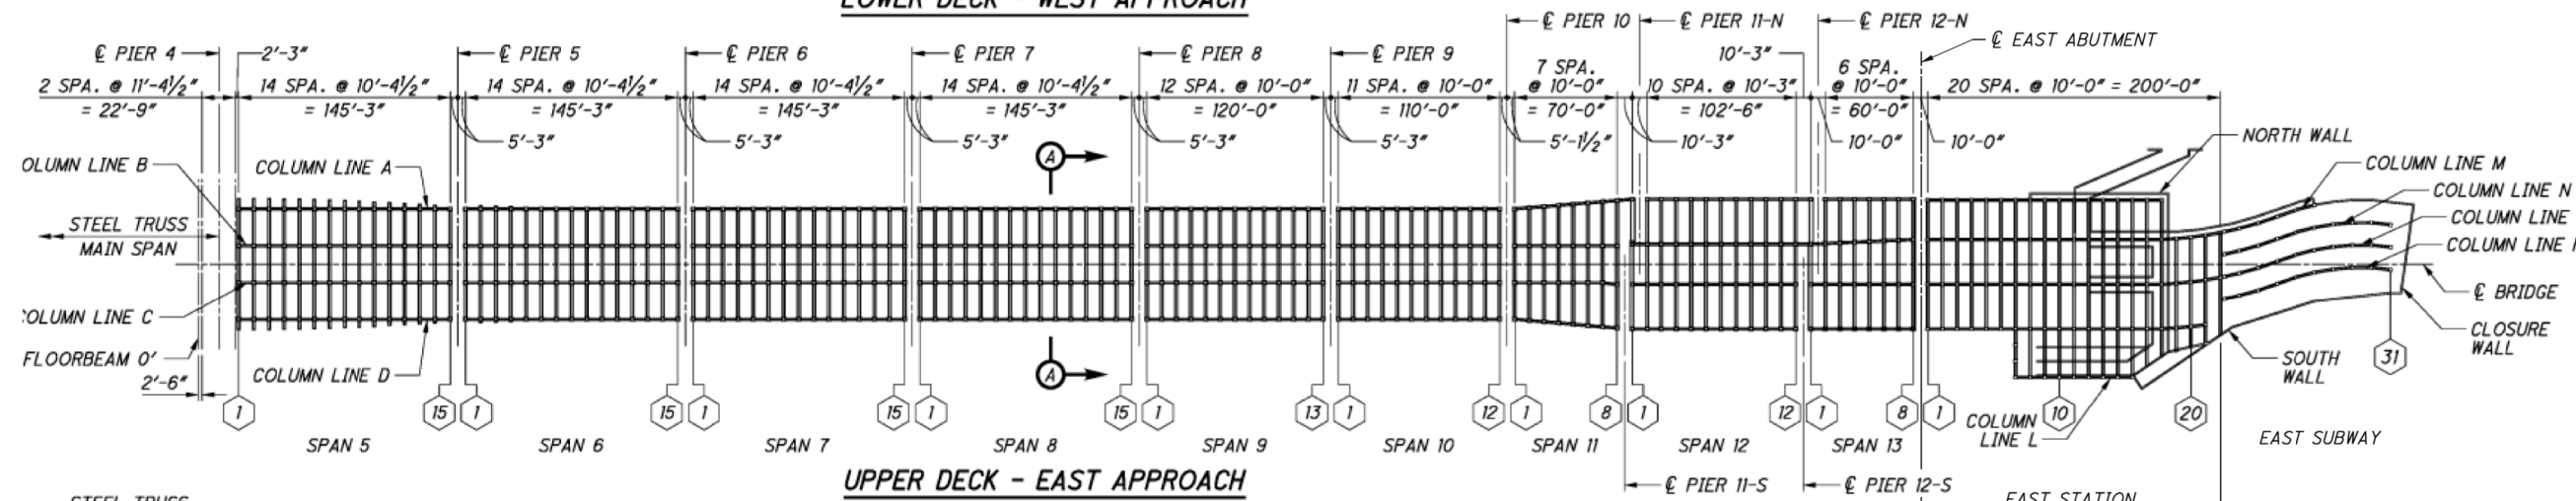


**PLAN**

|                                |           |                                                                                                                                                                  |                                                                      |                            |
|--------------------------------|-----------|------------------------------------------------------------------------------------------------------------------------------------------------------------------|----------------------------------------------------------------------|----------------------------|
| GRAPHIC SCALE MEASURED IN FEET | DATE      |  9902 Carver Road<br>Suite 201<br>Cincinnati, OH 45242<br>PH.: 614.699.5000 | DETROIT-SUPERIOR BRIDGE OVER CUYAHOGA RIVER<br>BRIDGE NO. CUY-6-1465 |                            |
|                                | NOV, 2018 |                                                                                                                                                                  | INFRASTRUCTURE ENGINEERS, INC.                                       | MEMBER IDENTIFICATION PLAN |

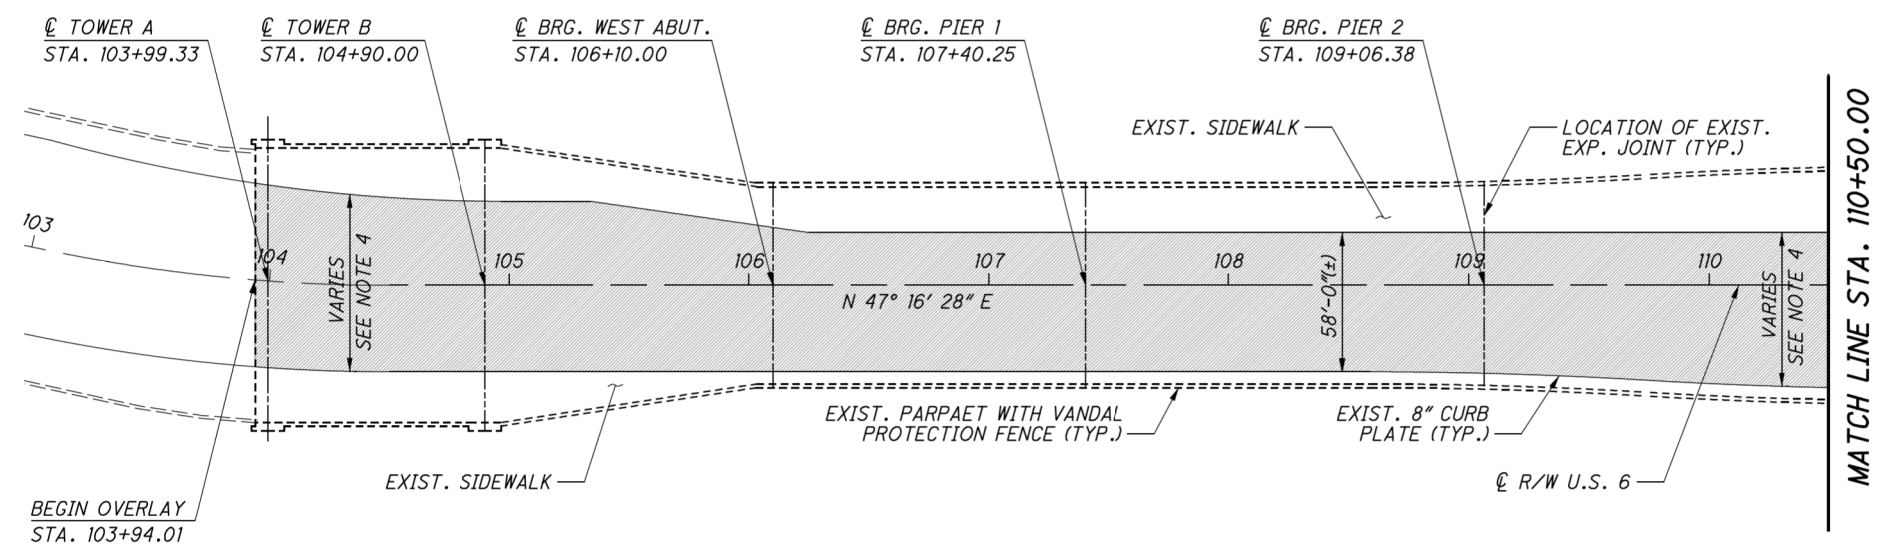

PLAN

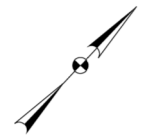


**NOTES**


1. FINISHED TOP OF DECK ELEVATIONS SHALL MATCH EXISTING TOP OF DECK ELEVATIONS.
2. FOR ADDITIONAL DETAILS NOT SHOWN, SEE ODOT SUPPLEMENTAL SPECIFICATION 848.
3. FOR VARYING ROADWAY WIDTHS AND STATIONING, SEE TYPICAL SECTIONS ON SHEET 3/128.

**LEGEND**

AREAS OF THE DECK TO HAVE EXISTING OVERLAY REMOVED AND REPLACED. FOR OVERLAY REMOVAL SEE NOTE 2. FOR MICRO SILICA MODIFIED CONCRETE OVERLAY SEE NOTE 3.

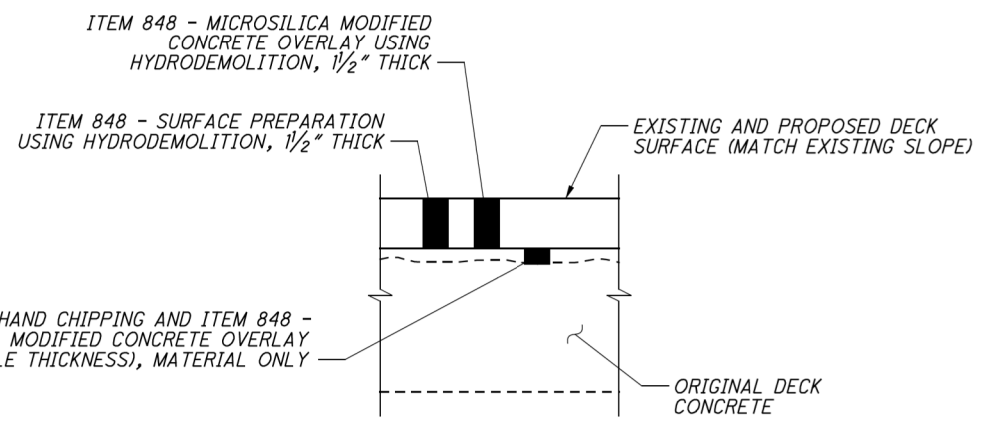

**BRIDGE DECK WEARING SURFACE REPLACEMENT DETAIL**

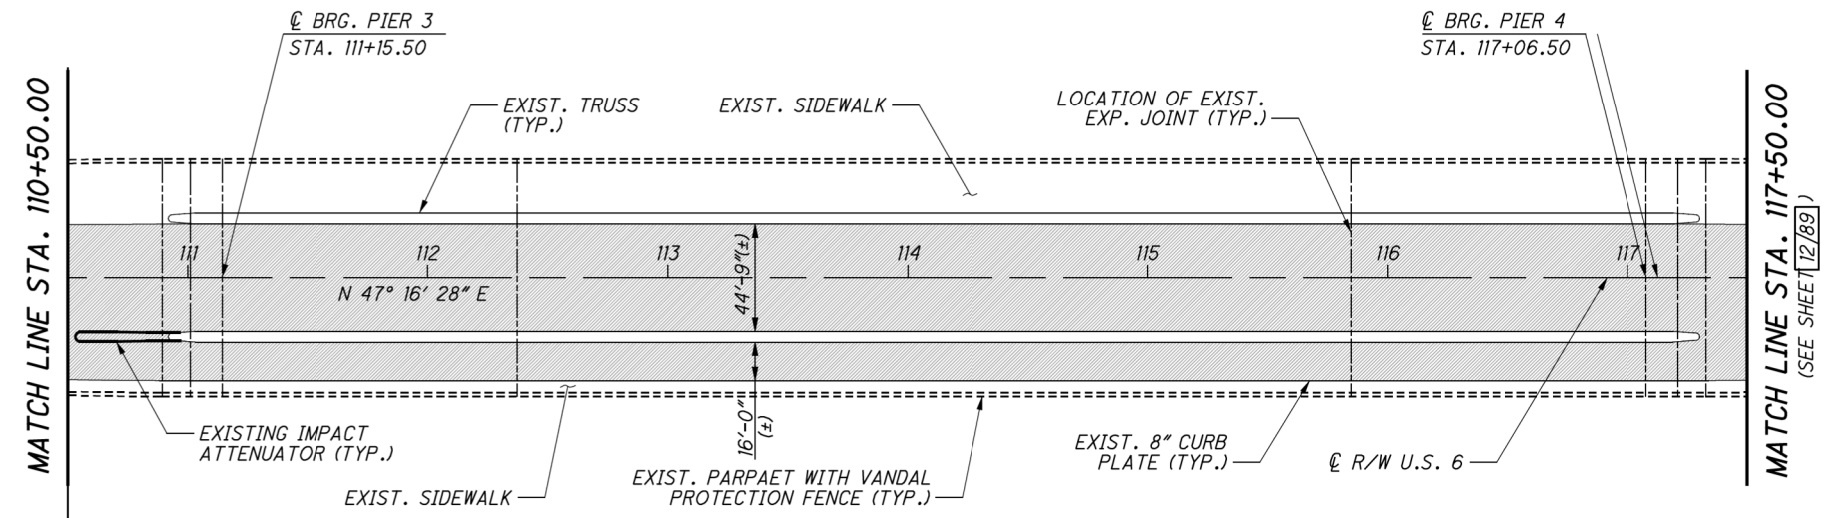


PLAN



|                                |                     |                                                                                                                                                                  |                                             |                       |
|--------------------------------|---------------------|------------------------------------------------------------------------------------------------------------------------------------------------------------------|---------------------------------------------|-----------------------|
| GRAPHIC SCALE MEASURED IN FEET | DATE                |  9902 Carver Road<br>Suite 201<br>Cincinnati, OH 45242<br>PH.: 614.699.5000 | DETROIT-SUPERIOR BRIDGE OVER CUYAHOGA RIVER |                       |
|                                | NOV, 2018           |                                                                                                                                                                  | INFRASTRUCTURE ENGINEERS, INC.              | BRIDGE NO. CUY-6-1465 |
| NOT TO SCALE                   | UPPER DECK PLAN - 1 |                                                                                                                                                                  | PAGE A-5                                    |                       |



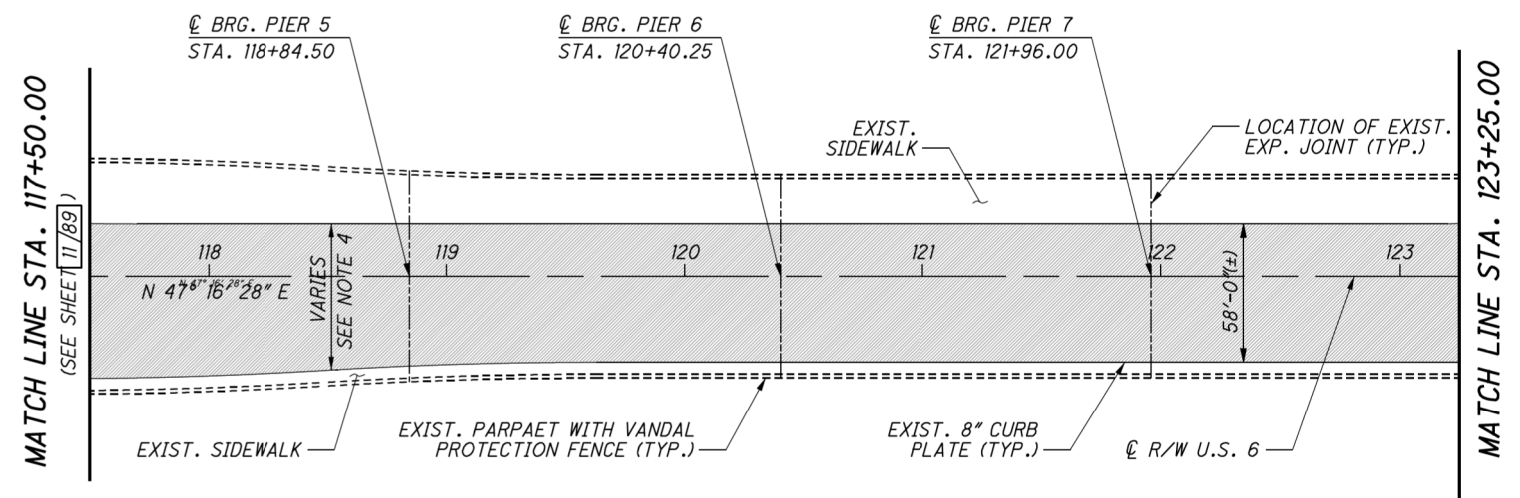

PLAN





**NOTES**


1. FINISHED TOP OF DECK ELEVATIONS SHALL MATCH EXISTING TOP OF DECK ELEVATIONS.
2. FOR ADDITIONAL DETAILS NOT SHOWN, SEE ODOT SUPPLEMENTAL SPECIFICATION 848.
3. FOR VARYING ROADWAY WIDTHS AND STATIONING, SEE TYPICAL SECTIONS ON SHEET 3/128.
4. FOR BRIDGE DECK WEARING SURFACE REPLACEMENT DETAIL, SEE SHEET 11/89.
5. FOR ADDITIONAL STRIP SEAL EXPANSION JOINT DETAILS, SEE STANDARD DRAWING EXJ-4-87.

**LEGEND**


- AREAS OF THE DECK TO HAVE EXISTING OVERLAY REMOVED AND REPLACED. FOR OVERLAY REMOVAL SEE NOTE 2. FOR MICRO SILICA MODIFIED CONCRETE OVERLAY SEE NOTE 3.
- REPLACE STRIP SEAL GLAND IN EXPANSION JOINT, SEE DETAIL ON THIS SHEET

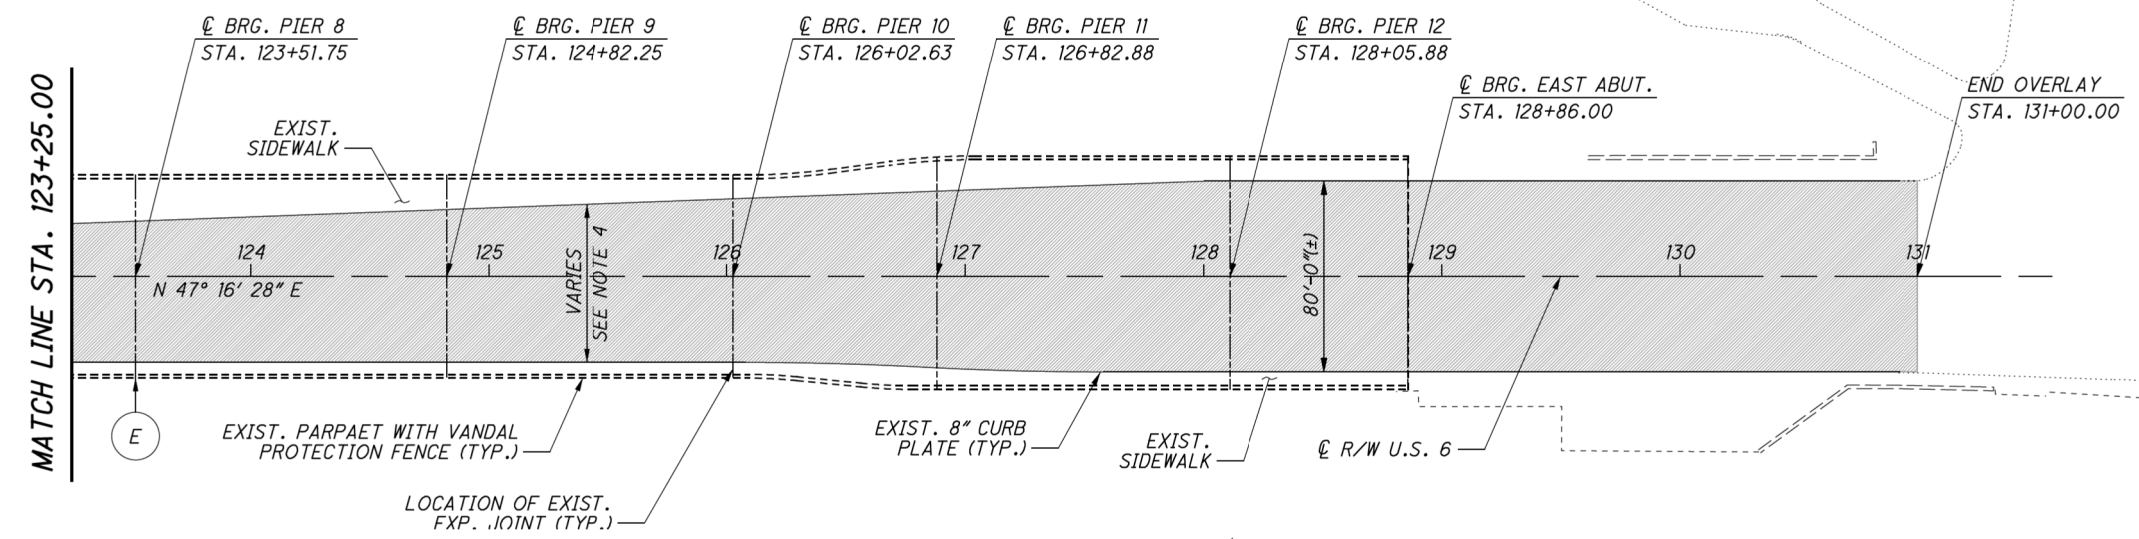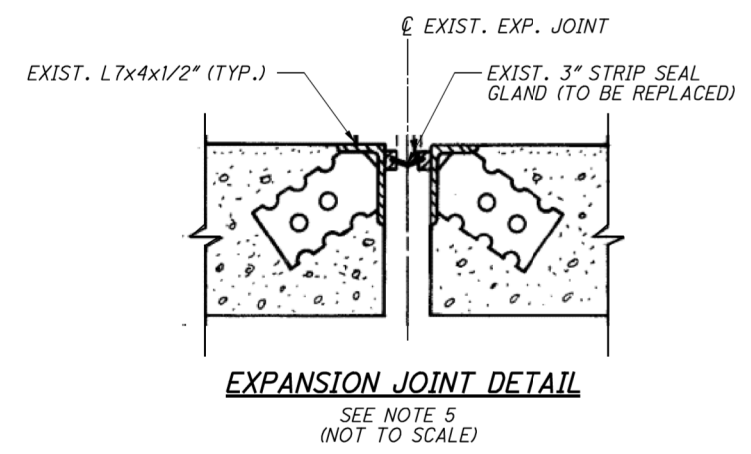

PLAN

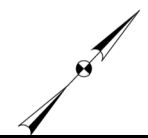

|                                |           |                                |                                                                            |                                                                      |             |
|--------------------------------|-----------|--------------------------------|----------------------------------------------------------------------------|----------------------------------------------------------------------|-------------|
| GRAPHIC SCALE MEASURED IN FEET | DATE      |                                | 9902 Carver Road<br>Suite 201<br>Cincinnati, OH 45242<br>PH.: 614.699.5000 | DETROIT-SUPERIOR BRIDGE OVER CUYAHOGA RIVER<br>BRIDGE NO. CUY-6-1465 | PAGE<br>A-6 |
| NOT TO SCALE                   | NOV, 2018 | INFRASTRUCTURE ENGINEERS, INC. |                                                                            | UPPER DECK PLAN - 2                                                  |             |

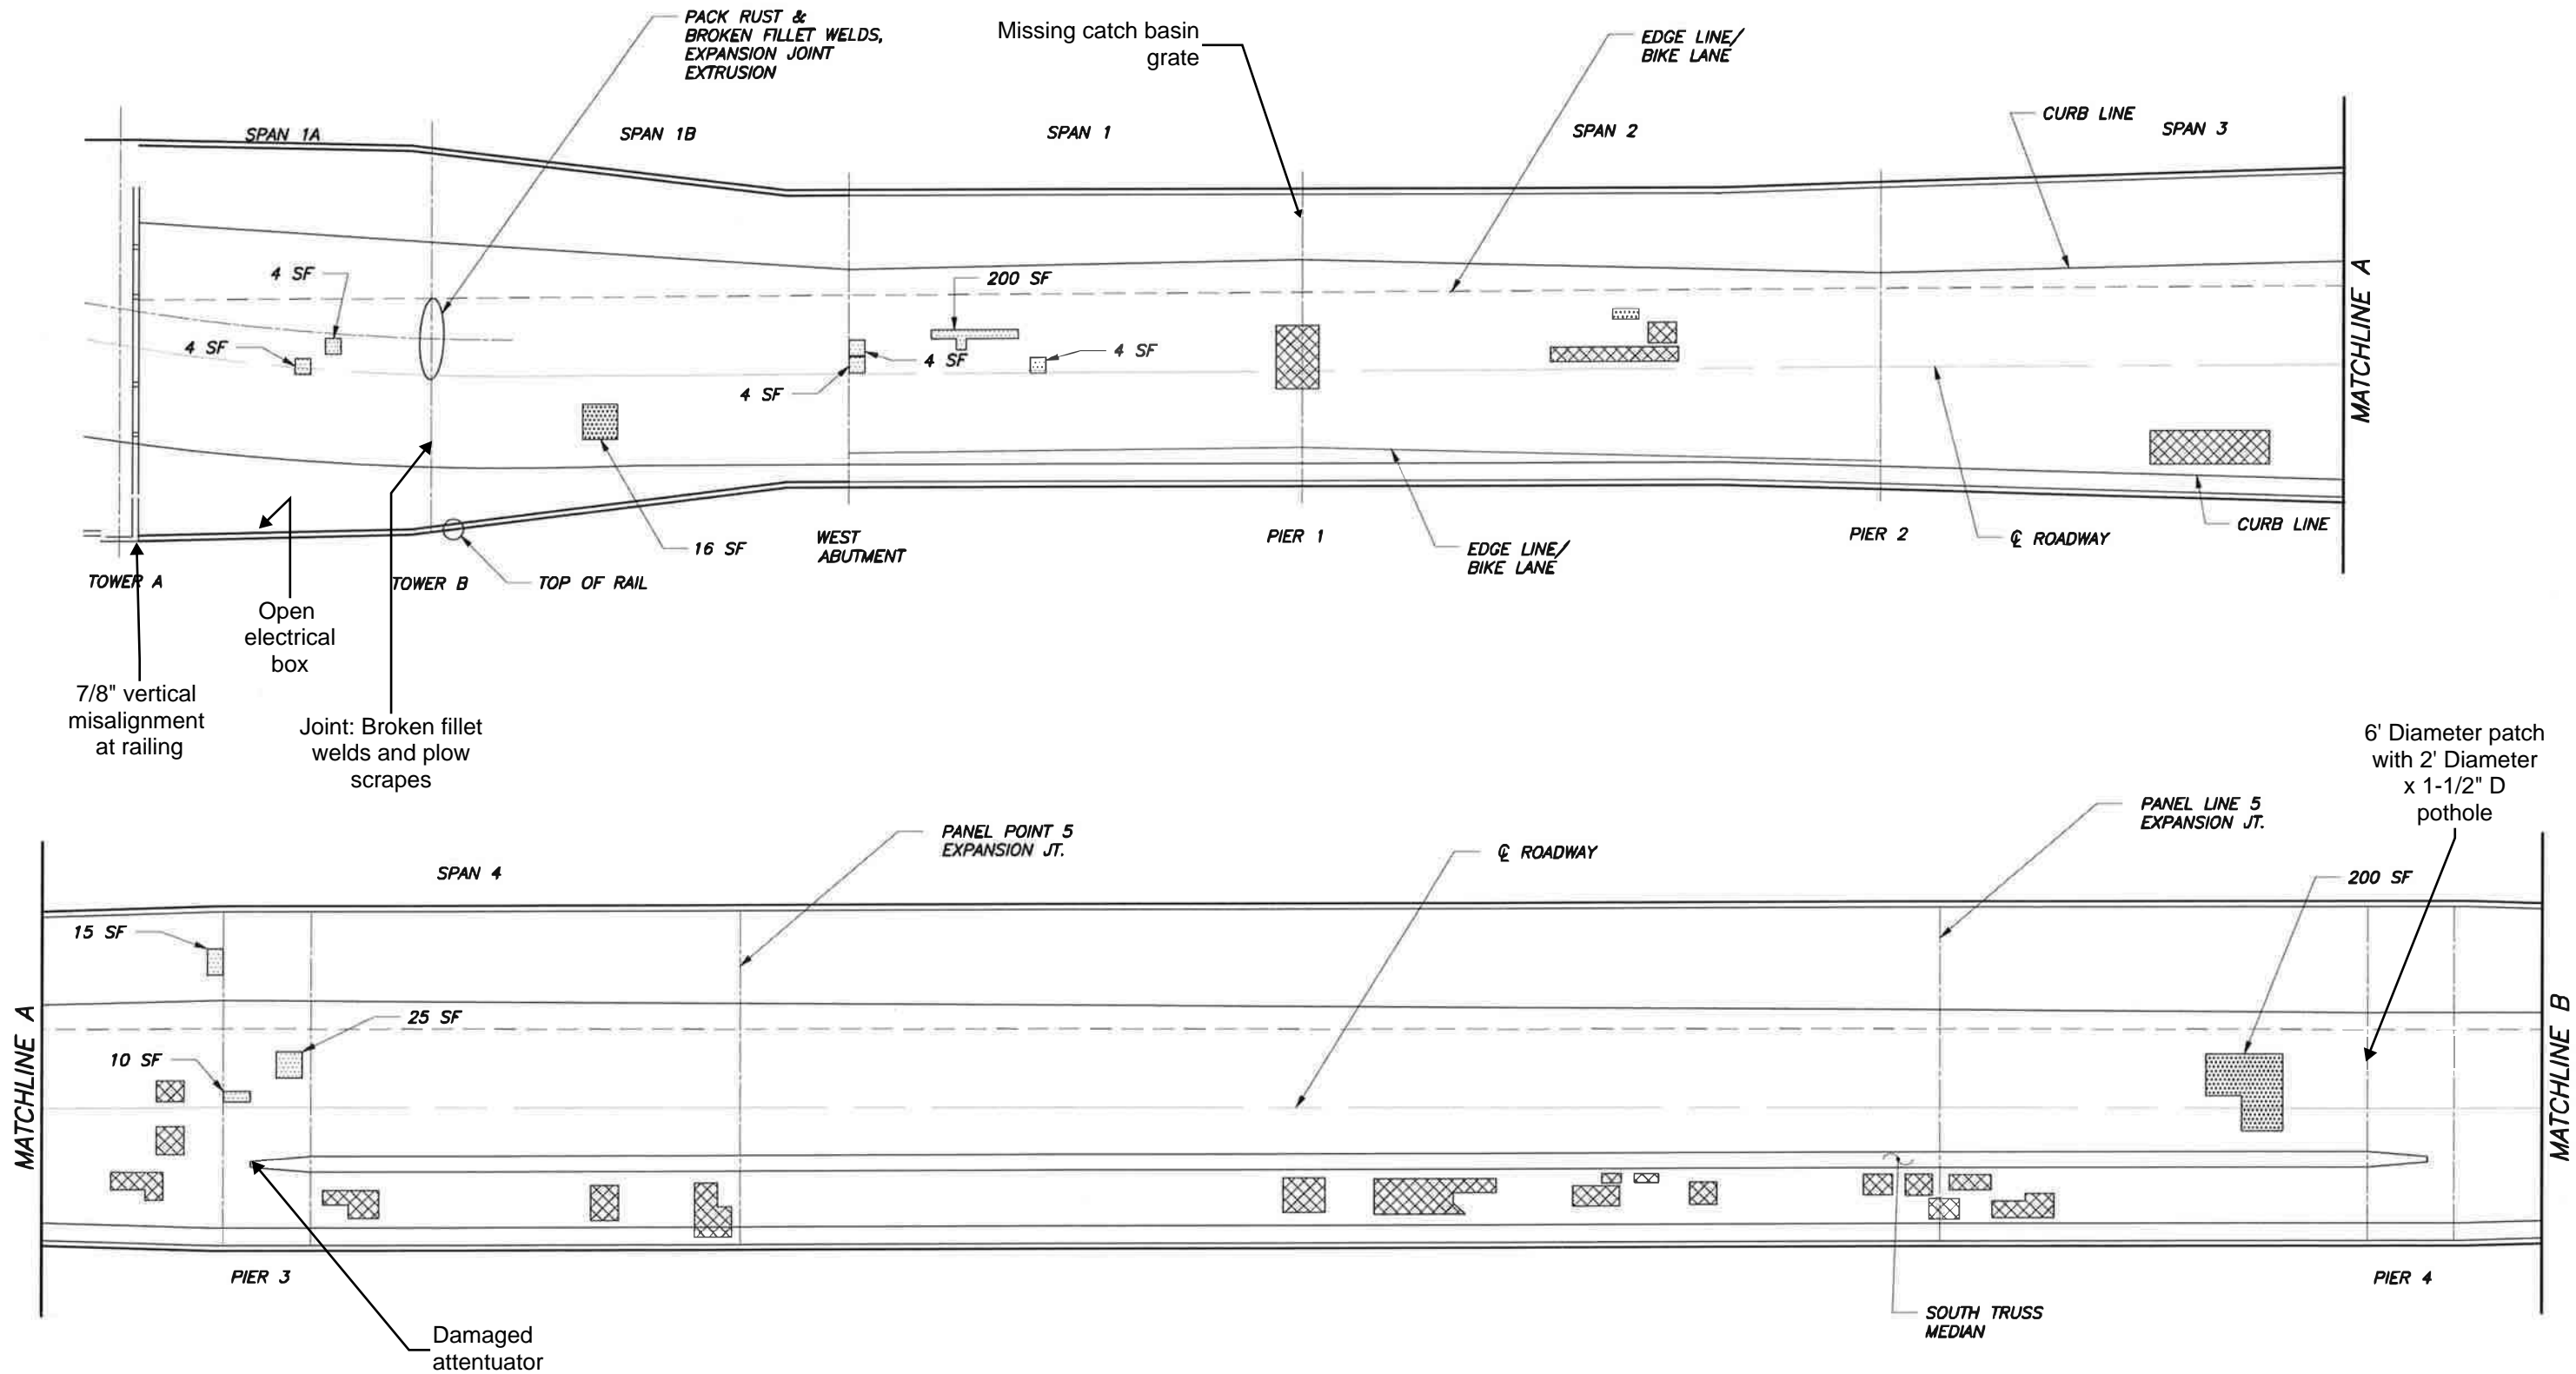

**General Notes:**

- Map cracking throughout wearing surface.
- Heavy cracking and patching throughout wearing surface. This is more prominent in the eastbound lanes.
- Joints are typically filled with debris and have edge spalls along the joint armor.
- Heavy efflorescence, cracking, delaminations, and spalls with corroded reinforcing throughout all members and underside of deck.

**LEGEND**


- DELAMINATED CONCRETE WEARING SURFACE WITH ESTIMATED AREA
- PATCHED WEARING SURFACE NOVEMBER 2015
- PREVIOUS WEARING SURFACE REPAIR

GRAPHIC SCALE MEASURED IN FEET

NOT TO SCALE

DATE



NOV, 2017

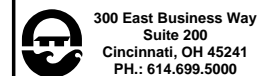



INFRASTRUCTURE ENGINEERS, INC.

DETROIT-SUPERIOR BRIDGE OVER CUYAHOGA RIVER  
BRIDGE NO. CUY-6-1456

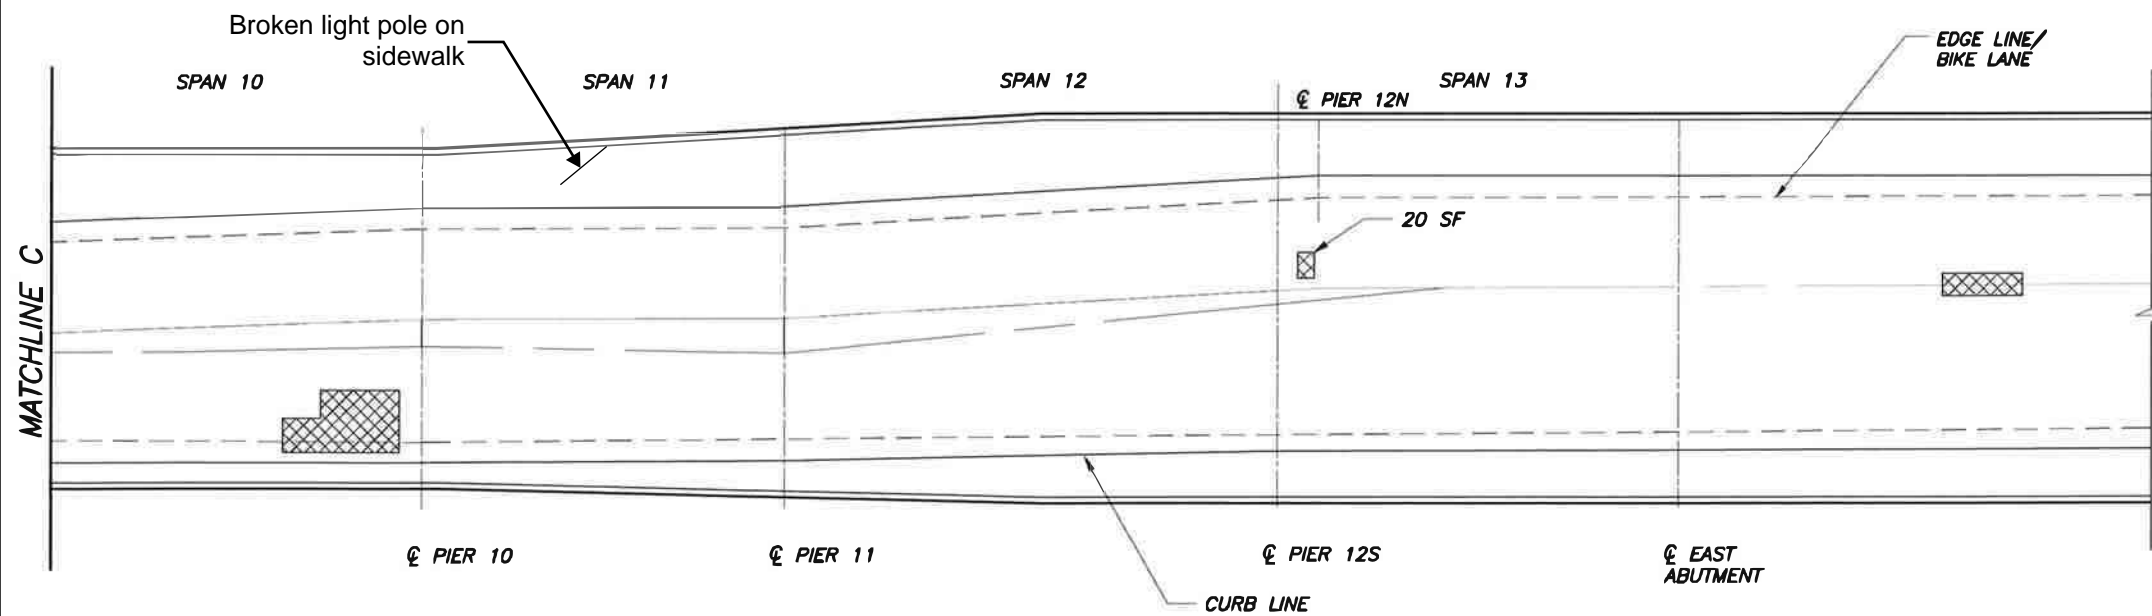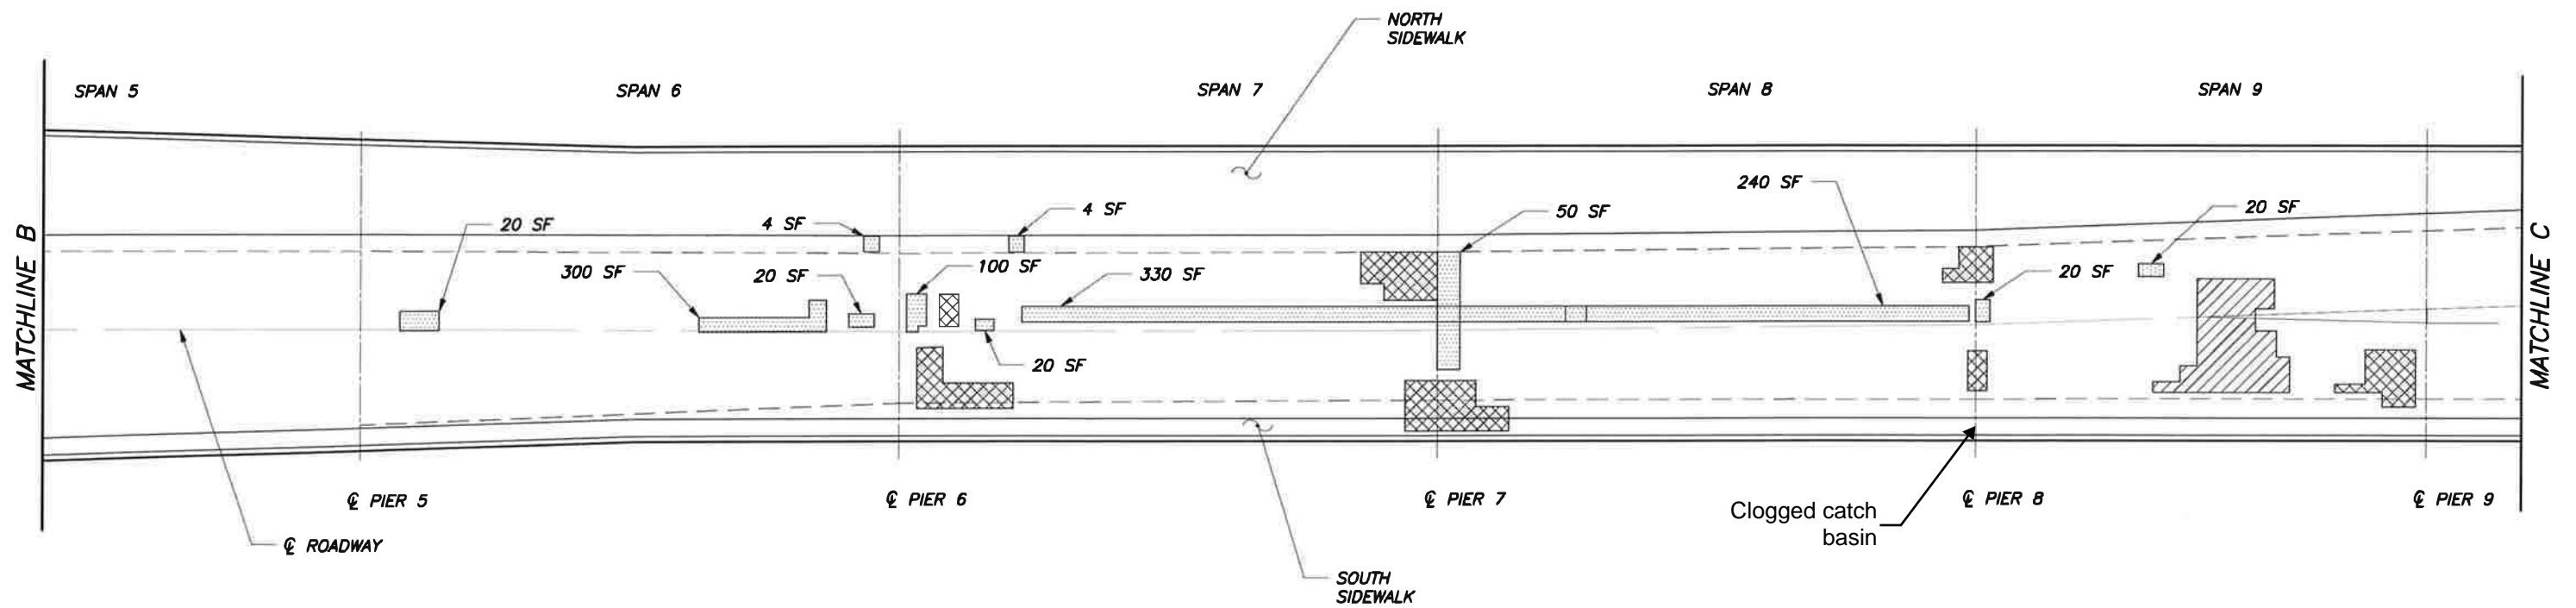DECK PLAN - SPAN 1A TO SPAN 5




**LEGEND**




-  DELAMINATED CONCRETE WEARING SURFACE
-  WEARING SURFACE PATCH 2015
-  PREVIOUSLY PATCH WORN

**General Notes:**


- Map cracking throughout wearing surface.
- Heavy cracking and patching throughout wearing surface. This is more prominent in the eastbound lanes.
- Joints are typically filled with debris and have edge spalls along the joint armor.
- Heavy efflorescence, cracking, delaminations, and spalls with corroded reinforcing throughout all members and underside of deck.
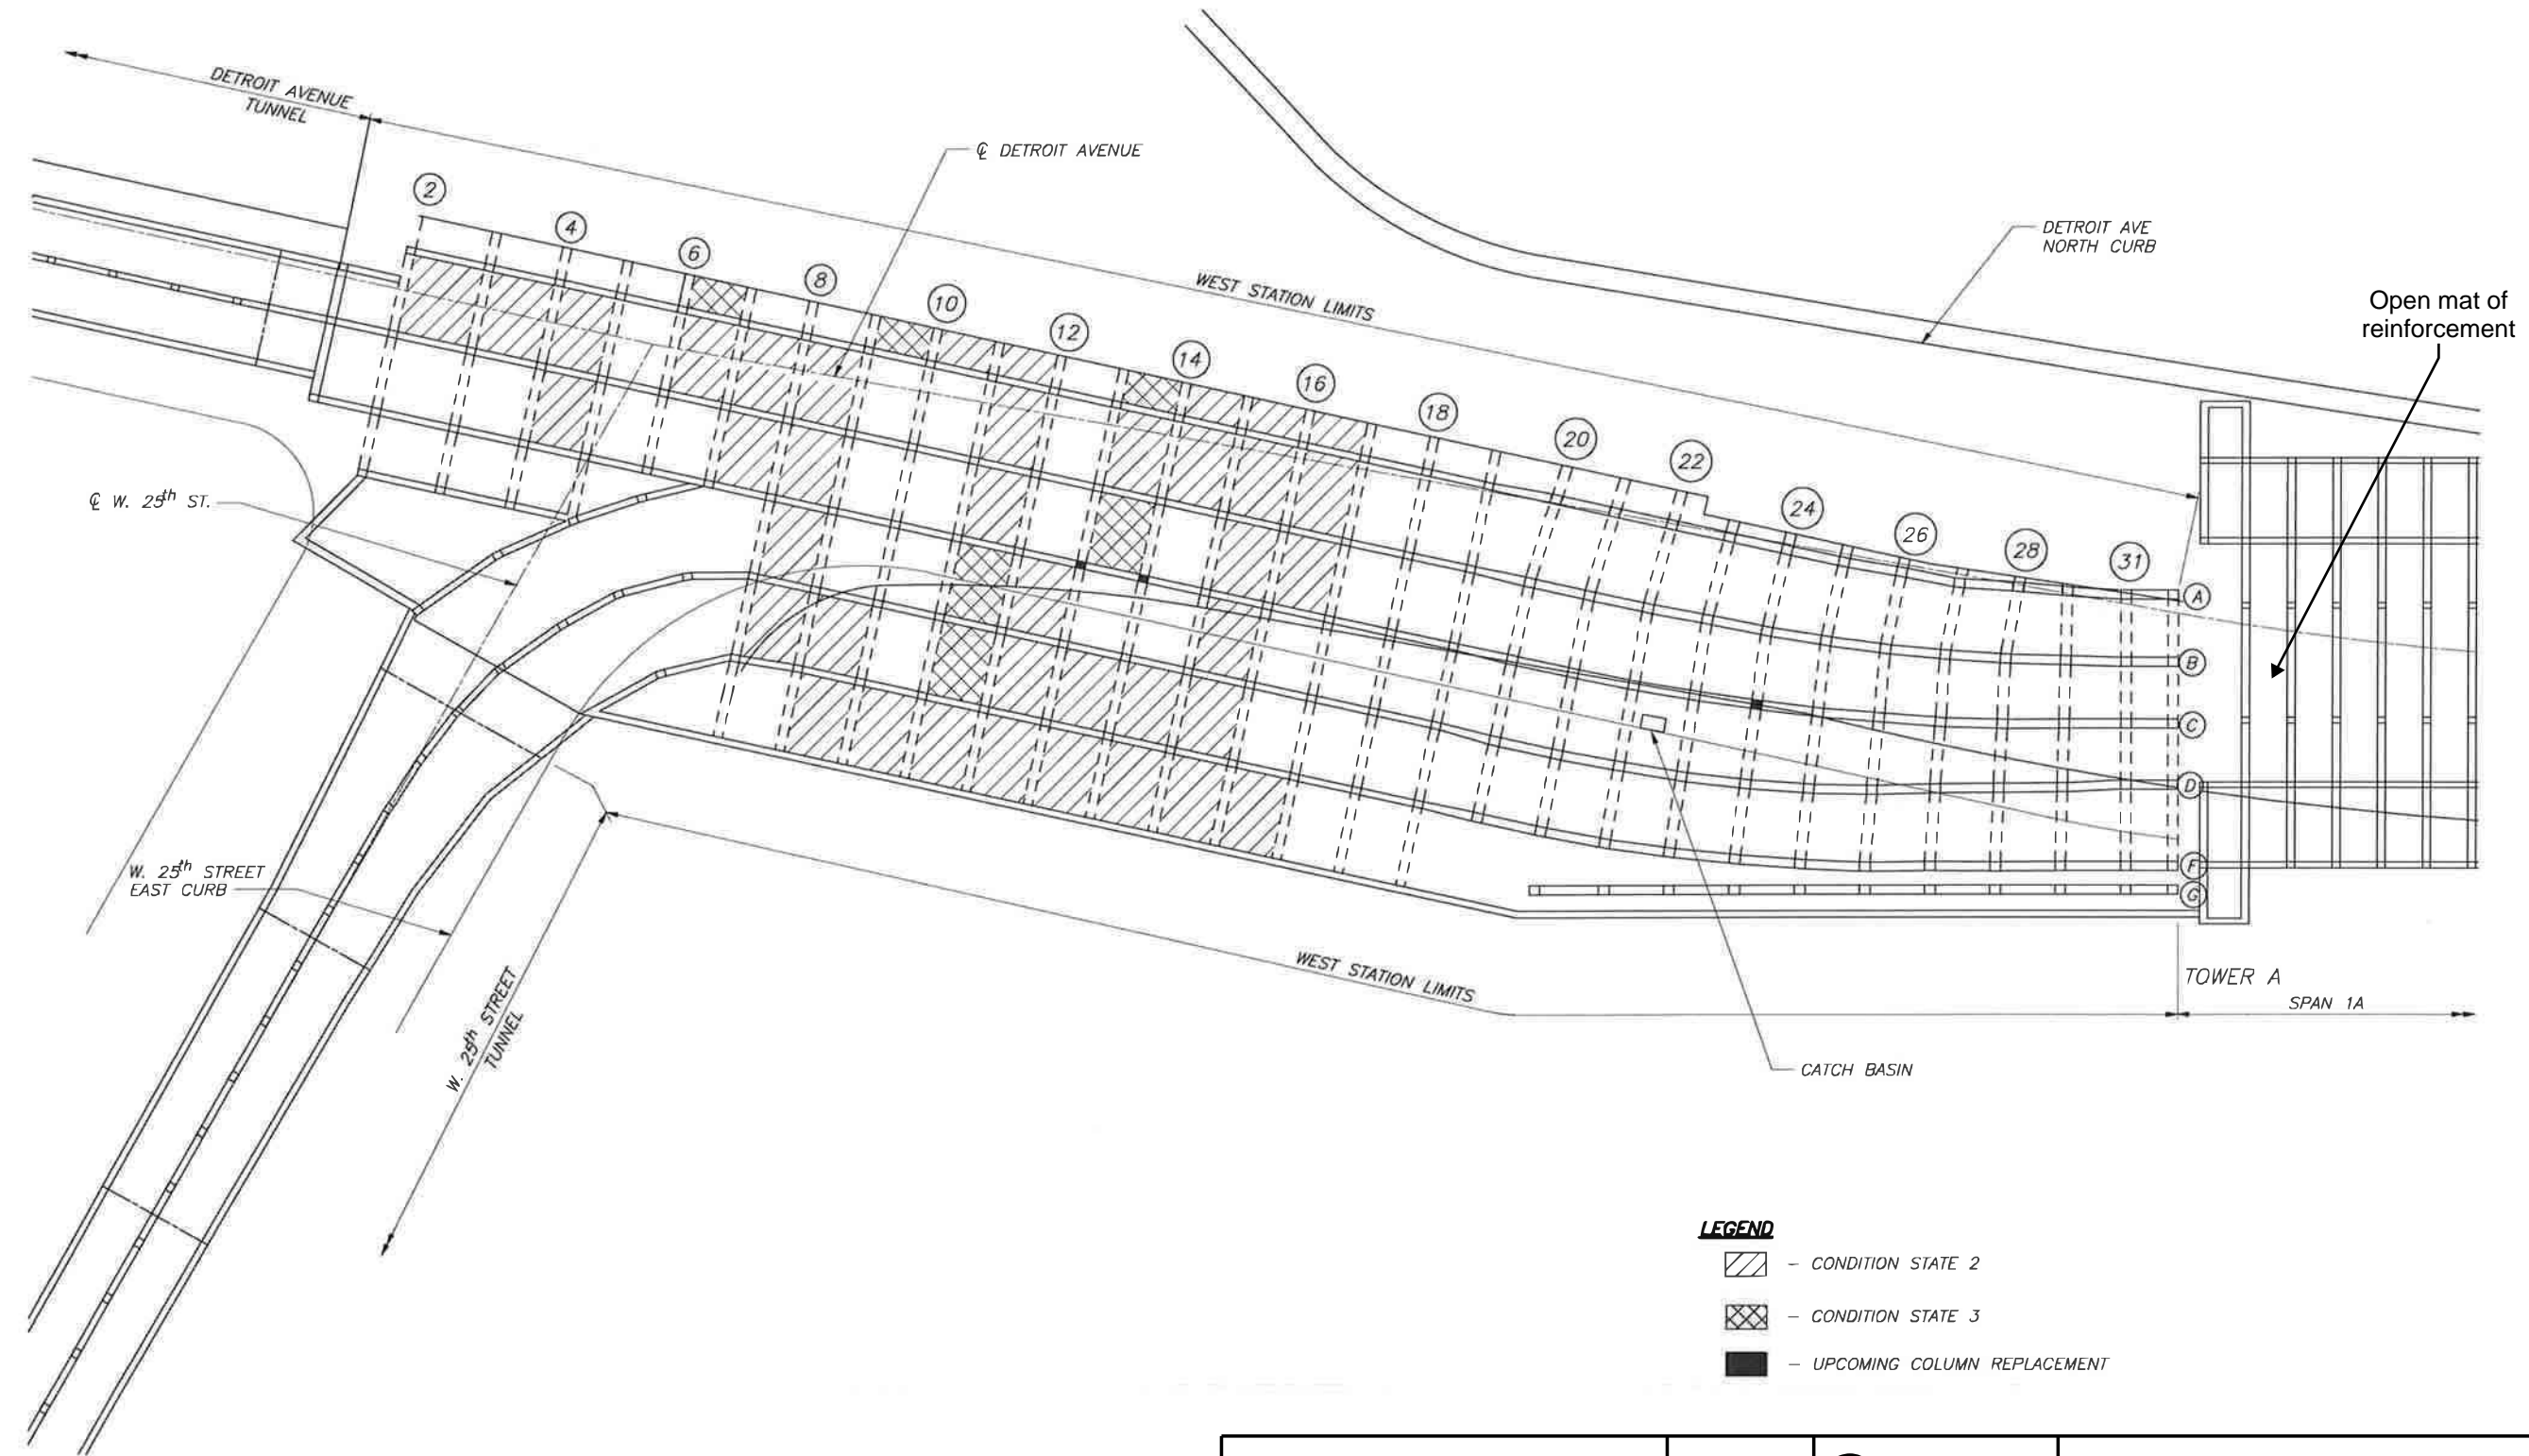
|                                |           |                                                                                                                                                                       |                                                                      |                                     |
|--------------------------------|-----------|-----------------------------------------------------------------------------------------------------------------------------------------------------------------------|----------------------------------------------------------------------|-------------------------------------|
| GRAPHIC SCALE MEASURED IN FEET | DATE      |  300 East Business Way<br>Suite 200<br>Cincinnati, OH 45241<br>PH.: 614.699.5000 | DETROIT-SUPERIOR BRIDGE OVER CUYAHOGA RIVER<br>BRIDGE NO. CUY-6-1456 |                                     |
|                                | NOV, 2017 |                                                                                                                                                                       | INFRASTRUCTURE ENGINEERS, INC.                                       | DECK PLAN - SPAN 5 TO EAST APPROACH |
| NOT TO SCALE                   |           |                                                                                                                                                                       |                                                                      |                                     |




- LEGEND**
-  - CONDITION STATE 2
  -  - CONDITION STATE 3
  -  - UPCOMING COLUMN REPLACEMENT

|                                |           |                                                                                                                                                                       |                                                                      |                   |
|--------------------------------|-----------|-----------------------------------------------------------------------------------------------------------------------------------------------------------------------|----------------------------------------------------------------------|-------------------|
| GRAPHIC SCALE MEASURED IN FEET | DATE      |  300 East Business Way<br>Suite 200<br>Cincinnati, OH 45241<br>PH.: 614.699.5000 | DETROIT-SUPERIOR BRIDGE OVER CUYAHOGA RIVER<br>BRIDGE NO. CUY-6-1456 |                   |
| NOT TO SCALE                   | NOV, 2017 |                                                                                                                                                                       | INFRASTRUCTURE<br>ENGINEERS, INC.                                    | WEST STATION PLAN |

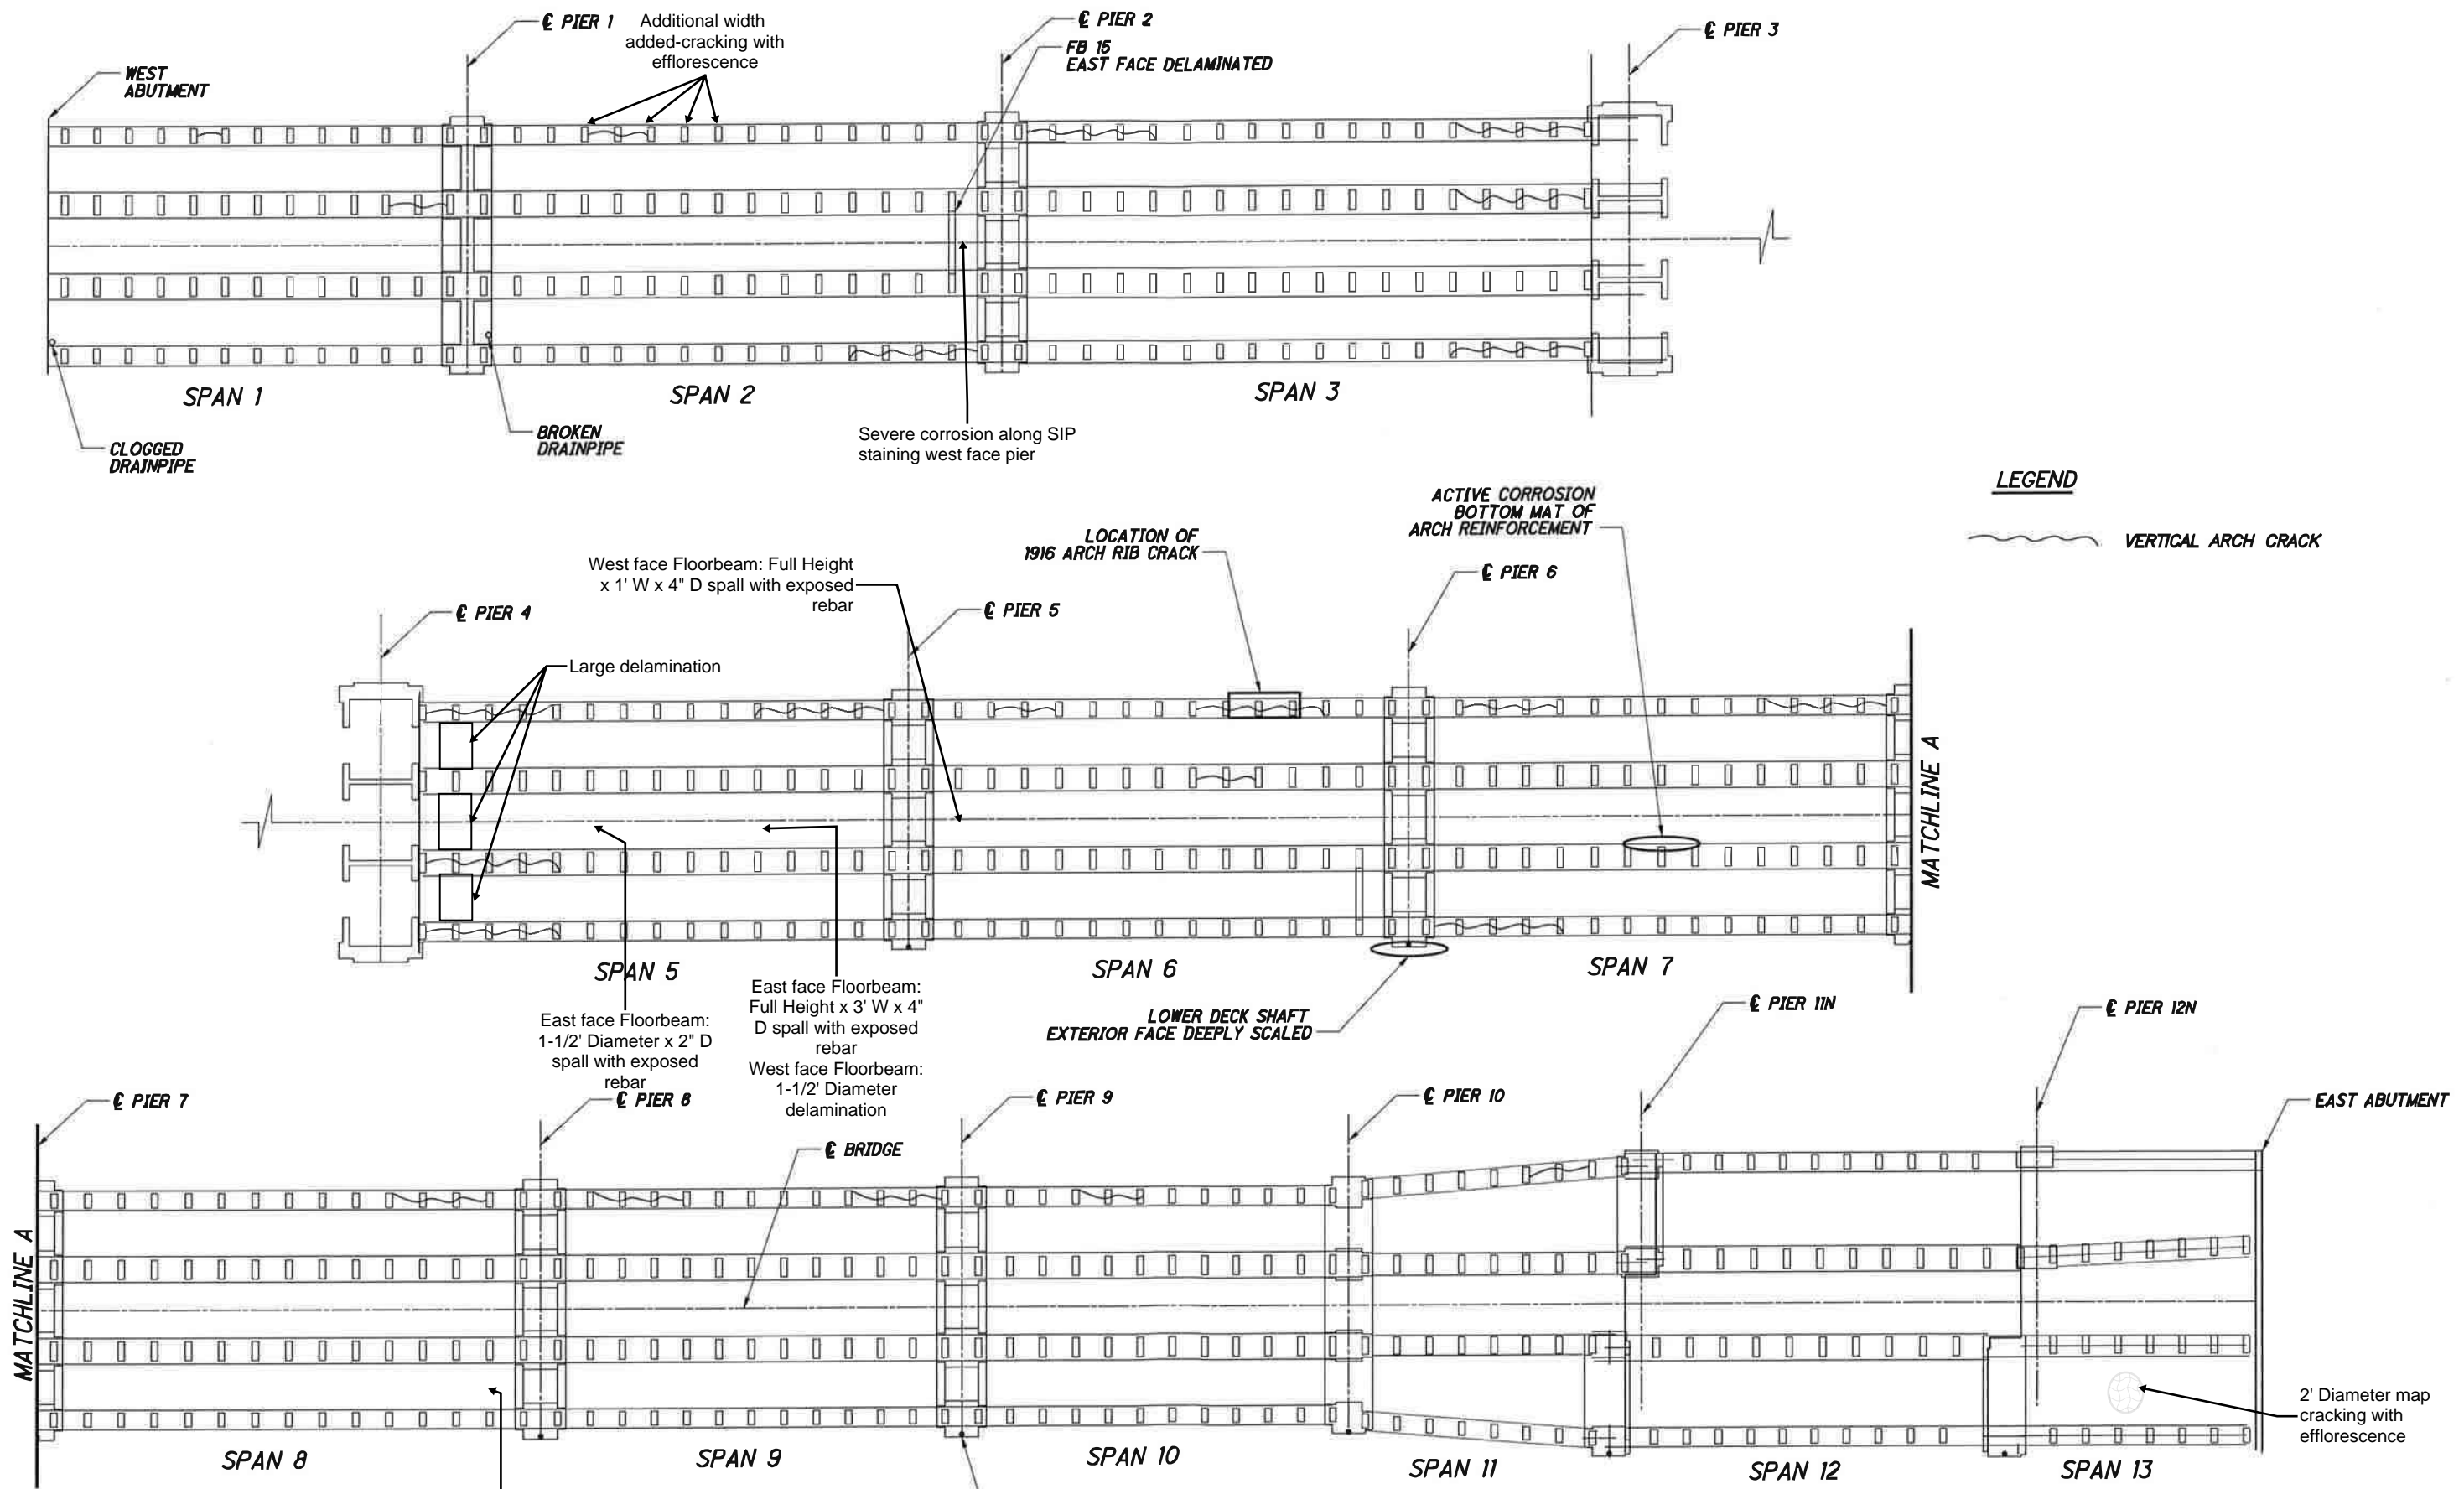

**LEGEND**  
 VERTICAL ARCH CRACK


|                                |           |                                                                                                                                                                       |                                                                      |                                |
|--------------------------------|-----------|-----------------------------------------------------------------------------------------------------------------------------------------------------------------------|----------------------------------------------------------------------|--------------------------------|
| GRAPHIC SCALE MEASURED IN FEET | DATE      |  300 East Business Way<br>Suite 200<br>Cincinnati, OH 45241<br>PH.: 614.699.5000 | DETROIT-SUPERIOR BRIDGE OVER CUYAHOGA RIVER<br>BRIDGE NO. CUY-6-1456 |                                |
|                                | NOV, 2017 |                                                                                                                                                                       | INFRASTRUCTURE ENGINEERS, INC.                                       | UNDERSIDE OF UPPER DECK - PLAN |
| NOT TO SCALE                   |           |                                                                                                                                                                       |                                                                      |                                |

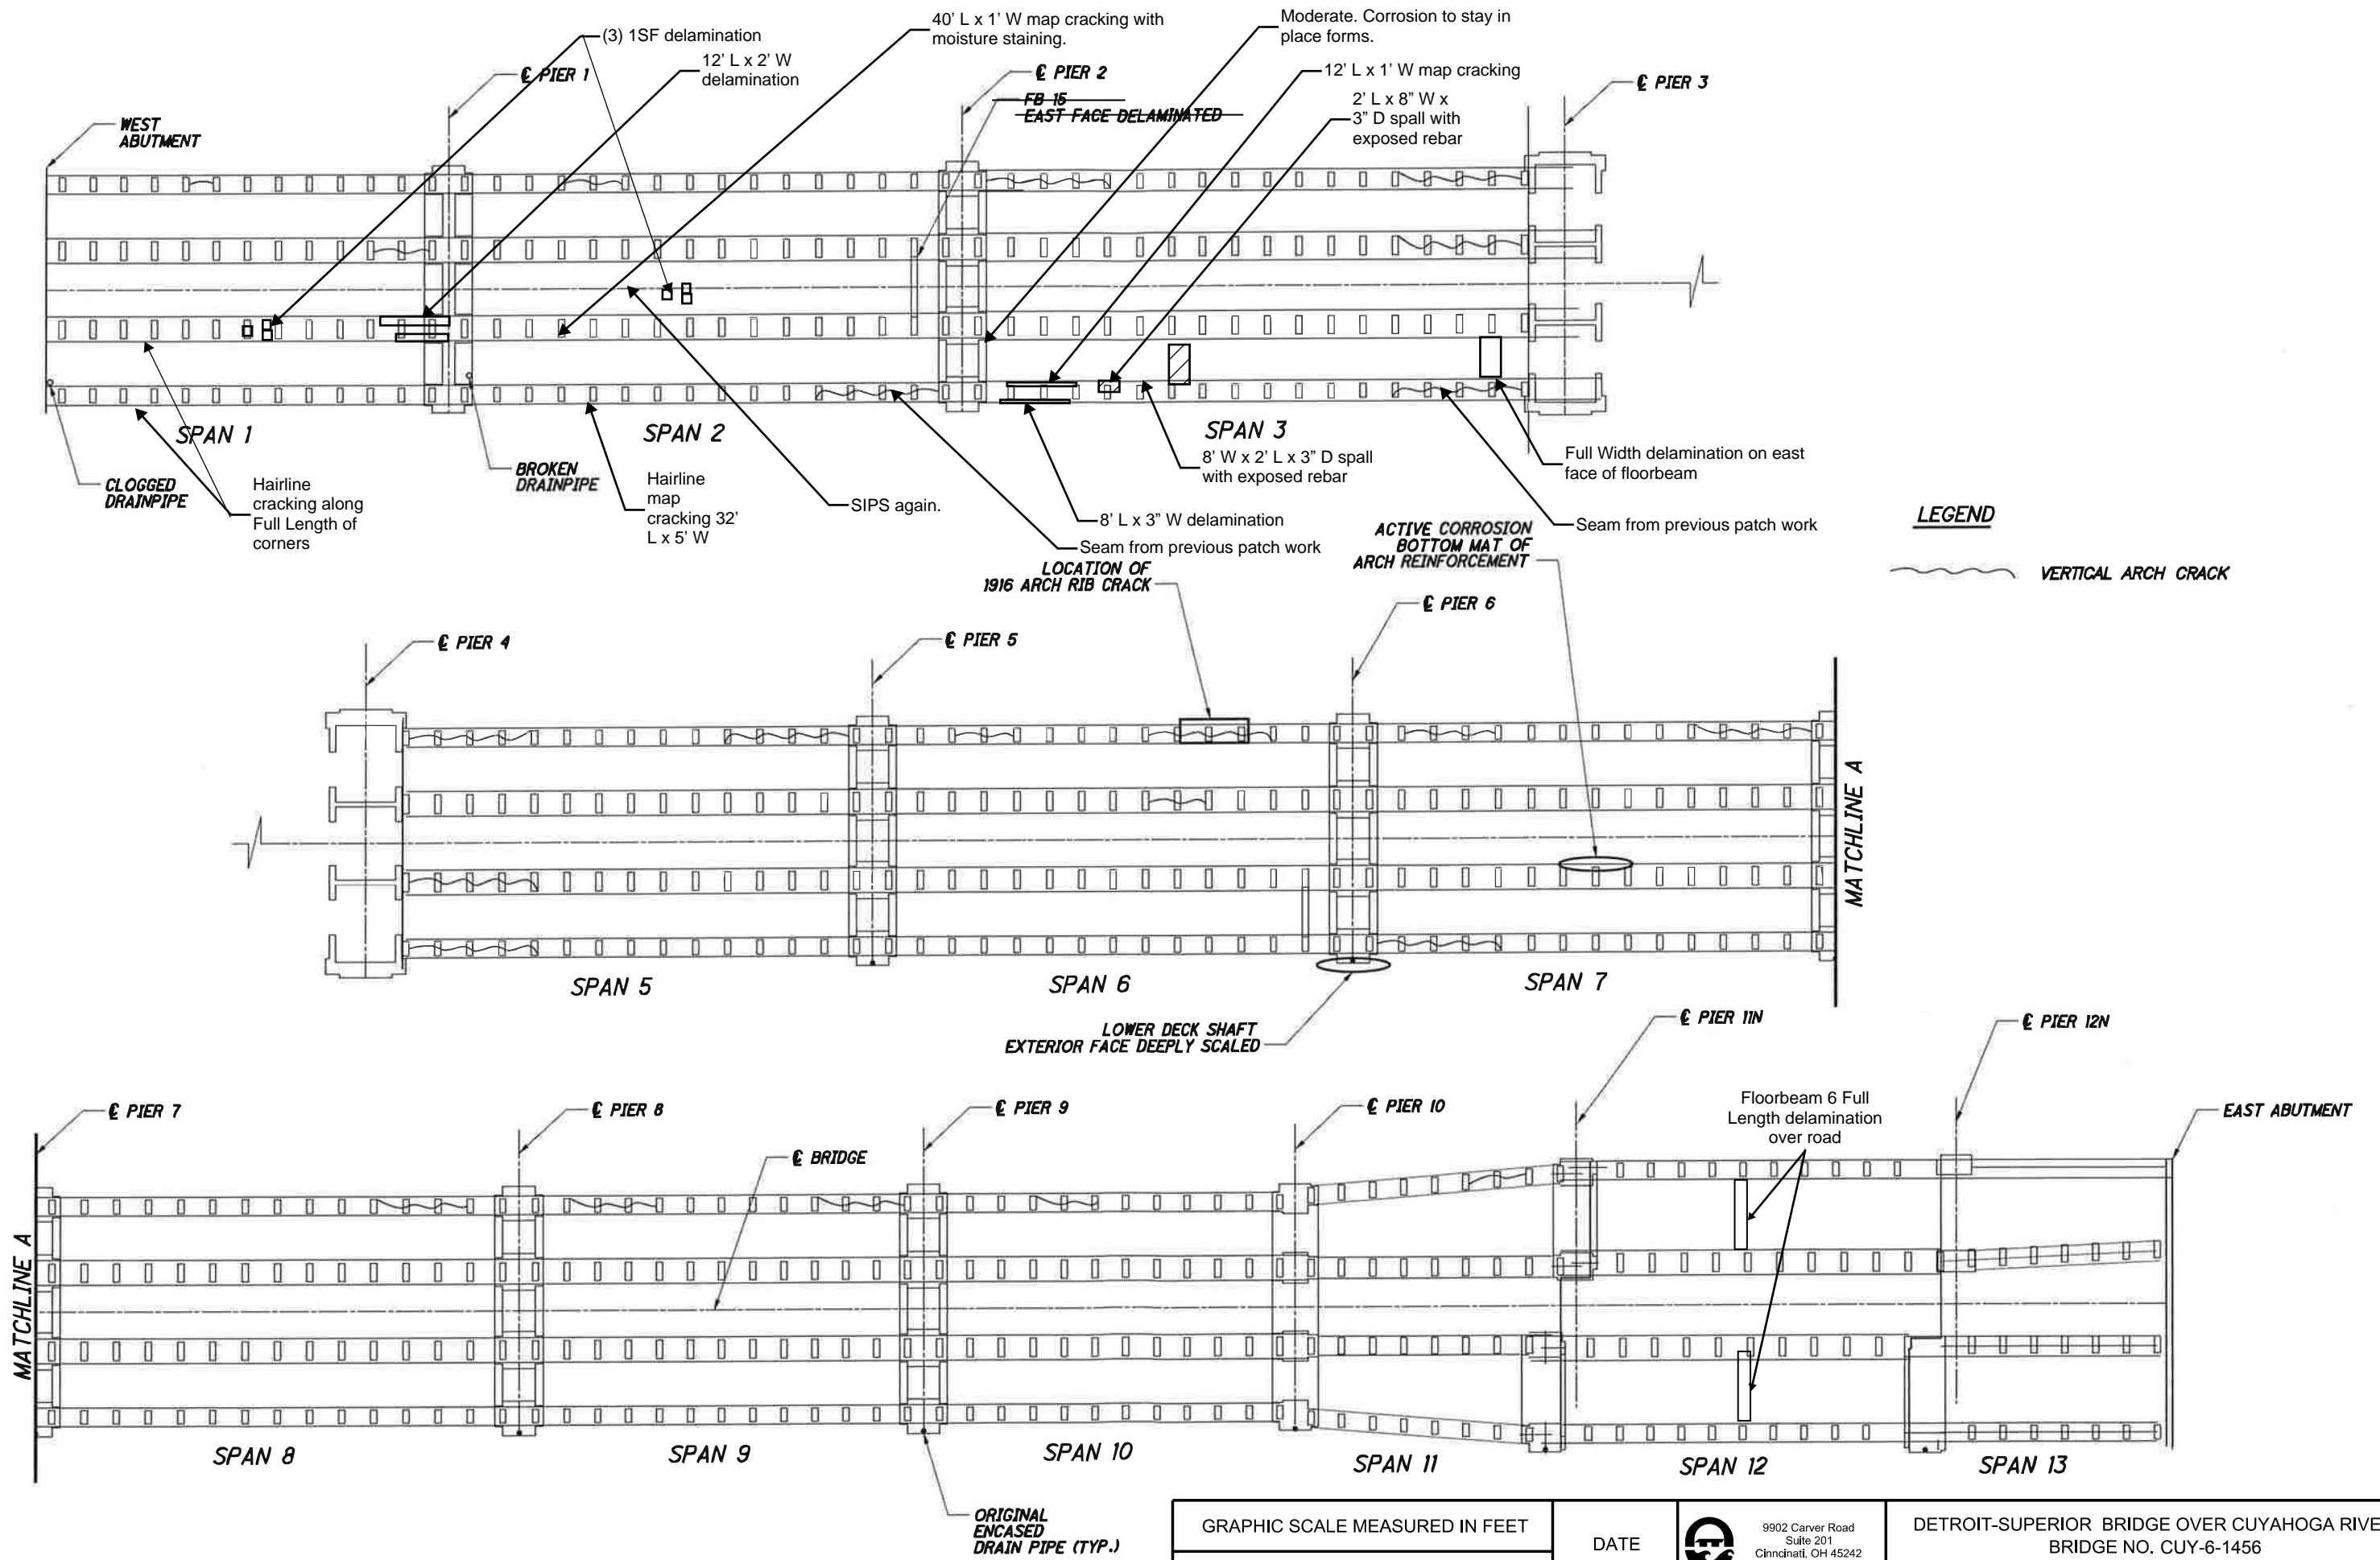


**LEGEND**

~~~~~ VERTICAL ARCH CRACK


| | | | | |
|--------------------------------|-----------|--|--|--------------------------------|
| GRAPHIC SCALE MEASURED IN FEET | DATE |  9902 Carver Road
Suite 201
Cincinnati, OH 45242
PH.: 614.699.5000 | DETROIT-SUPERIOR BRIDGE OVER CUYAHOGA RIVER
BRIDGE NO. CUY-6-1456 | |
| | NOV, 2018 | | INFRASTRUCTURE ENGINEERS, INC. | UNDERSIDE OF LOWER DECK - PLAN |
| NOT TO SCALE | | | | |

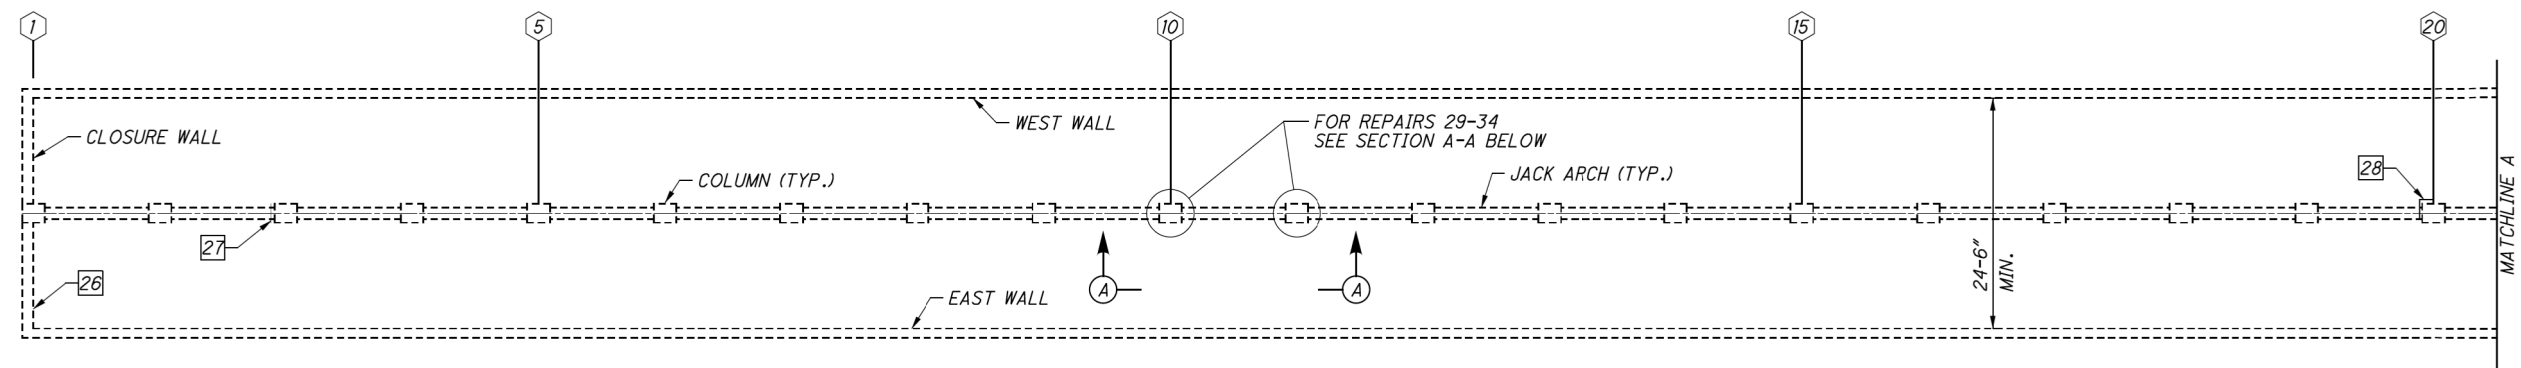

WEST 25TH STREET TUNNEL - PLAN

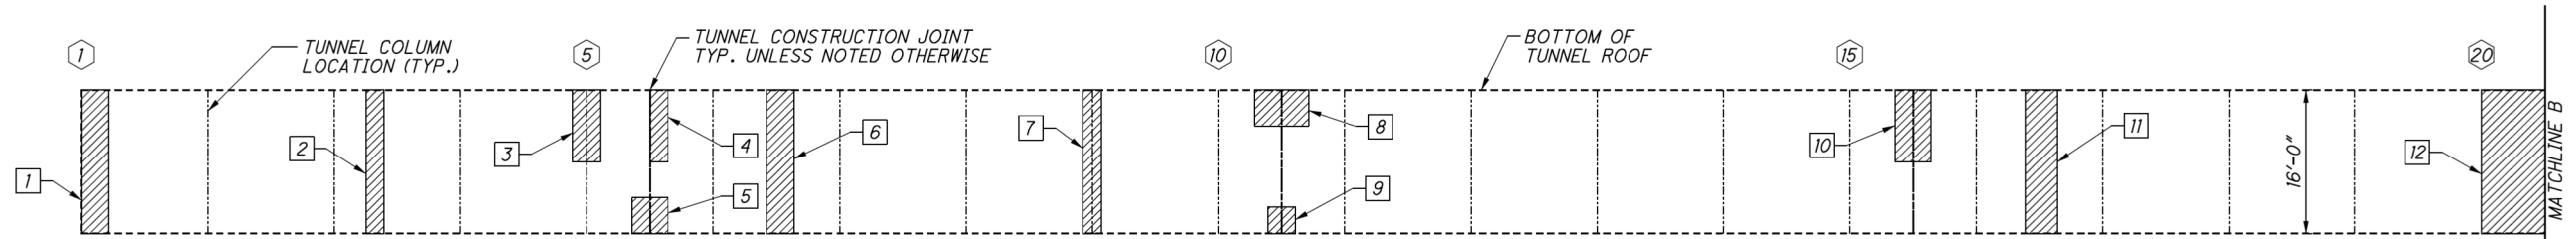

**WEST WALL
LOOKING WEST**

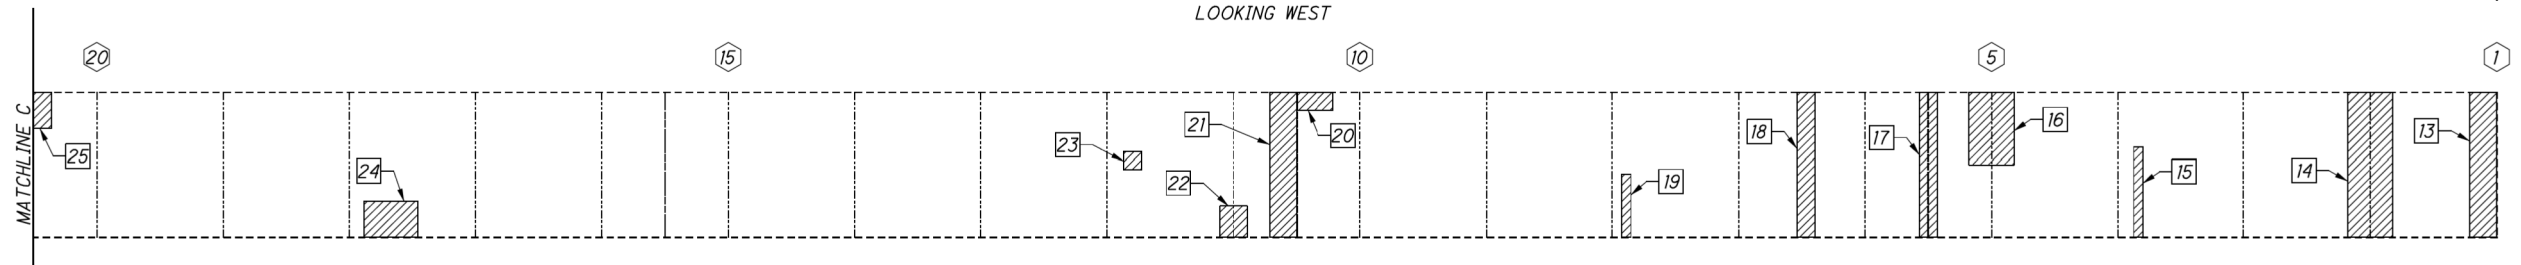


**EAST WALL
LOOKING EAST**

| ESTIMATED PATCHING QUANTITIES | | | |
|-------------------------------|-------------|-----------|------------------|
| REPAIR No. | REPAIR TYPE | AREA (SF) | ANODE QUANTITY** |
| 1 | TYPE 1 | 48 | 24 |
| 2 | TYPE 1 | 32 | 12 |
| 3 | TYPE 1 | 24 | 12 |
| 4 | TYPE 1 | 16 | 6 |
| 5 | TYPE 1 | 16 | 8 |
| 6 | TYPE 1 | 48 | 24 |
| 7 | TYPE 1 | 32 | 12 |
| 8 | TYPE 1 | 24 | 10 |
| 9 | TYPE 1 | 9 | 4 |
| 10 | TYPE 1 | 32 | 14 |
| 11 | TYPE 1 | 56 | 24 |
| 12 | TYPE 1 | 144 | 34 |
| 13 | TYPE 1 | 48 | 24 |
| 14 | TYPE 1 | 80 | 28 |
| 15 | TYPE 1 | 10 | 7 |
| 16 | TYPE 1 | 40 | 16 |
| 17 | TYPE 1 | 32 | 12 |
| 18 | TYPE 1 | 32 | 12 |
| 19 | TYPE 1 | 7 | 5 |
| 20 | TYPE 1 | 8 | 3 |
| 21 | TYPE 1 | 48 | 24 |
| 22 | TYPE 1 | 11 | 4 |

| ESTIMATED PATCHING QUANTITIES | | | |
|-------------------------------|-------------|-----------|------------------|
| REPAIR No. | REPAIR TYPE | AREA (SF) | ANODE QUANTITY** |
| 23 | TYPE 1 | 4 | - |
| 24 | TYPE 1 | 24 | 10 |
| 25 | TYPE 1 | 16 | 8 |
| 26 | TYPE 1 | 100 | 24 |
| 27 | TYPE 1 | 4 | 4 |
| 28 | TYPE 1 | 6 | 6 |
| 29 | TYPE 1 | 13 | 12 |
| 30 | TYPE 2 | 5 | 3 |
| 31 | TYPE 1 | 21 | 18 |
| 32 | TYPE 1 | 6 | 6 |
| 33 | TYPE 2 | 7 | 4 |
| 34 | TYPE 1 | 10 | 8 |
| MEASURED QUANTITY* | | 1013 | - |
| PLAN QUANTITY* | | 1520 | 422 |

* SEE NOTES 1 & 2
** SEE NOTE 3

| SHEET QUANTITY SUMMARY | | |
|------------------------|------|----------|
| ITEM | UNIT | QUANTITY |
| TYPE 1 REPAIR | SF | 1502 |
| TYPE 2 REPAIR | SF | 18 |

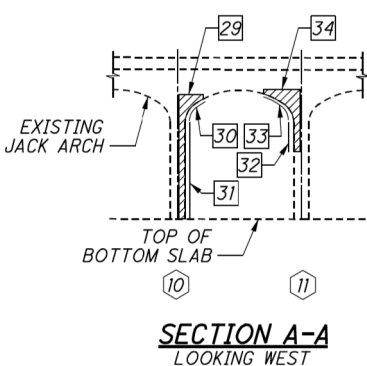

**SECTION A-A
LOOKING WEST**

NOTES:


- MEASURED QUANTITIES ARE BASED ON THE INSPECTION PERFORMED IN JANUARY 2017. THE EXACT DIMENSIONS AND LOCATIONS OF PATCHES SHALL BE DETERMINED BY THE ENGINEER IN THE FIELD FOR FINAL PAY QUANTITY.
- PLAN QUANTITIES INCLUDE 50% CONTINGENCY ADDED TO MEASURED QUANTITIES.
- ANODES ARE INCLUDED FOR PAYMENT WITH ITEM SPECIAL - PATCHING CONCRETE STRUCTURE, TYPE 1 OR 2 REPAIR.
- FOR DETAILS AND MAXIMUM GRID SPACING FOR THE EMBEDDED GALVANIC ANODES, SEE SHEET 84/89.
- EPOXY-URETHANE SEALER SHALL NOT BE APPLIED TO PATCHED OR REPLACED CONCRETE SURFACES.
- DETERIORATED CONCRETE SURFACES WITHIN THREE FEET OF THE TUNNEL FLOOR SHALL NOT BE REPAIRED UNLESS ASSOCIATED WITH A REPAIR ABOVE THIS HEIGHT OR AS NOTED ON THIS SHEET.

LEGEND:


- # TUNNEL COLUMN NUMBER
- # REPAIR NUMBER
- [Hatched Box] LOCATION OF DEFICIENT CONCRETE TO BE REPAIRED IN ACCORDANCE WITH ITEM SPECIAL - PATCHING CONCRETE STRUCTURE, TYPE 1 REPAIR
- [Dashed Box] LOCATION OF DEFICIENT CONCRETE ON PERPENDICULAR FACE (NOT VISIBLE IN ELEVATION VIEW) TO BE REPAIRED IN ACCORDANCE WITH ITEM SPECIAL - PATCHING CONCRETE STRUCTURE, TYPE 1 OR TYPE 2 REPAIR

| | | | | |
|--|-----------|--|--|--|
| GRAPHIC SCALE MEASURED IN FEET


NOT TO SCALE | DATE |  9902 Carver Road
Suite 201
Cincinnati, OH 45242
PH.: 614.699.5000 | DETROIT-SUPERIOR BRIDGE OVER CUYAHOGA RIVER
BRIDGE NO. CUY-6-1465 | |
| | NOV, 2018 | | INFRASTRUCTURE ENGINEERS, INC. | WEST 25TH ST TUNNEL CONC. REPAIR DETAILS |

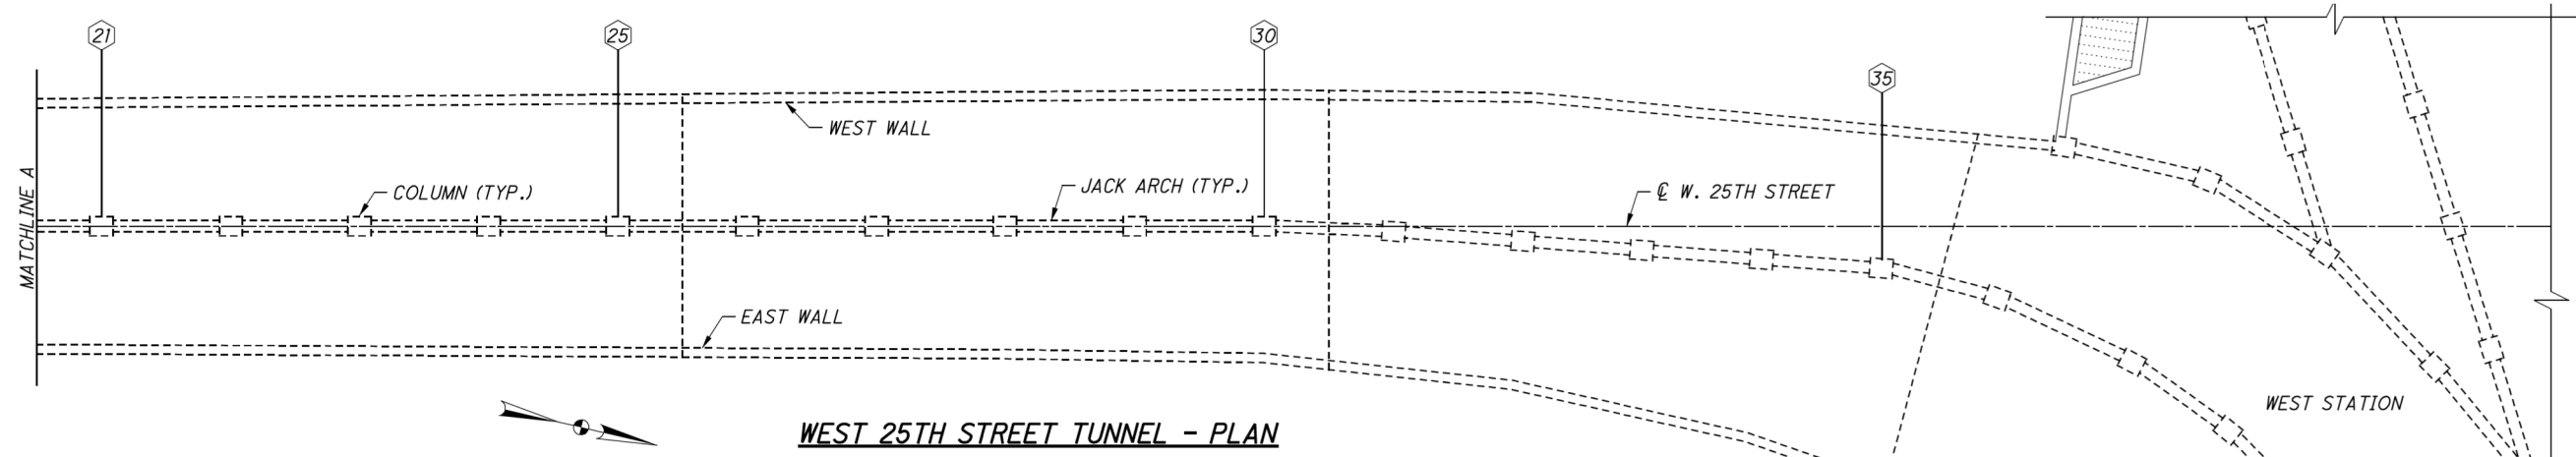

WEST 25TH STREET TUNNEL - PLAN

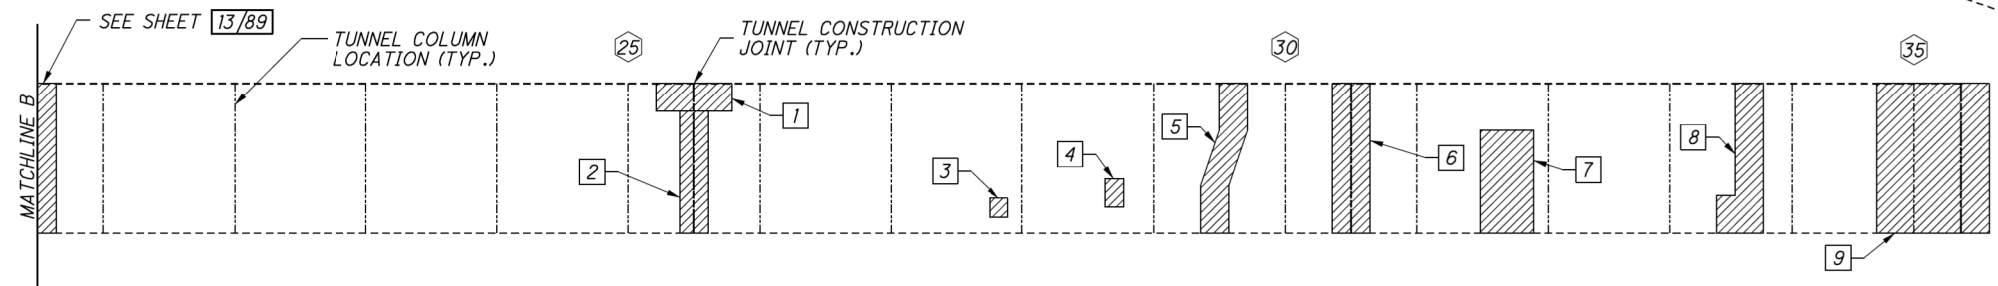

**WEST WALL
LOOKING WEST**

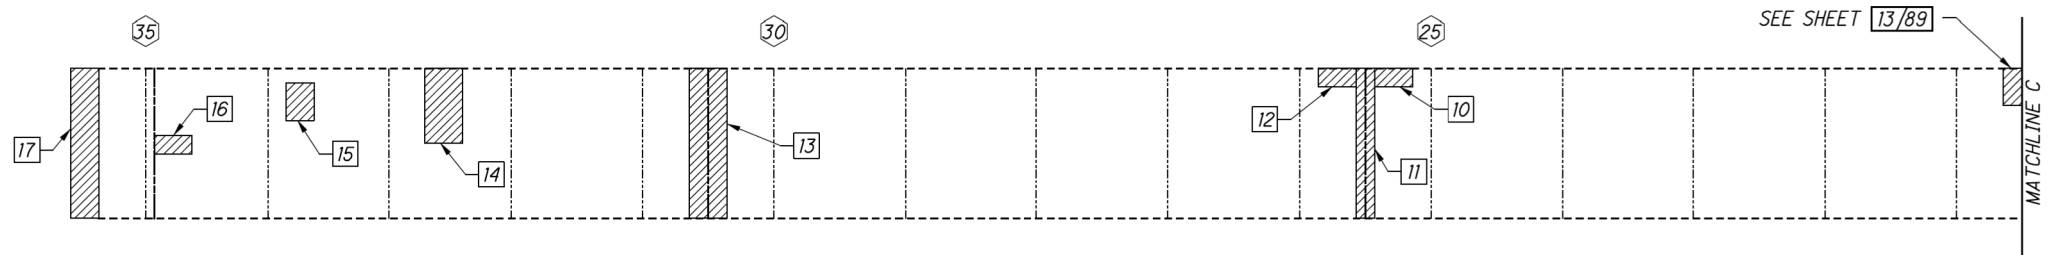

**EAST WALL
LOOKING EAST**

| ESTIMATED PATCHING QUANTITIES | | | |
|-------------------------------|-------------|-----------|------------------|
| REPAIR No. | REPAIR TYPE | AREA (SF) | ANODE QUANTITY** |
| 1 | TYPE 1 | 25 | 12 |
| 2 | TYPE 1 | 40 | 20 |
| 3 | TYPE 1 | 4 | - |
| 4 | TYPE 1 | 6 | 2 |
| 5 | TYPE 1 | 48 | 24 |
| 6 | TYPE 1 | 64 | 26 |
| 7 | TYPE 1 | 63 | 20 |
| 8 | TYPE 1 | 80 | 28 |
| 9 | TYPE 1 | 272 | 44 |
| 10 | TYPE 1 | 8 | 3 |
| 11 | TYPE 1 | 32 | 12 |
| 12 | TYPE 1 | 8 | 3 |
| 13 | TYPE 1 | 64 | 26 |
| 14 | TYPE 1 | 32 | 14 |
| 15 | TYPE 1 | 12 | 6 |

| ESTIMATED PATCHING QUANTITIES | | | |
|-------------------------------|-------------|-----------|------------------|
| REPAIR No. | REPAIR TYPE | AREA (SF) | ANODE QUANTITY** |
| 16 | TYPE 1 | 8 | 3 |
| 17 | TYPE 1 | 48 | 24 |
| MEASURED QUANTITY* | | 814 | - |
| PLAN QUANTITY* | | 1221 | 267 |

* SEE NOTES 1 & 2
** SEE NOTE 3

| SHEET QUANTITY SUMMARY | | |
|------------------------|------|----------|
| ITEM | UNIT | QUANTITY |
| TYPE 1 REPAIR | SF | 1221 |
| TYPE 2 REPAIR | SF | - |


NOTES:

- MEASURED QUANTITIES ARE BASED ON THE INSPECTION PERFORMED IN JANUARY 2017. THE EXACT DIMENSIONS AND LOCATIONS OF PATCHES SHALL BE DETERMINED BY THE ENGINEER IN THE FIELD FOR FINAL PAY QUANTITY.
- PLAN QUANTITIES INCLUDE 50% CONTINGENCY ADDED TO MEASURED QUANTITIES.
- ANODES ARE INCLUDED FOR PAYMENT WITH ITEM SPECIAL - PATCHING CONCRETE STRUCTURE, TYPE 1 OR 2 REPAIR.
- FOR DETAILS AND MAXIMUM GRID SPACING FOR THE EMBEDDED GALVANIC ANODES, SEE SHEET 84/89.
- EPOXY-URETHANE SEALER SHALL NOT BE APPLIED TO PATCHED OR REPLACED CONCRETE SURFACES.
- DETERIORATED CONCRETE SURFACES WITHIN THREE FEET OF THE TUNNEL FLOOR SHALL NOT BE REPAIRED UNLESS ASSOCIATED WITH A REPAIR ABOVE THIS HEIGHT OR AS NOTED ON THIS SHEET.


LEGEND:

- # TUNNEL COLUMN NUMBER
- # REPAIR NUMBER
- ▨ LOCATION OF DEFICIENT CONCRETE TO BE REPAIRED IN ACCORDANCE WITH ITEM SPECIAL - PATCHING CONCRETE STRUCTURE, TYPE 1 REPAIR
- ▨ LOCATION OF DEFICIENT CONCRETE ON PERPINDICULAR FACE (NOT VISIBLE IN ELEVATION VIEW) TO BE REPAIRED IN ACCORDANCE WITH ITEM SPECIAL - PATCHING CONCRETE STRUCTURE, TYPE 1 OR TYPE 2 REPAIR


| | | | |
|--------------------------------|-----------|---|--|
| GRAPHIC SCALE MEASURED IN FEET | DATE | 
9902 Carver Road
Suite 201
Cincinnati, OH 45242
PH.: 614.699.5000 | DETROIT-SUPERIOR BRIDGE OVER CUYAHOGA RIVER
BRIDGE NO. CUY-6-1465 |
| NOT TO SCALE | NOV, 2018 | INFRASTRUCTURE ENGINEERS, INC. | WEST 25TH ST TUNNEL CONC. REPAIR DETAILS |
| | | | PAGE A-13 |

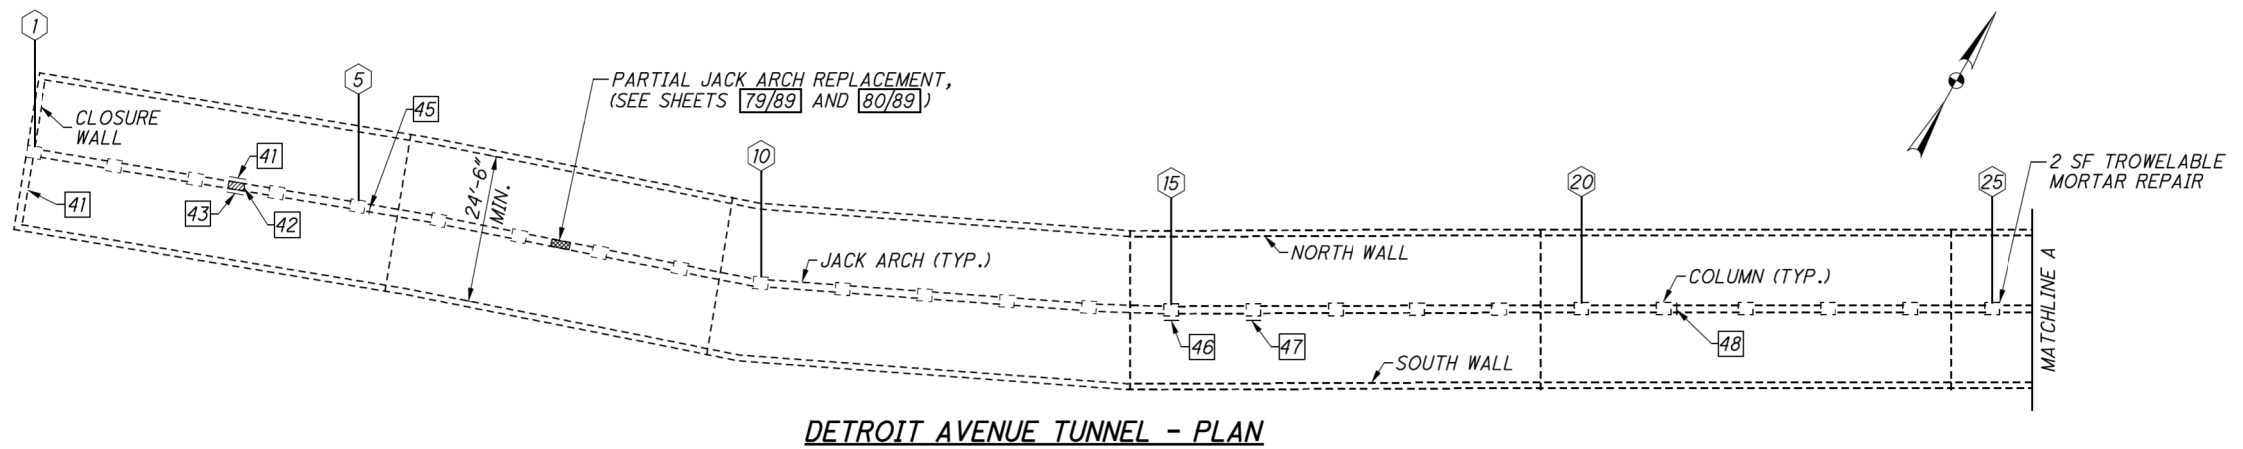

DETROIT AVENUE TUNNEL - PLAN

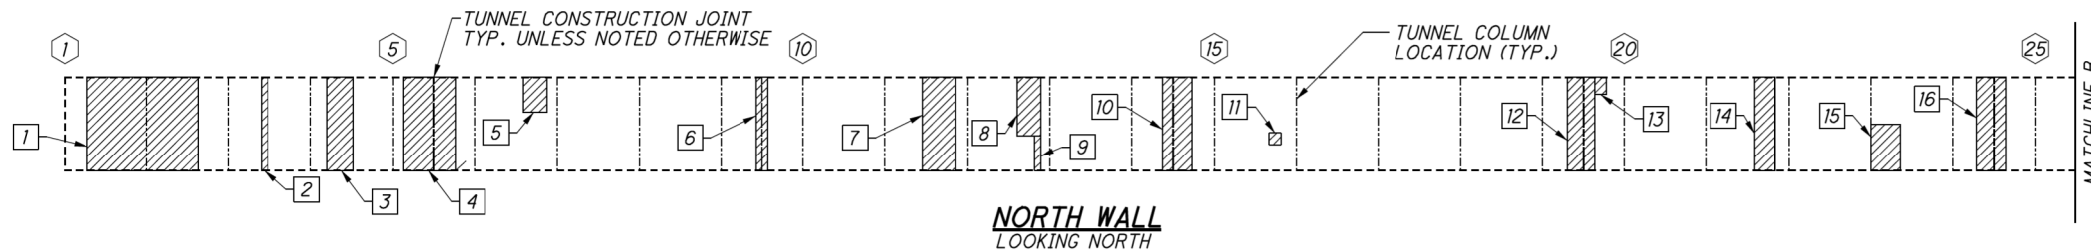

**NORTH WALL
LOOKING NORTH**

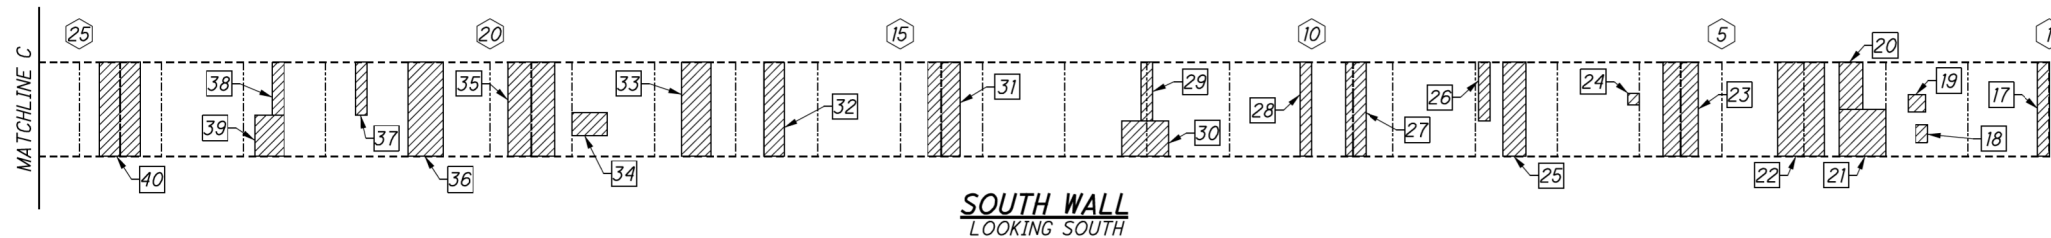

**SOUTH WALL
LOOKING SOUTH**

NOTES:

1. MEASURED QUANTITIES ARE BASED ON THE INSPECTION PERFORMED IN JANUARY 2017. THE EXACT DIMENSIONS AND LOCATIONS OF PATCHES SHALL BE DETERMINED BY THE ENGINEER IN THE FIELD FOR FINAL PAY QUANTITY.
2. PLAN QUANTITIES INCLUDE 50% CONTINGENCY ADDED TO MEASURED QUANTITIES.
3. ANODES ARE INCLUDED FOR PAYMENT WITH ITEM SPECIAL - PATCHING CONCRETE STRUCTURE, TYPE 1 OR 2 REPAIR.
4. FOR DETAILS AND MAXIMUM GRID SPACING FOR THE EMBEDDED GALVANIC ANODES, SEE SHEET 84/89.
5. EPOXY-URETHANE SEALER SHALL NOT BE APPLIED TO PATCHED OR REPLACED CONCRETE SURFACES.
6. DETERIORATED CONCRETE SURFACES WITHIN THREE FEET OF THE TUNNEL FLOOR SHALL NOT BE REPAIRED UNLESS ASSOCIATED WITH A REPAIR ABOVE THIS HEIGHT OR AS NOTED ON THIS SHEET.
7. A NEW TUNNEL ROOF WAS PREVIOUSLY CONSTRUCTED ON TOP OF THE ORIGINAL DETROIT AVENUE TUNNEL ROOF. THE CONTRACTOR SHALL REMOVE LOOSE ORIGINAL ROOF CONCRETE FROM THE BOTTOM OF THE ORIGINAL DETROIT AVENUE ROOF AS DIRECTED BY THE ENGINEER. PAYMENT SHALL BE INCLUDED AS PART OF ITEM 202 - PORTIONS OF STRUCTURE REMOVED, OVER 20-FOOT SPAN, AS PER PLAN.

LEGEND:

- # TUNNEL COLUMN NUMBER
- # REPAIR NUMBER
- [Hatched Box] LOCATION OF DEFICIENT CONCRETE TO BE REPAIRED IN ACCORDANCE WITH ITEM SPECIAL - PATCHING CONCRETE STRUCTURE, TYPE 1 OR TYPE 2 REPAIR
- [Vertical Line] LOCATION OF DEFICIENT CONCRETE ON PERPENDICULAR FACE (NOT VISIBLE IN ELEVATION VIEW) TO BE REPAIRED IN ACCORDANCE WITH ITEM SPECIAL - PATCHING CONCRETE STRUCTURE, TYPE 1 OR TYPE 2 REPAIR

| ESTIMATED PATCHING QUANTITIES | | | |
|-------------------------------|-------------|-----------|------------------|
| REPAIR No. | REPAIR TYPE | AREA (SF) | ANODE QUANTITY** |
| 1 | TYPE 1 | 304 | 48 |
| 2 | TYPE 1 | 16 | 12 |
| 3 | TYPE 1 | 72 | 26 |
| 4 | TYPE 1 | 144 | 34 |
| 5 | TYPE 1 | 24 | 10 |
| 6 | TYPE 1 | 32 | 12 |
| 7 | TYPE 1 | 88 | 28 |
| 8 | TYPE 1 | 45 | 18 |
| 9 | TYPE 1 | 6 | 4 |
| 10 | TYPE 1 | 80 | 28 |
| 11 | TYPE 1 | 4 | - |
| 12 | TYPE 1 | 76 | 26 |
| 13 | TYPE 1 | 12 | 2 |
| 14 | TYPE 1 | 56 | 24 |
| 15 | TYPE 1 | 40 | 16 |
| 16 | TYPE 1 | 84 | 28 |
| 17 | TYPE 1 | 32 | 12 |
| 18 | TYPE 1 | 6 | 2 |
| 19 | TYPE 1 | 9 | 4 |

| ESTIMATED PATCHING QUANTITIES | | | |
|-------------------------------|-------------|-----------|------------------|
| REPAIR No. | REPAIR TYPE | AREA (SF) | ANODE QUANTITY** |
| 20 | TYPE 1 | 32 | 14 |
| 21 | TYPE 1 | 64 | 20 |
| 22 | TYPE 1 | 128 | 32 |
| 23 | TYPE 1 | 96 | 28 |
| 24 | TYPE 1 | 4 | - |
| 25 | TYPE 1 | 64 | 26 |
| 26 | TYPE 1 | 21 | 7 |
| 27 | TYPE 1 | 56 | 24 |
| 28 | TYPE 1 | 32 | 12 |
| 29 | TYPE 1 | 20 | 7 |
| 30 | TYPE 1 | 48 | 16 |
| 31 | TYPE 1 | 88 | 28 |
| 32 | TYPE 1 | 56 | 24 |
| 33 | TYPE 1 | 80 | 28 |
| 34 | TYPE 1 | 24 | 10 |
| 35 | TYPE 1 | 128 | 32 |
| 36 | TYPE 1 | 96 | 28 |
| 37 | TYPE 1 | 18 | 7 |
| 38 | TYPE 1 | 18 | 7 |




| ESTIMATED PATCHING QUANTITIES | | | |
|-------------------------------|-------------|-----------|------------------|
| REPAIR No. | REPAIR TYPE | AREA (SF) | ANODE QUANTITY** |
| 39 | TYPE 1 | 35 | 14 |
| 40 | TYPE 1 | 112 | 30 |
| 41 | TYPE 1 | 36 | 12 |
| 42 | TYPE 1 | 7 | 6 |
| 43 | TYPE 2 | 7 | 6 |
| 44 | TYPE 1 | 7 | 6 |
| 45 | TYPE 1 | 13 | 12 |
| 46 | TYPE 1 | 4 | 4 |
| 47 | TYPE 1 | 6 | 6 |
| 48 | TYPE 1 | 5 | 4 |
| MEASURED QUANTITY* | | 2435 | - |
| PLAN QUANTITY* | | 3653 | 788 |

* SEE NOTES 1 & 2
** SEE NOTE 3

| SHEET QUANTITY SUMMARY | | |
|------------------------|------|----------|
| ITEM | UNIT | QUANTITY |
| TYPE 1 REPAIR | SF | 3642 |
| TYPE 2 REPAIR | SF | 11 |

| | | | |
|--|-------------------|---|--|
| GRAPHIC SCALE MEASURED IN FEET

NOT TO SCALE | DATE
NOV, 2018 | 9902 Carver Road
Suite 201
Cincinnati, OH 45242
PH.: 614.699.5000
INFRASTRUCTURE ENGINEERS, INC. | DETROIT-SUPERIOR BRIDGE OVER CUYAHOGA RIVER
BRIDGE NO. CUY-6-1465 |
| | | | DETROIT AVE TUNNEL CONC. REPAIR DETAIL |
| | | | PAGE
A-14 |

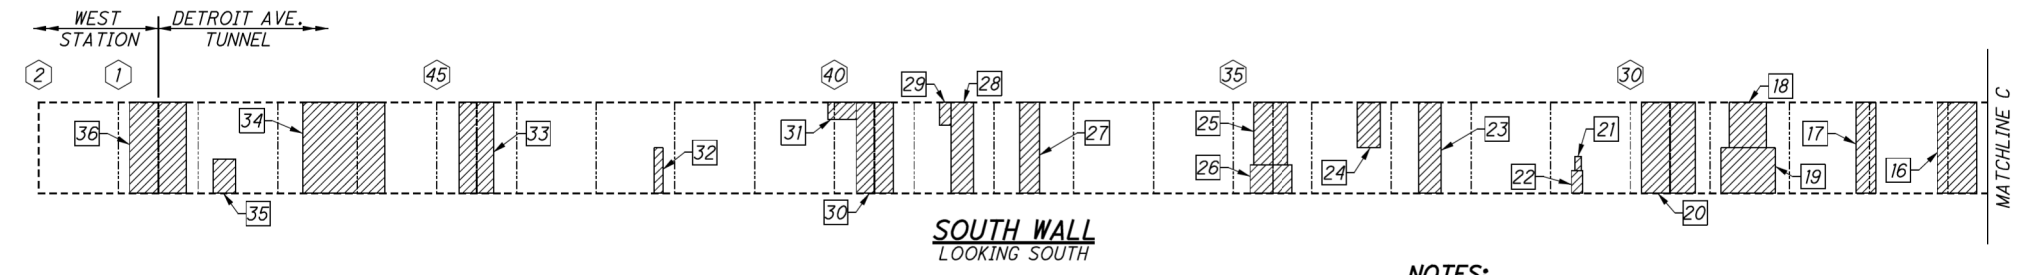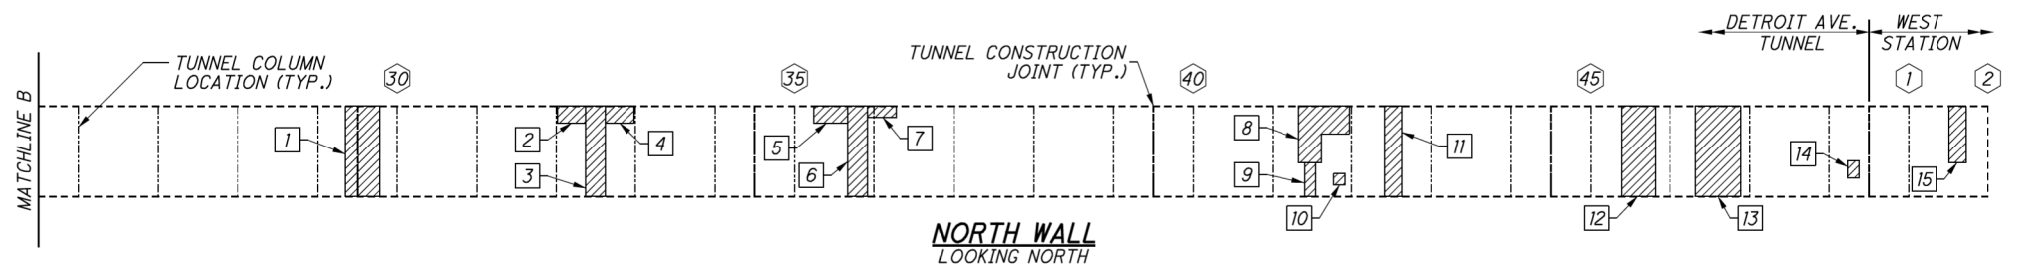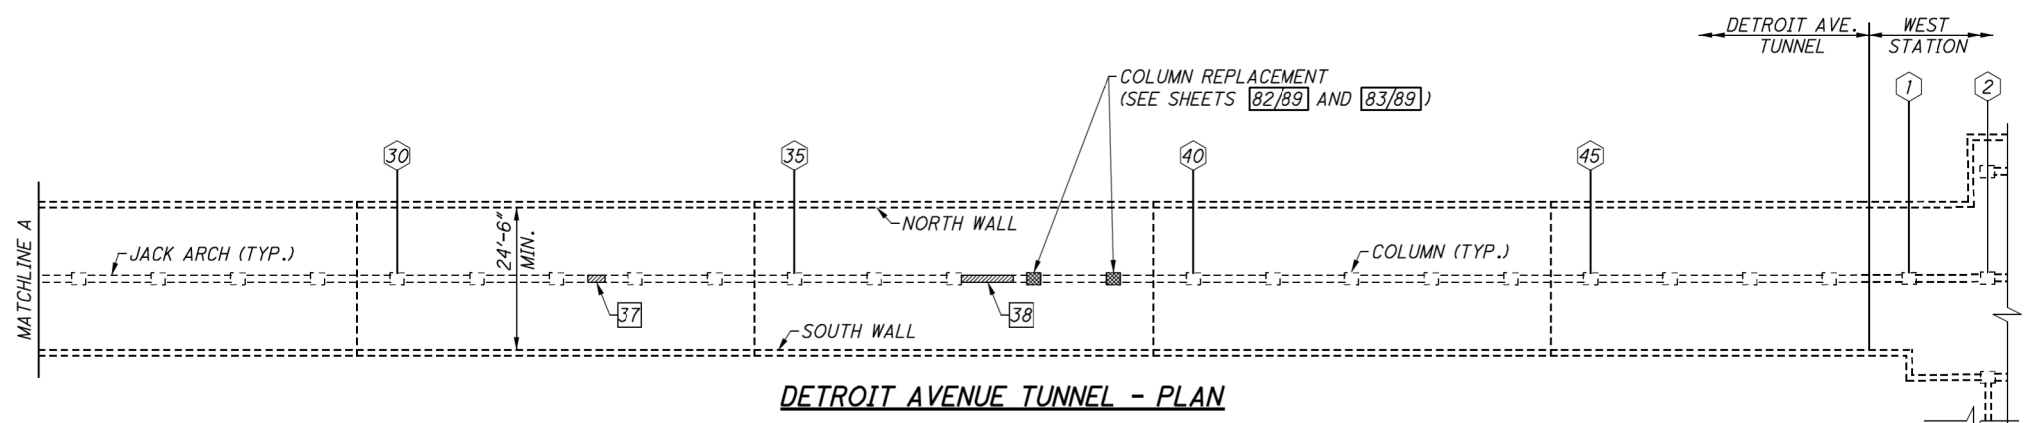

| ESTIMATED PATCHING QUANTITIES | | | |
|-------------------------------|-------------|-----------|------------------|
| REPAIR No. | REPAIR TYPE | AREA (SF) | ANODE QUANTITY** |
| 1 | TYPE 1 | 100 | 28 |
| 2 | TYPE 1 | 15 | 8 |
| 3 | TYPE 1 | 56 | 24 |
| 4 | TYPE 1 | 15 | 8 |
| 5 | TYPE 1 | 18 | 8 |
| 6 | TYPE 1 | 56 | 24 |
| 7 | TYPE 1 | 10 | 4 |
| 8 | TYPE 1 | 70 | 16 |
| 9 | TYPE 1 | 12 | 4 |
| 10 | TYPE 1 | 4 | - |
| 11 | TYPE 1 | 48 | 24 |
| 12 | TYPE 1 | 116 | 30 |
| 13 | TYPE 1 | 128 | 32 |
| 14 | TYPE 1 | 6 | 2 |
| 15 | TYPE 1 | 30 | 14 |

| ESTIMATED PATCHING QUANTITIES | | | |
|-------------------------------|-------------|-----------|------------------|
| REPAIR No. | REPAIR TYPE | AREA (SF) | ANODE QUANTITY** |
| 16 | TYPE 1 | 112 | 30 |
| 17 | TYPE 1 | 56 | 24 |
| 18 | TYPE 1 | 52 | 18 |
| 19 | TYPE 1 | 76 | 22 |
| 20 | TYPE 1 | 152 | 34 |
| 21 | TYPE 1 | 3 | - |
| 22 | TYPE 1 | 8 | 3 |
| 23 | TYPE 1 | 64 | 26 |
| 24 | TYPE 1 | 32 | 14 |
| 25 | TYPE 1 | 66 | 20 |
| 26 | TYPE 1 | 38 | 14 |
| 27 | TYPE 1 | 56 | 24 |
| 28 | TYPE 1 | 64 | 26 |
| 29 | TYPE 1 | 8 | 3 |
| 30 | TYPE 1 | 104 | 30 |

| ESTIMATED PATCHING QUANTITIES | | | |
|-------------------------------|-------------|-----------|------------------|
| REPAIR No. | REPAIR TYPE | AREA (SF) | ANODE QUANTITY** |
| 31 | TYPE 1 | 15 | 8 |
| 32 | TYPE 1 | 12 | 6 |
| 33 | TYPE 1 | 112 | 30 |
| 34 | TYPE 1 | 232 | 42 |
| 35 | TYPE 1 | 24 | 10 |
| 36 | TYPE 1 | 160 | 34 |
| 37 | TYPE 2 | 6 | 6 |
| 38 | TYPE 2 | 20 | 18 |
| MEASURED QUANTITY* | | 2126 | - |
| PLAN QUANTITY* | | 3189 | 668 |

* SEE NOTES 1 & 2
 ** SEE NOTE 3

| SHEET QUANTITY SUMMARY | | |
|------------------------|------|----------|
| ITEM | UNIT | QUANTITY |
| TYPE 1 REPAIR | SF | 3150 |
| TYPE 2 REPAIR | SF | 39 |


NOTES:

- MEASURED QUANTITIES ARE BASED ON THE INSPECTION PERFORMED IN JANUARY 2017. THE EXACT DIMENSIONS AND LOCATIONS OF PATCHES SHALL BE DETERMINED BY THE ENGINEER IN THE FIELD FOR FINAL PAY QUANTITY.
- PLAN QUANTITIES INCLUDE 50% CONTINGENCY ADDED TO MEASURED QUANTITIES.
- ANODES ARE INCLUDED FOR PAYMENT WITH ITEM SPECIAL - PATCHING CONCRETE STRUCTURE, TYPE 1 OR 2 REPAIR.
- FOR DETAILS AND MAXIMUM GRID SPACING FOR THE EMBEDDED GALVANIC ANODES, SEE SHEET 84/89.
- EPOXY-URETHANE SEALER SHALL NOT BE APPLIED TO PATCHED OR REPLACED CONCRETE SURFACES.
- DETERIORATED CONCRETE SURFACES WITHIN THREE FEET OF THE TUNNEL FLOOR SHALL NOT BE REPAIRED UNLESS ASSOCIATED WITH A REPAIR ABOVE THIS HEIGHT OR AS NOTED ON THIS SHEET.
- A NEW TUNNEL ROOF WAS PREVIOUSLY CONSTRUCTED ON TOP OF THE ORIGINAL DETROIT AVENUE TUNNEL ROOF. THE CONTRACTOR SHALL REMOVE LOOSE ORIGINAL ROOF CONCRETE FROM THE BOTTOM OF THE ORIGINAL DETROIT AVENUE ROOF AS DIRECTED BY THE ENGINEER. PAYMENT SHALL BE INCLUDED AS PART OF ITEM 202 - PORTIONS OF STRUCTURE REMOVED, OVER 20-FOOT SPAN, AS PER PLAN.


LEGEND:

- # TUNNEL COLUMN NUMBER
- # REPAIR NUMBER
- [Hatched Box] LOCATION OF DEFICIENT CONCRETE TO BE REPAIRED IN ACCORDANCE WITH ITEM SPECIAL - PATCHING CONCRETE STRUCTURE, TYPE 1 OR TYPE 2 REPAIR
- [Dashed Box] LOCATION OF DEFICIENT CONCRETE ON PERPENDICULAR FACE (NOT VISIBLE IN ELEVATION VIEW) TO BE REPAIRED IN ACCORDANCE WITH ITEM SPECIAL - PATCHING CONCRETE STRUCTURE, TYPE 1 OR TYPE 2 REPAIR

| | | | |
|--------------------------------|-----------|---|--|
| GRAPHIC SCALE MEASURED IN FEET | DATE | 
9902 Carver Road
Suite 201
Cincinnati, OH 45242
PH.: 614.699.5000 | DETROIT-SUPERIOR BRIDGE OVER CUYAHOGA RIVER
BRIDGE NO. CUY-6-1465 |
| NOT TO SCALE | NOV, 2018 | INFRASTRUCTURE ENGINEERS, INC. | DETROIT AVE TUNNEL CONC. REPAIR DETAIL |
| | | | PAGE A-15 |

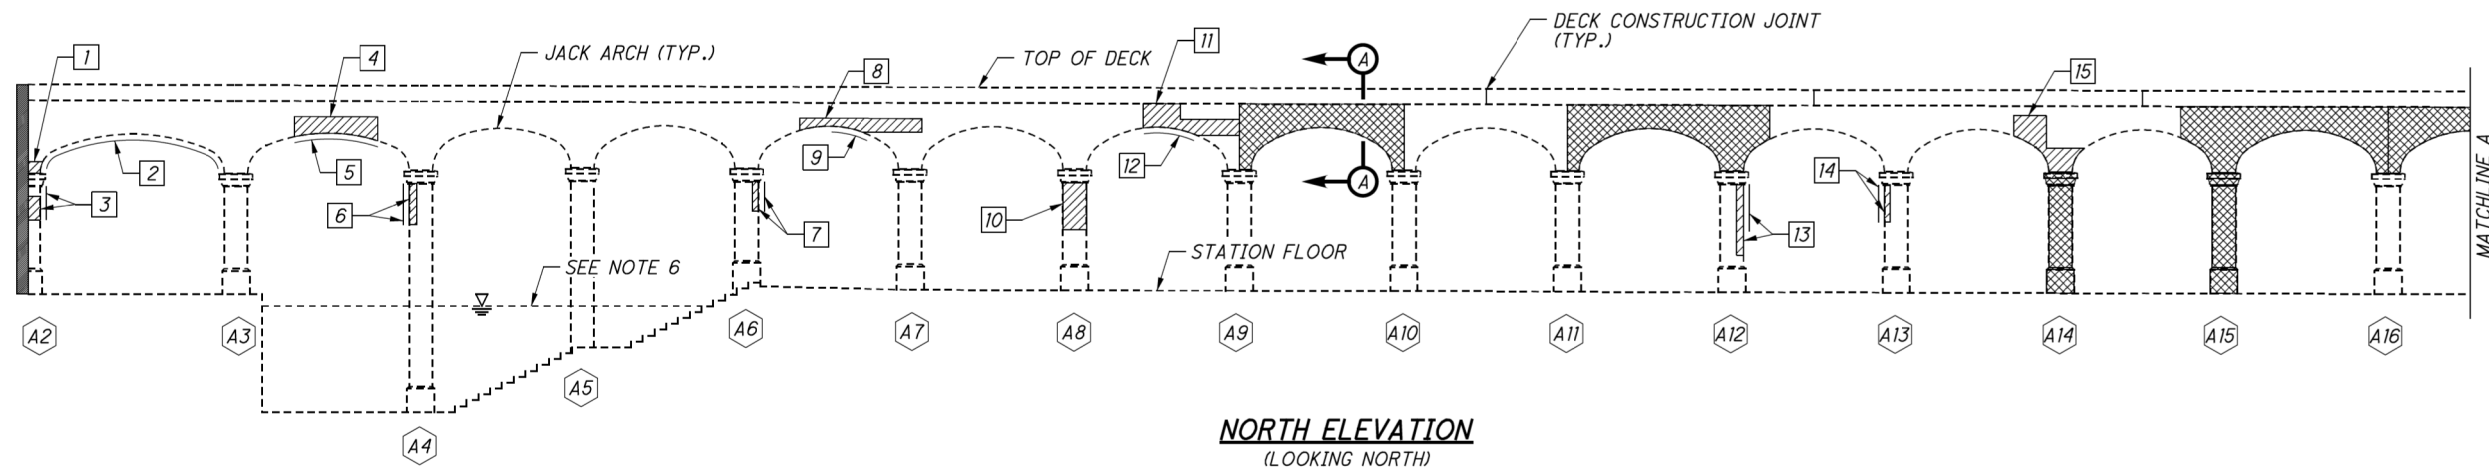


NORTH ELEVATION
(LOOKING NORTH)

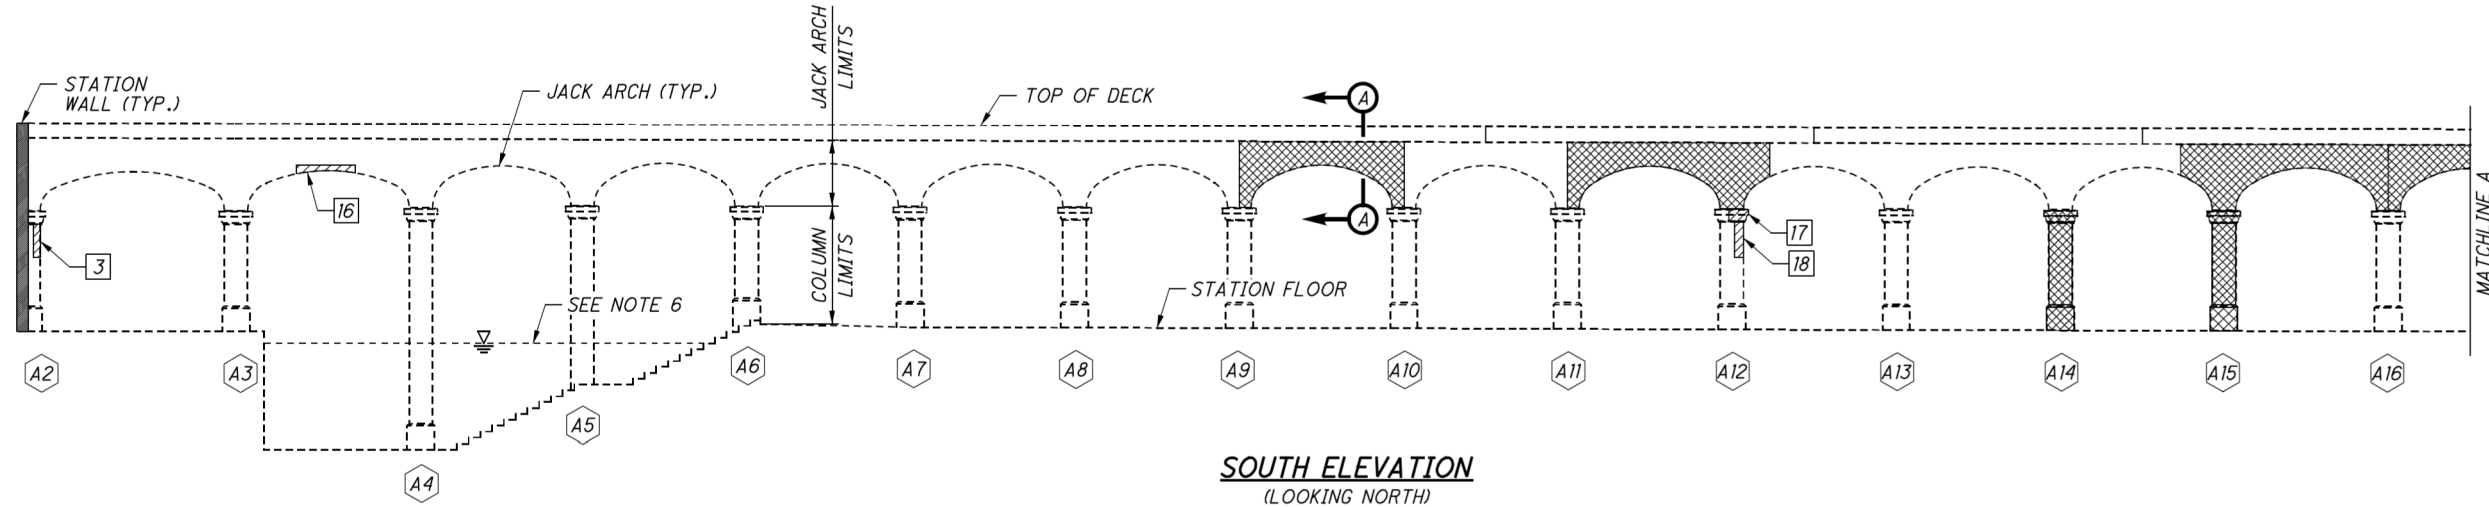

SOUTH ELEVATION
(LOOKING NORTH)

| ESTIMATED PATCHING QUANTITIES | | | |
|-------------------------------|-------------|-----------|------------------|
| REPAIR NO. | REPAIR TYPE | AREA (SF) | ANODE QUANTITY** |
| 1 | TYPE 1 | 2 | - |
| 2 | TYPE 2 | 9 | 15 |
| 3 | TYPE 1 | 10 | 4 |
| 4 | TYPE 1 | 11 | 6 |
| 5 | TYPE 2 | 4 | - |
| 6 | TYPE 1 | 6 | 2 |
| 7 | TYPE 1 | 3 | - |
| 8 | TYPE 1 | 14 | 9 |
| 9 | TYPE 2 | 2 | - |
| 10 | TYPE 1 | 8 | 3 |
| 11 | TYPE 1 | 14 | 7 |
| 12 | TYPE 2 | 4 | - |
| 13 | TYPE 1 | 12 | 8 |
| 14 | TYPE 1 | 4 | - |
| 15 | TYPE 1 | 12 | 8 |
| 16 | TYPE 1 | 4 | - |
| 17 | TYPE 1 | 2 | - |
| 18 | TYPE 1 | 3 | - |
| MEASURED QUANTITY* | | 124 | - |
| PLAN QUANTITY* | | 186 | 62 |

| SHEET QUANTITY SUMMARY | | |
|------------------------|------|----------|
| ITEM | UNIT | QUANTITY |
| TYPE 1 REPAIR | SF | 158 |
| TYPE 2 REPAIR | SF | 28 |

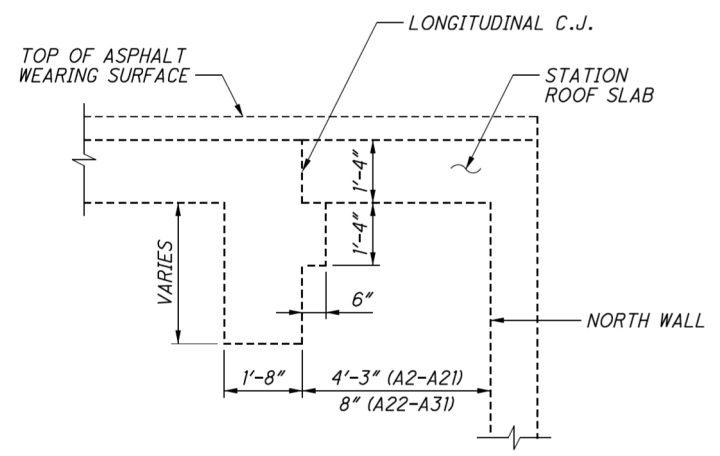

SECTION A-A

NOTES:


- MEASURED QUANTITIES ARE BASED ON THE INSPECTION PERFORMED IN SEPTEMBER 2016. THE EXACT DIMENSIONS AND LOCATIONS OF PATCHES SHALL BE DETERMINED BY THE ENGINEER IN THE FIELD FOR FINAL PAY QUANTITY.
- PLAN QUANTITIES INCLUDE 50% CONTINGENCY ADDED TO MEASURED QUANTITIES.
- ANODES ARE INCLUDED FOR PAYMENT WITH ITEM SPECIAL - PATCHING CONCRETE STRUCTURE, TYPE 1 OR 2 REPAIR.
- FOR DETAILS AND MAXIMUM GRID SPACING FOR THE EMBEDDED GALVANIC ANODES, SEE SHEET 84/89.
- EPOXY-URETHANE SEALER SHALL NOT BE APPLIED TO PATCHED OR REPLACED CONCRETE SURFACES.
- THE UNDERSIDE OF THE CEILING EXHIBITS TYPICAL AREAS OF SPALLING WITH EXPOSED AND CORRODED REINFORCEMENT BETWEEN ALL COLUMN LINES. APPROXIMATELY 15% OF THE UNDERSIDE IS SPALLED WITH CRACKING, MOISTURE LEAKAGE AND EFFLORESCENCE STAINING.

LEGEND:

- ⊕ STATION COLUMN NUMBER
- # REPAIR NUMBER
- ▨ LOCATION OF DEFICIENT CONCRETE TO BE REPAIRED IN ACCORDANCE WITH ITEM SPECIAL - PATCHING CONCRETE STRUCTURE, TYPE 1 REPAIR
- ▤ LOCATION OF DEFICIENT CONCRETE ON PERPENDICULAR FACE (NOT VISIBLE IN ELEVATION VIEW) TO BE REPAIRED IN ACCORDANCE WITH ITEM SPECIAL - PATCHING CONCRETE STRUCTURE, TYPE 1 OR TYPE 2 REPAIR
- ▩ LOCATION OF DEFICIENT COLUMN OR JACK ARCH TO BE REPLACED. FOR REPLACEMENT DETAILS, SEE SHEETS 79/89 THRU 83/89

* SEE NOTES 1 & 2
** SEE NOTE 3

| | | | | |
|--------------------------------|-----------|--|--|----------------------------------|
| GRAPHIC SCALE MEASURED IN FEET | DATE | 9902 Carver Road
Suite 201
Cincinnati, OH 45242
PH.: 614.699.5000 | DETROIT-SUPERIOR BRIDGE OVER CUYAHOGA RIVER
BRIDGE NO. CUY-6-1465 | |
| | NOV, 2018 | | INFRASTRUCTURE ENGINEERS, INC. | WEST STATION CONC REPAIR DETAILS |
| NOT TO SCALE | | | | PAGE A-16 |

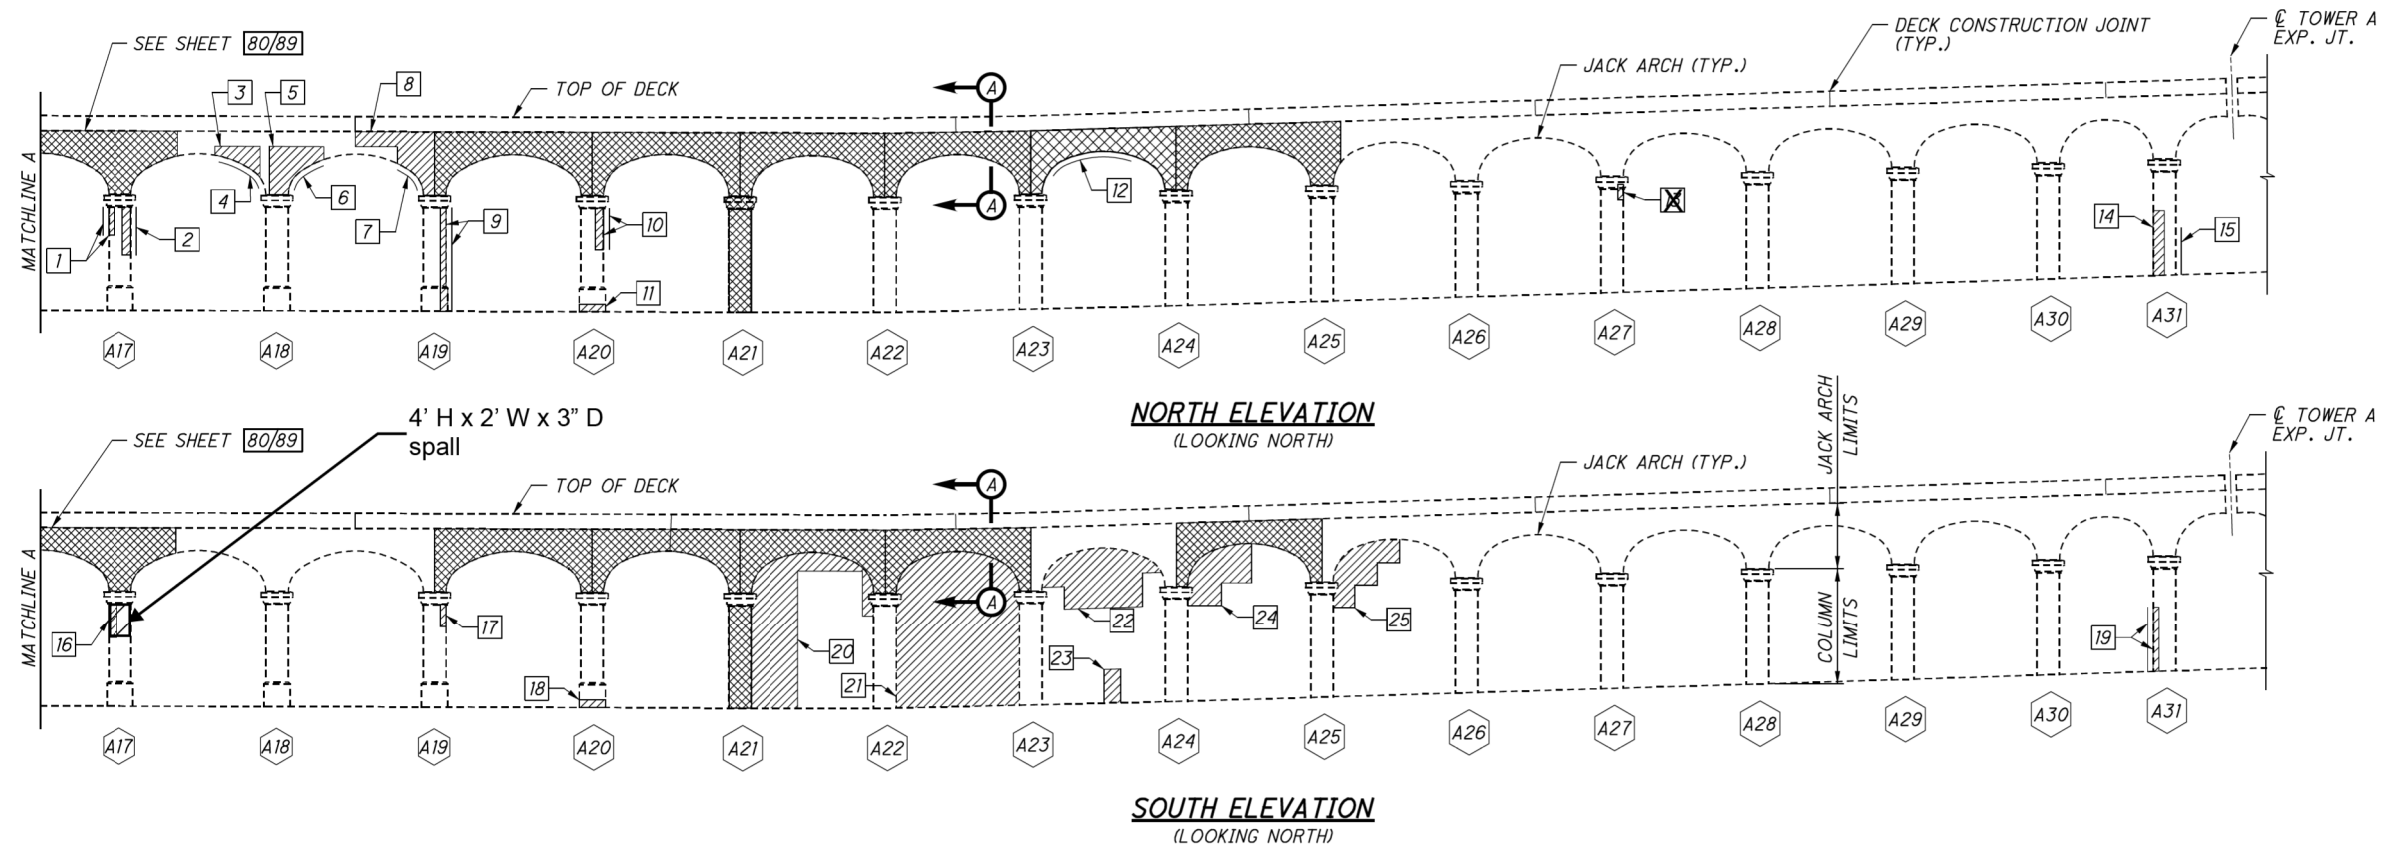

| ESTIMATED PATCHING QUANTITIES | | | |
|-------------------------------|-------------|-----------|------------------|
| REPAIR NO. | REPAIR TYPE | AREA (SF) | ANODE QUANTITY** |
| 1 | TYPE 1 | 4 | - |
| 2 | TYPE 1 | 7 | 3 |
| 3 | TYPE 1 | 6 | 3 |
| 4 | TYPE 2 | 3 | - |
| 5 | TYPE 1 | 14 | 6 |
| 6 | TYPE 2 | 5 | 2 |
| 7 | TYPE 2 | 3 | - |
| 8 | TYPE 1 | 18 | 10 |
| 9 | TYPE 1 | 10 | 7 |
| 10 | TYPE 1 | 6 | 2 |
| 11 | TYPE 1 | 2 | - |
| 12 | TYPE 2 | 12 | 5 |
| 13 | TYPE 1 | 1 | - |
| 14 | TYPE 1 | 6 | 4 |
| 15 | TYPE 1 | 4 | - |
| 16 | TYPE 1 | 3 | - |
| 17 | TYPE 1 | 1 | - |
| 18 | TYPE 1 | 2 | - |
| 19 | TYPE 1 | 13 | 8 |
| 20 | TYPE 1 | 65 | 20 |

| ESTIMATED PATCHING QUANTITIES | | | |
|-------------------------------|-------------|-----------|------------------|
| REPAIR NO. | REPAIR TYPE | AREA (SF) | ANODE QUANTITY** |
| 21 | TYPE 1 | 143 | 30 |
| 22 | TYPE 1 | 41 | 14 |
| 23 | TYPE 1 | 5 | 2 |
| 24 | TYPE 1 | 22 | 12 |
| 25 | TYPE 1 | 20 | 10 |
| MEASURED QUANTITY* | | 416 | - |
| PLAN QUANTITY* | | 624 | 138 |

* SEE NOTES 1 & 2
 ** SEE NOTE 3

| SHEET QUANTITY SUMMARY | | |
|------------------------|------|----------|
| ITEM | UNIT | QUANTITY |
| TYPE 1 REPAIR | SF | 590 |
| TYPE 2 REPAIR | SF | 34 |


NOTES:

- MEASURED QUANTITIES ARE BASED ON THE INSPECTION PERFORMED IN SEPTEMBER 2016. THE EXACT DIMENSIONS AND LOCATIONS OF PATCHES SHALL BE DETERMINED BY THE ENGINEER IN THE FIELD FOR FINAL PAY QUANTITY.
- PLAN QUANTITIES INCLUDE 50% CONTINGENCY ADDED TO MEASURED QUANTITIES.
- ANODES ARE INCLUDED FOR PAYMENT WITH ITEM SPECIAL - PATCHING CONCRETE STRUCTURE, TYPE 1 OR 2 REPAIR.
- FOR DETAILS AND MAXIMUM GRID SPACING FOR THE EMBEDDED GALVANIC ANODES, SEE SHEET 84/89.
- EPOXY-URETHANE SEALER SHALL NOT BE APPLIED TO PATCHED OR REPLACED CONCRETE SURFACES.
- FOR SECTION A-A, SEE SHEET 17/89.

LEGEND:

- # STATION COLUMN NUMBER
- # REPAIR NUMBER
- ▨ LOCATION OF DEFICIENT CONCRETE TO BE REPAIRED IN ACCORDANCE WITH ITEM SPECIAL - PATCHING CONCRETE STRUCTURE, TYPE 1 REPAIR
- ▨ LOCATION OF DEFICIENT CONCRETE ON PERPENDICULAR FACE (NOT VISIBLE IN ELEVATION VIEW) TO BE REPAIRED IN ACCORDANCE WITH ITEM SPECIAL - PATCHING CONCRETE STRUCTURE, TYPE 1 OR TYPE 2 REPAIR
- ▨ LOCATION OF DEFICIENT COLUMN OR JACK ARCH TO BE REPLACED. FOR REPLACEMENT DETAILS, SEE SHEETS 79/89 THRU 83/89

| | | | |
|--------------------------------|-----------|--|--------------|
| GRAPHIC SCALE MEASURED IN FEET | DATE | DETROIT-SUPERIOR BRIDGE OVER CUYAHOGA RIVER
BRIDGE NO. CUY-6-1465 | |
| NOT TO SCALE | NOV, 2018 | WEST STATION CONC. REPAIR DETAILS | PAGE
A-17 |

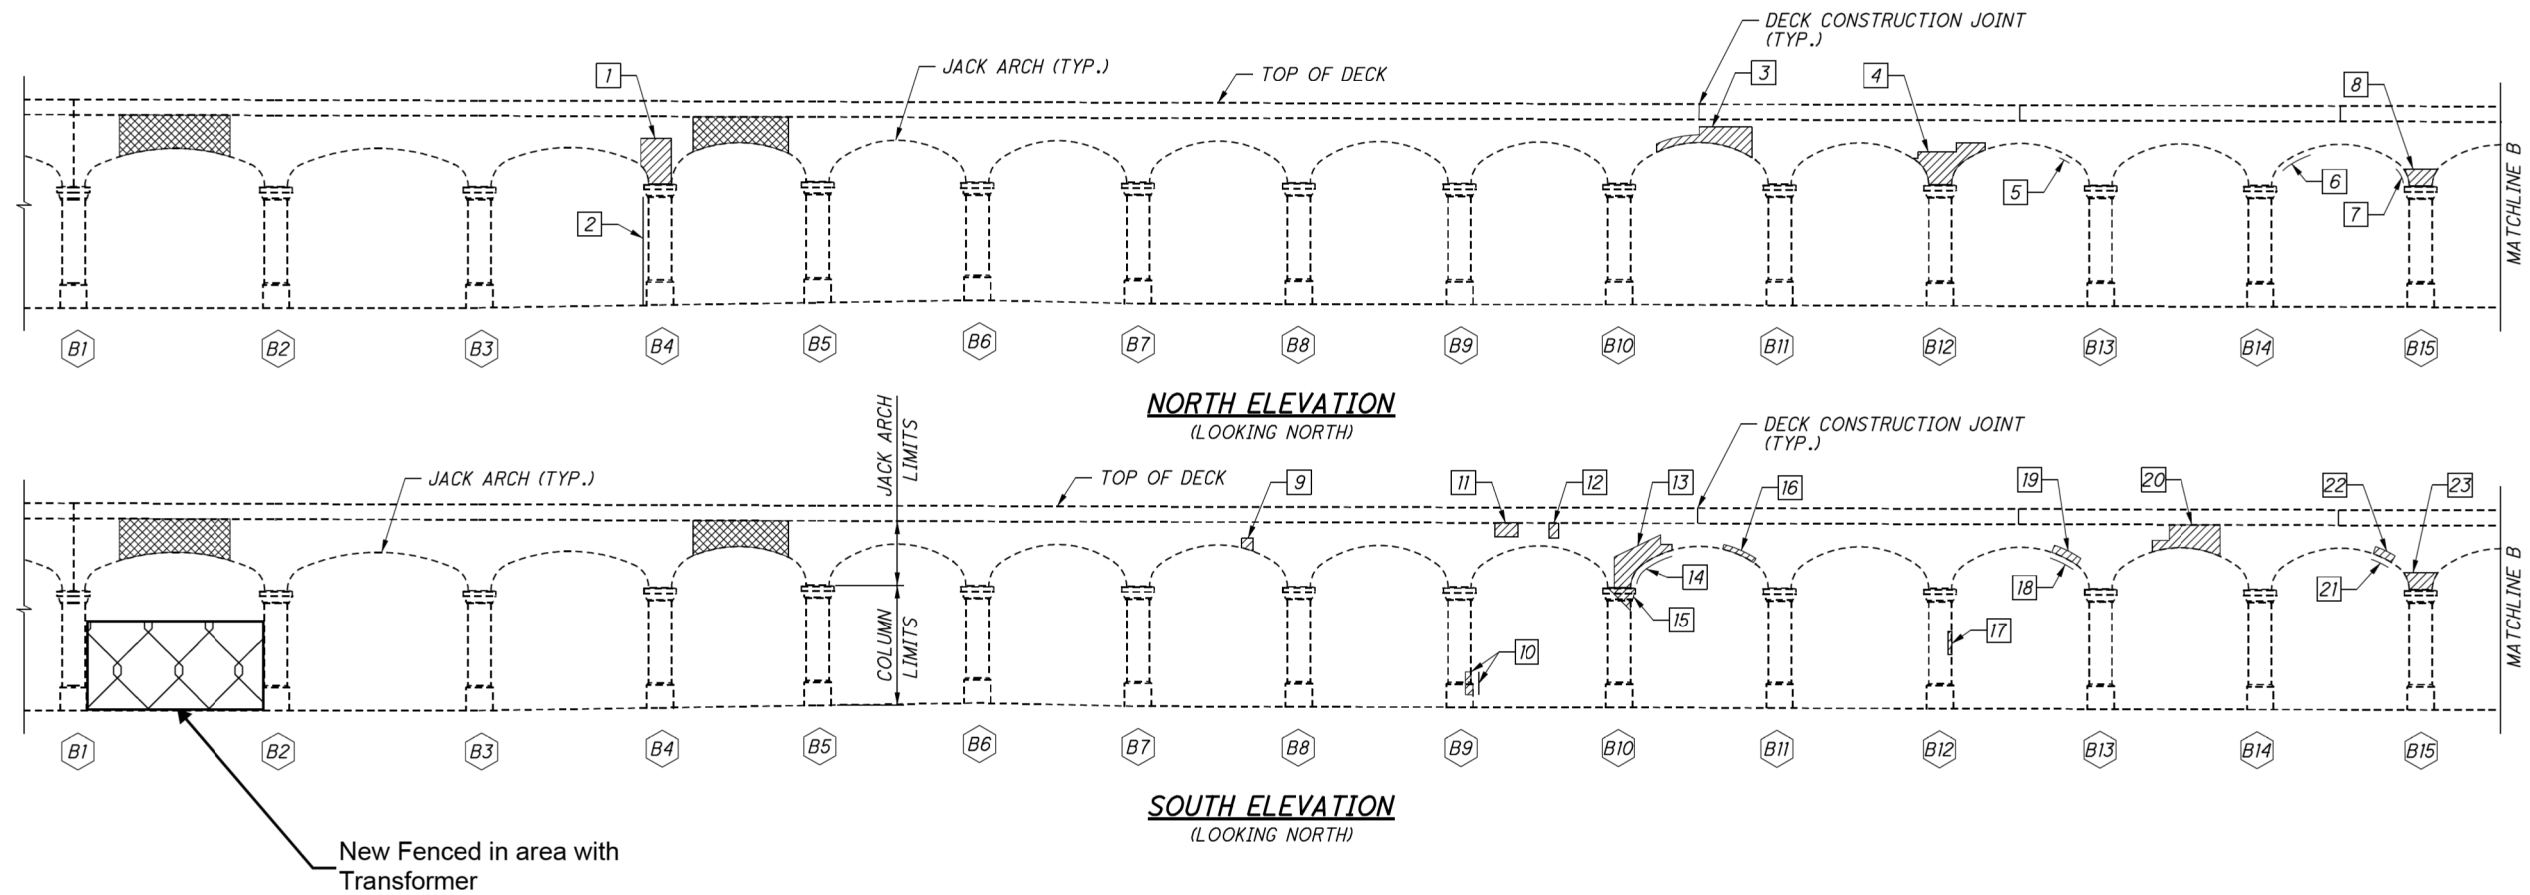

| ESTIMATED PATCHING QUANTITIES | | | |
|-------------------------------|-------------|-----------|------------------|
| REPAIR NO. | REPAIR TYPE | AREA (SF) | ANODE QUANTITY** |
| 1 | TYPE 1 | 10 | 6 |
| 2 | TYPE 1 | 18 | 7 |
| 3 | TYPE 1 | 11 | 7 |
| 4 | TYPE 1 | 12 | 8 |
| 5 | TYPE 2 | 1 | - |
| 6 | TYPE 2 | 5 | 3 |
| 7 | TYPE 2 | 3 | - |
| 8 | TYPE 1 | 4 | - |
| 9 | TYPE 1 | 1 | - |
| 10 | TYPE 1 | 4 | - |
| 11 | TYPE 1 | 3 | - |
| 12 | TYPE 1 | 2 | - |
| 13 | TYPE 1 | 10 | 8 |
| 14 | TYPE 2 | 3 | - |
| 15 | TYPE 1 | 3 | - |
| 16 | TYPE 1 | 2 | - |
| 17 | TYPE 1 | 1 | - |
| 18 | TYPE 2 | 3 | - |
| 19 | TYPE 1 | 2 | - |
| 20 | TYPE 1 | 12 | 10 |

| ESTIMATED PATCHING QUANTITIES | | | |
|-------------------------------|-------------|-----------|------------------|
| REPAIR NO. | REPAIR TYPE | AREA (SF) | ANODE QUANTITY** |
| 21 | TYPE 2 | 1 | - |
| 22 | TYPE 1 | 2 | - |
| 23 | TYPE 1 | 4 | - |
| MEASURED QUANTITY* | | 117 | - |
| PLAN QUANTITY* | | 176 | 49 |

* SEE NOTES 1 & 2
 ** SEE NOTE 3

| SHEET QUANTITY SUMMARY | | |
|------------------------|------|----------|
| ITEM | UNIT | QUANTITY |
| TYPE 1 REPAIR | SF | 152 |
| TYPE 2 REPAIR | SF | 24 |


NOTES:

- MEASURED QUANTITIES ARE BASED ON THE INSPECTION PERFORMED IN SEPTEMBER 2016. THE EXACT DIMENSIONS AND LOCATIONS OF PATCHES SHALL BE DETERMINED BY THE ENGINEER IN THE FIELD FOR FINAL PAY QUANTITY.
- PLAN QUANTITIES INCLUDE 50% CONTINGENCY ADDED TO MEASURED QUANTITIES.
- ANODES ARE INCLUDED FOR PAYMENT WITH ITEM SPECIAL - PATCHING CONCRETE STRUCTURE, TYPE 1 OR 2 REPAIR.
- FOR DETAILS AND MAXIMUM GRID SPACING FOR THE EMBEDDED GALVANIC ANODES, SEE SHEET [84/89].
- EPOXY-URETHANE SEALER SHALL NOT BE APPLIED TO PATCHED OR REPLACED CONCRETE SURFACES.

LEGEND:

- # STATION COLUMN NUMBER
- # REPAIR NUMBER
- [Hatched Box] LOCATION OF DEFICIENT CONCRETE TO BE REPAIRED IN ACCORDANCE WITH ITEM SPECIAL - PATCHING CONCRETE STRUCTURE, TYPE 1 REPAIR
- [Dashed Box] LOCATION OF DEFICIENT CONCRETE ON PERPENDICULAR FACE (NOT VISIBLE IN ELEVATION VIEW) TO BE REPAIRED IN ACCORDANCE WITH ITEM SPECIAL - PATCHING CONCRETE STRUCTURE, TYPE 1 OR TYPE 2 REPAIR
- [Cross-hatched Box] LOCATION OF DEFICIENT COLUMN OR JACK ARCH TO BE REPLACED. FOR REPLACEMENT DETAILS, SEE SHEETS [79/89] THRU [83/89]

| | | | |
|--------------------------------|-----------|---|--|
| GRAPHIC SCALE MEASURED IN FEET | DATE | 
9902 Carver Road
Suite 201
Cincinnati, OH 45242
PH.: 614.699.5000 | DETROIT-SUPERIOR BRIDGE OVER CUYAHOGA RIVER
BRIDGE NO. CUY-6-1465 |
| NOT TO SCALE | NOV, 2018 | INFRASTRUCTURE ENGINEERS, INC. | WEST STATION CONC. REPAIR DETAILS |
| | | | PAGE A-18 |

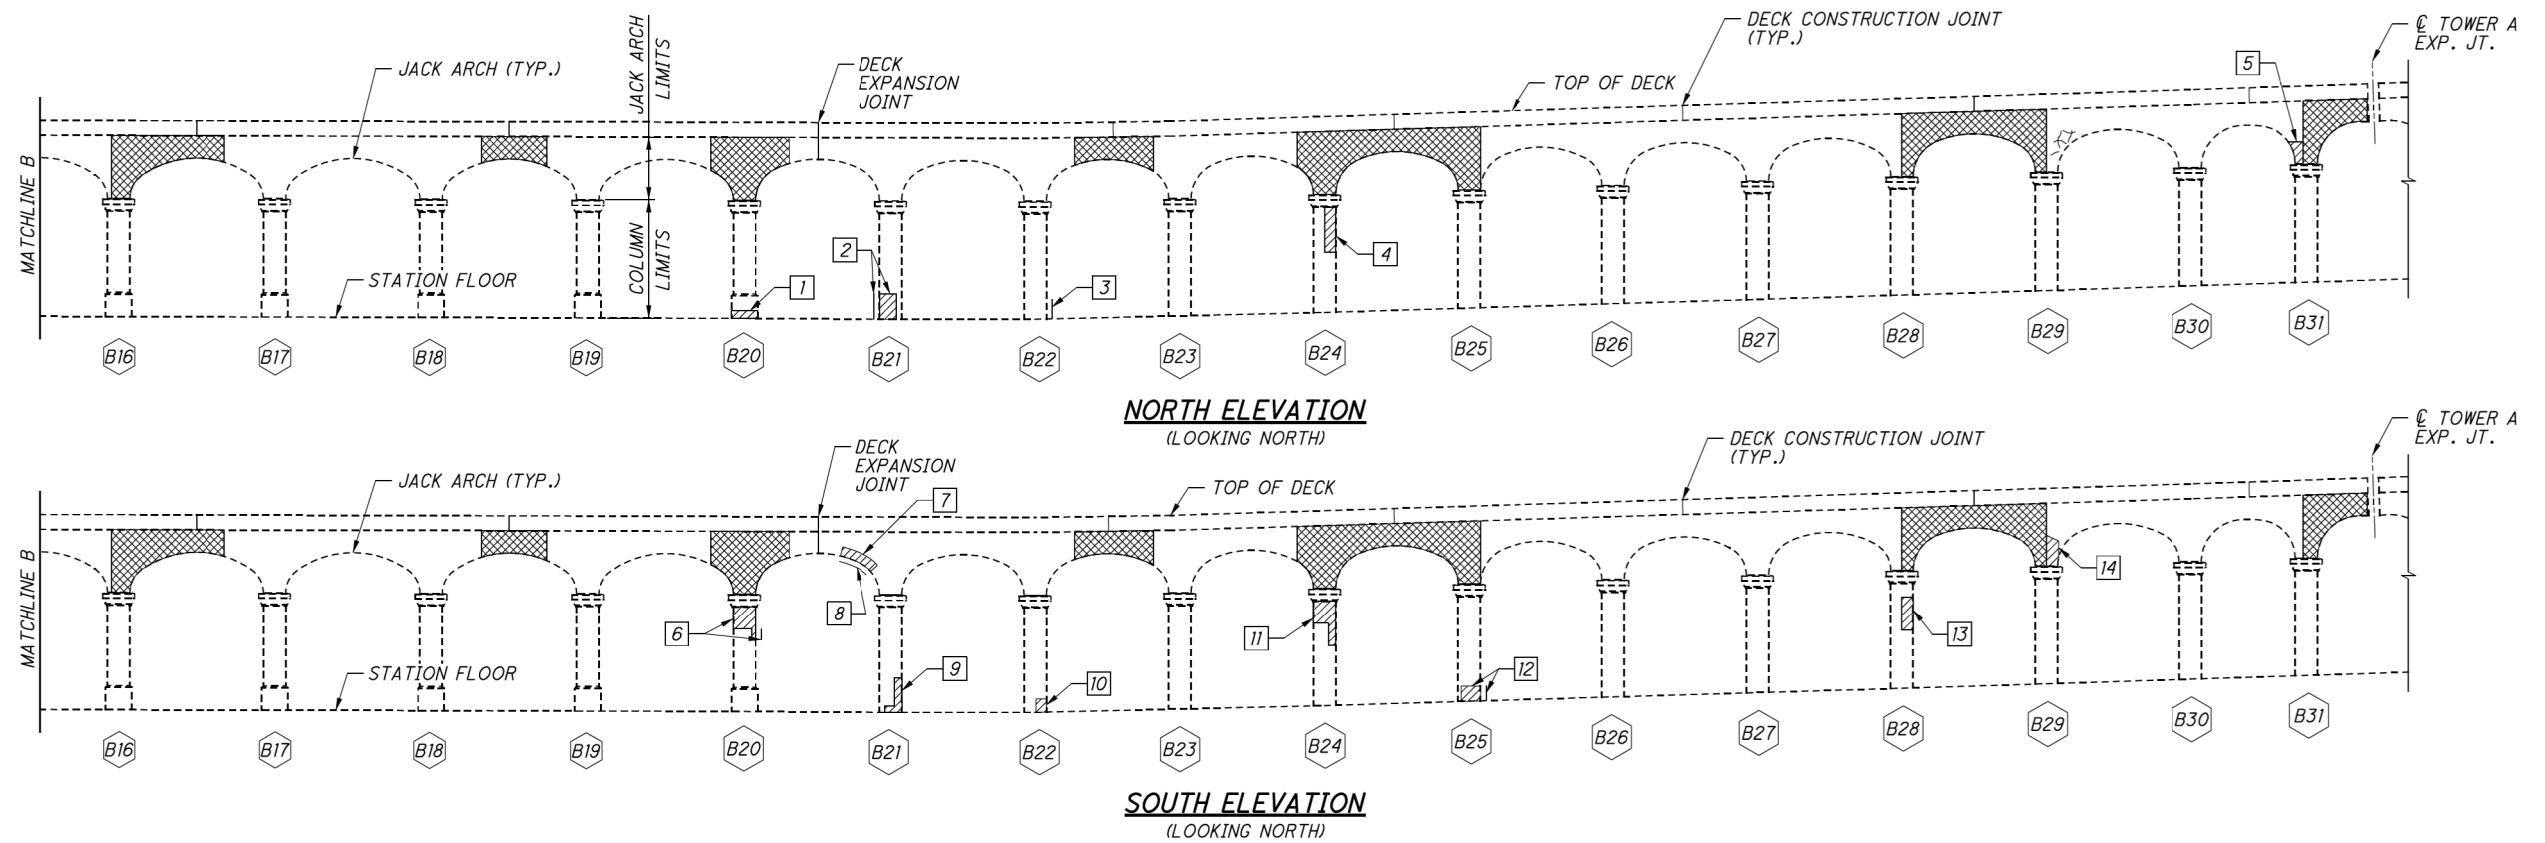

| ESTIMATED PATCHING QUANTITIES | | | |
|-------------------------------|-------------|-----------|------------------|
| REPAIR NO. | REPAIR TYPE | AREA (SF) | ANODE QUANTITY** |
| 1 | TYPE 1 | 2 | - |
| 2 | TYPE 1 | 6 | 4 |
| 3 | TYPE 1 | 3 | - |
| 4 | TYPE 1 | 4 | - |
| 5 | TYPE 1 | 3 | - |
| 6 | TYPE 1 | 6 | 4 |
| 7 | TYPE 1 | 3 | - |
| 8 | TYPE 2 | 3 | - |
| 9 | TYPE 1 | 2 | - |
| 10 | TYPE 1 | 2 | - |
| 11 | TYPE 1 | 6 | 3 |
| 12 | TYPE 1 | 4 | - |
| 13 | TYPE 1 | 3 | - |
| 14 | TYPE 1 | 3 | - |
| MEASURED QUANTITY* | | 50 | - |
| PLAN QUANTITY* | | 75 | 11 |

* SEE NOTES 1 & 2
 ** SEE NOTE 3


| SHEET QUANTITY SUMMARY | | | |
|------------------------|------|----------|--|
| ITEM | UNIT | QUANTITY | |
| TYPE 1 REPAIR | SF | 70 | |
| TYPE 2 REPAIR | SF | 5 | |

NOTES:

1. MEASURED QUANTITIES ARE BASED ON THE INSPECTION PERFORMED IN SEPTEMBER 2016. THE EXACT DIMENSIONS AND LOCATIONS OF PATCHES SHALL BE DETERMINED BY THE ENGINEER IN THE FIELD FOR FINAL PAY QUANTITY.
2. PLAN QUANTITIES INCLUDE 50% CONTINGENCY ADDED TO MEASURED QUANTITIES.
3. ANODES ARE INCLUDED FOR PAYMENT WITH ITEM SPECIAL - PATCHING CONCRETE STRUCTURE, TYPE 1 OR 2 REPAIR.
4. FOR DETAILS AND MAXIMUM GRID SPACING FOR THE EMBEDDED GALVANIC ANODES, SEE SHEET 84/89.
5. EPOXY-URETHANE SEALER SHALL NOT BE APPLIED TO PATCHED OR REPLACED CONCRETE SURFACES.

LEGEND:

- # STATION COLUMN NUMBER
- # REPAIR NUMBER
- LOCATION OF DEFICIENT CONCRETE TO BE REPAIRED IN ACCORDANCE WITH ITEM SPECIAL - PATCHING CONCRETE STRUCTURE, TYPE 1 REPAIR
- LOCATION OF DEFICIENT CONCRETE ON PERPENDICULAR FACE (NOT VISIBLE IN ELEVATION VIEW) TO BE REPAIRED IN ACCORDANCE WITH ITEM SPECIAL - PATCHING CONCRETE STRUCTURE, TYPE 1 OR TYPE 2 REPAIR
- LOCATION OF DEFICIENT COLUMN OR JACK ARCH TO BE REPLACED. FOR REPLACEMENT DETAILS, SEE SHEETS 79/89 THRU 83/89

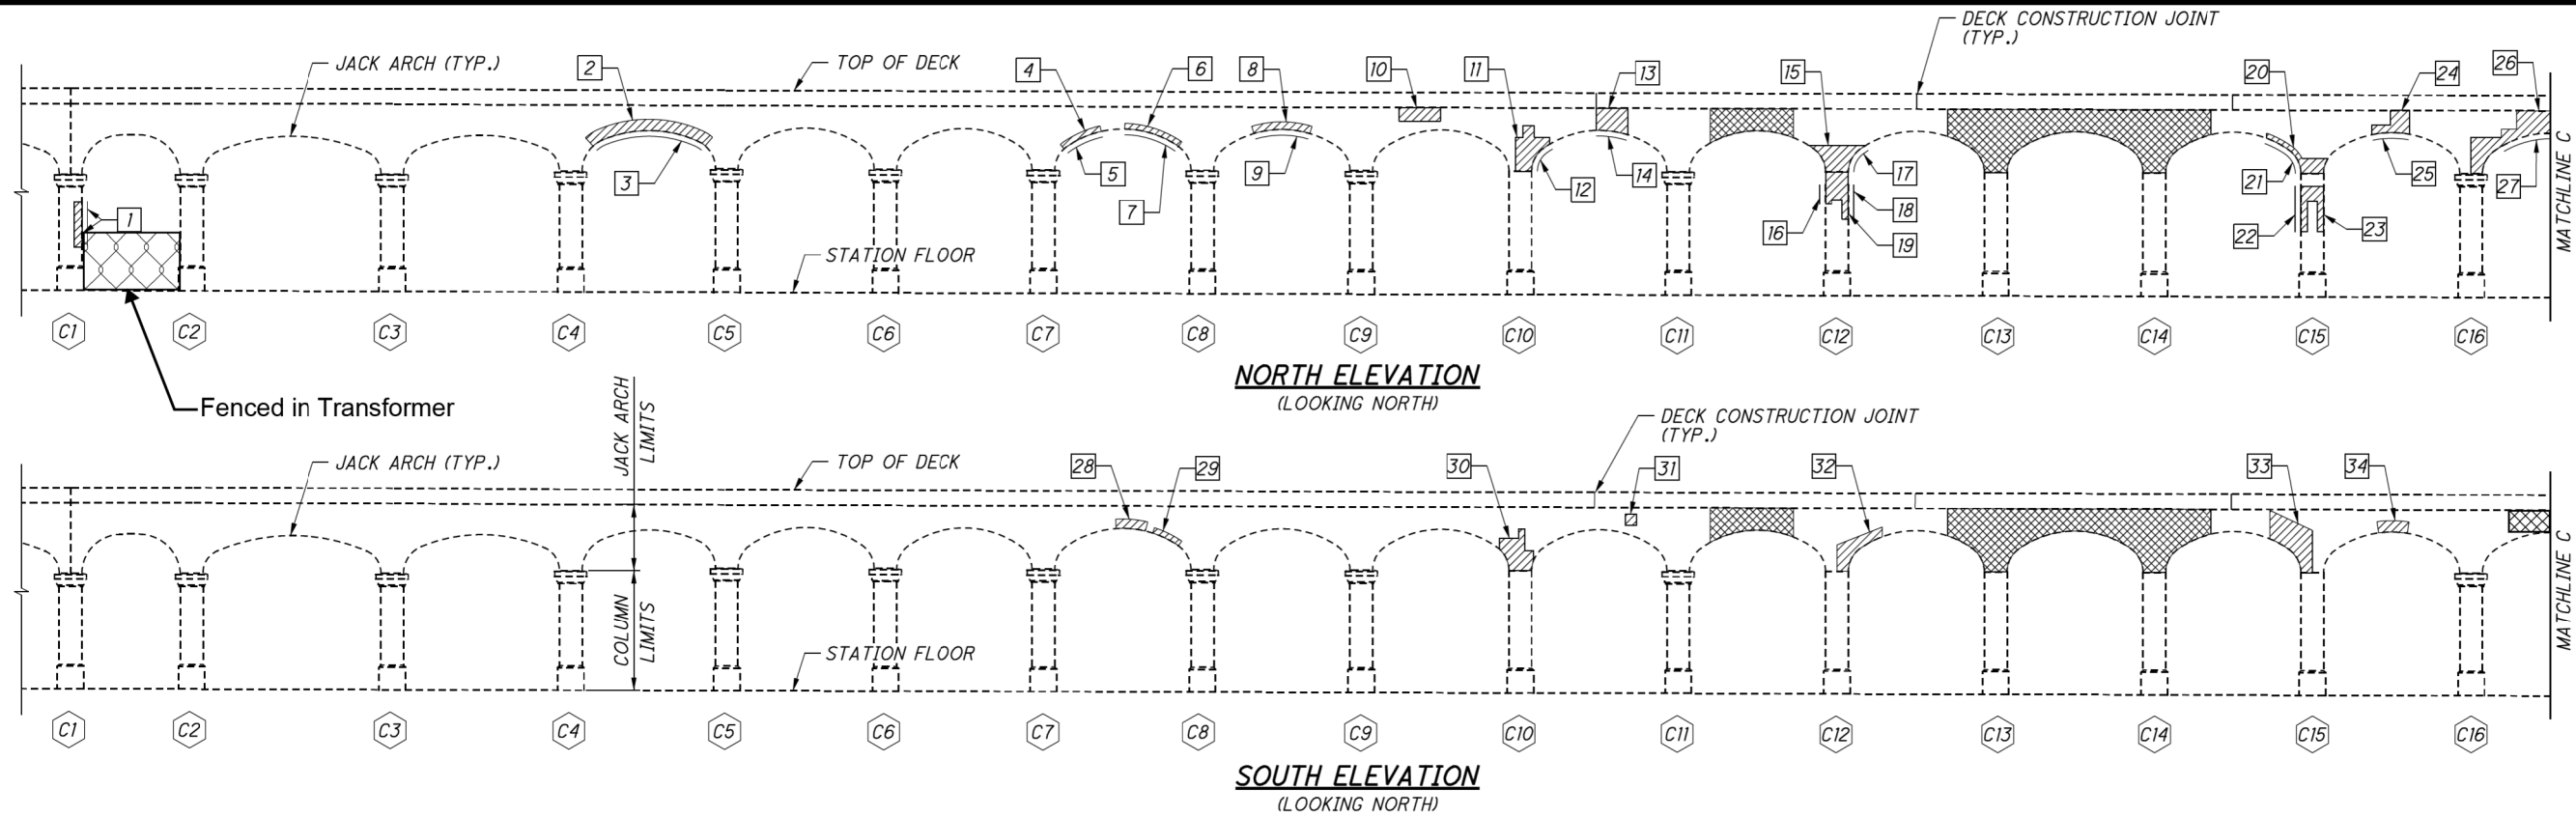

| ESTIMATED PATCHING QUANTITIES | | | |
|-------------------------------|-------------|-----------|------------------|
| REPAIR NO. | REPAIR TYPE | AREA (SF) | ANODE QUANTITY** |
| 1 | TYPE 1 | 10 | 6 |
| 2 | TYPE 1 | 11 | 10 |
| 3 | TYPE 2 | 6 | 10 |
| 4 | TYPE 1 | 2 | - |
| 5 | TYPE 2 | 2 | - |
| 6 | TYPE 1 | 3 | - |
| 7 | TYPE 2 | 3 | - |
| 8 | TYPE 1 | 4 | - |
| 9 | TYPE 2 | 3 | - |
| 10 | TYPE 1 | 5 | - |
| 11 | TYPE 1 | 8 | 6 |
| 12 | TYPE 2 | 4 | - |
| 13 | TYPE 1 | 6 | 4 |
| 14 | TYPE 2 | 2 | - |
| 15 | TYPE 1 | 8 | 4 |
| 16 | TYPE 1 | 1 | - |
| 17 | TYPE 2 | 4 | - |
| 18 | TYPE 1 | 3 | - |
| 19 | TYPE 1 | 6 | 2 |
| 20 | TYPE 1 | 5 | - |
| 21 | TYPE 2 | 7 | 3 |
| 22 | TYPE 1 | 7 | 3 |
| 23 | TYPE 1 | 6 | 2 |

| ESTIMATED PATCHING QUANTITIES | | | |
|-------------------------------|-------------|-----------|------------------|
| REPAIR NO. | REPAIR TYPE | AREA (SF) | ANODE QUANTITY** |
| 24 | TYPE 1 | 5 | - |
| 25 | TYPE 2 | 2 | - |
| 26 | TYPE 1 | 12 | 6 |
| 27 | TYPE 2 | 10 | 8 |
| 28 | TYPE 1 | 3 | - |
| 29 | TYPE 1 | 2 | - |
| 30 | TYPE 1 | 8 | 6 |
| 31 | TYPE 1 | 1 | - |
| 32 | TYPE 1 | 6 | 3 |
| 33 | TYPE 1 | 12 | 8 |
| 34 | TYPE 1 | 3 | - |
| MEASURED QUANTITY* | | 180 | - |
| PLAN QUANTITY* | | 270 | 81 |

* SEE NOTES 1 & 2
 ** SEE NOTE 3

| SHEET QUANTITY SUMMARY | | |
|------------------------|------|----------|
| ITEM | UNIT | QUANTITY |
| TYPE 1 REPAIR | SF | 206 |
| TYPE 2 REPAIR | SF | 64 |

NOTES:

- MEASURED QUANTITIES ARE BASED ON THE INSPECTION PERFORMED IN SEPTEMBER 2016. THE EXACT DIMENSIONS AND LOCATIONS OF PATCHES SHALL BE DETERMINED BY THE ENGINEER IN THE FIELD FOR FINAL PAY QUANTITY.
- PLAN QUANTITIES INCLUDE 50% CONTINGENCY ADDED TO MEASURED QUANTITIES.
- ANODES ARE INCLUDED FOR PAYMENT WITH ITEM SPECIAL - PATCHING CONCRETE STRUCTURE, TYPE 1 OR 2 REPAIR.
- FOR DETAILS AND MAXIMUM GRID SPACING FOR THE EMBEDDED GALVANIC ANODES, SEE SHEET [84/89].
- EPOXY-URETHANE SEALER SHALL NOT BE APPLIED TO PATCHED OR REPLACED CONCRETE SURFACES.


LEGEND:

- STATION COLUMN NUMBER
- REPAIR NUMBER
- LOCATION OF DEFICIENT CONCRETE TO BE REPAIRED IN ACCORDANCE WITH ITEM SPECIAL - PATCHING CONCRETE STRUCTURE, TYPE 1 REPAIR
- LOCATION OF DEFICIENT CONCRETE ON PERPENDICULAR FACE (NOT VISIBLE IN ELEVATION VIEW) TO BE REPAIRED IN ACCORDANCE WITH ITEM SPECIAL - PATCHING CONCRETE STRUCTURE, TYPE 1 OR TYPE 2 REPAIR
- LOCATION OF DEFICIENT COLUMN OR JACK ARCH TO BE REPLACED. FOR REPLACEMENT DETAILS, SEE SHEETS [79/89] THRU [83/89]

| | | | | |
|--|--------------------------------|---|---|--------------|
| GRAPHIC SCALE MEASURED IN FEET

NOT TO SCALE | DATE
NOV, 2018 | 9902 Carver Road
Suite 201
Cincinnati, OH 45242
PH.: 614.699.5000
INFRASTRUCTURE ENGINEERS, INC. | DETROIT-SUPERIOR BRIDGE OVER CUYAHOGA RIVER
BRIDGE NO. CUY-6-1465

WEST STATION CONC. REPAIR DETAILS | PAGE
A-20 |
| | INFRASTRUCTURE ENGINEERS, INC. | | | |

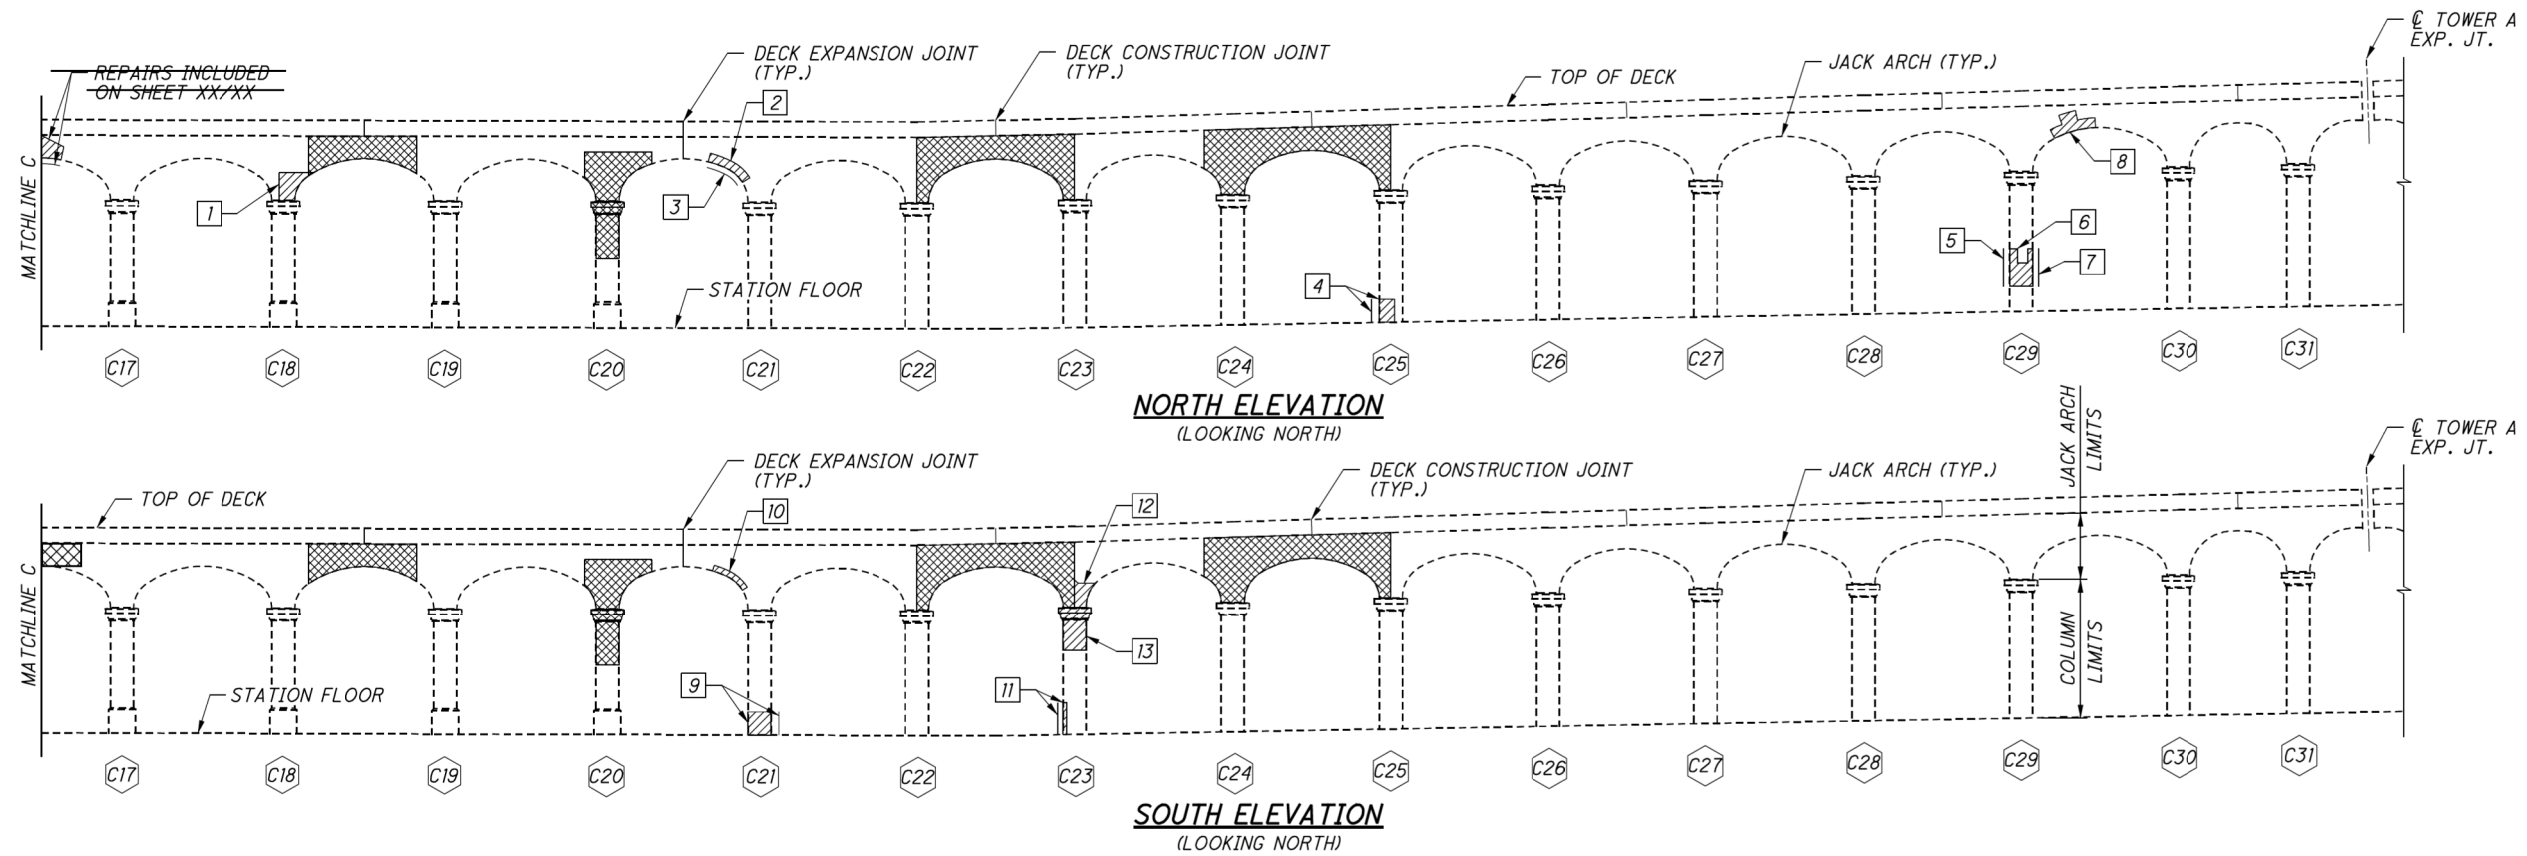

| ESTIMATED PATCHING QUANTITIES | | | |
|-------------------------------|-------------|-----------|------------------|
| REPAIR NO. | REPAIR TYPE | AREA (SF) | ANODE QUANTITY** |
| 1 | TYPE 1 | 5 | - |
| 2 | TYPE 1 | 3 | - |
| 3 | TYPE 2 | 7 | 4 |
| 4 | TYPE 1 | 7 | 2 |
| 5 | TYPE 1 | 2 | - |
| 6 | TYPE 1 | 7 | 2 |
| 7 | TYPE 1 | 2 | - |
| 8 | TYPE 1 | 6 | 3 |
| 9 | TYPE 1 | 8 | 3 |
| 10 | TYPE 1 | 2 | - |
| 11 | TYPE 1 | 6 | 2 |
| 12 | TYPE 1 | 3 | - |
| 13 | TYPE 1 | 6 | 2 |
| MEASURED QUANTITY* | | 64 | - |
| PLAN QUANTITY* | | 96 | 18 |

| SHEET QUANTITY SUMMARY | | | |
|------------------------|------|----------|--|
| ITEM | UNIT | QUANTITY | |
| TYPE 1 REPAIR | SF | 86 | |
| TYPE 2 REPAIR | SF | 10 | |

NOTES:


- MEASURED QUANTITIES ARE BASED ON THE INSPECTION PERFORMED IN SEPTEMBER 2016. THE EXACT DIMENSIONS AND LOCATIONS OF PATCHES SHALL BE DETERMINED BY THE ENGINEER IN THE FIELD FOR FINAL PAY QUANTITY.
- PLAN QUANTITIES INCLUDE 50% CONTINGENCY ADDED TO MEASURED QUANTITIES.
- ANODES ARE INCLUDED FOR PAYMENT WITH ITEM SPECIAL - PATCHING CONCRETE STRUCTURE, TYPE 1 OR 2 REPAIR.
- FOR DETAILS AND MAXIMUM GRID SPACING FOR THE EMBEDDED GALVANIC ANODES, SEE SHEET 84/89.
- EPOXY-URETHANE SEALER SHALL NOT BE APPLIED TO PATCHED OR REPLACED CONCRETE SURFACES.

LEGEND:

- # STATION COLUMN NUMBER
- # REPAIR NUMBER
- LOCATION OF DEFICIENT CONCRETE TO BE REPAIRED IN ACCORDANCE WITH ITEM SPECIAL - PATCHING CONCRETE STRUCTURE, TYPE 1 REPAIR
- LOCATION OF DEFICIENT CONCRETE ON PERPENDICULAR FACE (NOT VISIBLE IN ELEVATION VIEW) TO BE REPAIRED IN ACCORDANCE WITH ITEM SPECIAL - PATCHING CONCRETE STRUCTURE, TYPE 1 OR TYPE 2 REPAIR
- LOCATION OF DEFICIENT COLUMN OR JACK ARCH TO BE REPLACED. FOR REPLACEMENT DETAILS, SEE SHEETS 79/89 THRU 83/89

* SEE NOTES 1 & 2
 ** SEE NOTE 3

| | | | | |
|--------------------------------|-----------|--|--|-----------------------------------|
| GRAPHIC SCALE MEASURED IN FEET | DATE | 9902 Carver Road
Suite 201
Cincinnati, OH 45242
PH.: 614.699.5000 | DETROIT-SUPERIOR BRIDGE OVER CUYAHOGA RIVER
BRIDGE NO. CUY-6-1465 | |
| NOT TO SCALE | NOV, 2018 | | INFRASTRUCTURE ENGINEERS, INC. | WEST STATION CONC. REPAIR DETAILS |

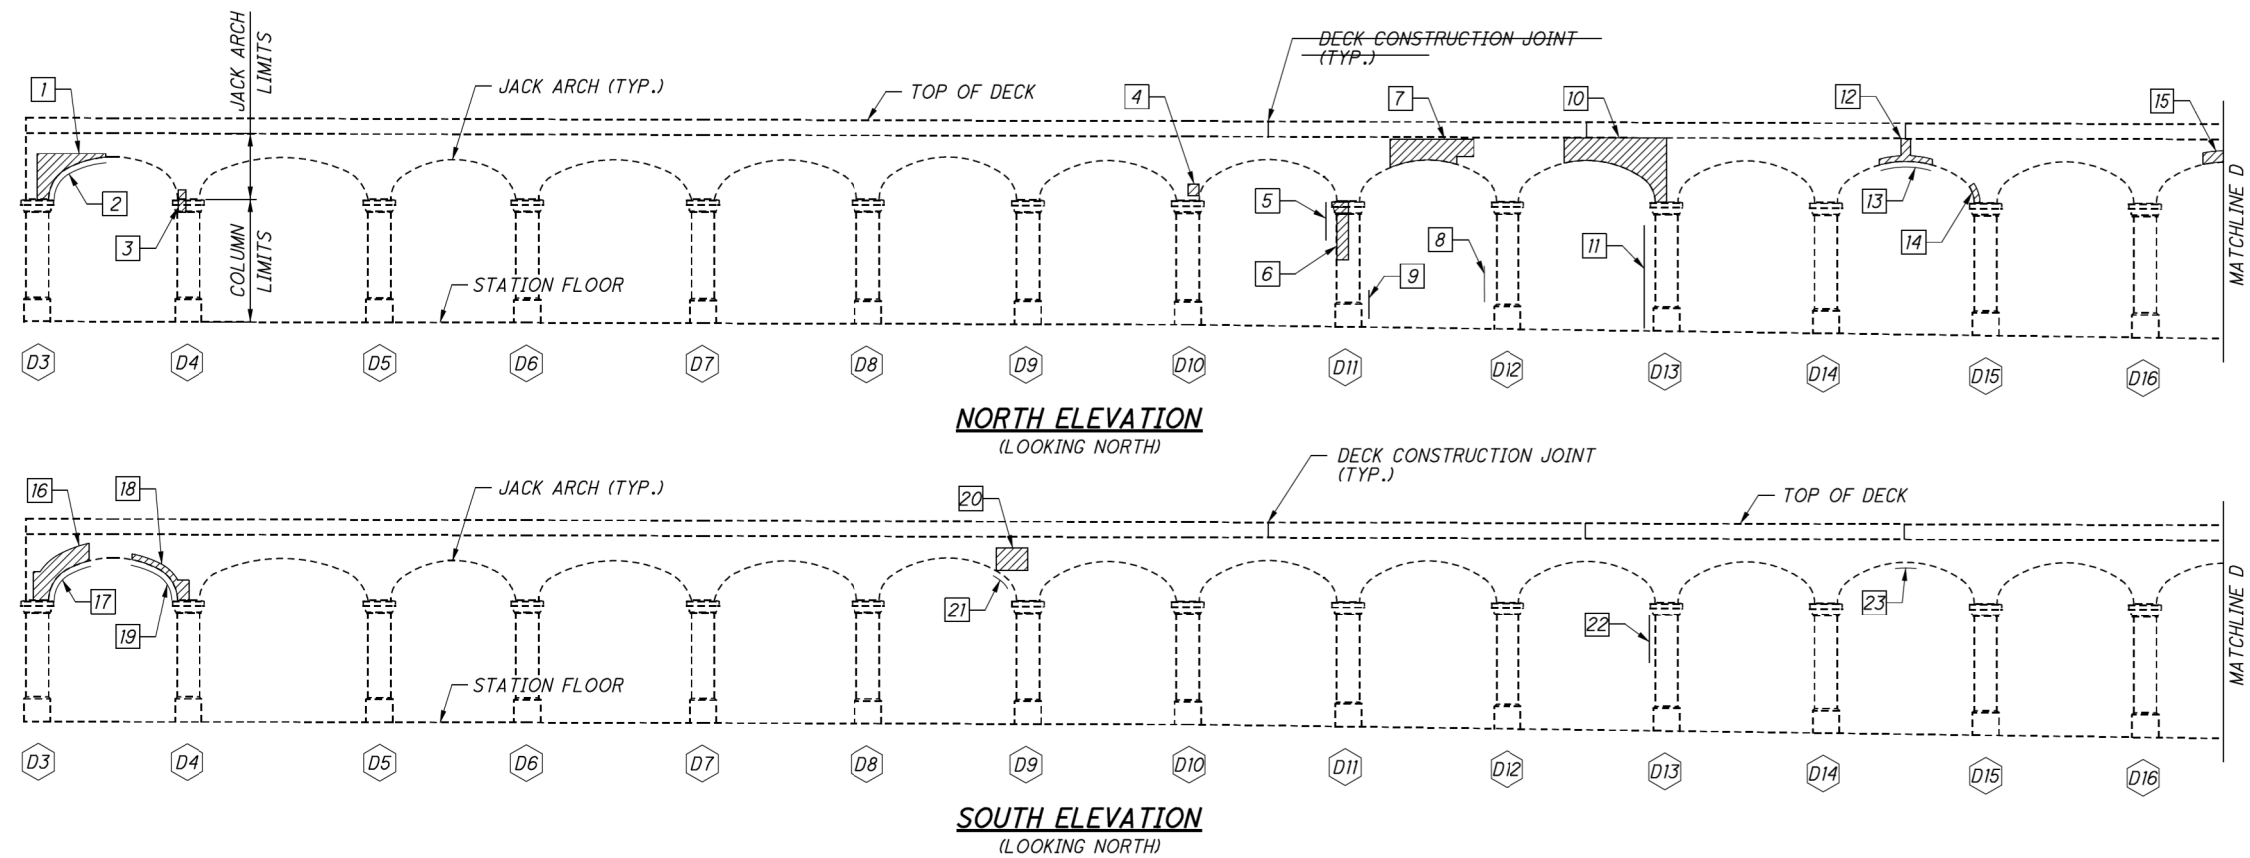

| ESTIMATED PATCHING QUANTITIES | | | |
|-------------------------------|-------------|-----------|------------------|
| REPAIR NO. | REPAIR TYPE | AREA (SF) | ANODE QUANTITY** |
| 1 | TYPE 1 | 10 | 5 |
| 2 | TYPE 2 | 4 | - |
| 3 | TYPE 1 | 2 | - |
| 4 | TYPE 1 | 1 | - |
| 5 | TYPE 1 | 4 | - |
| 6 | TYPE 1 | 6 | 4 |
| 7 | TYPE 1 | 14 | 6 |
| 8 | TYPE 1 | 7 | 2 |
| 9 | TYPE 1 | 5 | - |
| 10 | TYPE 1 | 27 | 18 |
| 11 | TYPE 1 | 9 | 7 |
| 12 | TYPE 1 | 4 | - |
| 13 | TYPE 2 | 3 | - |
| 14 | TYPE 1 | 1 | - |
| 15 | TYPE 1 | 3 | - |
| 16 | TYPE 1 | 10 | 8 |
| 17 | TYPE 2 | 3 | - |
| 18 | TYPE 1 | 5 | - |
| 19 | TYPE 2 | 3 | - |
| 20 | TYPE 1 | 7 | 4 |

| ESTIMATED PATCHING QUANTITIES | | | |
|-------------------------------|-------------|-----------|------------------|
| REPAIR NO. | REPAIR TYPE | AREA (SF) | ANODE QUANTITY** |
| 21 | TYPE 2 | 2 | - |
| 22 | TYPE 1 | 4 | - |
| 23 | TYPE 2 | 2 | - |
| MEASURED QUANTITY* | | 136 | - |
| PLAN QUANTITY* | | 204 | 54 |

* SEE NOTES 1 & 2
 ** SEE NOTE 3

| SHEET QUANTITY SUMMARY | | |
|------------------------|------|----------|
| ITEM | UNIT | QUANTITY |
| TYPE 1 REPAIR | SF | 178 |
| TYPE 2 REPAIR | SF | 26 |


NOTES:

- MEASURED QUANTITIES ARE BASED ON THE INSPECTION PERFORMED IN SEPTEMBER 2016. THE EXACT DIMENSIONS AND LOCATIONS OF PATCHES SHALL BE DETERMINED BY THE ENGINEER IN THE FIELD FOR FINAL PAY QUANTITY.
- PLAN QUANTITIES INCLUDE 50% CONTINGENCY ADDED TO MEASURED QUANTITIES.
- ANODES ARE INCLUDED FOR PAYMENT WITH ITEM SPECIAL - PATCHING CONCRETE STRUCTURE, TYPE 1 OR 2 REPAIR.
- FOR DETAILS AND MAXIMUM GRID SPACING FOR THE EMBEDDED GALVANIC ANODES, SEE SHEET [84/89].
- EPOXY-URETHANE SEALER SHALL NOT BE APPLIED TO PATCHED OR REPLACED CONCRETE SURFACES.

LEGEND:

- # STATION COLUMN NUMBER
- # REPAIR NUMBER
- LOCATION OF DEFICIENT CONCRETE TO BE REPAIRED IN ACCORDANCE WITH ITEM SPECIAL - PATCHING CONCRETE STRUCTURE, TYPE 1 REPAIR
- LOCATION OF DEFICIENT CONCRETE ON PERPENDICULAR FACE (NOT VISIBLE IN ELEVATION VIEW) TO BE REPAIRED IN ACCORDANCE WITH ITEM SPECIAL - PATCHING CONCRETE STRUCTURE, TYPE 1 OR TYPE 2 REPAIR
- LOCATION OF DEFICIENT COLUMN OR JACK ARCH TO BE REPLACED. FOR REPLACEMENT DETAILS, SEE SHEETS [79/89] THRU [83/89]

| | | | |
|--------------------------------|-----------|--|--|
| GRAPHIC SCALE MEASURED IN FEET | DATE | 9902 Carver Road
Suite 201
Cincinnati, OH 45242
PH.: 614.699.5000 | DETROIT-SUPERIOR BRIDGE OVER CUYAHOGA RIVER
BRIDGE NO. CUY-6-1465 |
| NOT TO SCALE | NOV, 2018 | INFRASTRUCTURE ENGINEERS, INC. | WEST STATION CONC. REPAIR DETAILS |
| | | | PAGE A-22 |

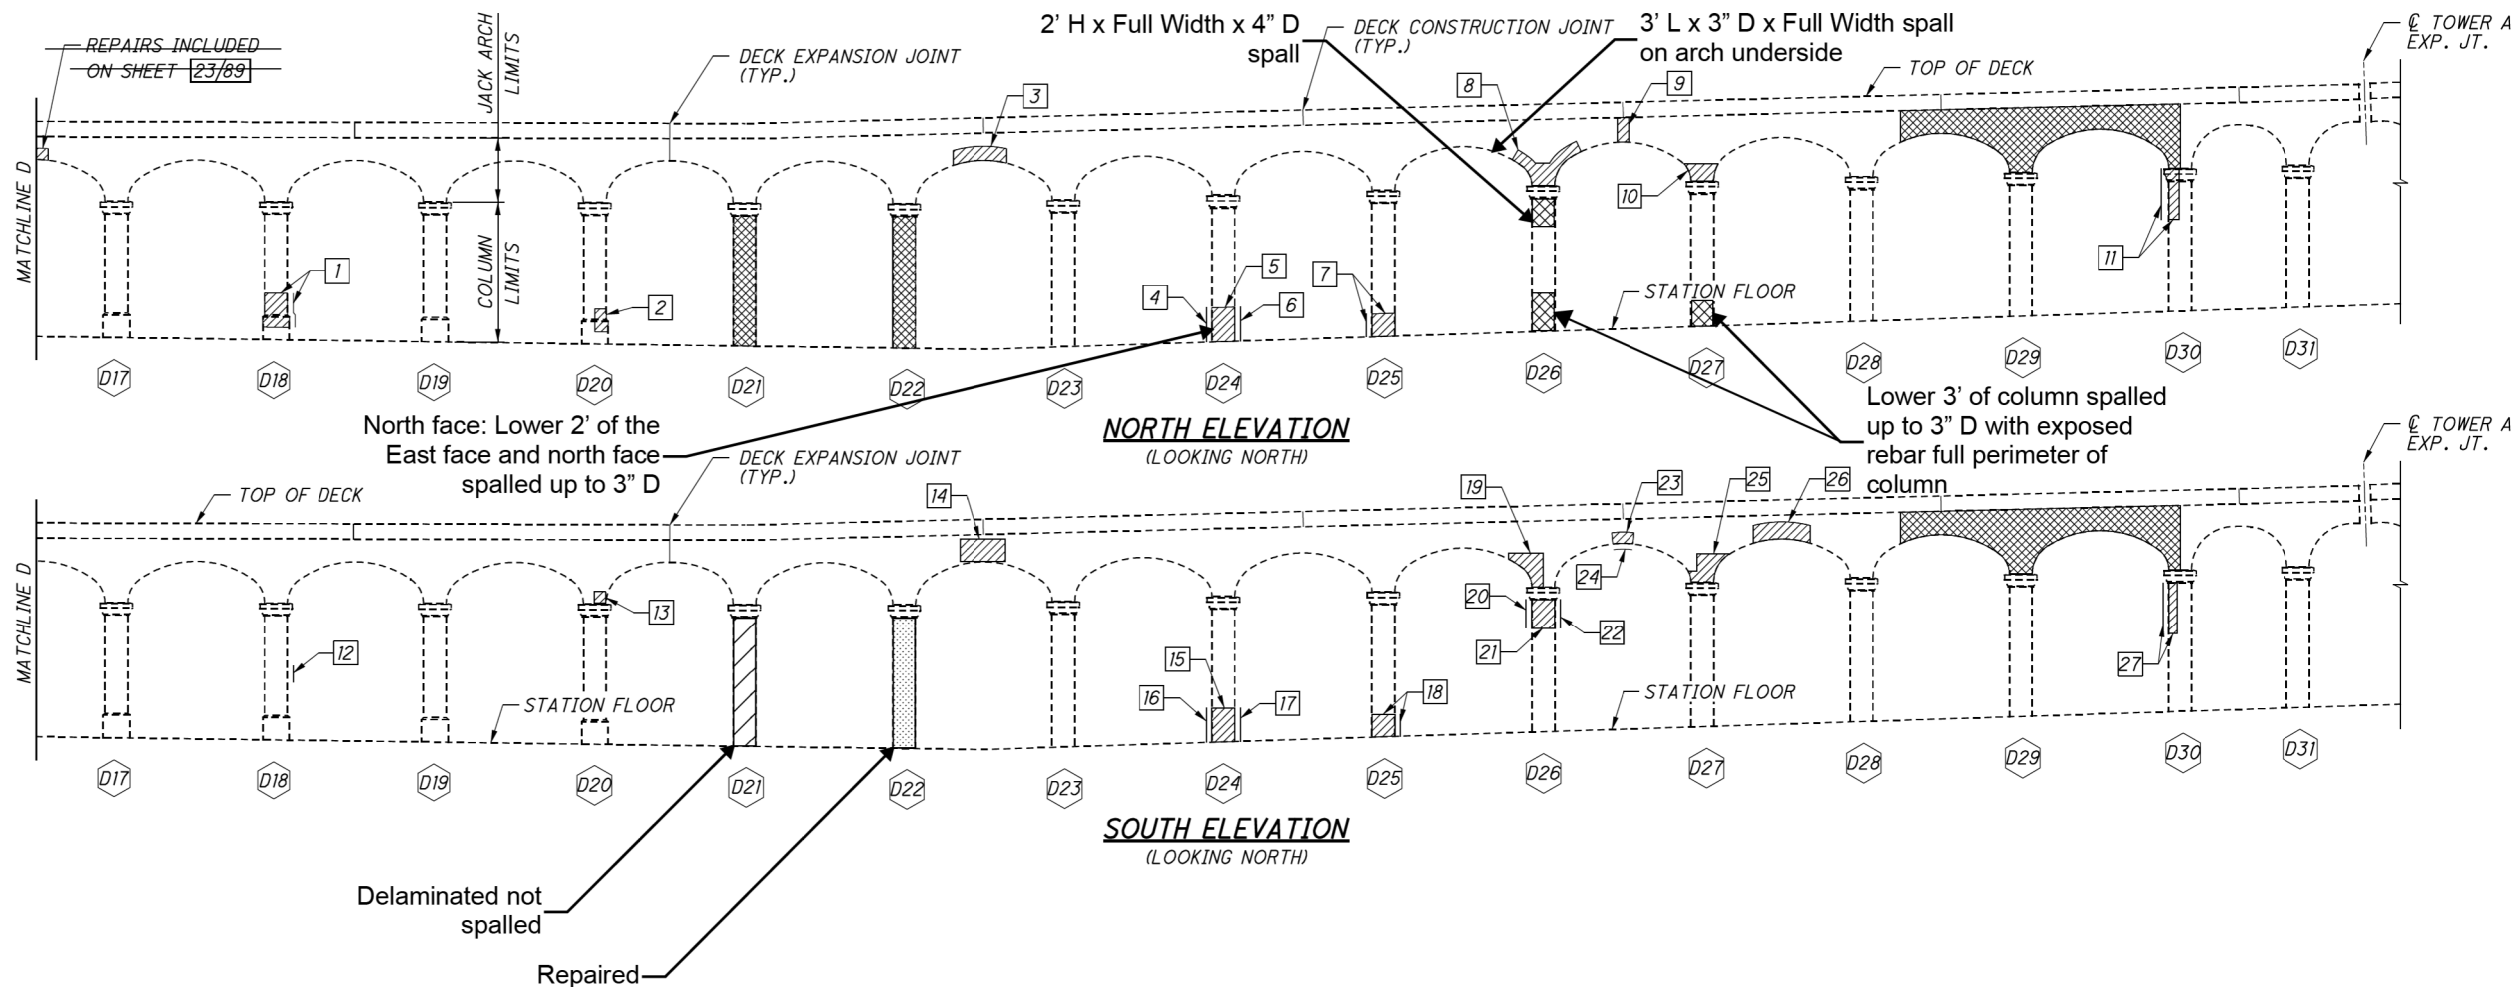

| ESTIMATED PATCHING QUANTITIES | | | |
|-------------------------------|-------------|-----------|------------------|
| REPAIR NO. | REPAIR TYPE | AREA (SF) | ANODE QUANTITY** |
| 1 | TYPE 1 | 12 | 6 |
| 2 | TYPE 1 | 2 | - |
| 3 | TYPE 1 | 6 | 4 |
| 4 | TYPE 1 | 6 | 2 |
| 5 | TYPE 1 | 6 | 2 |
| 6 | TYPE 1 | 6 | 2 |
| 7 | TYPE 1 | 8 | 3 |
| 8 | TYPE 1 | 9 | 5 |
| 9 | TYPE 1 | 2 | - |
| 10 | TYPE 1 | 4 | - |
| 11 | TYPE 1 | 9 | 3 |
| 12 | TYPE 1 | 3 | - |
| 13 | TYPE 1 | 1 | - |
| 14 | TYPE 1 | 8 | 6 |
| 15 | TYPE 1 | 6 | 2 |
| 16 | TYPE 1 | 6 | 2 |
| 17 | TYPE 1 | 6 | 2 |
| 18 | TYPE 1 | 8 | 3 |
| 19 | TYPE 1 | 5 | - |
| 20 | TYPE 1 | 2 | - |

| ESTIMATED PATCHING QUANTITIES | | | |
|-------------------------------|-------------|-----------|------------------|
| REPAIR NO. | REPAIR TYPE | AREA (SF) | ANODE QUANTITY** |
| 21 | TYPE 1 | 5 | - |
| 22 | TYPE 1 | 2 | - |
| 23 | TYPE 1 | 2 | - |
| 24 | TYPE 2 | 2 | - |
| 25 | TYPE 1 | 7 | 6 |
| 26 | TYPE 1 | 8 | 4 |
| 27 | TYPE 1 | 13 | 6 |
| MEASURED QUANTITY* | | 154 | - |
| PLAN QUANTITY* | | 231 | 58 |

* SEE NOTES 1 & 2
 ** SEE NOTE 3

| SHEET QUANTITY SUMMARY | | |
|------------------------|------|----------|
| ITEM | UNIT | QUANTITY |
| TYPE 1 REPAIR | SF | 228 |
| TYPE 2 REPAIR | SF | 3 |


NOTES:

- MEASURED QUANTITIES ARE BASED ON THE INSPECTION PERFORMED IN SEPTEMBER 2016. THE EXACT DIMENSIONS AND LOCATIONS OF PATCHES SHALL BE DETERMINED BY THE ENGINEER IN THE FIELD FOR FINAL PAY QUANTITY.
- PLAN QUANTITIES INCLUDE 50% CONTINGENCY ADDED TO MEASURED QUANTITIES.
- ANODES ARE INCLUDED FOR PAYMENT WITH ITEM SPECIAL - PATCHING CONCRETE STRUCTURE, TYPE 1 OR 2 REPAIR.
- FOR DETAILS AND MAXIMUM GRID SPACING FOR THE EMBEDDED GALVANIC ANODES, SEE SHEET 84/89.
- EPOXY-URETHANE SEALER SHALL NOT BE APPLIED TO PATCHED OR REPLACED CONCRETE SURFACES.

LEGEND:

- # STATION COLUMN NUMBER
- # REPAIR NUMBER
- ▨ LOCATION OF DEFICIENT CONCRETE TO BE REPAIRED IN ACCORDANCE WITH ITEM SPECIAL - PATCHING CONCRETE STRUCTURE, TYPE 1 REPAIR
- ▨ LOCATION OF DEFICIENT CONCRETE ON PERPENDICULAR FACE (NOT VISIBLE IN ELEVATION VIEW) TO BE REPAIRED IN ACCORDANCE WITH ITEM SPECIAL - PATCHING CONCRETE STRUCTURE, TYPE 1 OR TYPE 2 REPAIR
- ▨ LOCATION OF DEFICIENT COLUMN OR JACK ARCH TO BE REPLACED. FOR REPLACEMENT DETAILS, SEE SHEETS 79/89 THRU 83/89

| | | | |
|--------------------------------|-----------|---|--|
| GRAPHIC SCALE MEASURED IN FEET | DATE | 
9902 Carver Road
Suite 201
Cincinnati, OH 45242
PH.: 614.699.5000 | DETROIT-SUPERIOR BRIDGE OVER CUYAHOGA RIVER
BRIDGE NO. CUY-6-1465 |
| NOT TO SCALE | NOV, 2018 | INFRASTRUCTURE ENGINEERS, INC. | WEST STATION CONC. REPAIR DETAILS |
| | | | PAGE A-23 |


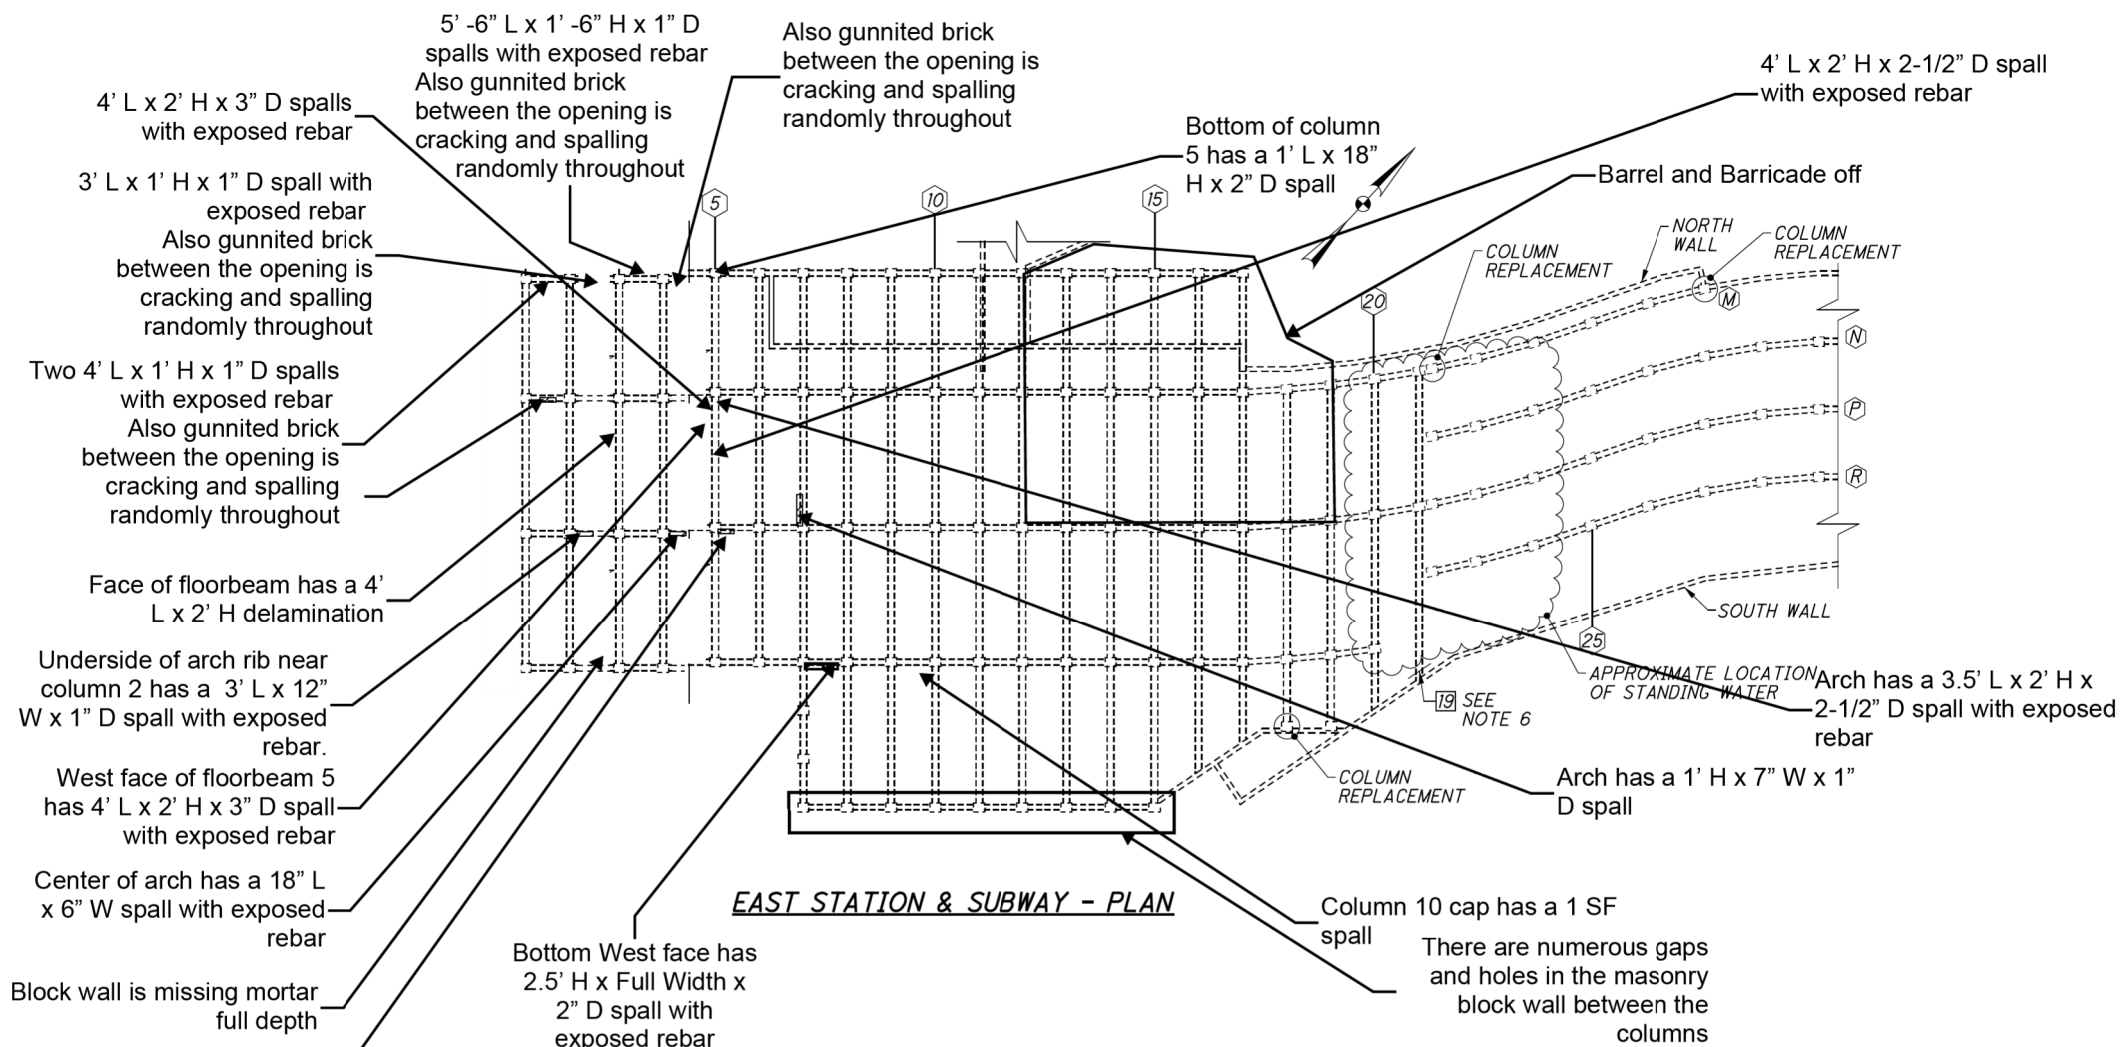


| ESTIMATED PATCHING QUANTITIES | | | |
|-------------------------------|-------------|-----------|------------------|
| REPAIR NO. | REPAIR TYPE | AREA (SF) | ANODE QUANTITY** |
| 1 ‡ | TYPE 1 | 183 | 42 |
| 2 | TYPE 1 | 120 | 28 |
| 3 | TYPE 1 | 3 | - |
| 4 | TYPE 1 | 80 | 20 |
| 5 | TYPE 1 | 4 | - |
| 6 | TYPE 1 | 11 | - |
| 7 ‡ | TYPE 1 | 111 | 30 |
| 8 | TYPE 1 | 27 | 27 |
| 9 | TYPE 1 | 6 | - |
| 10 | TYPE 1 | 21 | 12 |
| 11 | TYPE 1 | 4 | - |
| 12 | TYPE 1 | 10 | 6 |
| 13 | TYPE 1 | 2 | - |
| 14 | TYPE 1 | 4 | - |
| 15 | TYPE 1 | 7 | 2 |
| 16 | TYPE 1 | 18 | 14 |
| 17 | TYPE 1 | 13 | 6 |
| 18 | TYPE 1 | 6 | 2 |
| 19 | TYPE 1 | 70 | 34 |
| MEASURED QUANTITY* | | 700 | - |
| PLAN QUANTITY* | | 1050 | 223 |

* SEE NOTES 1 & 2 ‡ SEE NOTE 8
 ** SEE NOTES 3 & 4


| SHEET QUANTITY SUMMARY | | |
|------------------------|------|----------|
| ITEM | UNIT | QUANTITY |
| TYPE 1 REPAIR | SF | 1050 |
| TYPE 2 REPAIR | SF | - |

- NOTES:**
- MEASURED QUANTITIES ARE BASED ON THE INSPECTION PERFORMED IN JANUARY 2016. THE EXACT DIMENSIONS AND LOCATIONS OF PATCHES SHALL BE DETERMINED BY THE ENGINEER IN THE FIELD FOR FINAL PAY QUANTITY.
 - PLAN QUANTITIES INCLUDE 50% CONTINGENCY ADDED TO MEASURED QUANTITIES.
 - ANODES ARE INCLUDED FOR PAYMENT WITH ITEM SPECIAL - PATCHING CONCRETE STRUCTURE, TYPE 1 REPAIR.
 - FOR DETAILS AND MAXIMUM GRID SPACING FOR THE EMBEDDED GALVANIC ANODES, SEE SHEET [84/89].
 - EPOXY-URETHANE SEALER SHALL NOT BE APPLIED TO PATCHED OR REPLACED CONCRETE SURFACES IN THE EAST STATION AND EAST SUBWAY.
 - THE CONTRACTOR SHALL REMOVE DEBRIS THAT OBSTRUCTS THE PATCHING OF THE SOUTH WALL. PAYMENT SHALL BE INCLUDED AS PART OF ITEM 202 - PORTIONS OF STRUCTURE REMOVED OVER 20 FOOT SPAN, AS PER PLAN.
 - FOR DETAILS OF COLUMNS AND JACK ARCH REPLACEMENT, SEE SHEETS [79/89] THRU [83/89].
 - WALL REPAIR EXTENDS BEHIND COLUMN TO BE REPLACED.

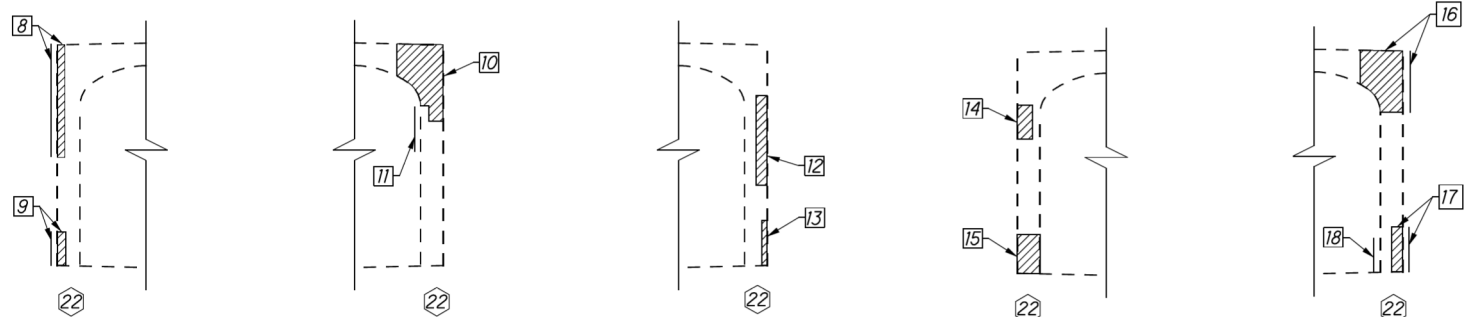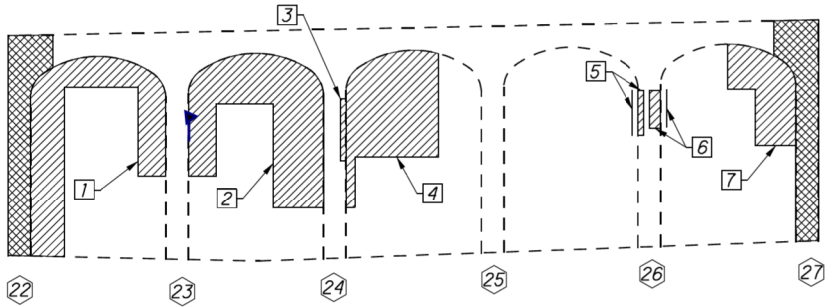


- LEGEND:**
- ⊕ STATION COLUMN NUMBER
 - # REPAIR NUMBER
 - [Hatched Box] LOCATION OF DEFICIENT CONCRETE TO BE REPAIRED IN ACCORDANCE WITH ITEM SPECIAL - PATCHING CONCRETE STRUCTURES, TYPE 1 REPAIR
 - [Dashed Line] LOCATION OF DEFICIENT CONCRETE ON PERPENDICULAR FACE (NOT VISIBLE IN ELEVATION VIEW) TO BE REPAIRED IN ACCORDANCE WITH ITEM SPECIAL PATCHING CONCRETE STRUCTURES, TYPE 1 REPAIR
 - [Cross-hatched Box] LOCATION OF DEFICIENT COLUMN OR JACK ARCH TO BE REPLACED.

| | | | | |
|--------------------------------|-----------|--|--|--------------------------------------|
| GRAPHIC SCALE MEASURED IN FEET | DATE | 9902 Carver Road
Suite 201
Cincinnati, OH 45242
PH.: 614.699.5000 | DETROIT-SUPERIOR BRIDGE OVER CUYAHOGA RIVER
BRIDGE NO. CUY-6-1465 | |
| NOT TO SCALE | NOV, 2018 | | INFRASTRUCTURE ENGINEERS, INC. | EAST STATION & SUBWAY REPAIR DETAILS |

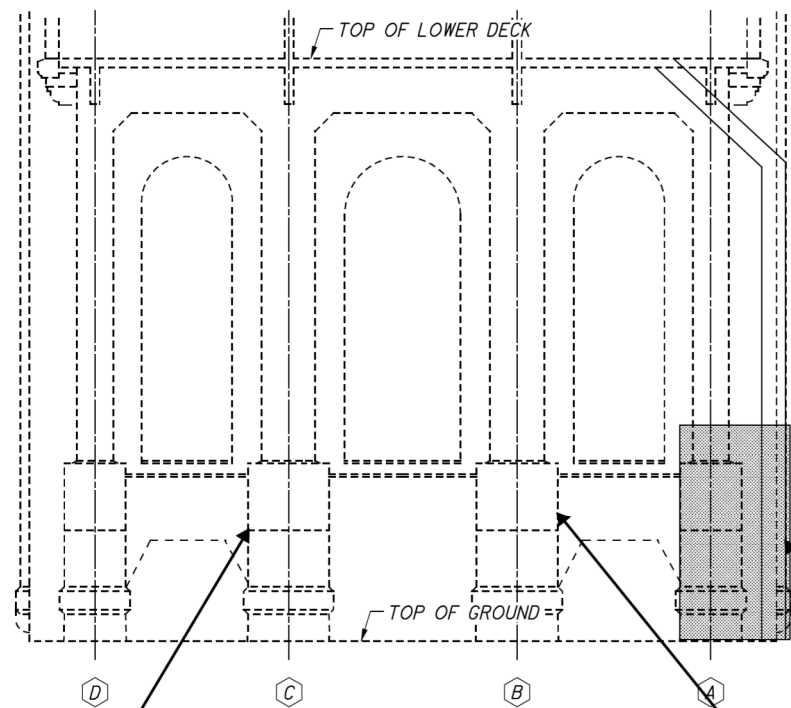


PIER 3 - EAST ELEVATION

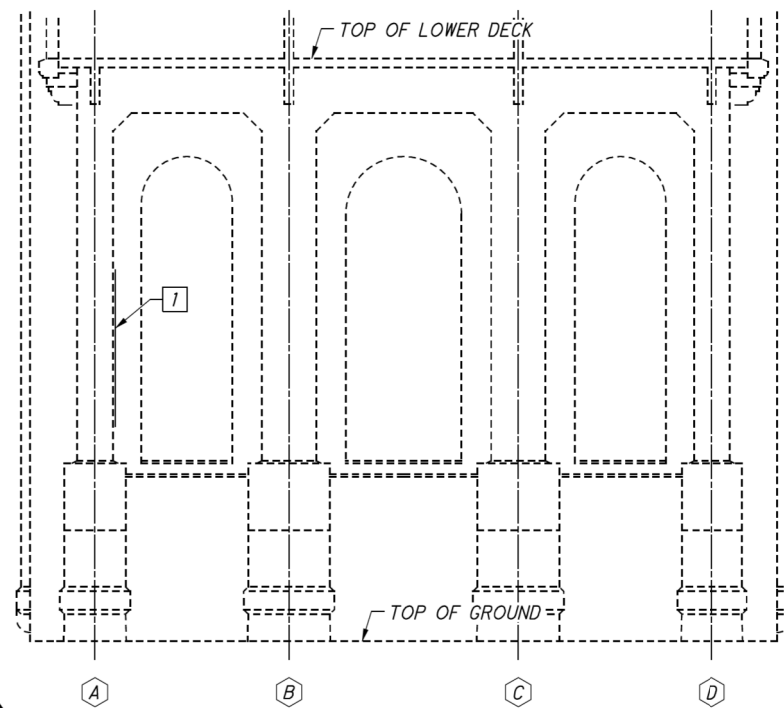


PIER 3 - WEST ELEVATION

Debris accumulations along bearings and bearing seats.

Vine growth covering concrete.

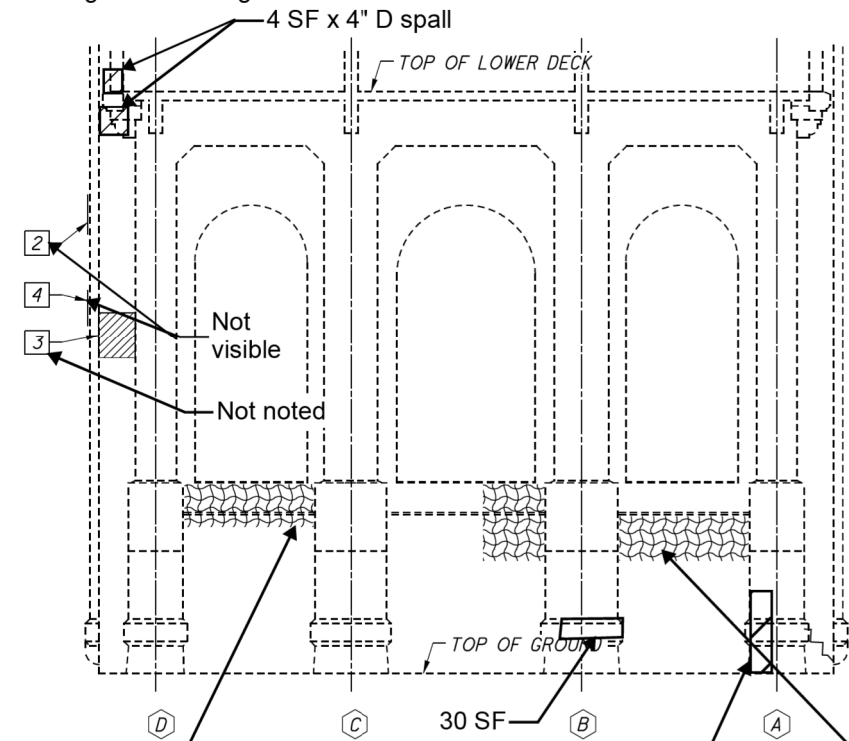

PIER 4 - EAST ELEVATION

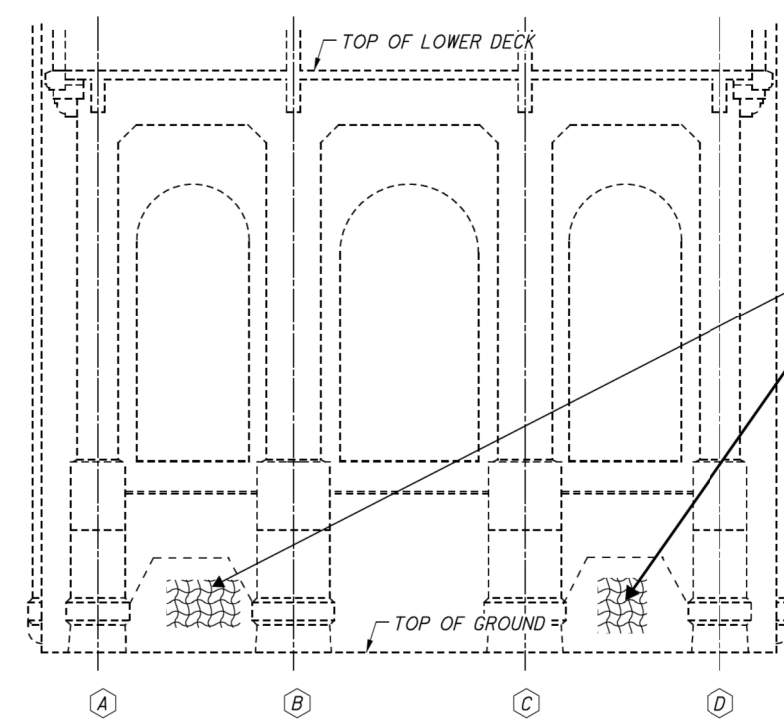

PIER 4 - WEST ELEVATION

7' W x 4' W map cracking.

Full Height x Full Width x 1' D

30 SF map cracking

| ESTIMATED PATCHING QUANTITIES | | | |
|-------------------------------|-------------|-----------|------------------|
| REPAIR NO. | REPAIR TYPE | AREA (SF) | ANODE QUANTITY** |
| 1 | TYPE 1 | 14 | 6 |
| 2 | TYPE 1 | 6 | 2 |
| 3 | TYPE 1 | 36 | 12 |
| 4 | TYPE 1 | 2 | 1 |
| MEASURED QUANTITY* | | 58 | - |
| PLAN QUANTITY* | | 87 | 21 |

* SEE NOTES 1 & 2
** SEE NOTE 3

| SHEET QUANTITY SUMMARY | | |
|------------------------|------|----------|
| ITEM | UNIT | QUANTITY |
| TYPE 1 REPAIR | SF | 87 |
| TYPE 2 REPAIR | SF | - |


NOTES:

1. MEASURED QUANTITIES ARE BASED ON THE INSPECTION PERFORMED IN SEPTEMBER 2016. THE EXACT DIMENSIONS AND LOCATIONS OF PATCHES SHALL BE DETERMINED BY THE ENGINEER IN THE FIELD FOR FINAL PAY QUANTITY.
2. PLAN QUANTITIES INCLUDE 50% CONTINGENCY ADDED TO MEASURED QUANTITIES.
3. ANODES ARE INCLUDED FOR PAYMENT WITH ITEM SPECIAL - PATCHING CONCRETE STRUCTURE, TYPE 1 OR 2 REPAIR.
4. FOR DETAILS AND MAXIMUM GRID SPACING FOR THE EMBEDDED GALVANIC ANODES, SEE SHEET 84/89.

LEGEND:

- (X) ARCH RIB LINE
- # REPAIR NUMBER
- [Hatched Box] LOCATION OF DEFICIENT CONCRETE TO BE REPAIRED IN ACCORDANCE WITH ITEM SPECIAL - PATCHING CONCRETE STRUCTURE, TYPE 1 REPAIR
- [Vertical Line] LOCATION OF DEFICIENT CONCRETE ON PERPENDICULAR FACE (NOT VISIBLE IN ELEVATION VIEW) TO BE REPAIRED IN ACCORDANCE WITH ITEM SPECIAL - PATCHING CONCRETE STRUCTURE, TYPE 1 OR TYPE 2 REPAIR



| | | | |
|--------------------------------|-----------|---|--|
| GRAPHIC SCALE MEASURED IN FEET | DATE | 
9902 Carver Road
Suite 201
Cincinnati, OH 45242
PH.: 614.699.5000 | DETROIT-SUPERIOR BRIDGE OVER CUYAHOGA RIVER
BRIDGE NO. CUY-6-1465 |
| NOT TO SCALE | NOV, 2018 | INFRASTRUCTURE ENGINEERS, INC. | PIER CONCRETE REPAIR DETAILS |
| | | | PAGE A-25 |

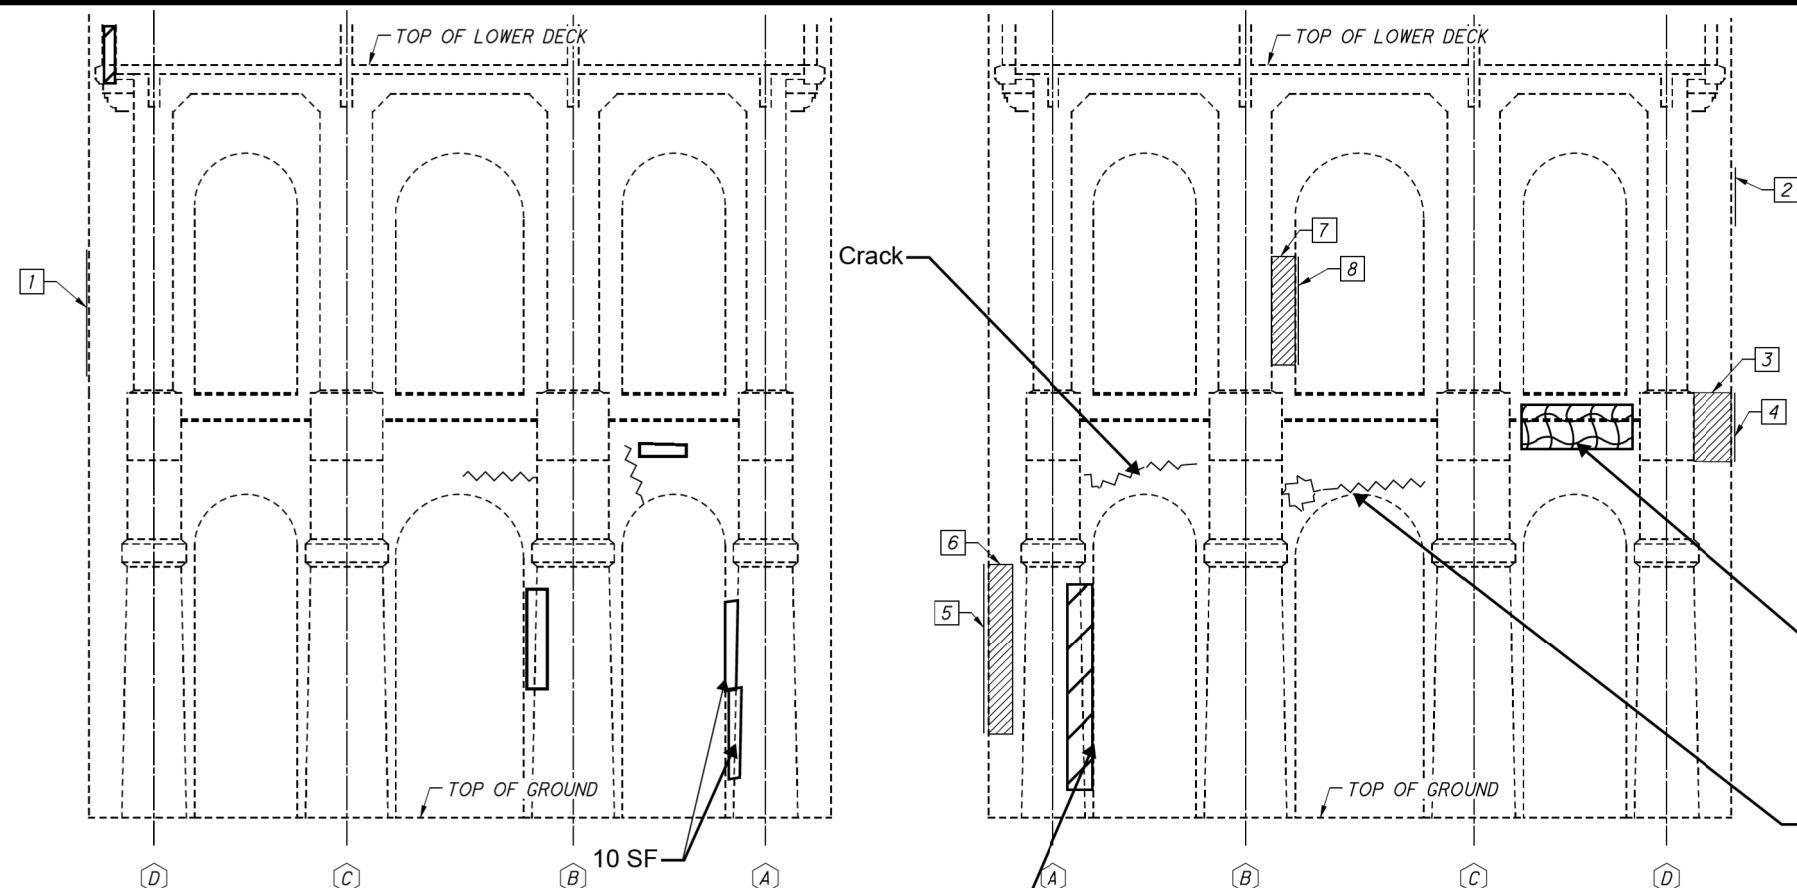

| ESTIMATED PATCHING QUANTITIES | | | |
|-------------------------------|-------------|-----------|------------------|
| REPAIR NO. | REPAIR TYPE | AREA (SF) | ANODE QUANTITY** |
| 1 | TYPE 1 | 28 | 9 |
| 2 | TYPE 1 | 4 | 1 |
| 3 | TYPE 1 | 16 | 5 |
| 4 | TYPE 1 | 5 | 2 |
| 5 | TYPE 1 | 12 | 7 |
| 6 | TYPE 1 | 24 | 7 |
| 7 | TYPE 1 | 3 | 3 |
| 8 | TYPE 1 | 3 | 3 |
| 9 | TYPE 1 | 1 | 1 |
| 10 | TYPE 1 | 4 | 1 |
| MEASURED QUANTITY* | | 100 | - |
| PLAN QUANTITY* | | 150 | 39 |

* SEE NOTES 1 & 2
 ** SEE NOTE 3

| SHEET QUANTITY SUMMARY | | |
|------------------------|------|----------|
| ITEM | UNIT | QUANTITY |
| TYPE 1 REPAIR | SF | 150 |
| TYPE 2 REPAIR | SF | - |

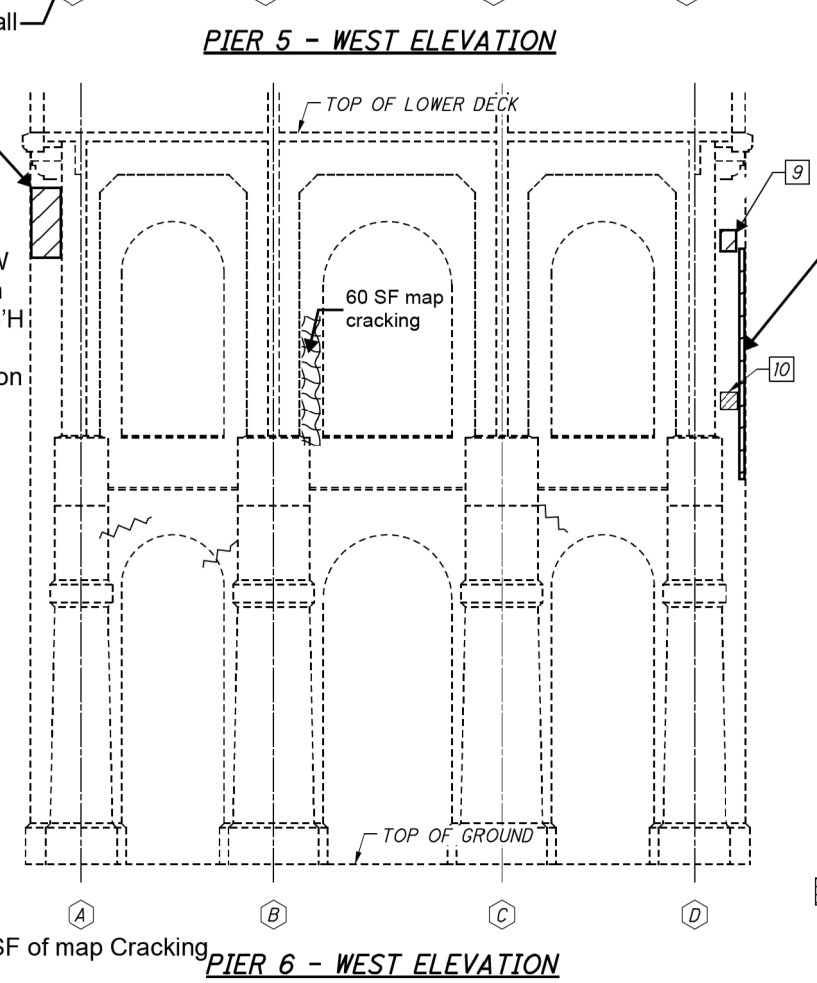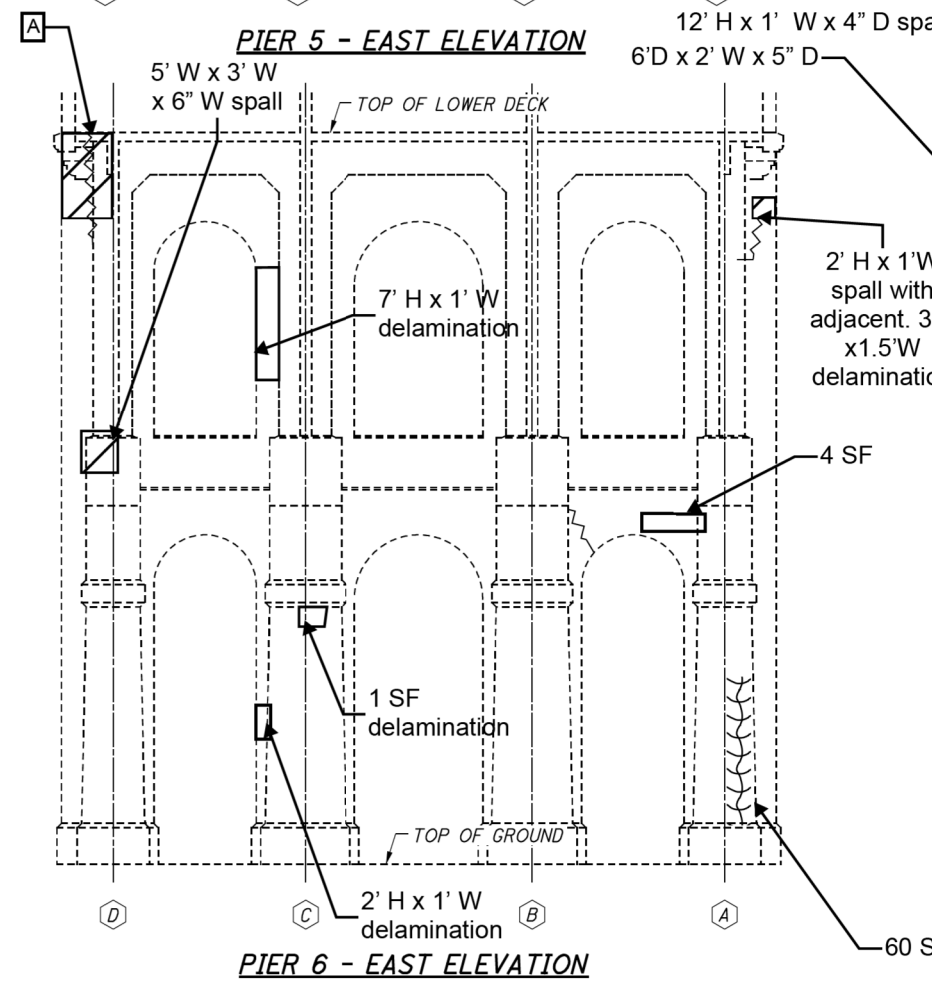



30' H x 7' W area of spalls and associated delaminations.

DEFECT NOTE:
 A: TOP 15' H X 7' W APPEARS TO BE FALLING/ROTATING AWAY FROM THE ARCH RIBS. APPEARS THERE IS A 2'-3" GAP NEAR THE TOP AND NO GAP AT LOWER DECK LEVEL. CRACK ALONG SOUTH FACE ALMOST FULL WIDTH OF THE SECTION IN QUESTION.

- NOTES:**
1. MEASURED QUANTITIES ARE BASED ON THE INSPECTION PERFORMED IN SEPTEMBER 2016. THE EXACT DIMENSIONS AND LOCATIONS OF PATCHES SHALL BE DETERMINED BY THE ENGINEER IN THE FIELD FOR FINAL PAY QUANTITY.
 2. PLAN QUANTITIES INCLUDE 50% CONTINGENCY ADDED TO MEASURED QUANTITIES.
 3. ANODES ARE INCLUDED FOR PAYMENT WITH ITEM SPECIAL - PATCHING CONCRETE STRUCTURE, TYPE 1 OR 2 REPAIR.
 4. FOR DETAILS AND MAXIMUM GRID SPACING FOR THE EMBEDDED GALVANIC ANODES, SEE SHEET [84/89].

- LEGEND:**
- (X) ARCH RIB LINE
 - # REPAIR NUMBER
 - [Hatched Box] LOCATION OF DEFICIENT CONCRETE TO BE REPAIRED IN ACCORDANCE WITH ITEM SPECIAL - PATCHING CONCRETE STRUCTURE, TYPE 1 REPAIR
 - [Vertical Line] LOCATION OF DEFICIENT CONCRETE ON PERPENDICULAR FACE (NOT VISIBLE IN ELEVATION VIEW) TO BE REPAIRED IN ACCORDANCE WITH ITEM SPECIAL - PATCHING CONCRETE STRUCTURE, TYPE 1 OR TYPE 2 REPAIR

| | | | | |
|--------------------------------|--------------------------------|--|---|-----------|
| GRAPHIC SCALE MEASURED IN FEET | DATE | 9902 Carver Road
Suite 201
Cincinnati, OH 45242
PH.: 614.699.5000 | DETROIT-SUPERIOR BRIDGE OVER CUYAHOGA RIVER | |
| | NOV, 2018 | | BRIDGE NO. CUY-6-1465 | |
| NOT TO SCALE | INFRASTRUCTURE ENGINEERS, INC. | | PIER CONCRETE REPIAR DETAILS | PAGE A-26 |

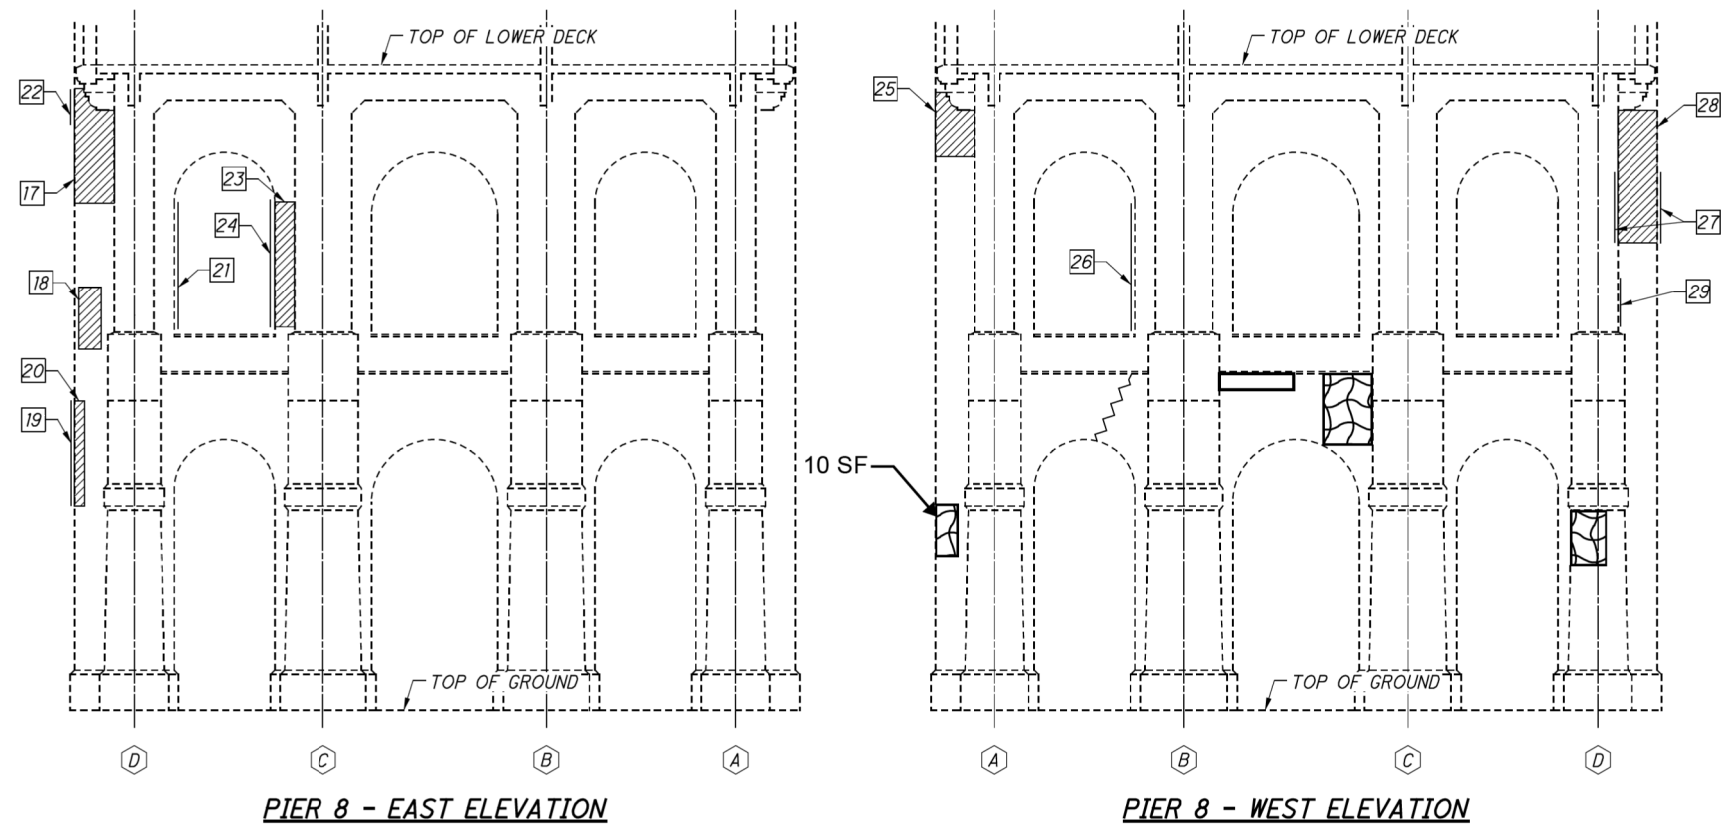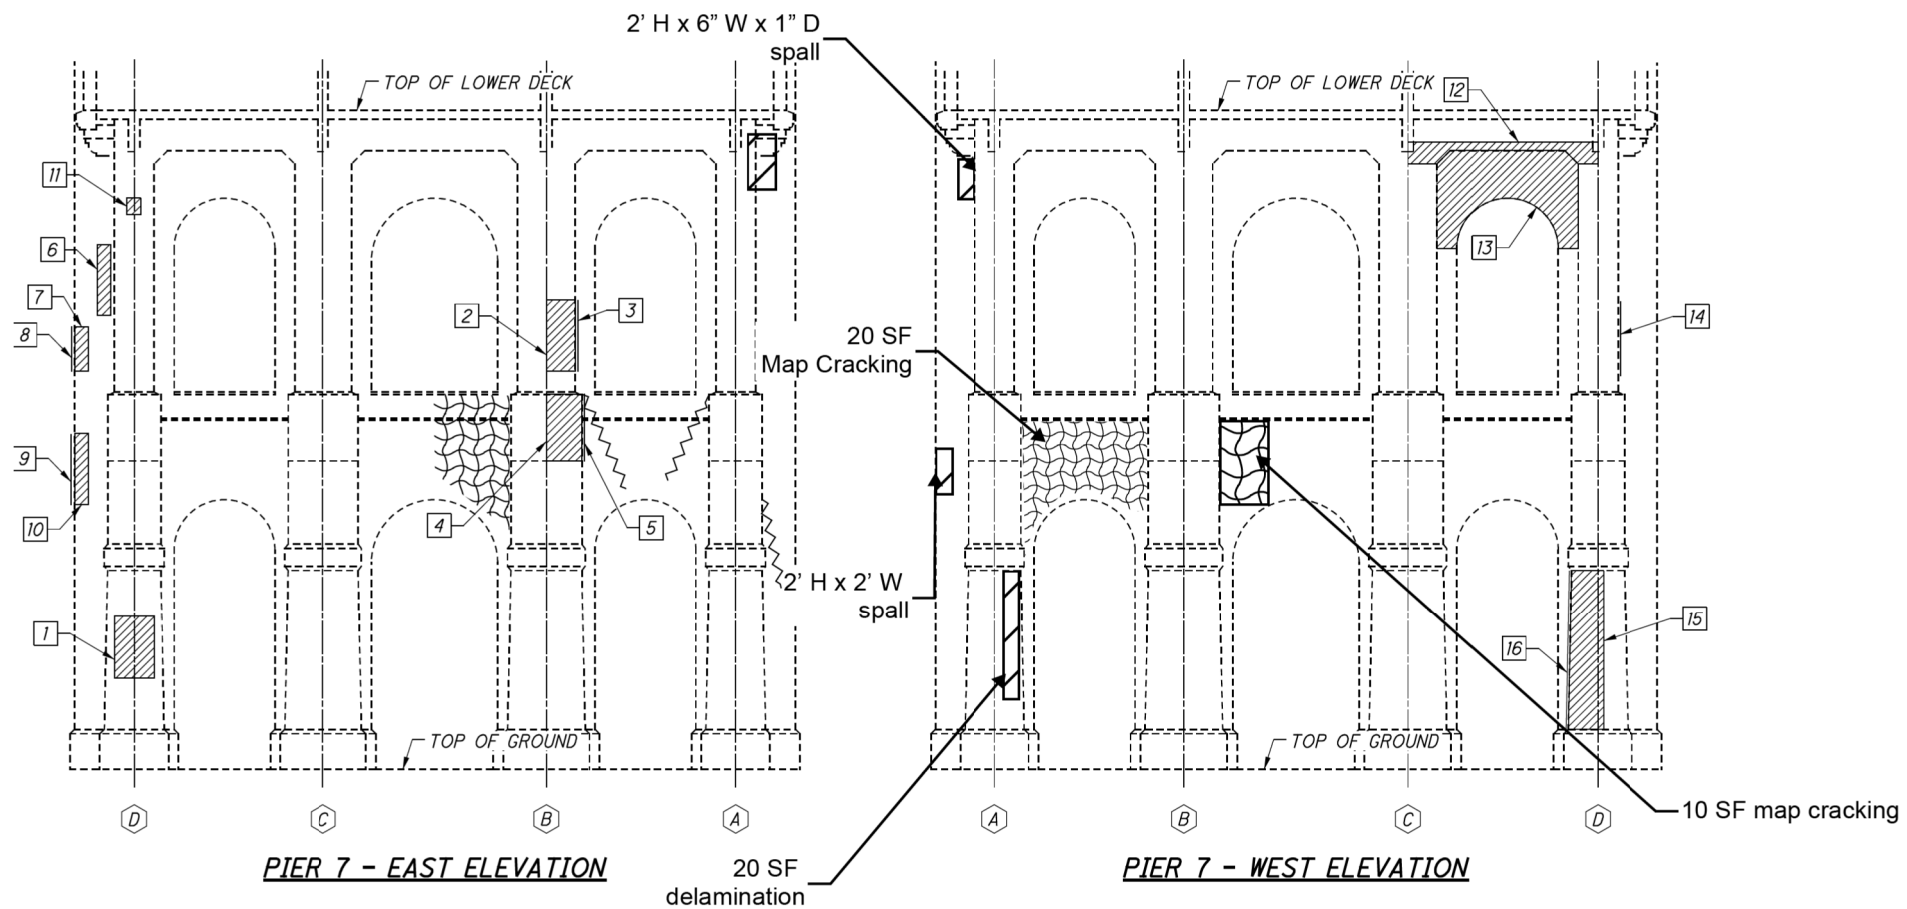

| ESTIMATED PATCHING QUANTITIES | | | |
|-------------------------------|-------------|-----------|------------------|
| REPAIR NO. | REPAIR TYPE | AREA (SF) | ANODE QUANTITY** |
| 1 | TYPE 1 | 9 | 4 |
| 2 | TYPE 1 | 12 | 3 |
| 3 | TYPE 1 | 3 | 3 |
| 4 | TYPE 1 | 8 | 5 |
| 5 | TYPE 1 | 6 | 5 |
| 6 | TYPE 1 | 7 | 3 |
| 7 | TYPE 1 | 6 | 7 |
| 8 | TYPE 1 | 6 | 7 |
| 9 | TYPE 1 | 4 | 1 |
| 10 | TYPE 1 | 4 | 1 |
| 11 | TYPE 1 | 1 | 1 |
| 12 | TYPE 1 | 152 | 30 |
| 13 | TYPE 1 | 71 | 26 |
| 14 | TYPE 1 | 18 | 5 |
| 15 | TYPE 1 | 67 | 20 |
| 16 | TYPE 1 | 34 | 10 |
| 17 | TYPE 1 | 83 | 24 |
| 18 | TYPE 1 | 21 | 8 |
| 19 | TYPE 1 | 5 | 2 |
| 20 | TYPE 1 | 15 | 9 |
| 21 | TYPE 1 | 15 | 9 |
| 22 | TYPE 1 | 8 | 5 |
| 23 | TYPE 1 | 45 | 18 |
| 24 | TYPE 1 | 15 | 9 |
| 25 | TYPE 1 | 32 | 10 |
| 26 | TYPE 1 | 150 | 26 |
| 27 | TYPE 1 | 9 | 4 |
| 28 | TYPE 1 | 68 | 20 |
| 29 | TYPE 1 | 17 | 6 |
| MEASURED QUANTITY* | | 891 | - |
| PLAN QUANTITY* | | 1337 | 281 |

* SEE NOTES 1 & 2
 ** SEE NOTE 3

| SHEET QUANTITY SUMMARY | | |
|------------------------|------|----------|
| ITEM | UNIT | QUANTITY |
| TYPE 1 REPAIR | SF | 1337 |
| TYPE 2 REPAIR | SF | - |


NOTES:

- MEASURED QUANTITIES ARE BASED ON THE INSPECTION PERFORMED IN SEPTEMBER 2016. THE EXACT DIMENSIONS AND LOCATIONS OF PATCHES SHALL BE DETERMINED BY THE ENGINEER IN THE FIELD FOR FINAL PAY QUANTITY.
- PLAN QUANTITIES INCLUDE 50% CONTINGENCY ADDED TO MEASURED QUANTITIES.
- ANODES ARE INCLUDED FOR PAYMENT WITH ITEM SPECIAL - PATCHING CONCRETE STRUCTURE, TYPE 1 OR 2 REPAIR.
- FOR DETAILS AND MAXIMUM GRID SPACING FOR THE EMBEDDED GALVANIC ANODES, SEE SHEET [84/89].

LEGEND:

- (X) ARCH RIB LINE
- # REPAIR NUMBER
- [Hatched Box] LOCATION OF DEFICIENT CONCRETE TO BE REPAIRED IN ACCORDANCE WITH ITEM SPECIAL - PATCHING CONCRETE STRUCTURE, TYPE 1 REPAIR
- [Dashed Box] LOCATION OF DEFICIENT CONCRETE ON PERPENDICULAR FACE (NOT VISIBLE IN ELEVATION VIEW) TO BE REPAIRED IN ACCORDANCE WITH ITEM SPECIAL - PATCHING CONCRETE STRUCTURE, TYPE 1 OR TYPE 2 REPAIR

| | | | | |
|--------------------------------|-----------|--|--|------------------------------|
| GRAPHIC SCALE MEASURED IN FEET | DATE | 9902 Carver Road
Suite 201
Cincinnati, OH 45242
PH.: 614.699.5000 | DETROIT-SUPERIOR BRIDGE OVER CUYAHOGA RIVER
BRIDGE NO. CUY-6-1465 | |
| NOT TO SCALE | NOV, 2018 | | INFRASTRUCTURE ENGINEERS, INC. | PIER CONCRETE REPIAR DETAILS |

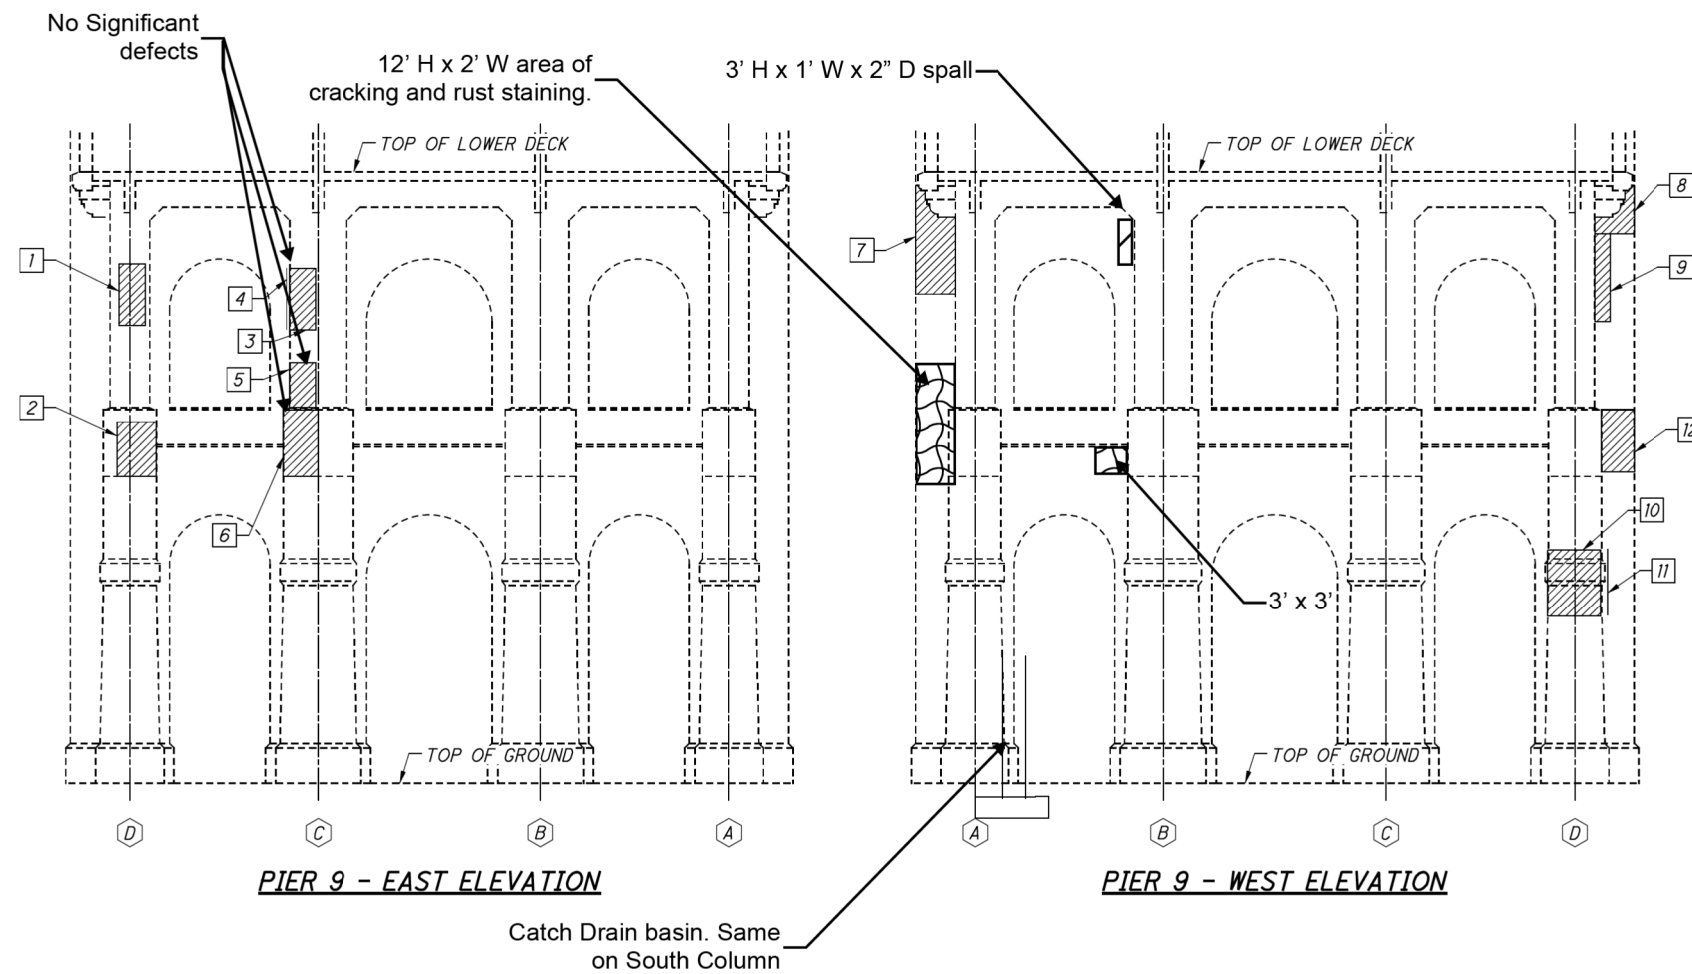

| ESTIMATED PATCHING QUANTITIES | | | |
|-------------------------------|-------------|-----------|------------------|
| REPAIR NO. | REPAIR TYPE | AREA (SF) | ANODE QUANTITY** |
| 1 | TYPE 1 | 21 | 8 |
| 2 | TYPE 1 | 11 | 5 |
| 3 | TYPE 1 | 16 | 4 |
| 4 | TYPE 1 | 4 | 4 |
| 5 | TYPE 1 | 27 | 10 |
| 6 | TYPE 1 | 4 | 4 |
| 7 | TYPE 1 | 34 | 12 |
| 8 | TYPE 1 | 20 | 6 |
| 9 | TYPE 1 | 18 | 6 |
| 10 | TYPE 1 | 9 | 4 |
| 11 | TYPE 1 | 6 | 2 |
| 12 | TYPE 1 | 25 | 8 |
| MEASURED QUANTITY* | | 195 | - |
| PLAN QUANTITY* | | 293 | 75 |

* SEE NOTES 1 & 2
 ** SEE NOTE 3

| SHEET QUANTITY SUMMARY | | |
|------------------------|------|----------|
| ITEM | UNIT | QUANTITY |
| TYPE 1 REPAIR | SF | 293 |
| TYPE 2 REPAIR | SF | - |



NOTES:

1. MEASURED QUANTITIES ARE BASED ON THE INSPECTION PERFORMED IN SEPTEMBER 2016. THE EXACT DIMENSIONS AND LOCATIONS OF PATCHES SHALL BE DETERMINED BY THE ENGINEER IN THE FIELD FOR FINAL PAY QUANTITY.
2. PLAN QUANTITIES INCLUDE 50% CONTINGENCY ADDED TO MEASURED QUANTITIES.
3. ANODES ARE INCLUDED FOR PAYMENT WITH ITEM SPECIAL - PATCHING CONCRETE STRUCTURE, TYPE 1 OR 2 REPAIR.
4. FOR DETAILS AND MAXIMUM GRID SPACING FOR THE EMBEDDED GALVANIC ANODES, SEE SHEET 84/89.

LEGEND:

- (X) ARCH RIB LINE
- # REPAIR NUMBER
- ▨ LOCATION OF DEFICIENT CONCRETE TO BE REPAIRED IN ACCORDANCE WITH ITEM SPECIAL - PATCHING CONCRETE STRUCTURE, TYPE 1 REPAIR
- ||| LOCATION OF DEFICIENT CONCRETE ON PERPENDICULAR FACE (NOT VISIBLE IN ELEVATION VIEW) TO BE REPAIRED IN ACCORDANCE WITH ITEM SPECIAL - PATCHING CONCRETE STRUCTURE, TYPE 1 OR TYPE 2 REPAIR

| | | | |
|--------------------------------|-----------|---|--|
| GRAPHIC SCALE MEASURED IN FEET | DATE | 
9902 Carver Road
Suite 201
Cincinnati, OH 45242
PH.: 614.699.5000 | DETROIT-SUPERIOR BRIDGE OVER CUYAHOGA RIVER
BRIDGE NO. CUY-6-1465 |
| NOT TO SCALE | NOV, 2018 | INFRASTRUCTURE ENGINEERS, INC. | PIER CONCRETE REPIAR DETAILS |
| | | | PAGE A-28 |

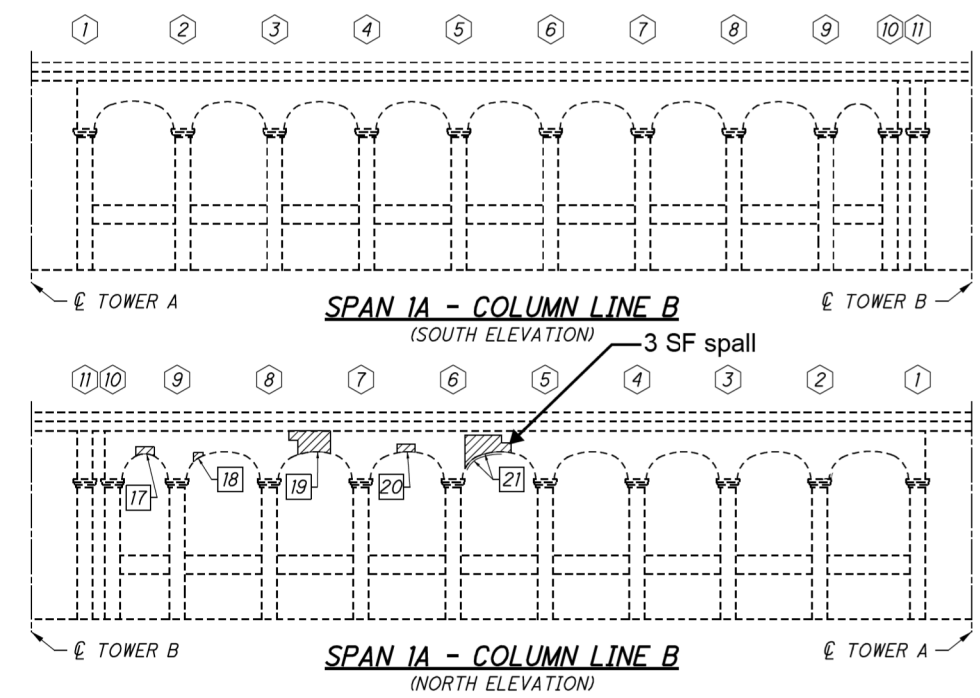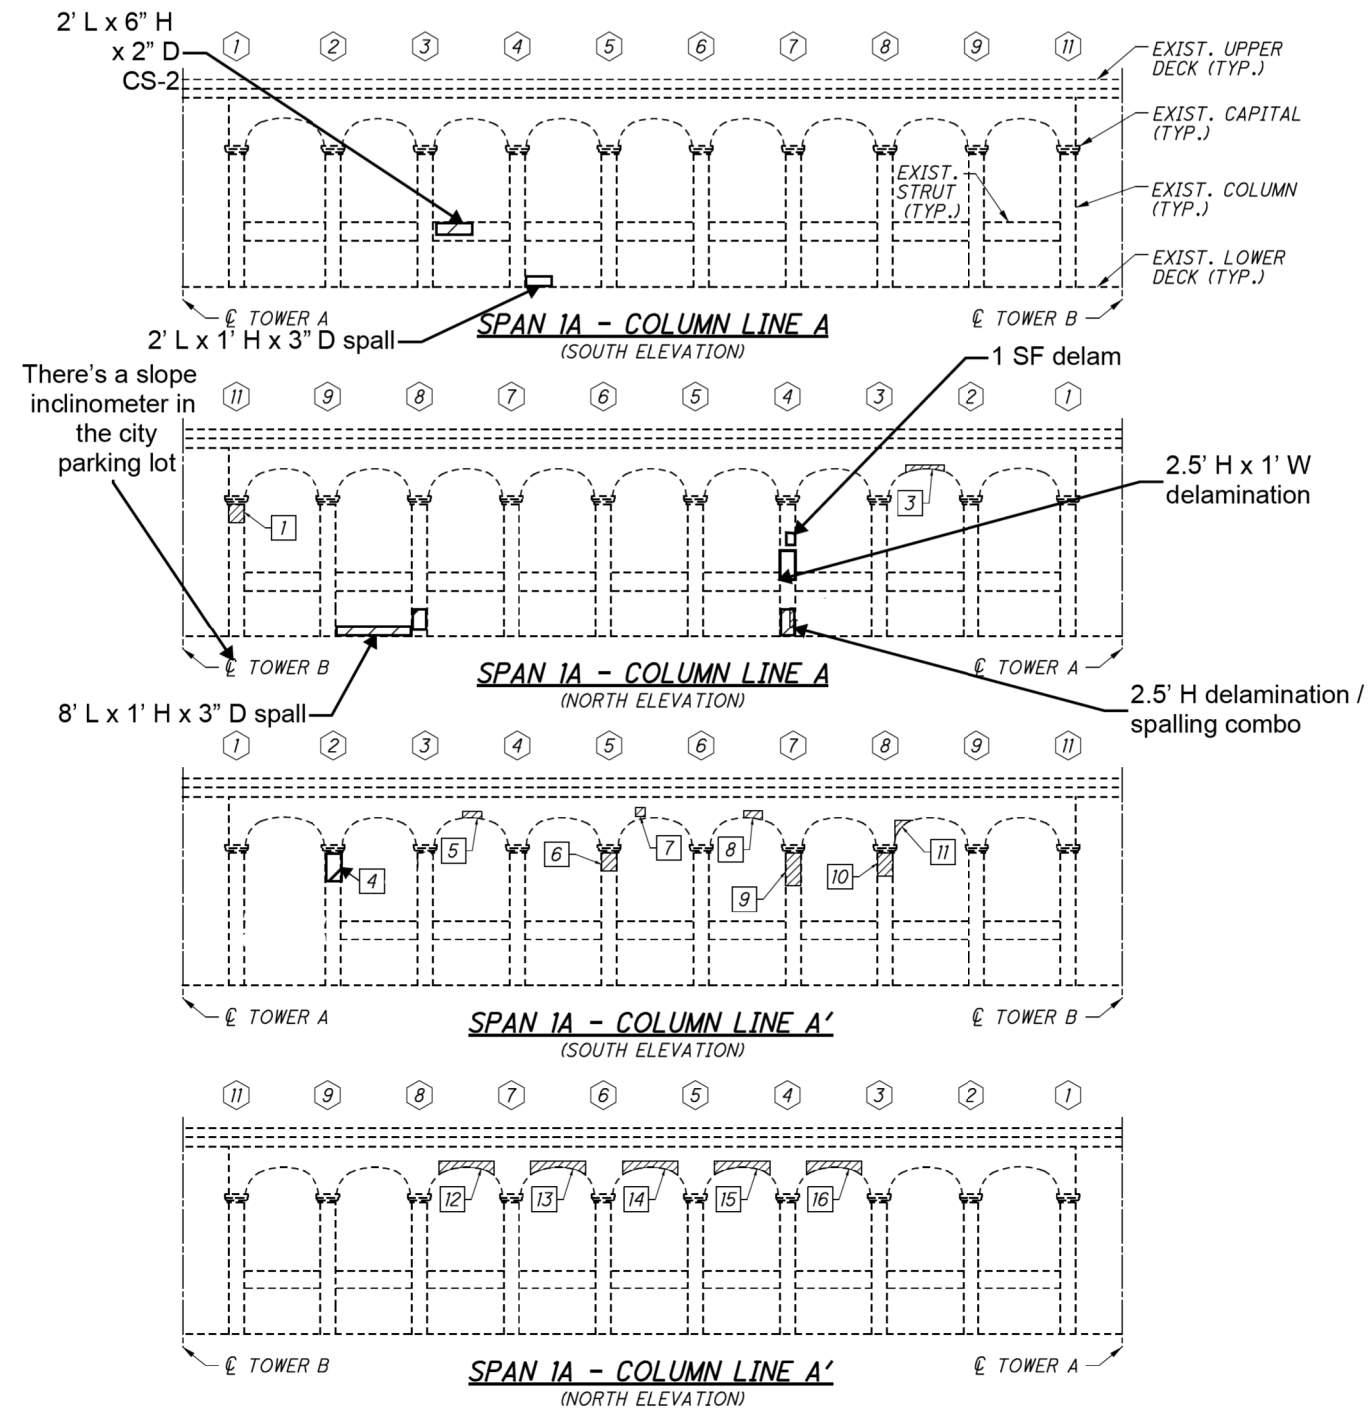

| ESTIMATED PATCHING QUANTITIES | | | |
|-------------------------------|-------------|-----------|------------------|
| REPAIR NO. | REPAIR TYPE | AREA (SF) | ANODE QUANTITY** |
| 1 | TYPE 1 | 2 | - |
| 2 | TYPE 1 | 1 | - |
| 3 | TYPE 1 | 1 | - |
| 4 | TYPE 1 | 3 | - |
| 5 | TYPE 1 | 2 | - |
| 6 | TYPE 1 | 3 | - |
| 7 | TYPE 1 | 1 | - |
| 8 | TYPE 1 | 4 | - |
| 9 | TYPE 1 | 6 | 3 |
| 10 | TYPE 1 | 5 | 2 |
| 11 | TYPE 1 | 4 | - |
| 12 | TYPE 1 | 6 | 5 |
| 13 | TYPE 1 | 6 | 5 |
| 14 | TYPE 1 | 6 | 5 |
| 15 | TYPE 1 | 6 | 5 |
| 16 | TYPE 1 | 6 | 5 |
| 17 | TYPE 1 | 2 | - |
| 18 | TYPE 1 | 1 | - |
| 19 | TYPE 1 | 8 | 6 |
| 20 | TYPE 1 | 1 | - |

| ESTIMATED PATCHING QUANTITIES | | | |
|-------------------------------|-------------|-----------|------------------|
| REPAIR NO. | REPAIR TYPE | AREA (SF) | ANODE QUANTITY** |
| 21 | TYPE 2 | 21 | 12 |
| 22 | TYPE 1 | 2 | - |
| MEASURED QUANTITY* | | 97 | - |
| PLAN QUANTITY* | | 146 | 48 |

* SEE NOTES 1 & 2
 ** SEE NOTE 3


| SHEET QUANTITY SUMMARY | | |
|------------------------|------|----------|
| ITEM | UNIT | QUANTITY |
| TYPE 1 REPAIR | SF | 114 |
| TYPE 2 REPAIR | SF | 32 |





NOTES:

- MEASURED QUANTITIES ARE BASED ON THE INSPECTION PERFORMED IN DECEMBER 2016. THE EXACT DIMENSIONS AND LOCATIONS OF PATCHES SHALL BE DETERMINED BY THE ENGINEER IN THE FIELD FOR FINAL PAY QUANTITY.
- PLAN QUANTITIES INCLUDE 50% CONTINGENCY ADDED TO MEASURED QUANTITIES.
- ANODES ARE INCLUDED FOR PAYMENT WITH ITEM SPECIAL - PATCHING CONCRETE STRUCTURE, TYPE 1 OR TYPE 2 REPAIR.
- FOR DETAILS AND MAXIMUM GRID SPACING FOR THE EMBEDDED GALVANIC ANODES, SEE SHEET 84/89.
- EPOXY-URETHANE SEALER SHALL NOT BE APPLIED TO PATCHED OR REPLACED CONCRETE SURFACES.



LEGEND:

- # SPANDREL COLUMN NUMBER
- # REPAIR NUMBER
- ▨ LOCATION OF DEFICIENT CONCRETE TO BE REPAIRED IN ACCORDANCE WITH ITEM SPECIAL - PATCHING CONCRETE STRUCTURE, TYPE 1 REPAIR
- || LOCATION OF DEFICIENT CONCRETE ON PERPENDICULAR FACE (NOT VISIBLE IN ELEVATION VIEW) TO BE REPAIRED IN ACCORDANCE WITH ITEM SPECIAL - PATCHING CONCRETE STRUCTURE, TYPE 1 OR TYPE 2 REPAIR

| | | | |
|--------------------------------|-----------|---|--|
| GRAPHIC SCALE MEASURED IN FEET | DATE | 
9902 Carver Road
Suite 201
Cincinnati, OH 45242
PH.: 614.699.5000 | DETROIT-SUPERIOR BRIDGE OVER CUYAHOGA RIVER
BRIDGE NO. CUY-6-1465 |
| NOT TO SCALE | NOV, 2018 | INFRASTRUCTURE
ENGINEERS, INC. | SPAN 1A CONCRETE REPAIR DETAILS |
| | | | PAGE
A-29 |

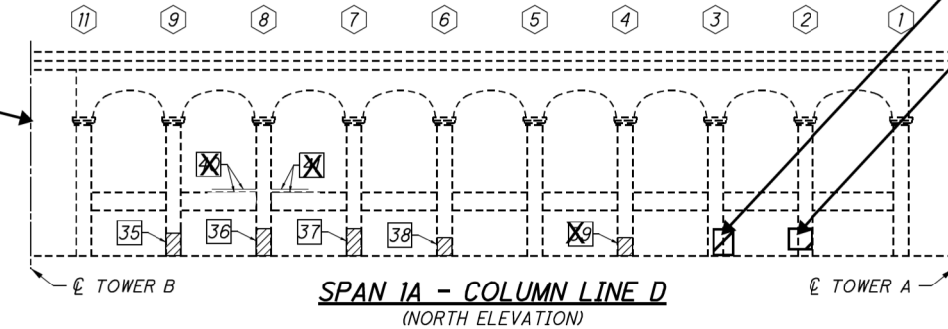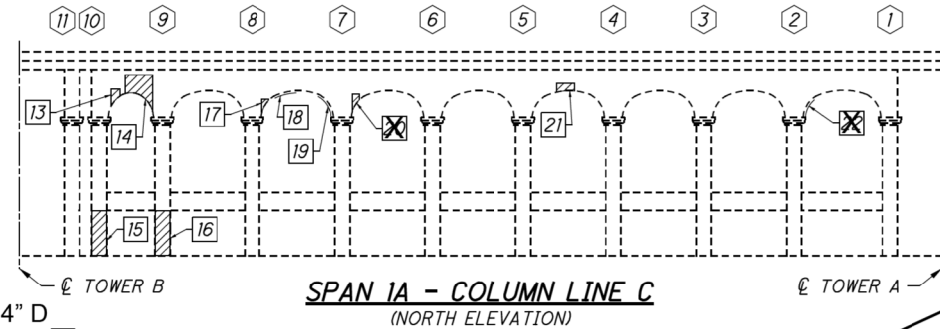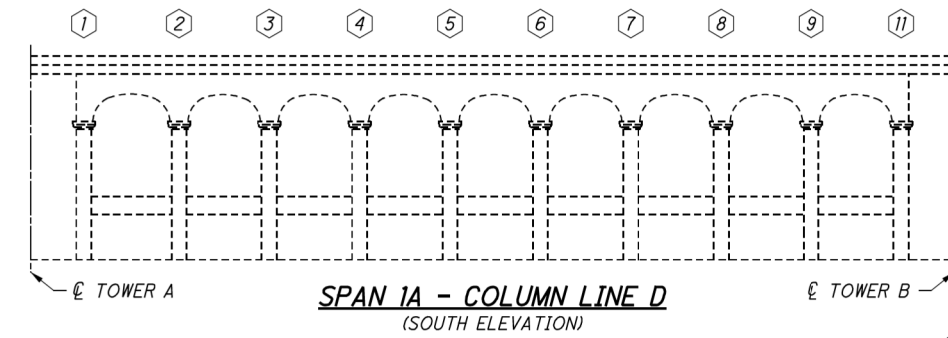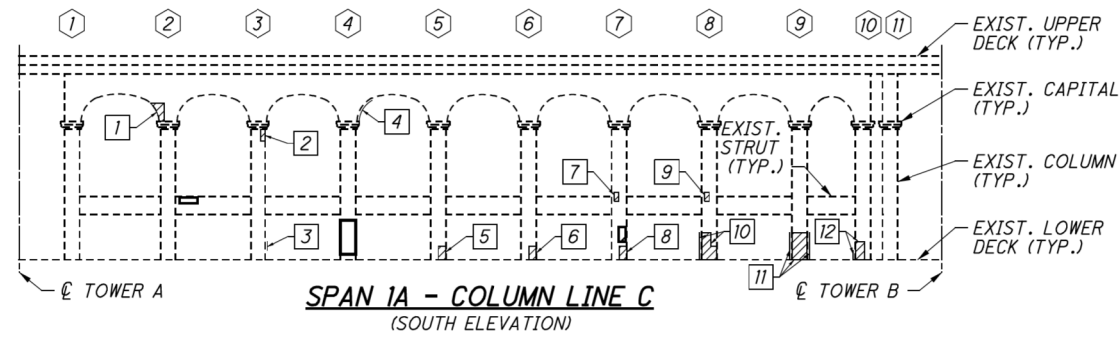

Tower B is rotating to the south West side measures 5-1/8" East side 6"

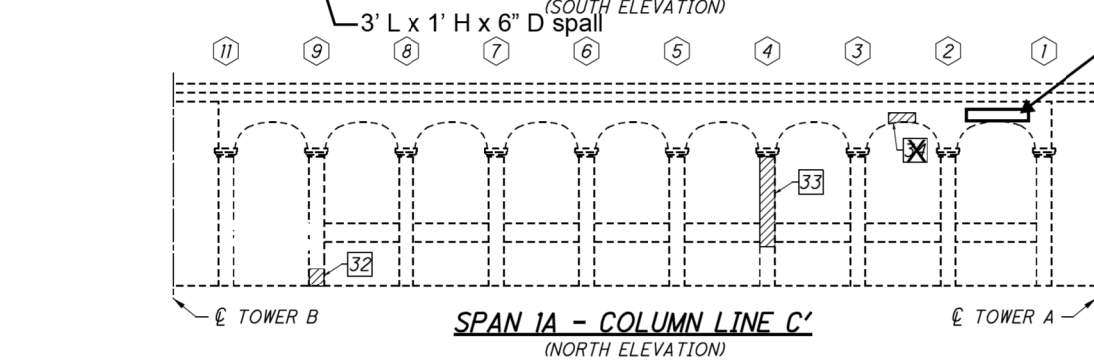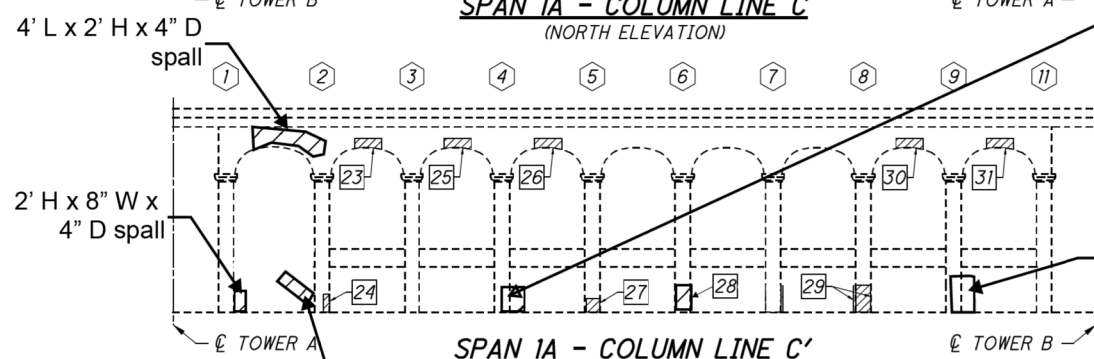

| ESTIMATED PATCHING QUANTITIES | | | |
|-------------------------------|-------------|-----------|------------------|
| REPAIR NO. | REPAIR TYPE | AREA (SF) | ANODE QUANTITY** |
| 1 | TYPE 1 | 2 | - |
| 2 | TYPE 1 | 1 | - |
| 3 | TYPE 1 | 1 | - |
| 4 | TYPE 2 | 3 | - |
| 5 | TYPE 1 | 2 | - |
| 6 | TYPE 1 | 2 | - |
| 7 | TYPE 1 | 1 | - |
| 8 | TYPE 1 | 2 | - |
| 9 | TYPE 1 | 1 | - |
| 10 | TYPE 1 | 8 | 4 |
| 11 | TYPE 1 | 15 | 8 |
| 12 | TYPE 1 | 4 | - |
| 13 | TYPE 1 | 2 | 2 |
| 14 | TYPE 1 | 12 | 8 |
| 15 | TYPE 1 | 5 | 2 |
| 16 | TYPE 1 | 5 | 2 |
| 17 | TYPE 1 | 2 | - |
| 18 | TYPE 2 | 3 | - |
| 19 | TYPE 2 | 4 | - |
| 20 | TYPE 1 | 2 | - |
| 21 | TYPE 1 | 3 | - |
| 22 | TYPE 2 | 5 | 4 |

| ESTIMATED PATCHING QUANTITIES | | | |
|-------------------------------|-------------|-----------|------------------|
| REPAIR NO. | REPAIR TYPE | AREA (SF) | ANODE QUANTITY** |
| 23 | TYPE 1 | 3 | - |
| 24 | TYPE 1 | 2 | - |
| 25 | TYPE 1 | 3 | - |
| 26 | TYPE 1 | 3 | - |
| 27 | TYPE 1 | 3 | - |
| 28 | TYPE 1 | 9 | 4 |
| 29 | TYPE 1 | 8 | 6 |
| 30 | TYPE 1 | 3 | - |
| 31 | TYPE 1 | 3 | - |
| 32 | TYPE 1 | 4 | - |
| 33 | TYPE 1 | 17 | 7 |
| 34 | TYPE 1 | 3 | - |
| 35 | TYPE 1 | 7 | 3 |
| 36 | TYPE 1 | 6 | 2 |
| 37 | TYPE 1 | 6 | 2 |
| 38 | TYPE 1 | 4 | - |
| 39 | TYPE 1 | 4 | - |
| 40 | TYPE 1 | 6 | 1 |
| 41 | TYPE 1 | 2 | - |
| MEASURED QUANTITY* | | 181 | - |
| PLAN QUANTITY* | | 272 | 55 |

* SEE NOTES 1 & 2
** SEE NOTE 3

Notes:
Floorbeams between C' and D exhibit shallow rebar and popouts throughout. 50 SF of patch work to be done.

| SHEET QUANTITY SUMMARY | | |
|------------------------|------|----------|
| ITEM | UNIT | QUANTITY |
| TYPE 1 REPAIR | SF | 249 |
| TYPE 2 REPAIR | SF | 23 |


NOTES:

- MEASURED QUANTITIES ARE BASED ON THE INSPECTION PERFORMED IN DECEMBER 2016. THE EXACT DIMENSIONS AND LOCATIONS OF PATCHES SHALL BE DETERMINED BY THE ENGINEER IN THE FIELD FOR FINAL PAY QUANTITY.
- PLAN QUANTITIES INCLUDE 50% CONTINGENCY ADDED TO MEASURED QUANTITIES.
- ANODES ARE INCLUDED FOR PAYMENT WITH ITEM SPECIAL - PATCHING CONCRETE STRUCTURE, TYPE 1 OR TYPE 2 REPAIR.
- FOR DETAILS AND MAXIMUM GRID SPACING FOR THE EMBEDDED GALVANIC ANODES, SEE SHEET 84/89.
- EPOXY-URETHANE SEALER SHALL NOT BE APPLIED TO PATCHED OR REPLACED CONCRETE SURFACES.

LEGEND:

- SPANDREL COLUMN NUMBER
- REPAIR NUMBER
- LOCATION OF DEFICIENT CONCRETE TO BE REPAIRED IN ACCORDANCE WITH ITEM SPECIAL - PATCHING CONCRETE STRUCTURE, TYPE 1 REPAIR
- LOCATION OF DEFICIENT CONCRETE ON PERPENDICULAR FACE (NOT VISIBLE IN ELEVATION VIEW) TO BE REPAIRED IN ACCORDANCE WITH ITEM SPECIAL - PATCHING CONCRETE STRUCTURE, TYPE 1 OR TYPE 2 REPAIR

| | | | |
|--------------------------------|-----------|--------------------------------|--|
| GRAPHIC SCALE MEASURED IN FEET | DATE | | 9902 Carver Road
Suite 201
Cincinnati, OH 45242
PH.: 614.699.5000 |
| NOT TO SCALE | NOV, 2018 | INFRASTRUCTURE ENGINEERS, INC. | DETROIT-SUPERIOR BRIDGE OVER CUYAHOGA RIVER
BRIDGE NO. CUY-6-1465 |
| | | | SPAN 1A CONCRETE REPAIR DETAILS |
| | | | PAGE A-30 |

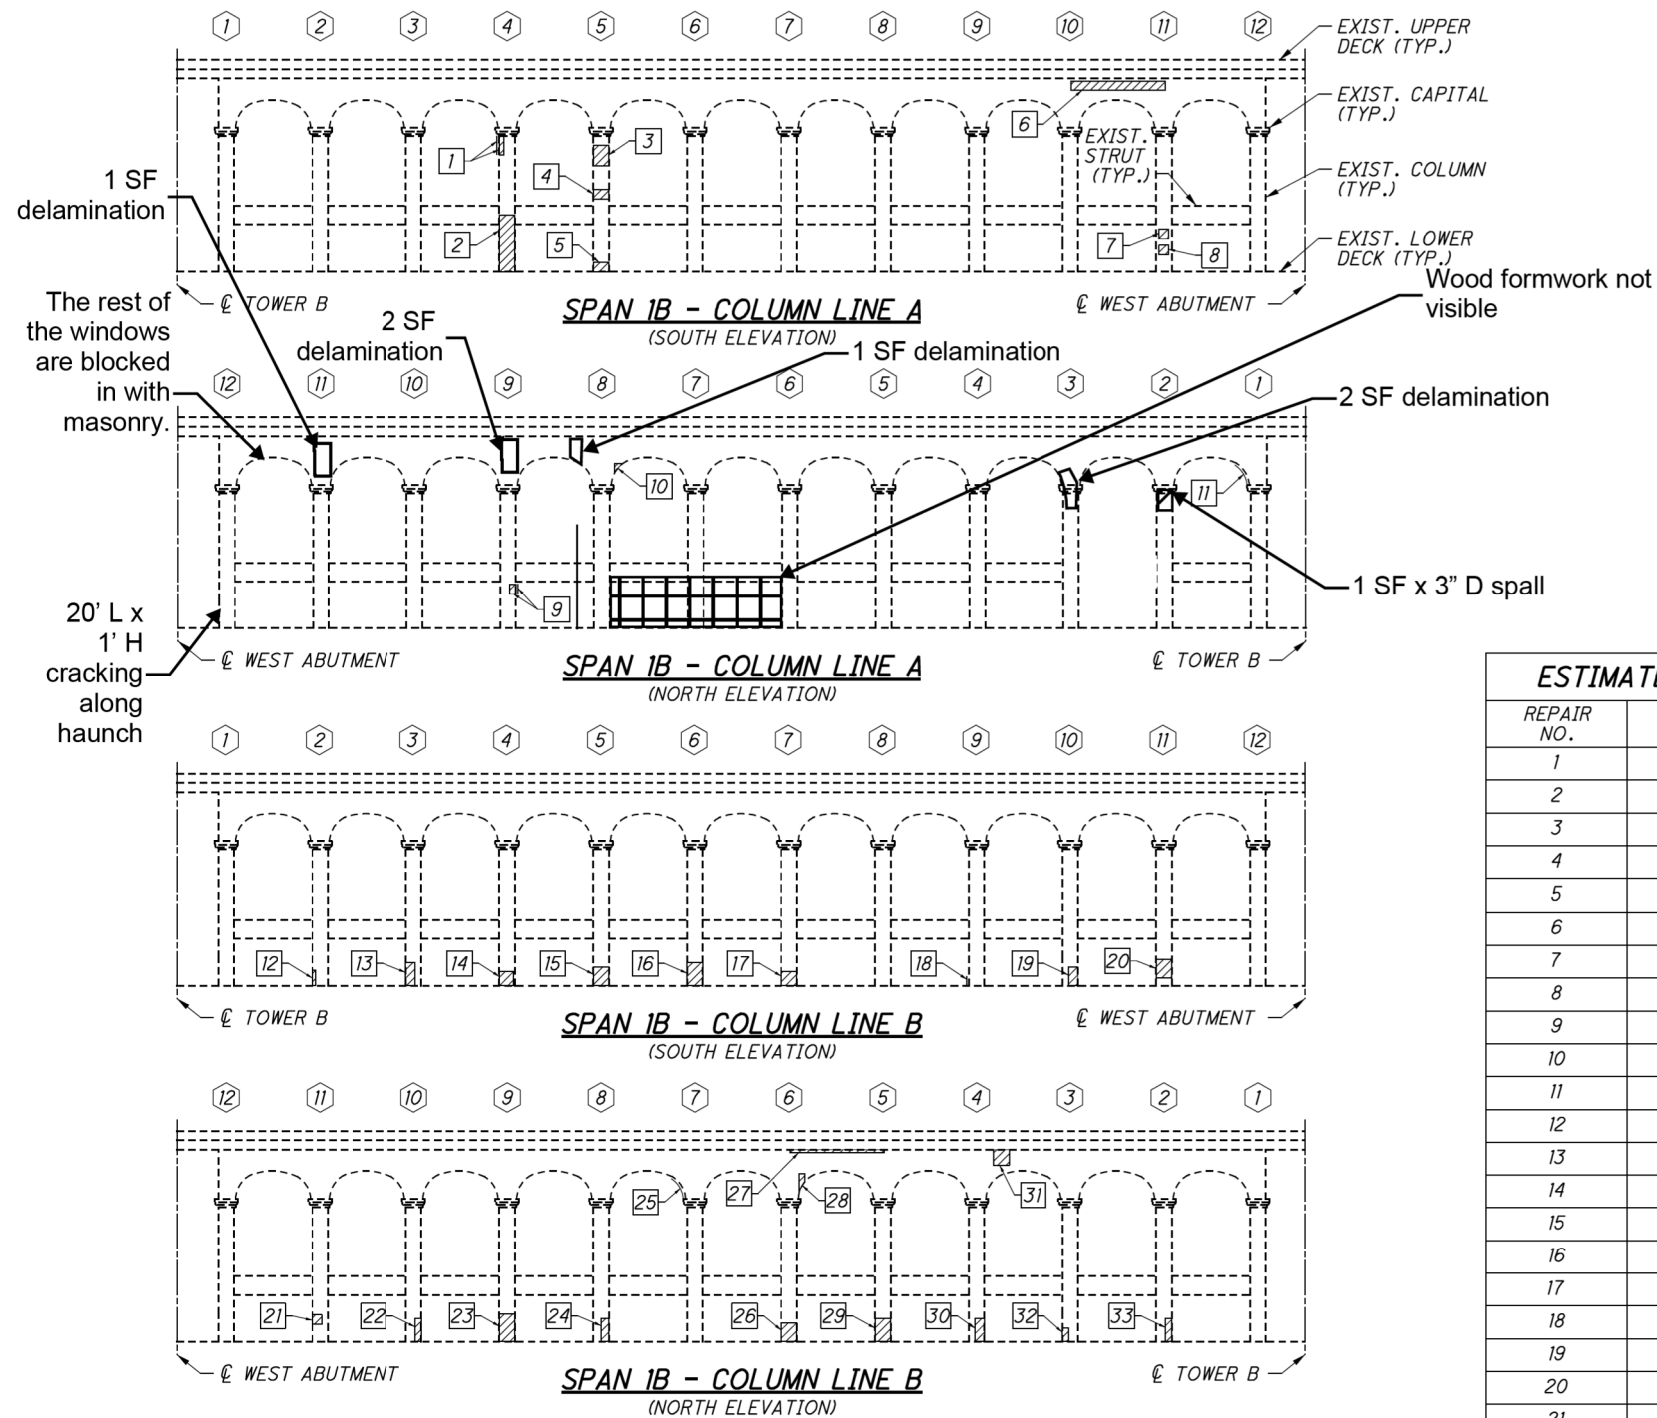

| ESTIMATED PATCHING QUANTITIES | | | |
|-------------------------------|-------------|-----------|------------------|
| REPAIR NO. | REPAIR TYPE | AREA (SF) | ANODE QUANTITY** |
| 1 | TYPE 1 | 2 | - |
| 2 | TYPE 1 | 7 | 3 |
| 3 | TYPE 1 | 4 | - |
| 4 | TYPE 1 | 2 | - |
| 5 | TYPE 1 | 2 | - |
| 6 | TYPE 1 | 10 | 9 |
| 7 | TYPE 1 | 1 | - |
| 8 | TYPE 1 | 1 | - |
| 9 | TYPE 1 | 2 | - |
| 10 | TYPE 1 | 1 | - |
| 11 | TYPE 2 | 6 | 6 |
| 12 | TYPE 1 | 1 | - |
| 13 | TYPE 1 | 3 | - |
| 14 | TYPE 1 | 3 | - |
| 15 | TYPE 1 | 4 | - |
| 16 | TYPE 1 | 5 | 2 |
| 17 | TYPE 1 | 3 | - |
| 18 | TYPE 1 | 1 | - |
| 19 | TYPE 1 | 2 | - |
| 20 | TYPE 1 | 4 | - |
| 21 | TYPE 1 | 1 | - |
| 22 | TYPE 1 | 2 | - |

| ESTIMATED PATCHING QUANTITIES | | | |
|-------------------------------|-------------|-----------|------------------|
| REPAIR NO. | REPAIR TYPE | AREA (SF) | ANODE QUANTITY** |
| 23 | TYPE 1 | 5 | 1 |
| 24 | TYPE 1 | 3 | - |
| 25 | TYPE 2 | 3 | - |
| 26 | TYPE 1 | 4 | - |
| 27 | TYPE 1 | 4 | - |
| 28 | TYPE 1 | 2 | - |
| 29 | TYPE 1 | 5 | 7 |
| 30 | TYPE 1 | 3 | - |
| 31 | TYPE 1 | 3 | - |
| 32 | TYPE 1 | 1 | - |
| 33 | TYPE 1 | 2 | - |
| MEASURED QUANTITY* | | 102 | - |
| PLAN QUANTITY* | | 153 | 28 |

* SEE NOTES 1 & 2

** SEE NOTE 3

| SHEET QUANTITY SUMMARY | | |
|------------------------|------|----------|
| ITEM | UNIT | QUANTITY |
| TYPE 1 REPAIR | SF | 139 |
| TYPE 2 REPAIR | SF | 14 |





NOTES:

- MEASURED QUANTITIES ARE BASED ON THE INSPECTION PERFORMED IN DECEMBER 2016. THE EXACT DIMENSIONS AND LOCATIONS OF PATCHES SHALL BE DETERMINED BY THE ENGINEER IN THE FIELD FOR FINAL PAY QUANTITY.
- PLAN QUANTITIES INCLUDE 50% CONTINGENCY ADDED TO MEASURED QUANTITIES.
- ANODES ARE INCLUDED FOR PAYMENT WITH ITEM SPECIAL - PATCHING CONCRETE STRUCTURE, TYPE 1 OR TYPE 2 REPAIR.
- FOR DETAILS AND MAXIMUM GRID SPACING FOR THE EMBEDDED GALVANIC ANODES, SEE SHEET 84/89.
- EPOXY-URETHANE SEALER SHALL NOT BE APPLIED TO PATCHED OR REPLACED CONCRETE SURFACES.

LEGEND:

- SPANDREL COLUMN NUMBER
- REPAIR NUMBER
- LOCATION OF DEFICIENT CONCRETE TO BE REPAIRED IN ACCORDANCE WITH ITEM SPECIAL - PATCHING CONCRETE STRUCTURE, TYPE 1 REPAIR
- LOCATION OF DEFICIENT CONCRETE ON PERPENDICULAR FACE (NOT VISIBLE IN ELEVATION VIEW) TO BE REPAIRED IN ACCORDANCE WITH ITEM SPECIAL - PATCHING CONCRETE STRUCTURE, TYPE 1 OR TYPE 2 REPAIR

| | | | | |
|--------------------------------|-----------|--|--|---------------------------------|
| GRAPHIC SCALE MEASURED IN FEET | DATE | 9902 Carver Road
Suite 201
Cincinnati, OH 45242
PH.: 614.699.5000 | DETROIT-SUPERIOR BRIDGE OVER CUYAHOGA RIVER
BRIDGE NO. CUY-6-1465 | |
| NOT TO SCALE | NOV, 2018 | | INFRASTRUCTURE ENGINEERS, INC. | SPAN 1B CONCRETE REPAIR DETAILS |

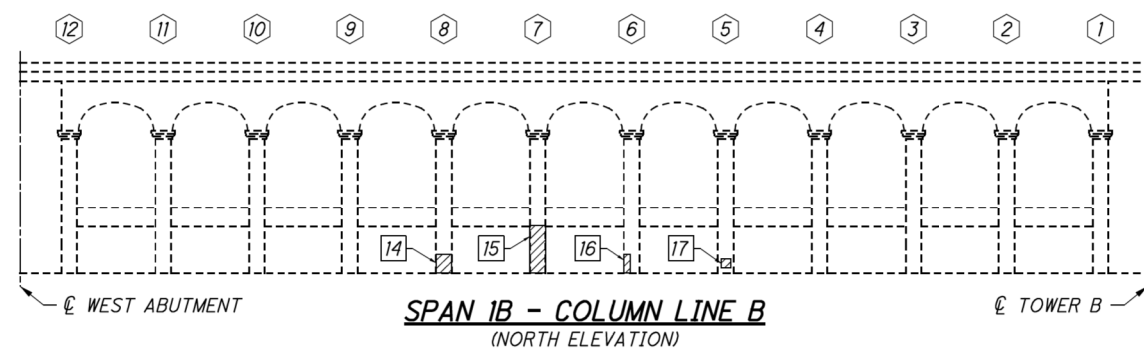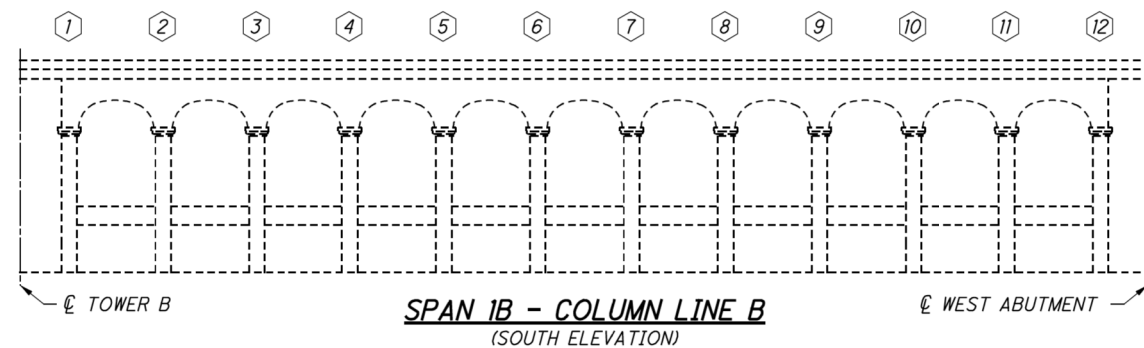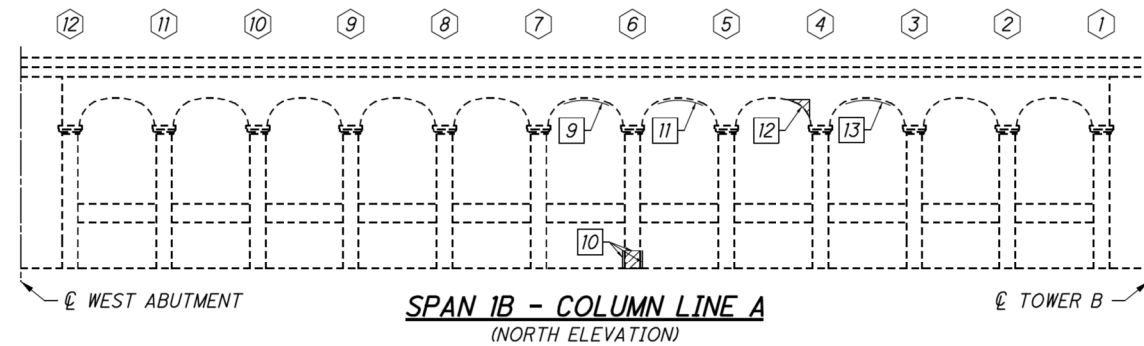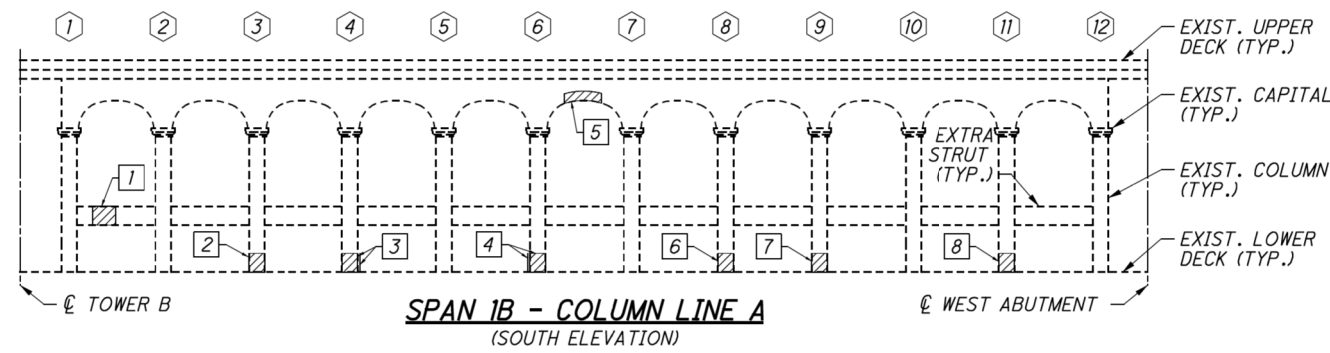

| ESTIMATED PATCHING QUANTITIES | | | |
|-------------------------------|-------------|-----------|------------------|
| REPAIR NO. | REPAIR TYPE | AREA (SF) | ANODE QUANTITY** |
| 1 | TYPE 1 | 5 | 4 |
| 2 | TYPE 1 | 4 | - |
| 3 | TYPE 1 | 8 | 4 |
| 4 | TYPE 1 | 8 | 4 |
| 5 | TYPE 1 | 4 | - |
| 6 | TYPE 1 | 4 | - |
| 7 | TYPE 1 | 4 | - |
| 8 | TYPE 1 | 4 | - |
| 9 | TYPE 2 | 6 | 4 |
| 10 | TYPE 1 | 12 | 8 |
| 11 | TYPE 2 | 5 | 4 |
| 12 | TYPE 1 | 2 | - |
| 13 | TYPE 2 | 4 | - |
| 14 | TYPE 1 | 4 | - |
| 15 | TYPE 1 | 10 | 4 |
| 16 | TYPE 1 | 2 | - |
| 17 | TYPE 1 | 1 | - |
| MEASURED QUANTITY* | | 87 | - |
| PLAN QUANTITY* | | 131 | 32 |

| SHEET QUANTITY SUMMARY | | |
|------------------------|------|----------|
| ITEM | UNIT | QUANTITY |
| TYPE 1 REPAIR | SF | 108 |
| TYPE 2 REPAIR | SF | 23 |

* SEE NOTES 1 & 2
 ** SEE NOTE 3


NOTES:

- MEASURED QUANTITIES ARE BASED ON THE INSPECTION PERFORMED IN DECEMBER 2016. THE EXACT DIMENSIONS AND LOCATIONS OF PATCHES SHALL BE DETERMINED BY THE ENGINEER IN THE FIELD FOR FINAL PAY QUANTITY.
- PLAN QUANTITIES INCLUDE 50% CONTINGENCY ADDED TO MEASURED QUANTITIES.
- ANODES ARE INCLUDED FOR PAYMENT WITH ITEM SPECIAL - PATCHING CONCRETE STRUCTURE, TYPE 1 OR TYPE 2 REPAIR.
- FOR DETAILS AND MAXIMUM GRID SPACING FOR THE EMBEDDED GALVANIC ANODES, SEE SHEET 84/89.
- EPOXY-URETHANE SEALER SHALL NOT BE APPLIED TO PATCHED OR REPLACED CONCRETE SURFACES.

LEGEND:

- SPANDREL COLUMN NUMBER
- REPAIR NUMBER
- LOCATION OF DEFICIENT CONCRETE TO BE REPAIRED IN ACCORDANCE WITH ITEM SPECIAL - PATCHING CONCRETE STRUCTURE, TYPE 1 REPAIR
- LOCATION OF DEFICIENT CONCRETE ON PERPENDICULAR FACE (NOT VISIBLE IN ELEVATION VIEW) TO BE REPAIRED IN ACCORDANCE WITH ITEM SPECIAL - PATCHING CONCRETE STRUCTURE, TYPE 1 OR TYPE 2 REPAIR


| | | | | |
|--------------------------------|--------------|--|--|--------------------------------|
| GRAPHIC SCALE MEASURED IN FEET | DATE | 9902 Carver Road
Suite 201
Cincinnati, OH 45242
PH.: 614.699.5000 | DETROIT-SUPERIOR BRIDGE OVER CUYAHOGA RIVER
BRIDGE NO. CUY-6-1465 | |
| | NOT TO SCALE | | NOV, 2018 | INFRASTRUCTURE ENGINEERS, INC. |
| | | | | PAGE A-32 |

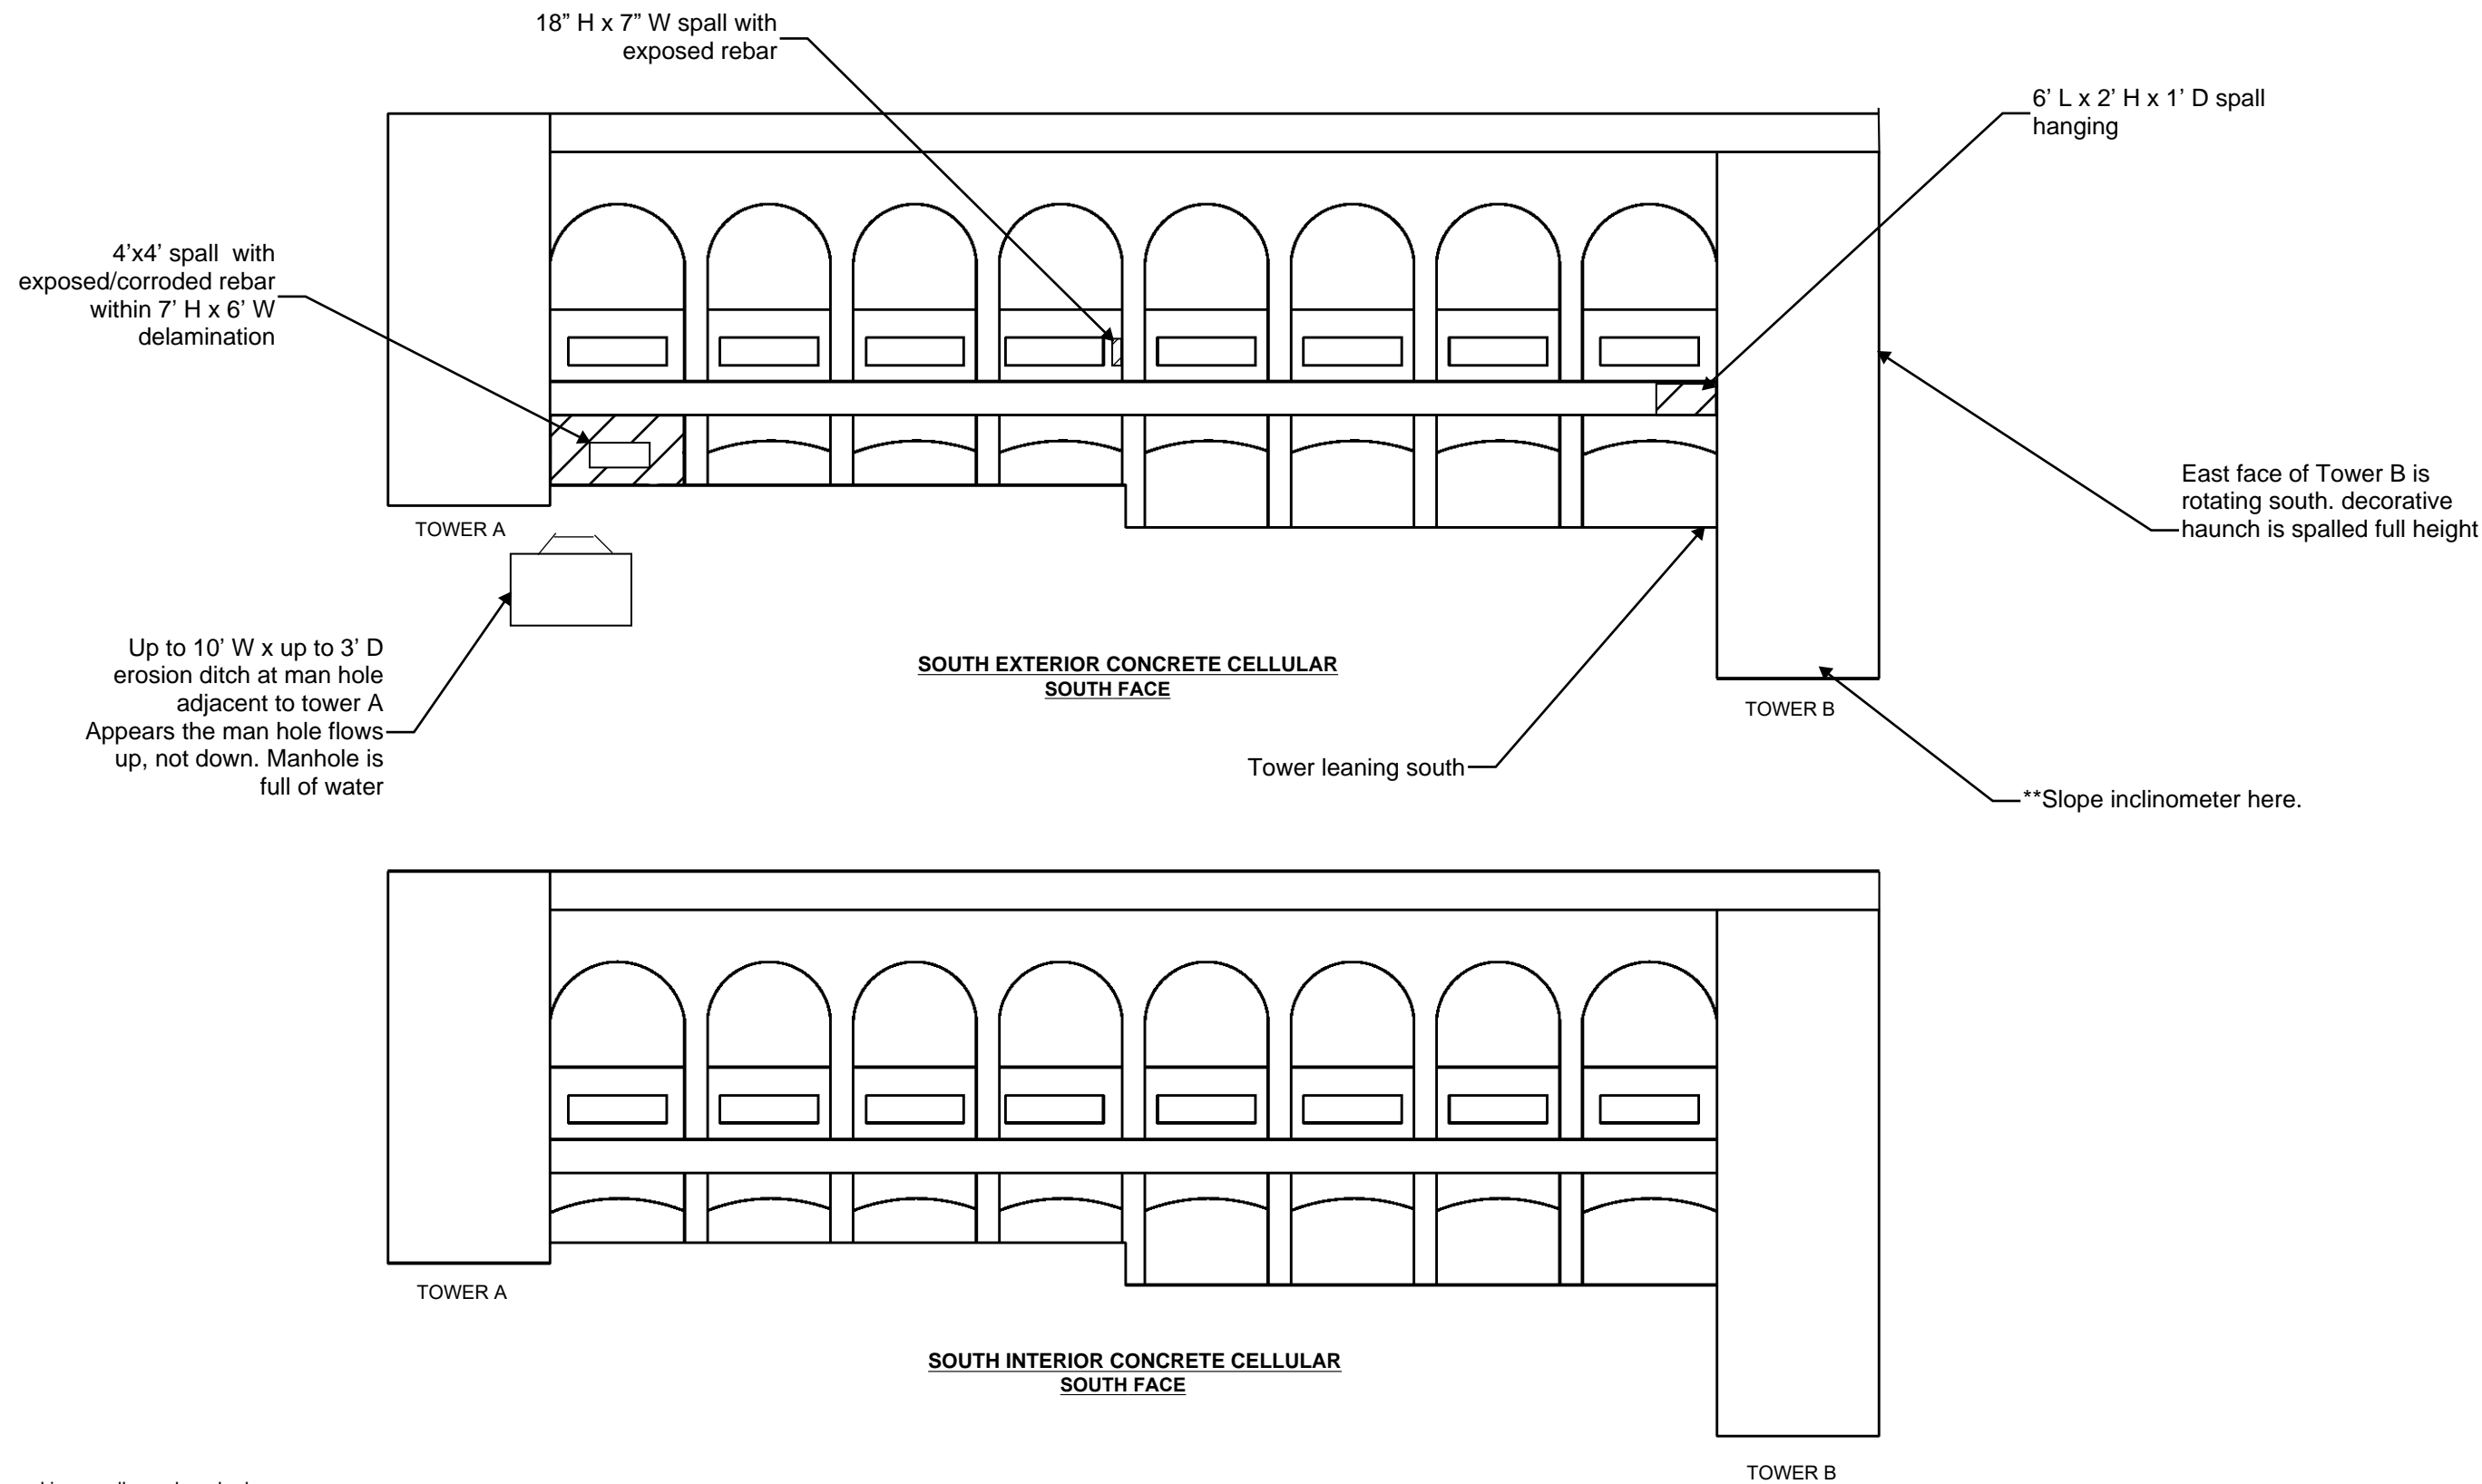


General Notes:

- Arches typically exhibit cracking, spalls, and marked up delaminations throughout.


| | | | |
|---------------------------------------|------------------|--|--|
| <p>GRAPHIC SCALE MEASURED IN FEET</p> | <p>DATE</p> |  <p>9902 Carver Road
Suite 201
Cincinnati, OH 45242
PH.: 614.699.5000</p> | <p>DETROIT-SUPERIOR BRIDGE OVER CUYAHOGA RIVER
BRIDGE NO. CUY-6-1465</p> |
| <p>NOT TO SCALE</p> | <p>NOV, 2018</p> | <p>INFRASTRUCTURE
ENGINEERS, INC.</p> | <p>STRUCTURE ELEVATION - SPAN 1A</p> |

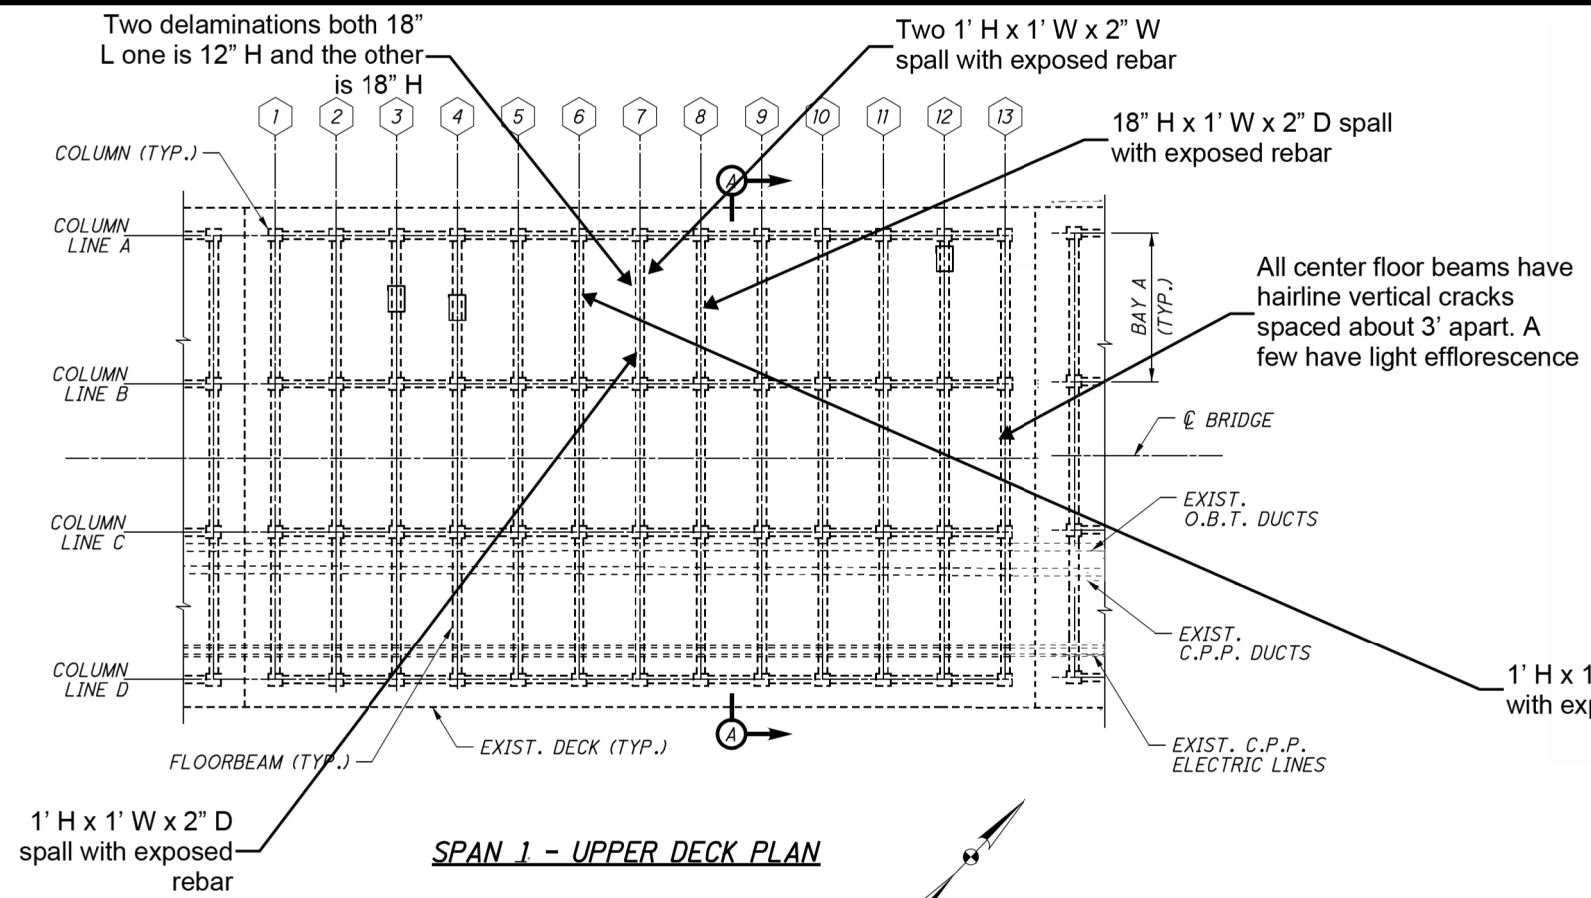

SPAN 1 - UPPER DECK PLAN

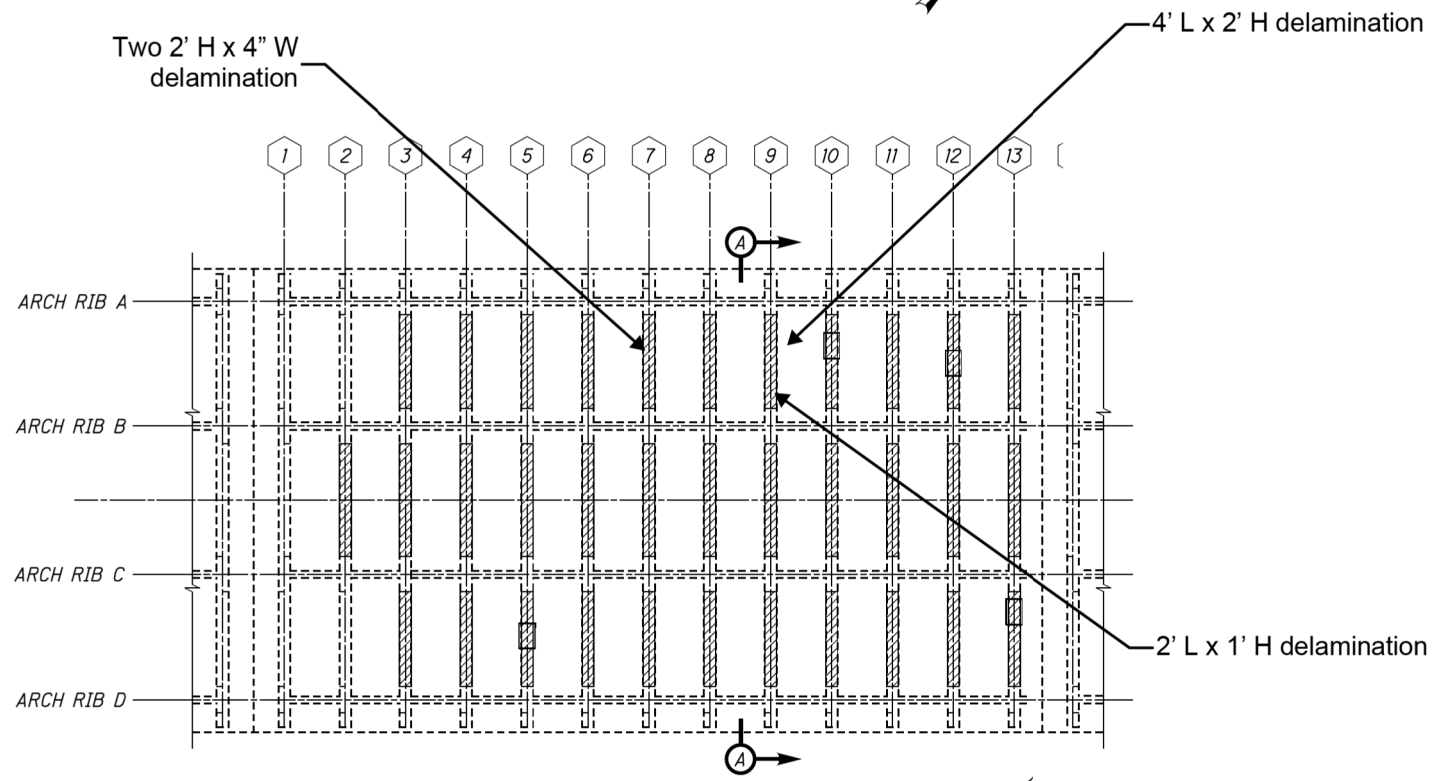

SPAN 1 - LOWER DECK PLAN

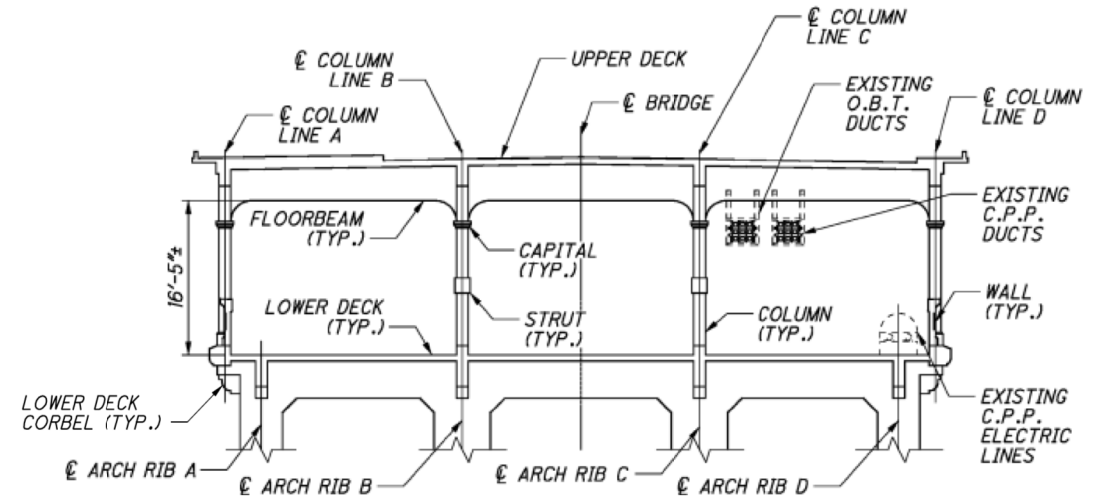

SECTION A-A



NOTES:

1. MEASURED QUANTITIES ARE BASED ON THE INSPECTION PERFORMED IN OCTOBER 2017. THE EXACT DIMENSIONS AND LOCATIONS OF PATCHES SHALL BE DETERMINED BY THE ENGINEER IN THE FIELD FOR FINAL PAY QUANTITY.
2. PLAN QUANTITIES INCLUDE 50% CONTINGENCY ADDED TO MEASURED QUANTITIES.
3. ANODES ARE INCLUDED FOR PAYMENT WITH ITEM SPECIAL - PATCHING CONCRETE STRUCTURE, TYPE 1 OR TYPE 2 REPAIR.
4. FOR DETAILS AND MAXIMUM GRID SPACING FOR EMBEDDED GALVANIC ANODES, SEE SHEET [84/89].
5. FOR FRP WRAP DETAILS, SEE SHEET [85/89].

LEGEND:

- # FLOORBEAM LINE NUMBER
- # REPAIR NO. OF DEFICIENT CONCRETE TO BE REPAIRED IN ACCORDANCE WITH ITEM SPECIAL - PATCHING CONCRETE STRUCTURE, TYPE 1 OR TYPE 2 REPAIR.
- ▨ AREA TO BE TREATED WITH FRP WRAP PER ITEM SPECIAL - COMPOSITE FIBER WRAP SYSTEM


| | | | | |
|--------------------------------|-----------|--|--|--------------------------------|
| GRAPHIC SCALE MEASURED IN FEET | DATE | 9902 Carver Road
Suite 201
Cincinnati, OH 45242
PH.: 614.699.5000 | DETROIT-SUPERIOR BRIDGE OVER CUYAHOGA RIVER
BRIDGE NO. CUY-6-1465 | |
| NOT TO SCALE | NOV, 2018 | | INFRASTRUCTURE ENGINEERS, INC. | SPAN 1 CONCRETE REPAIR DETAILS |

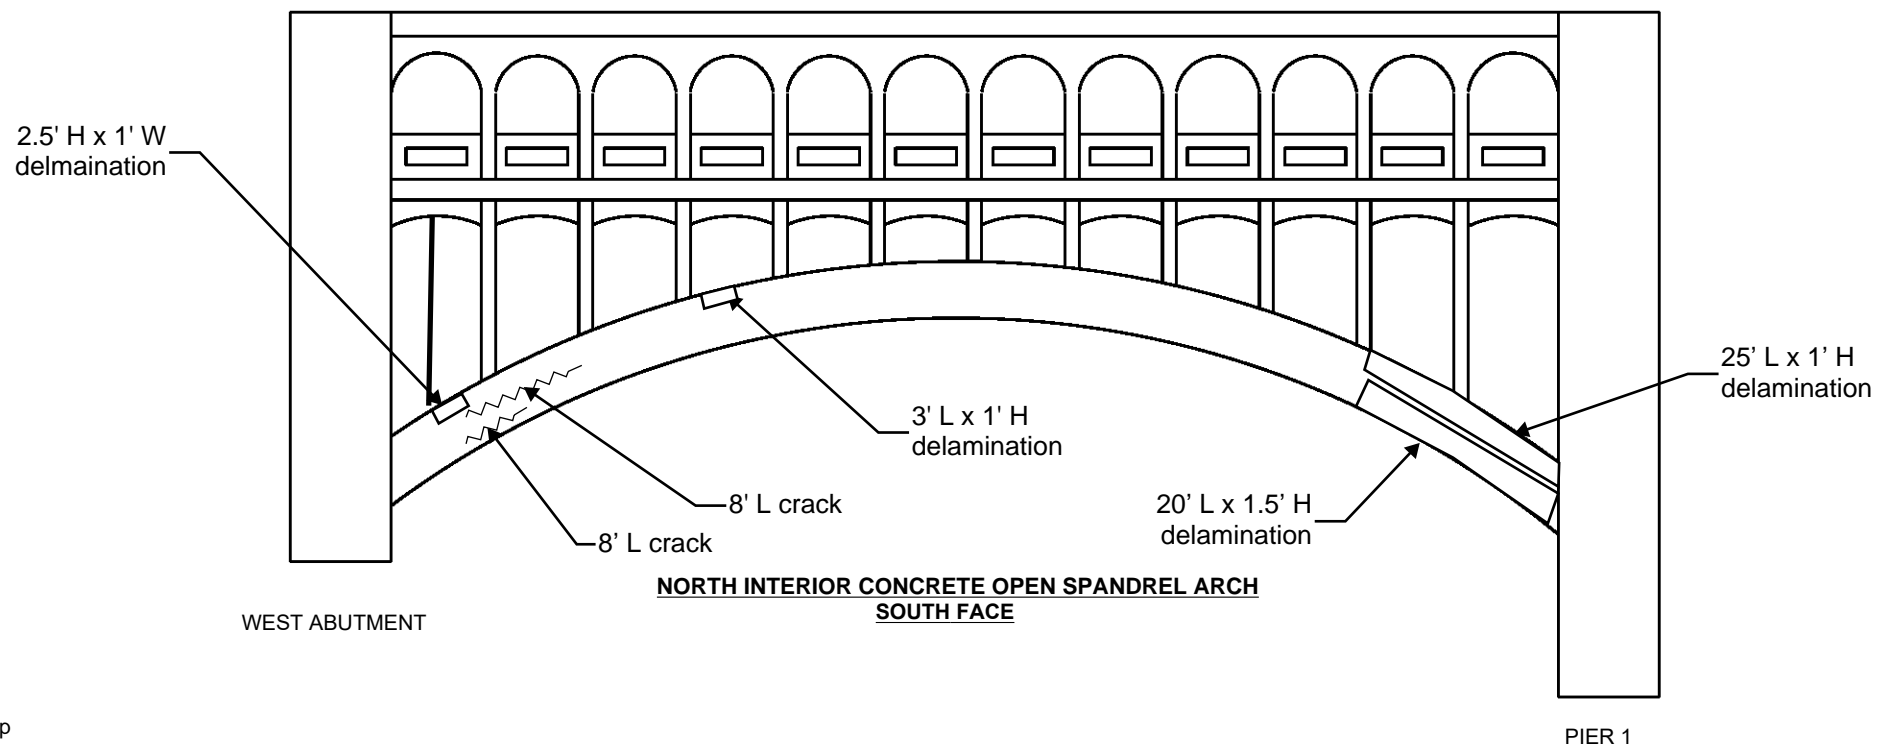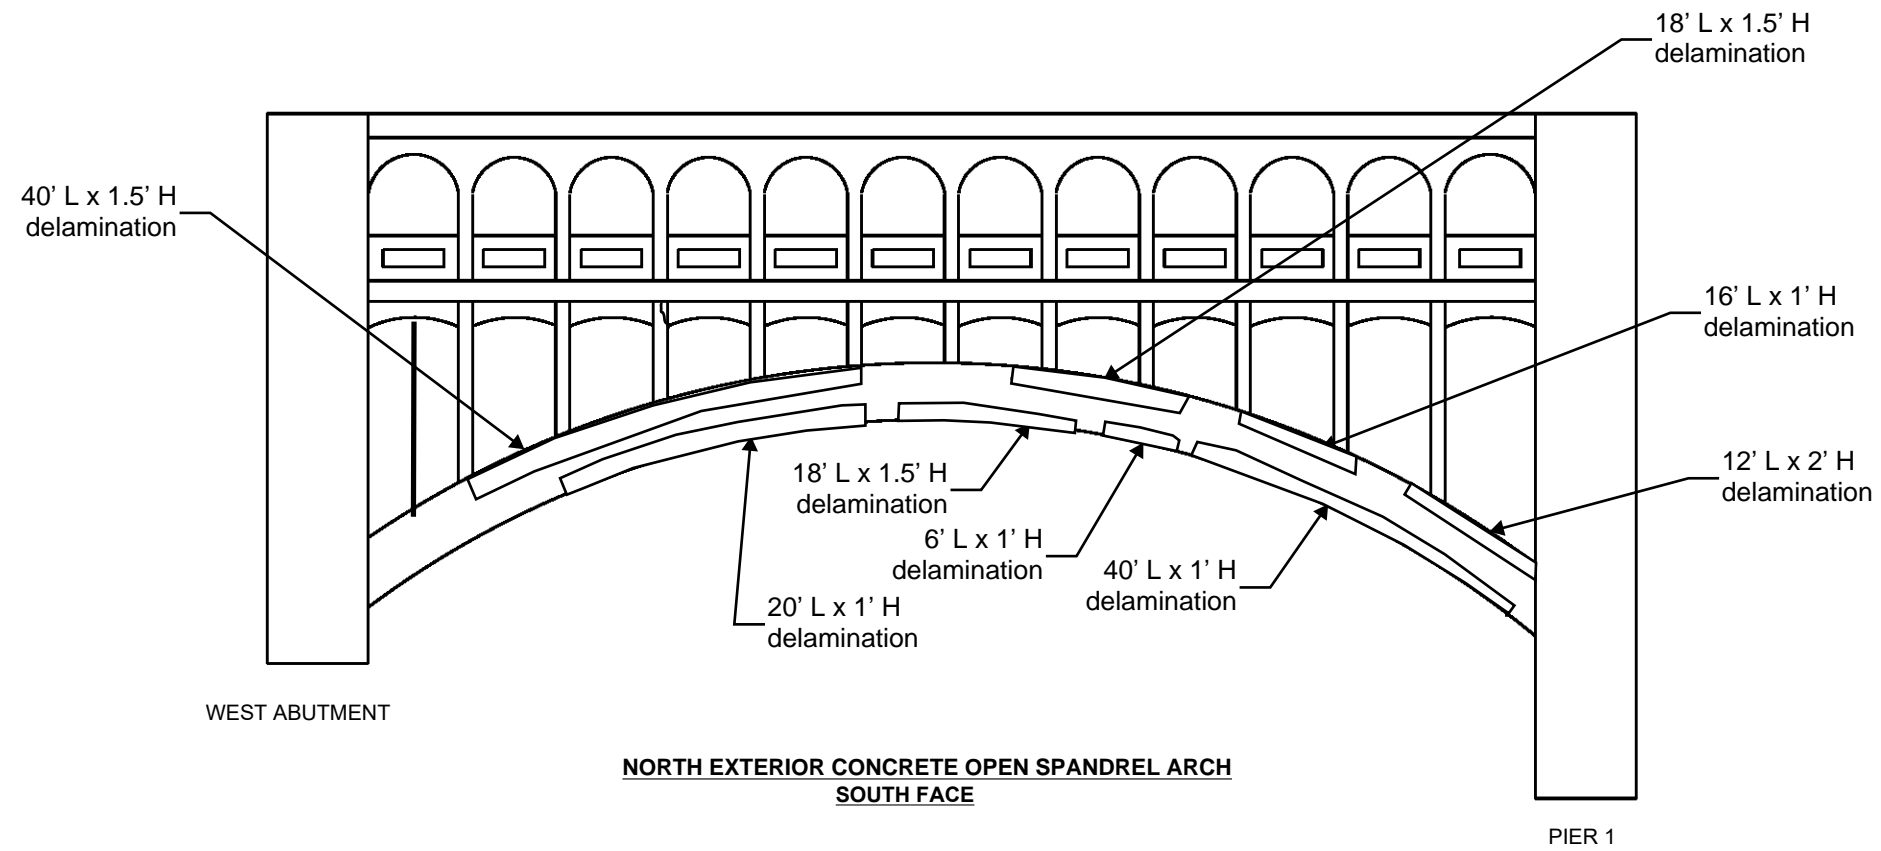


General Notes:

- Arches typically exhibit cracking, spalls, and marked up delaminations throughout.

| | | | | |
|--------------------------------|------|--|--|-----------|
| GRAPHIC SCALE MEASURED IN FEET | DATE |  9902 Carver Road
Suite 201
Cincinnati, OH 45242
PH.: 614.699.5000 | DETROIT-SUPERIOR BRIDGE OVER CUYAHOGA RIVER
BRIDGE NO. CUY-6-1465 | |
| | | | NOT TO SCALE | NOV, 2018 |
| | | | PAGE | A-35 |

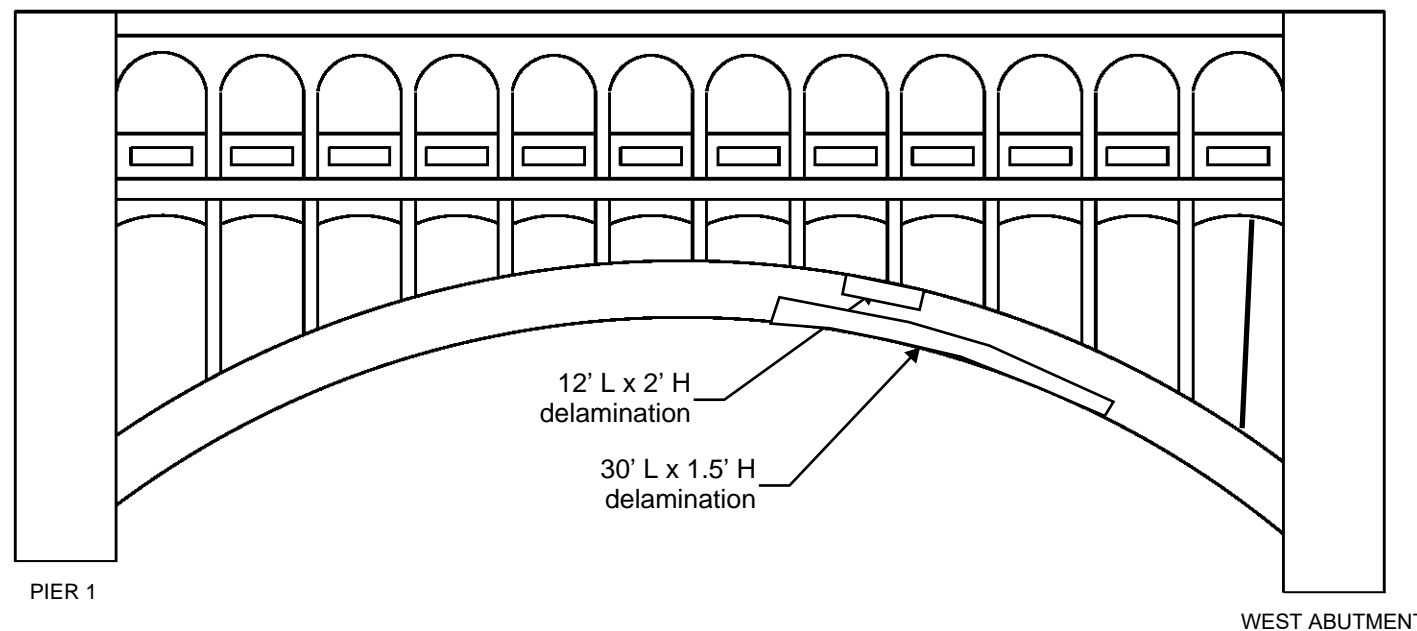

NORTH EXTERIOR CONCRETE OPEN SPANDREL ARCH
NORTH FACE

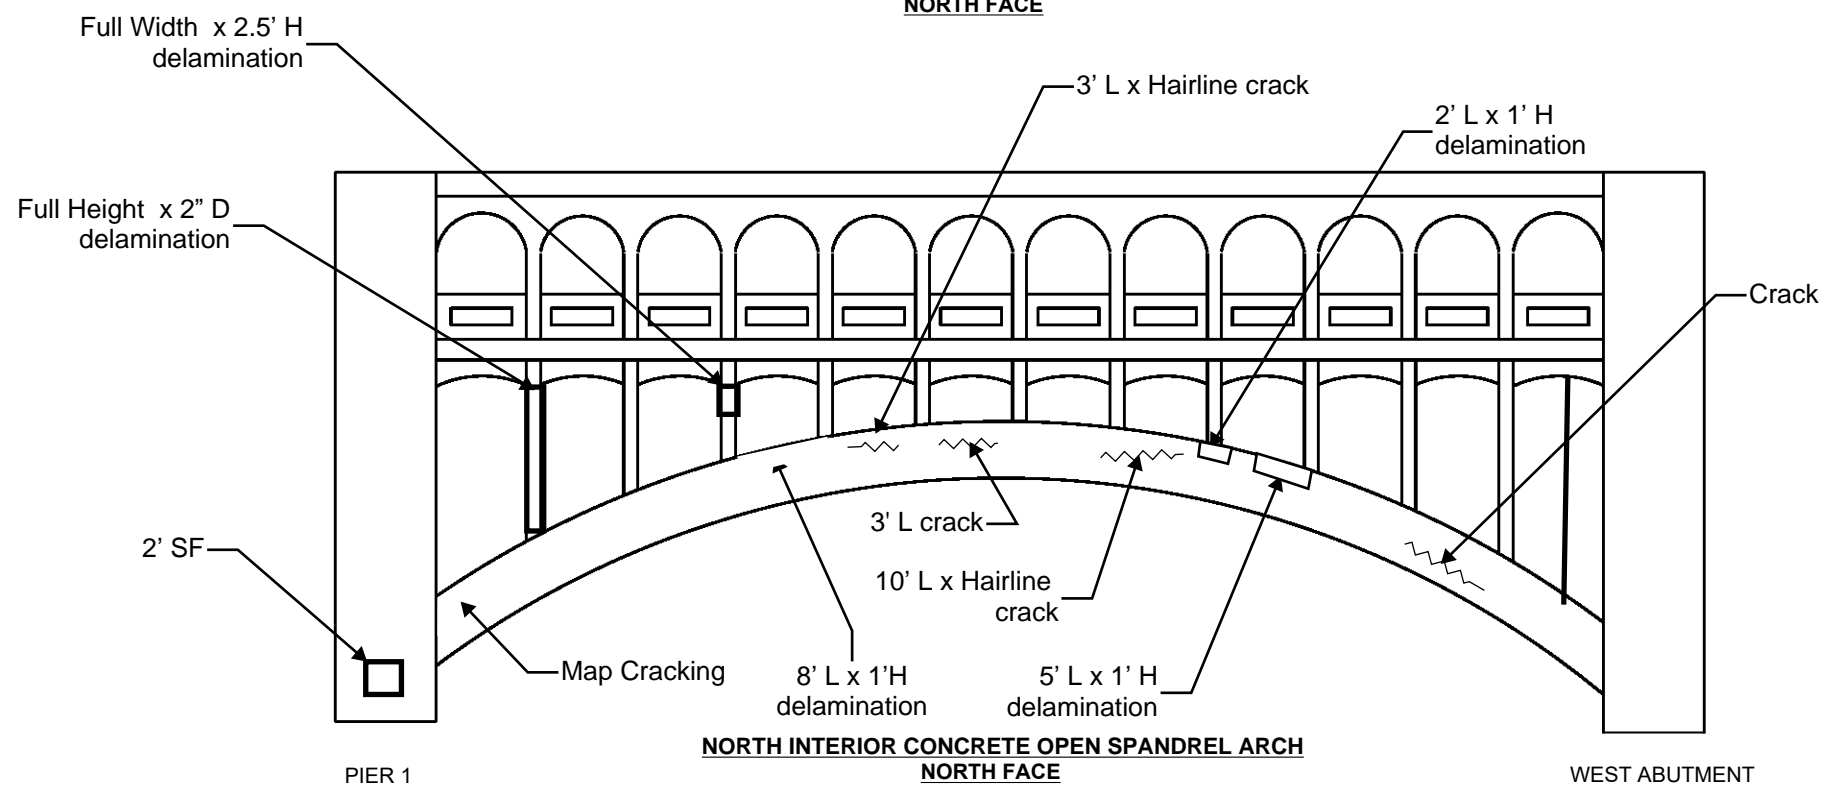


NORTH INTERIOR CONCRETE OPEN SPANDREL ARCH
NORTH FACE

General Notes:

- Arches typically exhibit cracking, spalls, and marked up delaminations throughout.


| | | | | |
|--------------------------------|--------------|--|--|--------------------------------|
| GRAPHIC SCALE MEASURED IN FEET | DATE |  9902 Carver Road
Suite 201
Cincinnati, OH 45242
PH.: 614.699.5000 | DETROIT-SUPERIOR BRIDGE OVER CUYAHOGA RIVER
BRIDGE NO. CUY-6-1465 | |
| | NOT TO SCALE | | NOV, 2018 | INFRASTRUCTURE ENGINEERS, INC. |
| | | | PAGE | A-36 |

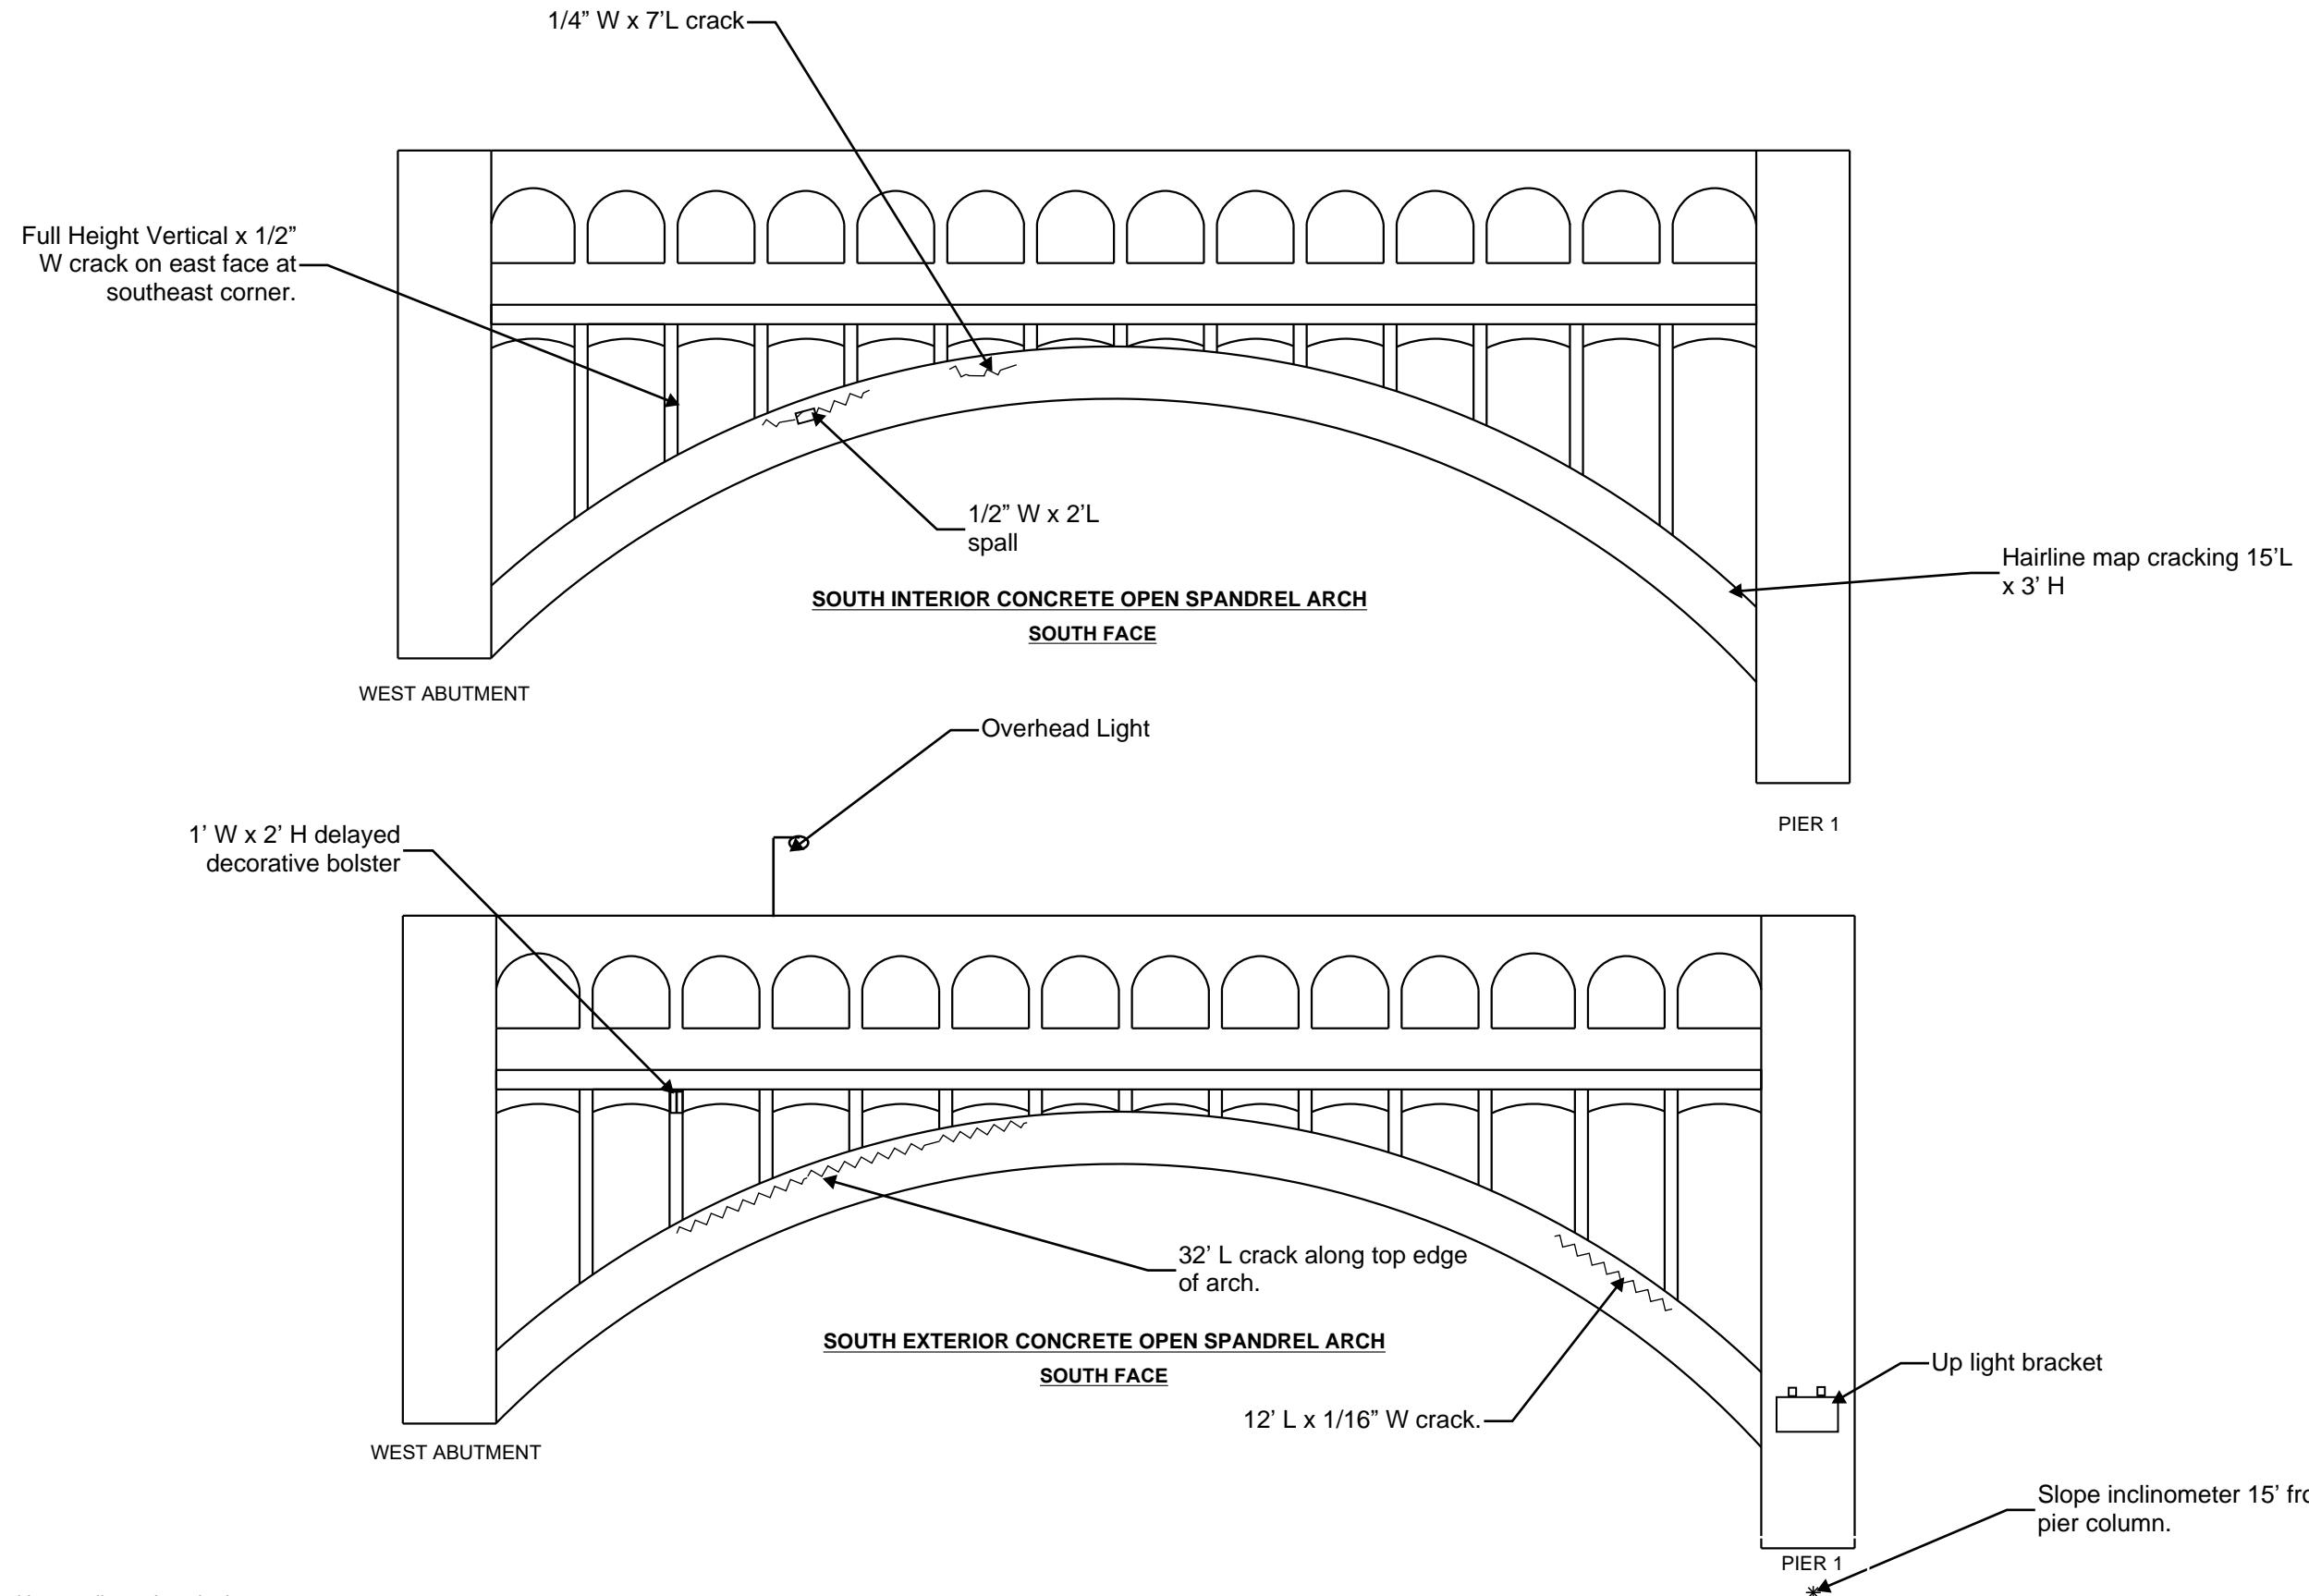


General Notes:

- Arches typically exhibit cracking, spalls, and marked up delaminations throughout.


| | | | |
|--------------------------------|-----------|--|--|
| GRAPHIC SCALE MEASURED IN FEET | DATE |  9902 Carver Road
Suite 201
Cincinnati, OH 45242
PH.: 614.699.5000 | DETROIT-SUPERIOR BRIDGE OVER CUYAHOGA RIVER
BRIDGE NO. CUY-6-1465 |
| NOT TO SCALE | NOV, 2018 | INFRASTRUCTURE ENGINEERS, INC. | STRUCTURE ELEVATION - SPAN 1 |
| | | | PAGE
A-37 |

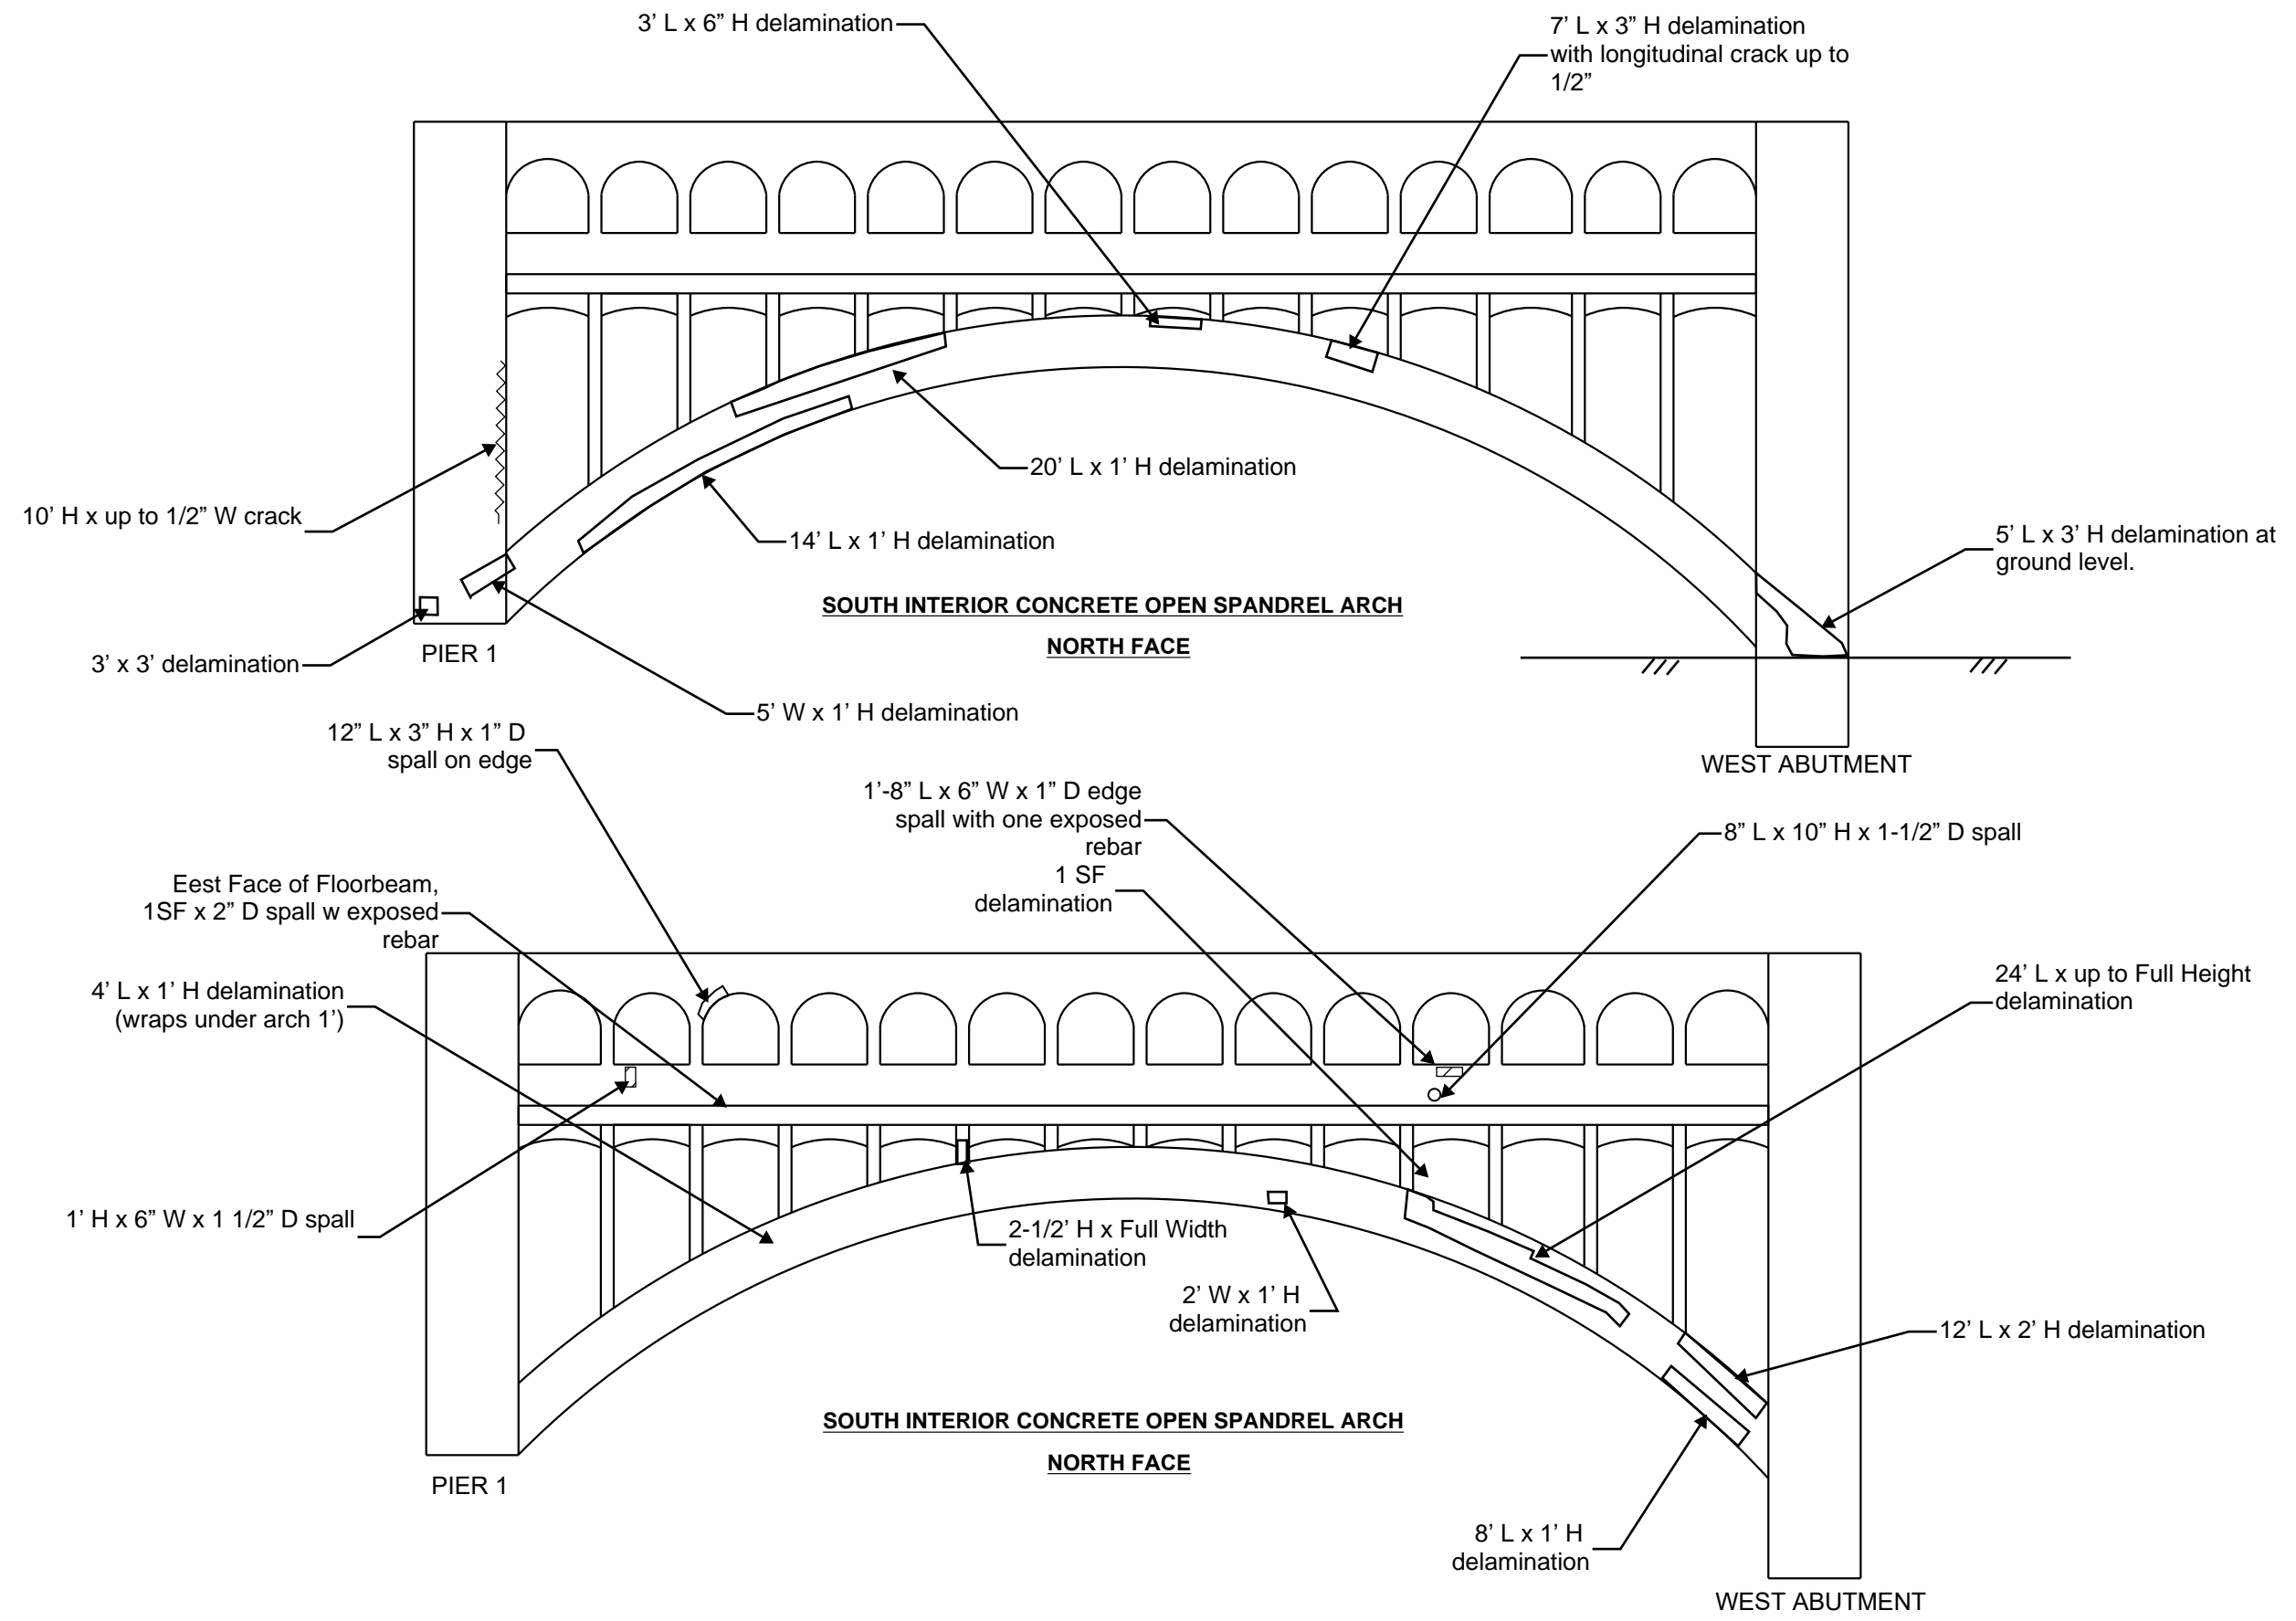

| | | | | |
|--------------------------------|------|--|--|-----------|
| GRAPHIC SCALE MEASURED IN FEET | DATE |  9902 Carver Road
Suite 201
Cincinnati, OH 45242
PH.: 614.699.5000 | DETROIT-SUPERIOR BRIDGE OVER CUYAHOGA RIVER
BRIDGE NO. CUY-6-1465 | |
| | | | NOT TO SCALE | NOV, 2018 |
| | | | PAGE | A-38 |

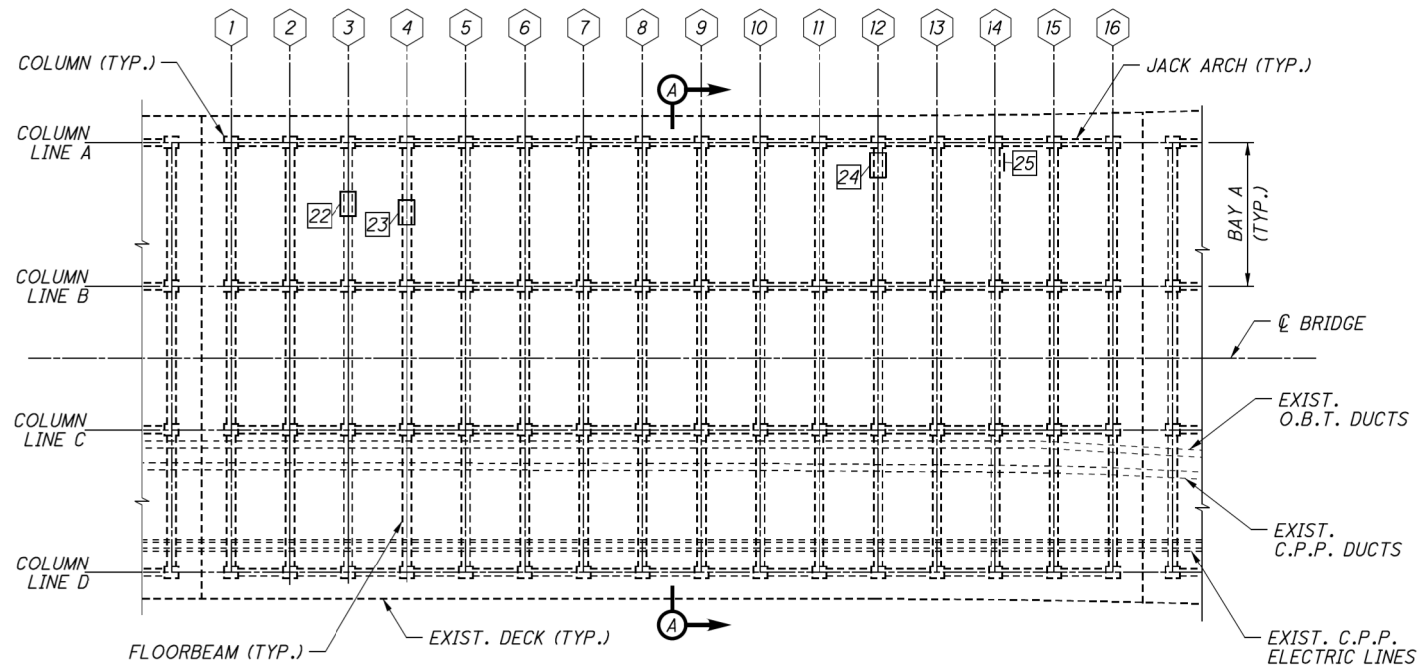

SPAN 2 - UPPER DECK PLAN

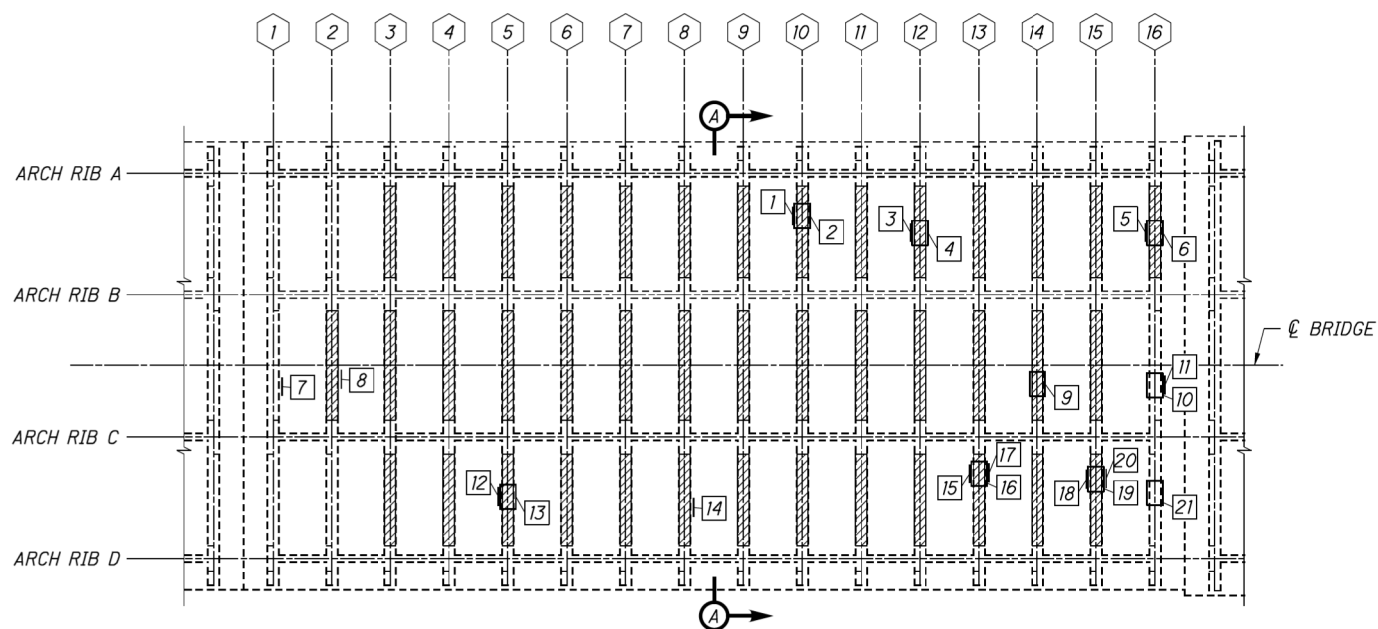


SPAN 2 - LOWER DECK PLAN

| ESTIMATED PATCHING QUANTITIES | | | |
|-------------------------------|-------------|-----------|------------------|
| REPAIR NO. | REPAIR TYPE | AREA (SF) | ANODE QUANTITY** |
| 1 | TYPE 1 | 5 | 3 |
| 2 | TYPE 2 | 10 | 4 |
| 3 | TYPE 1 | 10 | 5 |
| 4 | TYPE 2 | 10 | 8 |
| 5 | TYPE 1 | 5 | 3 |
| 6 | TYPE 2 | 10 | 4 |
| 7 | TYPE 1 | 4 | 1 |
| 8 | TYPE 1 | 3 | 2 |
| 9 | TYPE 2 | 10 | 8 |
| 10 | TYPE 2 | 12 | 10 |
| 11 | TYPE 1 | 20 | 5 |
| 12 | TYPE 1 | 10 | 3 |
| 13 | TYPE 2 | 10 | 8 |
| 14 | TYPE 1 | 8 | 2 |
| 15 | TYPE 1 | 10 | 3 |
| 16 | TYPE 2 | 10 | 4 |
| 17 | TYPE 1 | 5 | 3 |

| ESTIMATED PATCHING QUANTITIES | | | |
|-------------------------------|-------------|-----------|------------------|
| REPAIR NO. | REPAIR TYPE | AREA (SF) | ANODE QUANTITY** |
| 18 | TYPE 1 | 10 | 5 |
| 19 | TYPE 2 | 10 | 4 |
| 20 | TYPE 1 | 20 | 5 |
| 21 | TYPE 2 | 33 | 13 |
| 22 | TYPE 2 | 2 | 1 |
| 23 | TYPE 2 | 3 | 2 |
| 24 | TYPE 2 | 1 | 1 |
| 25 | TYPE 1 | 12 | 3 |
| MEASURED QUANTITY* | | 243 | - |
| PLAN QUANTITY* | | 365 | 110 |

* SEE NOTES 1 & 2
** SEE NOTE 3

| SHEET QUANTITY SUMMARY | | |
|------------------------|------|----------|
| ITEM | UNIT | QUANTITY |
| TYPE 1 REPAIR | SF | 183 |
| TYPE 2 REPAIR | SF | 182 |
| FRP WRAP | SF | 3524 |

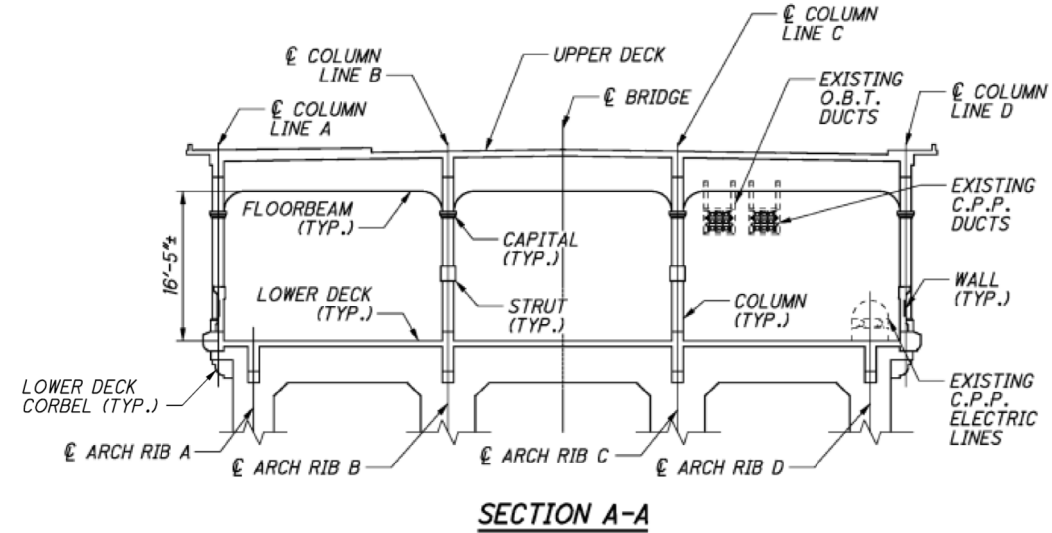

SECTION A-A


NOTES:

- MEASURED QUANTITIES ARE BASED ON THE INSPECTION PERFORMED IN OCTOBER 2017. THE EXACT DIMENSIONS AND LOCATIONS OF PATCHES SHALL BE DETERMINED BY THE ENGINEER IN THE FIELD FOR FINAL PAY QUANTITY.
- PLAN QUANTITIES INCLUDE 50% CONTINGENCY ADDED TO MEASURED QUANTITIES.
- ANODES ARE INCLUDED FOR PAYMENT WITH ITEM SPECIAL - PATCHING CONCRETE STRUCTURE, TYPE 1 OR TYPE 2 REPAIR.
- FOR DETAILS AND MAXIMUM GRID SPACING FOR EMBEDDED GALVANIC ANODES, SEE SHEET 84/89.
- FOR FRP WRAP DETAILS, SEE SHEET 85/89.


LEGEND:

- # FLOORBEAM LINE NUMBER
- # REPAIR NO. OF DEFICIENT CONCRETE TO BE REPAIRED IN ACCORDANCE WITH ITEM SPECIAL - PATCHING CONCRETE STRUCTURE, TYPE 1 OR TYPE 2 REPAIR.
- ▨ AREA TO BE TREATED WITH FRP WRAP PER ITEM SPECIAL - COMPOSITE FIBER WRAP SYSTEM

| | | | | |
|--------------------------------|-----------|--|--|--------------------------------|
| GRAPHIC SCALE MEASURED IN FEET | DATE | 9902 Carver Road
Suite 201
Cincinnati, OH 45242
PH.: 614.699.5000 | DETROIT-SUPERIOR BRIDGE OVER CUYAHOGA RIVER
BRIDGE NO. CUY-6-1465 | |
| NOT TO SCALE | NOV, 2018 | | INFRASTRUCTURE ENGINEERS, INC. | SPAN 2 CONCRETE REPAIR DETAILS |

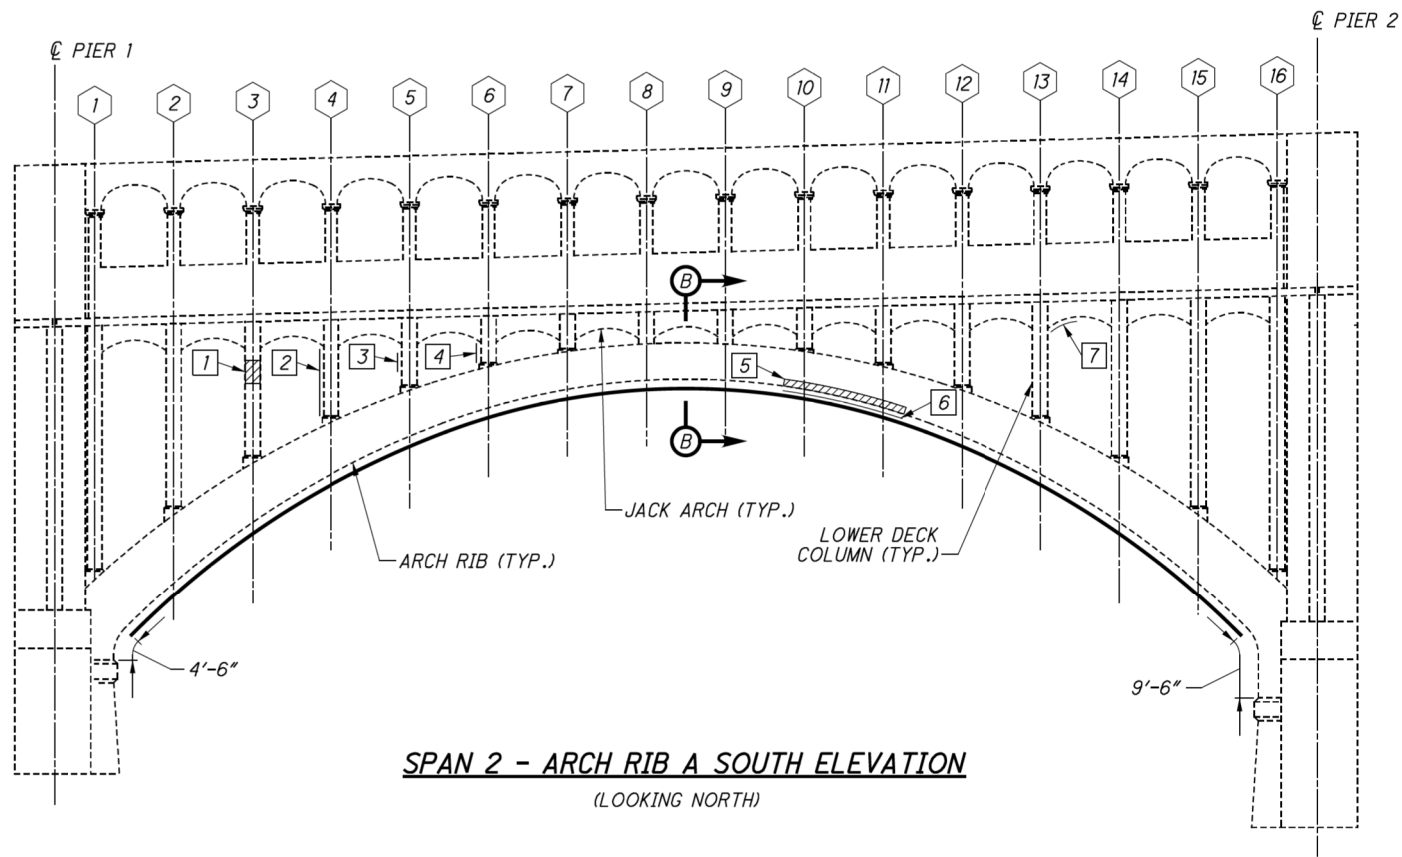

SPAN 2 - ARCH RIB A SOUTH ELEVATION
(LOOKING NORTH)

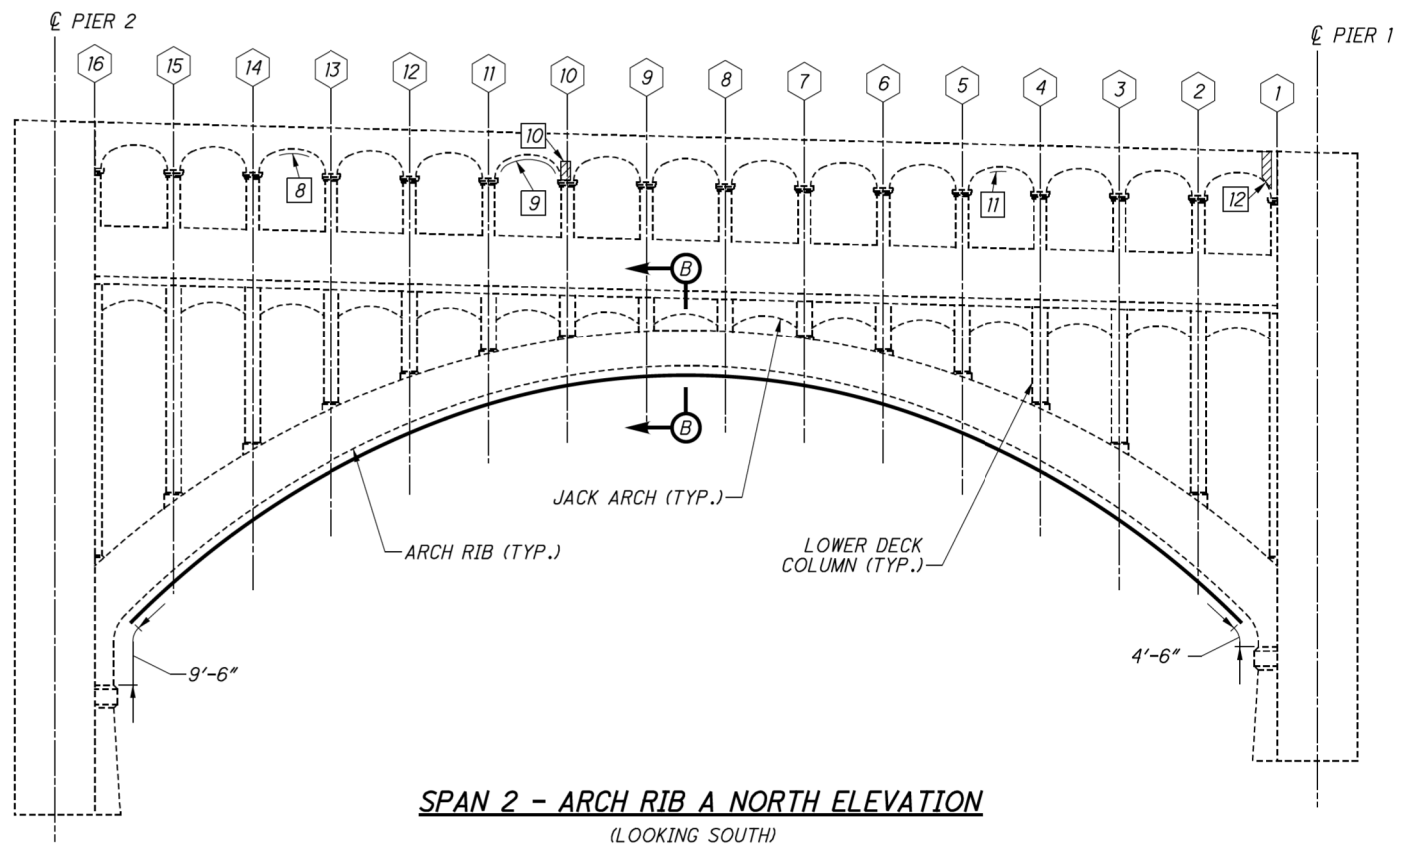

SPAN 2 - ARCH RIB A NORTH ELEVATION
(LOOKING SOUTH)

| ESTIMATED PATCHING QUANTITIES | | | |
|-------------------------------|-------------|-----------|------------------|
| REPAIR NO. | REPAIR TYPE | AREA (SF) | ANODE QUANTITY** |
| 1 | TYPE 1 | 6 | 2 |
| 2 | TYPE 1 | 14 | 4 |
| 3 | TYPE 1 | 2 | 1 |
| 4 | TYPE 1 | 6 | 2 |
| 5 | TYPE 1 | 14 | - |
| 6 | TYPE 2 | 14 | 10 |
| 7 | TYPE 2 | 3 | 2 |
| 8 | TYPE 2 | 5 | 2 |
| 9 | TYPE 2 | 8 | 6 |
| 10 | TYPE 1 | 2 | 1 |
| 11 | TYPE 2 | 2 | 1 |
| 12 | TYPE 1 | 4 | 2 |
| MEASURED QUANTITY* | | 80 | - |
| PLAN QUANTITY* | | 120 | 33 |

* SEE NOTES 1 & 2
** SEE NOTES 3 & 4

| SHEET QUANTITY SUMMARY | | |
|------------------------|------|----------|
| ITEM | UNIT | QUANTITY |
| TYPE 1 REPAIR | SF | 72 |
| TYPE 2 REPAIR | SF | 48 |
| FRP WRAP | SF | 1949 |


NOTES:

- MEASURED QUANTITIES ARE BASED ON THE VISUAL INSPECTION PERFORMED IN NOVEMBER 2017. THE EXACT DIMENSIONS AND LOCATIONS OF PATCHES SHALL BE DETERMINED BY THE ENGINEER IN THE FIELD FOR FINAL PAY QUANTITY.
- PLAN QUANTITIES INCLUDE 50% CONTINGENCY ADDED TO MEASURED QUANTITIES.
- ANODES ARE INCLUDED FOR PAYMENT WITH ITEM SPECIAL - PATCHING CONCRETE STRUCTURE, TYPE 1 OR TYPE 2 REPAIR.
- GALVANIC ANODES WILL NOT BE USED FOR PATCHING THE UNREINFORCED VERTICAL SIDES OF THE CONCRETE ARCH RIBS.
- FOR DETAILS AND MAXIMUM GRID SPACING FOR EMBEDDED GALVANIC ANODES, SEE SHEET 84/89.
- FOR FRP WRAP DETAILS AND SECTION B-B, SEE SHEET 85/89.


LEGEND:

- SPANDREL COLUMN NUMBER
- REPAIR NUMBER
- LOCATION OF DEFICIENT CONCRETE TO BE REPAIRED IN ACCORDANCE WITH ITEM SPECIAL - PATCHING CONCRETE STRUCTURE, TYPE 1 REPAIR
- LOCATION OF DEFICIENT CONCRETE ON PERPENDICULAR FACE (NOT VISIBLE IN ELEVATION VIEW) TO BE REPAIRED IN ACCORDANCE WITH ITEM SPECIAL - PATCHING CONCRETE STRUCTURE, TYPE 1 OR TYPE 2 REPAIR
- AREA TO BE TREATED WITH FRP WRAP PER ITEM SPECIAL - COMPOSITE FIBER WRAP SYSTEM

| | | | | |
|--------------------------------|-----------|--|--|--------------------------------|
| GRAPHIC SCALE MEASURED IN FEET | DATE | 9902 Carver Road
Suite 201
Cincinnati, OH 45242
PH.: 614.699.5000 | DETROIT-SUPERIOR BRIDGE OVER CUYAHOGA RIVER
BRIDGE NO. CUY-6-1465 | |
| NOT TO SCALE | NOV, 2018 | | INFRASTRUCTURE ENGINEERS, INC. | SPAN 1 CONCRETE REPAIR DETAILS |

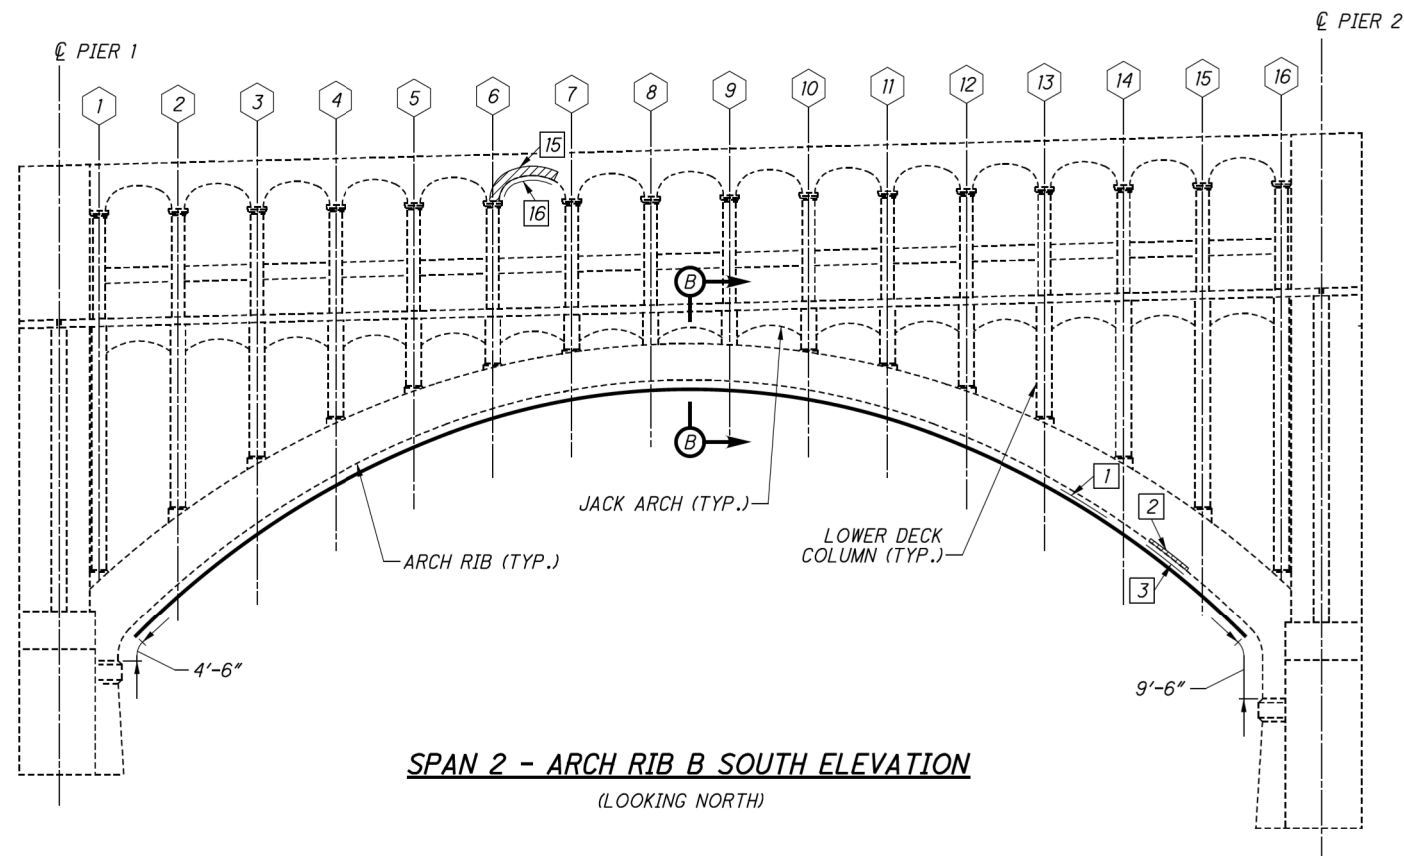

SPAN 2 - ARCH RIB B SOUTH ELEVATION
(LOOKING NORTH)

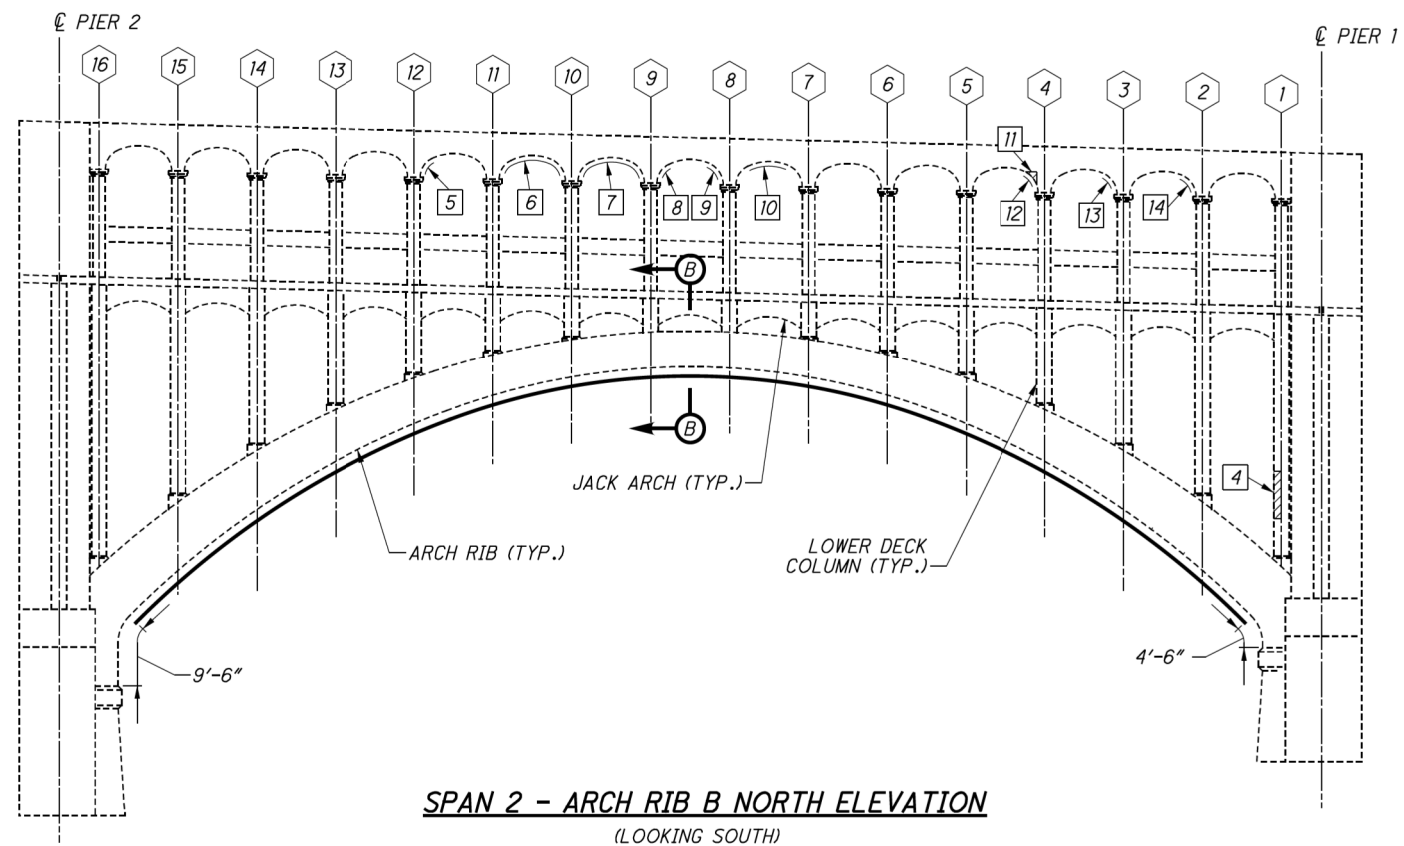

SPAN 2 - ARCH RIB B NORTH ELEVATION
(LOOKING SOUTH)

| ESTIMATED PATCHING QUANTITIES | | | |
|-------------------------------|-------------|-----------|------------------|
| REPAIR NO. | REPAIR TYPE | AREA (SF) | ANODE QUANTITY** |
| 1 | TYPE 2 | 6 | 4 |
| 2 | TYPE 1 | 1 | - |
| 3 | TYPE 2 | 5 | 4 |
| 4 | TYPE 1 | 6 | 3 |
| 5 | TYPE 2 | 2 | 1 |
| 6 | TYPE 2 | 18 | 8 |
| 7 | TYPE 2 | 18 | 8 |
| 8 | TYPE 2 | 6 | 2 |
| 9 | TYPE 2 | 6 | 2 |
| 10 | TYPE 2 | 9 | 4 |
| 11 | TYPE 1 | 1 | 1 |
| 12 | TYPE 2 | 1 | 1 |
| 13 | TYPE 2 | 2 | 1 |
| 14 | TYPE 2 | 4 | 2 |
| 15 | TYPE 1 | 10 | 5 |
| 16 | TYPE 2 | 12 | 6 |
| MEASURED QUANTITY* | | 107 | - |
| PLAN QUANTITY* | | 161 | 52 |

* SEE NOTES 1 & 2
** SEE NOTES 3 & 4

| SHEET QUANTITY SUMMARY | | |
|------------------------|------|----------|
| ITEM | UNIT | QUANTITY |
| TYPE 1 REPAIR | SF | 27 |
| TYPE 2 REPAIR | SF | 134 |
| FRP WRAP | SF | 2322 |



NOTES:

- MEASURED QUANTITIES ARE BASED ON THE VISUAL INSPECTION PERFORMED IN NOVEMBER 2017. THE EXACT DIMENSIONS AND LOCATIONS OF PATCHES SHALL BE DETERMINED BY THE ENGINEER IN THE FIELD FOR FINAL PAY QUANTITY.
- PLAN QUANTITIES INCLUDE 50% CONTINGENCY ADDED TO MEASURED QUANTITIES.
- ANODES ARE INCLUDED FOR PAYMENT WITH ITEM SPECIAL - PATCHING CONCRETE STRUCTURE, TYPE 1 OR TYPE 2 REPAIR.
- GALVANIC ANODES WILL NOT BE USED FOR PATCHING THE UNREINFORCED VERTICAL SIDES OF THE CONCRETE ARCH RIBS.
- FOR DETAILS AND MAXIMUM GRID SPACING FOR EMBEDDED GALVANIC ANODES, SEE SHEET 84/89.
- FOR FRP WRAP DETAILS AND SECTION B-B, SEE SHEET 85/89.

LEGEND:

- SPANDREL COLUMN NUMBER
- REPAIR NUMBER
- LOCATION OF DEFICIENT CONCRETE TO BE REPAIRED IN ACCORDANCE WITH ITEM SPECIAL - PATCHING CONCRETE STRUCTURE, TYPE 1 REPAIR
- LOCATION OF DEFICIENT CONCRETE ON PERPENDICULAR FACE (NOT VISIBLE IN ELEVATION VIEW) TO BE REPAIRED IN ACCORDANCE WITH ITEM SPECIAL - PATCHING CONCRETE STRUCTURE, TYPE 1 OR TYPE 2 REPAIR
- AREA TO BE TREATED WITH FRP WRAP PER ITEM SPECIAL - COMPOSITE FIBER WRAP SYSTEM

| | | | | |
|--------------------------------|--------------------------------|--|---|-----------|
| GRAPHIC SCALE MEASURED IN FEET | DATE | 9902 Carver Road
Suite 201
Cincinnati, OH 45242
PH.: 614.699.5000 | DETROIT-SUPERIOR BRIDGE OVER CUYAHOGA RIVER | |
| | NOV, 2018 | | BRIDGE NO. CUY-6-1465 | |
| NOT TO SCALE | INFRASTRUCTURE ENGINEERS, INC. | | SPAN 2 CONCRETE REPAIR DETAILS | PAGE A-41 |

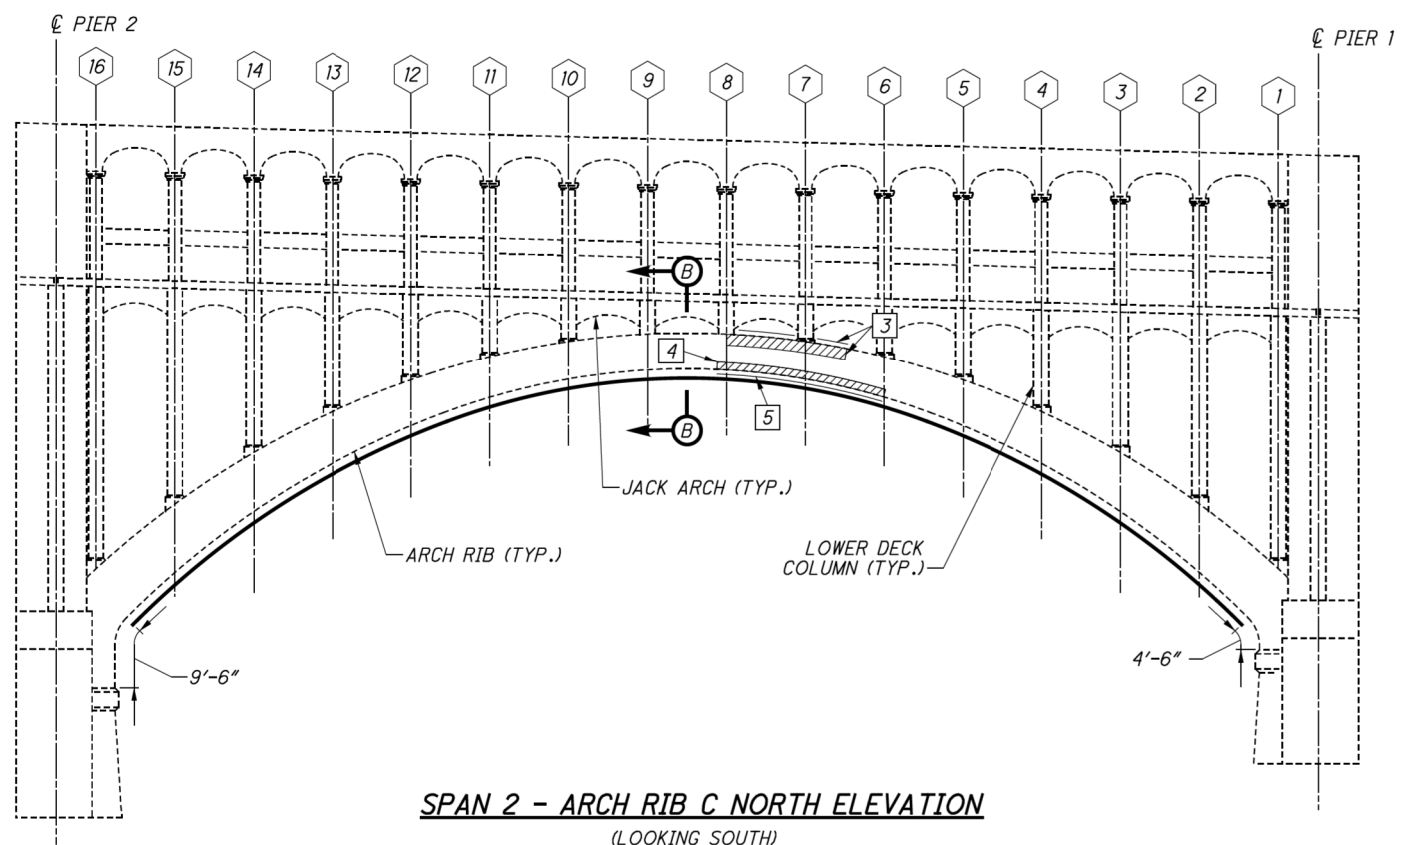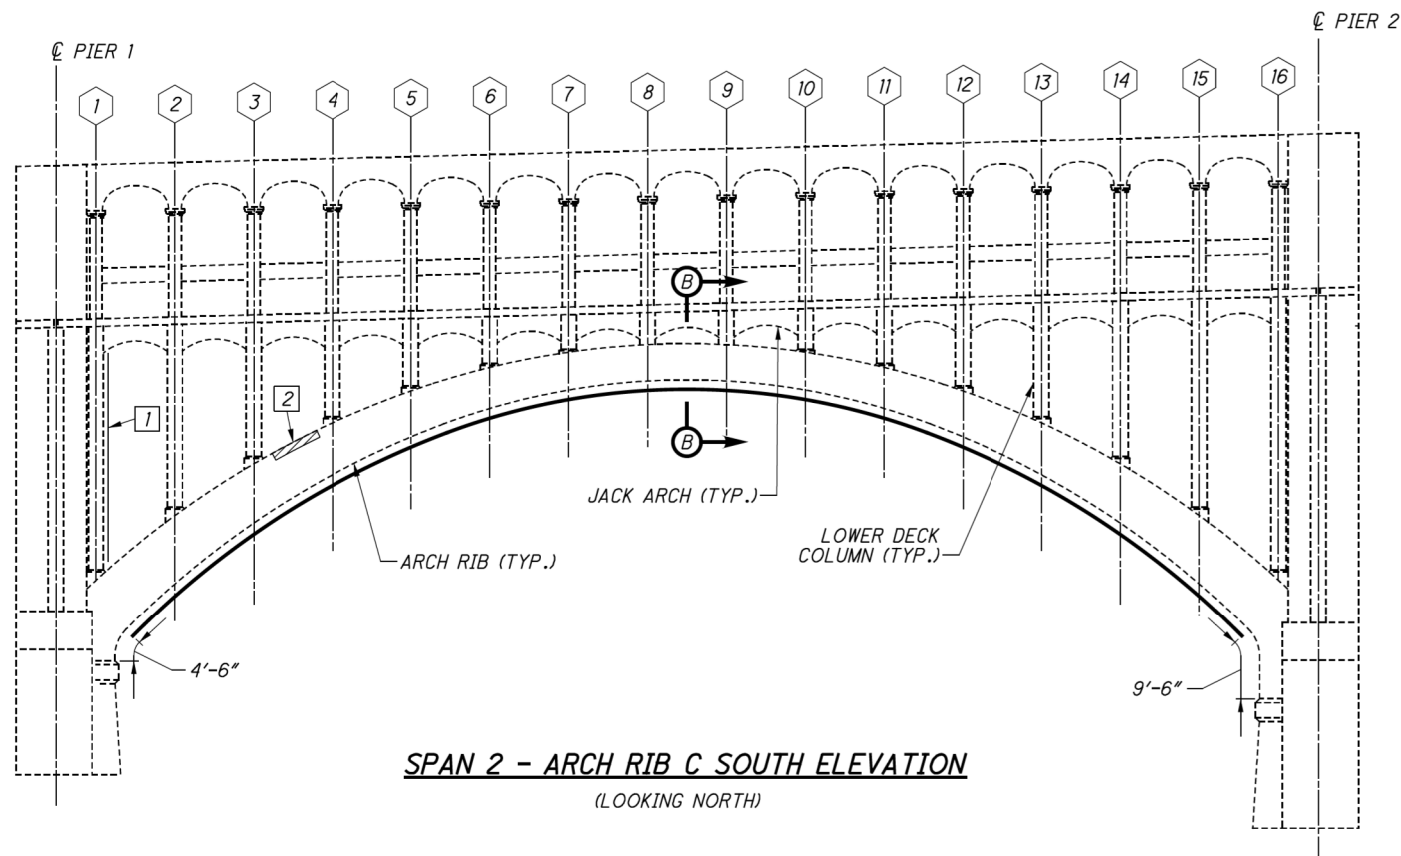

| ESTIMATED PATCHING QUANTITIES | | | |
|-------------------------------|-------------|-----------|------------------|
| REPAIR NO. | REPAIR TYPE | AREA (SF) | ANODE QUANTITY** |
| 1 | TYPE 1 | 56 | 14 |
| 2 | TYPE 1 | 6 | - |
| 3 | TYPE 1 | 40 | 12 |
| 4 | TYPE 1 | 23 | - |
| 5 | TYPE 2 | 23 | 17 |
| MEASURED QUANTITY* | | 148 | - |
| PLAN QUANTITY* | | 222 | 43 |

* SEE NOTES 1 & 2
** SEE NOTES 3 & 4

| SHEET QUANTITY SUMMARY | | |
|------------------------|------|----------|
| ITEM | UNIT | QUANTITY |
| TYPE 1 REPAIR | SF | 188 |
| TYPE 2 REPAIR | SF | 34 |
| FRP WRAP | SF | 2322 |

NOTES:


- MEASURED QUANTITIES ARE BASED ON THE VISUAL INSPECTION PERFORMED IN NOVEMBER 2017. THE EXACT DIMENSIONS AND LOCATIONS OF PATCHES SHALL BE DETERMINED BY THE ENGINEER IN THE FIELD FOR FINAL PAY QUANTITY.
- PLAN QUANTITIES INCLUDE 50% CONTINGENCY ADDED TO MEASURED QUANTITIES.
- ANODES ARE INCLUDED FOR PAYMENT WITH ITEM SPECIAL - PATCHING CONCRETE STRUCTURE, TYPE 1 OR TYPE 2 REPAIR.
- GALVANIC ANODES WILL NOT BE USED FOR PATCHING THE UNREINFORCED VERTICAL SIDES OF THE CONCRETE ARCH RIBS.
- FOR DETAILS AND MAXIMUM GRID SPACING FOR EMBEDDED GALVANIC ANODES, SEE SHEET [84/89].
- FOR FRP WRAP DETAILS AND SECTION B-B, SEE SHEET [85/89].

LEGEND:


- # SPANDREL COLUMN NUMBER
- # REPAIR NUMBER
- LOCATION OF DEFICIENT CONCRETE TO BE REPAIRED IN ACCORDANCE WITH ITEM SPECIAL - PATCHING CONCRETE STRUCTURE, TYPE 1 REPAIR
- LOCATION OF DEFICIENT CONCRETE ON PERPENDICULAR FACE (NOT VISIBLE IN ELEVATION VIEW) TO BE REPAIRED IN ACCORDANCE WITH ITEM SPECIAL - PATCHING CONCRETE STRUCTURE, TYPE 1 OR TYPE 2 REPAIR
- AREA TO BE TREATED WITH FRP WRAP PER ITEM SPECIAL - COMPOSITE FIBER WRAP SYSTEM

| | | | |
|--------------------------------|-----------|---------------------------------------|---|
| GRAPHIC SCALE MEASURED IN FEET | DATE | | 9902 Carver Road
Suite 201
Cincinnati, OH 45242
PH.: 614.699.5000 |
| NOT TO SCALE | NOV, 2018 | INFRASTRUCTURE ENGINEERS, INC. | DETROIT-SUPERIOR BRIDGE OVER CUYAHOGA RIVER
BRIDGE NO. CUY-6-1465

SPAN 2 CONCRETE REPAIR DETAILS |
| | | | PAGE A-42 |

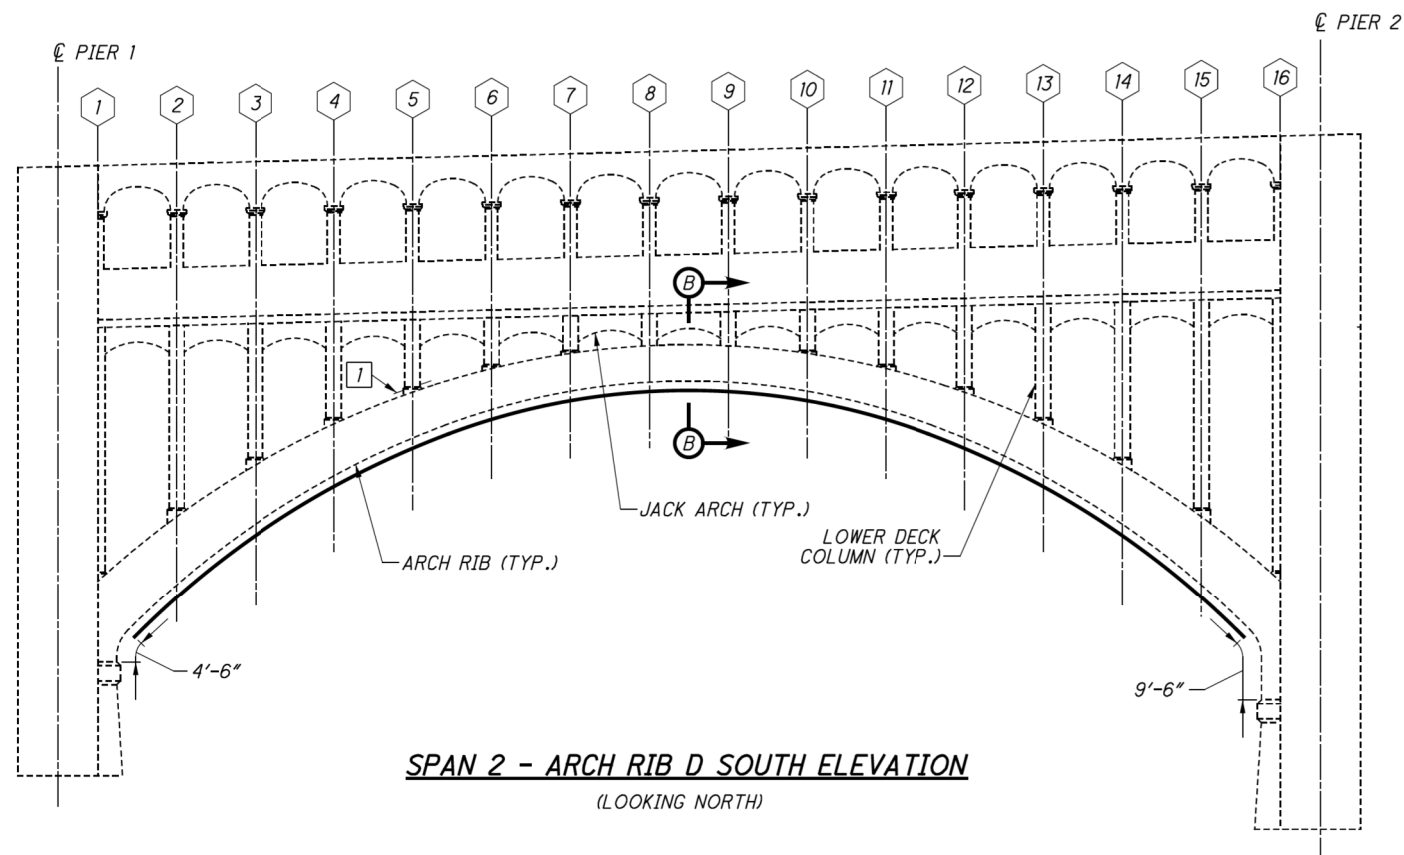

SPAN 2 - ARCH RIB D SOUTH ELEVATION
(LOOKING NORTH)

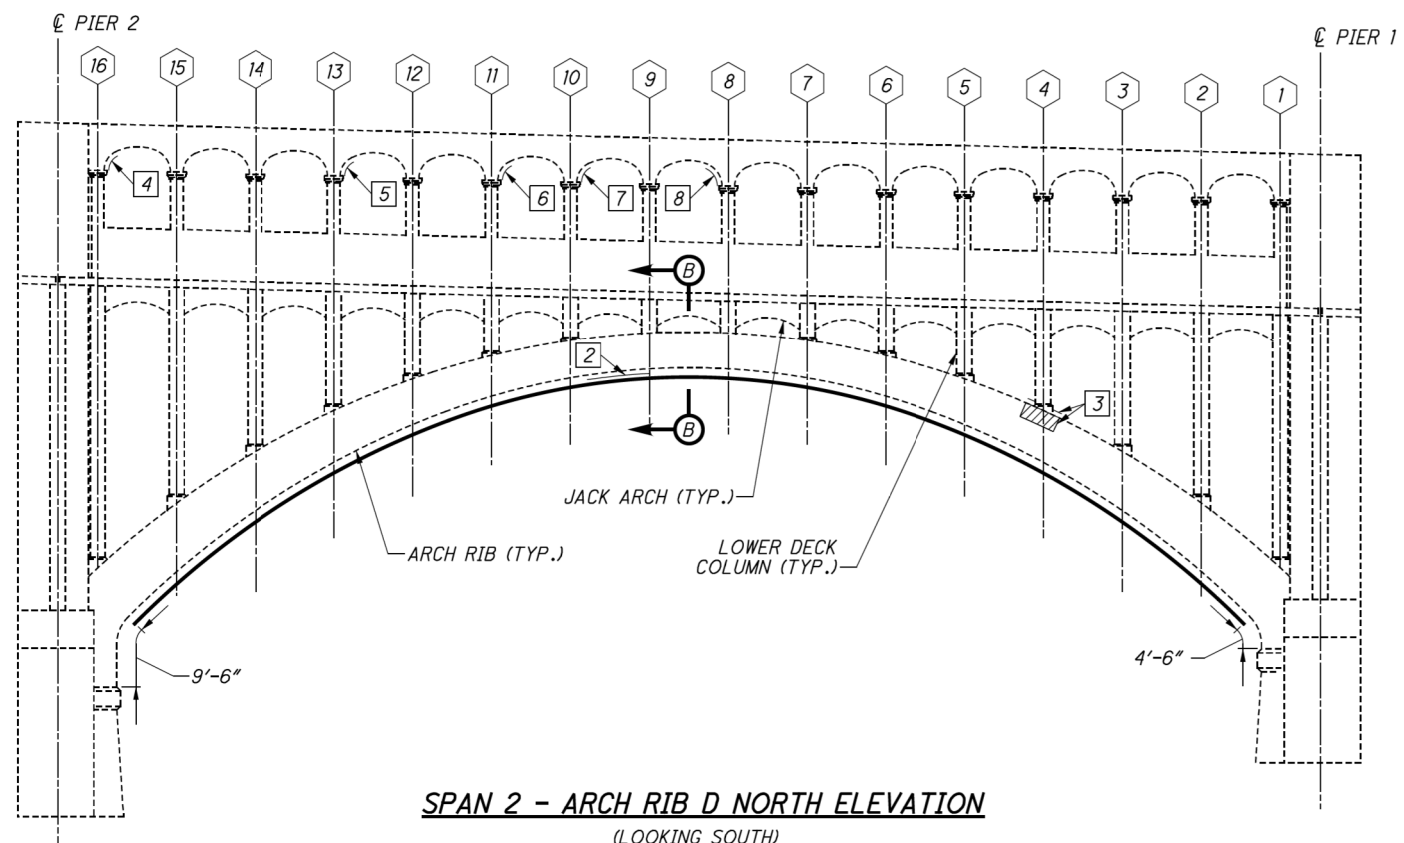

SPAN 2 - ARCH RIB D NORTH ELEVATION
(LOOKING SOUTH)

| ESTIMATED PATCHING QUANTITIES | | | |
|-------------------------------|-------------|-----------|------------------|
| REPAIR NO. | REPAIR TYPE | AREA (SF) | ANODE QUANTITY** |
| 1 | TYPE 1 | 5 | 4 |
| 2 | TYPE 2 | 24 | 12 |
| 3 | TYPE 1 | 12 | 3 |
| 4 | TYPE 2 | 3 | 1 |
| 5 | TYPE 2 | 3 | 1 |
| 6 | TYPE 2 | 4 | 2 |
| 7 | TYPE 2 | 8 | 3 |
| 8 | TYPE 2 | 8 | 3 |
| MEASURED QUANTITY* | | 67 | - |
| PLAN QUANTITY* | | 101 | 29 |

* SEE NOTES 1 & 2
** SEE NOTES 3 & 4

| SHEET QUANTITY SUMMARY | | |
|------------------------|------|----------|
| ITEM | UNIT | QUANTITY |
| TYPE 1 REPAIR | SF | 26 |
| TYPE 2 REPAIR | SF | 75 |
| FRP WRAP | SF | 1949 |


NOTES:

- MEASURED QUANTITIES ARE BASED ON THE VISUAL INSPECTION PERFORMED IN NOVEMBER 2017. THE EXACT DIMENSIONS AND LOCATIONS OF PATCHES SHALL BE DETERMINED BY THE ENGINEER IN THE FIELD FOR FINAL PAY QUANTITY.
- PLAN QUANTITIES INCLUDE 50% CONTINGENCY ADDED TO MEASURED QUANTITIES.
- ANODES ARE INCLUDED FOR PAYMENT WITH ITEM SPECIAL - PATCHING CONCRETE STRUCTURE, TYPE 1 OR TYPE 2 REPAIR.
- GALVANIC ANODES WILL NOT BE USED FOR PATCHING THE UNREINFORCED VERTICAL SIDES OF THE CONCRETE ARCH RIBS.
- FOR DETAILS AND MAXIMUM GRID SPACING FOR EMBEDDED GALVANIC ANODES, SEE SHEET 84/89.
- FOR FRP WRAP DETAILS AND SECTION B-B, SEE SHEET 85/89.

LEGEND:


- SPANDREL COLUMN NUMBER
- REPAIR NUMBER
- LOCATION OF DEFICIENT CONCRETE TO BE REPAIRED IN ACCORDANCE WITH ITEM SPECIAL - PATCHING CONCRETE STRUCTURE, TYPE 1 REPAIR
- LOCATION OF DEFICIENT CONCRETE ON PERPENDICULAR FACE (NOT VISIBLE IN ELEVATION VIEW) TO BE REPAIRED IN ACCORDANCE WITH ITEM SPECIAL - PATCHING CONCRETE STRUCTURE, TYPE 1 OR TYPE 2 REPAIR
- AREA TO BE TREATED WITH FRP WRAP PER ITEM SPECIAL - COMPOSITE FIBER WRAP SYSTEM

| | | | | |
|--------------------------------|-----------|--|--|--------------------------------|
| GRAPHIC SCALE MEASURED IN FEET | DATE | 9902 Carver Road
Suite 201
Cincinnati, OH 45242
PH.: 614.699.5000 | DETROIT-SUPERIOR BRIDGE OVER CUYAHOGA RIVER
BRIDGE NO. CUY-6-1465 | |
| NOT TO SCALE | NOV, 2018 | | INFRASTRUCTURE ENGINEERS, INC. | SPAN 2 CONCRETE REPAIR DETAILS |

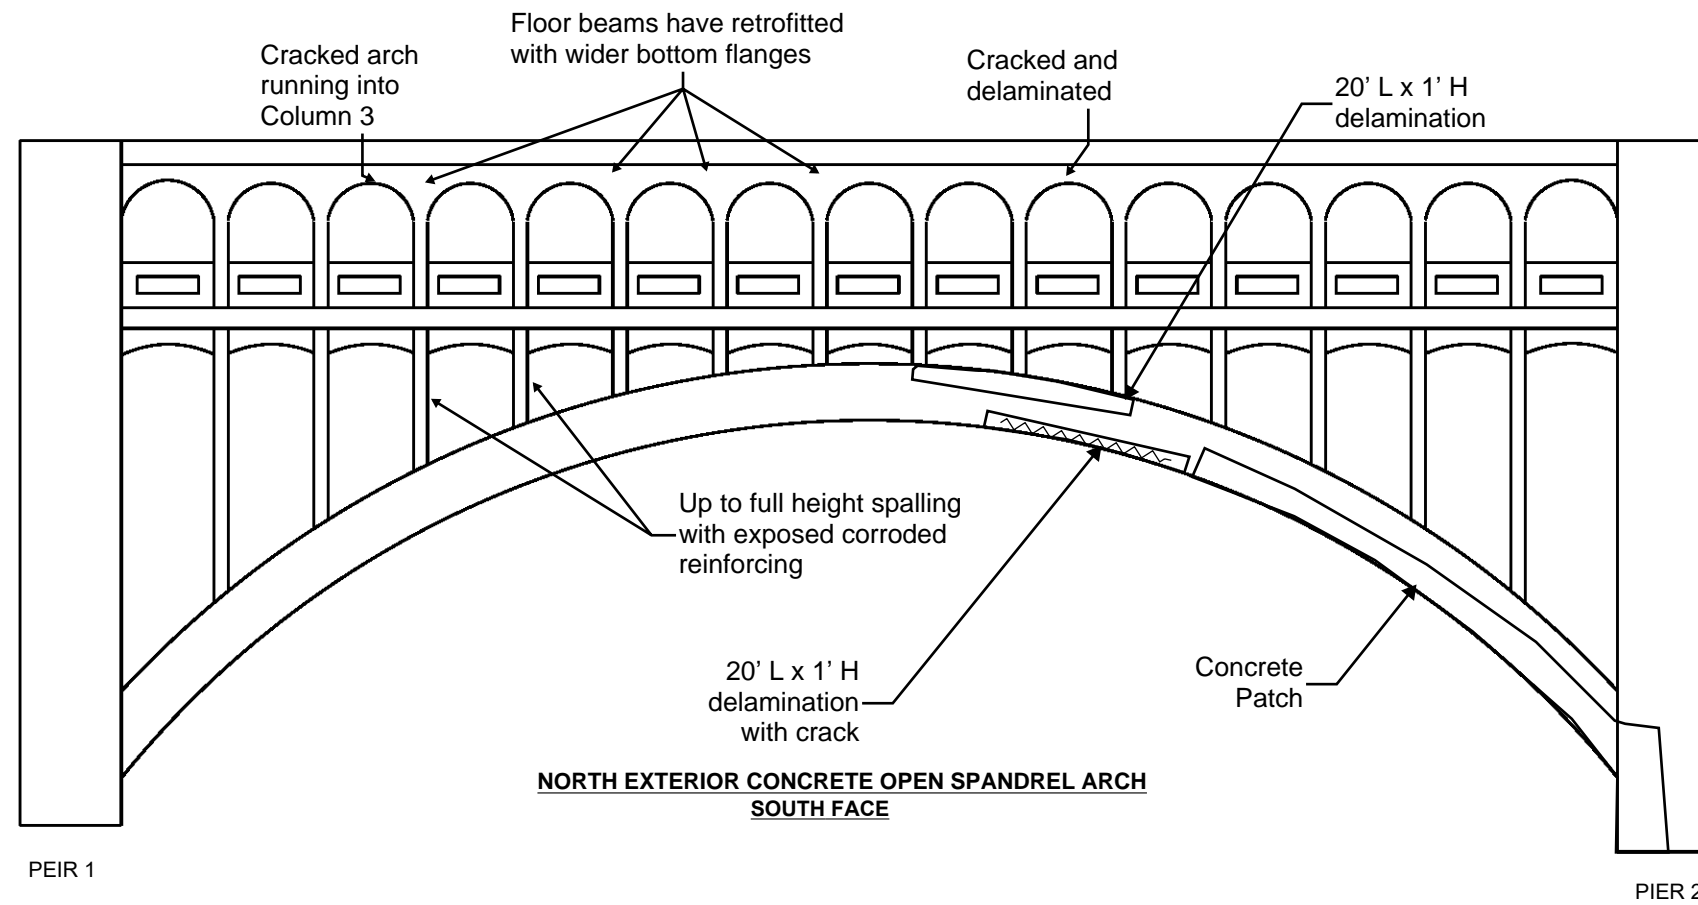

PIER 1

PIER 2

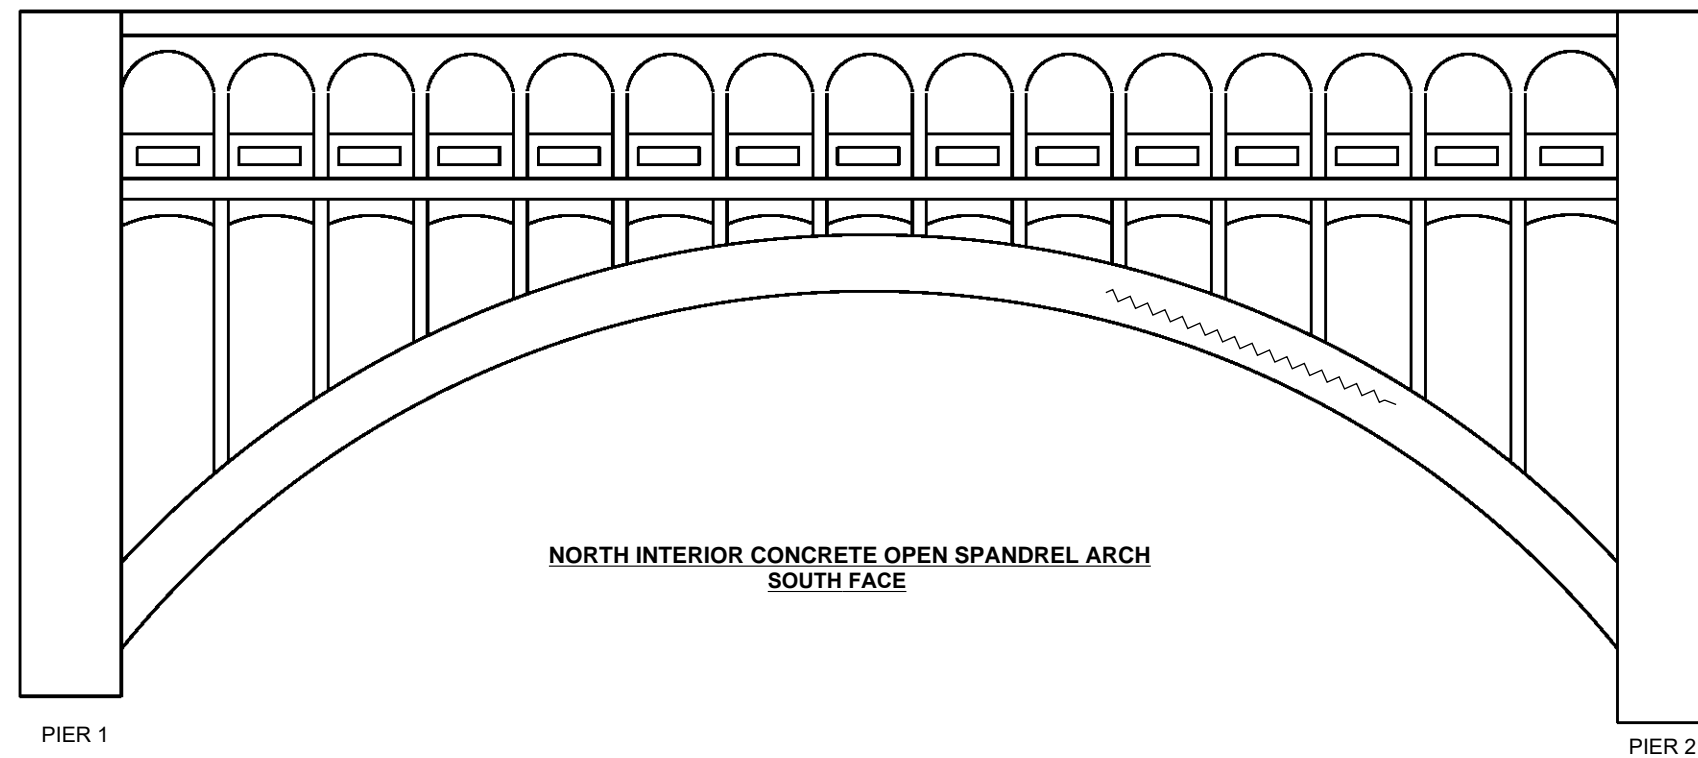



PIER 1

PIER 2

General Notes:

- Arches typically exhibit cracking, spalls, and marked up delaminations throughout.



| | | | | |
|--------------------------------|-----------|--|--|---|
| GRAPHIC SCALE MEASURED IN FEET | DATE |  9902 Carver Road
Suite 201
Cincinnati, OH 45242
PH.: 614.699.5000 | DETROIT-SUPERIOR BRIDGE OVER CUYAHOGA RIVER
BRIDGE NO. CUY-6-1465 | |
| NOT TO SCALE | NOV, 2018 | | | STRUCTURE ELEVATION - SPAN 2 <table border="1" style="float: right; margin-left: 10px;"> <tr> <td>PAGE</td> </tr> <tr> <td>A-44</td> </tr> </table> |
| PAGE | | | | |
| A-44 | | | | |

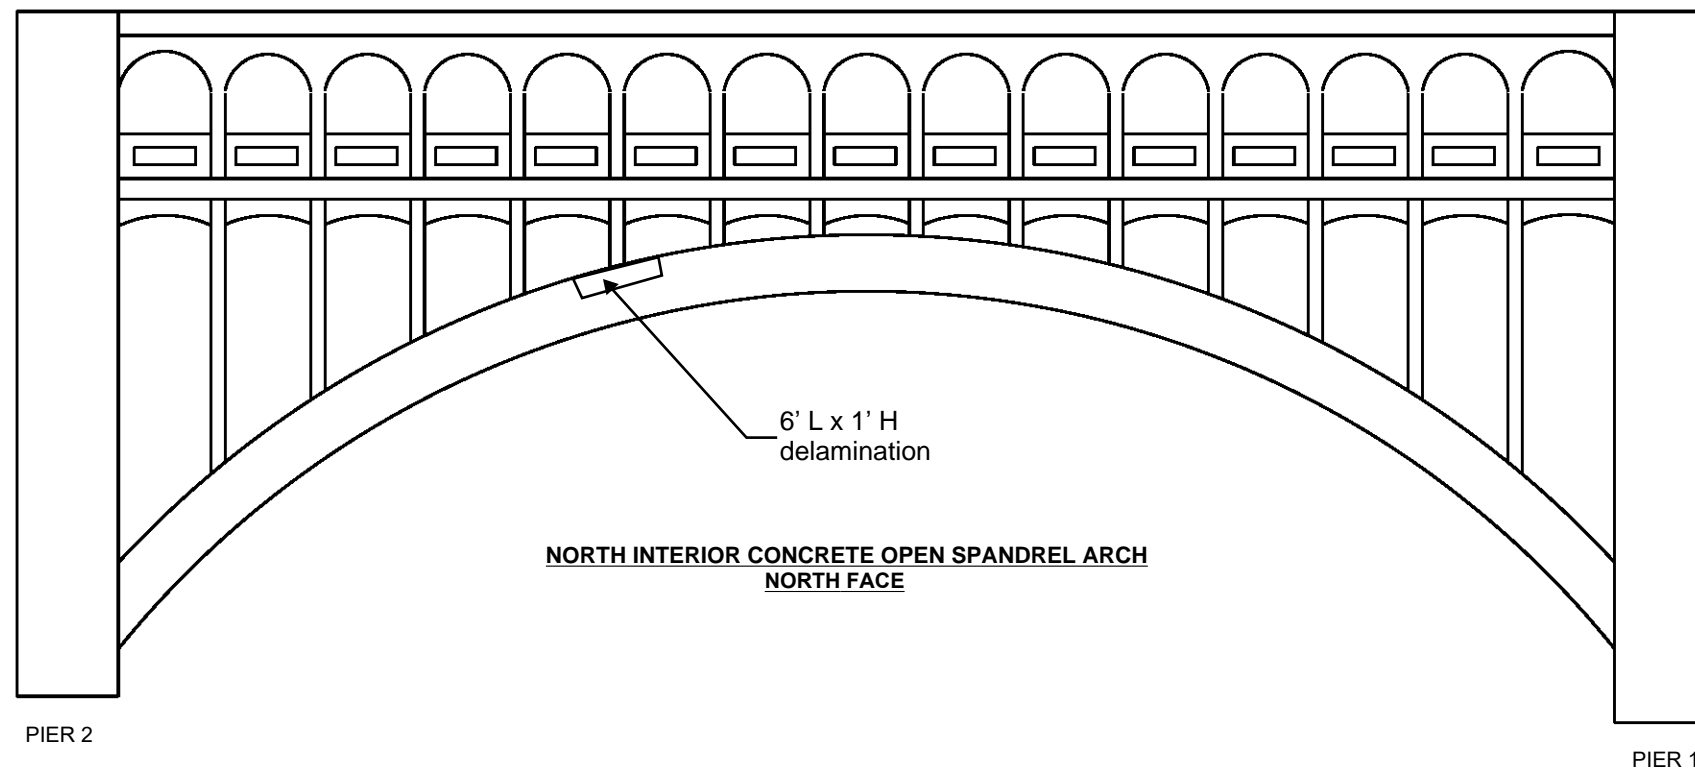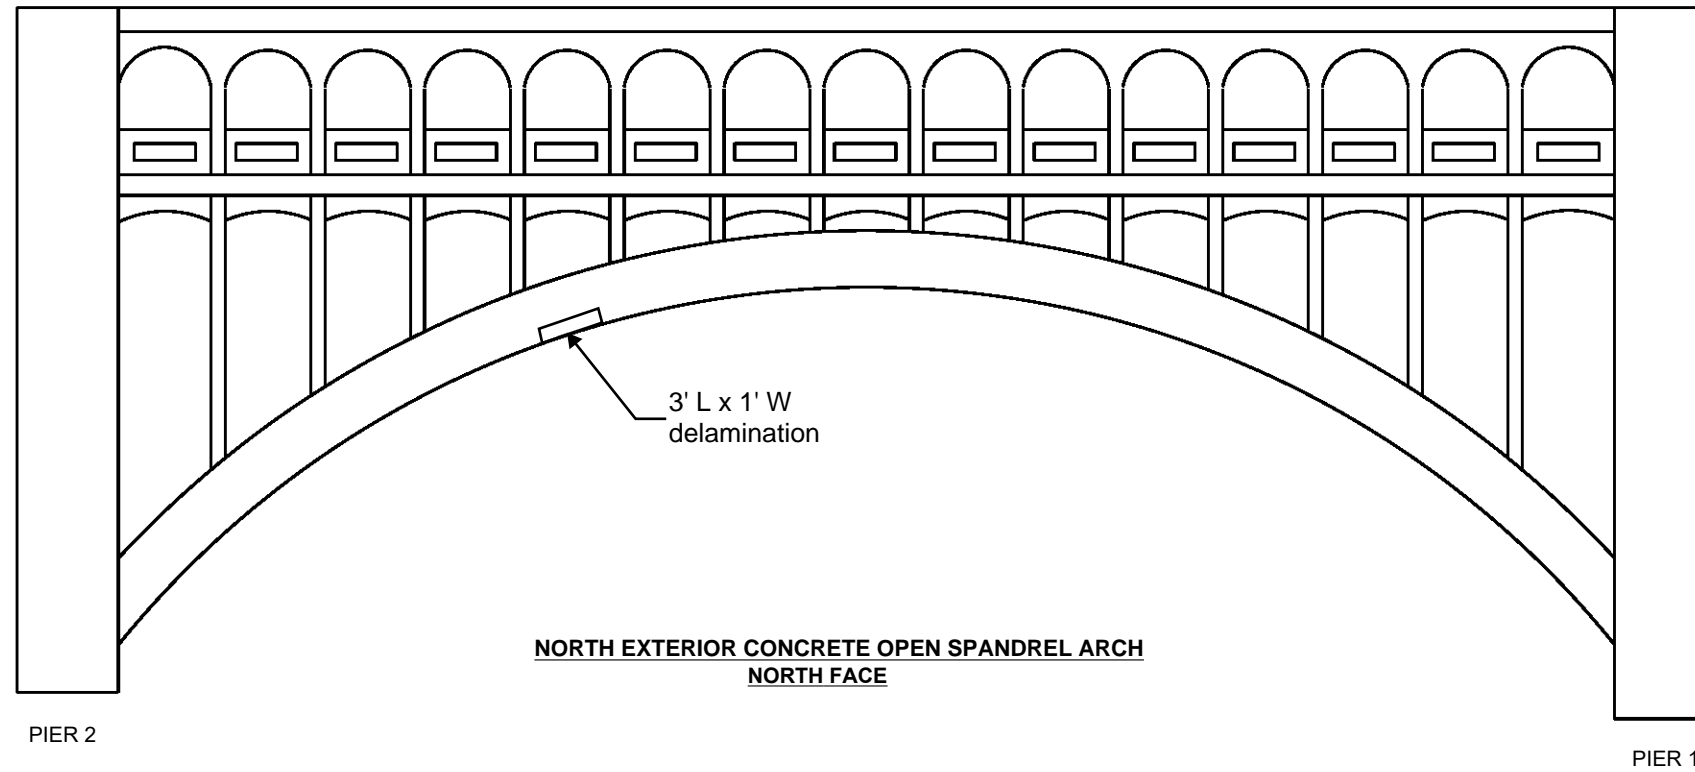

General Notes:

- Arches typically exhibit cracking, spalls, and marked up delaminations throughout.



| | | | | |
|--------------------------------|-----------|--|--|------------------------------|
| GRAPHIC SCALE MEASURED IN FEET | DATE |  9902 Carver Road
Suite 201
Cincinnati, OH 45242
PH.: 614.699.5000 | DETROIT-SUPERIOR BRIDGE OVER CUYAHOGA RIVER
BRIDGE NO. CUY-6-1465 | |
| NOT TO SCALE | NOV, 2018 | | INFRASTRUCTURE ENGINEERS, INC. | STRUCTURE ELEVATION - SPAN 2 |

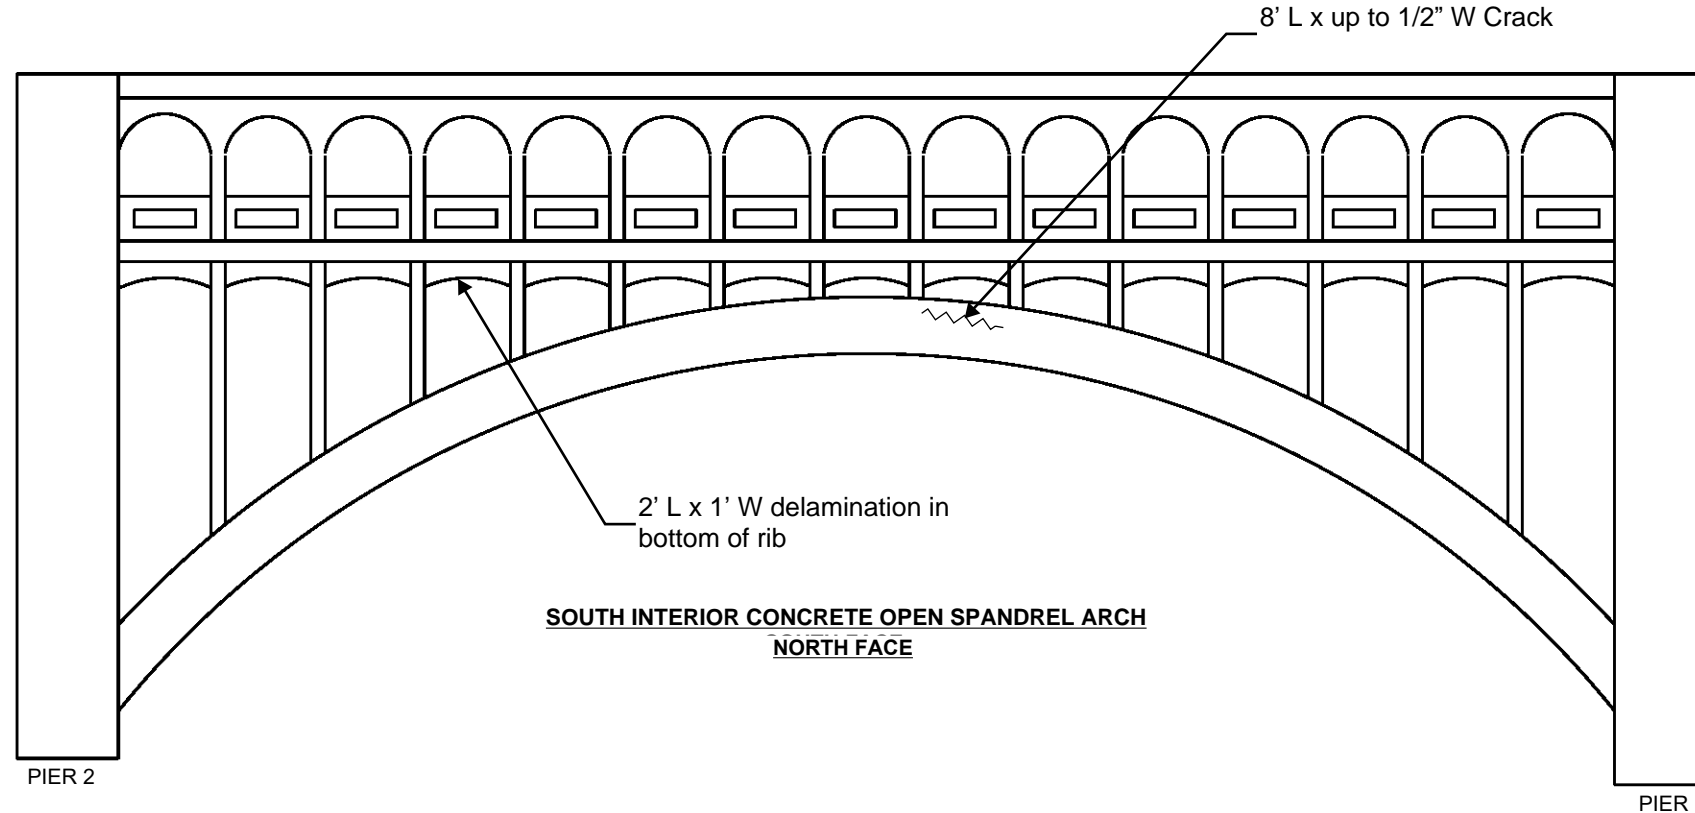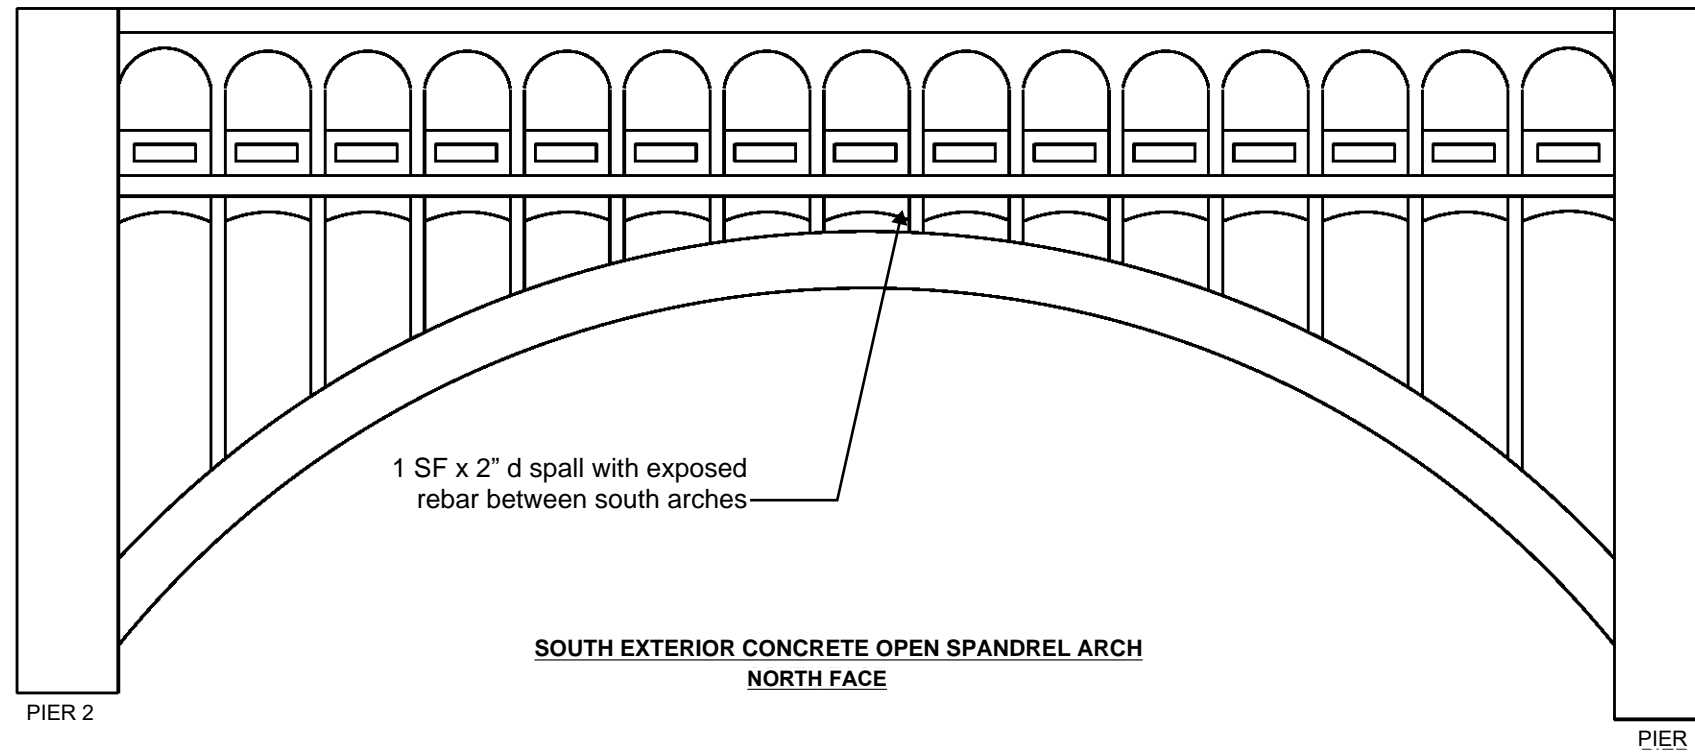

General Notes:

- Arches typically exhibit cracking, spalls, and marked up delaminations throughout.


| | | | | |
|--------------------------------|-----------|--|--|------------------------------|
| GRAPHIC SCALE MEASURED IN FEET | DATE |  9902 Carver Road
Suite 201
Cincinnati, OH 45242
PH.: 614.699.5000 | DETROIT-SUPERIOR BRIDGE OVER CUYAHOGA RIVER
BRIDGE NO. CUY-6-1465 | |
| NOT TO SCALE | NOV, 2018 | | INFRASTRUCTURE
ENGINEERS, INC. | STRUCTURE ELEVATION - SPAN 2 |

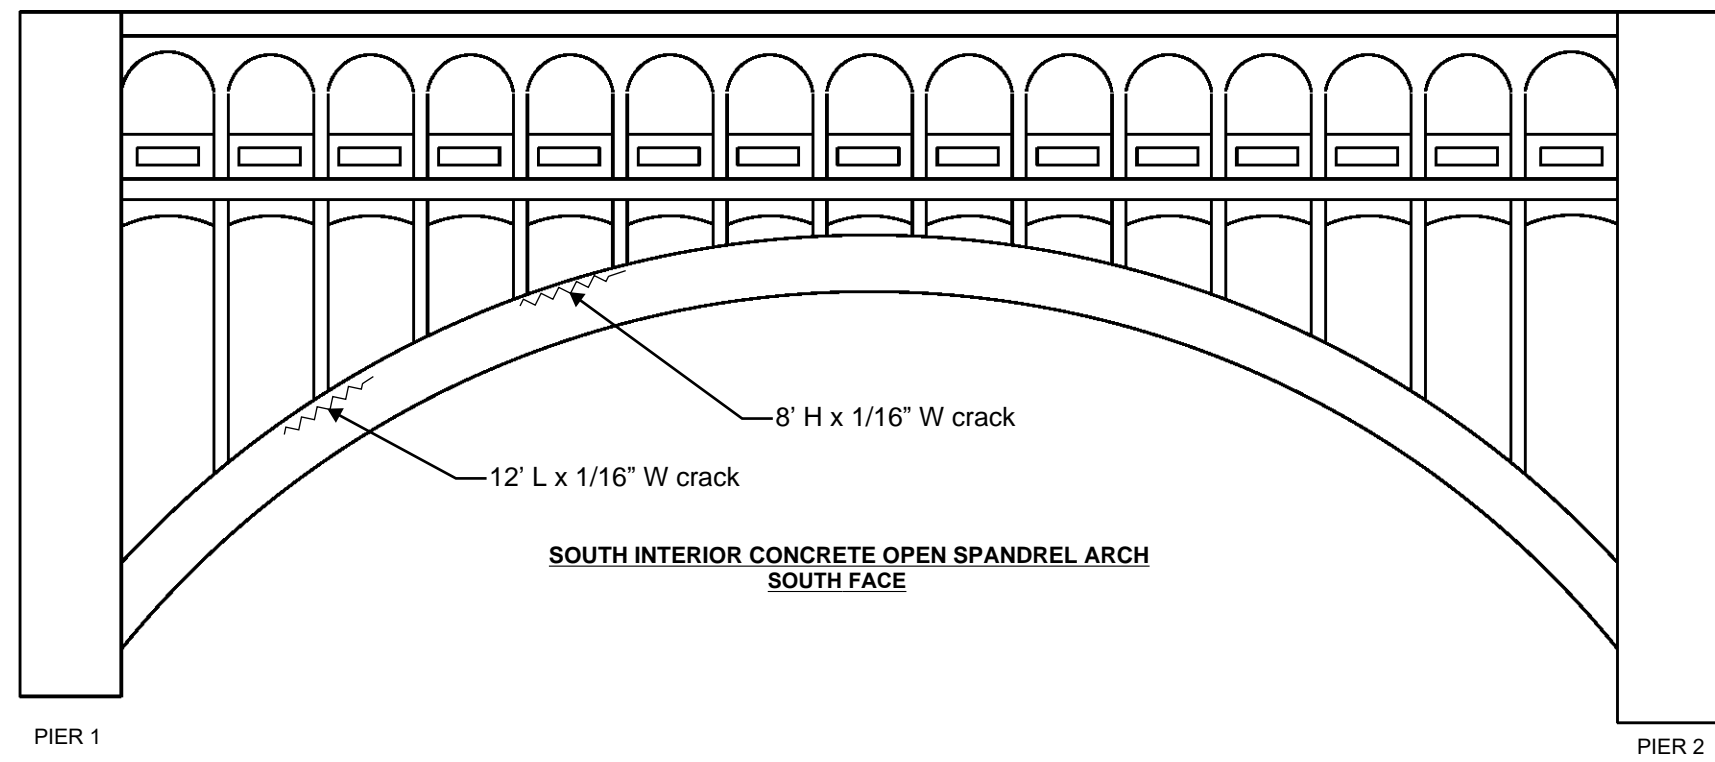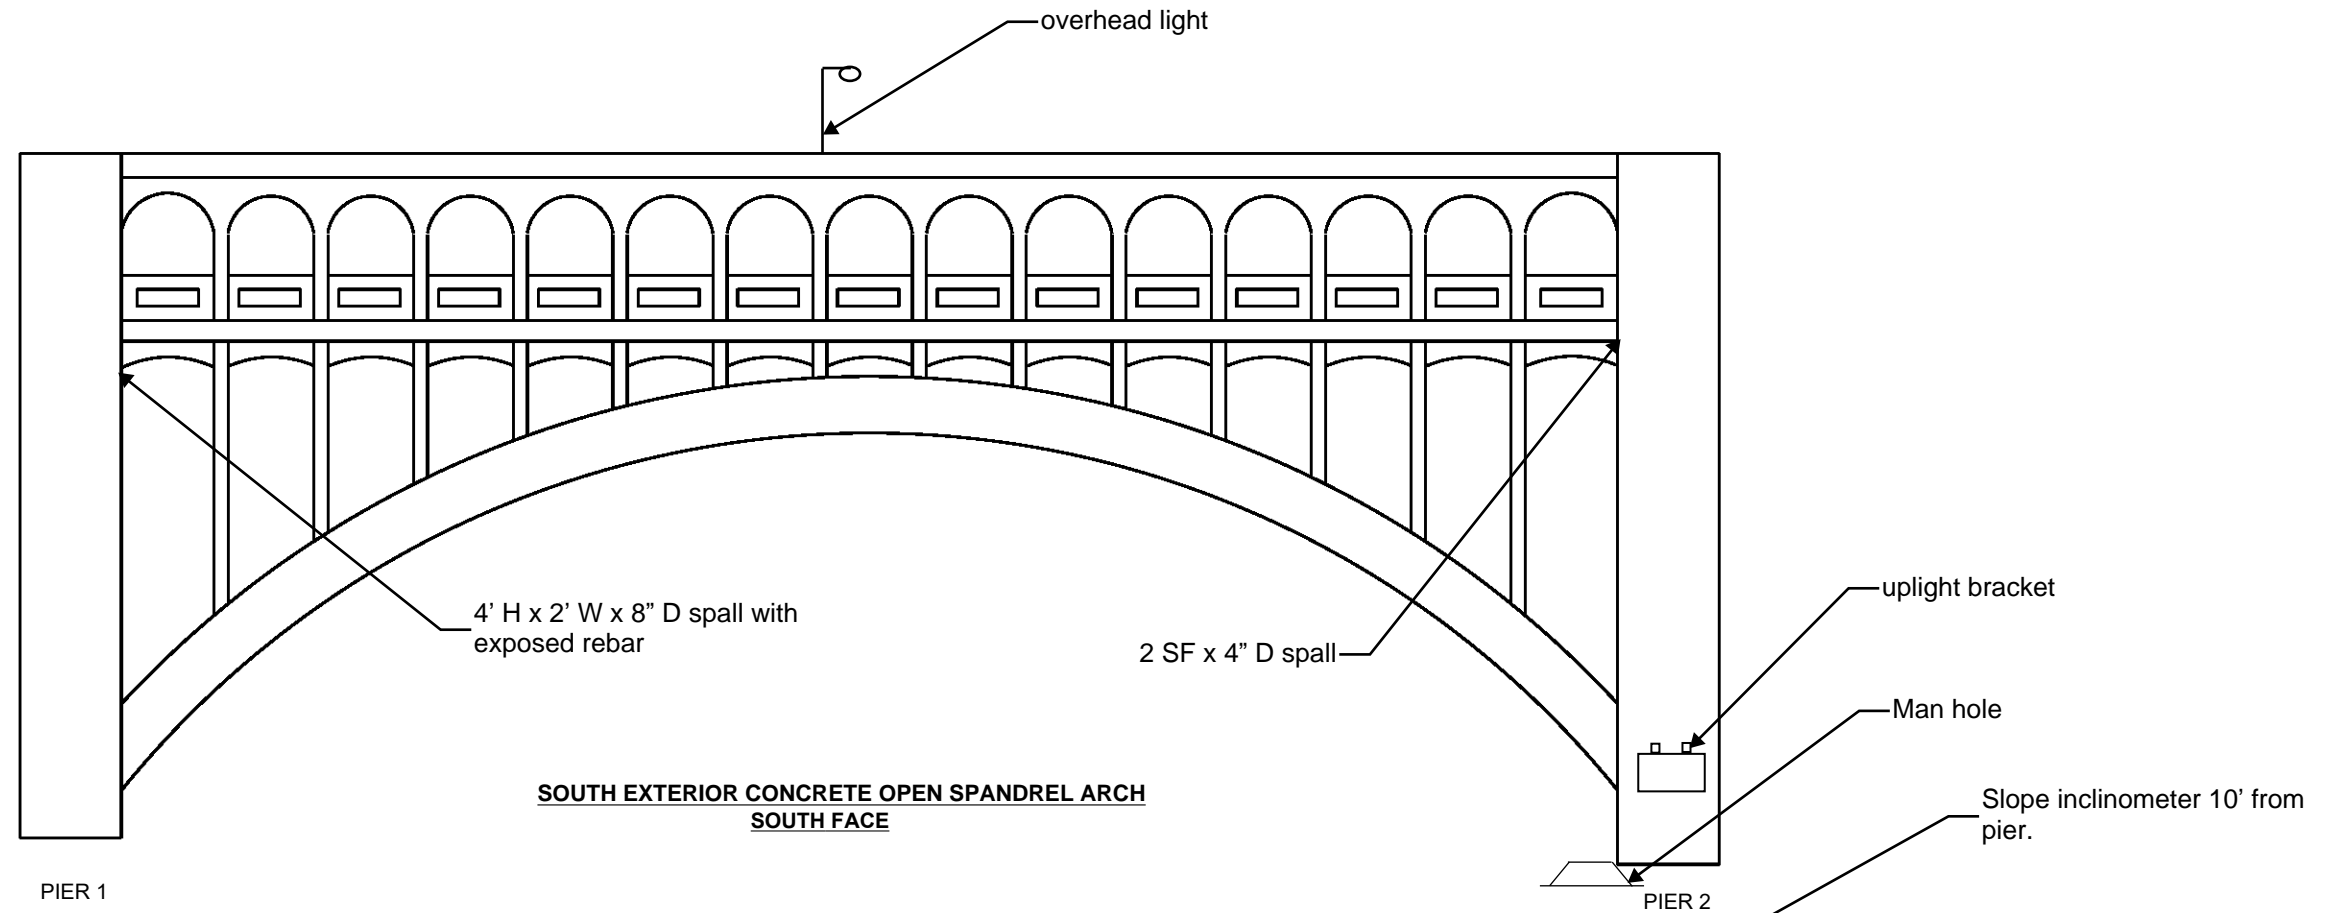


General Notes:

- Arches typically exhibit cracking, spalls, and marked up delaminations throughout.

| | | | | |
|--------------------------------|------|--|--|-----------|
| GRAPHIC SCALE MEASURED IN FEET | DATE |  9902 Carver Road
Suite 201
Cincinnati, OH 45242
PH.: 614.699.5000 | DETROIT-SUPERIOR BRIDGE OVER CUYAHOGA RIVER
BRIDGE NO. CUY-6-1465 | |
| | | | NOT TO SCALE | NOV, 2018 |
| | | | PAGE | A-47 |

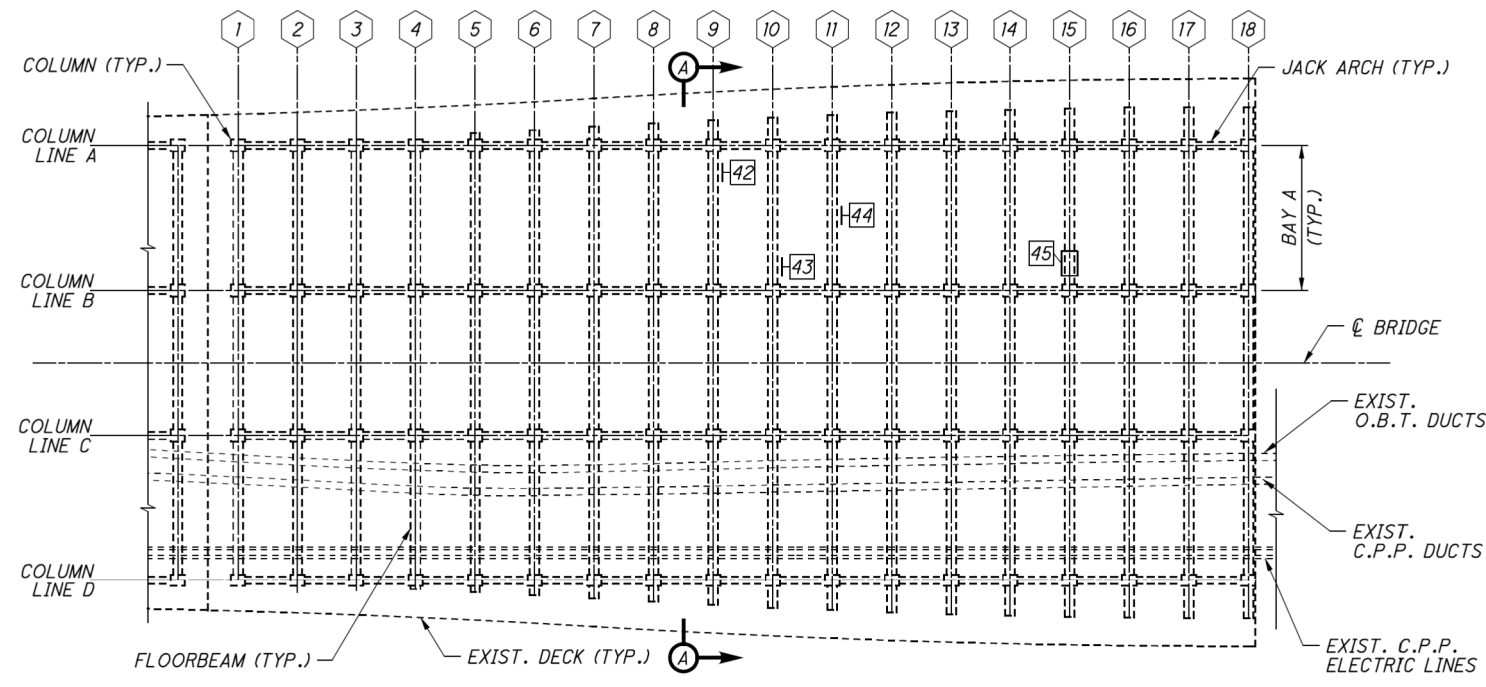

SPAN 3 - UPPER DECK PLAN

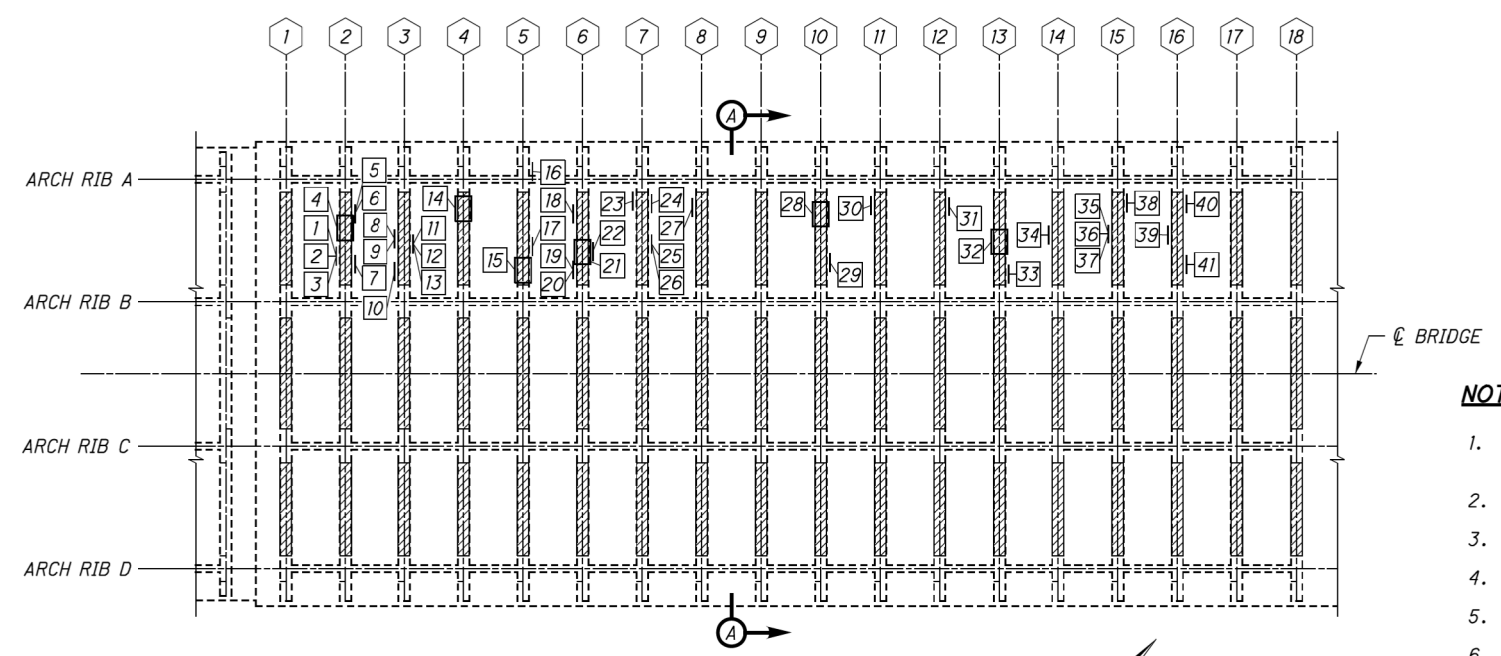

SPAN 3 - LOWER DECK PLAN

| ESTIMATED PATCHING QUANTITIES | | | |
|-------------------------------|-------------|-----------|------------------|
| REPAIR NO. | REPAIR TYPE | AREA (SF) | ANODE QUANTITY** |
| 1 | TYPE 1 | 7 | 2 |
| 2 | TYPE 1 | 2 | 1 |
| 3 | TYPE 1 | 5 | 2 |
| 4 | TYPE 2 | 13 | 5 |
| 5 | TYPE 1 | 2 | 1 |
| 6 | TYPE 1 | 2 | 1 |
| 7 | TYPE 1 | 2 | 1 |
| 8 | TYPE 1 | 3 | 1 |
| 9 | TYPE 1 | 3 | 1 |
| 10 | TYPE 1 | 3 | 1 |
| 11 | TYPE 1 | 2 | 1 |
| 12 | TYPE 1 | 2 | 1 |
| 13 | TYPE 1 | 3 | 1 |
| 14 | TYPE 2 | 7 | 3 |
| 15 | TYPE 2 | 4 | 2 |
| 16 | TYPE 1 | 10 | 2 |
| 17 | TYPE 1 | 1 | 1 |
| 18 | TYPE 1 | 3 | 1 |
| 19 | TYPE 1 | 2 | 1 |
| 20 | TYPE 1 | 2 | 1 |

| ESTIMATED PATCHING QUANTITIES | | | |
|-------------------------------|-------------|-----------|------------------|
| REPAIR NO. | REPAIR TYPE | AREA (SF) | ANODE QUANTITY** |
| 21 | TYPE 2 | 9 | 7 |
| 22 | TYPE 1 | 5 | 4 |
| 23 | TYPE 1 | 2 | 1 |
| 24 | TYPE 1 | 3 | 2 |
| 25 | TYPE 1 | 2 | 1 |
| 26 | TYPE 1 | 3 | 1 |
| 27 | TYPE 1 | 1 | 1 |
| 28 | TYPE 2 | 4 | 1 |
| 29 | TYPE 1 | 2 | 1 |
| 30 | TYPE 1 | 3 | 1 |
| 31 | TYPE 1 | 3 | 1 |
| 32 | TYPE 2 | 7 | 3 |
| 33 | TYPE 1 | 2 | 1 |
| 34 | TYPE 1 | 6 | 2 |
| 35 | TYPE 1 | 5 | 2 |
| 36 | TYPE 1 | 3 | 1 |
| 37 | TYPE 1 | 2 | 1 |
| 38 | TYPE 1 | 1 | 1 |
| 39 | TYPE 1 | 6 | 1 |
| 40 | TYPE 1 | 2 | 1 |
| 41 | TYPE 1 | 8 | 2 |
| 42 | TYPE 1 | 4 | 2 |
| 43 | TYPE 1 | 9 | 2 |
| 44 | TYPE 1 | 5 | 3 |
| 45 | TYPE 2 | 1 | 1 |
| MEASURED QUANTITY* | | 176 | - |
| PLAN QUANTITY* | | 264 | 74 |

* SEE NOTES 1 & 2
** SEE NOTE 3


| SHEET QUANTITY SUMMARY | | |
|------------------------|------|----------|
| ITEM | UNIT | QUANTITY |
| TYPE 1 REPAIR | SF | 197 |
| TYPE 2 REPAIR | SF | 67 |
| FRP WRAP | SF | 4635 |


NOTES:

- MEASURED QUANTITIES ARE BASED ON THE INSPECTION PERFORMED IN JANUARY 2017. THE EXACT DIMENSIONS AND LOCATIONS OF PATCHES SHALL BE DETERMINED BY THE ENGINEER IN THE FIELD FOR FINAL PAY QUANTITY.
- PLAN QUANTITIES INCLUDE 50% CONTINGENCY ADDED TO MEASURED QUANTITIES.
- ANODES ARE INCLUDED FOR PAYMENT WITH ITEM SPECIAL - PATCHING CONCRETE STRUCTURE, TYPE 1 OR TYPE 2 REPAIR.
- FOR DETAILS AND MAXIMUM GRID SPACING FOR EMBEDDED GALVANIC ANODES, SEE SHEET [84/89].
- FOR SECTION A-A, SEE SHEET [34/89].
- FOR FRP WRAP DETAILS, SEE SHEET [85/89].


LEGEND:

- # FLOORBEAM LINE NUMBER
- # REPAIR NO. OF DEFICIENT CONCRETE TO BE REPAIRED IN ACCORDANCE WITH ITEM SPECIAL - PATCHING CONCRETE STRUCTURE, TYPE 1 OR TYPE 2 REPAIR.
- ▨ AREA TO BE TREATED WITH FRP WRAP PER ITEM SPECIAL - COMPOSITE FIBER WRAP SYSTEM

| | | | |
|--------------------------------|-----------|---|--|
| GRAPHIC SCALE MEASURED IN FEET | DATE | 
9902 Carver Road
Suite 201
Cincinnati, OH 45242
PH.: 614.699.5000 | DETROIT-SUPERIOR BRIDGE OVER CUYAHOGA RIVER
BRIDGE NO. CUY-6-1465 |
| NOT TO SCALE | NOV, 2018 | INFRASTRUCTURE ENGINEERS, INC. | SPAN 3 CONCRETE REPAIR DETAILS |
| | | | PAGE A-48 |

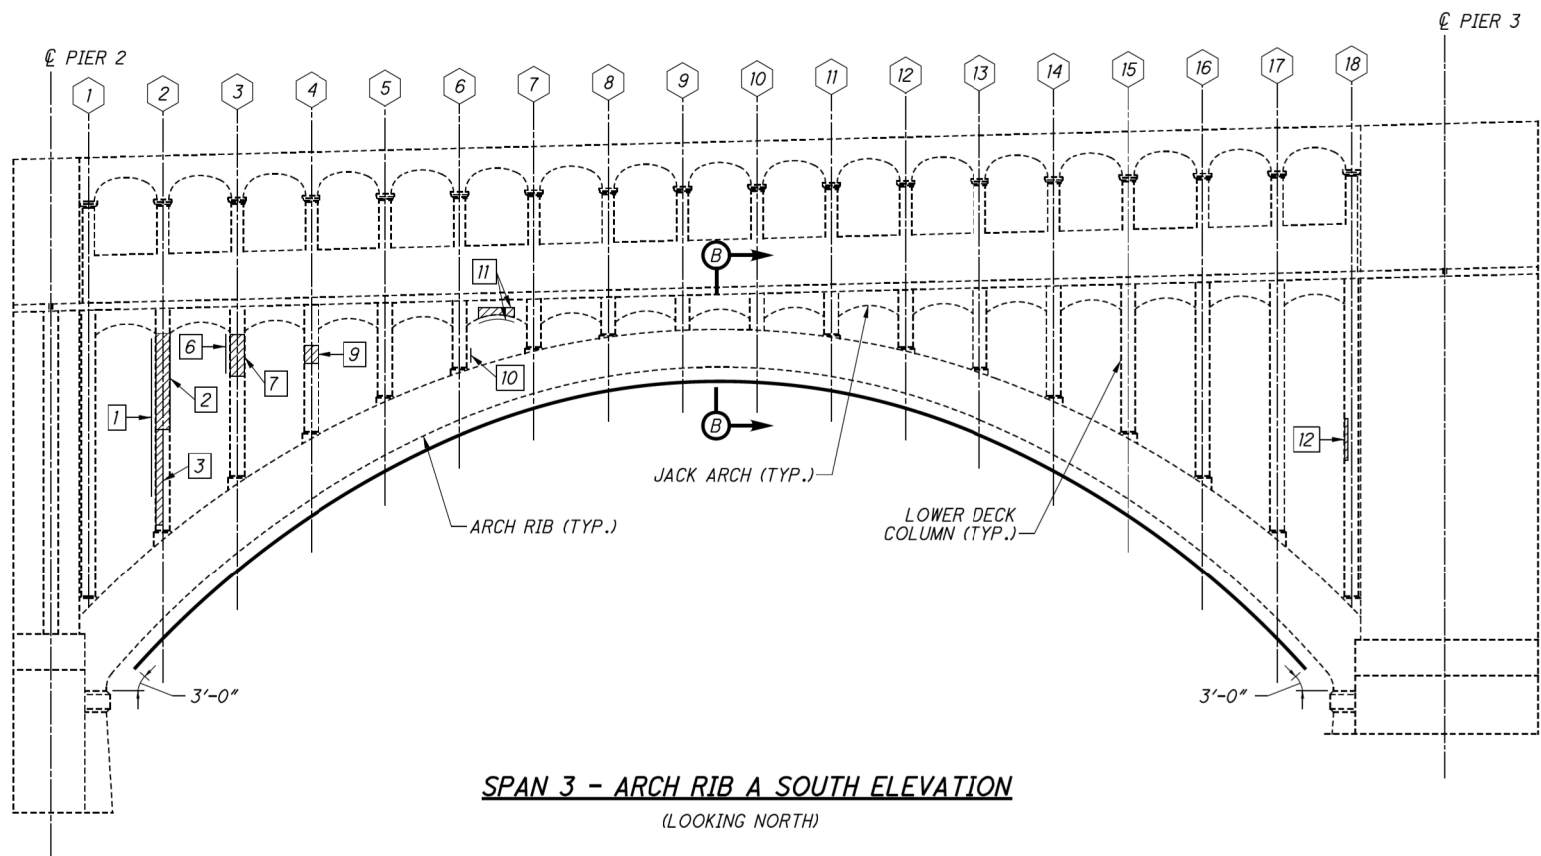

SPAN 3 - ARCH RIB A SOUTH ELEVATION
(LOOKING NORTH)

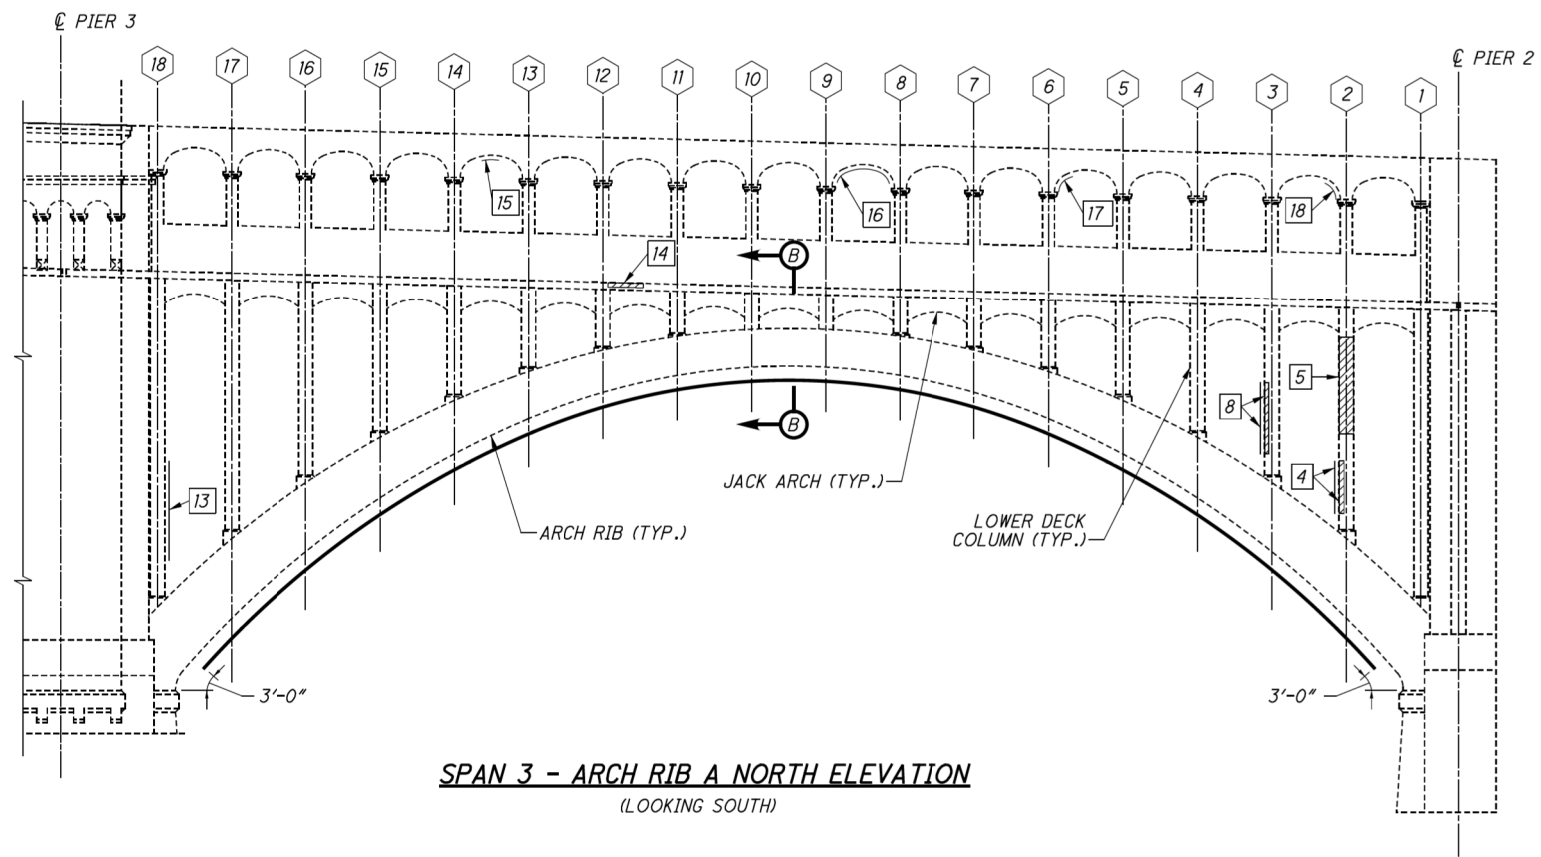

SPAN 3 - ARCH RIB A NORTH ELEVATION
(LOOKING SOUTH)

ESTIMATED PATCHING QUANTITIES

| REPAIR NO. | REPAIR TYPE | AREA (SF) | ANODE QUANTITY** |
|--------------------|-------------|-----------|------------------|
| 1 | TYPE 1 | 96 | 22 |
| 2 | TYPE 1 | 27 | 7 |
| 3 | TYPE 1 | 14 | 7 |
| 4 | TYPE 1 | 10 | 4 |
| 5 | TYPE 1 | 27 | 7 |
| 6 | TYPE 1 | 19 | 6 |
| 7 | TYPE 1 | 12 | 3 |
| 8 | TYPE 1 | 10 | 5 |
| 9 | TYPE 1 | 5 | 1 |
| 10 | TYPE 1 | 2 | 1 |
| 11 | TYPE 1 | 8 | 4 |
| 12 | TYPE 1 | 5 | 2 |
| 13 | TYPE 1 | 7 | 3 |
| 14 | TYPE 1 | 2 | 3 |
| 15 | TYPE 2 | 2 | 1 |
| 16 | TYPE 2 | 13 | 7 |
| 17 | TYPE 2 | 4 | 2 |
| 18 | TYPE 2 | 1 | 1 |
| MEASURED QUANTITY* | | 264 | - |
| PLAN QUANTITY* | | 396 | 86 |

* SEE NOTES 1 & 2
** SEE NOTES 3 & 4

SHEET QUANTITY SUMMARY

| ITEM | UNIT | QUANTITY |
|---------------|------|----------|
| TYPE 1 REPAIR | SF | 366 |
| TYPE 2 REPAIR | SF | 30 |
| FRP WRAP | SF | 2300 |

NOTES:

- MEASURED QUANTITIES ARE BASED ON THE INSPECTION PERFORMED IN JANUARY 2017. THE EXACT DIMENSIONS AND LOCATIONS OF PATCHES SHALL BE DETERMINED BY THE ENGINEER IN THE FIELD FOR FINAL PAY QUANTITY.
- PLAN QUANTITIES INCLUDE 50% CONTINGENCY ADDED TO MEASURED QUANTITIES.
- ANODES ARE INCLUDED FOR PAYMENT WITH ITEM SPECIAL - PATCHING CONCRETE STRUCTURE, TYPE 1 OR TYPE 2 REPAIR.
- GALVANIC ANODES WILL NOT BE USED FOR PATCHING THE UNREINFORCED VERTICAL SIDES OF THE CONCRETE ARCH RIBS.
- FOR DETAILS AND MAXIMUM GRID SPACING FOR EMBEDDED GALVANIC ANODES, SEE SHEET [84/89].
- FOR PIER 3 REPAIR DETAILS, SEE SHEET [26/89].
- FOR FRP WRAP DETAILS AND SECTION B-B, SEE SHEET [85/89].

LEGEND:

- # SPANDREL COLUMN NUMBER
- # REPAIR NUMBER
- ▨ LOCATION OF DEFICIENT CONCRETE TO BE REPAIRED IN ACCORDANCE WITH ITEM SPECIAL - PATCHING CONCRETE STRUCTURE, TYPE 1 REPAIR.
- || LOCATION OF DEFICIENT CONCRETE ON PERPENDICULAR FACE (NOT VISIBLE IN ELEVATION VIEW) TO BE REPAIRED IN ACCORDANCE WITH ITEM SPECIAL - PATCHING CONCRETE STRUCTURE, TYPE 1 OR TYPE 2 REPAIR
- AREA TO BE TREATED WITH FRP WRAP PER ITEM SPECIAL - COMPOSITE FIBER WRAP SYSTEM

GRAPHIC SCALE MEASURED IN FEET

NOT TO SCALE

DATE

NOV, 2018




9902 Carver Road
Suite 201
Cincinnati, OH 45242
PH.: 614.699.5000

INFRASTRUCTURE
ENGINEERS, INC.


DETROIT-SUPERIOR BRIDGE OVER CUYAHOGA RIVER
BRIDGE NO. CUY-6-1465

SPAN 3 CONCRETE REPAIR DETAILS

PAGE
A-49

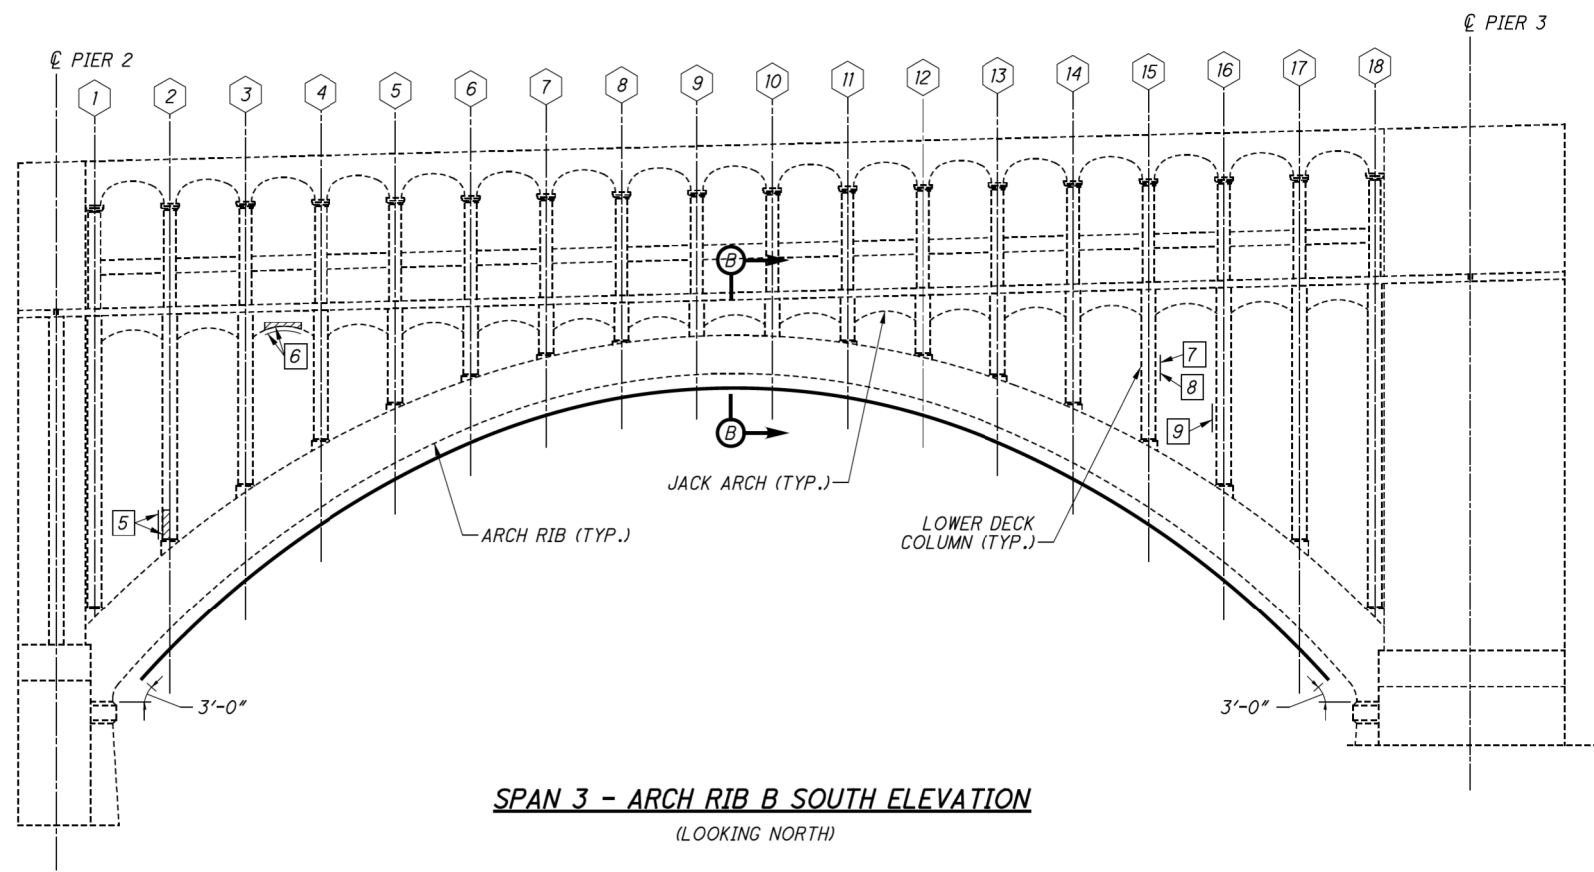

SPAN 3 - ARCH RIB B SOUTH ELEVATION
(LOOKING NORTH)

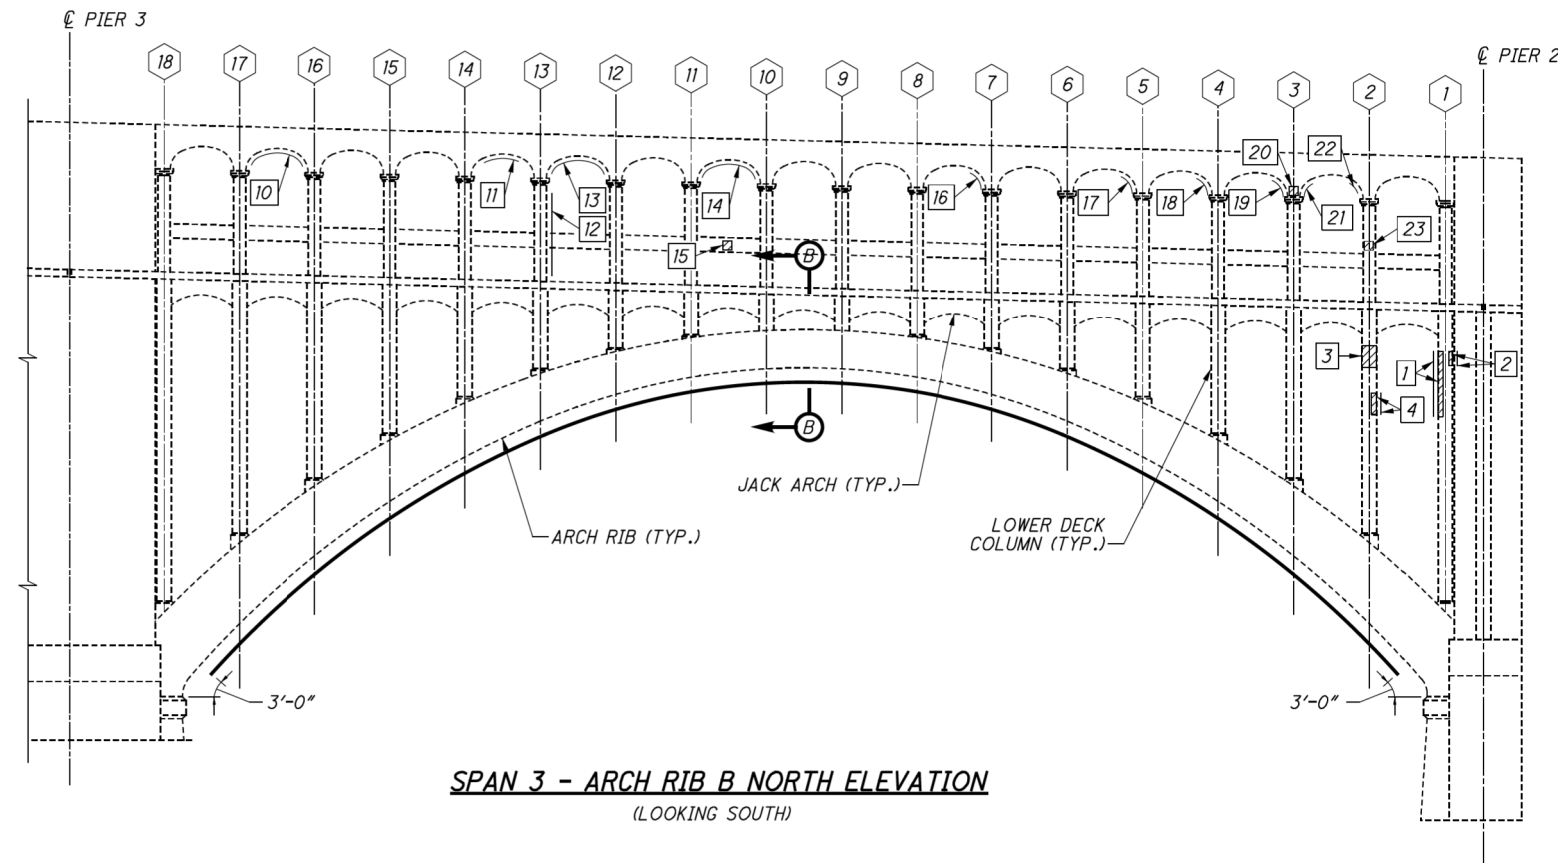

SPAN 3 - ARCH RIB B NORTH ELEVATION
(LOOKING SOUTH)

| ESTIMATED PATCHING QUANTITIES | | | |
|-------------------------------|-------------|-----------|------------------|
| REPAIR NO. | REPAIR TYPE | AREA (SF) | ANODE QUANTITY** |
| 1 | TYPE 1 | 13 | 5 |
| 2 | TYPE 1 | 4 | 2 |
| 3 | TYPE 1 | 2 | 1 |
| 4 | TYPE 1 | 4 | 2 |
| 5 | TYPE 1 | 8 | 2 |
| 6 | TYPE 2 | 15 | 10 |
| 7 | TYPE 1 | 2 | 1 |
| 8 | TYPE 1 | 2 | 1 |
| 9 | TYPE 1 | 3 | 1 |
| 10 | TYPE 2 | 13 | 7 |

| ESTIMATED PATCHING QUANTITIES | | | |
|-------------------------------|-------------|-----------|------------------|
| REPAIR NO. | REPAIR TYPE | AREA (SF) | ANODE QUANTITY** |
| 11 | TYPE 2 | 9 | 5 |
| 12 | TYPE 1 | 14 | 7 |
| 13 | TYPE 2 | 13 | 7 |
| 14 | TYPE 2 | 13 | 7 |
| 15 | TYPE 1 | 1 | 1 |
| 16 | TYPE 2 | 1 | 1 |
| 17 | TYPE 2 | 1 | 1 |
| 18 | TYPE 2 | 1 | 1 |
| 19 | TYPE 2 | 6 | 4 |
| 20 | TYPE 1 | 1 | 1 |
| 21 | TYPE 2 | 6 | 4 |
| 22 | TYPE 2 | 1 | 1 |
| 23 | TYPE 1 | 1 | 1 |
| MEASURED QUANTITY* | | 134 | - |
| PLAN QUANTITY* | | 201 | 73 |

* SEE NOTES 1 & 2
** SEE NOTES 3 & 4

| SHEET QUANTITY SUMMARY | | |
|------------------------|------|----------|
| ITEM | UNIT | QUANTITY |
| TYPE 1 REPAIR | SF | 82 |
| TYPE 2 REPAIR | SF | 119 |
| FRP WRAP | SF | 2741 |


NOTES:

- MEASURED QUANTITIES ARE BASED ON THE INSPECTION PERFORMED IN JANUARY 2017. THE EXACT DIMENSIONS AND LOCATIONS OF PATCHES SHALL BE DETERMINED BY THE ENGINEER IN THE FIELD FOR FINAL PAY QUANTITY.
- PLAN QUANTITIES INCLUDE 50% CONTINGENCY ADDED TO MEASURED QUANTITIES.
- ANODES ARE INCLUDED FOR PAYMENT WITH ITEM SPECIAL - PATCHING CONCRETE STRUCTURE, TYPE 1 OR TYPE 2 REPAIR.
- GALVANIC ANODES WILL NOT BE USED FOR PATCHING THE UNREINFORCED VERTICAL SIDES OF THE CONCRETE ARCH RIBS.
- FOR DETAILS AND MAXIMUM GRID SPACING FOR EMBEDDED GALVANIC ANODES, SEE SHEET [84/89].
- FOR PIER 3 REPAIR DETAILS, SEE SHEET [26/89].
- FOR FRP WRAP DETAILS AND SECTION B-B, SEE SHEET [85/89].

LEGEND:


- # SPANDREL COLUMN NUMBER
- # REPAIR NUMBER
- ▨ LOCATION OF DEFICIENT CONCRETE TO BE REPAIRED IN ACCORDANCE WITH ITEM SPECIAL - PATCHING CONCRETE STRUCTURE, TYPE 1 REPAIR.
- || LOCATION OF DEFICIENT CONCRETE ON PERPENDICULAR FACE (NOT VISIBLE IN ELEVATION VIEW) TO BE REPAIRED IN ACCORDANCE WITH ITEM SPECIAL - PATCHING CONCRETE STRUCTURE, TYPE 1 OR TYPE 2 REPAIR
- AREA TO BE TREATED WITH FRP WRAP PER ITEM SPECIAL - COMPOSITE FIBER WRAP SYSTEM

| | | | | |
|--------------------------------|--------------|--|--|--------------------------------|
| GRAPHIC SCALE MEASURED IN FEET | DATE |  9902 Carver Road
Suite 201
Cincinnati, OH 45242
PH.: 614.699.5000 | DETROIT-SUPERIOR BRIDGE OVER CUYAHOGA RIVER
BRIDGE NO. CUY-6-1465 | |
| | NOT TO SCALE | | NOV, 2018 | INFRASTRUCTURE ENGINEERS, INC. |
| | | | | PAGE A-50 |

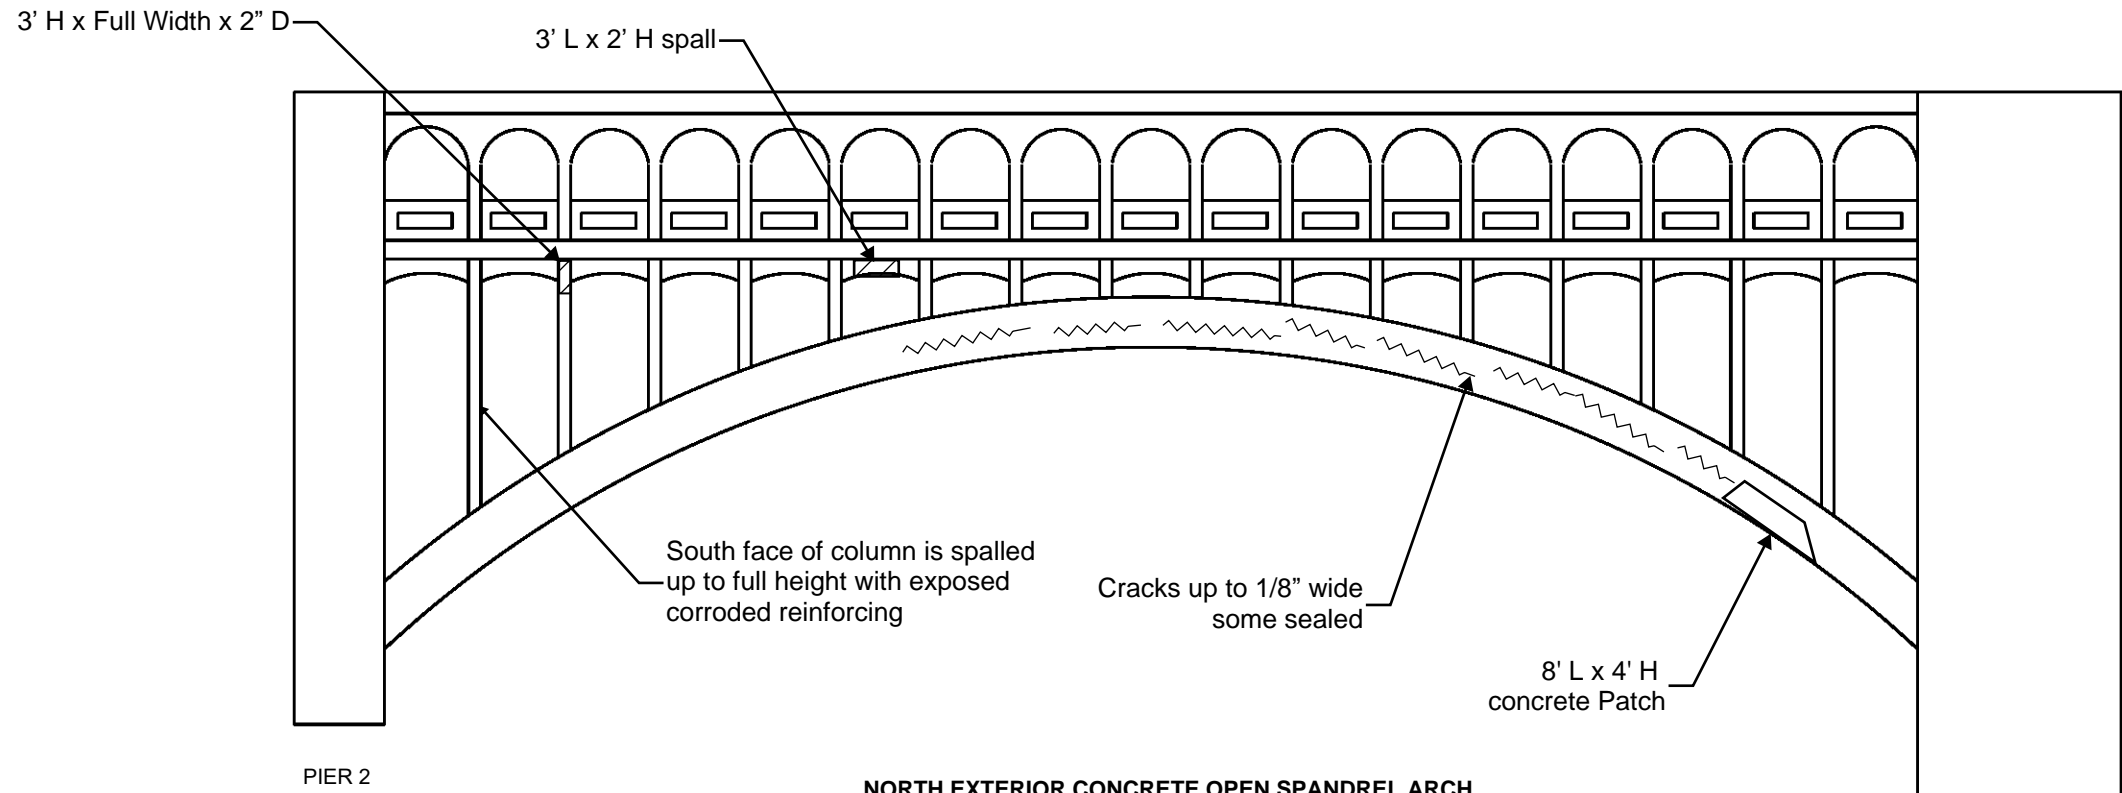

PIER 2

PIER 3

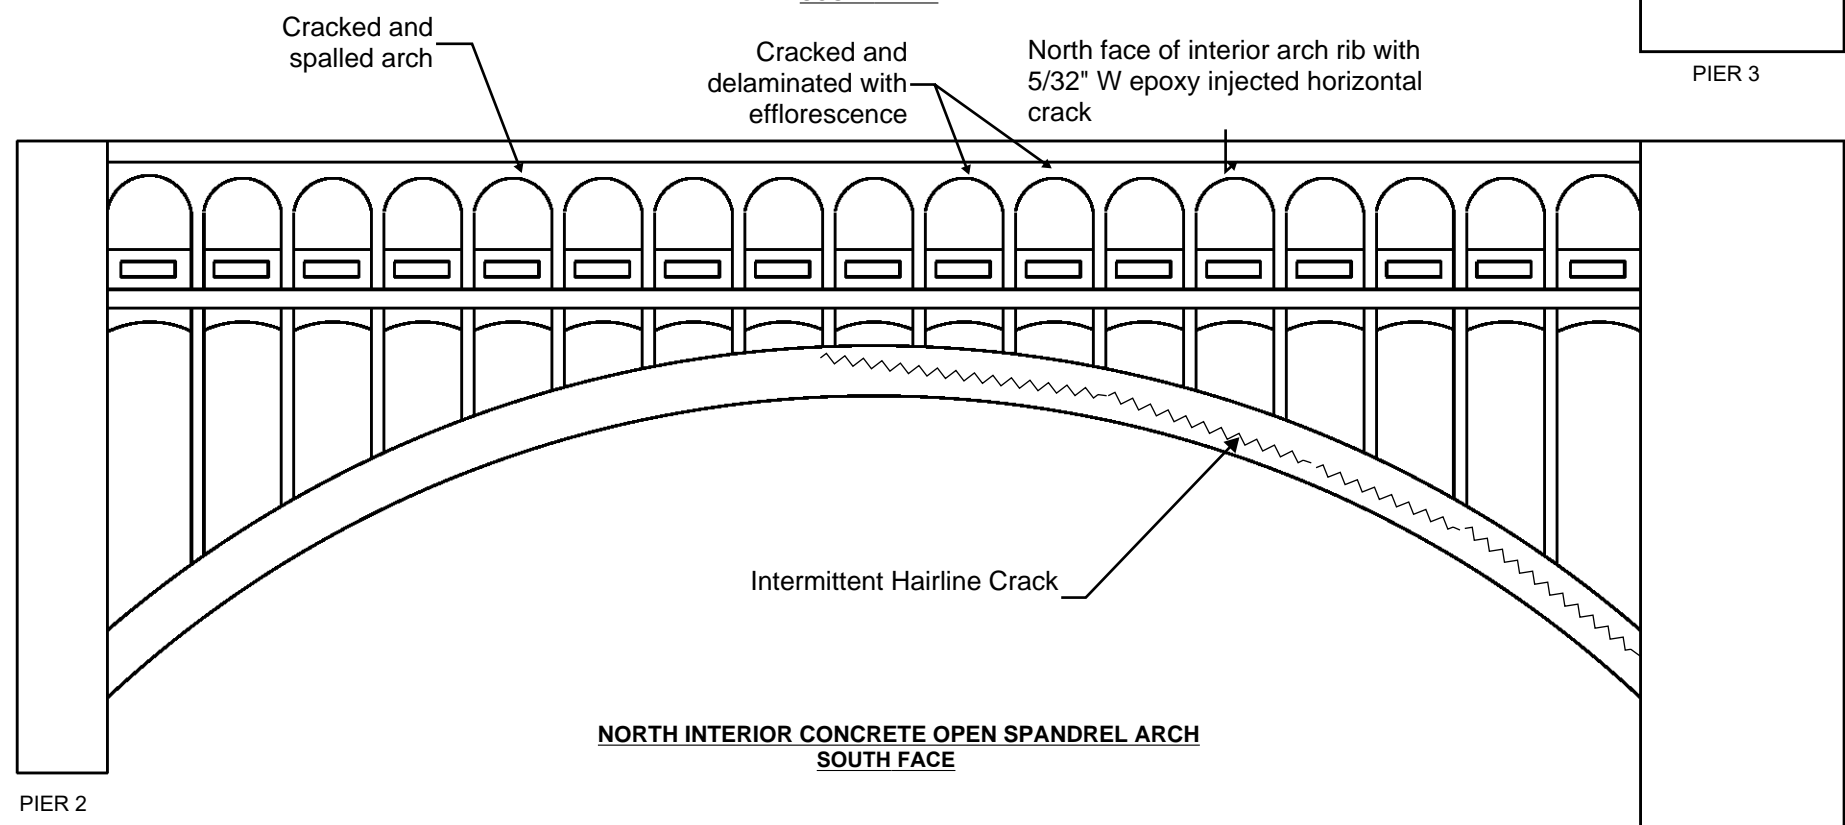


PIER 2

PIER 3


General Notes:
 - Arches typically exhibit cracking, spalls, and marked up delaminations throughout.

| | | | | |
|--------------------------------|------|--|--|-----------|
| GRAPHIC SCALE MEASURED IN FEET | DATE |  9902 Carver Road
Suite 201
Cincinnati, OH 45242
PH.: 614.699.5000 | DETROIT-SUPERIOR BRIDGE OVER CUYAHOGA RIVER
BRIDGE NO. CUY-6-1465 | |
| | | | NOT TO SCALE | NOV, 2018 |
| | | | PAGE | A-51 |

3' H x 1.5' W x 1.5" D spall

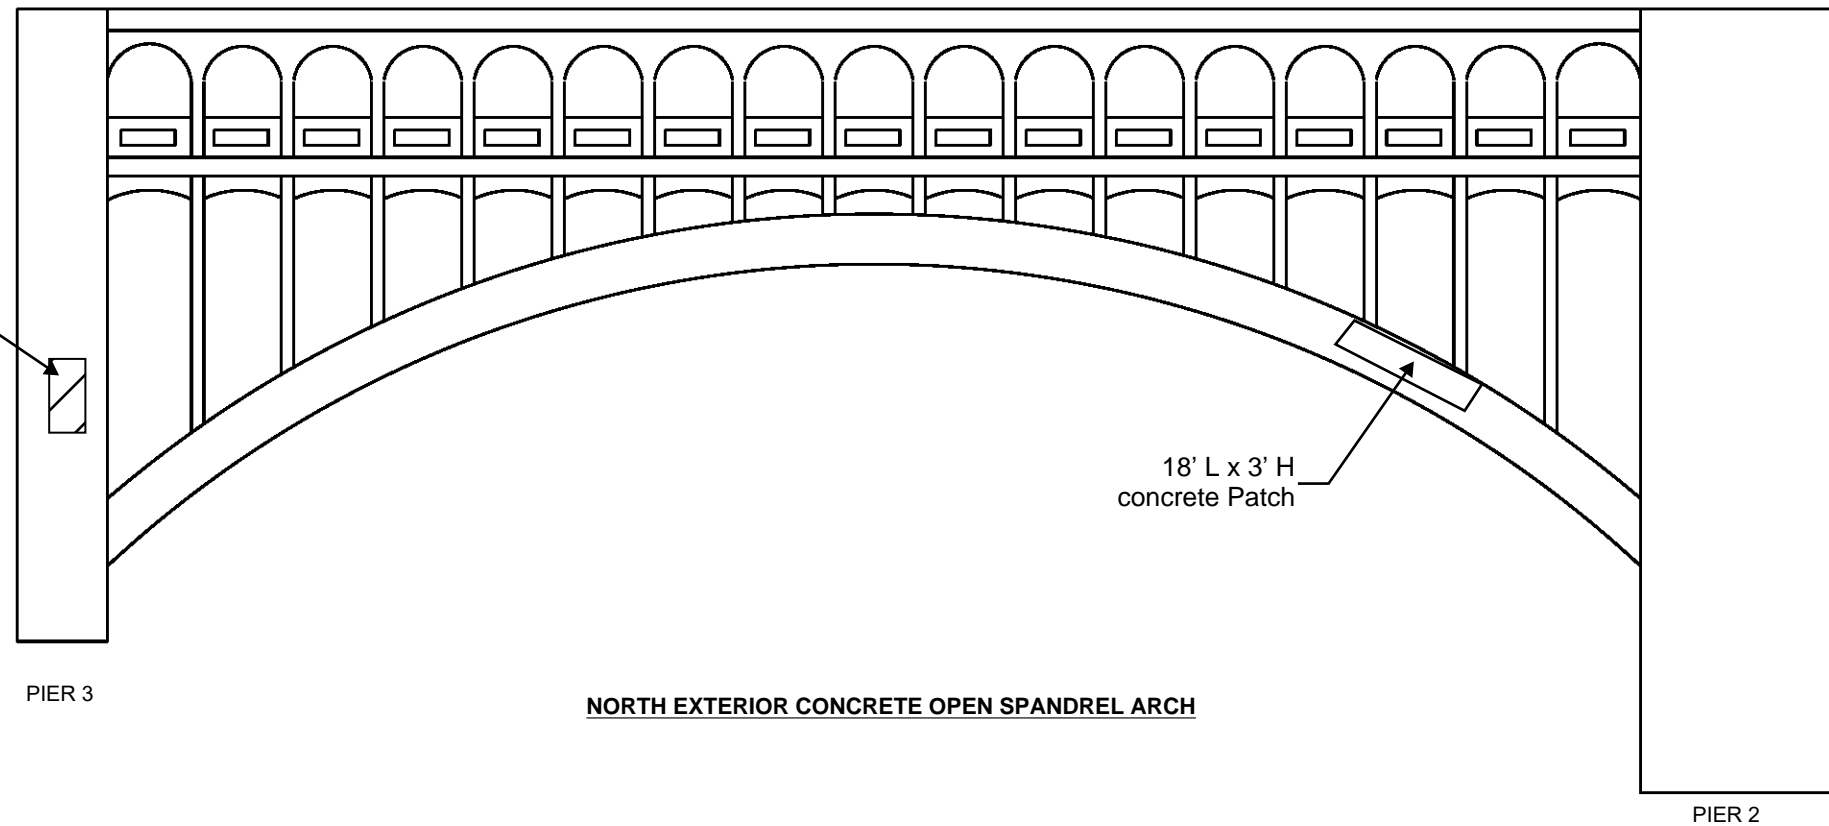

NORTH EXTERIOR CONCRETE OPEN SPANDREL ARCH

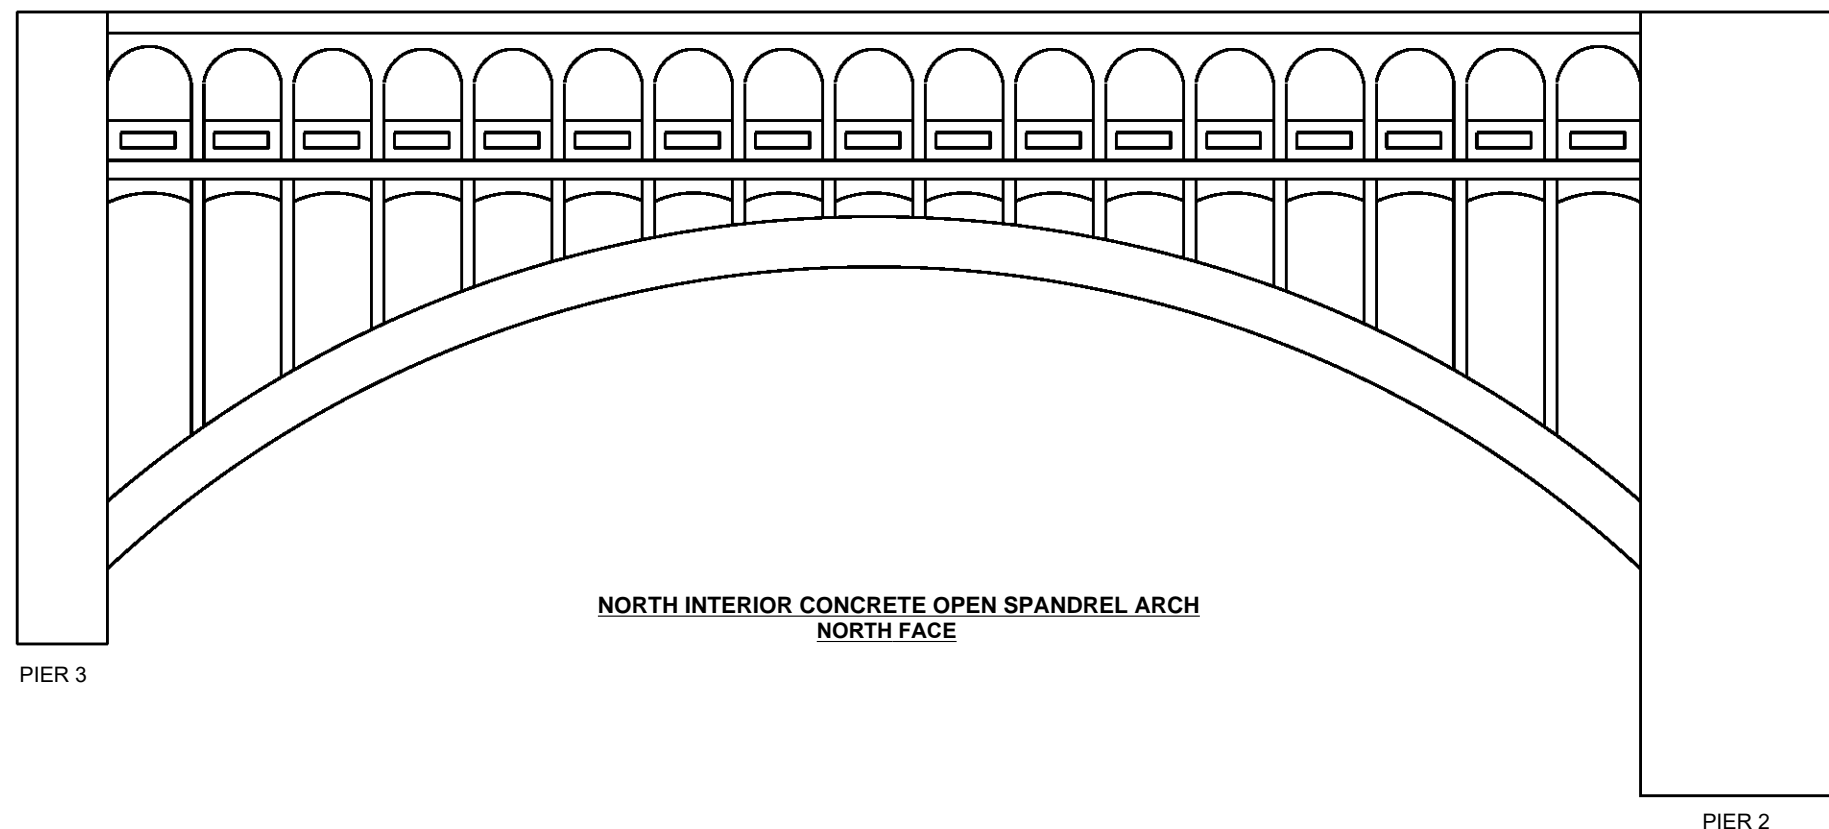

**NORTH INTERIOR CONCRETE OPEN SPANDREL ARCH
NORTH FACE**

General Notes:

- Arches typically exhibit cracking, spalls, and marked up delaminations throughout.

GRAPHIC SCALE MEASURED IN FEET

NOT TO SCALE

DATE

NOV, 2018





9902 Carver Road
Suite 201
Cincinnati, OH 45242
PH.: 614.699.5000

INFRASTRUCTURE
ENGINEERS, INC.

**DETROIT-SUPERIOR BRIDGE OVER CUYAHOGA RIVER
BRIDGE NO. CUY-6-1465**

STRUCTURE ELEVATION - SPAN 3



PAGE
A-52

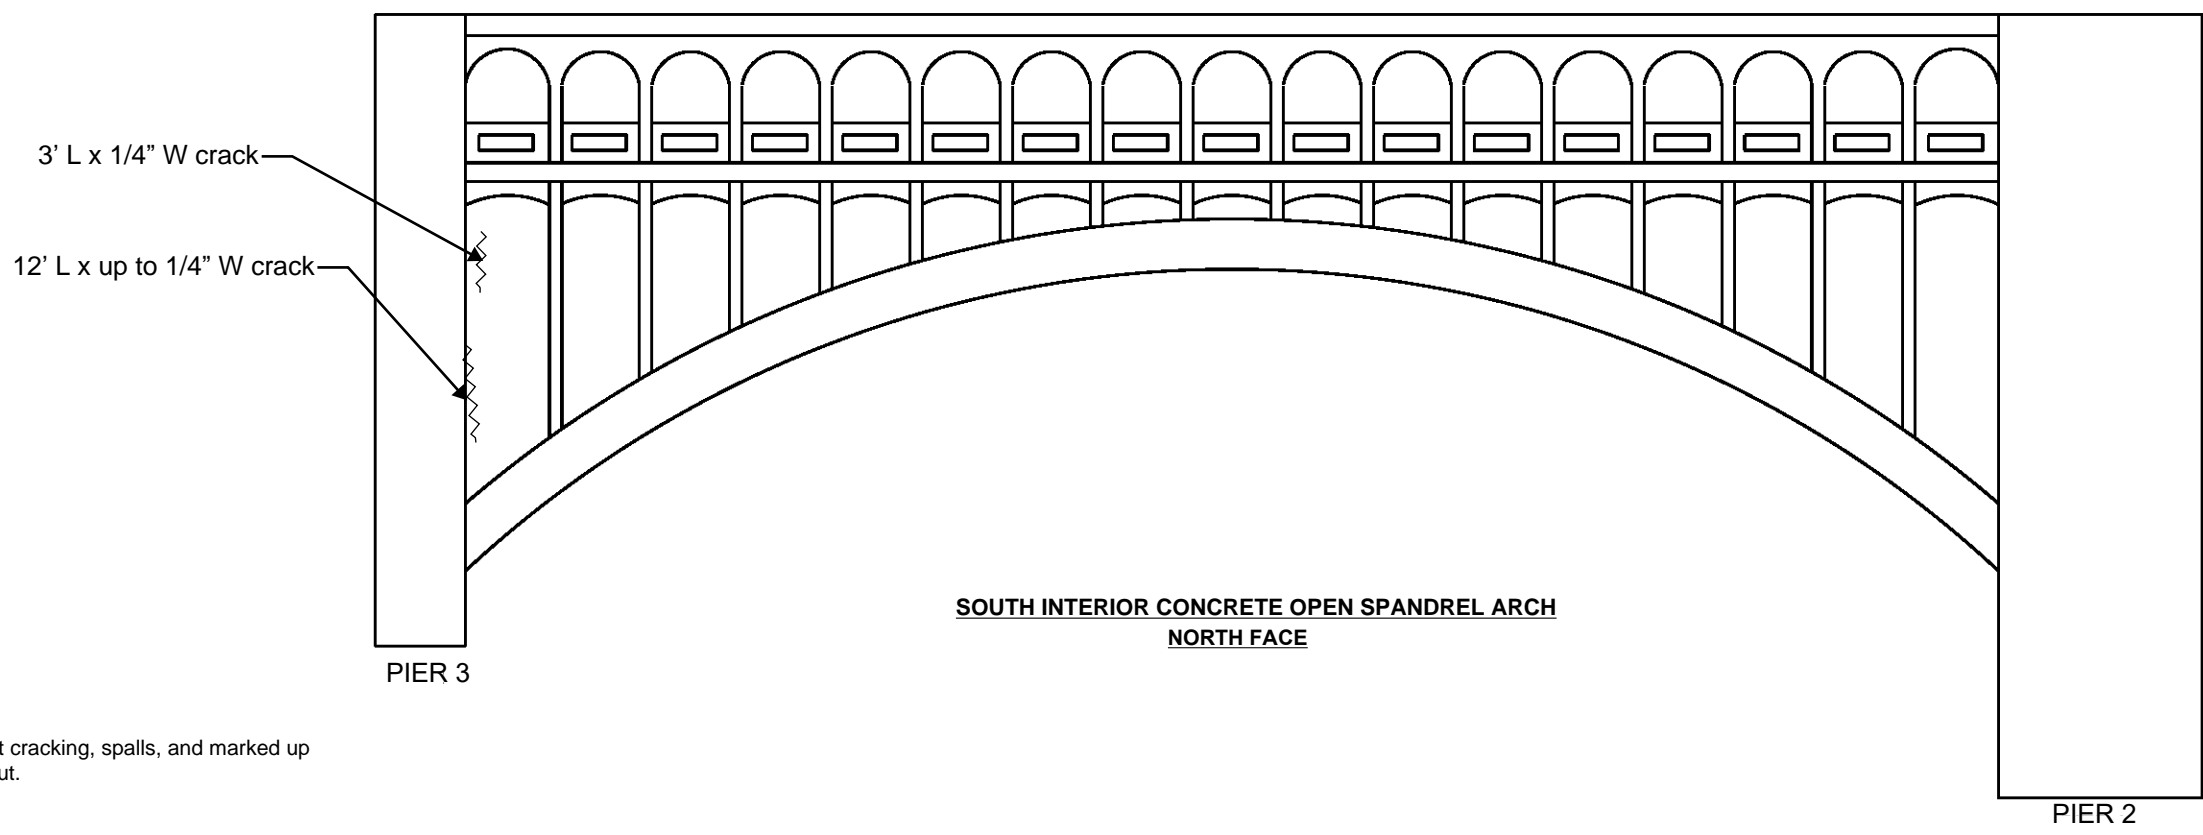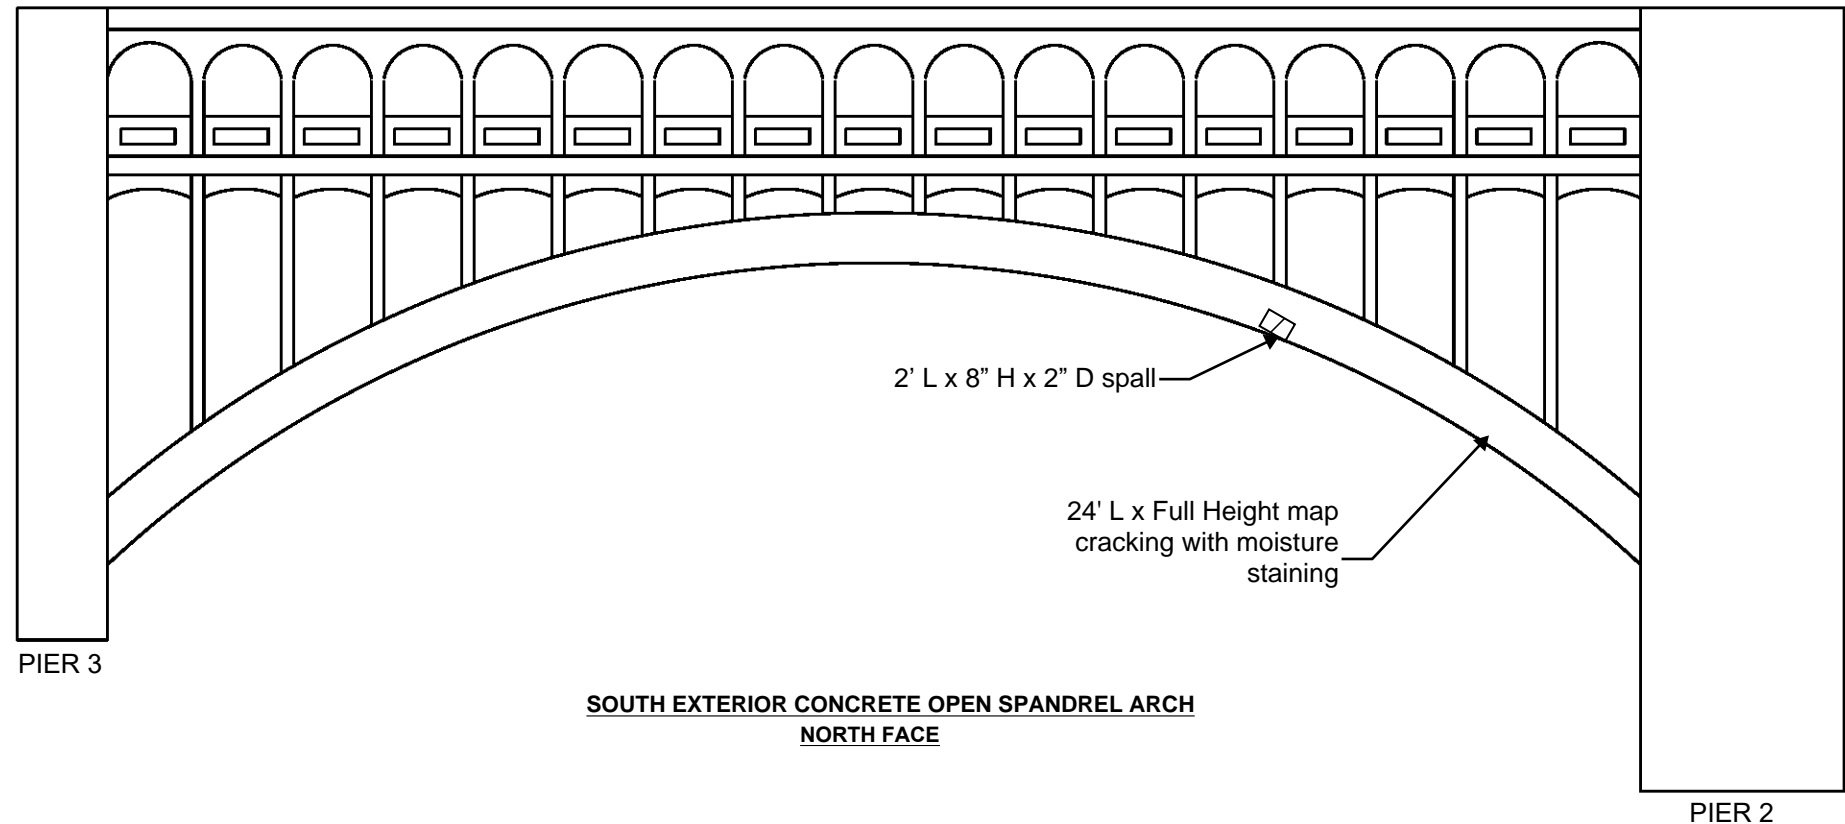

General Notes:

- Arches typically exhibit cracking, spalls, and marked up delaminations throughout.



| | | | | | |
|--------------------------------|-----------|--|---|------|------|
| GRAPHIC SCALE MEASURED IN FEET | DATE |  9902 Carver Road
Suite 201
Cincinnati, OH 45242
PH.: 614.699.5000 | DETROIT-SUPERIOR BRIDGE OVER CUYAHOGA RIVER
BRIDGE NO. CUY-6-1465 | | |
| NOT TO SCALE | NOV, 2018 | INFRASTRUCTURE ENGINEERS, INC. | STRUCTURE ELEVATION - SPAN 3 <table border="1" style="float: right; width: 50px;"> <tr> <td>PAGE</td> </tr> <tr> <td>A-53</td> </tr> </table> | PAGE | A-53 |
| PAGE | | | | | |
| A-53 | | | | | |

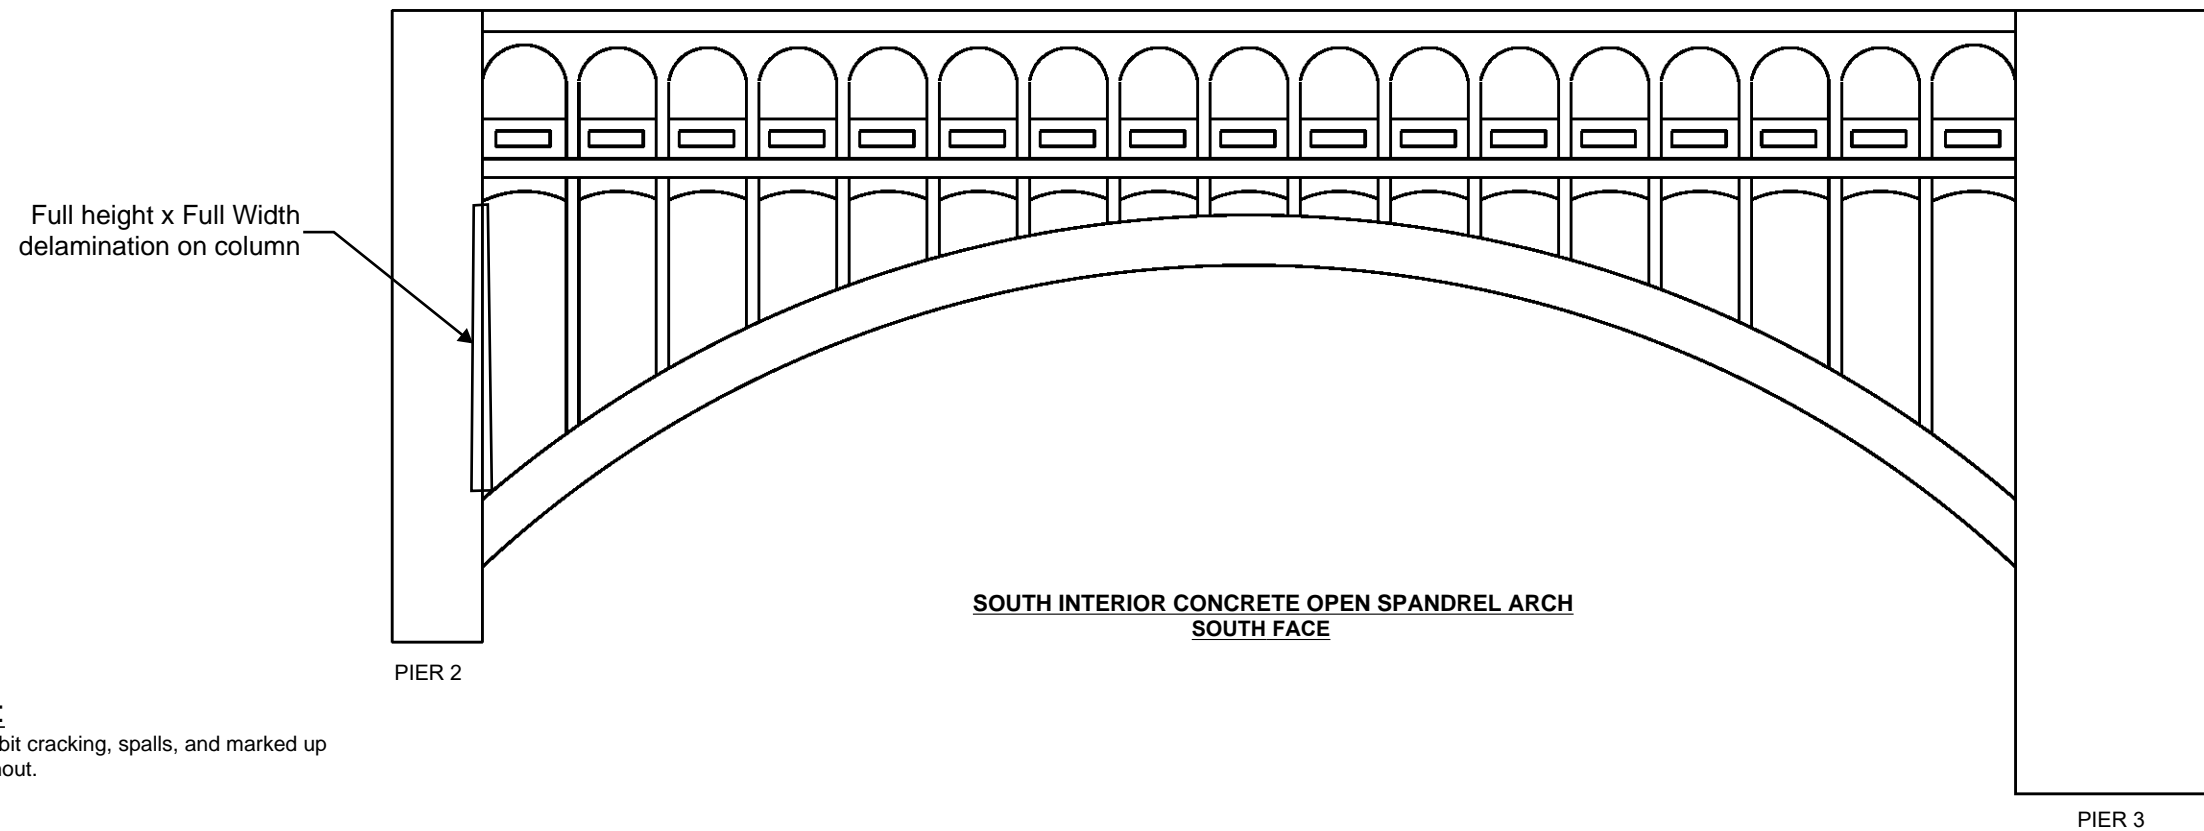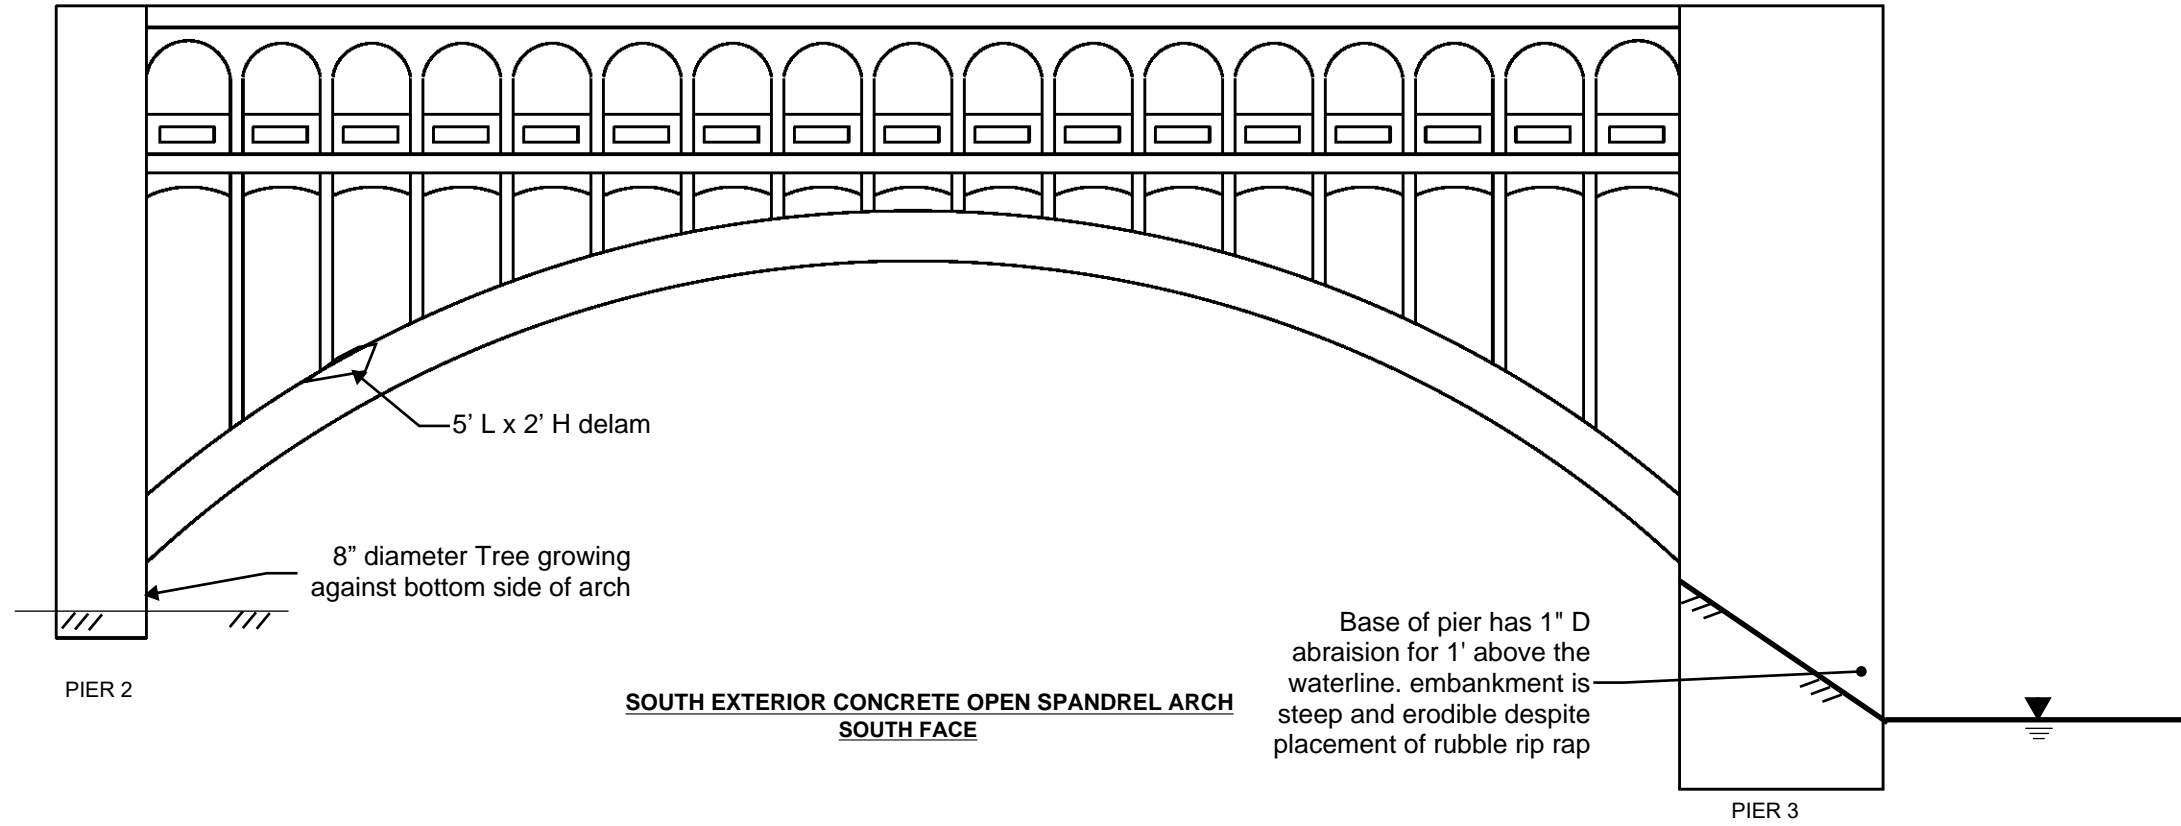


General Notes:

- Arches typically exhibit cracking, spalls, and marked up delaminations throughout.


| | | | | |
|--------------------------------|-----------|--|--|------------------------------|
| GRAPHIC SCALE MEASURED IN FEET | DATE |  9902 Carver Road
Suite 201
Cincinnati, OH 45242
PH.: 614.699.5000 | DETROIT-SUPERIOR BRIDGE OVER CUYAHOGA RIVER
BRIDGE NO. CUY-6-1465 | |
| NOT TO SCALE | NOV, 2018 | | INFRASTRUCTURE ENGINEERS, INC. | STRUCTURE ELEVATION - SPAN 3 |

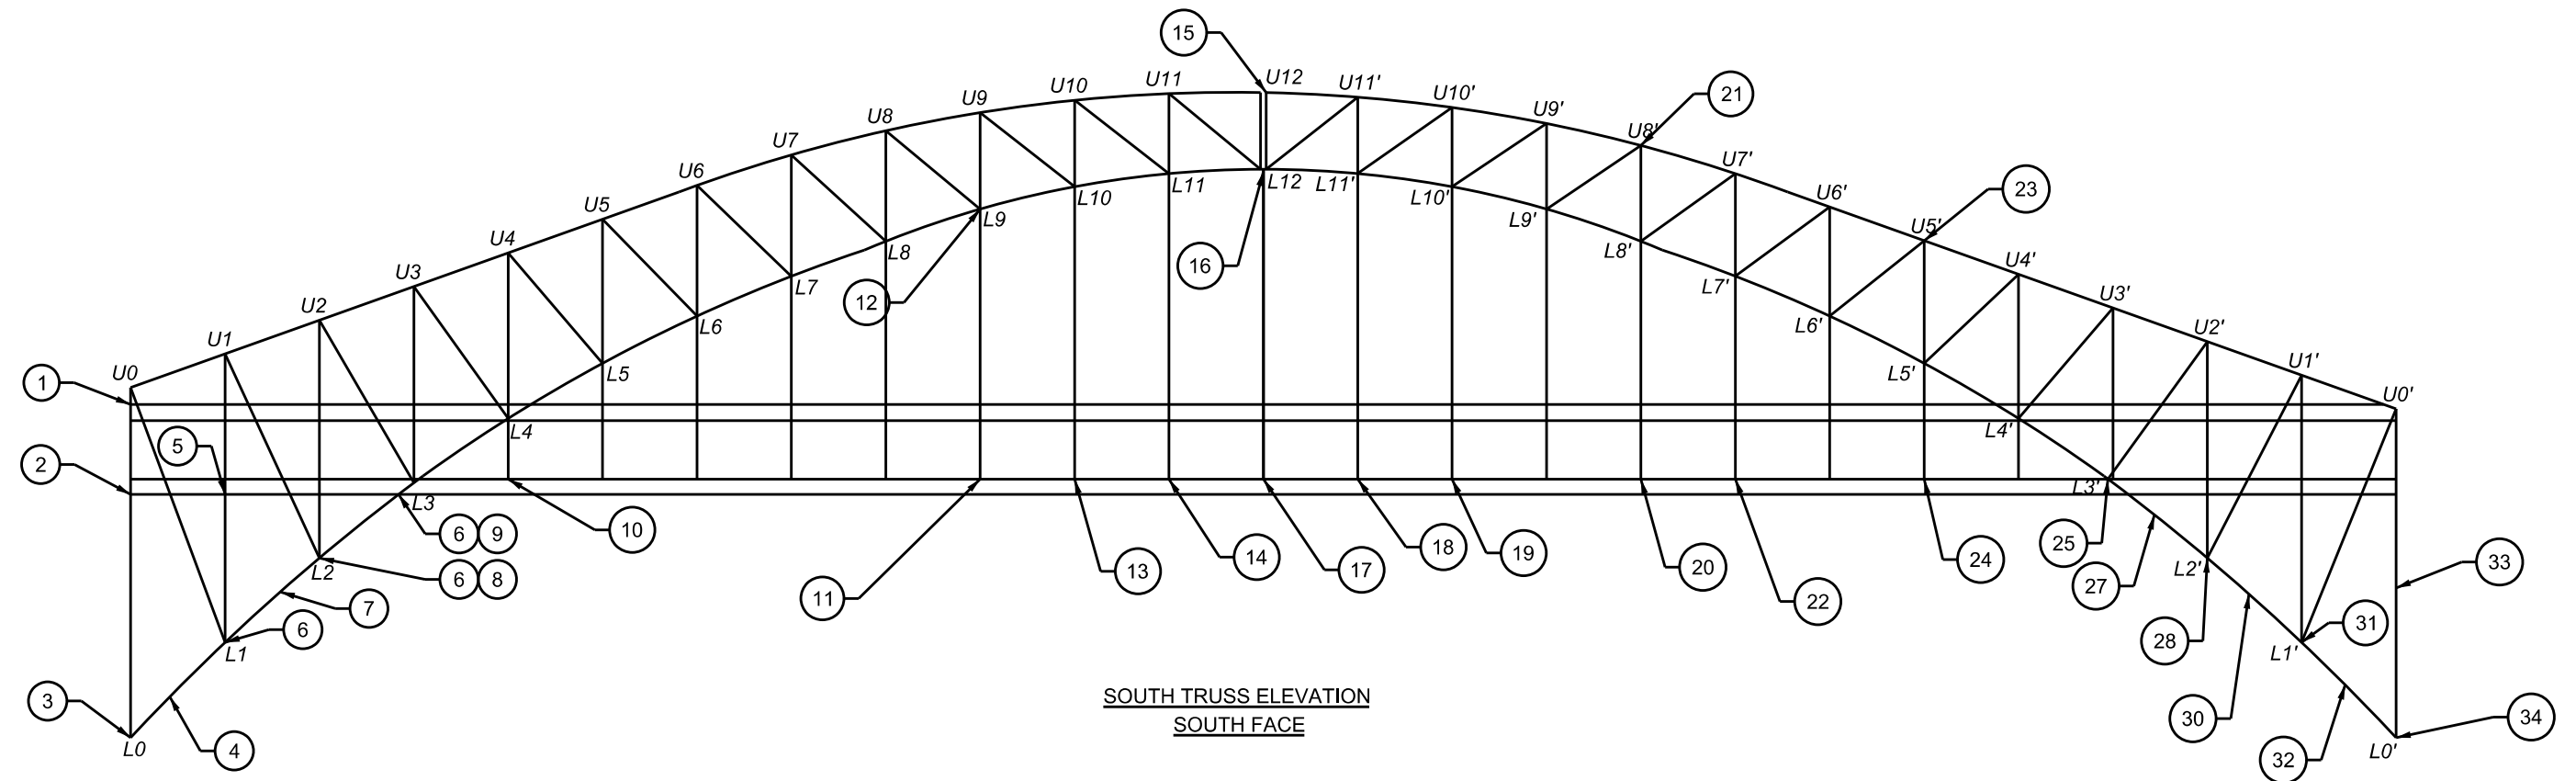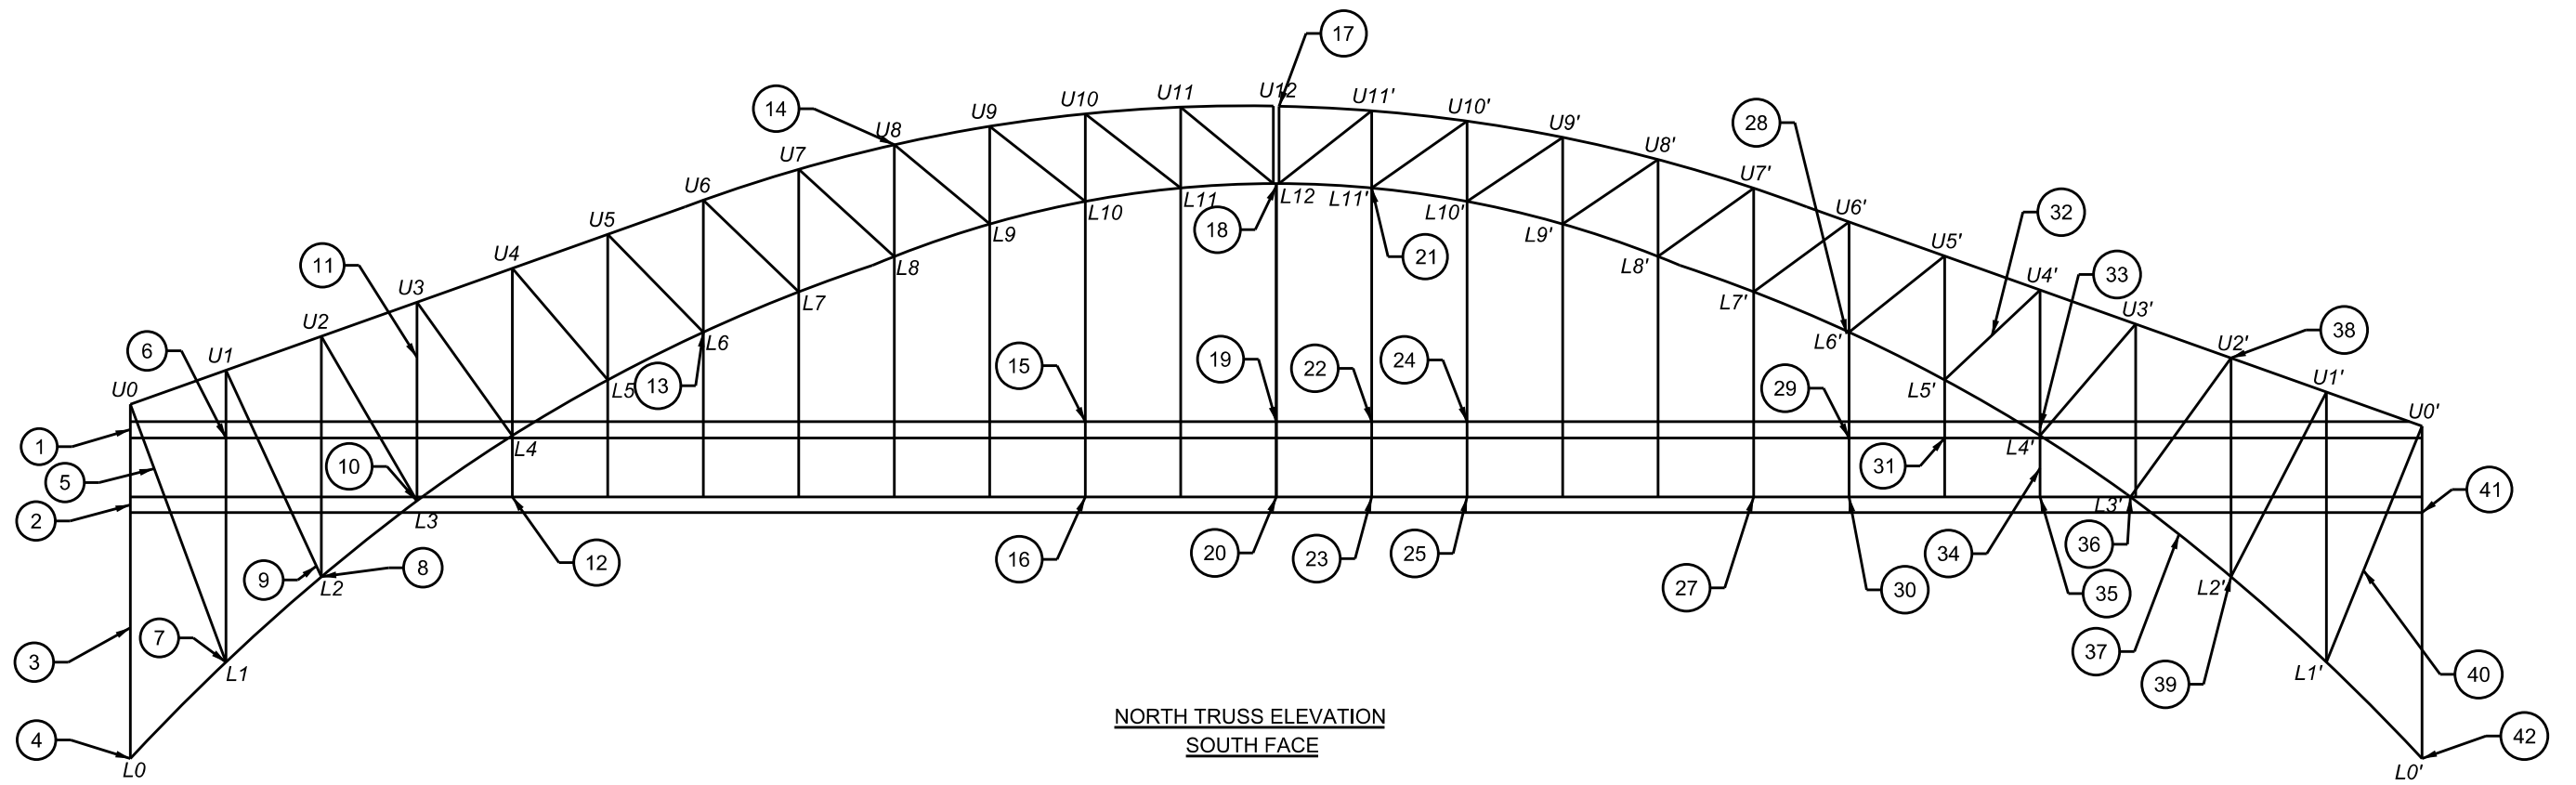

| | | | |
|--------------------------------|-----------|--|--|
| GRAPHIC SCALE MEASURED IN FEET | DATE |  9902 Carver Road
Suite 201
Cincinnati, OH 45242
PH.: 614.699.5000 | DETROIT-SUPERIOR BRIDGE OVER CUYAHOGA RIVER
BRIDGE NO. CUY-6-1465 |
| NOT TO SCALE | NOV, 2018 | INFRASTRUCTURE ENGINEERS, INC. | TRUSS ELEVATION - SPAN 4 |
| | | | PAGE
A-55 |

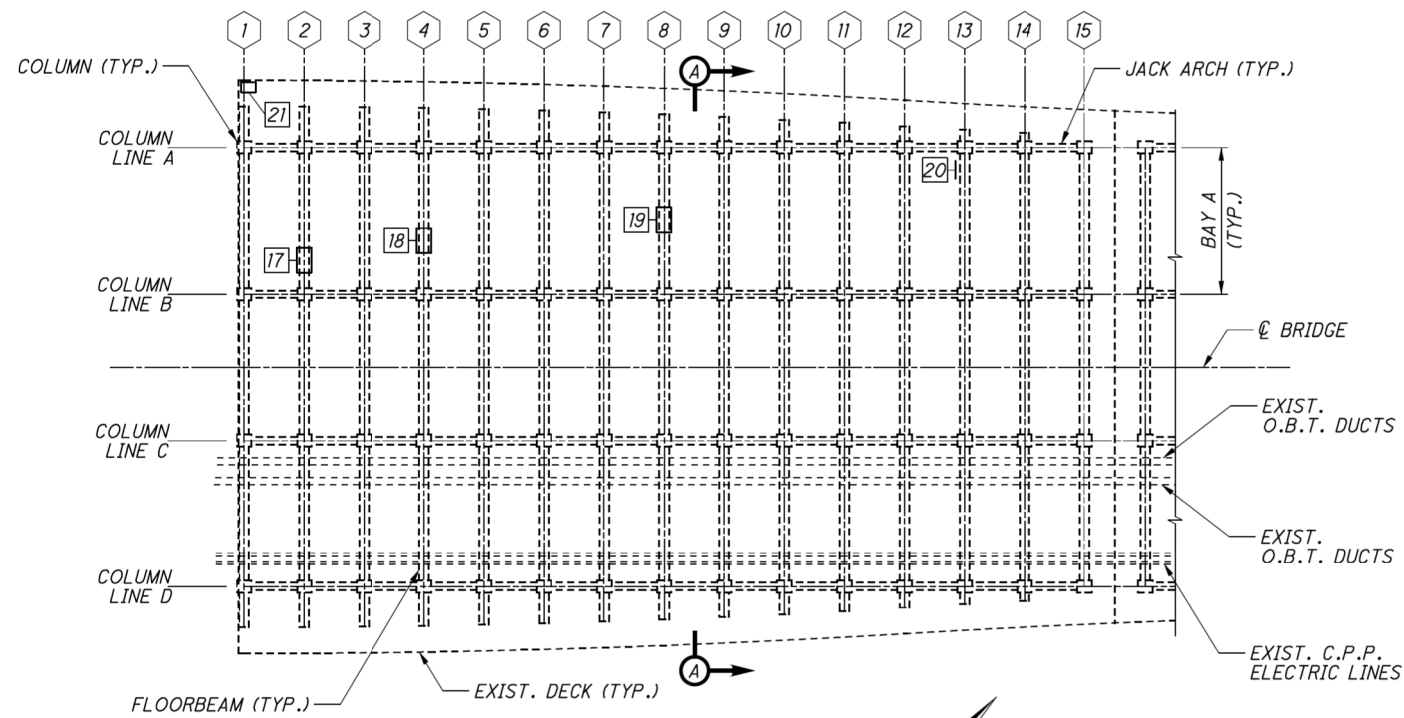

SPAN 5 - UPPER DECK PLAN

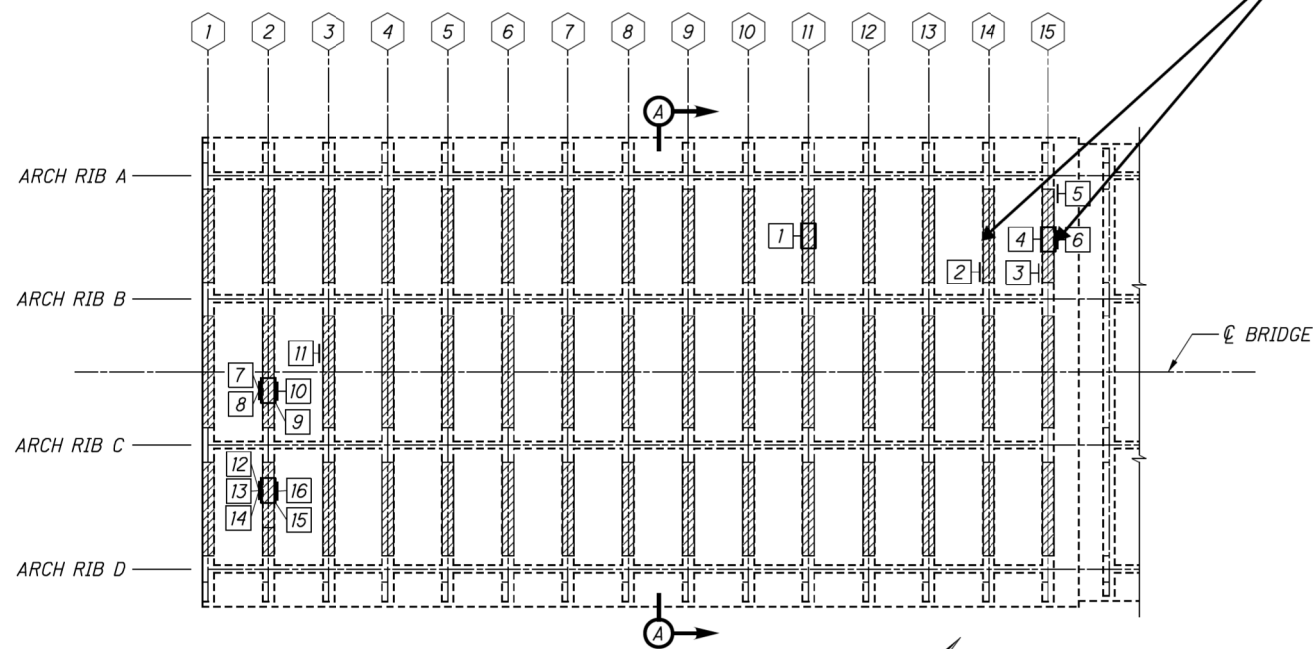

SPAN 5 - LOWER DECK PLAN

| ESTIMATED PATCHING QUANTITIES | | | |
|-------------------------------|-------------|-----------|------------------|
| REPAIR NO. | REPAIR TYPE | AREA (SF) | ANODE QUANTITY** |
| 1 | TYPE 2 | 11 | 4 |
| 2 | TYPE 1 | 2 | 1 |
| 3 | TYPE 1 | 5 | 1 |
| 4 | TYPE 2 | 4 | 3 |
| 5 | TYPE 1 | 2 | 1 |
| 6 | TYPE 1 | 15 | 4 |
| 7 | TYPE 1 | 17 | 8 |
| 8 | TYPE 1 | 10 | 3 |
| 9 | TYPE 2 | 33 | 13 |
| 10 | TYPE 1 | 41 | 8 |
| 11 | TYPE 1 | 12 | 2 |
| 12 | TYPE 1 | 4 | 1 |
| 13 | TYPE 1 | 11 | 2 |
| 14 | TYPE 1 | 4 | 1 |
| 15 | TYPE 2 | 14 | 6 |
| 16 | TYPE 1 | 8 | 2 |
| 17 | TYPE 2 | 3 | 2 |
| 18 | TYPE 2 | 2 | 2 |
| 19 | TYPE 2 | 1 | 1 |
| 20 | TYPE 1 | 9 | 4 |
| 21 | TYPE 2 | 1 | 1 |
| MEASURED QUANTITY* | | 209 | - |
| PLAN QUANTITY* | | 314 | 70 |

* SEE NOTES 1 & 2
 ** SEE NOTE 3

| SHEET QUANTITY SUMMARY | | |
|------------------------|------|----------|
| ITEM | UNIT | QUANTITY |
| TYPE 1 REPAIR | SF | 210 |
| TYPE 2 REPAIR | SF | 104 |
| FRP WRAP | SF | 3863 |


NOTES:

- MEASURED QUANTITIES ARE BASED ON THE INSPECTION PERFORMED IN JANUARY 2017. THE EXACT DIMENSIONS AND LOCATIONS OF PATCHES SHALL BE DETERMINED BY THE ENGINEER IN THE FIELD FOR FINAL PAY QUANTITY.
- PLAN QUANTITIES INCLUDE 50% CONTINGENCY ADDED TO MEASURED QUANTITIES.
- ANODES ARE INCLUDED FOR PAYMENT WITH ITEM SPECIAL - PATCHING CONCRETE STRUCTURE, TYPE 1 OR TYPE 2 REPAIR.
- FOR DETAILS AND MAXIMUM GRID SPACING FOR EMBEDDED GALVANIC ANODES, SEE SHEET 84/89.
- FOR SECTION A-A, SEE SHEET 34/89.
- FOR FRP WRAP DETAILS, SEE SHEET 85/89.


LEGEND:

- # FLOORBEAM LINE NUMBER
- # REPAIR NO. OF DEFICIENT CONCRETE TO BE REPAIRED IN ACCORDANCE WITH ITEM SPECIAL - PATCHING CONCRETE STRUCTURE, TYPE 1 OR TYPE 2 REPAIR.
- AREA TO BE TREATED WITH FRP WRAP PER ITEM SPECIAL - COMPOSITE FIBER WRAP SYSTEM

| | | | | |
|--------------------------------|-----------|--|--|-------------------------|
| GRAPHIC SCALE MEASURED IN FEET | DATE | 9902 Carver Road
Suite 201
Cincinnati, OH 45242
PH.: 614.699.5000 | DETROIT-SUPERIOR BRIDGE OVER CUYAHOGA RIVER
BRIDGE NO. CUY-6-1465 | |
| NOT TO SCALE | NOV, 2018 | | INFRASTRUCTURE ENGINEERS, INC. | SPAN 5 CONCRETE DETAILS |

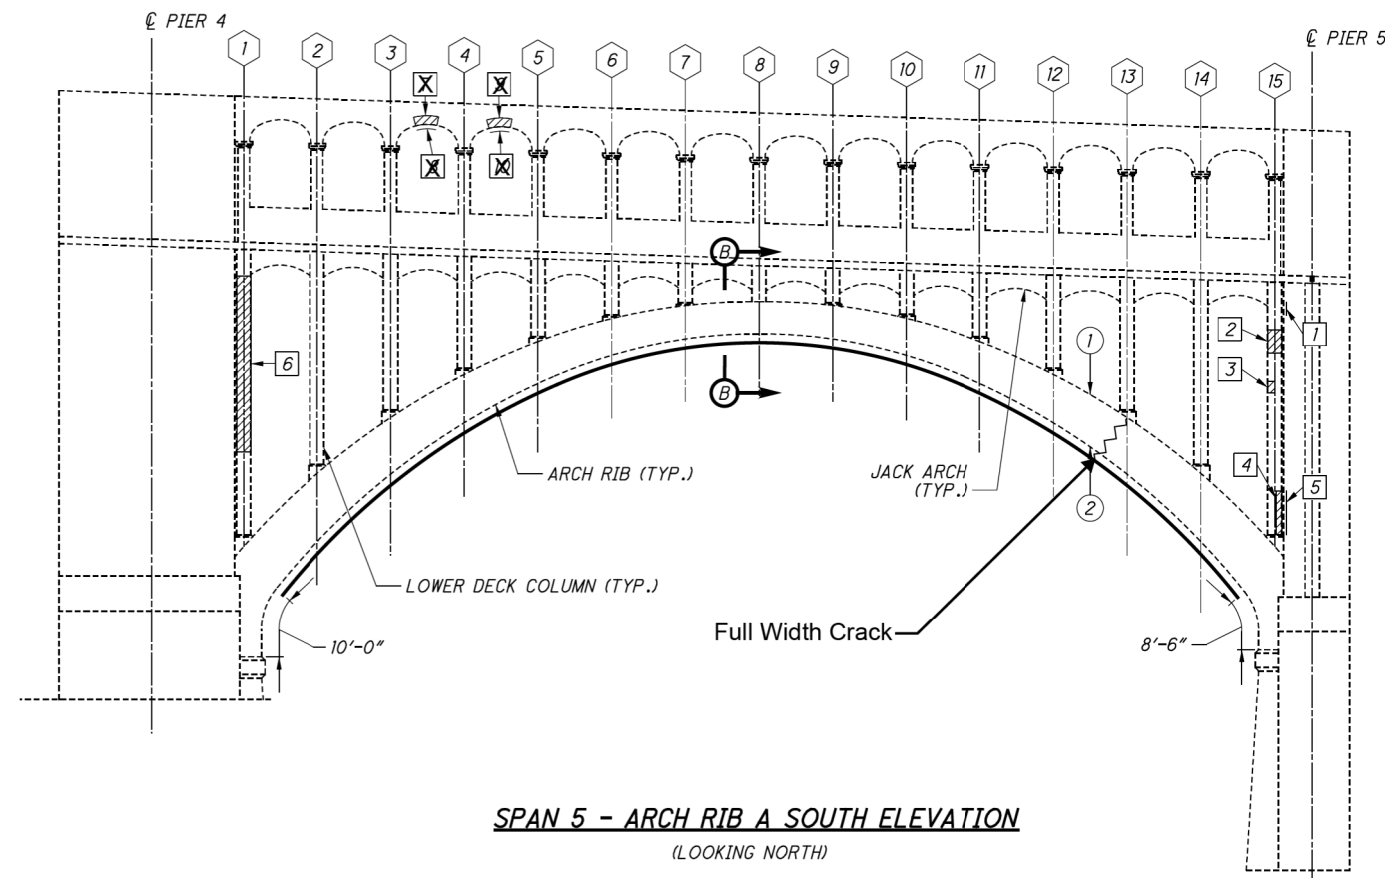

SPAN 5 - ARCH RIB A SOUTH ELEVATION
(LOOKING NORTH)

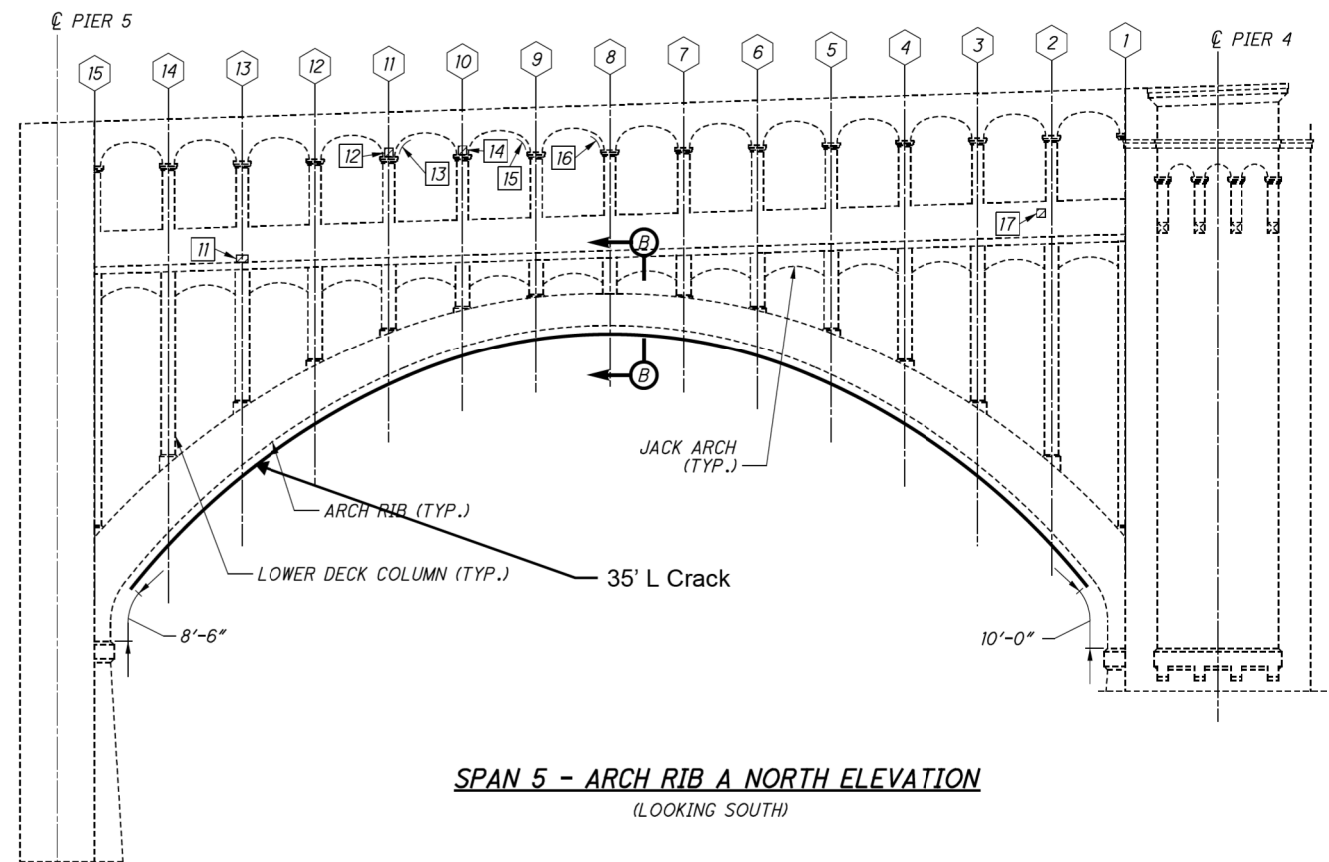

SPAN 5 - ARCH RIB A NORTH ELEVATION
(LOOKING SOUTH)

| ESTIMATED PATCHING QUANTITIES | | | |
|-------------------------------|-------------|-----------|------------------|
| REPAIR NO. | REPAIR TYPE | AREA (SF) | ANODE QUANTITY** |
| 1 | TYPE 1 | 3 | 1 |
| 2 | TYPE 1 | 6 | 1 |
| 3 | TYPE 1 | 2 | 1 |
| 4 | TYPE 1 | 4 | 3 |
| 5 | TYPE 1 | 4 | 2 |
| 6 | TYPE 1 | 40 | 10 |
| 7 | TYPE 1 | 3 | 1 |
| 8 | TYPE 2 | 3 | 2 |
| 9 | TYPE 1 | 4 | 1 |
| 10 | TYPE 2 | 3 | 1 |
| 11 | TYPE 1 | 2 | 1 |
| 12 | TYPE 1 | 1 | 1 |
| 13 | TYPE 2 | 3 | 2 |
| 14 | TYPE 1 | 1 | 1 |
| 15 | TYPE 2 | 4 | 2 |
| 16 | TYPE 2 | 3 | 2 |
| 17 | TYPE 1 | 1 | 1 |
| MEASURED QUANTITY* | | 87 | - |
| PLAN QUANTITY* | | 131 | 33 |

* SEE NOTES 1 & 2
** SEE NOTES 3 & 4

| CRACK REPAIRS | | |
|---------------|-------------|-----|
| REPAIR NO. | LENGTH (FT) | |
| 1 | 50-15 | |
| 2 | 50 | |
| TOTAL | | 100 |

| SHEET QUANTITY SUMMARY | | |
|------------------------|------|----------|
| ITEM | UNIT | QUANTITY |
| TYPE 1 REPAIR | SF | 107 |
| TYPE 2 REPAIR | SF | 24 |
| EPOXY INJECTION | FT | 100 |
| FRP WRAP | SF | 1755 |


NOTES:

- MEASURED QUANTITIES ARE BASED ON THE INSPECTION PERFORMED IN DECEMBER 2016. THE EXACT DIMENSIONS AND LOCATIONS OF PATCHES SHALL BE DETERMINED BY THE ENGINEER IN THE FIELD FOR FINAL PAY QUANTITY.
- PLAN QUANTITIES INCLUDE 50% CONTINGENCY ADDED TO MEASURED QUANTITIES.
- ANODES ARE INCLUDED FOR PAYMENT WITH ITEM SPECIAL - PATCHING CONCRETE STRUCTURE, TYPE 1 OR TYPE 2 REPAIR.
- GALVANIC ANODES WILL NOT BE USED FOR PATCHING THE UNREINFORCED VERTICAL SIDES OF THE CONCRETE ARCH RIBS.
- FOR DETAILS AND MAXIMUM GRID SPACING FOR EMBEDDED GALVANIC ANODES, SEE SHEET [84/89].
- FOR PIER 4 REPAIR DETAILS, SEE SHEET [26/89]. FOR PIER 5 REPAIR DETAILS, SEE SHEET [27/89].
- FOR FRP WRAP DETAILS AND SECTION B-B, SEE SHEET [85/89].


LEGEND:

- # SPANDREL COLUMN NUMBER
- # REPAIR NUMBER
- [Hatched Box] LOCATION OF DEFICIENT CONCRETE TO BE REPAIRED IN ACCORDANCE WITH ITEM SPECIAL - PATCHING CONCRETE STRUCTURE, TYPE 1 REPAIR
- [Vertical Dashed Line] LOCATION OF DEFICIENT CONCRETE ON PERPENDICULAR FACE (NOT VISIBLE IN ELEVATION VIEW) TO BE REPAIRED IN ACCORDANCE WITH ITEM SPECIAL - PATCHING CONCRETE STRUCTURE, TYPE 1 OR TYPE 2 REPAIR
- [Dashed Line] AREA TO BE TREATED WITH FRP WRAP PER ITEM SPECIAL - COMPOSITE FIBER WRAP SYSTEM
- # [Circle with X] LOCATION OF CRACK TO BE REPAIRED IN ACCORDANCE WITH ITEM 512 - CONCRETE REPAIR BY EPOXY INJECTION

| | | | | |
|--------------------------------|-----------|--|--|-------------------------|
| GRAPHIC SCALE MEASURED IN FEET | DATE |  9902 Carver Road
Suite 201
Cincinnati, OH 45242
PH.: 614.699.5000 | DETROIT-SUPERIOR BRIDGE OVER CUYAHOGA RIVER
BRIDGE NO. CUY-6-1465 | |
| NOT TO SCALE | NOV, 2018 | | INFRASTRUCTURE ENGINEERS, INC. | SPAN 5 CONCRETE DETAILS |

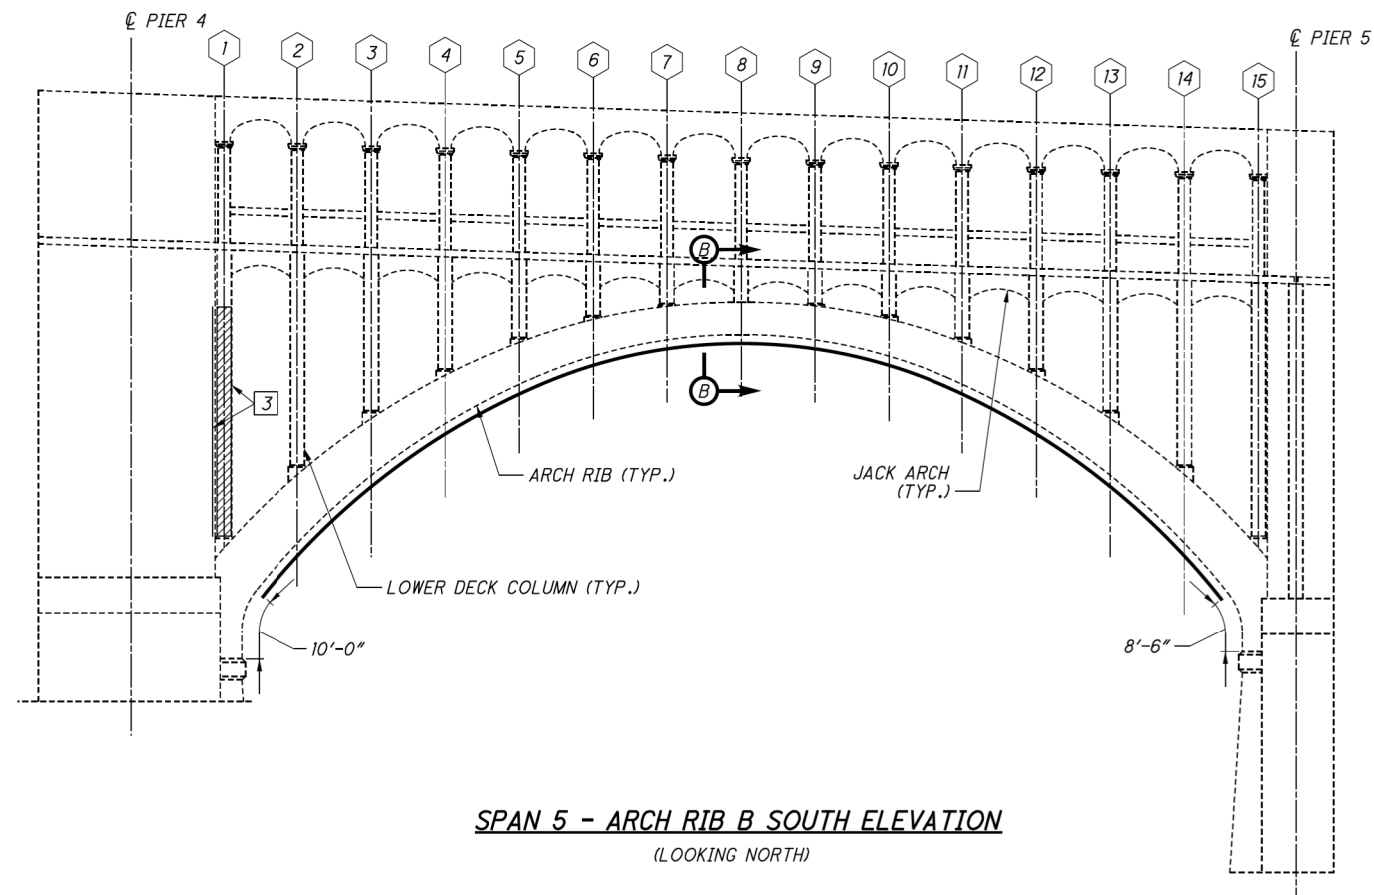

SPAN 5 - ARCH RIB B SOUTH ELEVATION
(LOOKING NORTH)

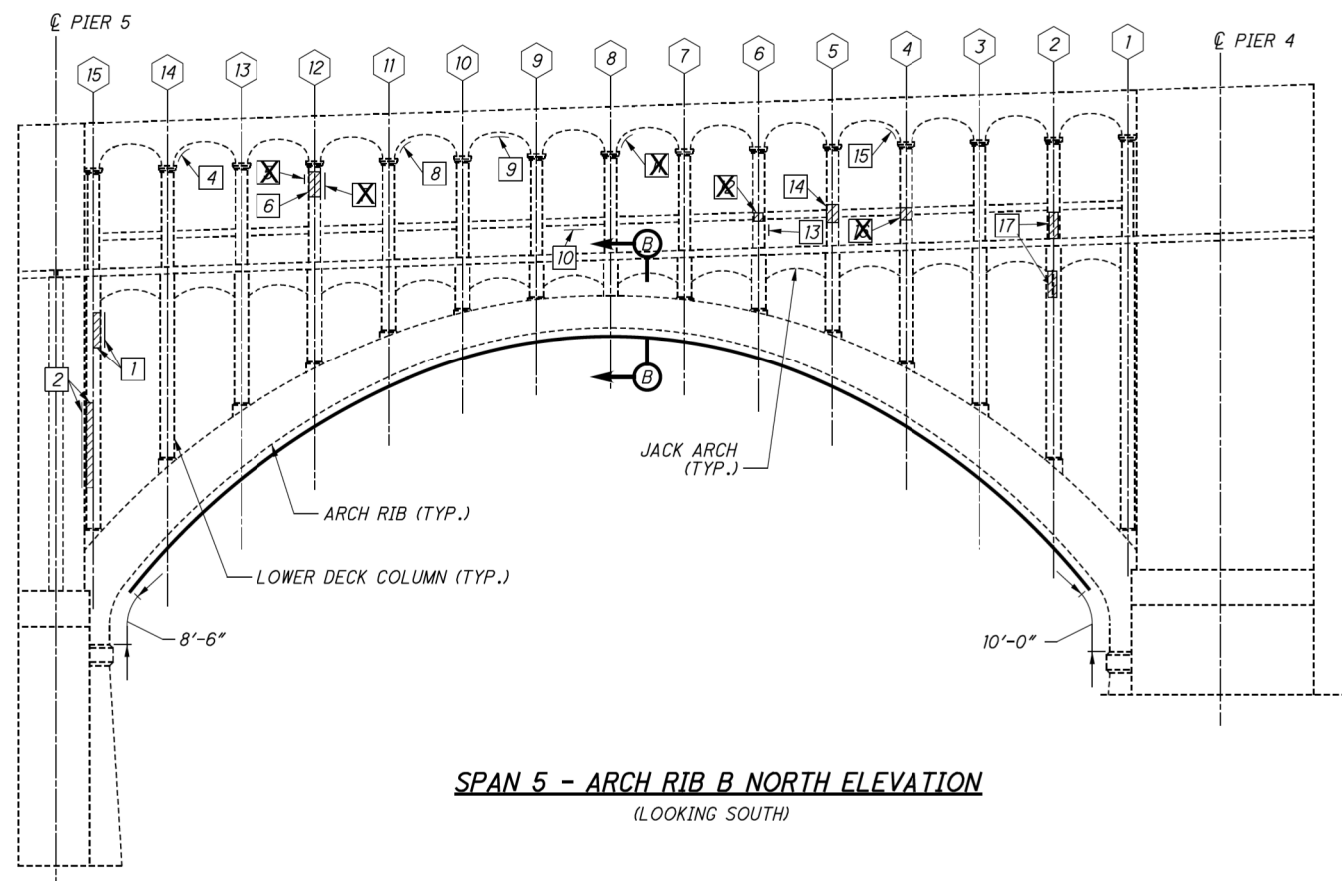

SPAN 5 - ARCH RIB B NORTH ELEVATION
(LOOKING SOUTH)

| ESTIMATED PATCHING QUANTITIES | | | |
|-------------------------------|-------------|-----------|------------------|
| REPAIR NO. | REPAIR TYPE | AREA (SF) | ANODE QUANTITY** |
| 1 | TYPE 1 | 7 | 2 |
| 2 | TYPE 1 | 26 | 5 |
| 3 | TYPE 1 | 96 | 24 |
| 4 | TYPE 2 | 3 | 2 |
| 5 | TYPE 1 | 1 | 1 |
| 6 | TYPE 1 | 4 | 2 |
| 7 | TYPE 1 | 3 | 2 |
| 8 | TYPE 2 | 2 | 1 |
| 9 | TYPE 2 | 2 | 1 |
| 10 | TYPE 2 | 4 | 3 |
| 11 | TYPE 2 | 3 | 2 |
| 12 | TYPE 1 | 1 | 1 |
| 13 | TYPE 1 | 1 | 1 |
| 14 | TYPE 1 | 3 | 1 |
| 15 | TYPE 2 | 3 | 2 |
| 16 | TYPE 1 | 2 | 1 |
| 17 | TYPE 1 | 3 | 2 |
| MEASURED QUANTITY* | | 164 | - |
| PLAN QUANTITY* | | 246 | 53 |

* SEE NOTES 1 & 2
** SEE NOTES 3 & 4

| SHEET QUANTITY SUMMARY | | |
|------------------------|------|----------|
| ITEM | UNIT | QUANTITY |
| TYPE 1 REPAIR | SF | 220 |
| TYPE 2 REPAIR | SF | 26 |
| FRP WRAP | SF | 2074 |


NOTES:

- MEASURED QUANTITIES ARE BASED ON THE INSPECTION PERFORMED IN DECEMBER 2016. THE EXACT DIMENSIONS AND LOCATIONS OF PATCHES SHALL BE DETERMINED BY THE ENGINEER IN THE FIELD FOR FINAL PAY QUANTITY.
- PLAN QUANTITIES INCLUDE 50% CONTINGENCY ADDED TO MEASURED QUANTITIES.
- ANODES ARE INCLUDED FOR PAYMENT WITH ITEM SPECIAL - PATCHING CONCRETE STRUCTURE, TYPE 1 OR TYPE 2 REPAIR.
- GALVANIC ANODES WILL NOT BE USED FOR PATCHING THE UNREINFORCED VERTICAL SIDES OF THE CONCRETE ARCH RIBS.
- FOR DETAILS AND MAXIMUM GRID SPACING FOR EMBEDDED GALVANIC ANODES, SEE SHEET [84/89].
- FOR PIER 4 REPAIR DETAILS, SEE SHEET [26/89]. FOR PIER 5 REPAIR DETAILS, SEE SHEET [27/89].
- FOR FRP WRAP DETAILS AND SECTION B-B, SEE SHEET [85/89].


LEGEND:

- # SPANDREL COLUMN NUMBER
- # REPAIR NUMBER
- ▨ LOCATION OF DEFICIENT CONCRETE TO BE REPAIRED IN ACCORDANCE WITH ITEM SPECIAL - PATCHING CONCRETE STRUCTURE, TYPE 1 REPAIR
- || LOCATION OF DEFICIENT CONCRETE ON PERPENDICULAR FACE (NOT VISIBLE IN ELEVATION VIEW) TO BE REPAIRED IN ACCORDANCE WITH ITEM SPECIAL - PATCHING CONCRETE STRUCTURE, TYPE 1 OR TYPE 2 REPAIR
- AREA TO BE TREATED WITH FRP WRAP PER ITEM SPECIAL - COMPOSITE FIBER WRAP SYSTEM

| | | | | |
|--------------------------------|--------------|--|--|--------------------------------|
| GRAPHIC SCALE MEASURED IN FEET | DATE |  9902 Carver Road
Suite 201
Cincinnati, OH 45242
PH.: 614.699.5000 | DETROIT-SUPERIOR BRIDGE OVER CUYAHOGA RIVER
BRIDGE NO. CUY-6-1465 | |
| | NOT TO SCALE | | NOV, 2018 | INFRASTRUCTURE ENGINEERS, INC. |
| | | | | PAGE A-58 |

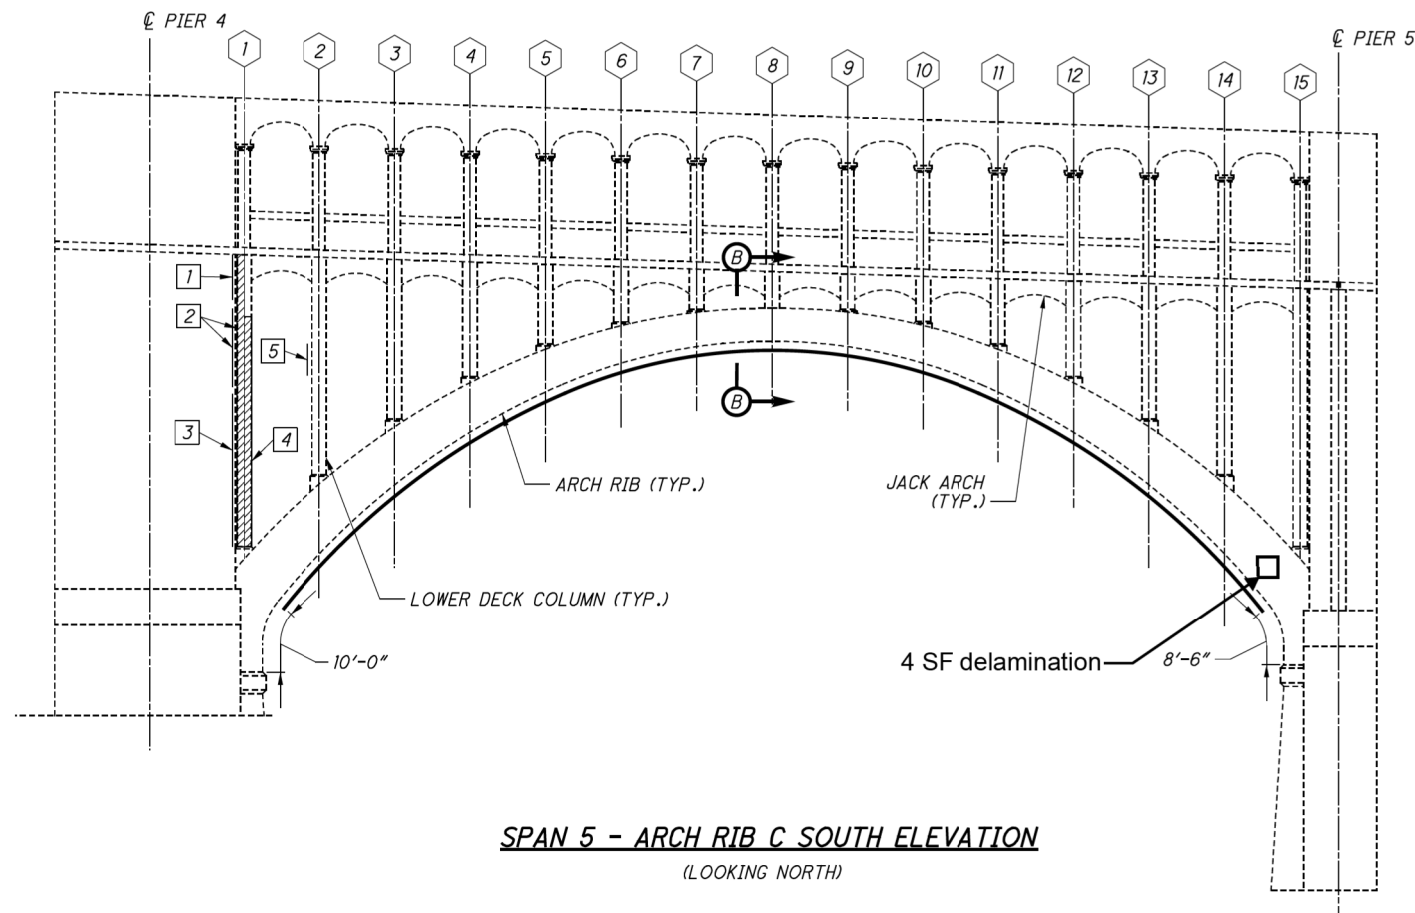

SPAN 5 - ARCH RIB C SOUTH ELEVATION
(LOOKING NORTH)

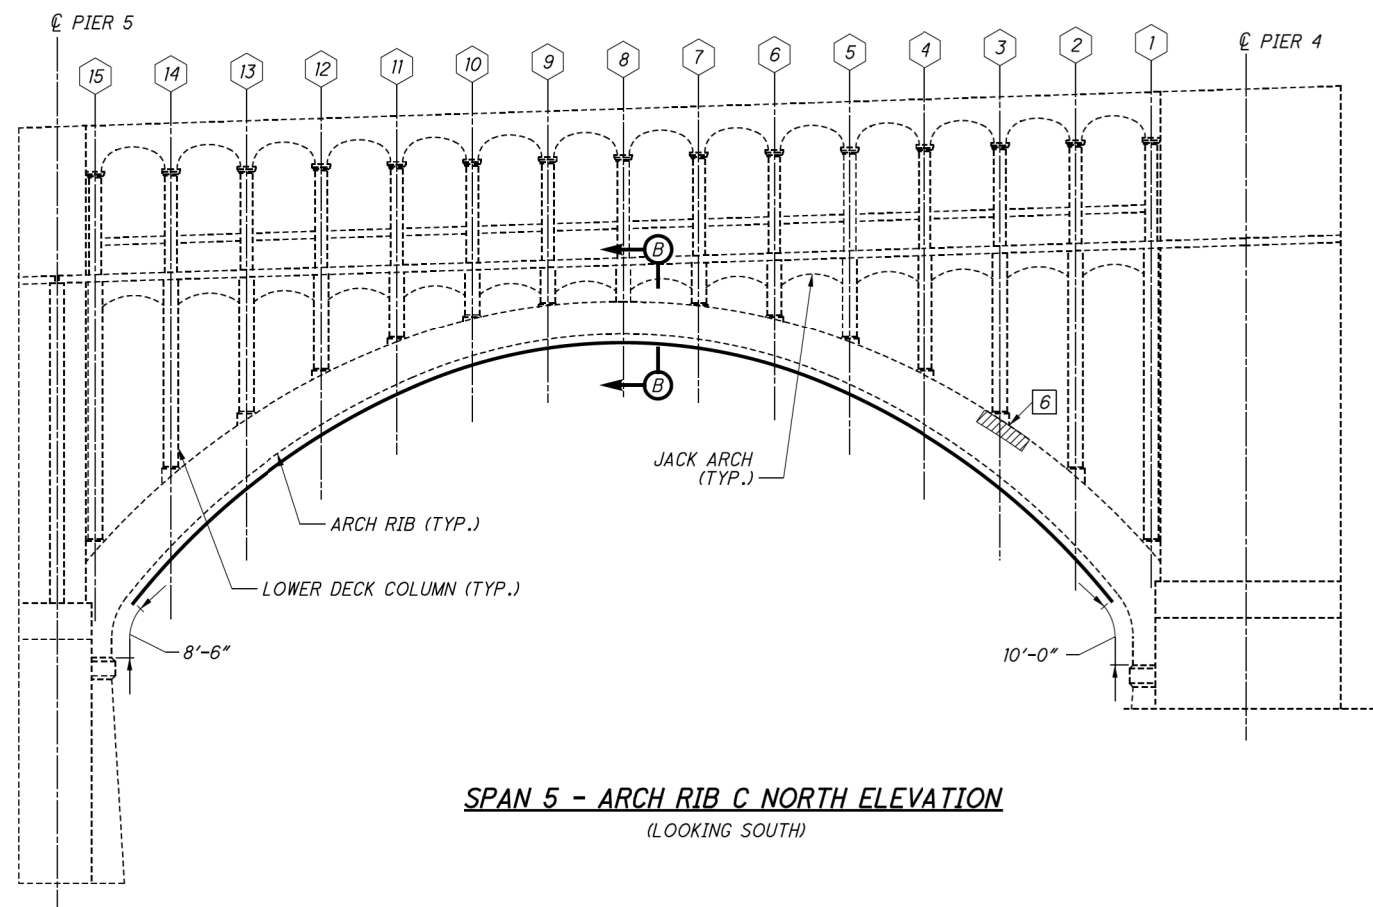

SPAN 5 - ARCH RIB C NORTH ELEVATION
(LOOKING SOUTH)

| ESTIMATED PATCHING QUANTITIES | | | |
|-------------------------------|-------------|-----------|------------------|
| REPAIR NO. | REPAIR TYPE | AREA (SF) | ANODE QUANTITY** |
| 1 | TYPE 1 | 23 | 6 |
| 2 | TYPE 1 | 70 | 14 |
| 3 | TYPE 1 | 60 | 16 |
| 4 | TYPE 1 | 44 | 11 |
| 5 | TYPE 1 | 7 | 2 |
| 6 | TYPE 1 | 10 | - |
| MEASURED QUANTITY* | | 214 | - |
| PLAN QUANTITY* | | 321 | 49 |

* SEE NOTES 1 & 2
** SEE NOTES 3 & 4

| SHEET QUANTITY SUMMARY | | |
|------------------------|------|----------|
| ITEM | UNIT | QUANTITY |
| TYPE 1 REPAIR | SF | 321 |
| TYPE 2 REPAIR | SF | - |
| FRP WRAP | SF | 2074 |


NOTES:

- MEASURED QUANTITIES ARE BASED ON THE INSPECTION PERFORMED IN DECEMBER 2016. THE EXACT DIMENSIONS AND LOCATIONS OF PATCHES SHALL BE DETERMINED BY THE ENGINEER IN THE FIELD FOR FINAL PAY QUANTITY.
- PLAN QUANTITIES INCLUDE 50% CONTINGENCY ADDED TO MEASURED QUANTITIES.
- ANODES ARE INCLUDED FOR PAYMENT WITH ITEM SPECIAL - PATCHING CONCRETE STRUCTURE, TYPE 1 OR TYPE 2 REPAIR.
- GALVANIC ANODES WILL NOT BE USED FOR PATCHING THE UNREINFORCED VERTICAL SIDES OF THE CONCRETE ARCH RIBS.
- FOR DETAILS AND MAXIMUM GRID SPACING FOR EMBEDDED GALVANIC ANODES, SEE SHEET [84/89].
- FOR PIER 4 REPAIR DETAILS, SEE SHEET [26/89]. FOR PIER 5 REPAIR DETAILS, SEE SHEET [27/89].
- FOR FRP WRAP DETAILS AND SECTION B-B, SEE SHEET [85/89].


LEGEND:

- SPANDREL COLUMN NUMBER
- REPAIR NUMBER
- LOCATION OF DEFICIENT CONCRETE TO BE REPAIRED IN ACCORDANCE WITH ITEM SPECIAL - PATCHING CONCRETE STRUCTURE, TYPE 1 REPAIR
- LOCATION OF DEFICIENT CONCRETE ON PERPENDICULAR FACE (NOT VISIBLE IN ELEVATION VIEW) TO BE REPAIRED IN ACCORDANCE WITH ITEM SPECIAL - PATCHING CONCRETE STRUCTURE, TYPE 1 OR TYPE 2 REPAIR
- AREA TO BE TREATED WITH FRP WRAP PER ITEM SPECIAL - COMPOSITE FIBER WRAP SYSTEM

| | | | | |
|--------------------------------|--------------------------------|--|---|-----------|
| GRAPHIC SCALE MEASURED IN FEET | DATE | 9902 Carver Road
Suite 201
Cincinnati, OH 45242
PH.: 614.699.5000 | DETROIT-SUPERIOR BRIDGE OVER CUYAHOGA RIVER | |
| | NOV, 2018 | | BRIDGE NO. CUY-6-1465 | |
| NOT TO SCALE | INFRASTRUCTURE ENGINEERS, INC. | | SPAN 5 CONCRETE REPAIR DETAILS | PAGE A-59 |

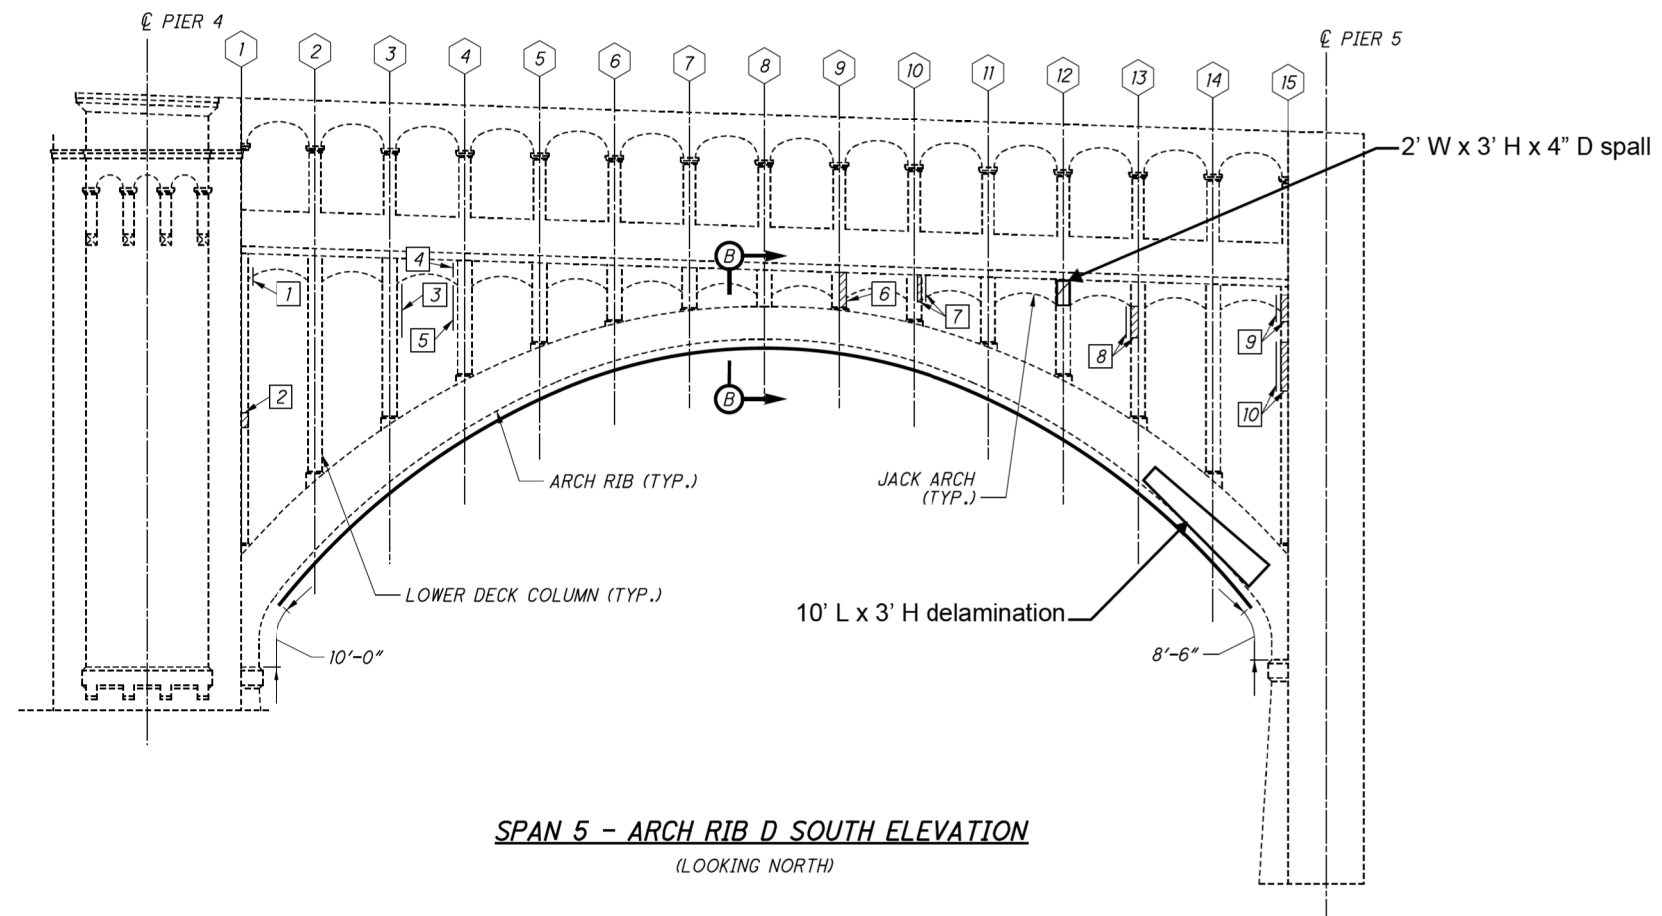

SPAN 5 - ARCH RIB D SOUTH ELEVATION
(LOOKING NORTH)

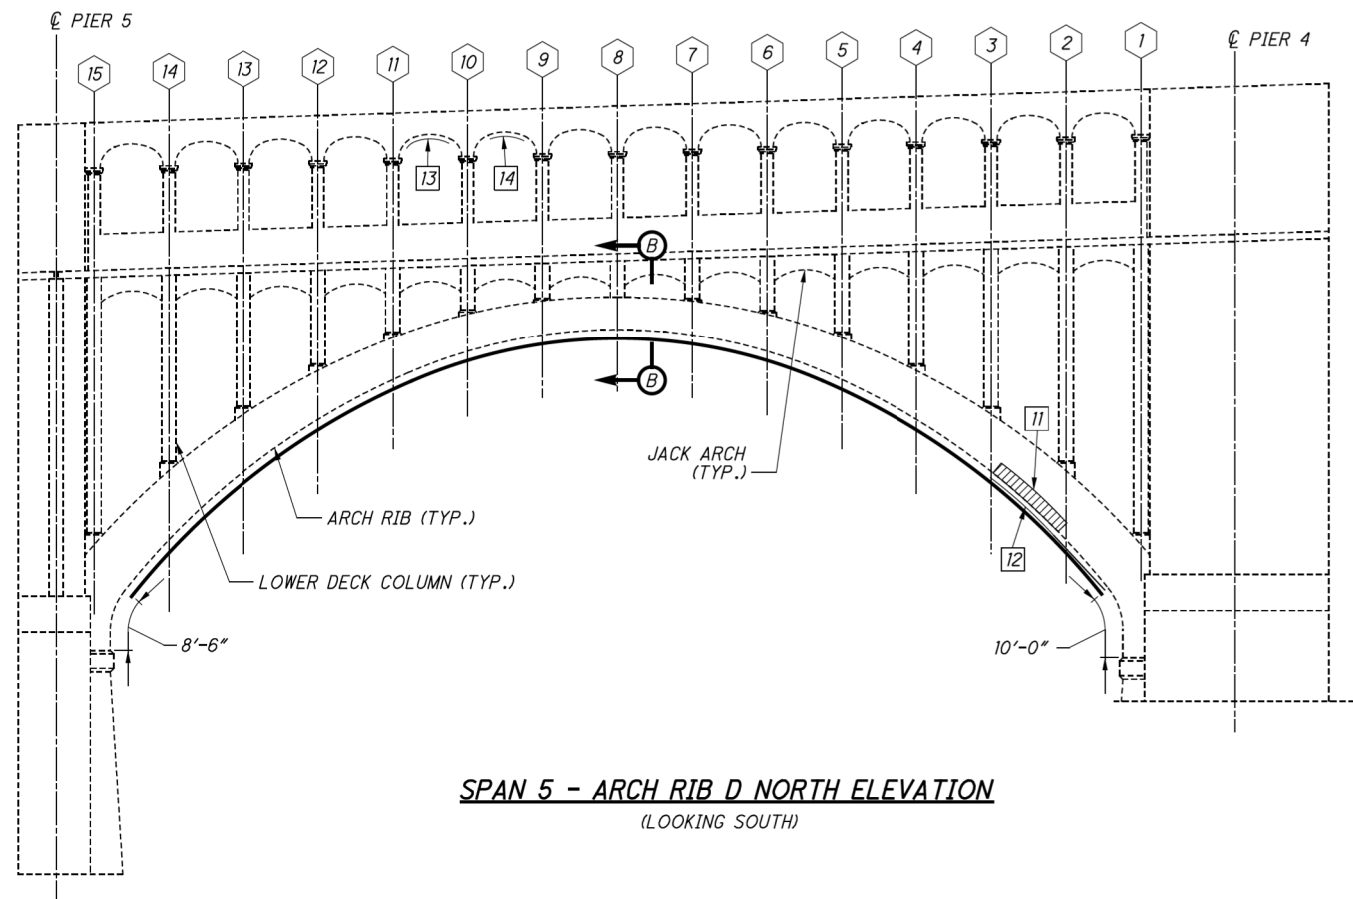

SPAN 5 - ARCH RIB D NORTH ELEVATION
(LOOKING SOUTH)

| ESTIMATED PATCHING QUANTITIES | | | |
|-------------------------------|-------------|-----------|------------------|
| REPAIR NO. | REPAIR TYPE | AREA (SF) | ANODE QUANTITY** |
| 1 | TYPE 1 | 5 | 1 |
| 2 | TYPE 1 | 4 | 1 |
| 3 | TYPE 1 | 12 | 3 |
| 4 | TYPE 1 | 4 | 1 |
| 5 | TYPE 1 | 15 | 6 |
| 6 | TYPE 1 | 4 | 2 |
| 7 | TYPE 1 | 3 | 2 |
| 8 | TYPE 1 | 7 | 2 |
| 9 | TYPE 1 | 9 | 2 |
| 10 | TYPE 1 | 16 | 3 |
| 11 | TYPE 1 | 15 | - |
| 12 | TYPE 1 | 15 | 7 |
| 13 | TYPE 2 | 6 | 4 |
| 14 | TYPE 2 | 5 | 4 |
| MEASURED QUANTITY* | | 120 | - |
| PLAN QUANTITY* | | 180 | 38 |

* SEE NOTES 1 & 2
** SEE NOTES 3 & 4

| SHEET QUANTITY SUMMARY | | |
|------------------------|------|----------|
| ITEM | UNIT | QUANTITY |
| TYPE 1 REPAIR | SF | 164 |
| TYPE 2 REPAIR | SF | 16 |
| FRP WRAP | SF | 1755 |


NOTES:

1. MEASURED QUANTITIES ARE BASED ON THE INSPECTION PERFORMED IN DECEMBER 2016. THE EXACT DIMENSIONS AND LOCATIONS OF PATCHES SHALL BE DETERMINED BY THE ENGINEER IN THE FIELD FOR FINAL PAY QUANTITY.
2. PLAN QUANTITIES INCLUDE 50% CONTINGENCY ADDED TO MEASURED QUANTITIES.
3. ANODES ARE INCLUDED FOR PAYMENT WITH ITEM SPECIAL - PATCHING CONCRETE STRUCTURE, TYPE 1 OR TYPE 2 REPAIR.
4. GALVANIC ANODES WILL NOT BE USED FOR PATCHING THE UNREINFORCED VERTICAL SIDES OF THE CONCRETE ARCH RIBS.
5. FOR DETAILS AND MAXIMUM GRID SPACING FOR EMBEDDED GALVANIC ANODES, SEE SHEET **84/89**.
6. FOR PIER 4 REPAIR DETAILS, SEE SHEET **26/89**. FOR PIER 5 REPAIR DETAILS, SEE SHEET **27/89**.
7. FOR FRP WRAP DETAILS AND SECTION B-B, SEE SHEET **85/89**.

LEGEND:


- SPANDREL COLUMN NUMBER
- REPAIR NUMBER
- LOCATION OF DEFICIENT CONCRETE TO BE REPAIRED IN ACCORDANCE WITH ITEM SPECIAL - PATCHING CONCRETE STRUCTURE, TYPE 1 REPAIR
- LOCATION OF DEFICIENT CONCRETE ON PERPENDICULAR FACE (NOT VISIBLE IN ELEVATION VIEW) TO BE REPAIRED IN ACCORDANCE WITH ITEM SPECIAL - PATCHING CONCRETE STRUCTURE, TYPE 1 OR TYPE 2 REPAIR
- AREA TO BE TREATED WITH FRP WRAP PER ITEM SPECIAL - COMPOSITE FIBER WRAP SYSTEM

| | | | | |
|--------------------------------|--------------------------------|--|---|-----------|
| GRAPHIC SCALE MEASURED IN FEET | DATE | 9902 Carver Road
Suite 201
Cincinnati, OH 45242
PH.: 614.699.5000 | DETROIT-SUPERIOR BRIDGE OVER CUYAHOGA RIVER | |
| | NOV, 2018 | | BRIDGE NO. CUY-6-1465 | |
| NOT TO SCALE | INFRASTRUCTURE ENGINEERS, INC. | | SPAN 5 CONCRETE REPAIR DETAILS | PAGE A-60 |

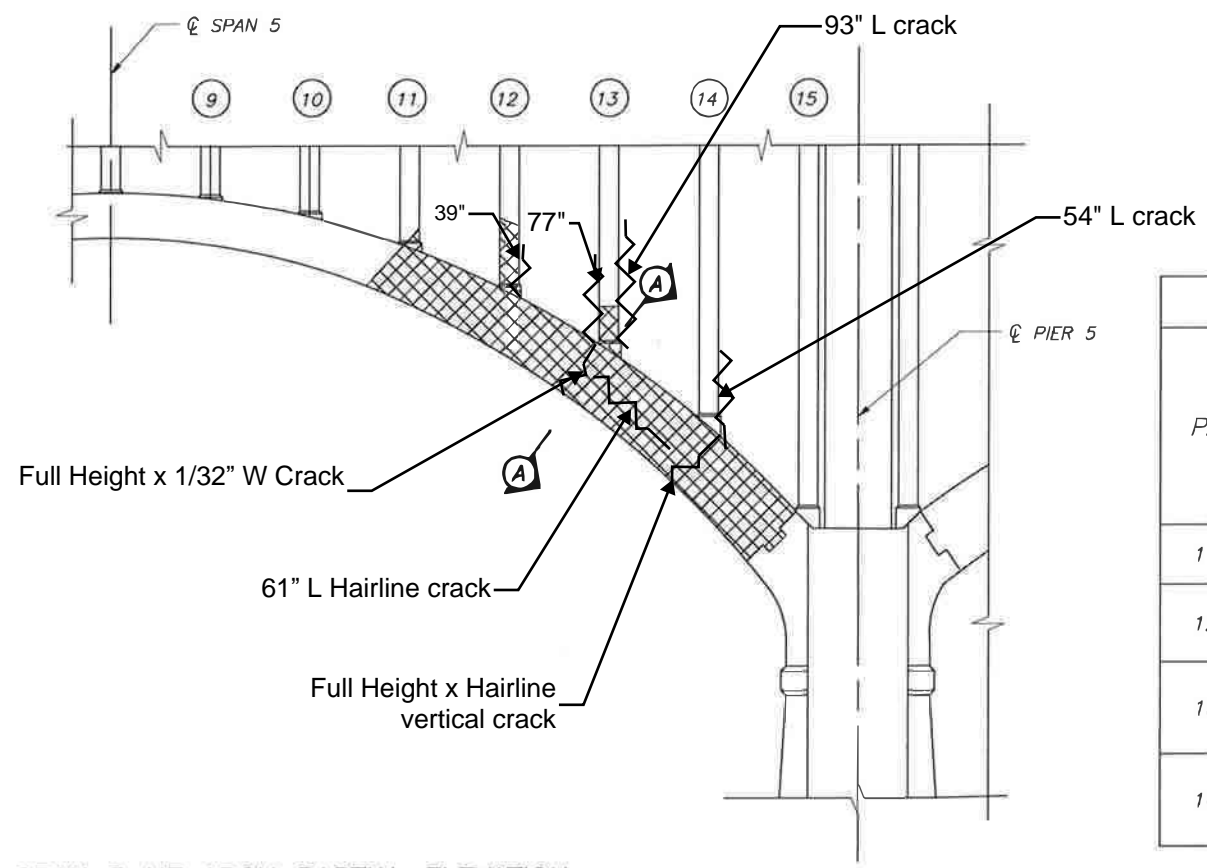


SPAN 5 NE ARCH PARTIAL ELEVATION
LOOKING NORTH

| CRACK MEASUREMENTS | | | | |
|--------------------|----------------------|-----------------------|----------------------|-----------------------|
| PANEL | INTRADOS | | EXTRADOS | |
| | MEASURED CRACK WIDTH | DIST. FROM SOUTH FACE | MEASURED CRACK WIDTH | DIST. FROM SOUTH FACE |
| 11-12 | 43" | 43" | - | - |
| 12-13 | 3/16" | 32.5" | 3/32" | 47.25" |
| 13-14 | 3/16" | 39" | 3/16" | 35" |
| 14-15 | 0.002" | 22.5 | 1/32" | 33" |

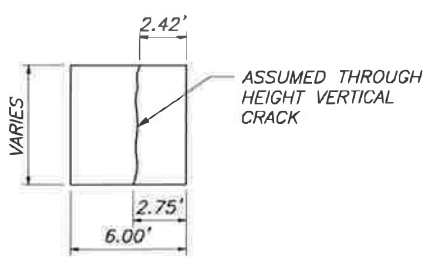

SECTION A-A

LEGEND
 - VERTICAL CRACK LOCATION

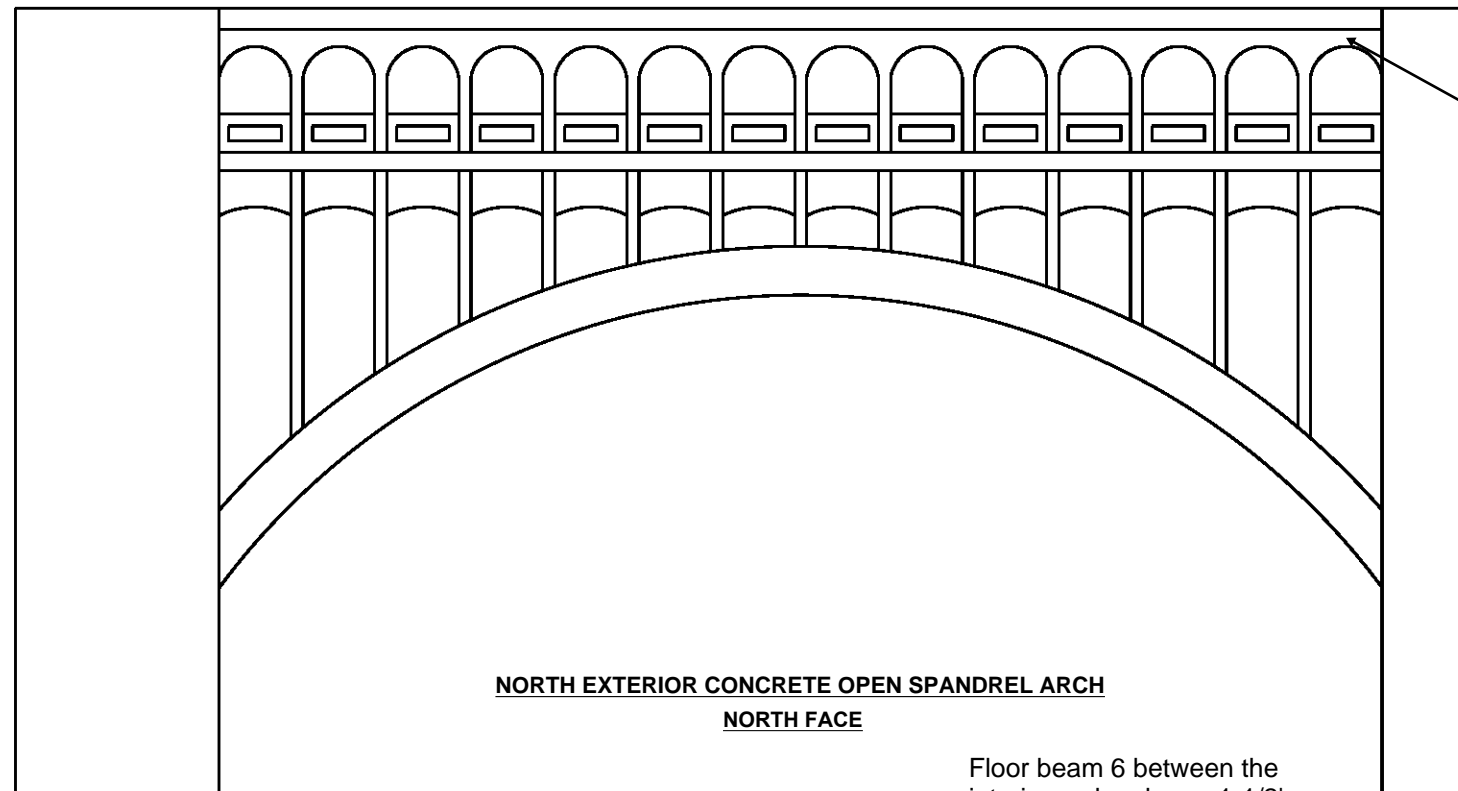


PIER 4

PIER 5

NORTH EXTERIOR CONCRETE OPEN SPANDREL ARCH
NORTH FACE

Longitudinal crack has propagated into the base of several spandrel columns

Floor beam 6 between the interior arches has a 1-1/2' Diameter x 2" D spall with exposed reinforcing on the east face

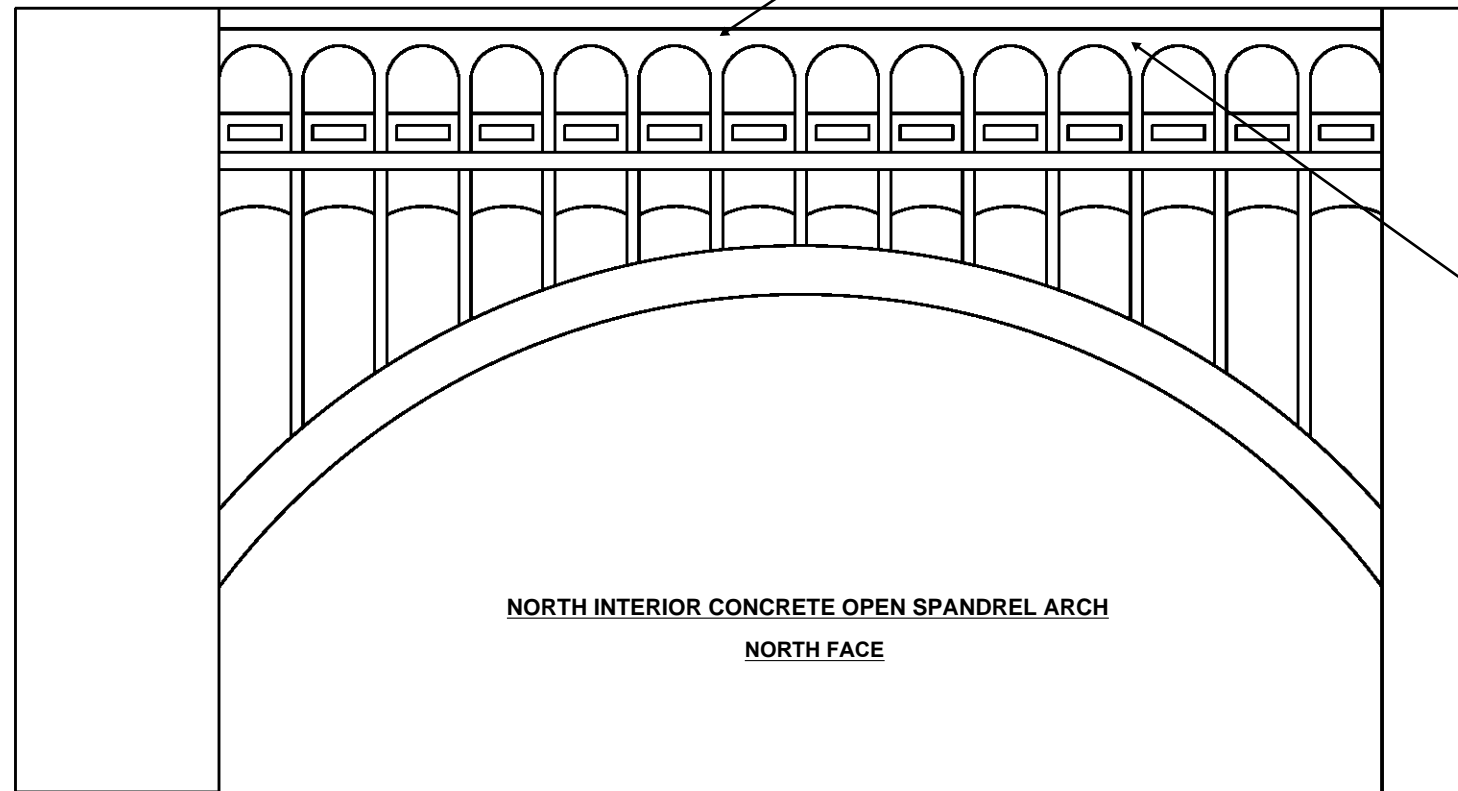


PIER 4

PIER 5


NORTH INTERIOR CONCRETE OPEN SPANDREL ARCH
NORTH FACE

Floor Beam 11 between interior arches has a Full Height x 3' W x 4" D spall with exposed reinforcing on the west face. East face has a 1-1/2' Diameter delamination.

| | | | | |
|--------------------------------|-----------|--|--|------------------------------|
| GRAPHIC SCALE MEASURED IN FEET | DATE |  9902 Carver Road
Suite 201
Cincinnati, OH 45242
PH.: 614.699.5000 | DETROIT-SUPERIOR BRIDGE OVER CUYAHOGA RIVER
BRIDGE NO. CUY-6-1465 | |
| NOT TO SCALE | NOV, 2018 | | INFRASTRUCTURE ENGINEERS, INC. | STRUCTURE ELEVATION - SPAN 5 |

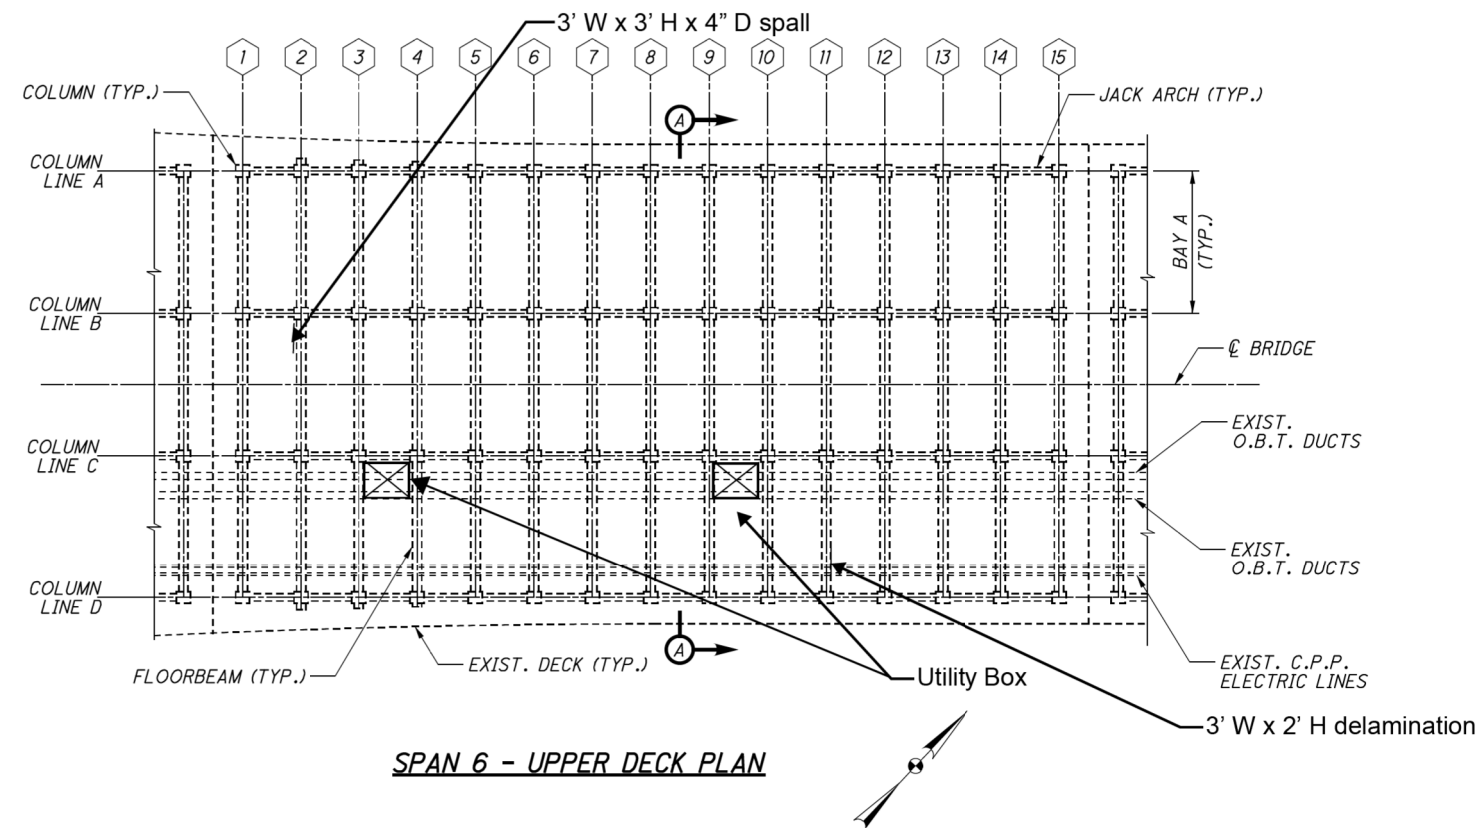

SPAN 6 - UPPER DECK PLAN

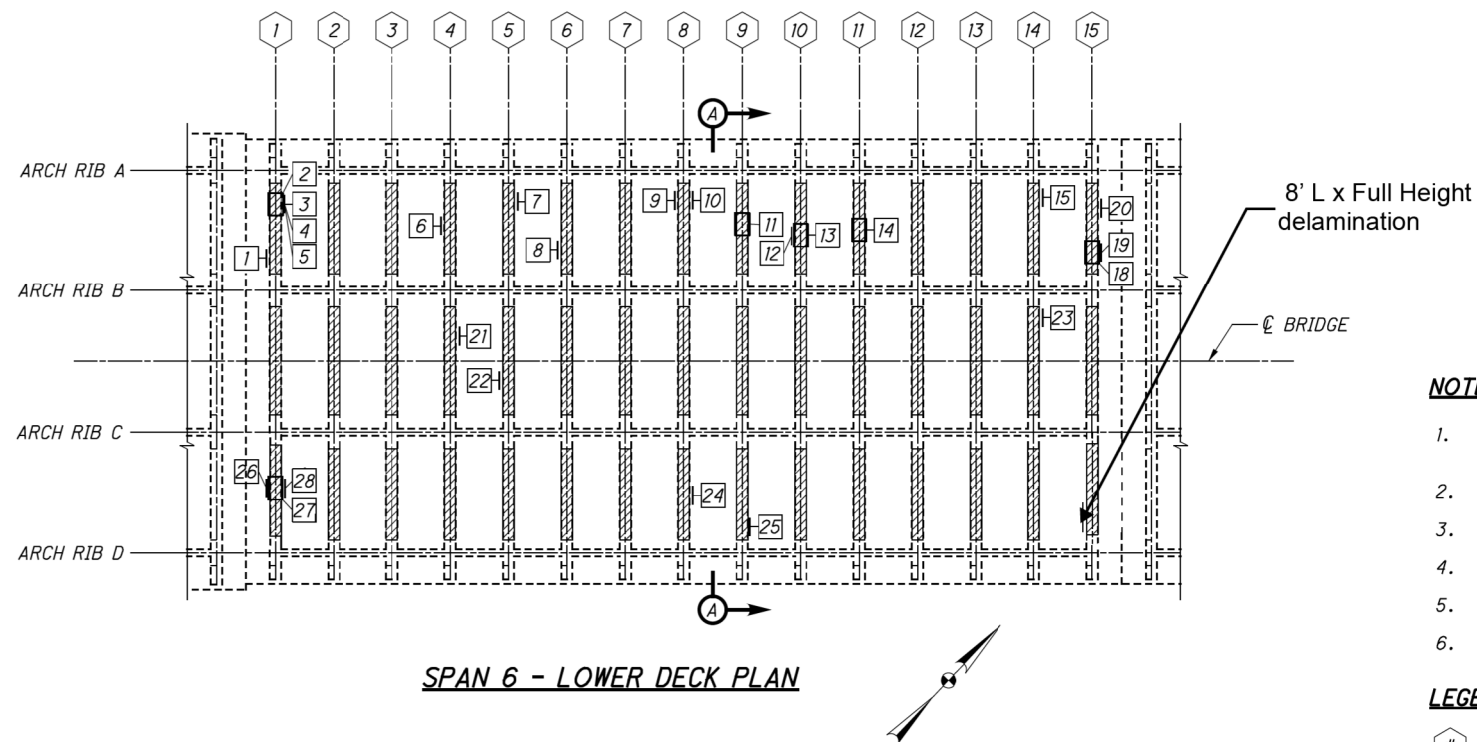

SPAN 6 - LOWER DECK PLAN

| ESTIMATED PATCHING QUANTITIES | | | |
|-------------------------------|-------------|-----------|------------------|
| REPAIR NO. | REPAIR TYPE | AREA (SF) | ANODE QUANTITY** |
| 1 | TYPE 1 | 10 | 3 |
| 2 | TYPE 2 | 11 | 4 |
| 3 | TYPE 1 | 6 | 1 |
| 4 | TYPE 1 | 3 | 1 |
| 5 | TYPE 1 | 3 | 1 |
| 6 | TYPE 1 | 7 | 2 |
| 7 | TYPE 1 | 2 | 1 |
| 8 | TYPE 1 | 1 | 1 |
| 9 | TYPE 1 | 2 | 1 |
| 10 | TYPE 1 | 8 | 2 |
| 11 | TYPE 2 | 7 | 3 |
| 12 | TYPE 1 | 6 | 2 |
| 13 | TYPE 2 | 51 | 20 |
| 14 | TYPE 2 | 7 | 4 |
| 15 | TYPE 1 | 4 | 1 |
| 16 | TYPE 1 | 6 | 5 |
| 17 | TYPE 1 | 21 | 5 |
| 18 | TYPE 2 | 6 | 8 |
| 19 | TYPE 1 | 13 | 4 |
| 20 | TYPE 1 | 12 | 4 |
| 21 | TYPE 1 | 6 | 3 |
| 22 | TYPE 1 | 5 | 1 |
| 23 | TYPE 1 | 6 | 1 |
| 24 | TYPE 1 | 6 | 1 |
| 25 | TYPE 1 | 51 | 12 |
| 26 | TYPE 1 | 26 | 12 |
| 27 | TYPE 2 | 51 | 20 |
| 28 | TYPE 1 | 26 | 12 |
| MEASURED QUANTITY* | | 363 | - |
| PLAN QUANTITY* | | 545 | 135 |

* SEE NOTES 1 & 2
** SEE NOTE 3

| SHEET QUANTITY SUMMARY | | |
|------------------------|------|----------|
| ITEM | UNIT | QUANTITY |
| TYPE 1 REPAIR | SF | 345 |
| TYPE 2 REPAIR | SF | 200 |
| FRP WRAP | SF | 3863 |


NOTES:

- MEASURED QUANTITIES ARE BASED ON THE INSPECTION PERFORMED IN JANUARY 2017. THE EXACT DIMENSIONS AND LOCATIONS OF PATCHES SHALL BE DETERMINED BY THE ENGINEER IN THE FIELD FOR FINAL PAY QUANTITY.
- PLAN QUANTITIES INCLUDE 50% CONTINGENCY ADDED TO MEASURED QUANTITIES.
- ANODES ARE INCLUDED FOR PAYMENT WITH ITEM SPECIAL - PATCHING CONCRETE STRUCTURE, TYPE 1 OR TYPE 2 REPAIR.
- FOR DETAILS AND MAXIMUM GRID SPACING FOR EMBEDDED GALVANIC ANODES, SEE SHEET 84/89.
- FOR SECTION A-A, SEE SHEET 34/89.
- FOR FRP WRAP DETAILS, SEE SHEET 85/89.


LEGEND:

- # FLOORBEAM LINE NUMBER
- # REPAIR NO. OF DEFICIENT CONCRETE TO BE REPAIRED IN ACCORDANCE WITH ITEM SPECIAL - PATCHING CONCRETE STRUCTURE, TYPE 1 OR TYPE 2 REPAIR.
- ▨ AREA TO BE TREATED WITH FRP WRAP PER ITEM SPECIAL - COMPOSITE FIBER WRAP SYSTEM

| | | | | |
|--------------------------------|-----------|--|--|--------------------------------|
| GRAPHIC SCALE MEASURED IN FEET | DATE | 9902 Carver Road
Suite 201
Cincinnati, OH 45242
PH.: 614.699.5000 | DETROIT-SUPERIOR BRIDGE OVER CUYAHOGA RIVER
BRIDGE NO. CUY-6-1465 | |
| NOT TO SCALE | NOV, 2018 | | INFRASTRUCTURE ENGINEERS, INC. | SPAN 6 CONCRETE REPAIR DETAILS |

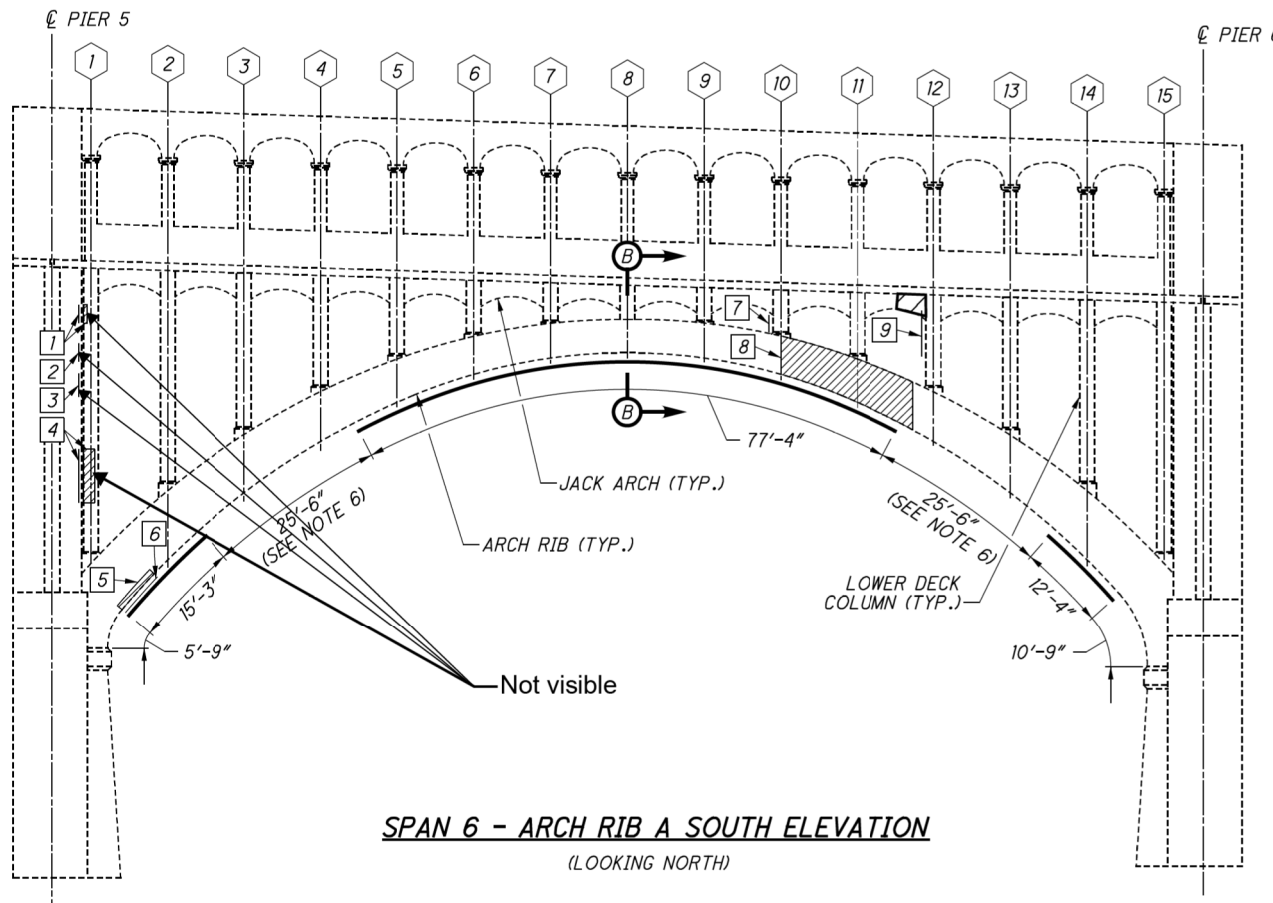

SPAN 6 - ARCH RIB A SOUTH ELEVATION
(LOOKING NORTH)

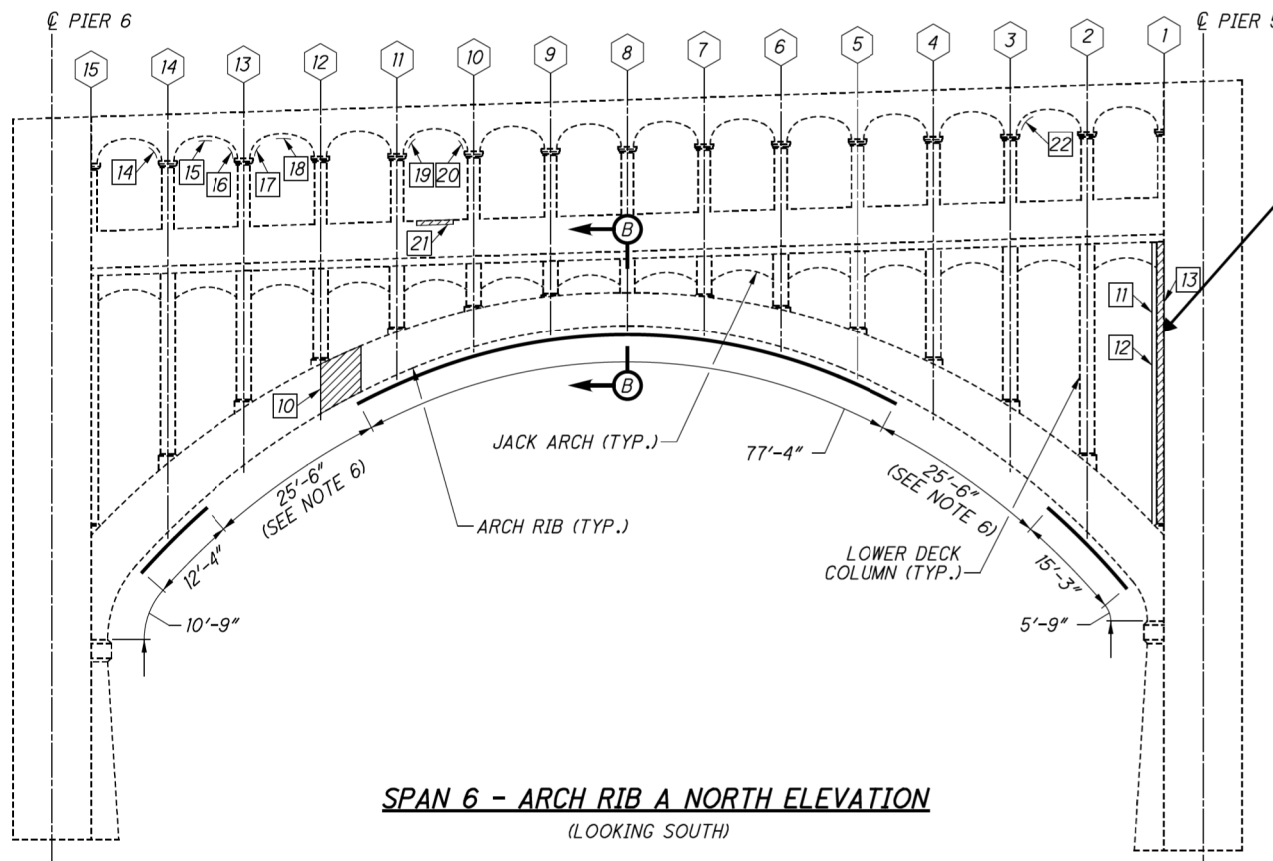

SPAN 6 - ARCH RIB A NORTH ELEVATION
(LOOKING SOUTH)

| ESTIMATED PATCHING QUANTITIES | | | |
|-------------------------------|-------------|-----------|------------------|
| REPAIR NO. | REPAIR TYPE | AREA (SF) | ANODE QUANTITY** |
| 1 | TYPE 1 | 2 | 1 |
| 2 | TYPE 1 | 2 | 1 |
| 3 | TYPE 1 | 4 | 1 |
| 4 | TYPE 1 | 13 | 3 |
| 5 | TYPE 1 | 4 | - |
| 6 | TYPE 2 | 4 | 3 |
| 7 | TYPE 1 | 4 | 1 |
| 8 | TYPE 1 | 68 | - |
| 9 | TYPE 1 | 15 | 6 |
| 10 | TYPE 1 | 20 | - |
| 11 | TYPE 1 | 104 | 30 |
| 12 | TYPE 1 | 8 | 2 |
| 13 | TYPE 1 | 26 | 15 |

| ESTIMATED PATCHING QUANTITIES | | | |
|-------------------------------|-------------|-----------|------------------|
| REPAIR NO. | REPAIR TYPE | AREA (SF) | ANODE QUANTITY** |
| 14 | TYPE 2 | 2 | 1 |
| 15 | TYPE 2 | 1 | 1 |
| 16 | TYPE 2 | 1 | 1 |
| 17 | TYPE 2 | 1 | 1 |
| 18 | TYPE 2 | 1 | 1 |
| 19 | TYPE 2 | 1 | 1 |
| 20 | TYPE 2 | 1 | 1 |
| 21 | TYPE 1 | 2 | 3 |
| 22 | TYPE 2 | 2 | 1 |
| MEASURED QUANTITY* | | 286 | - |
| PLAN QUANTITY* | | 429 | 74 |

* SEE NOTES 1 & 2
** SEE NOTES 3 & 4

| SHEET QUANTITY SUMMARY | | |
|------------------------|------|----------|
| ITEM | UNIT | QUANTITY |
| TYPE 1 REPAIR | SF | 408 |
| TYPE 2 REPAIR | SF | 21 |
| FRP WRAP | SF | 1154 |

Defect not Found, does not appear to be spalled


NOTES:

- MEASURED QUANTITIES ARE BASED ON THE INSPECTION PERFORMED IN JANUARY 2017. THE EXACT DIMENSIONS AND LOCATIONS OF PATCHES SHALL BE DETERMINED BY THE ENGINEER IN THE FIELD FOR FINAL PAY QUANTITY.
- PLAN QUANTITIES INCLUDE 50% CONTINGENCY ADDED TO MEASURED QUANTITIES.
- ANODES ARE INCLUDED FOR PAYMENT WITH ITEM SPECIAL - PATCHING CONCRETE STRUCTURE, TYPE 1 OR TYPE 2 REPAIR.
- GALVANIC ANODES WILL NOT BE USED FOR PATCHING THE UNREINFORCED VERTICAL SIDES OF THE CONCRETE ARCH RIBS.
- FOR DETAILS AND MAXIMUM GRID SPACING FOR EMBEDDED GALVANIC ANODES, SEE SHEET [84/89].
- FRP WRAP WILL NOT BE USED FOR WRAPPING THE UNREINFORCED SECTIONS OF THE CONCRETE ARCH RIBS.
- FOR PIER 5 AND PIER 6 REPAIR DETAILS, SEE SHEET [27/89].
- FOR FRP WRAP DETAILS AND SECTION B-B, SEE SHEET [85/89].


LEGEND:

- # SPANDREL COLUMN NUMBER
- # REPAIR NUMBER
- ▨ LOCATION OF DEFICIENT CONCRETE TO BE REPAIRED IN ACCORDANCE WITH ITEM SPECIAL - PATCHING CONCRETE STRUCTURE, TYPE 1 REPAIR
- ⋮ LOCATION OF DEFICIENT CONCRETE ON PERPENDICULAR FACE (NOT VISIBLE IN ELEVATION VIEW) TO BE REPAIRED IN ACCORDANCE WITH ITEM SPECIAL - PATCHING CONCRETE STRUCTURE, TYPE 1 OR TYPE 2 REPAIR
- AREA TO BE TREATED WITH FRP WRAP PER ITEM SPECIAL - COMPOSITE FIBER WRAP SYSTEM

| | | | | |
|--------------------------------|-----------|--|--|--------------------------------|
| GRAPHIC SCALE MEASURED IN FEET | DATE |  9902 Carver Road
Suite 201
Cincinnati, OH 45242
PH.: 614.699.5000 | DETROIT-SUPERIOR BRIDGE OVER CUYAHOGA RIVER
BRIDGE NO. CUY-6-1465 | |
| NOT TO SCALE | NOV, 2018 | | INFRASTRUCTURE ENGINEERS, INC. | SPAN 6 CONCRETE REPAIR DETAILS |

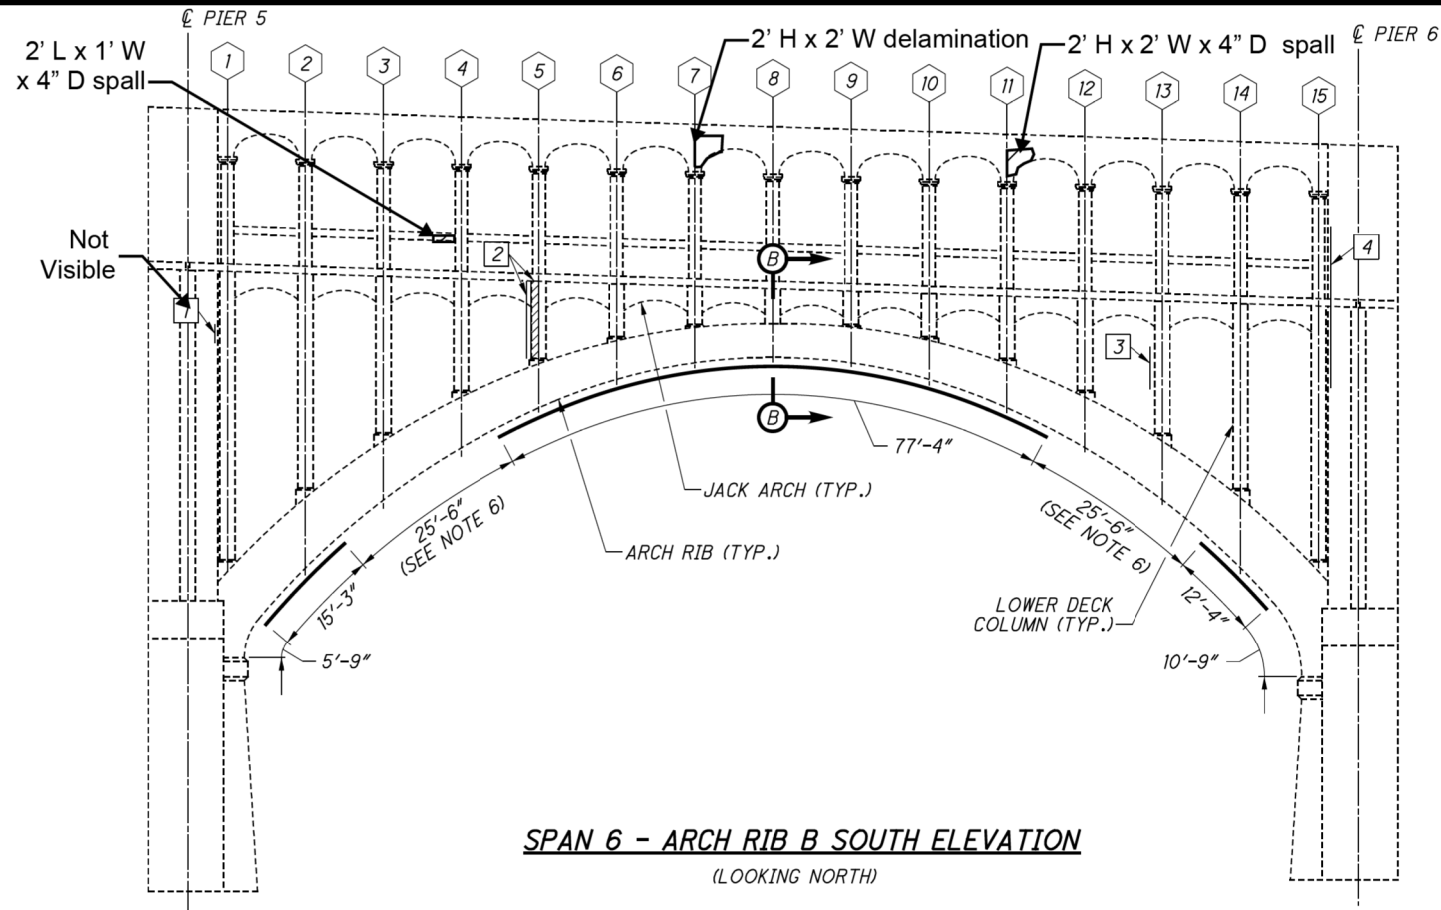

SPAN 6 - ARCH RIB B SOUTH ELEVATION
(LOOKING NORTH)

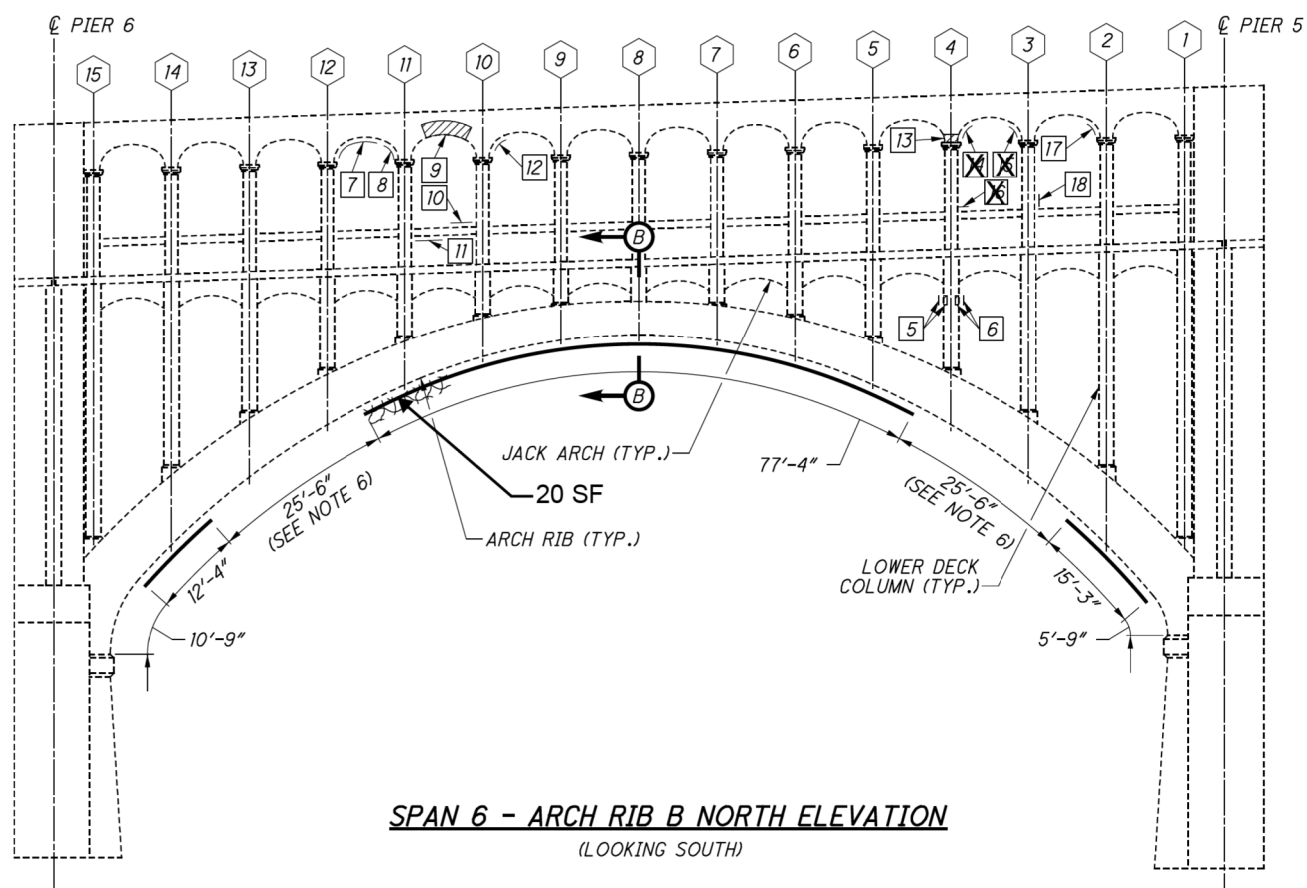

SPAN 6 - ARCH RIB B NORTH ELEVATION
(LOOKING SOUTH)

| ESTIMATED PATCHING QUANTITIES | | | |
|-------------------------------|-------------|-----------|------------------|
| REPAIR NO. | REPAIR TYPE | AREA (SF) | ANODE QUANTITY** |
| 1 | TYPE 1 | 2 | 1 |
| 2 | TYPE 1 | 17 | 5 |
| 3 | TYPE 1 | 16 | 4 |
| 4 | TYPE 1 | 35 | 9 |
| 5 | TYPE 1 | 1 | 1 |
| 6 | TYPE 1 | 1 | 1 |
| 7 | TYPE 2 | 16 | 6 |
| 8 | TYPE 2 | 8 | 3 |
| 9 | TYPE 1 | 6 | 2 |
| 10 | TYPE 1 | 3 | 2 |

| ESTIMATED PATCHING QUANTITIES | | | |
|-------------------------------|-------------|-----------|------------------|
| REPAIR NO. | REPAIR TYPE | AREA (SF) | ANODE QUANTITY** |
| 11 | TYPE 2 | 3 | 2 |
| 12 | TYPE 2 | 1 | 1 |
| 13 | TYPE 1 | 2 | 1 |
| 14 | TYPE 2 | 3 | 2 |
| 15 | TYPE 2 | 2 | 1 |
| 16 | TYPE 1 | 1 | 1 |
| 17 | TYPE 2 | 3 | 2 |
| 18 | TYPE 1 | 1 | 1 |
| MEASURED QUANTITY* | | 121 | - |
| PLAN QUANTITY* | | 182 | 45 |

* SEE NOTES 1 & 2
** SEE NOTES 3 & 4

| SHEET QUANTITY SUMMARY | | |
|------------------------|------|----------|
| ITEM | UNIT | QUANTITY |
| TYPE 1 REPAIR | SF | 128 |
| TYPE 2 REPAIR | SF | 54 |
| FRP WRAP | SF | 1364 |


NOTES:

- MEASURED QUANTITIES ARE BASED ON THE INSPECTION PERFORMED IN JANUARY 2017. THE EXACT DIMENSIONS AND LOCATIONS OF PATCHES SHALL BE DETERMINED BY THE ENGINEER IN THE FIELD FOR FINAL PAY QUANTITY.
- PLAN QUANTITIES INCLUDE 50% CONTINGENCY ADDED TO MEASURED QUANTITIES.
- ANODES ARE INCLUDED FOR PAYMENT WITH ITEM SPECIAL - PATCHING CONCRETE STRUCTURE, TYPE 1 OR TYPE 2 REPAIR.
- GALVANIC ANODES WILL NOT BE USED FOR PATCHING THE UNREINFORCED VERTICAL SIDES OF THE CONCRETE ARCH RIBS.
- FOR DETAILS AND MAXIMUM GRID SPACING FOR EMBEDDED GALVANIC ANODES, SEE SHEET [84/89].
- FRP WRAP WILL NOT BE USED FOR WRAPPING THE UNREINFORCED SECTIONS OF THE CONCRETE ARCH RIBS.
- FOR PIER 5 AND PIER 6 REPAIR DETAILS, SEE SHEET [27/89].
- FOR FRP WRAP DETAILS AND SECTION B-B, SEE SHEET [85/89].


LEGEND:

- # SPANDREL COLUMN NUMBER
- # REPAIR NUMBER
- ▨ LOCATION OF DEFICIENT CONCRETE TO BE REPAIRED IN ACCORDANCE WITH ITEM SPECIAL - PATCHING CONCRETE STRUCTURE, TYPE 1 REPAIR
- ▤ LOCATION OF DEFICIENT CONCRETE ON PERPENDICULAR FACE (NOT VISIBLE IN ELEVATION VIEW) TO BE REPAIRED IN ACCORDANCE WITH ITEM SPECIAL - PATCHING CONCRETE STRUCTURE, TYPE 1 OR TYPE 2 REPAIR
- AREA TO BE TREATED WITH FRP WRAP PER ITEM SPECIAL - COMPOSITE FIBER WRAP SYSTEM

| | | | | |
|--------------------------------|-----------|--|--|--------------------------------|
| GRAPHIC SCALE MEASURED IN FEET | DATE |  9902 Carver Road
Suite 201
Cincinnati, OH 45242
PH.: 614.699.5000 | DETROIT-SUPERIOR BRIDGE OVER CUYAHOGA RIVER
BRIDGE NO. CUY-6-1465 | |
| NOT TO SCALE | NOV, 2018 | | INFRASTRUCTURE ENGINEERS, INC. | SPAN 6 CONCRETE REPAIR DETAILS |

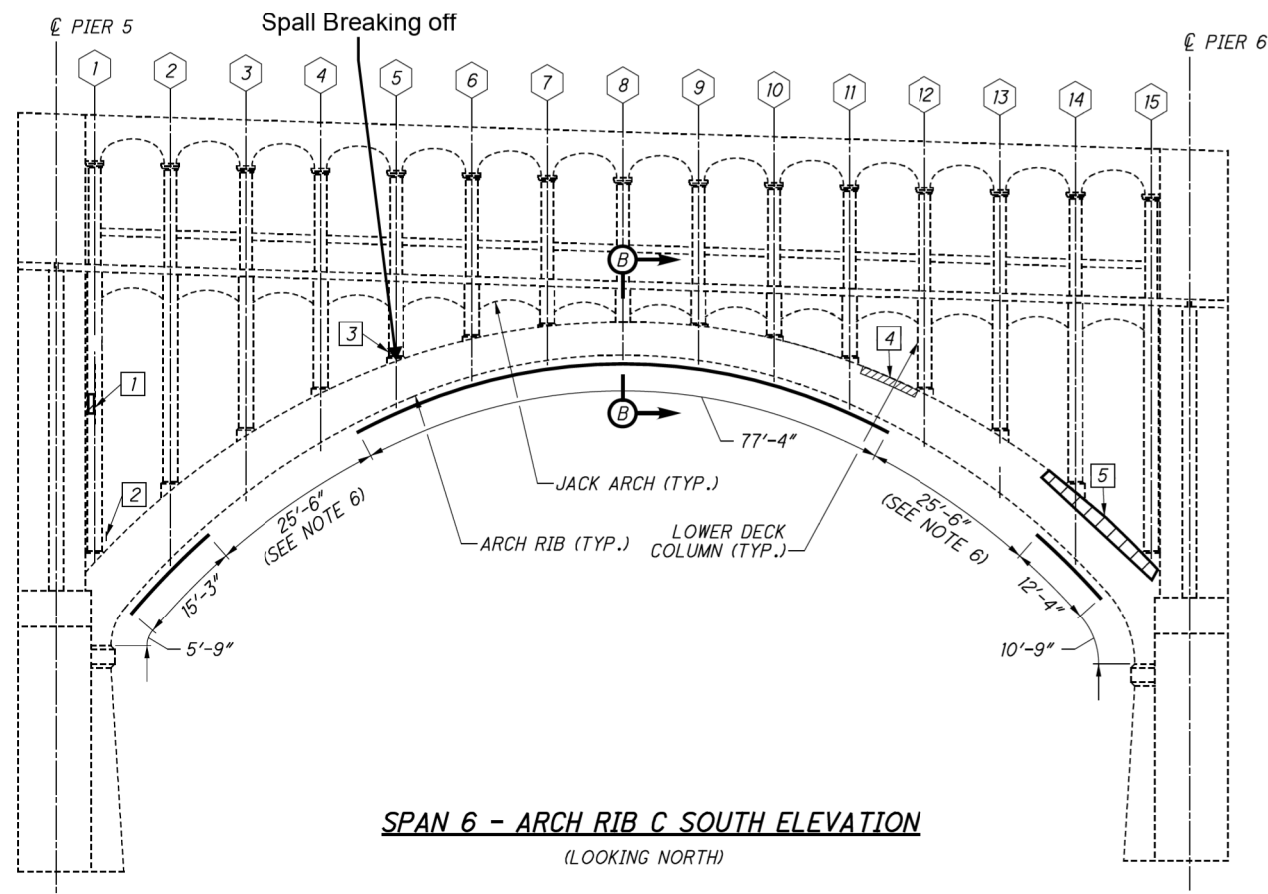

SPAN 6 - ARCH RIB C SOUTH ELEVATION
(LOOKING NORTH)

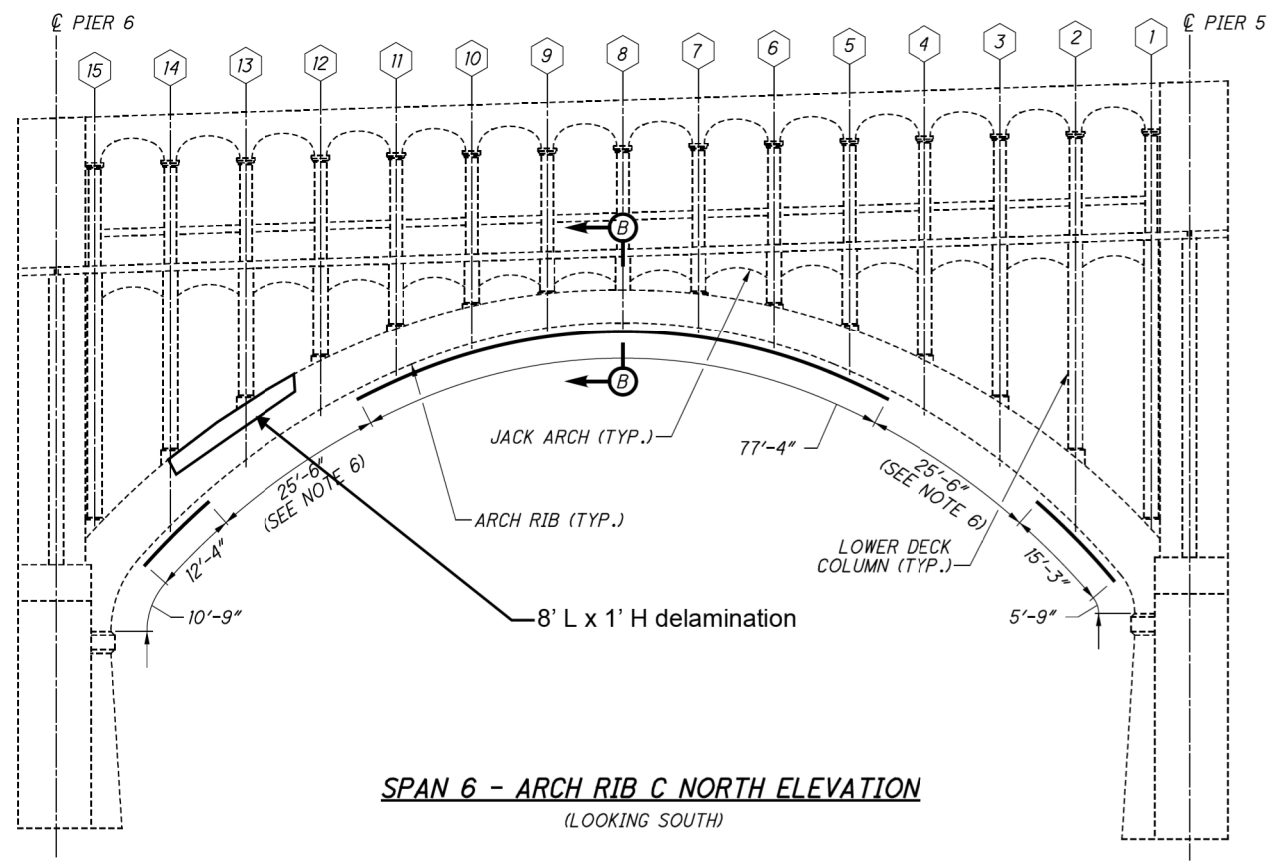

SPAN 6 - ARCH RIB C NORTH ELEVATION
(LOOKING SOUTH)

| ESTIMATED PATCHING QUANTITIES | | | |
|-------------------------------|-------------|-----------|------------------|
| REPAIR NO. | REPAIR TYPE | AREA (SF) | ANODE QUANTITY** |
| 1 | TYPE 1 | 1 | 1 |
| 2 | TYPE 1 | 1 | 1 |
| 3 | TYPE 1 | 1 | 1 |
| 4 | TYPE 1 | 5 | - |
| 5 | TYPE 1 | 10 | - |
| MEASURED QUANTITY* | | 18 | - |
| PLAN QUANTITY* | | 27 | 3 |

* SEE NOTES 1 & 2
** SEE NOTES 3 & 4

| SHEET QUANTITY SUMMARY | | |
|------------------------|------|----------|
| ITEM | UNIT | QUANTITY |
| TYPE 1 REPAIR | SF | 27 |
| TYPE 2 REPAIR | SF | - |
| FRP WRAP | SF | 1364 |


NOTES:

- MEASURED QUANTITIES ARE BASED ON THE INSPECTION PERFORMED IN DECEMBER 2016. THE EXACT DIMENSIONS AND LOCATIONS OF PATCHES SHALL BE DETERMINED BY THE ENGINEER IN THE FIELD FOR FINAL PAY QUANTITY.
- PLAN QUANTITIES INCLUDE 50% CONTINGENCY ADDED TO MEASURED QUANTITIES.
- ANODES ARE INCLUDED FOR PAYMENT WITH ITEM SPECIAL - PATCHING CONCRETE STRUCTURE, TYPE 1 OR TYPE 2 REPAIR.
- GALVANIC ANODES WILL NOT BE USED FOR PATCHING THE UNREINFORCED VERTICAL SIDES OF THE CONCRETE ARCH RIBS.
- FOR DETAILS AND MAXIMUM GRID SPACING FOR EMBEDDED GALVANIC ANODES, SEE SHEET [84/89].
- FRP WRAP WILL NOT BE USED FOR WRAPPING THE UNREINFORCED SECTIONS OF THE CONCRETE ARCH RIBS.
- FOR PIER 5 AND PIER 6 REPAIR DETAILS, SEE SHEET [27/89].
- FOR FRP WRAP DETAILS AND SECTION B-B, SEE SHEET [85/89].


LEGEND:

- SPANDREL COLUMN NUMBER
- REPAIR NUMBER
- LOCATION OF DEFICIENT CONCRETE TO BE REPAIRED IN ACCORDANCE WITH ITEM SPECIAL - PATCHING CONCRETE STRUCTURE, TYPE 1 REPAIR
- LOCATION OF DEFICIENT CONCRETE ON PERPENDICULAR FACE (NOT VISIBLE IN ELEVATION VIEW) TO BE REPAIRED IN ACCORDANCE WITH ITEM SPECIAL - PATCHING CONCRETE STRUCTURE, TYPE 1 OR TYPE 2 REPAIR
- AREA TO BE TREATED WITH FRP WRAP PER ITEM SPECIAL - COMPOSITE FIBER WRAP SYSTEM

| | | | | |
|--------------------------------|--------------|--|--|--------------------------------|
| GRAPHIC SCALE MEASURED IN FEET | DATE | 9902 Carver Road
Suite 201
Cincinnati, OH 45242
PH.: 614.699.5000 | DETROIT-SUPERIOR BRIDGE OVER CUYAHOGA RIVER
BRIDGE NO. CUY-6-1465 | |
| | NOT TO SCALE | | NOV, 2018 | INFRASTRUCTURE ENGINEERS, INC. |
| | | | | PAGE A-66 |

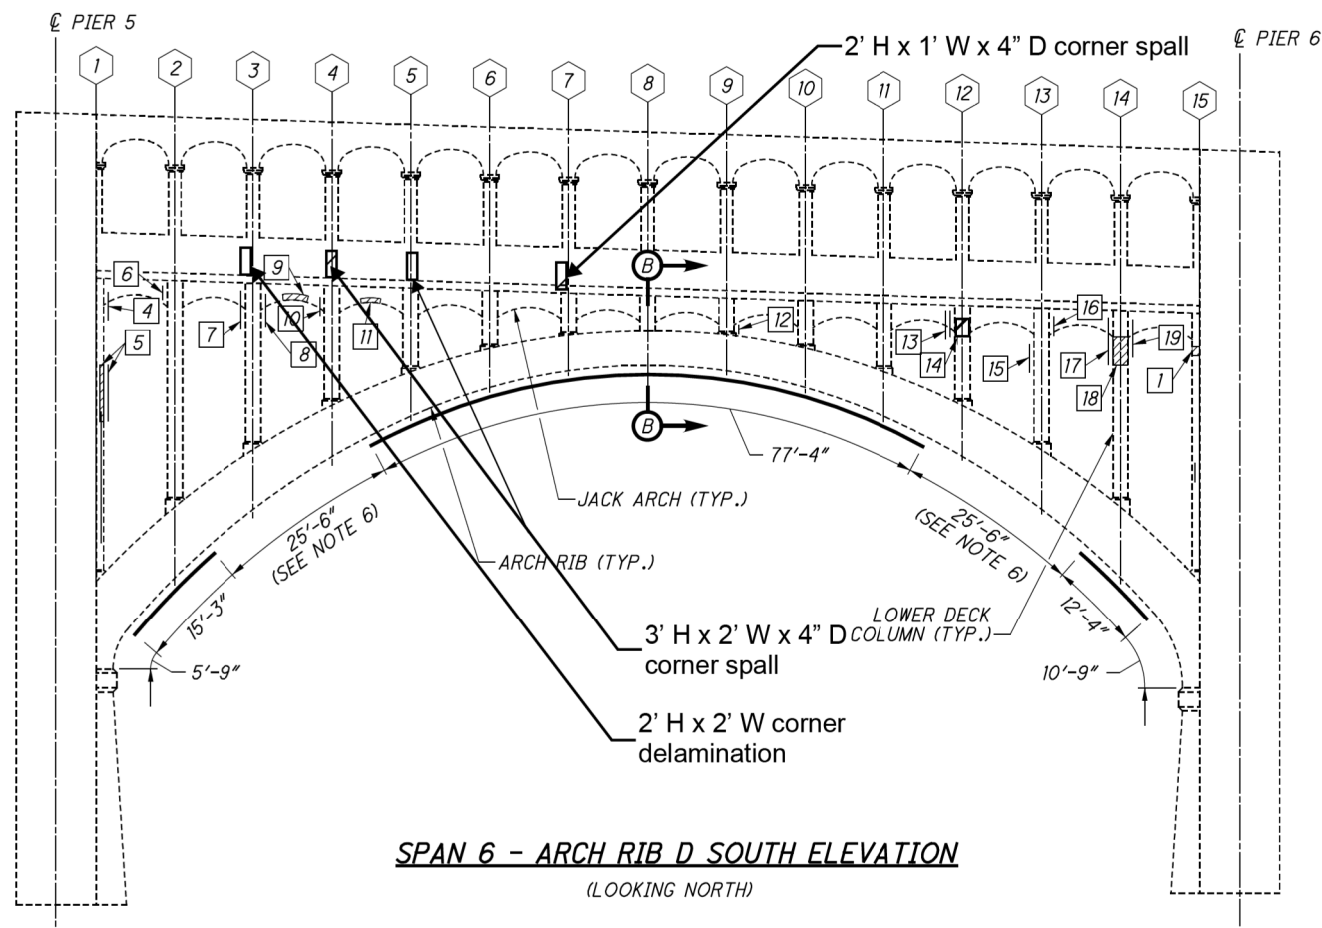

SPAN 6 - ARCH RIB D SOUTH ELEVATION
(LOOKING NORTH)

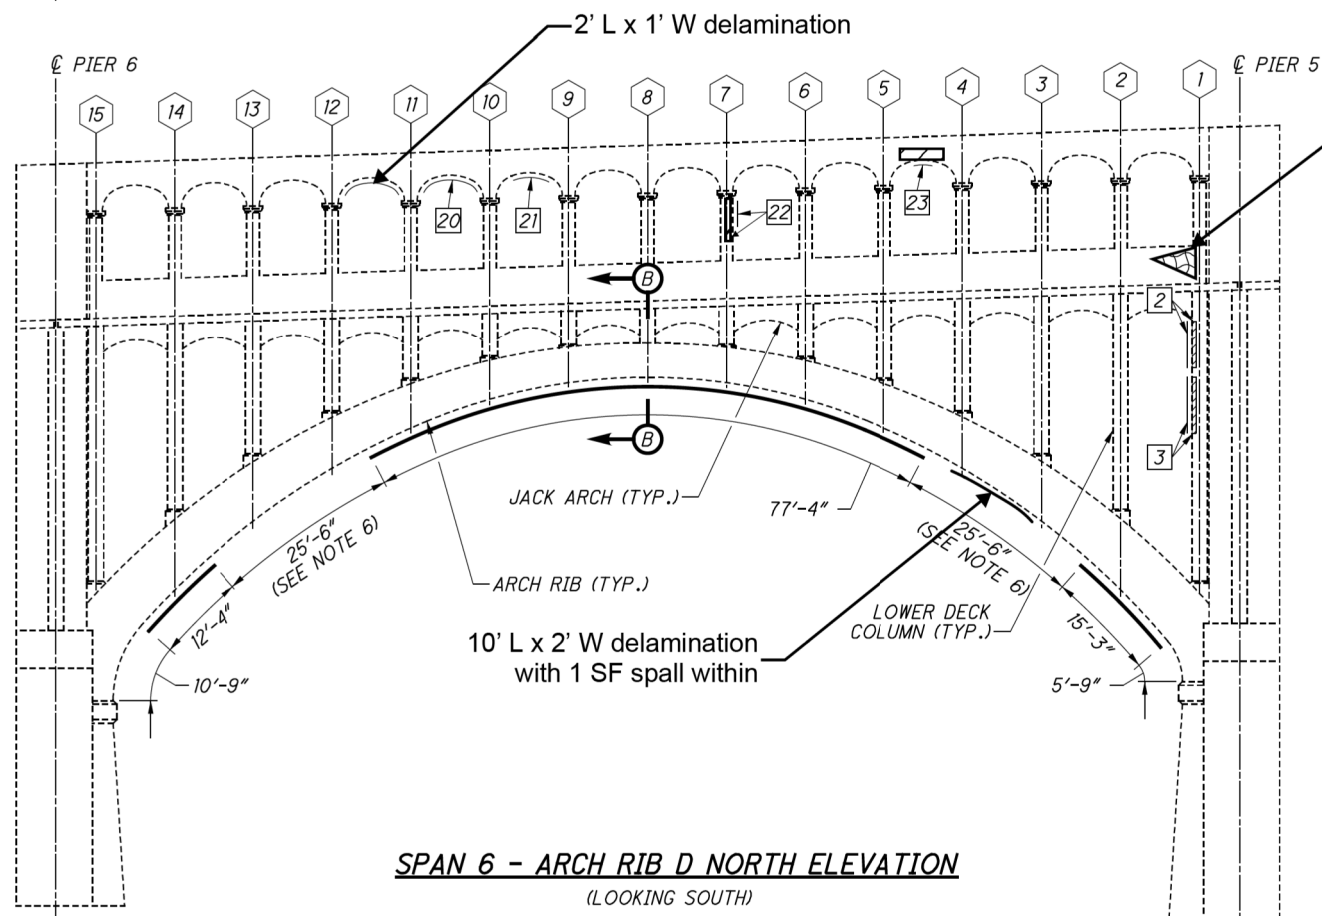

SPAN 6 - ARCH RIB D NORTH ELEVATION
(LOOKING SOUTH)

| ESTIMATED PATCHING QUANTITIES | | | |
|-------------------------------|-------------|-----------|------------------|
| REPAIR NO. | REPAIR TYPE | AREA (SF) | ANODE QUANTITY** |
| 1 | TYPE 1 | 1 | 2 |
| 2 | TYPE 1 | 6 | 3 |
| 3 | TYPE 1 | 6 | 1 |
| 4 | TYPE 1 | 3 | 4 |
| 5 | TYPE 1 | 14 | 4 |
| 6 | TYPE 1 | 14 | 2 |
| 7 | TYPE 1 | 2 | 1 |
| 8 | TYPE 1 | 4 | 2 |
| 9 | TYPE 1 | 1 | 1 |
| 10 | TYPE 1 | 1 | 4 |
| 11 | TYPE 1 | 9 | 2 |
| 12 | TYPE 1 | 8 | 2 |

| ESTIMATED PATCHING QUANTITIES | | | |
|-------------------------------|-------------|-----------|------------------|
| REPAIR NO. | REPAIR TYPE | AREA (SF) | ANODE QUANTITY** |
| 13 | TYPE 1 | 4 | 1 |
| 14 | TYPE 1 | 10 | 3 |
| 15 | TYPE 1 | 6 | 2 |
| 16 | TYPE 1 | 8 | 2 |
| 17 | TYPE 1 | 1 | 1 |
| 18 | TYPE 1 | 5 | 3 |
| 19 | TYPE 1 | 6 | 3 |
| 20 | TYPE 2 | 10 | 7 |
| 21 | TYPE 2 | 4 | 3 |
| 22 | TYPE 1 | 5 | 4 |
| 23 | TYPE 2 | 2 | 1 |
| MEASURED QUANTITY* | | 132 | - |
| PLAN QUANTITY* | | 198 | 58 |

* SEE NOTES 1 & 2
** SEE NOTES 3 & 4

| SHEET QUANTITY SUMMARY | | |
|------------------------|------|----------|
| ITEM | UNIT | QUANTITY |
| TYPE 1 REPAIR | SF | 174 |
| TYPE 2 REPAIR | SF | 24 |
| FRP WRAP | SF | 1154 |

Cracking and delamination



NOTES:

- MEASURED QUANTITIES ARE BASED ON THE INSPECTION PERFORMED IN DECEMBER 2016. THE EXACT DIMENSIONS AND LOCATIONS OF PATCHES SHALL BE DETERMINED BY THE ENGINEER IN THE FIELD FOR FINAL PAY QUANTITY.
- PLAN QUANTITIES INCLUDE 50% CONTINGENCY ADDED TO MEASURED QUANTITIES.
- ANODES ARE INCLUDED FOR PAYMENT WITH ITEM SPECIAL - PATCHING CONCRETE STRUCTURE, TYPE 1 OR TYPE 2 REPAIR.
- GALVANIC ANODES WILL NOT BE USED FOR PATCHING THE UNREINFORCED VERTICAL SIDES OF THE CONCRETE ARCH RIBS.
- FOR DETAILS AND MAXIMUM GRID SPACING FOR EMBEDDED GALVANIC ANODES, SEE SHEET **84/89**.
- FRP WRAP WILL NOT BE USED FOR WRAPPING THE UNREINFORCED SECTIONS OF THE CONCRETE ARCH RIBS.
- FOR PIER 5 AND PIER 6 REPAIR DETAILS, SEE SHEET **27/89**.
- FOR FRP WRAP DETAILS AND SECTION B-B, SEE SHEET **85/89**.



LEGEND:

- # SPANDREL COLUMN NUMBER
- # REPAIR NUMBER
- ▨ LOCATION OF DEFICIENT CONCRETE TO BE REPAIRED IN ACCORDANCE WITH ITEM SPECIAL - PATCHING CONCRETE STRUCTURE, TYPE 1 REPAIR
- ▨ LOCATION OF DEFICIENT CONCRETE ON PERPENDICULAR FACE (NOT VISIBLE IN ELEVATION VIEW) TO BE REPAIRED IN ACCORDANCE WITH ITEM SPECIAL - PATCHING CONCRETE STRUCTURE, TYPE 1 OR TYPE 2 REPAIR
- AREA TO BE TREATED WITH FRP WRAP PER ITEM SPECIAL - COMPOSITE FIBER WRAP SYSTEM


| | | | | |
|--------------------------------|-----------|--|--|--------------------------------|
| GRAPHIC SCALE MEASURED IN FEET | DATE |  9902 Carver Road
Suite 201
Cincinnati, OH 45242
PH.: 614.699.5000 | DETROIT-SUPERIOR BRIDGE OVER CUYAHOGA RIVER
BRIDGE NO. CUY-6-1465 | |
| NOT TO SCALE | NOV, 2018 | | INFRASTRUCTURE ENGINEERS, INC. | SPAN 6 CONCRETE REPAIR DETAILS |

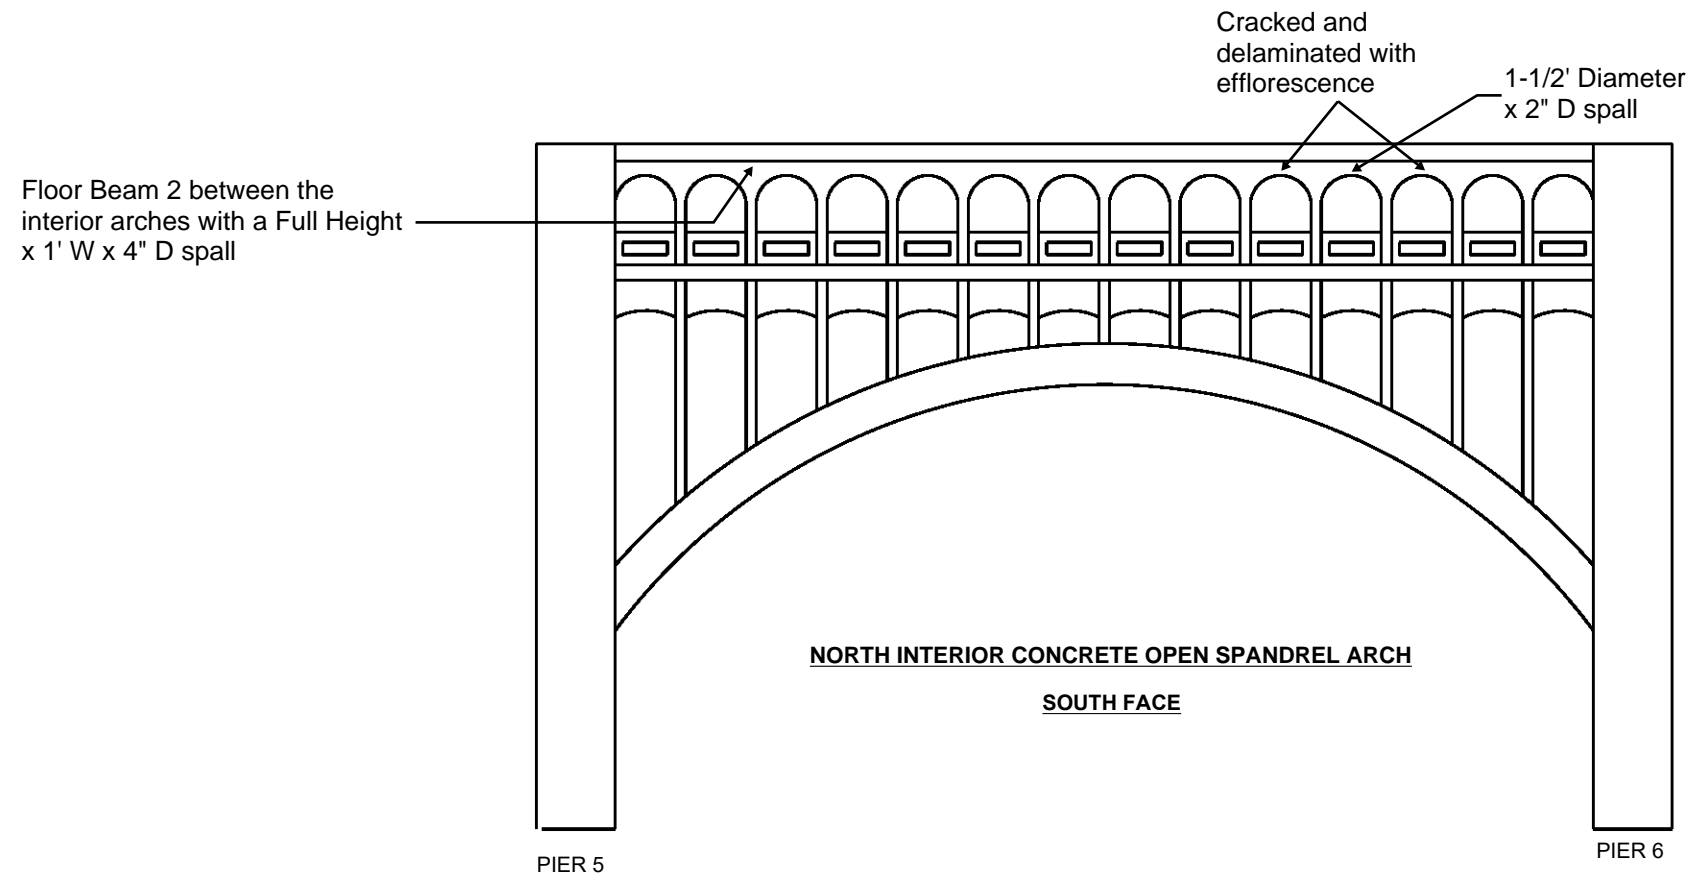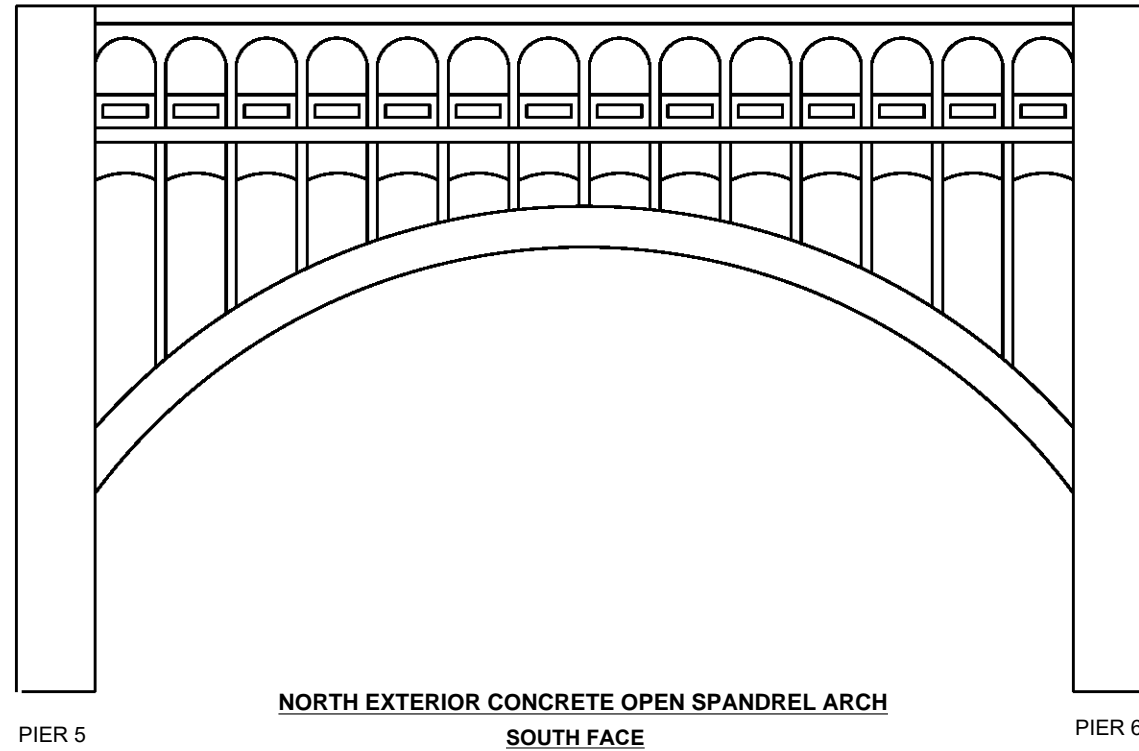

| | | | | | |
|--------------------------------|-----------|---|--|--|--|
| GRAPHIC SCALE MEASURED IN FEET | DATE |  | 9902 Carver Road
Suite 201
Cincinnati, OH 45242
PH.: 614.699.5000 | DETROIT-SUPERIOR BRIDGE OVER CUYAHOGA RIVER
BRIDGE NO. CUY-6-1465 | |
| NOT TO SCALE | NOV, 2018 | INFRASTRUCTURE
ENGINEERS, INC. | STRUCTURE ELEVATION - SPAN 6 | PAGE
A-68 | |

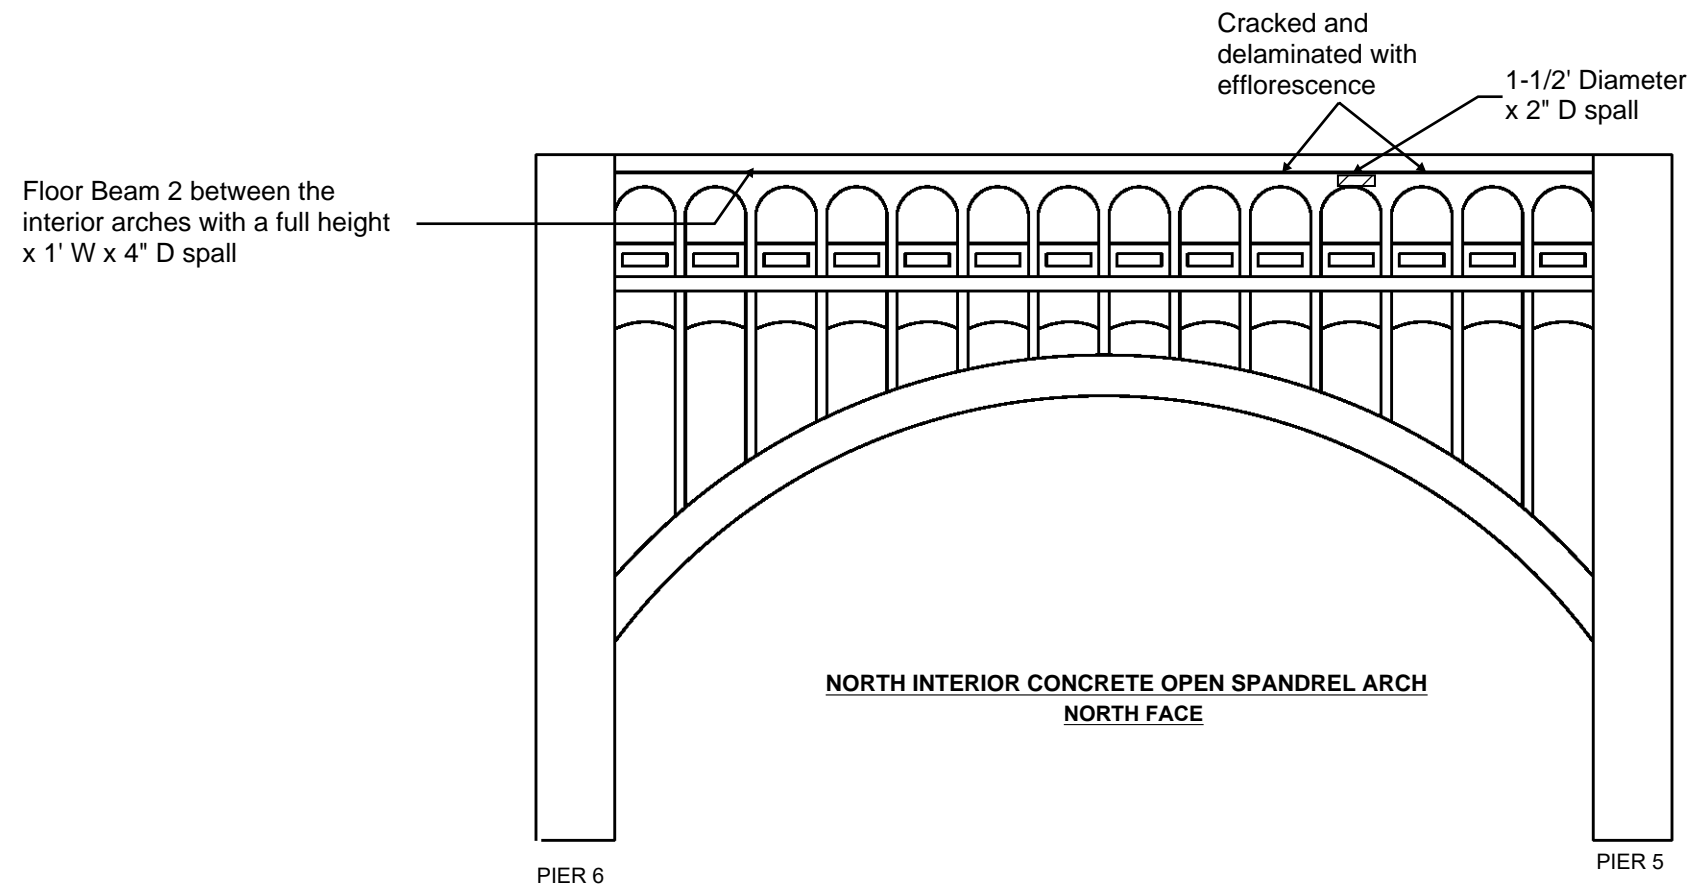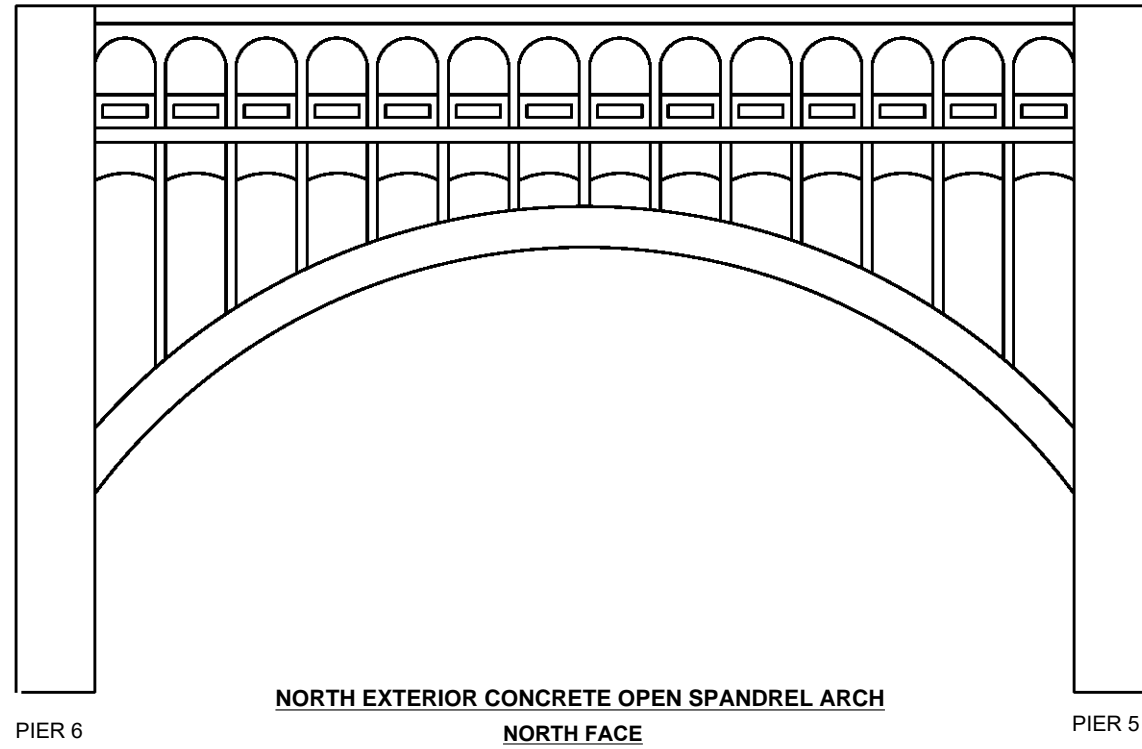


| | | | |
|--------------------------------|-----------|--|--|
| GRAPHIC SCALE MEASURED IN FEET | DATE | | DETROIT-SUPERIOR BRIDGE OVER CUYAHOGA RIVER
BRIDGE NO. CUY-6-1465 |
| NOT TO SCALE | NOV, 2018 | 9902 Carver Road
Suite 201
Cincinnati, OH 45242
PH.: 614.699.5000 | STRUCTURE ELEVATION - SPAN 6 |
| | | | PAGE
A-69 |

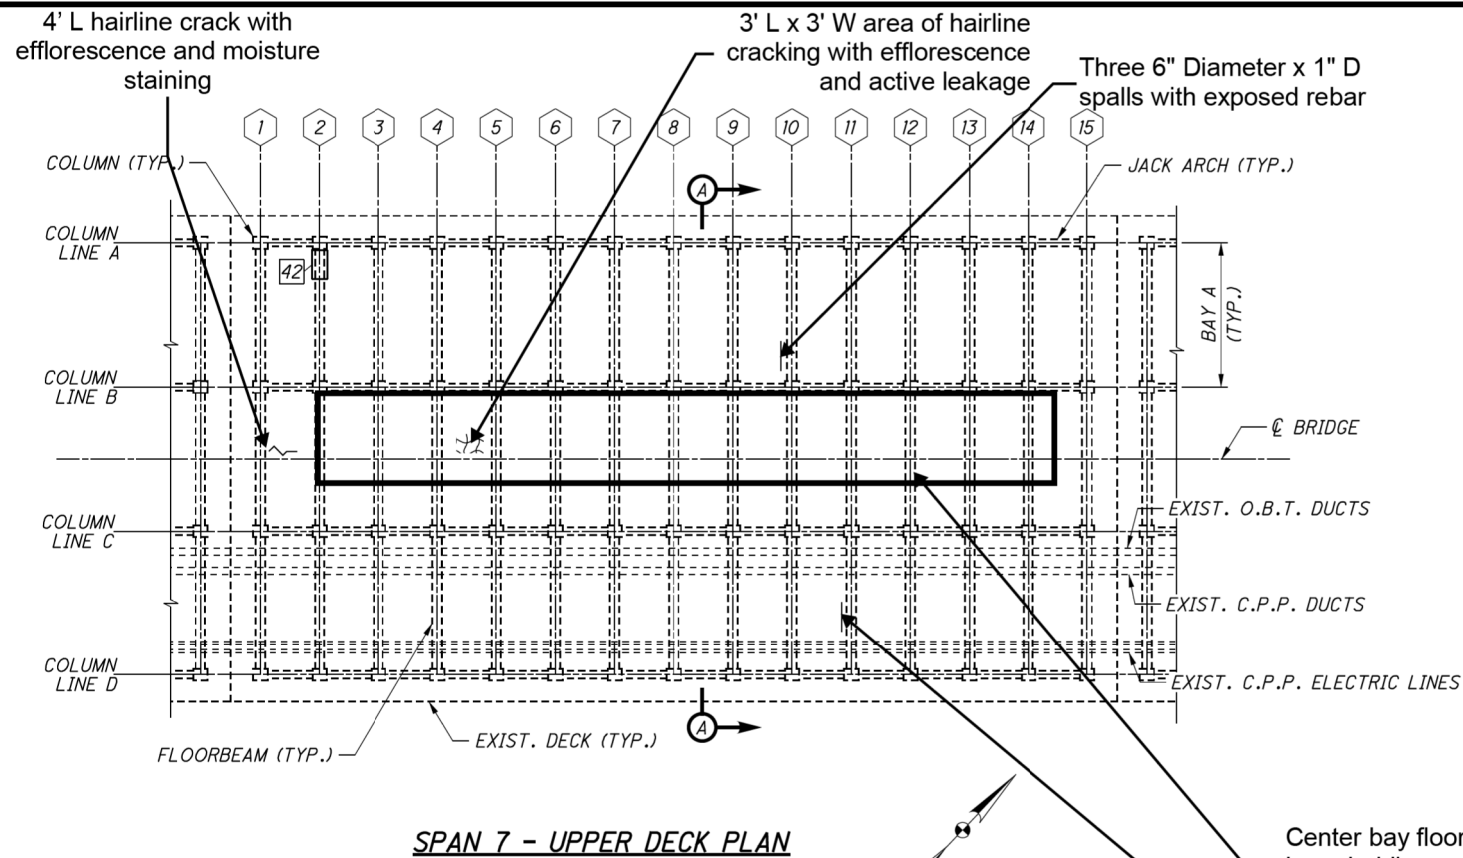

SPAN 7 - UPPER DECK PLAN

Center bay floor beams have hairline vertical cracks spaced 3' apart, some with light efflorescence

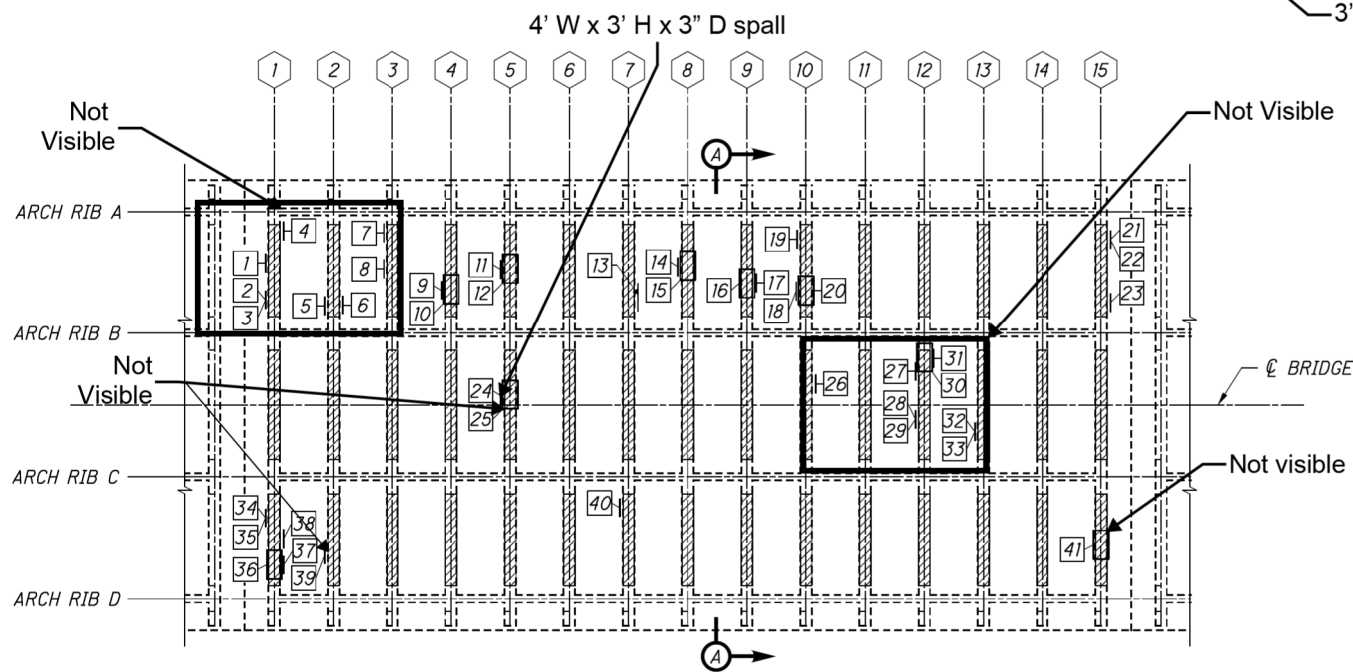

SPAN 7 - LOWER DECK PLAN

| ESTIMATED PATCHING QUANTITIES | | | |
|-------------------------------|-------------|-----------|------------------|
| REPAIR NO. | REPAIR TYPE | AREA (SF) | ANODE QUANTITY** |
| 1 | TYPE 1 | 8 | 2 |
| 2 | TYPE 1 | 20 | 4 |
| 3 | TYPE 1 | 5 | 1 |
| 4 | TYPE 1 | 4 | 1 |
| 5 | TYPE 1 | 2 | 1 |
| 6 | TYPE 1 | 2 | 1 |
| 7 | TYPE 1 | 8 | 2 |
| 8 | TYPE 1 | 21 | 6 |
| 9 | TYPE 1 | 25 | 4 |
| 10 | TYPE 2 | 22 | 9 |
| 11 | TYPE 1 | 6 | 3 |
| 12 | TYPE 2 | 1 | 1 |
| 13 | TYPE 1 | 16 | 4 |
| 14 | TYPE 1 | 6 | 3 |
| 15 | TYPE 2 | 30 | 12 |
| 16 | TYPE 2 | 5 | 2 |
| 17 | TYPE 1 | 4 | 1 |
| 18 | TYPE 1 | 6 | 2 |
| 19 | TYPE 1 | 3 | 2 |
| 20 | TYPE 2 | 3 | 3 |
| 21 | TYPE 1 | 20 | 6 |

| ESTIMATED PATCHING QUANTITIES | | | |
|-------------------------------|-------------|-----------|------------------|
| REPAIR NO. | REPAIR TYPE | AREA (SF) | ANODE QUANTITY** |
| 22 | TYPE 1 | 5 | 1 |
| 23 | TYPE 1 | 19 | 6 |
| 24 | TYPE 1 | 12 | 4 |
| 25 | TYPE 2 | 4 | 3 |
| 26 | TYPE 1 | 6 | 2 |
| 27 | TYPE 1 | 4 | 1 |
| 28 | TYPE 1 | 17 | 3 |
| 29 | TYPE 1 | 13 | 2 |
| 30 | TYPE 2 | 2 | 2 |
| 31 | TYPE 1 | 3 | 1 |
| 32 | TYPE 1 | 2 | 1 |
| 33 | TYPE 1 | 2 | 1 |
| 34 | TYPE 1 | 16 | 6 |
| 35 | TYPE 1 | 6 | 2 |
| 36 | TYPE 2 | 3 | 3 |
| 37 | TYPE 1 | 3 | 2 |
| 38 | TYPE 1 | 10 | 2 |
| 39 | TYPE 1 | 33 | 12 |
| 40 | TYPE 1 | 21 | 4 |
| 41 | TYPE 2 | 13 | 8 |
| 42 | TYPE 2 | 1 | 1 |
| MEASURED QUANTITY* | | 412 | - |
| PLAN QUANTITY* | | 618 | 137 |

* SEE NOTES 1 & 2
** SEE NOTE 3

| SHEET QUANTITY SUMMARY | | |
|------------------------|------|----------|
| ITEM | UNIT | QUANTITY |
| TYPE 1 REPAIR | SF | 492 |
| TYPE 2 REPAIR | SF | 126 |
| FRP WRAP | SF | 3863 |


NOTES:

1. MEASURED QUANTITIES ARE BASED ON THE INSPECTION PERFORMED IN DECEMBER 2018. THE EXACT DIMENSIONS AND LOCATIONS OF PATCHES SHALL BE DETERMINED BY THE ENGINEER IN THE FIELD FOR FINAL PAY QUANTITY.
2. PLAN QUANTITIES INCLUDE 50% CONTINGENCY ADDED TO MEASURED QUANTITIES.
3. ANODES ARE INCLUDED FOR PAYMENT WITH ITEM SPECIAL - PATCHING CONCRETE STRUCTURE, TYPE 1 OR TYPE 2 REPAIR.
4. FOR DETAILS AND MAXIMUM GRID SPACING FOR EMBEDDED GALVANIC ANODES, SEE SHEET [84/89].
5. FOR SECTION A-A, SEE SHEET [34/89].
6. FOR FRP WRAP DETAILS, SEE SHEET [85/89].


LEGEND:

- # FLOORBEAM LINE NUMBER
- # REPAIR NO. OF DEFICIENT CONCRETE TO BE REPAIRED IN ACCORDANCE WITH ITEM SPECIAL - PATCHING CONCRETE STRUCTURE, TYPE 1 OR TYPE 2 REPAIR.
- ▨ AREA TO BE TREATED WITH FRP WRAP PER ITEM SPECIAL - COMPOSITE FIBER WRAP SYSTEM

| | | | | |
|--------------------------------|-----------|--|--|--------------------------------|
| GRAPHIC SCALE MEASURED IN FEET | DATE |  9902 Carver Road
Suite 201
Cincinnati, OH 45242
PH.: 614.699.5000 | DETROIT-SUPERIOR BRIDGE OVER CUYAHOGA RIVER
BRIDGE NO. CUY-6-1465 | |
| NOT TO SCALE | NOV, 2018 | | INFRASTRUCTURE ENGINEERS, INC. | SPAN 7 CONCRETE REPAIR DETAILS |

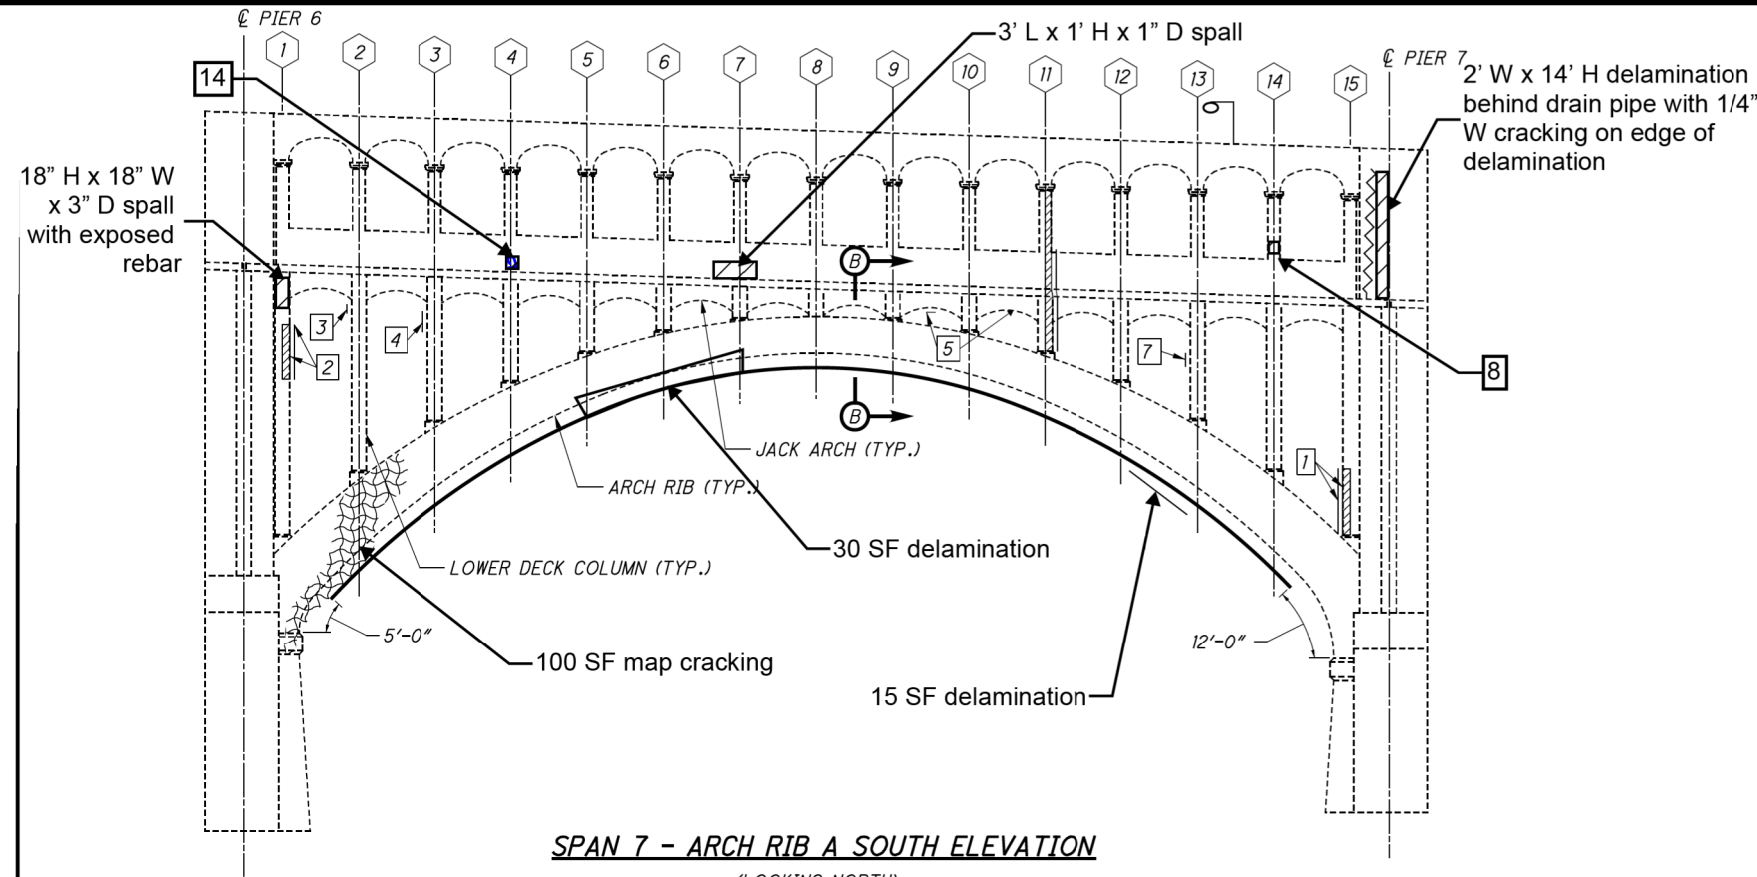

SPAN 7 - ARCH RIB A SOUTH ELEVATION
(LOOKING NORTH)

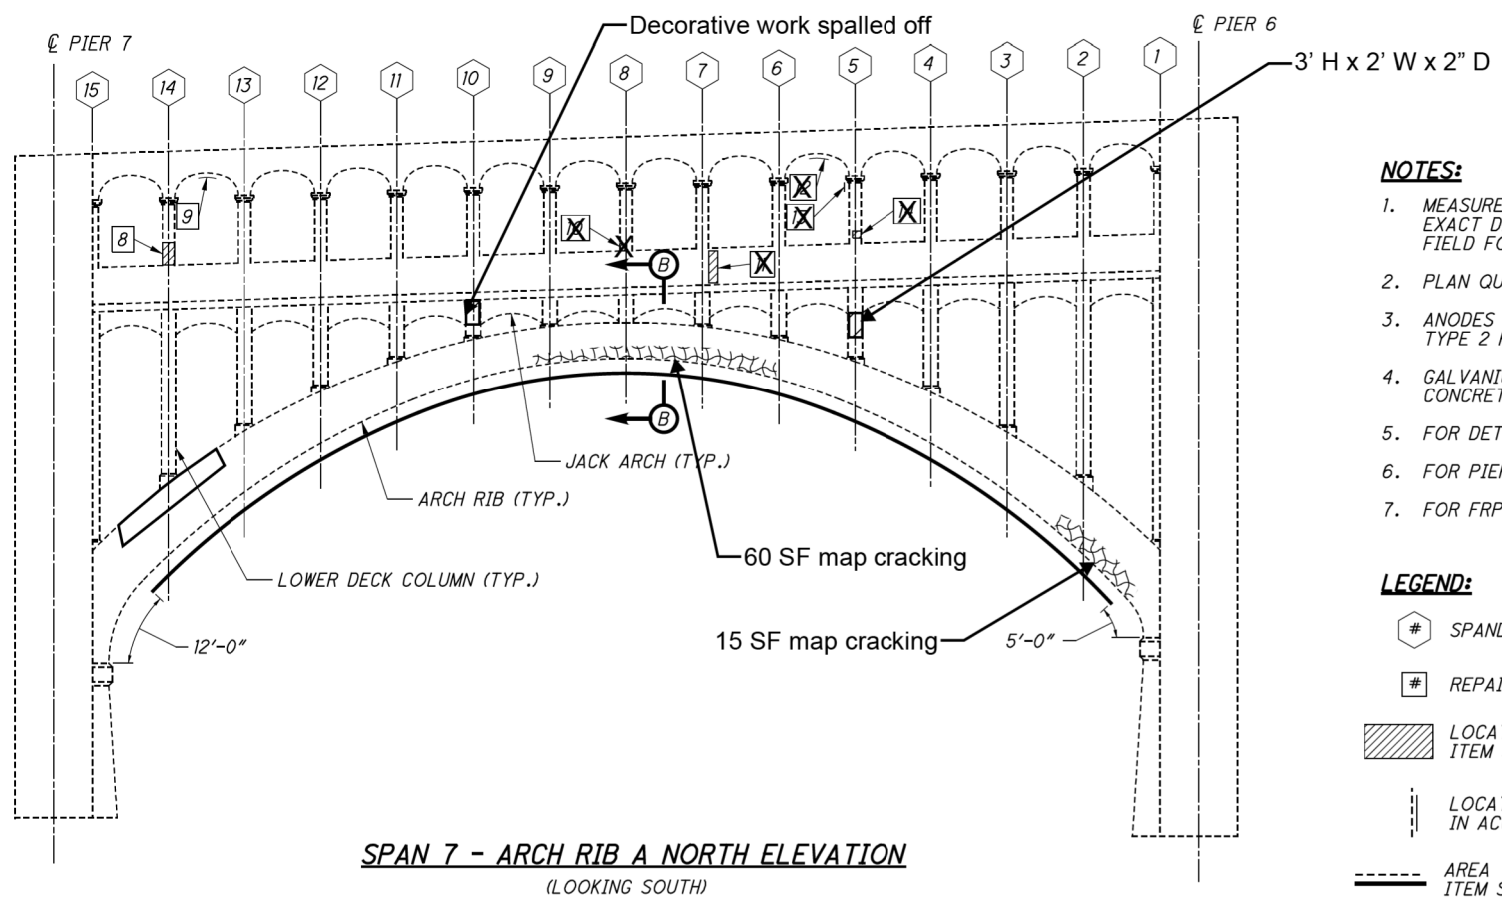

SPAN 7 - ARCH RIB A NORTH ELEVATION
(LOOKING SOUTH)

| ESTIMATED PATCHING QUANTITIES | | | |
|-------------------------------|-------------|-----------|------------------|
| REPAIR NO. | REPAIR TYPE | AREA (SF) | ANODE QUANTITY** |
| 1 | TYPE 1 | 21 | 5 |
| 2 | TYPE 1 | 20 | 6 |
| 3 | TYPE 1 | 1 | 1 |
| 4 | TYPE 1 | 7 | 2 |
| 5 | TYPE 2 | 2 | 2 |
| 6 | TYPE 1 | 32 | 12 |
| 7 | TYPE 1 | 3 | 1 |
| 8 | TYPE 1 | 5 | 2 |
| 9 | TYPE 2 | 4 | 1 |
| 10 | TYPE 1 | 1 | 1 |
| 11 | TYPE 1 | 4 | 2 |
| 12 | TYPE 2 | 2 | 1 |
| 13 | TYPE 1 | 1 | 1 |
| 14 | TYPE 1 | 1 | 1 |
| MEASURED QUANTITY* | | 104 | - |
| PLAN QUANTITY* | | 156 | 38 |

* SEE NOTES 1 & 2
** SEE NOTES 3 & 4

| SHEET QUANTITY SUMMARY | | |
|------------------------|------|----------|
| ITEM | UNIT | QUANTITY |
| TYPE 1 REPAIR | SF | 144 |
| TYPE 2 REPAIR | SF | 12 |
| FRP WRAP | SF | 1681 |


NOTES:

- MEASURED QUANTITIES ARE BASED ON THE INSPECTION PERFORMED IN JANUARY 2017. THE EXACT DIMENSIONS AND LOCATIONS OF PATCHES SHALL BE DETERMINED BY THE ENGINEER IN THE FIELD FOR FINAL PAY QUANTITY.
- PLAN QUANTITIES INCLUDE 50% CONTINGENCY ADDED TO MEASURED QUANTITIES.
- ANODES ARE INCLUDED FOR PAYMENT WITH ITEM SPECIAL - PATCHING CONCRETE STRUCTURE, TYPE 1 OR TYPE 2 REPAIR.
- GALVANIC ANODES WILL NOT BE USED FOR PATCHING THE UNREINFORCED VERTICAL SIDES OF THE CONCRETE ARCH RIBS.
- FOR DETAILS AND MAXIMUM GRID SPACING FOR EMBEDDED GALVANIC ANODES, SEE SHEET **84/89**.
- FOR PIER 6 REPAIR DETAILS, SEE SHEET **27/89**. FOR PIER 7 REPAIR DETAILS, SEE SHEET **28/89**.
- FOR FRP WRAP DETAILS AND SECTION B-B, SEE SHEET **85/89**.


LEGEND:

- SPANDREL COLUMN NUMBER
- REPAIR NUMBER
- LOCATION OF DEFICIENT CONCRETE TO BE REPAIRED IN ACCORDANCE WITH ITEM SPECIAL - PATCHING CONCRETE STRUCTURE, TYPE 1 REPAIR
- LOCATION OF DEFICIENT CONCRETE ON PERPENDICULAR FACE (NOT VISIBLE IN ELEVATION VIEW) TO BE REPAIRED IN ACCORDANCE WITH ITEM SPECIAL - PATCHING CONCRETE STRUCTURE, TYPE 1 OR TYPE 2 REPAIR
- AREA TO BE TREATED WITH FRP WRAP PER ITEM SPECIAL - COMPOSITE FIBER WRAP SYSTEM

| | | | | |
|--------------------------------|--------------------------------|--|---|-----------|
| GRAPHIC SCALE MEASURED IN FEET | DATE | 9902 Carver Road
Suite 201
Cincinnati, OH 45242
PH.: 614.699.5000 | DETROIT-SUPERIOR BRIDGE OVER CUYAHOGA RIVER | |
| | NOV, 2018 | | BRIDGE NO. CUY-6-1465 | |
| NOT TO SCALE | INFRASTRUCTURE ENGINEERS, INC. | | SPAN 7 CONCRETE REPAIR DETAILS | PAGE A-71 |

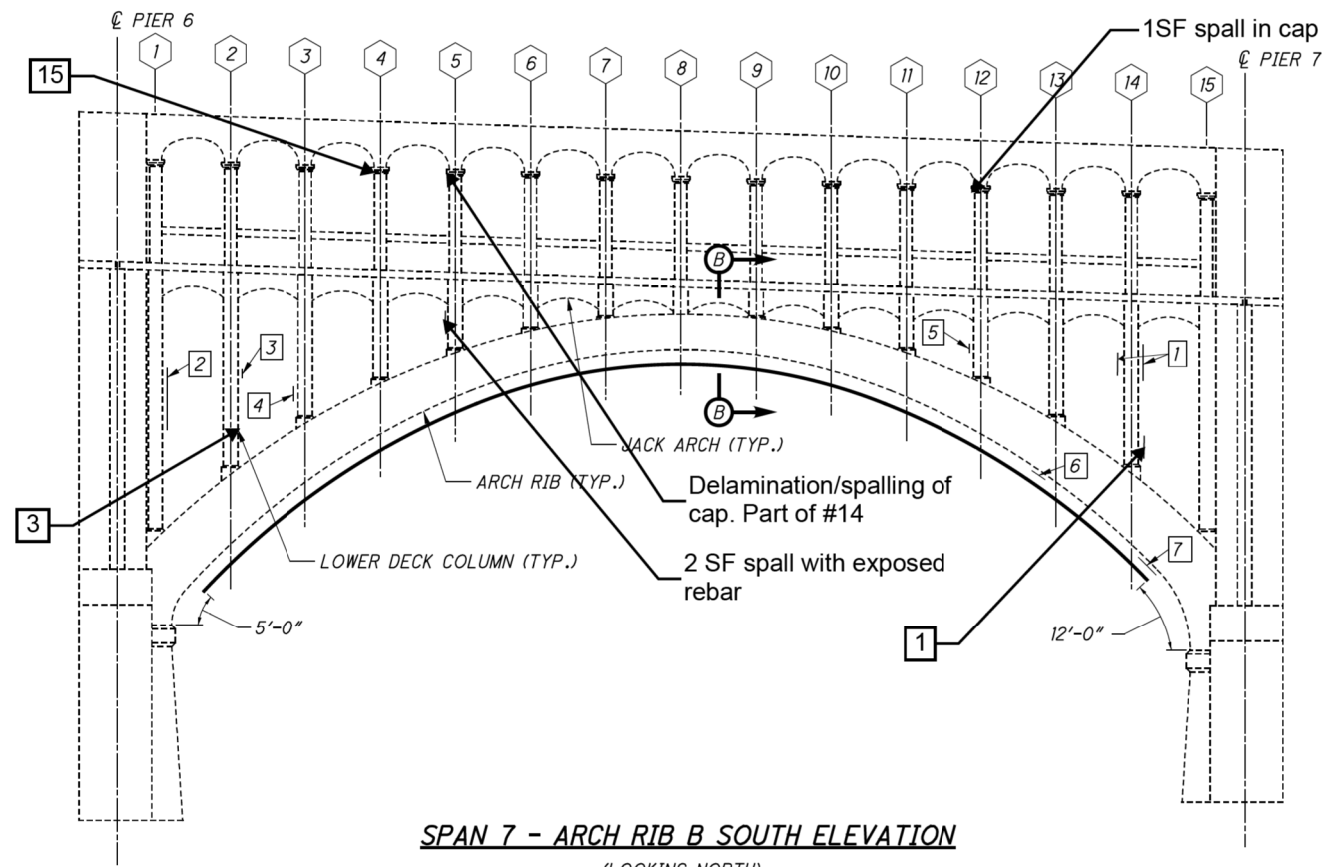

SPAN 7 - ARCH RIB B SOUTH ELEVATION
(LOOKING NORTH)

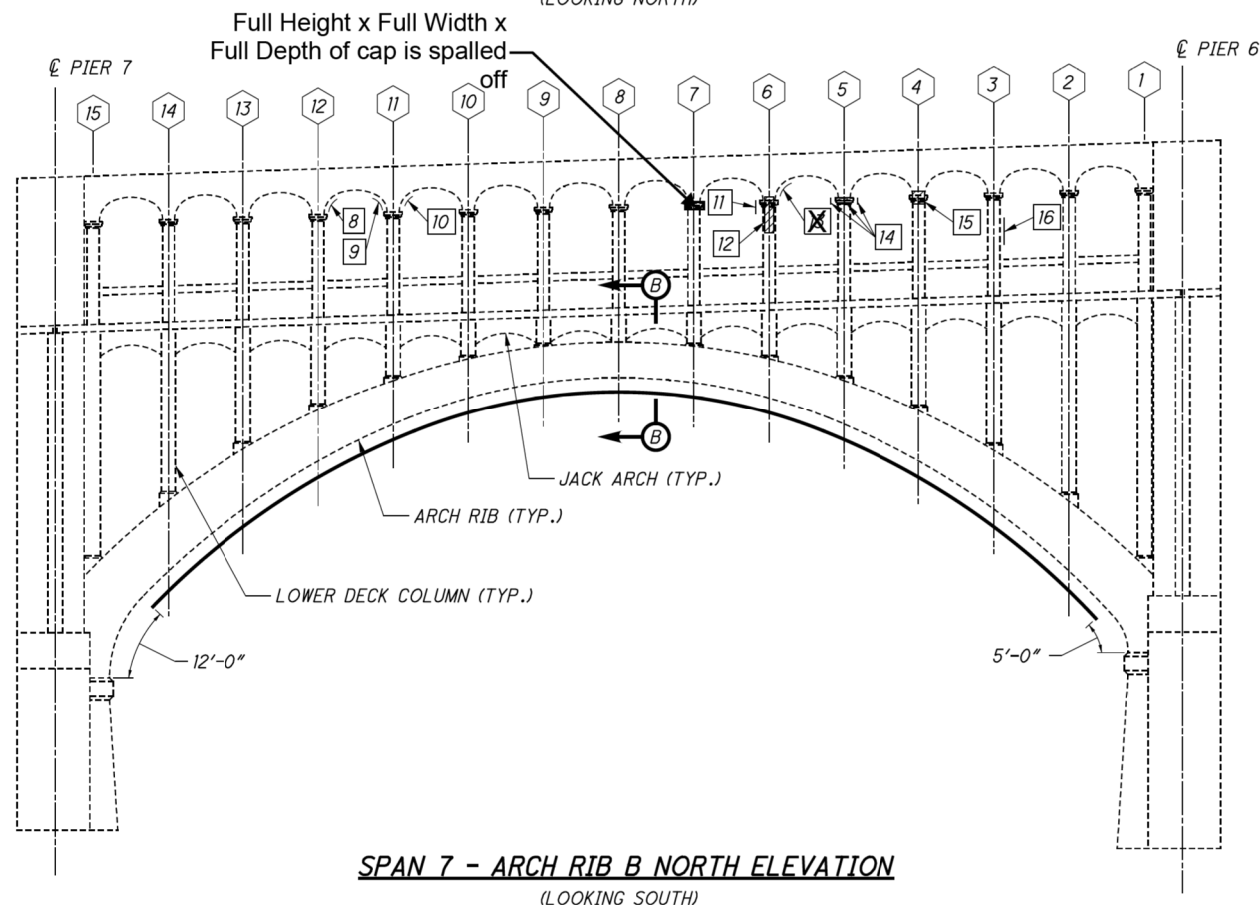

SPAN 7 - ARCH RIB B NORTH ELEVATION
(LOOKING SOUTH)

| ESTIMATED PATCHING QUANTITIES | | | |
|-------------------------------|-------------|-----------|------------------|
| REPAIR NO. | REPAIR TYPE | AREA (SF) | ANODE QUANTITY** |
| 1 | TYPE 1 | 10 | 2 |
| 2 | TYPE 1 | 28 | 8 |
| 3 | TYPE 1 | 2 | 1 |
| 4 | TYPE 1 | 5 | 1 |
| 5 | TYPE 1 | 1 | 1 |
| 6 | TYPE 2 | 3 | 1 |
| 7 | TYPE 2 | 21 | 8 |
| 8 | TYPE 2 | 3 | 2 |
| 9 | TYPE 2 | 3 | 2 |
| 10 | TYPE 2 | 1 | 1 |
| 11 | TYPE 1 | 4 | 1 |
| 12 | TYPE 1 | 5 | 4 |
| 13 | TYPE 2 | 4 | 3 |
| 14 | TYPE 1 | 5 | 4 |
| 15 | TYPE 1 | 4 | 1 |
| 16 | TYPE 1 | 5 | 4 |
| MEASURED QUANTITY* | | 104 | - |
| PLAN QUANTITY* | | 156 | 44 |

* SEE NOTES 1 & 2
** SEE NOTES 3 & 4

| SHEET QUANTITY SUMMARY | | |
|------------------------|------|----------|
| ITEM | UNIT | QUANTITY |
| TYPE 1 REPAIR | SF | 103 |
| TYPE 2 REPAIR | SF | 53 |
| FRP WRAP | SF | 1987 |


NOTES:

1. MEASURED QUANTITIES ARE BASED ON THE INSPECTION PERFORMED IN JANUARY 2017. THE EXACT DIMENSIONS AND LOCATIONS OF PATCHES SHALL BE DETERMINED BY THE ENGINEER IN THE FIELD FOR FINAL PAY QUANTITY.
2. PLAN QUANTITIES INCLUDE 50% CONTINGENCY ADDED TO MEASURED QUANTITIES.
3. ANODES ARE INCLUDED FOR PAYMENT WITH ITEM SPECIAL - PATCHING CONCRETE STRUCTURE, TYPE 1 OR TYPE 2 REPAIR.
4. GALVANIC ANODES WILL NOT BE USED FOR PATCHING THE UNREINFORCED VERTICAL SIDES OF THE CONCRETE ARCH RIBS.
5. FOR DETAILS AND MAXIMUM GRID SPACING FOR EMBEDDED GALVANIC ANODES, SEE SHEET [84/89].
6. FOR PIER 6 REPAIR DETAILS, SEE SHEET [27/89]. FOR PIER 7 REPAIR DETAILS, SEE SHEET [28/89].
7. FOR FRP WRAP DETAILS AND SECTION B-B, SEE SHEET [85/89].


LEGEND:

- # SPANDREL COLUMN NUMBER
- # REPAIR NUMBER
- [Hatched Box] LOCATION OF DEFICIENT CONCRETE TO BE REPAIRED IN ACCORDANCE WITH ITEM SPECIAL - PATCHING CONCRETE STRUCTURE, TYPE 1 REPAIR
- [Dashed Box] LOCATION OF DEFICIENT CONCRETE ON PERPENDICULAR FACE (NOT VISIBLE IN ELEVATION VIEW) TO BE REPAIRED IN ACCORDANCE WITH ITEM SPECIAL - PATCHING CONCRETE STRUCTURE, TYPE 1 OR TYPE 2 REPAIR
- [Dashed Line] AREA TO BE TREATED WITH FRP WRAP PER ITEM SPECIAL - COMPOSITE FIBER WRAP SYSTEM

| | | | | |
|--------------------------------|--------------|--|--|--------------------------------|
| GRAPHIC SCALE MEASURED IN FEET | DATE |  9902 Carver Road
Suite 201
Cincinnati, OH 45242
PH.: 614.699.5000 | DETROIT-SUPERIOR BRIDGE OVER CUYAHOGA RIVER
BRIDGE NO. CUY-6-1465 | |
| | NOT TO SCALE | | NOV, 2018 | INFRASTRUCTURE ENGINEERS, INC. |
| | | | | PAGE A-72 |

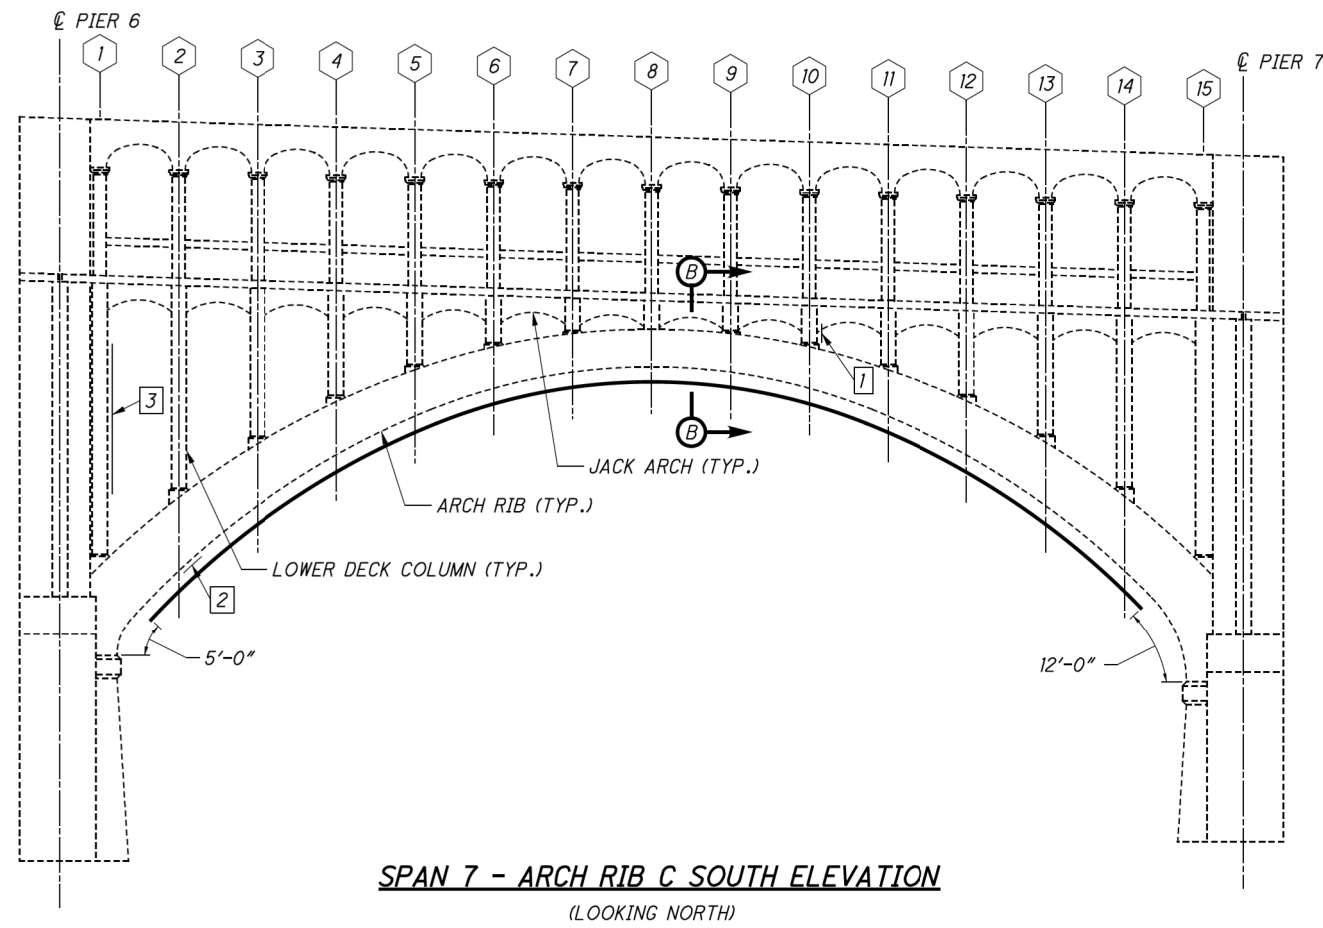

SPAN 7 - ARCH RIB C SOUTH ELEVATION
(LOOKING NORTH)

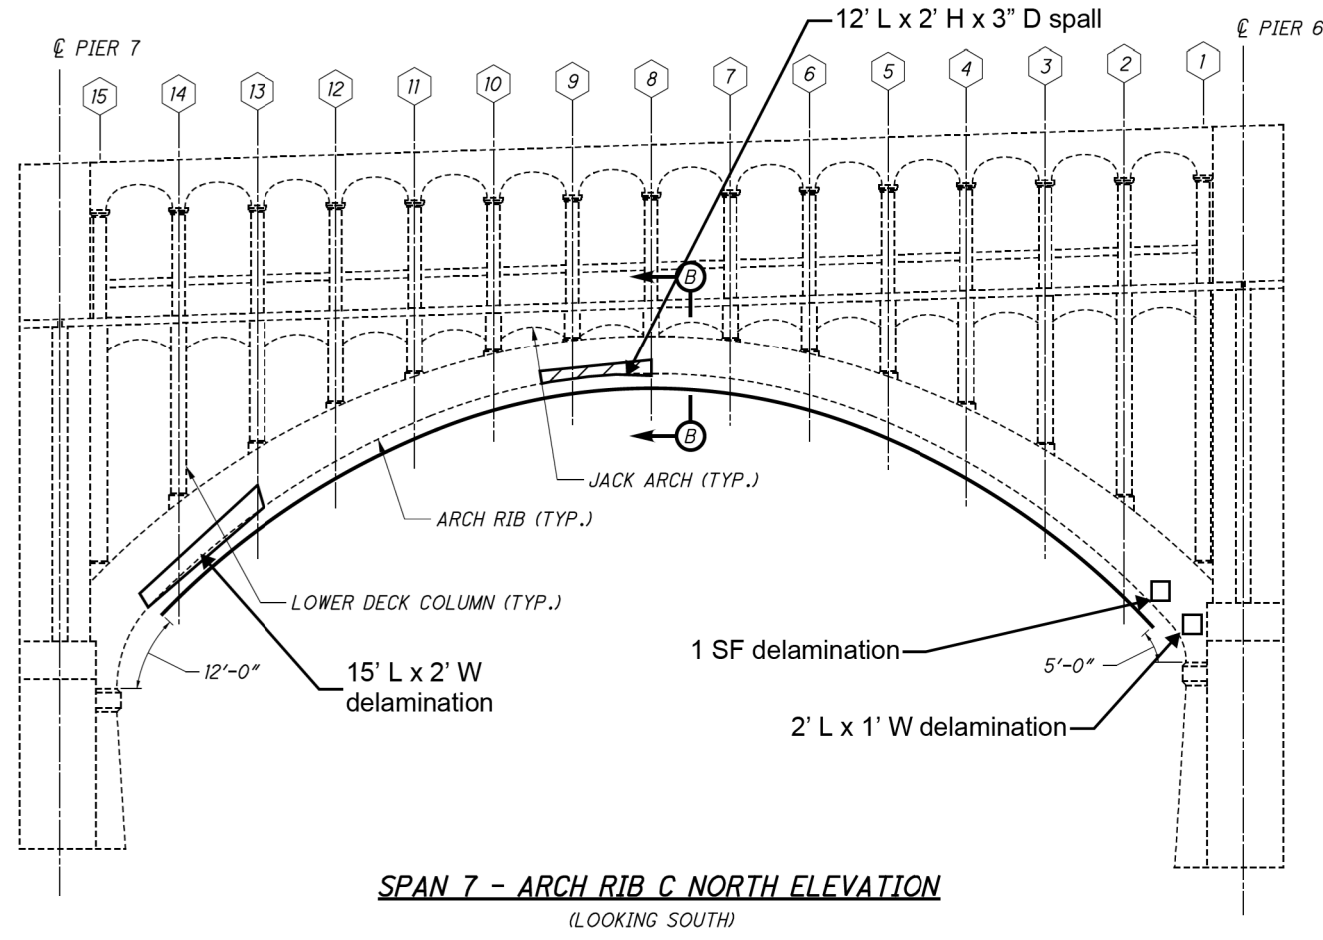

SPAN 7 - ARCH RIB C NORTH ELEVATION
(LOOKING SOUTH)

| REPAIR NO. | REPAIR TYPE | AREA (SF) | ANODE QUANTITY** |
|--------------------|-------------|-----------|------------------|
| 1 | TYPE 1 | 2 | 1 |
| 2 | TYPE 2 | 15 | 5 |
| 3 | TYPE 1 | 32 | 8 |
| MEASURED QUANTITY* | | 49 | - |
| PLAN QUANTITY* | | 74 | 14 |

* SEE NOTES 1 & 2
** SEE NOTES 3 & 4

| ITEM | UNIT | QUANTITY |
|---------------|------|----------|
| TYPE 1 REPAIR | SF | 51 |
| TYPE 2 REPAIR | SF | 23 |
| FRP WRAP | SF | 1987 |


NOTES:

1. MEASURED QUANTITIES ARE BASED ON THE INSPECTION PERFORMED IN JANUARY 2017. THE EXACT DIMENSIONS AND LOCATIONS OF PATCHES SHALL BE DETERMINED BY THE ENGINEER IN THE FIELD FOR FINAL PAY QUANTITY.
2. PLAN QUANTITIES INCLUDE 50% CONTINGENCY ADDED TO MEASURED QUANTITIES.
3. ANODES ARE INCLUDED FOR PAYMENT WITH ITEM SPECIAL - PATCHING CONCRETE STRUCTURE, TYPE 1 OR TYPE 2 REPAIR.
4. GALVANIC ANODES WILL NOT BE USED FOR PATCHING THE UNREINFORCED VERTICAL SIDES OF THE CONCRETE ARCH RIBS.
5. FOR DETAILS AND MAXIMUM GRID SPACING FOR EMBEDDED GALVANIC ANODES, SEE SHEET [84/89].
6. FOR PIER 6 REPAIR DETAILS, SEE SHEET [27/89]. FOR PIER 7 REPAIR DETAILS, SEE SHEET [28/89].
7. FOR FRP WRAP DETAILS AND SECTION B-B, SEE SHEET [85/89].

LEGEND:


- # SPANDREL COLUMN NUMBER
- # REPAIR NUMBER
- ▨ LOCATION OF DEFICIENT CONCRETE TO BE REPAIRED IN ACCORDANCE WITH ITEM SPECIAL - PATCHING CONCRETE STRUCTURE, TYPE 1 REPAIR
- ▨ LOCATION OF DEFICIENT CONCRETE ON PERPENDICULAR FACE (NOT VISIBLE IN ELEVATION VIEW) TO BE REPAIRED IN ACCORDANCE WITH ITEM SPECIAL - PATCHING CONCRETE STRUCTURE, TYPE 1 OR TYPE 2 REPAIR
- AREA TO BE TREATED WITH FRP WRAP PER ITEM SPECIAL - COMPOSITE FIBER WRAP SYSTEM

| | | | | |
|--------------------------------|-----------|--|--|--------------------------------|
| GRAPHIC SCALE MEASURED IN FEET | DATE |  9902 Carver Road
Suite 201
Cincinnati, OH 45242
PH.: 614.699.5000 | DETROIT-SUPERIOR BRIDGE OVER CUYAHOGA RIVER
BRIDGE NO. CUY-6-1465 | |
| NOT TO SCALE | NOV, 2018 | | INFRASTRUCTURE ENGINEERS, INC. | SPAN 7 CONCRETE REPAIR DETAILS |

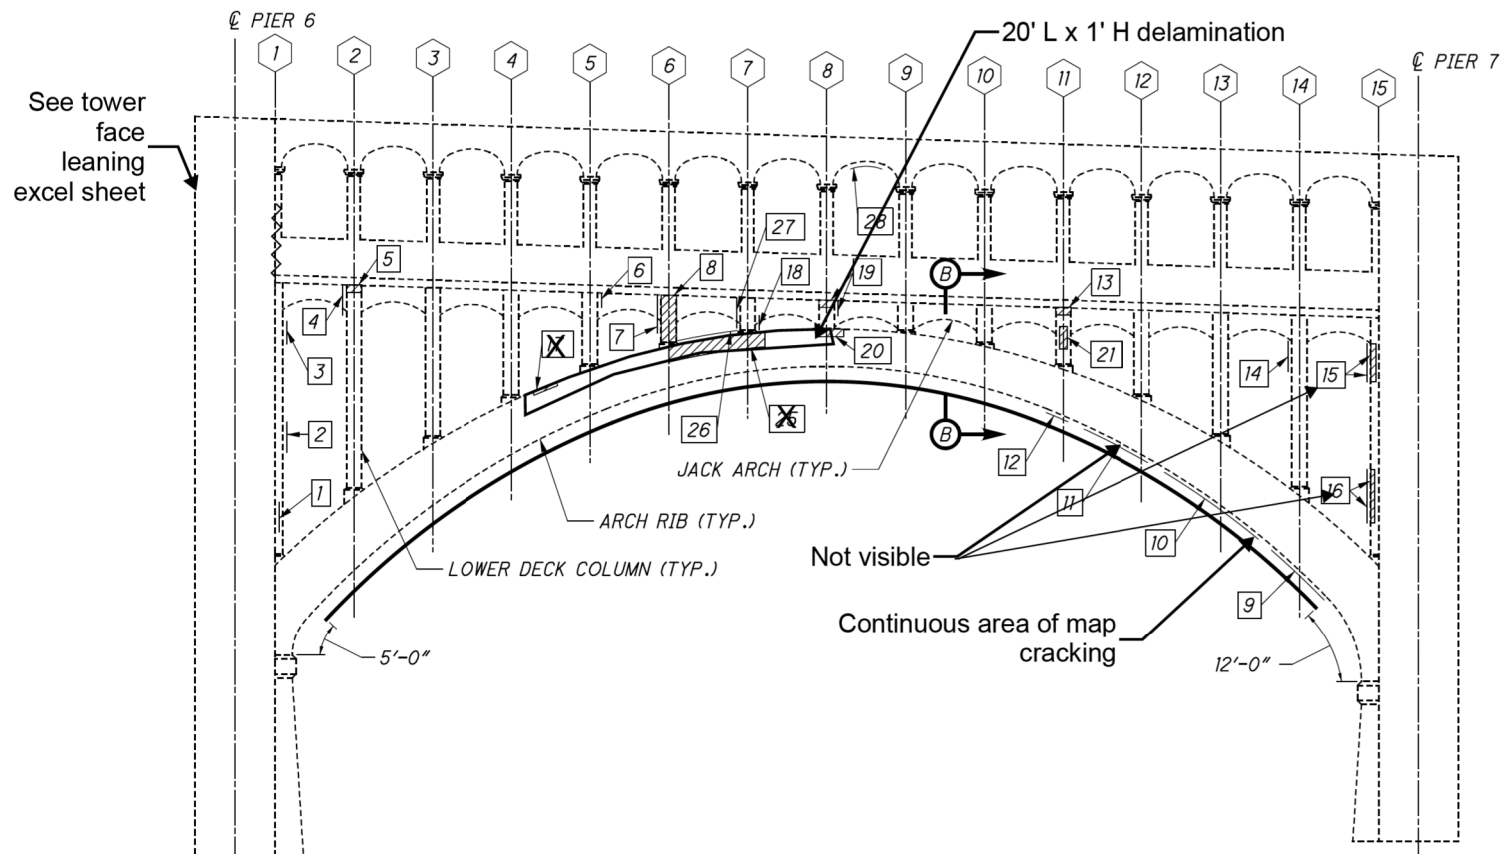

SPAN 7 - ARCH RIB D SOUTH ELEVATION

(LOOKING NORTH)

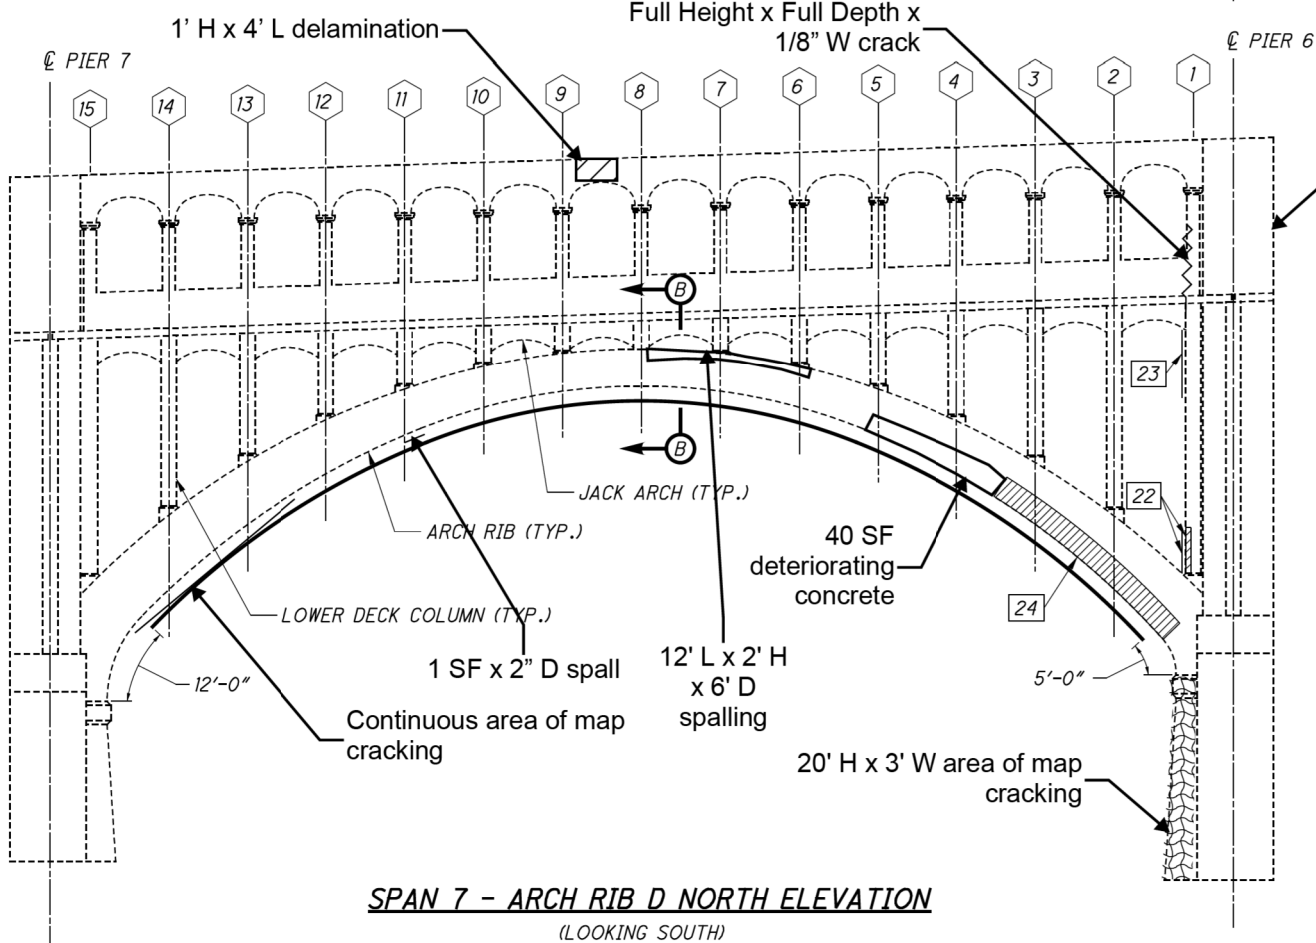

SPAN 7 - ARCH RIB D NORTH ELEVATION

(LOOKING SOUTH)

| ESTIMATED PATCHING QUANTITIES | | | |
|-------------------------------|-------------|-----------|------------------|
| REPAIR NO. | REPAIR TYPE | AREA (SF) | ANODE QUANTITY** |
| 1 | TYPE 1 | 4 | 2 |
| 2 | TYPE 1 | 4 | 2 |
| 3 | TYPE 1 | 3 | 2 |
| 4 | TYPE 1 | 8 | 2 |
| 5 | TYPE 1 | 2 | 1 |
| 6 | TYPE 1 | 3 | 2 |
| 7 | TYPE 1 | 20 | 6 |
| 8 | TYPE 1 | 12 | 3 |
| 9 | TYPE 2 | 16 | 6 |
| 10 | TYPE 2 | 25 | 12 |
| 11 | TYPE 2 | 18 | 10 |
| 12 | TYPE 2 | 5 | 2 |
| 13 | TYPE 1 | 2 | 1 |
| 14 | TYPE 1 | 6 | 2 |
| 15 | TYPE 1 | 18 | 6 |

| ESTIMATED PATCHING QUANTITIES | | | |
|-------------------------------|-------------|-----------|------------------|
| REPAIR NO. | REPAIR TYPE | AREA (SF) | ANODE QUANTITY** |
| 16 | TYPE 1 | 10 | 4 |
| 17 | TYPE 1 | 17 | 10 |
| 18 | TYPE 1 | 4 | 1 |
| 19 | TYPE 1 | 6 | 2 |
| 20 | TYPE 1 | 3 | - |
| 21 | TYPE 1 | 3 | 2 |
| 22 | TYPE 1 | 8 | 3 |
| 23 | TYPE 1 | 12 | 5 |
| 24 | TYPE 1 | 90 | - |
| 25 | TYPE 1 | 24 | - |
| 26 | TYPE 1 | 72 | 22 |
| 27 | TYPE 1 | 8 | 2 |
| 28 | TYPE 2 | 4 | 3 |
| MEASURED QUANTITY* | | 407 | - |
| PLAN QUANTITY* | | 611 | 113 |

* SEE NOTES 1 & 2
 ** SEE NOTES 3 & 4

| SHEET QUANTITY SUMMARY | | |
|------------------------|------|----------|
| ITEM | UNIT | QUANTITY |
| TYPE 1 REPAIR | SF | 509 |
| TYPE 2 REPAIR | SF | 102 |
| FRP WRAP | SF | 1681 |


NOTES:

- MEASURED QUANTITIES ARE BASED ON THE INSPECTION PERFORMED IN JANUARY 2017. THE EXACT DIMENSIONS AND LOCATIONS OF PATCHES SHALL BE DETERMINED BY THE ENGINEER IN THE FIELD FOR FINAL PAY QUANTITY.
- PLAN QUANTITIES INCLUDE 50% CONTINGENCY ADDED TO MEASURED QUANTITIES.
- ANODES ARE INCLUDED FOR PAYMENT WITH ITEM SPECIAL - PATCHING CONCRETE STRUCTURE, TYPE 1 OR TYPE 2 REPAIR.
- GALVANIC ANODES WILL NOT BE USED FOR PATCHING THE UNREINFORCED VERTICAL SIDES OF THE CONCRETE ARCH RIBS.
- FOR DETAILS AND MAXIMUM GRID SPACING FOR EMBEDDED GALVANIC ANODES, SEE SHEET [84/89].
- FOR PIER 6 REPAIR DETAILS, SEE SHEET [27/89]. FOR PIER 7 REPAIR DETAILS, SEE SHEET [28/89].
- FOR FRP WRAP DETAILS AND SECTION B-B, SEE SHEET [85/89].

LEGEND:

- # SPANDREL COLUMN NUMBER
- # REPAIR NUMBER
- [Hatched Box] LOCATION OF DEFICIENT CONCRETE TO BE REPAIRED IN ACCORDANCE WITH ITEM SPECIAL - PATCHING CONCRETE STRUCTURE, TYPE 1 REPAIR
- [Dashed Box] LOCATION OF DEFICIENT CONCRETE ON PERPENDICULAR FACE (NOT VISIBLE IN ELEVATION VIEW) TO BE REPAIRED IN ACCORDANCE WITH ITEM SPECIAL - PATCHING CONCRETE STRUCTURE, TYPE 1 OR TYPE 2 REPAIR
- [Dotted Box] AREA TO BE TREATED WITH FRP WRAP PER ITEM SPECIAL - COMPOSITE FIBER WRAP SYSTEM


| | | | | |
|--------------------------------|-----------|--|--|--------------------------------|
| GRAPHIC SCALE MEASURED IN FEET | DATE |  9902 Carver Road
Suite 201
Cincinnati, OH 45242
PH.: 614.699.5000 | DETROIT-SUPERIOR BRIDGE OVER CUYAHOGA RIVER
BRIDGE NO. CUY-6-1465 | |
| NOT TO SCALE | NOV, 2018 | | INFRASTRUCTURE ENGINEERS, INC. | SPAN 7 CONCRETE REPAIR DETAILS |

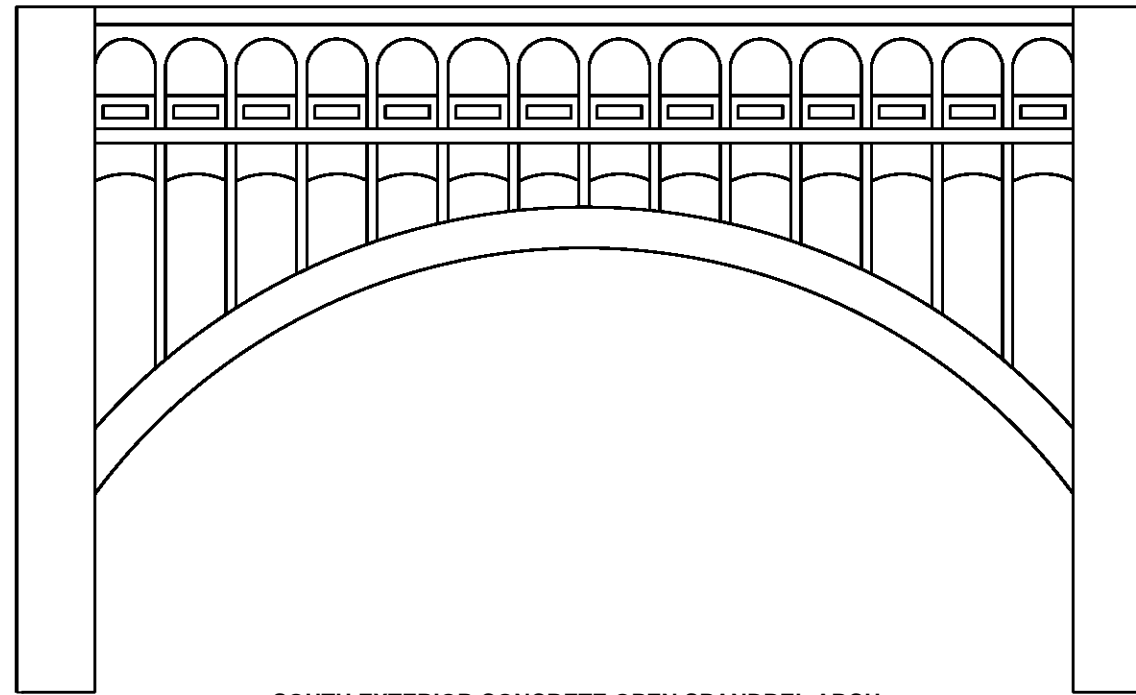

PIER 7

SOUTH EXTERIOR CONCRETE OPEN SPANDREL ARCH
NORTH FACE

PIER 6

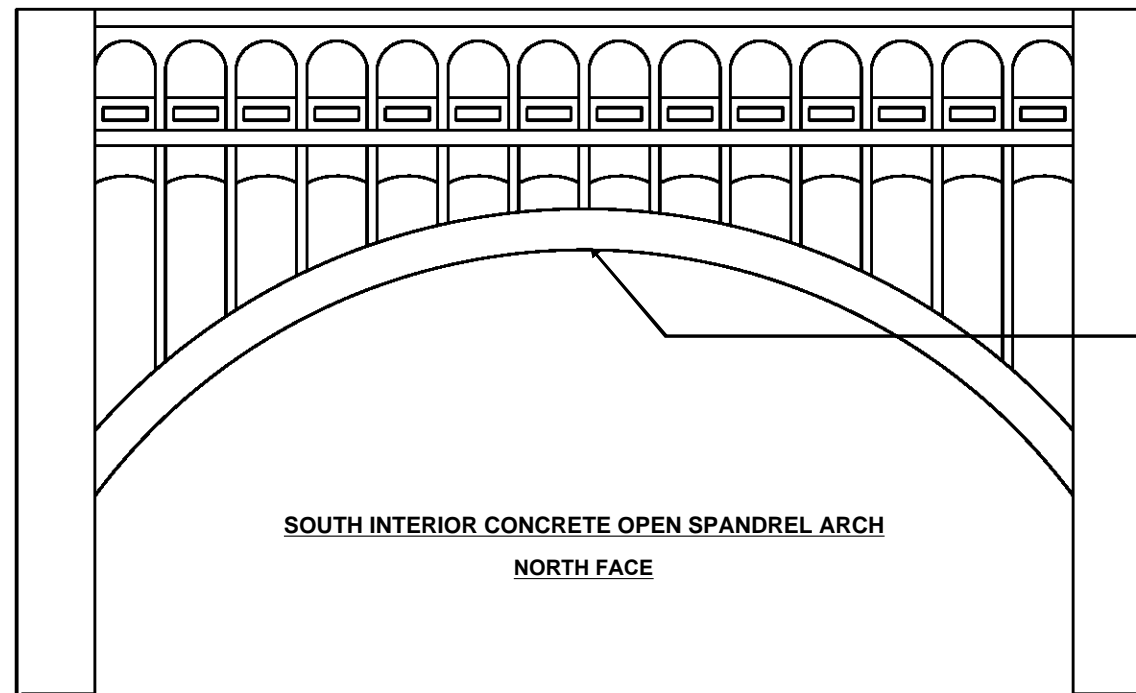


PIER 7

SOUTH INTERIOR CONCRETE OPEN SPANDREL ARCH
NORTH FACE

PIER 6

Bottom north edge of arch rib has a spall with corroded reinforcing


| | | | |
|---------------------------------------|------------------|--|--|
| <p>GRAPHIC SCALE MEASURED IN FEET</p> | <p>DATE</p> |  <p>9902 Carver Road
Suite 201
Cincinnati, OH 45242
PH.: 614.699.5000</p> | <p>DETROIT-SUPERIOR BRIDGE OVER CUYAHOGA RIVER
BRIDGE NO. CUY-6-1465</p> |
| <p>NOT TO SCALE</p> | <p>NOV, 2018</p> | <p>INFRASTRUCTURE
ENGINEERS, INC.</p> | <p>STRUCTURE ELEVATION - SPAN 7</p> <p>PAGE
A-75</p> |

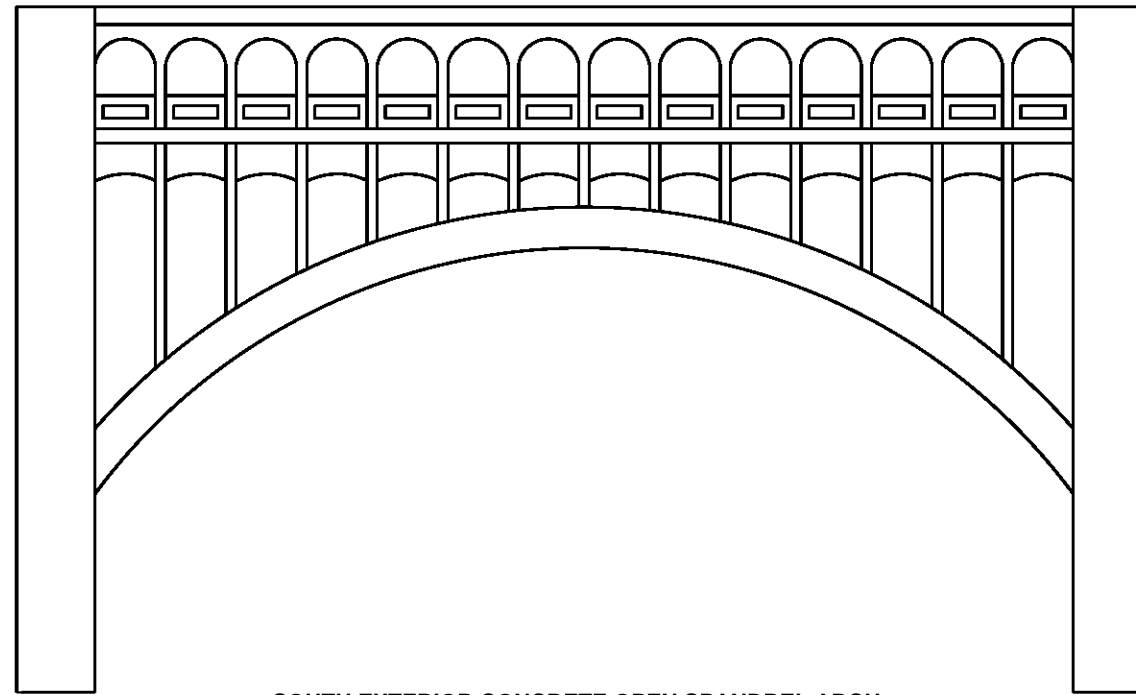

PIER 6

SOUTH EXTERIOR CONCRETE OPEN SPANDREL ARCH
SOUTH FACE

PIER 7

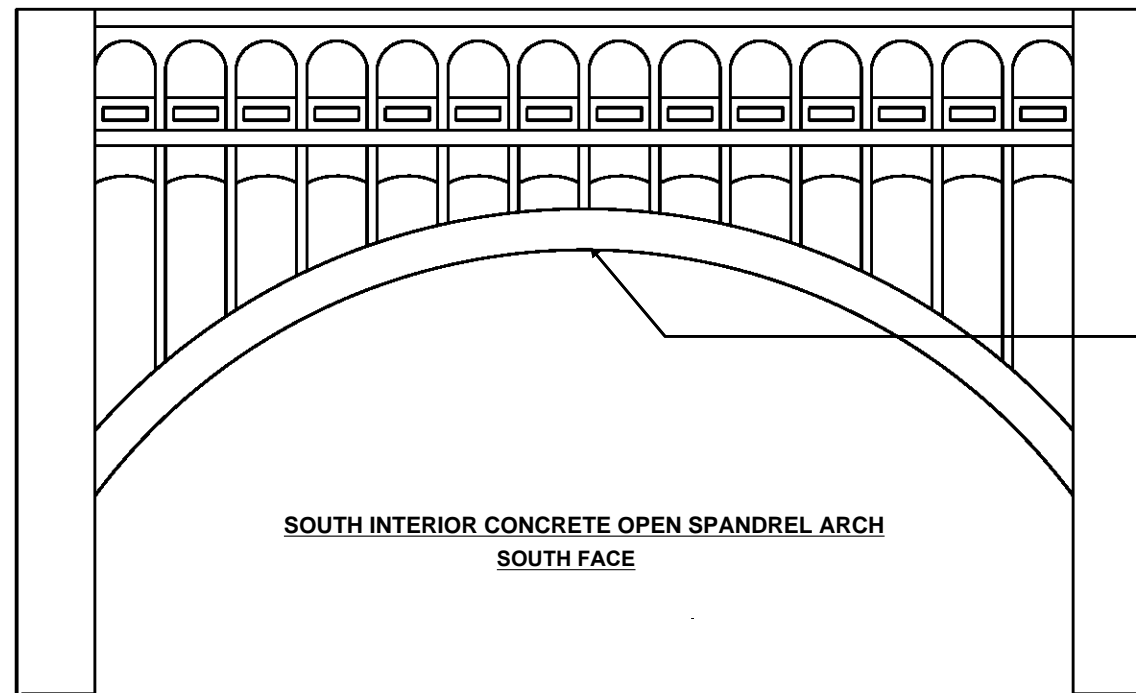


PIER 6

SOUTH INTERIOR CONCRETE OPEN SPANDREL ARCH
SOUTH FACE


PIER 7

Bottom north edge of arch rib has a spall with corroded reinforcing

| | | | | |
|---------------------------------------|------------------|--|--|----------------------|
| <p>GRAPHIC SCALE MEASURED IN FEET</p> | <p>DATE</p> |  <p>9902 Carver Road
Suite 201
Cincinnati, OH 45242
PH.: 614.699.5000</p> | <p>DETROIT-SUPERIOR BRIDGE OVER CUYAHOGA RIVER
BRIDGE NO. CUY-6-1465</p> | |
| <p>NOT TO SCALE</p> | <p>NOV, 2018</p> | <p>INFRASTRUCTURE
ENGINEERS, INC.</p> | <p>STRUCTURE ELEVATION - SPAN 7</p> | <p>PAGE
A-76</p> |

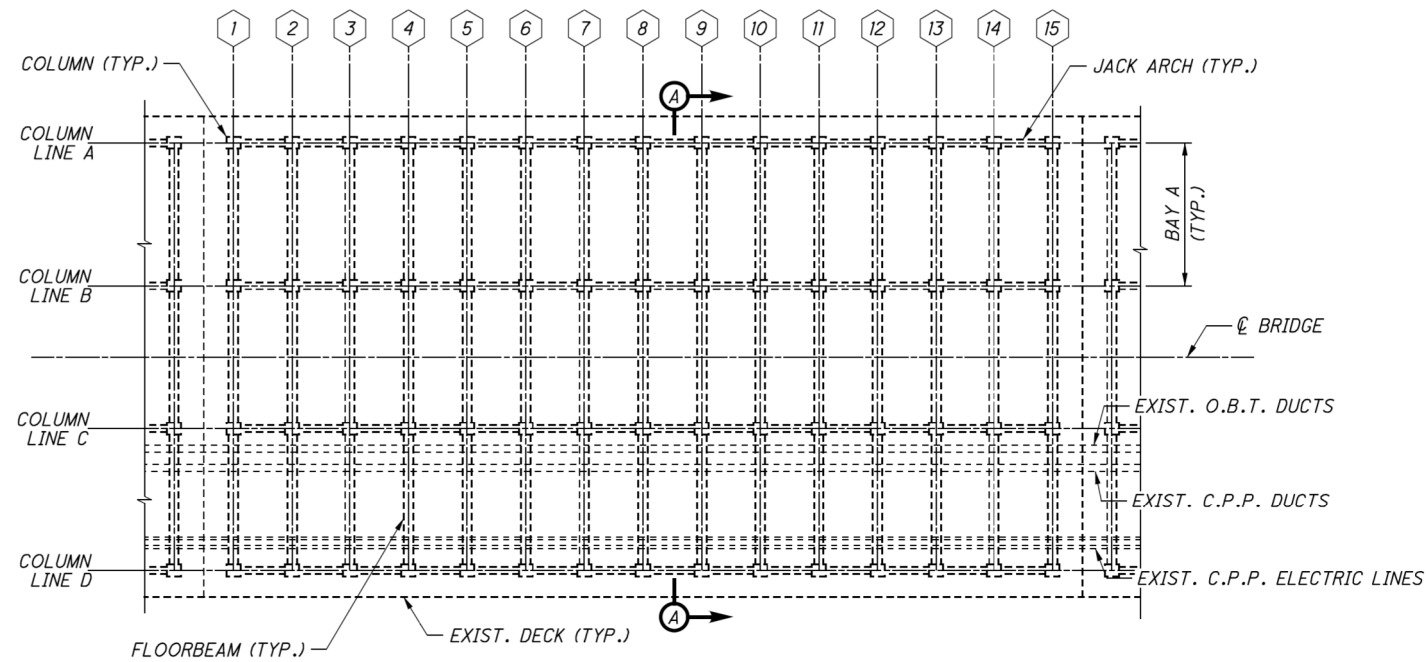

SPAN 8 - UPPER DECK PLAN

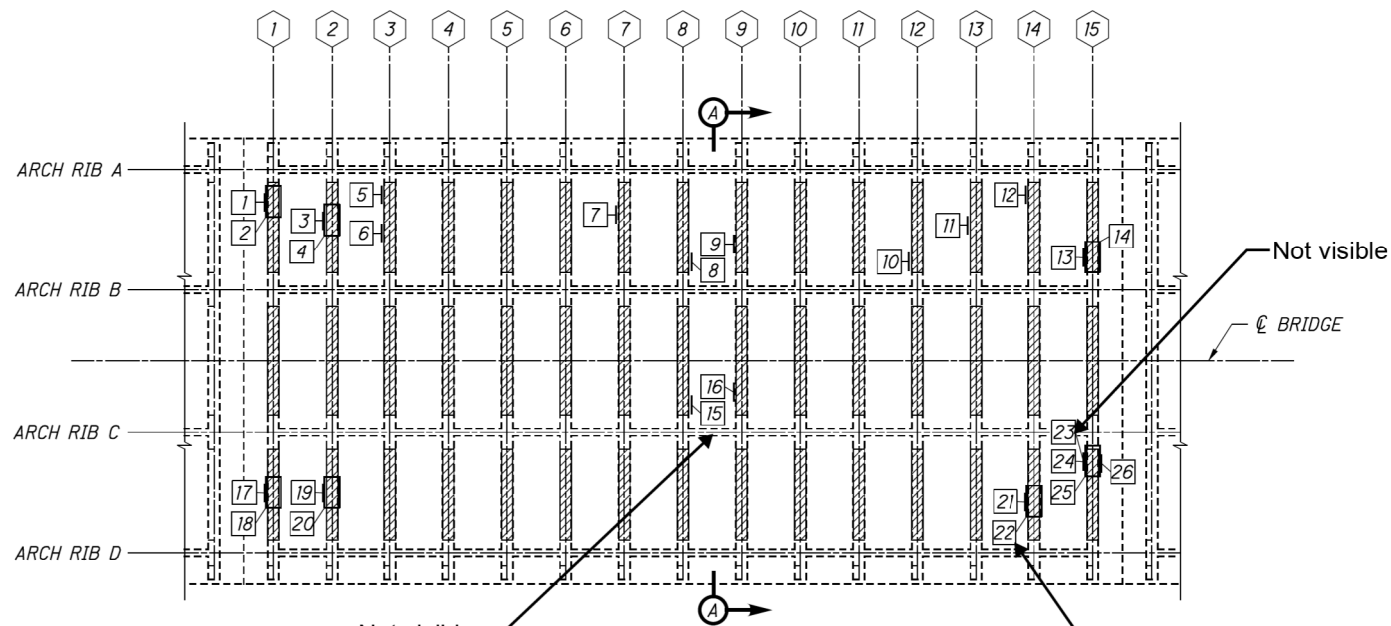

SPAN 8 - LOWER DECK PLAN

| ESTIMATED PATCHING QUANTITIES | | | |
|-------------------------------|-------------|-----------|------------------|
| REPAIR NO. | REPAIR TYPE | AREA (SF) | ANODE QUANTITY** |
| 1 | TYPE 1 | 4 | 4 |
| 2 | TYPE 2 | 4 | 6 |
| 3 | TYPE 1 | 3 | 2 |
| 4 | TYPE 2 | 6 | 3 |
| 5 | TYPE 1 | 4 | 2 |
| 6 | TYPE 1 | 14 | 4 |
| 7 | TYPE 1 | 3 | 1 |
| 8 | TYPE 1 | 8 | 2 |
| 9 | TYPE 1 | 39 | 10 |
| 10 | TYPE 1 | 1 | 1 |
| 11 | TYPE 1 | 8 | 2 |
| 12 | TYPE 1 | 10 | 4 |
| 13 | TYPE 1 | 1 | 1 |
| 14 | TYPE 2 | 2 | 2 |
| 15 | TYPE 1 | 2 | 1 |
| 16 | TYPE 1 | 8 | 2 |
| 17 | TYPE 1 | 4 | 4 |
| 18 | TYPE 2 | 7 | 6 |
| 19 | TYPE 1 | 20 | 6 |
| 20 | TYPE 2 | 5 | 4 |
| 21 | TYPE 1 | 17 | 4 |
| 22 | TYPE 2 | 3 | 2 |
| 23 | TYPE 1 | 23 | 6 |
| 24 | TYPE 1 | 5 | 1 |
| 25 | TYPE 2 | 5 | 2 |
| 26 | TYPE 1 | 8 | 2 |
| MEASURED QUANTITY* | | 214 | |
| PLAN QUANTITY* | | 321 | 84 |

* SEE NOTES 1 & 2
 ** SEE NOTE 3

| SHEET QUANTITY SUMMARY | | |
|------------------------|------|----------|
| ITEM | UNIT | QUANTITY |
| TYPE 1 REPAIR | SF | 273 |
| TYPE 2 REPAIR | SF | 48 |
| FRP WRAP | SF | 3863 |


NOTES:

- MEASURED QUANTITIES ARE BASED ON THE INSPECTION PERFORMED IN DECEMBER 2016. THE EXACT DIMENSIONS AND LOCATIONS OF PATCHES SHALL BE DETERMINED BY THE ENGINEER IN THE FIELD FOR FINAL PAY QUANTITY.
- PLAN QUANTITIES INCLUDE 50% CONTINGENCY ADDED TO MEASURED QUANTITIES.
- ANODES ARE INCLUDED FOR PAYMENT WITH ITEM SPECIAL - PATCHING CONCRETE STRUCTURE, TYPE 1 OR TYPE 2 REPAIR.
- FOR DETAILS AND MAXIMUM GRID SPACING FOR EMBEDDED GALVANIC ANODES, SEE SHEET [84/89].
- FOR SECTION A-A, SEE SHEET [34/89].
- FOR FRP WRAP DETAILS, SEE SHEET [85/89].


LEGEND:

- # FLOORBEAM LINE NUMBER
- # REPAIR NO. OF DEFICIENT CONCRETE TO BE REPAIRED IN ACCORDANCE WITH ITEM SPECIAL - PATCHING CONCRETE STRUCTURE, TYPE 1 OR TYPE 2 REPAIR.
- ▨ AREA TO BE TREATED WITH FRP WRAP PER ITEM SPECIAL - COMPOSITE FIBER WRAP SYSTEM

| | | | | |
|--------------------------------|--------------|--|--|--------------------------------|
| GRAPHIC SCALE MEASURED IN FEET | DATE | 9902 Carver Road
Suite 201
Cincinnati, OH 45242
PH.: 614.699.5000 | DETROIT-SUPERIOR BRIDGE OVER CUYAHOGA RIVER
BRIDGE NO. CUY-6-1465 | |
| | NOT TO SCALE | | NOV, 2018 | INFRASTRUCTURE ENGINEERS, INC. |
| | | | | PAGE A-77 |

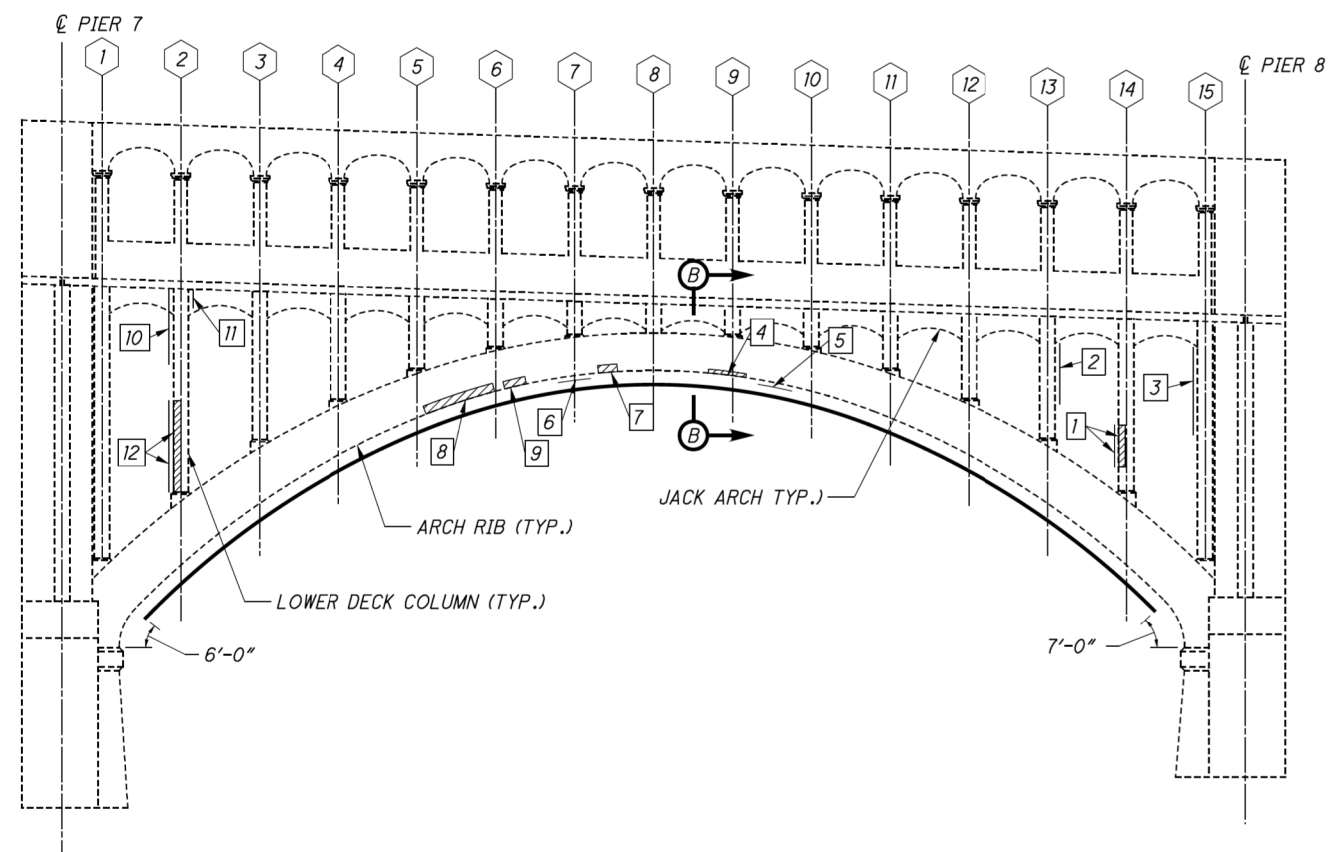

SPAN 8 - ARCH RIB A SOUTH ELEVATION
(LOOKING NORTH)

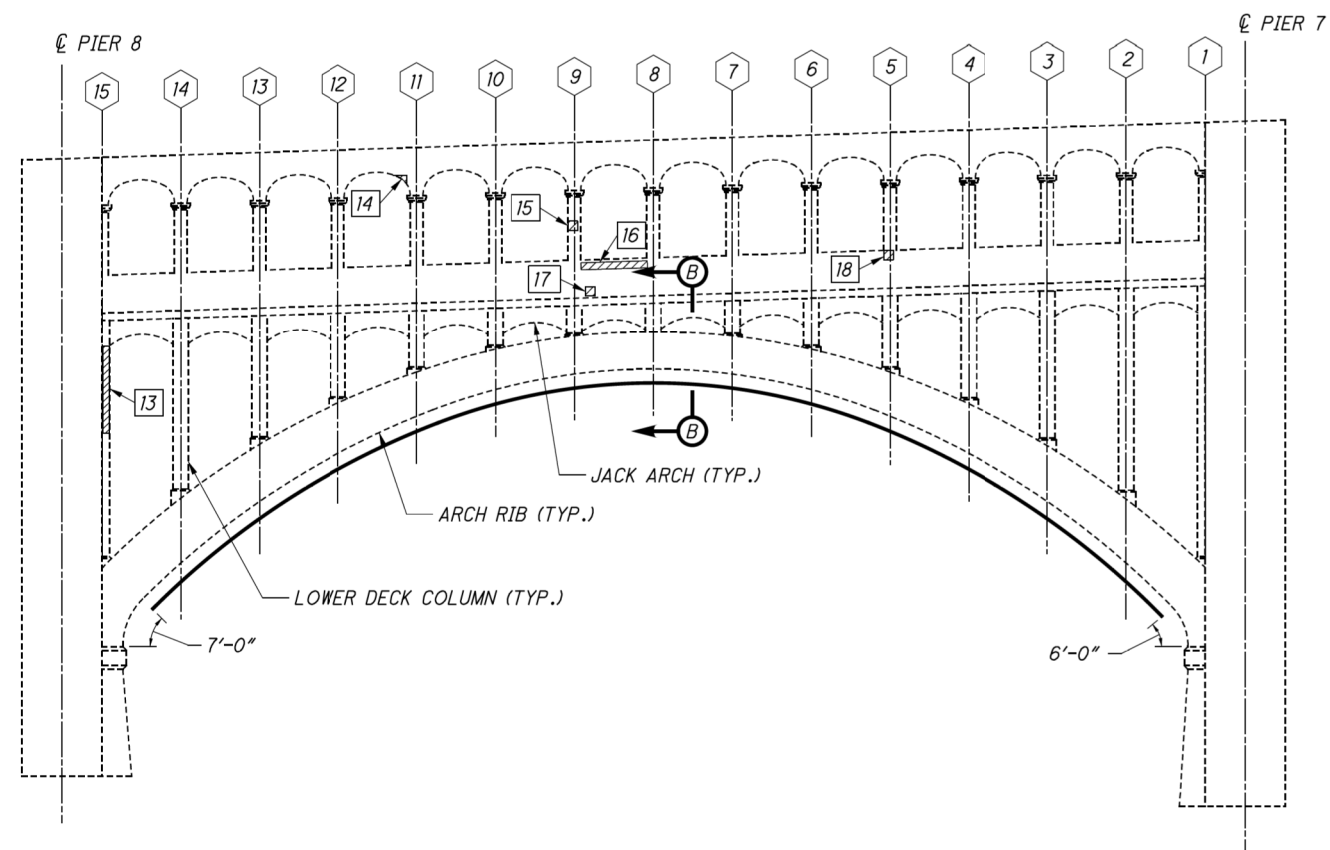

SPAN 8 - ARCH RIB A NORTH ELEVATION
(LOOKING SOUTH)

| ESTIMATED PATCHING QUANTITIES | | | |
|-------------------------------|-------------|-----------|------------------|
| REPAIR NO. | REPAIR TYPE | AREA (SF) | ANODE QUANTITY** |
| 1 | TYPE 1 | 15 | 3 |
| 2 | TYPE 1 | 26 | 8 |
| 3 | TYPE 1 | 18 | 6 |
| 4 | TYPE 1 | 3 | - |
| 5 | TYPE 2 | 11 | 6 |
| 6 | TYPE 2 | 7 | 4 |
| 7 | TYPE 1 | 2 | - |
| 8 | TYPE 1 | 12 | - |
| 9 | TYPE 1 | 2 | - |
| 10 | TYPE 1 | 12 | 5 |
| 11 | TYPE 1 | 32 | 6 |
| 12 | TYPE 1 | 1 | 1 |
| 13 | TYPE 1 | 6 | 4 |
| 14 | TYPE 1 | 1 | 1 |
| 15 | TYPE 1 | 1 | 1 |
| 16 | TYPE 1 | 9 | 5 |
| 17 | TYPE 1 | 1 | 1 |
| 18 | TYPE 1 | 1 | 1 |
| MEASURED QUANTITY* | | 160 | - |
| PLAN QUANTITY* | | 240 | 52 |

* SEE NOTES 1 & 2
** SEE NOTES 3 & 4

| SHEET QUANTITY SUMMARY | | |
|------------------------|------|----------|
| ITEM | UNIT | QUANTITY |
| TYPE 1 REPAIR | SF | 213 |
| TYPE 2 REPAIR | SF | 27 |
| FRP WRAP | SF | 1680 |


NOTES:

1. MEASURED QUANTITIES ARE BASED ON THE INSPECTION PERFORMED IN JANUARY 2017. THE EXACT DIMENSIONS AND LOCATIONS OF PATCHES SHALL BE DETERMINED BY THE ENGINEER IN THE FIELD FOR FINAL PAY QUANTITY.
2. PLAN QUANTITIES INCLUDE 50% CONTINGENCY ADDED TO MEASURED QUANTITIES.
3. ANODES ARE INCLUDED FOR PAYMENT WITH ITEM SPECIAL - PATCHING CONCRETE STRUCTURE, TYPE 1 OR TYPE 2 REPAIR.
4. GALVANIC ANODES WILL NOT BE USED FOR PATCHING THE UNREINFORCED VERTICAL SIDES OF THE CONCRETE ARCH RIBS.
5. FOR DETAILS AND MAXIMUM GRID SPACING FOR EMBEDDED GALVANIC ANODES, SEE SHEET [84/89].
6. FOR PIER 7 AND PIER 8 REPAIR DETAILS, SEE SHEET [28/89].
7. FOR FRP WRAP DETAILS AND SECTION B-B, SEE SHEET [85/89].


LEGEND:

- # SPANDREL COLUMN NUMBER
- # REPAIR NUMBER
- ▨ LOCATION OF DEFICIENT CONCRETE TO BE REPAIRED IN ACCORDANCE WITH ITEM SPECIAL - PATCHING CONCRETE STRUCTURE, TYPE 1 REPAIR
- || LOCATION OF DEFICIENT CONCRETE ON PERPENDICULAR FACE (NOT VISIBLE IN ELEVATION VIEW) TO BE REPAIRED IN ACCORDANCE WITH ITEM SPECIAL - PATCHING CONCRETE STRUCTURE, TYPE 1 OR TYPE 2 REPAIR
- AREA TO BE TREATED WITH FRP WRAP PER ITEM SPECIAL - COMPOSITE FIBER WRAP SYSTEM

| | | | | |
|--------------------------------|-----------|--|--|--------------------------------|
| GRAPHIC SCALE MEASURED IN FEET | DATE |  9902 Carver Road
Suite 201
Cincinnati, OH 45242
PH.: 614.699.5000 | DETROIT-SUPERIOR BRIDGE OVER CUYAHOGA RIVER
BRIDGE NO. CUY-6-1465 | |
| NOT TO SCALE | NOV, 2018 | | INFRASTRUCTURE ENGINEERS, INC. | SPAN 8 CONCRETE REPAIR DETAILS |

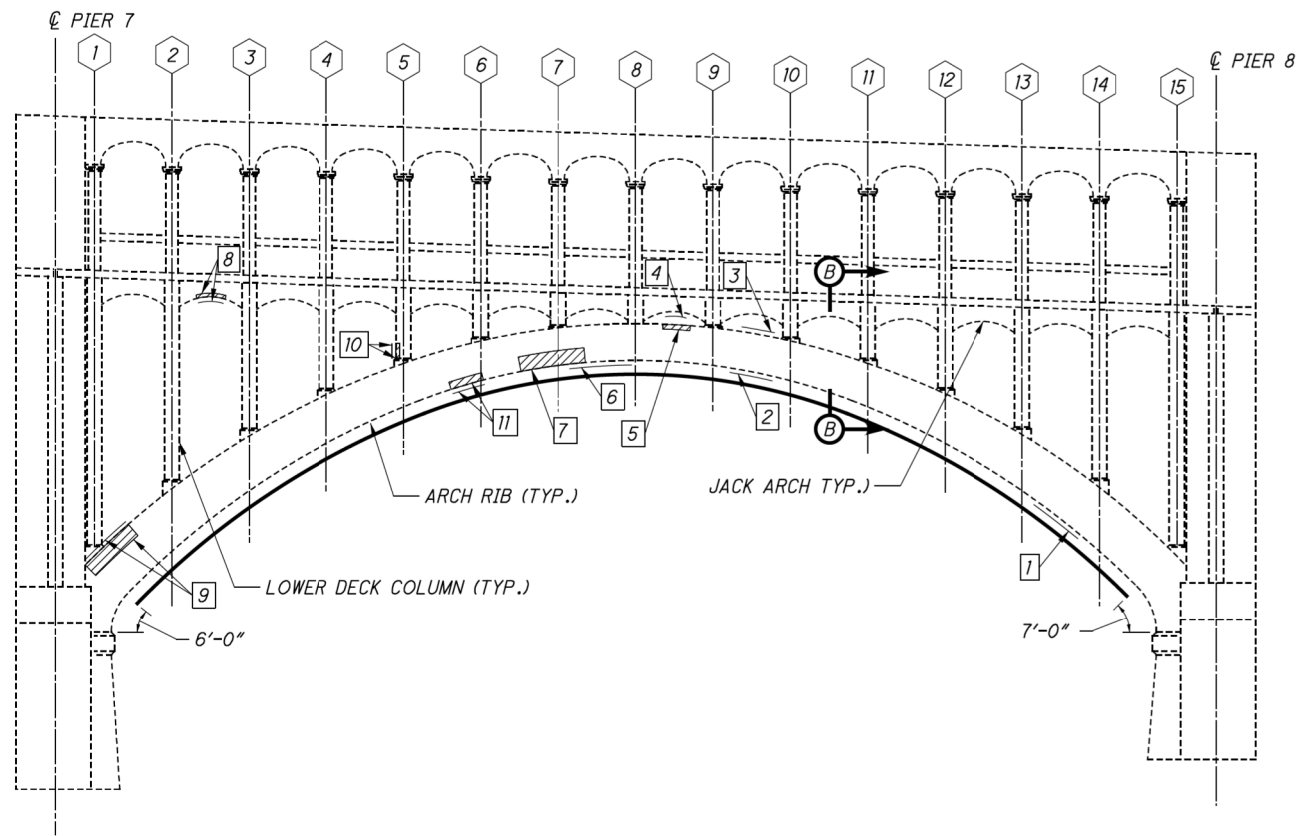

SPAN 8 - ARCH RIB B SOUTH ELEVATION
(LOOKING NORTH)

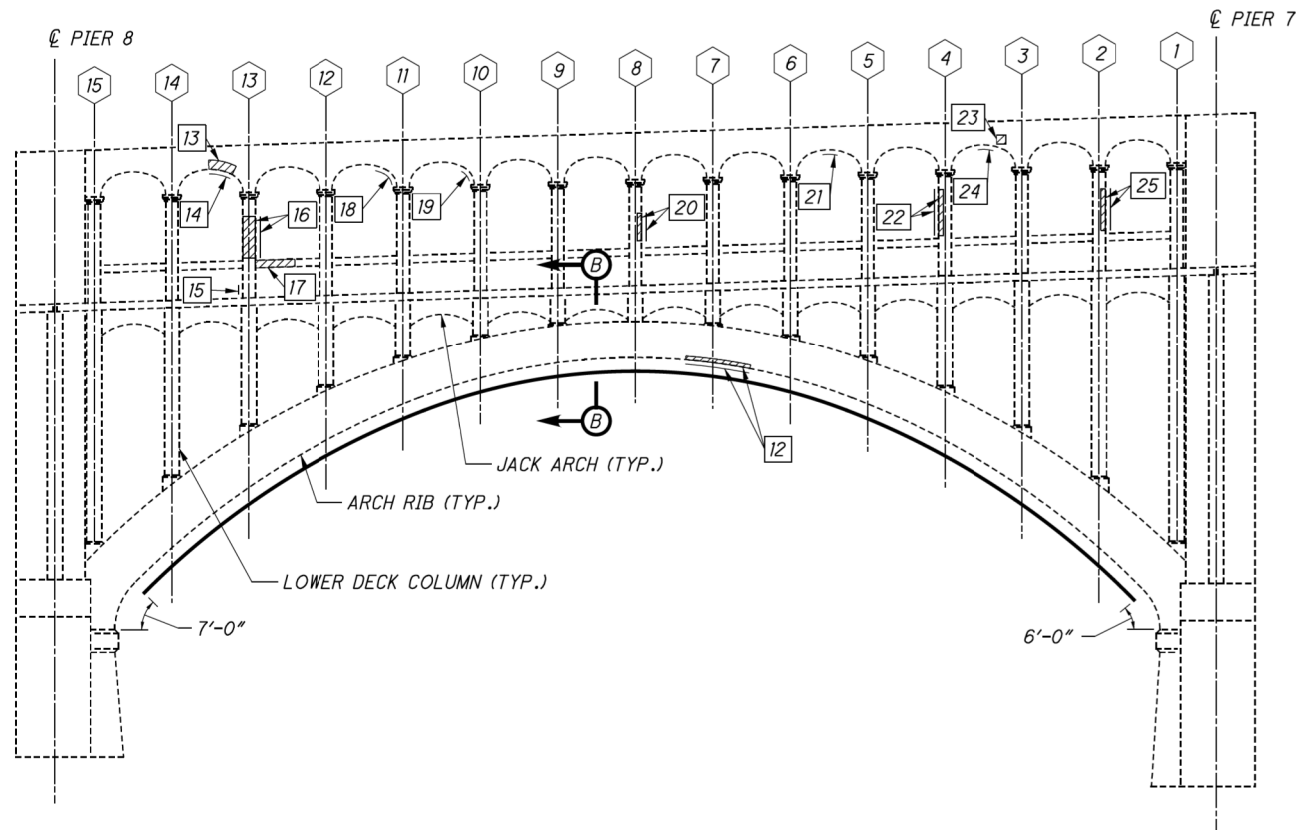

SPAN 8 - ARCH RIB B NORTH ELEVATION
(LOOKING SOUTH)

| ESTIMATED PATCHING QUANTITIES | | | |
|-------------------------------|-------------|-----------|------------------|
| REPAIR NO. | REPAIR TYPE | AREA (SF) | ANODE QUANTITY** |
| 1 | TYPE 2 | 9 | 5 |
| 2 | TYPE 2 | 32 | 12 |
| 3 | TYPE 1 | 5 | 3 |
| 4 | TYPE 2 | 3 | 3 |
| 5 | TYPE 1 | 4 | - |
| 6 | TYPE 2 | 11 | 4 |
| 7 | TYPE 1 | 23 | - |
| 8 | TYPE 2 | 2 | 2 |
| 9 | TYPE 1 | 11 | - |
| 10 | TYPE 1 | 2 | 1 |
| 11 | TYPE 2 | 6 | 2 |
| 12 | TYPE 2 | 13 | 8 |
| 13 | TYPE 1 | 2 | 1 |
| 14 | TYPE 2 | 2 | 1 |
| 15 | TYPE 1 | 1 | 1 |

| ESTIMATED PATCHING QUANTITIES | | | |
|-------------------------------|-------------|-----------|------------------|
| REPAIR NO. | REPAIR TYPE | AREA (SF) | ANODE QUANTITY** |
| 16 | TYPE 1 | 12 | 6 |
| 17 | TYPE 1 | 5 | 3 |
| 18 | TYPE 2 | 6 | 3 |
| 19 | TYPE 2 | 1 | 1 |
| 20 | TYPE 1 | 3 | 2 |
| 21 | TYPE 2 | 1 | 1 |
| 22 | TYPE 1 | 5 | 4 |
| 23 | TYPE 1 | 1 | 1 |
| 24 | TYPE 2 | 1 | 1 |
| 25 | TYPE 1 | 5 | 3 |
| MEASURED QUANTITY* | | 166 | - |
| PLAN QUANTITY* | | 249 | 68 |

* SEE NOTES 1 & 2
** SEE NOTES 3 & 4

| SHEET QUANTITY SUMMARY | | |
|------------------------|------|----------|
| ITEM | UNIT | QUANTITY |
| TYPE 1 REPAIR | SF | 119 |
| TYPE 2 REPAIR | SF | 130 |
| FRP WRAP | SF | 1985 |


NOTES:

- MEASURED QUANTITIES ARE BASED ON THE INSPECTION PERFORMED IN JANUARY 2017. THE EXACT DIMENSIONS AND LOCATIONS OF PATCHES SHALL BE DETERMINED BY THE ENGINEER IN THE FIELD FOR FINAL PAY QUANTITY.
- PLAN QUANTITIES INCLUDE 50% CONTINGENCY ADDED TO MEASURED QUANTITIES.
- ANODES ARE INCLUDED FOR PAYMENT WITH ITEM SPECIAL - PATCHING CONCRETE STRUCTURE, TYPE 1 OR TYPE 2 REPAIR.
- GALVANIC ANODES WILL NOT BE USED FOR PATCHING THE UNREINFORCED VERTICAL SIDES OF THE CONCRETE ARCH RIBS.
- FOR DETAILS AND MAXIMUM GRID SPACING FOR EMBEDDED GALVANIC ANODES, SEE SHEET [84/89].
- FOR PIER 7 AND PIER 8 REPAIR DETAILS, SEE SHEET [28/89].
- FOR FRP WRAP DETAILS AND SECTION B-B, SEE SHEET [85/89].


LEGEND:

- # SPANDREL COLUMN NUMBER
- # REPAIR NUMBER
- ▨ LOCATION OF DEFICIENT CONCRETE TO BE REPAIRED IN ACCORDANCE WITH ITEM SPECIAL - PATCHING CONCRETE STRUCTURE, TYPE 1 REPAIR
- ▤ LOCATION OF DEFICIENT CONCRETE ON PERPENDICULAR FACE (NOT VISIBLE IN ELEVATION VIEW) TO BE REPAIRED IN ACCORDANCE WITH ITEM SPECIAL - PATCHING CONCRETE STRUCTURE, TYPE 1 OR TYPE 2 REPAIR
- AREA TO BE TREATED WITH FRP WRAP PER ITEM SPECIAL - COMPOSITE FIBER WRAP SYSTEM

| | | | | |
|--------------------------------|-----------|--|--|--------------------------------|
| GRAPHIC SCALE MEASURED IN FEET | DATE |  9902 Carver Road
Suite 201
Cincinnati, OH 45242
PH.: 614.699.5000 | DETROIT-SUPERIOR BRIDGE OVER CUYAHOGA RIVER
BRIDGE NO. CUY-6-1465 | |
| NOT TO SCALE | NOV, 2018 | | INFRASTRUCTURE ENGINEERS, INC. | SPAN 8 CONCRETE REPAIR DETAILS |

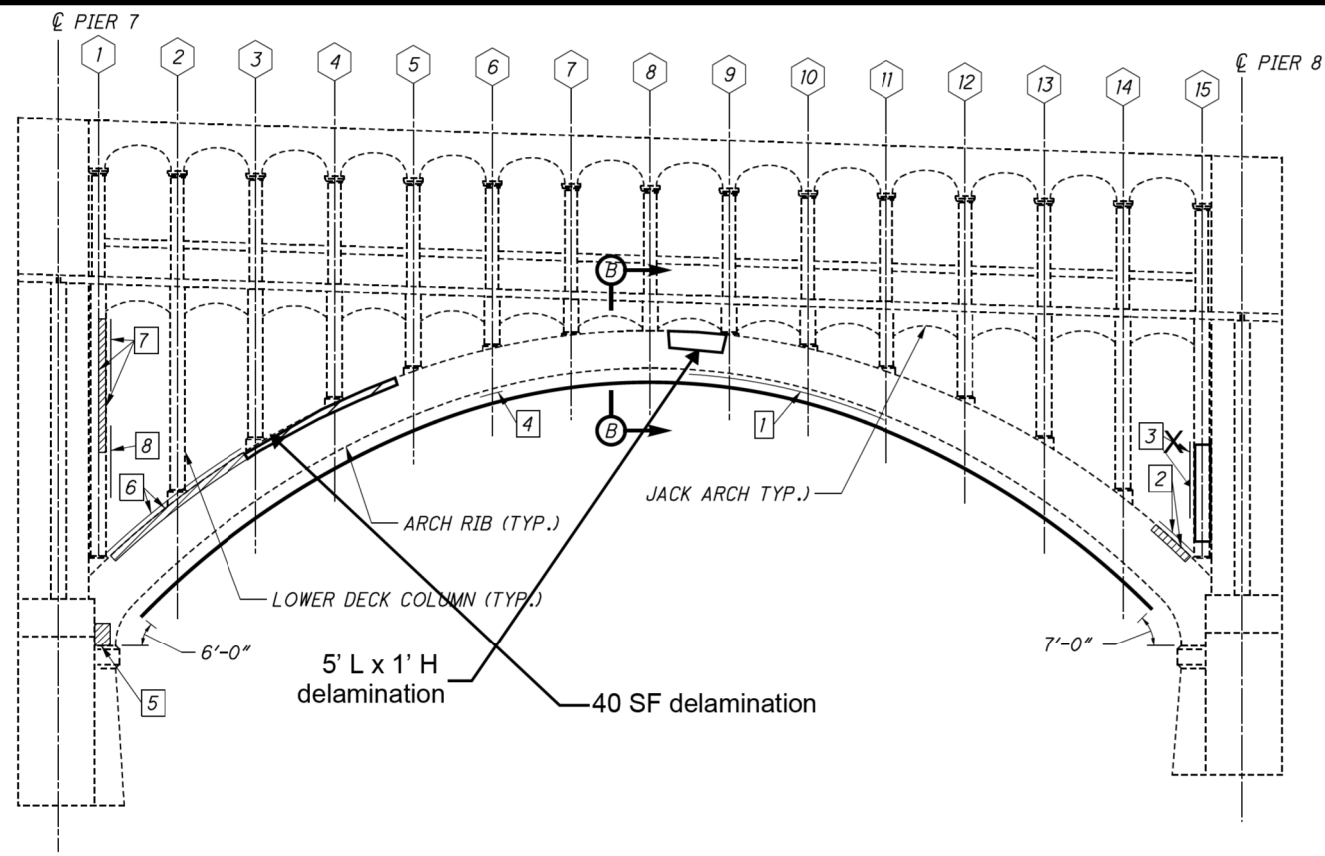

SPAN 8 - ARCH RIB C SOUTH ELEVATION
(LOOKING NORTH)

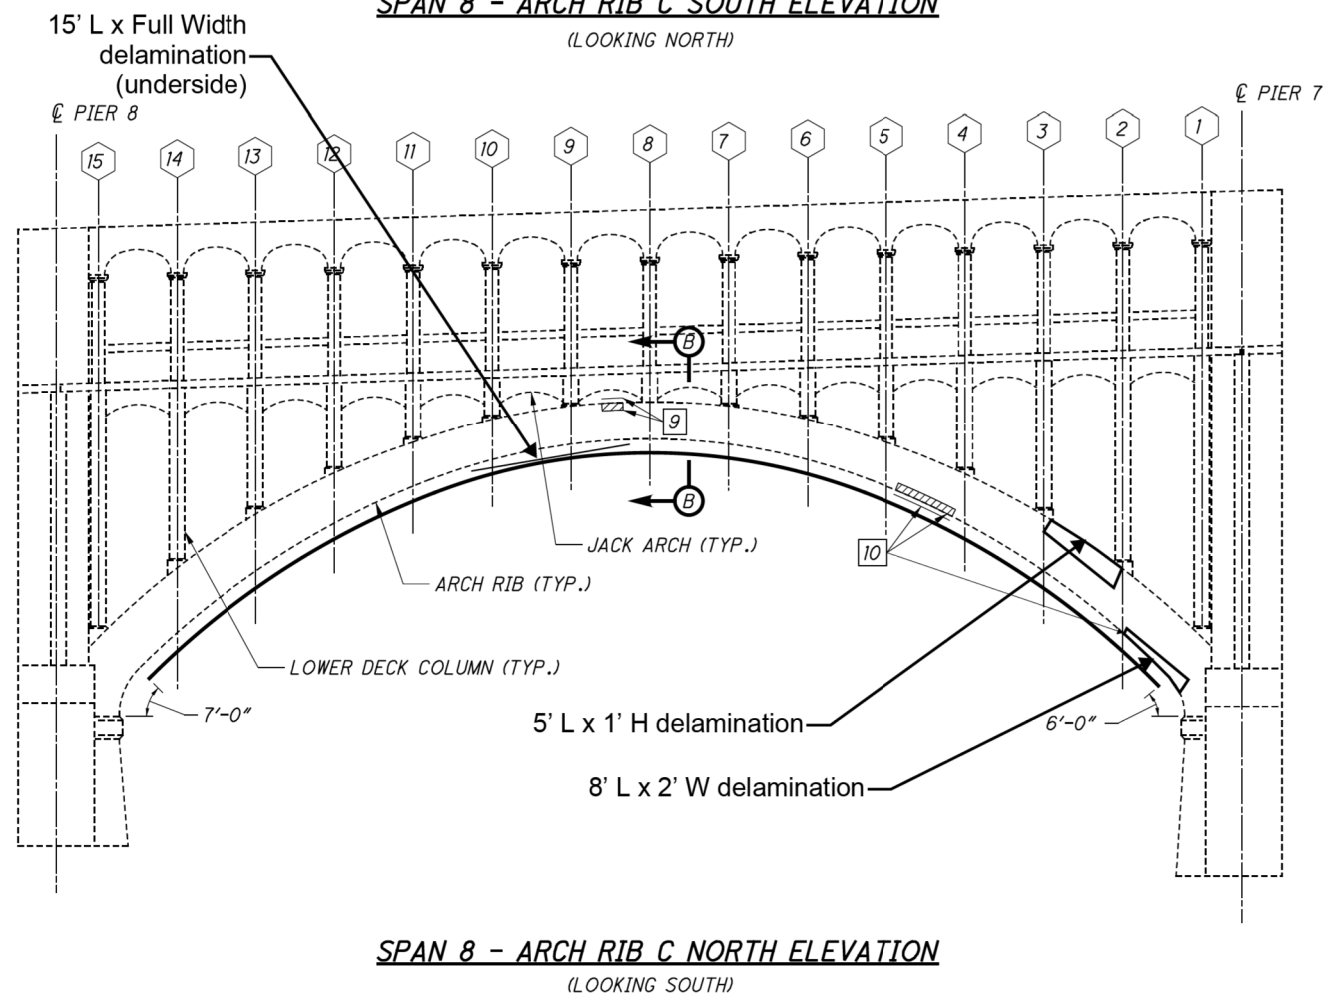

SPAN 8 - ARCH RIB C NORTH ELEVATION
(LOOKING SOUTH)

| ESTIMATED PATCHING QUANTITIES | | | |
|-------------------------------|-------------|-----------|------------------|
| REPAIR NO. | REPAIR TYPE | AREA (SF) | ANODE QUANTITY** |
| 1 | TYPE 2 | 192 | 44 |
| 2 | TYPE 1 | 26 | 12 |
| 3 | TYPE 1 | 35 | 10 |
| 4 | TYPE 2 | 4 | 1 |
| 5 | TYPE 1 | 6 | 2 |
| 6 | TYPE 1 | 40 | 15 |
| 7 | TYPE 1 | 175 | 36 |
| 8 | TYPE 1 | 10 | 5 |
| 9 | TYPE 1 | 3 | 2 |
| 10 | TYPE 2 | 21 | 10 |
| MEASURED QUANTITY* | | 512 | - |
| PLAN QUANTITY* | | 768 | 137 |

* SEE NOTES 1 & 2
** SEE NOTES 3 & 4

| SHEET QUANTITY SUMMARY | | |
|------------------------|------|----------|
| ITEM | UNIT | QUANTITY |
| TYPE 1 REPAIR | SF | 442 |
| TYPE 2 REPAIR | SF | 326 |
| FRP WRAP | SF | 1985 |


NOTES:

- MEASURED QUANTITIES ARE BASED ON THE INSPECTION PERFORMED IN JANUARY 2017. THE EXACT DIMENSIONS AND LOCATIONS OF PATCHES SHALL BE DETERMINED BY THE ENGINEER IN THE FIELD FOR FINAL PAY QUANTITY.
- PLAN QUANTITIES INCLUDE 50% CONTINGENCY ADDED TO MEASURED QUANTITIES.
- ANODES ARE INCLUDED FOR PAYMENT WITH ITEM SPECIAL - PATCHING CONCRETE STRUCTURE, TYPE 1 OR TYPE 2 REPAIR.
- GALVANIC ANODES WILL NOT BE USED FOR PATCHING THE UNREINFORCED VERTICAL SIDES OF THE CONCRETE ARCH RIBS.
- FOR DETAILS AND MAXIMUM GRID SPACING FOR EMBEDDED GALVANIC ANODES, SEE SHEET [84/89].
- FOR PIER 7 AND PIER 8 REPAIR DETAILS, SEE SHEET [28/89].
- FOR FRP WRAP DETAILS AND SECTION B-B, SEE SHEET [85/89].


LEGEND:

- # SPANDREL COLUMN NUMBER
- # REPAIR NUMBER
- [Hatched Box] LOCATION OF DEFICIENT CONCRETE TO BE REPAIRED IN ACCORDANCE WITH ITEM SPECIAL - PATCHING CONCRETE STRUCTURE, TYPE 1 REPAIR
- [Dashed Box] LOCATION OF DEFICIENT CONCRETE ON PERPENDICULAR FACE (NOT VISIBLE IN ELEVATION VIEW) TO BE REPAIRED IN ACCORDANCE WITH ITEM SPECIAL - PATCHING CONCRETE STRUCTURE, TYPE 1 OR TYPE 2 REPAIR
- [Dotted Line] AREA TO BE TREATED WITH FRP WRAP PER ITEM SPECIAL - COMPOSITE FIBER WRAP SYSTEM

| | | | | |
|--------------------------------|-----------|--|--|--------------------------------|
| GRAPHIC SCALE MEASURED IN FEET | DATE |  9902 Carver Road
Suite 201
Cincinnati, OH 45242
PH.: 614.699.5000 | DETROIT-SUPERIOR BRIDGE OVER CUYAHOGA RIVER
BRIDGE NO. CUY-6-1465 | |
| NOT TO SCALE | NOV, 2018 | | INFRASTRUCTURE ENGINEERS, INC. | SPAN 8 CONCRETE REPAIR DETAILS |

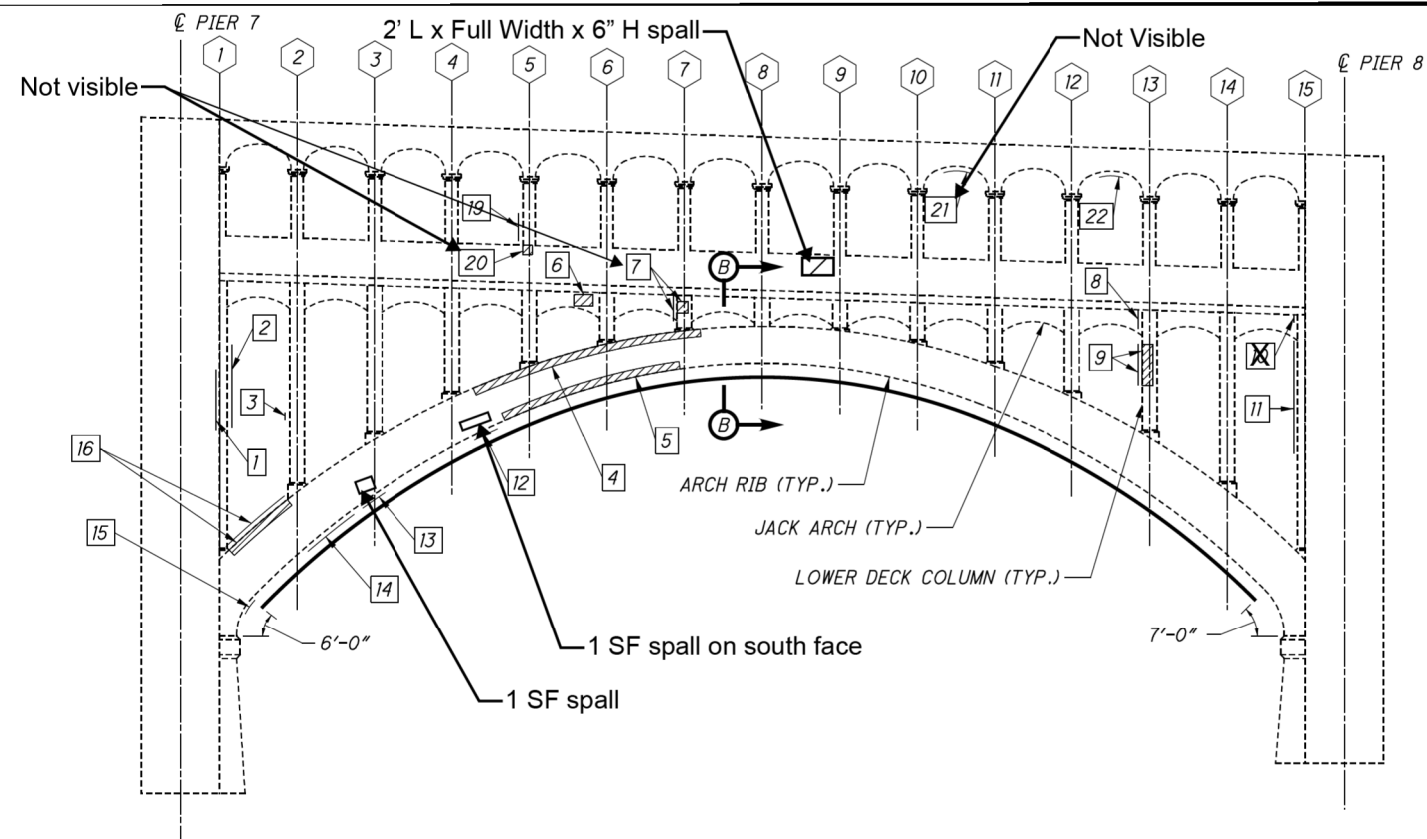

SPAN 8 - ARCH RIB D SOUTH ELEVATION
(LOOKING NORTH)

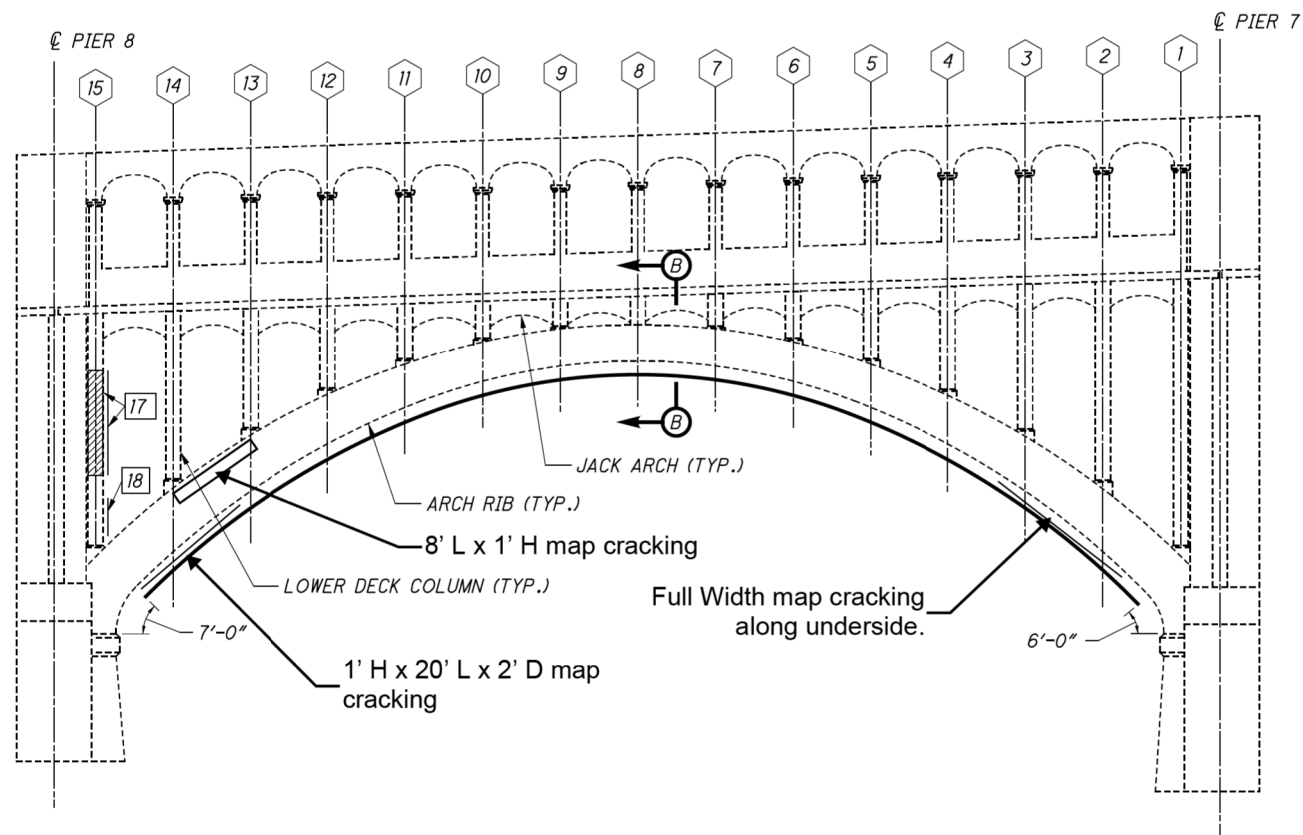

SPAN 8 - ARCH RIB D NORTH ELEVATION
(LOOKING SOUTH)

| ESTIMATED PATCHING QUANTITIES | | | |
|-------------------------------|-------------|-----------|------------------|
| REPAIR NO. | REPAIR TYPE | AREA (SF) | ANODE QUANTITY** |
| 1 | TYPE 1 | 12 | 4 |
| 2 | TYPE 1 | 11 | 5 |
| 3 | TYPE 1 | 1 | 1 |
| 4 | TYPE 1 | 65 | - |
| 5 | TYPE 1 | 30 | - |
| 6 | TYPE 1 | 4 | 2 |
| 7 | TYPE 1 | 12 | 8 |
| 8 | TYPE 1 | 5 | 1 |
| 9 | TYPE 1 | 16 | 3 |
| 10 | TYPE 1 | 1 | 1 |
| 11 | TYPE 1 | 23 | 7 |
| 12 | TYPE 2 | 8 | 3 |
| 13 | TYPE 2 | 4 | 2 |
| 14 | TYPE 2 | 15 | 6 |
| 15 | TYPE 2 | 5 | 2 |

| ESTIMATED PATCHING QUANTITIES | | | |
|-------------------------------|-------------|-----------|------------------|
| REPAIR NO. | REPAIR TYPE | AREA (SF) | ANODE QUANTITY** |
| 16 | TYPE 1 | 27 | 12 |
| 17 | TYPE 1 | 56 | 22 |
| 18 | TYPE 1 | 5 | 4 |
| 19 | TYPE 1 | 5 | 2 |
| 20 | TYPE 1 | 1 | 1 |
| 21 | TYPE 2 | 4 | 3 |
| 22 | TYPE 2 | 3 | 2 |
| MEASURED QUANTITY* | | 313 | - |
| PLAN QUANTITY* | | 470 | 91 |

* SEE NOTES 1 & 2
** SEE NOTES 3 & 4

| SHEET QUANTITY SUMMARY | | |
|------------------------|------|----------|
| ITEM | UNIT | QUANTITY |
| TYPE 1 REPAIR | SF | 411 |
| TYPE 2 REPAIR | SF | 59 |
| FRP WRAP | SF | 1680 |


NOTES:

1. MEASURED QUANTITIES ARE BASED ON THE INSPECTION PERFORMED IN JANUARY 2017. THE EXACT DIMENSIONS AND LOCATIONS OF PATCHES SHALL BE DETERMINED BY THE ENGINEER IN THE FIELD FOR FINAL PAY QUANTITY.
2. PLAN QUANTITIES INCLUDE 50% CONTINGENCY ADDED TO MEASURED QUANTITIES.
3. ANODES ARE INCLUDED FOR PAYMENT WITH ITEM SPECIAL - PATCHING CONCRETE STRUCTURE, TYPE 1 OR TYPE 2 REPAIR.
4. GALVANIC ANODES WILL NOT BE USED FOR PATCHING THE UNREINFORCED VERTICAL SIDES OF THE CONCRETE ARCH RIBS.
5. FOR DETAILS AND MAXIMUM GRID SPACING FOR EMBEDDED GALVANIC ANODES, SEE SHEET [84/89].
6. FOR PIER 7 AND PIER 8 REPAIR DETAILS, SEE SHEET [28/89].
7. FOR FRP WRAP DETAILS AND SECTION B-B, SEE SHEET [85/89].


LEGEND:

- # SPANDREL COLUMN NUMBER
- # REPAIR NUMBER
- ▨ LOCATION OF DEFICIENT CONCRETE TO BE REPAIRED IN ACCORDANCE WITH ITEM SPECIAL - PATCHING CONCRETE STRUCTURE, TYPE 1 REPAIR
- ⋮ LOCATION OF DEFICIENT CONCRETE ON PERPENDICULAR FACE (NOT VISIBLE IN ELEVATION VIEW) TO BE REPAIRED IN ACCORDANCE WITH ITEM SPECIAL - PATCHING CONCRETE STRUCTURE, TYPE 1 OR TYPE 2 REPAIR
- AREA TO BE TREATED WITH FRP WRAP PER ITEM SPECIAL - COMPOSITE FIBER WRAP SYSTEM

| | | | | |
|--------------------------------|-----------|--|--|--------------------------------|
| GRAPHIC SCALE MEASURED IN FEET | DATE |  9902 Carver Road
Suite 201
Cincinnati, OH 45242
PH.: 614.699.5000 | DETROIT-SUPERIOR BRIDGE OVER CUYAHOGA RIVER
BRIDGE NO. CUY-6-1465 | |
| NOT TO SCALE | NOV, 2018 | | INFRASTRUCTURE ENGINEERS, INC. | SPAN 8 CONCRETE REPAIR DETAILS |

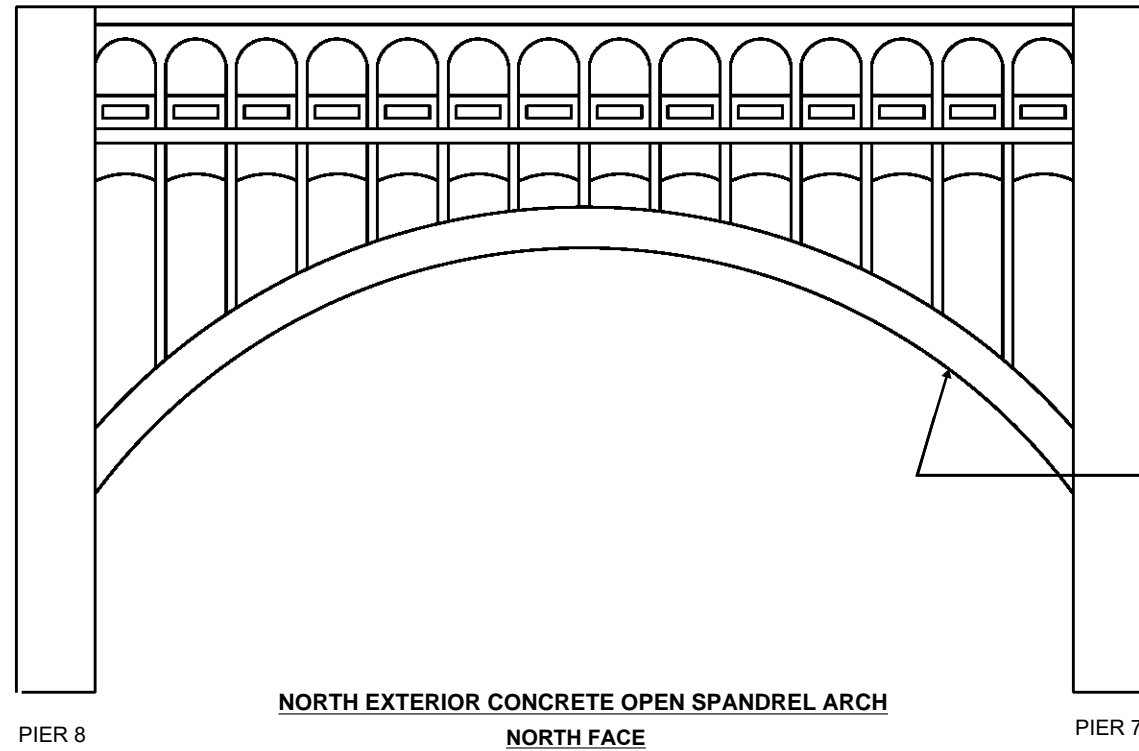



Underside of arch is cracked and delaminated on the east end

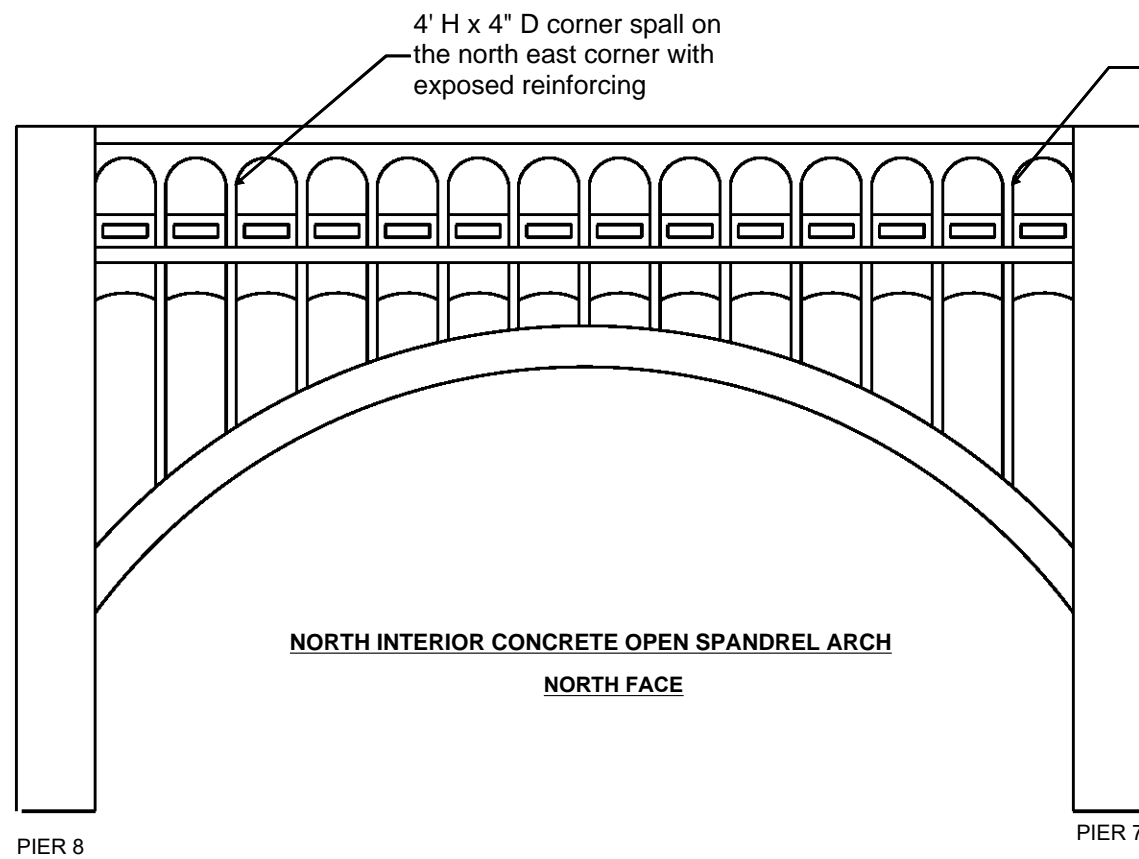

4' H x 4" D corner spall on the north east corner with exposed reinforcing



Corner spall on the northeast corner up to 4" D with exposed reinforcing

| | | | | |
|--|---|--|--|--|
| <p>GRAPHIC SCALE MEASURED IN FEET</p> <p style="text-align: center;">NOT TO SCALE</p> | <p>DATE</p> <p style="text-align: center;">NOV, 2018</p> |  <p style="font-size: 8px;">9902 Carver Road
Suite 201
Cincinnati, OH 45242
PH.: 614.699.5000</p> <p style="font-weight: bold; font-size: 10px;">INFRASTRUCTURE
ENGINEERS, INC.</p> | <p>DETROIT-SUPERIOR BRIDGE OVER CUYAHOGA RIVER
BRIDGE NO. CUY-6-1465</p> <p style="text-align: center;">STRUCTURE ELEVATION - SPAN 8</p> | <p>PAGE</p> <p style="text-align: center;">A-82</p> |
|--|---|--|--|--|

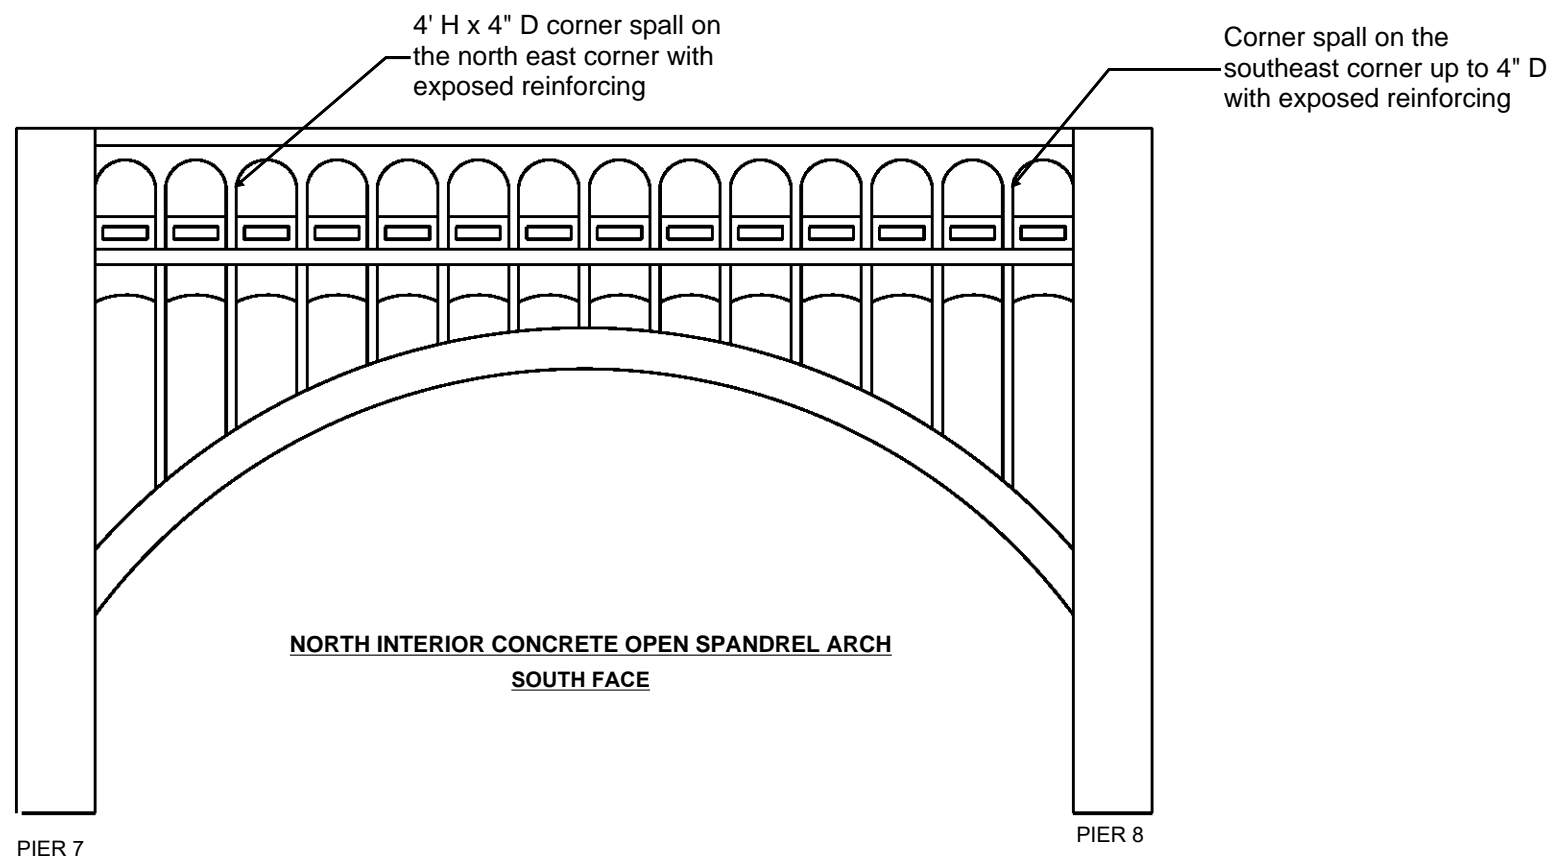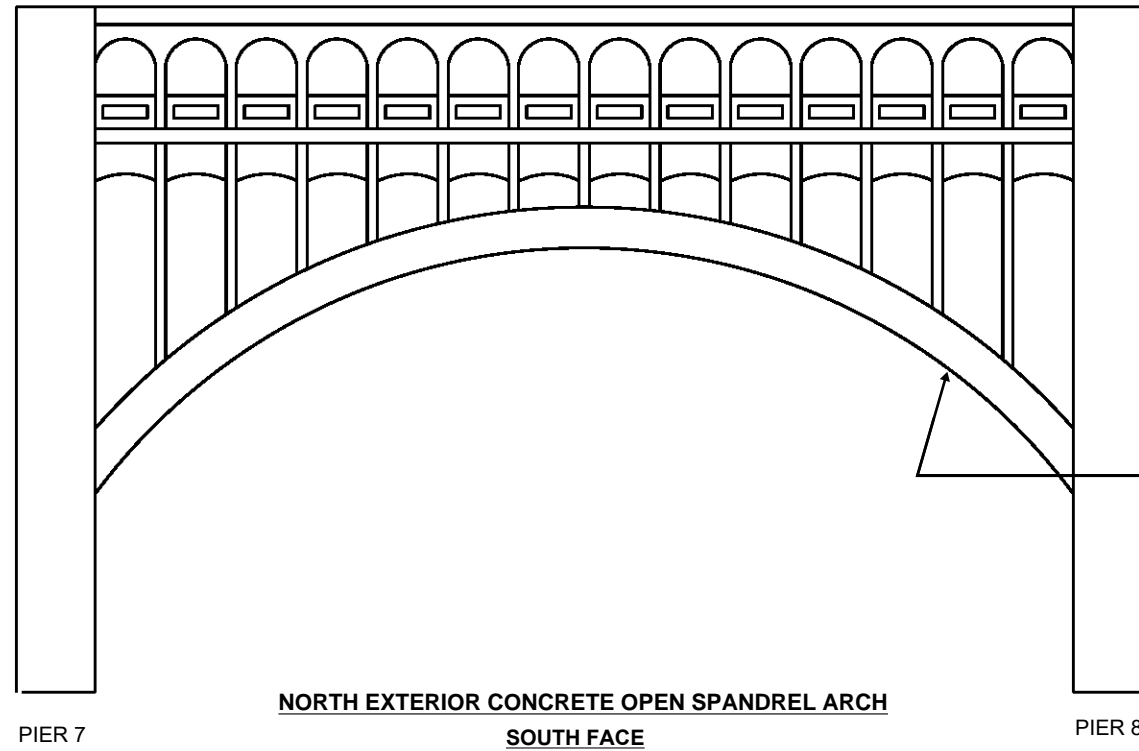


| | | | | |
|--------------------------------|-----------|---|--|------|
| GRAPHIC SCALE MEASURED IN FEET | DATE |  | DETROIT-SUPERIOR BRIDGE OVER CUYAHOGA RIVER
BRIDGE NO. CUY-6-1465 | PAGE |
| NOT TO SCALE | NOV, 2018 | <small>9902 Carver Road
Suite 201
Cincinnati, OH 45242
PH.: 614.699.5000</small>
INFRASTRUCTURE ENGINEERS, INC. | STRUCTURE ELEVATION - SPAN 8 | A-83 |


Floor beam 14 between the interior and exterior arches with 3' H x 4' W x 4" D with exposed reinforcing on the west face

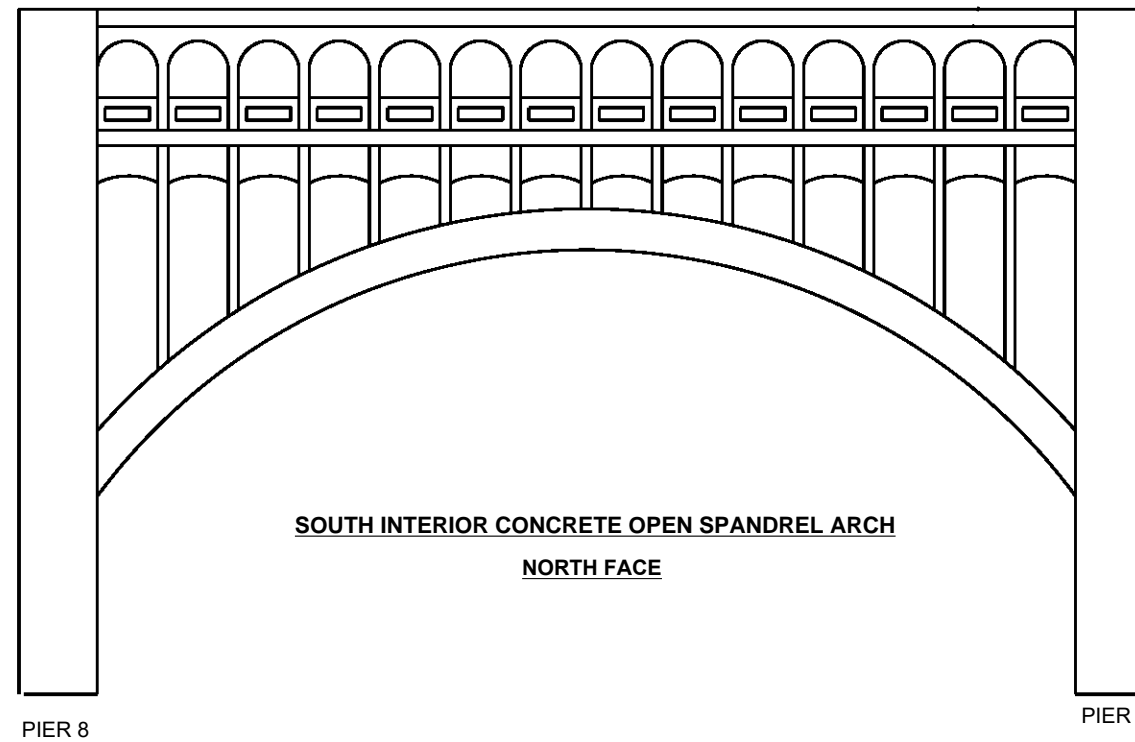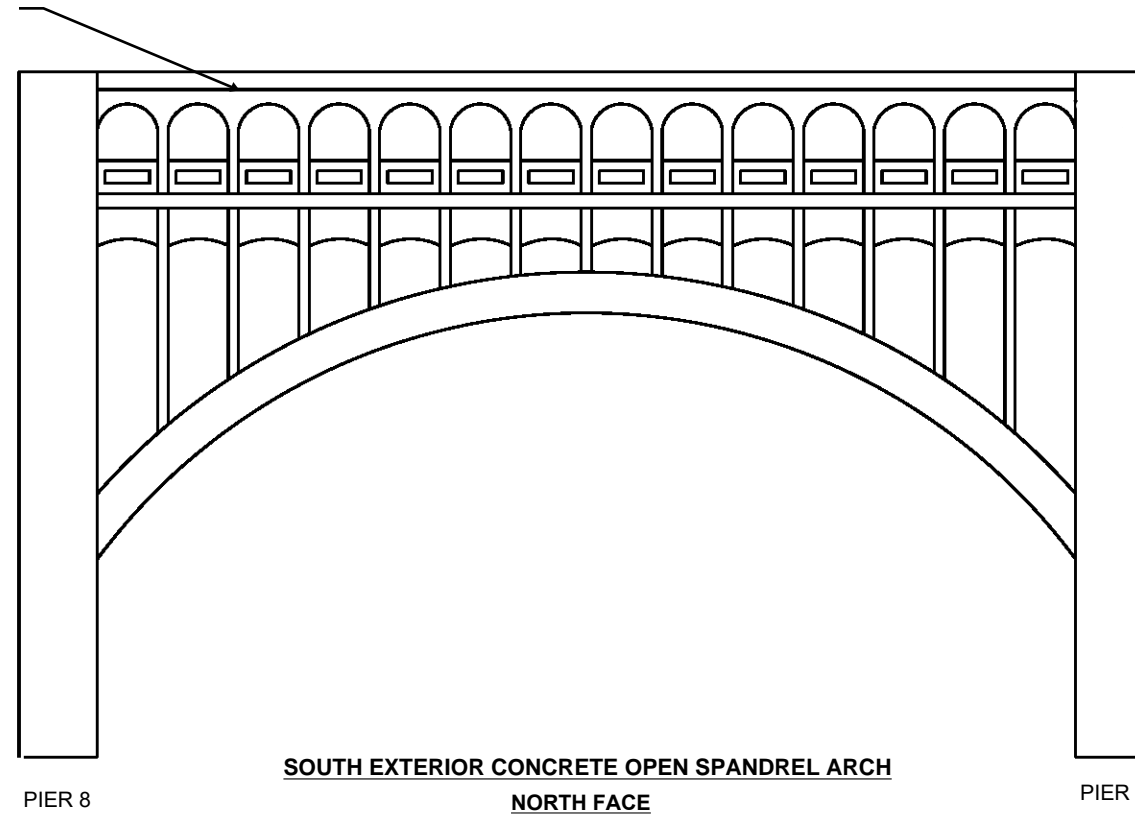

| | | | |
|---------------------------------------|------------------|--|--|
| <p>GRAPHIC SCALE MEASURED IN FEET</p> | <p>DATE</p> |  <p>9902 Carver Road
Suite 201
Cincinnati, OH 45242
PH.: 614.699.5000</p> | <p>DETROIT-SUPERIOR BRIDGE OVER CUYAHOGA RIVER
BRIDGE NO. CUY-6-1465</p> |
| <p>NOT TO SCALE</p> | <p>NOV, 2018</p> | <p>INFRASTRUCTURE
ENGINEERS, INC.</p> | <p>STRUCTURE ELEVATION - SPAN 8</p> <p>PAGE
A-84</p> |

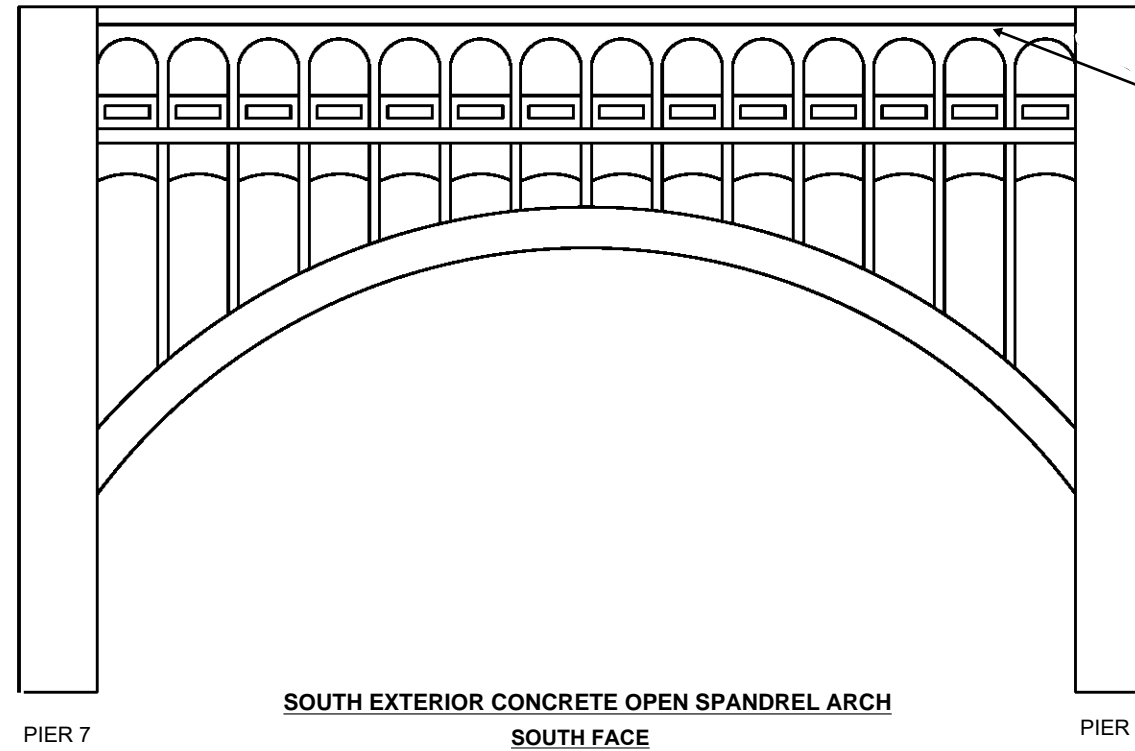


Floor beam 14 between the interior and exterior arches with 3' H x 4' W x 4" D with exposed reinforcing on the west face

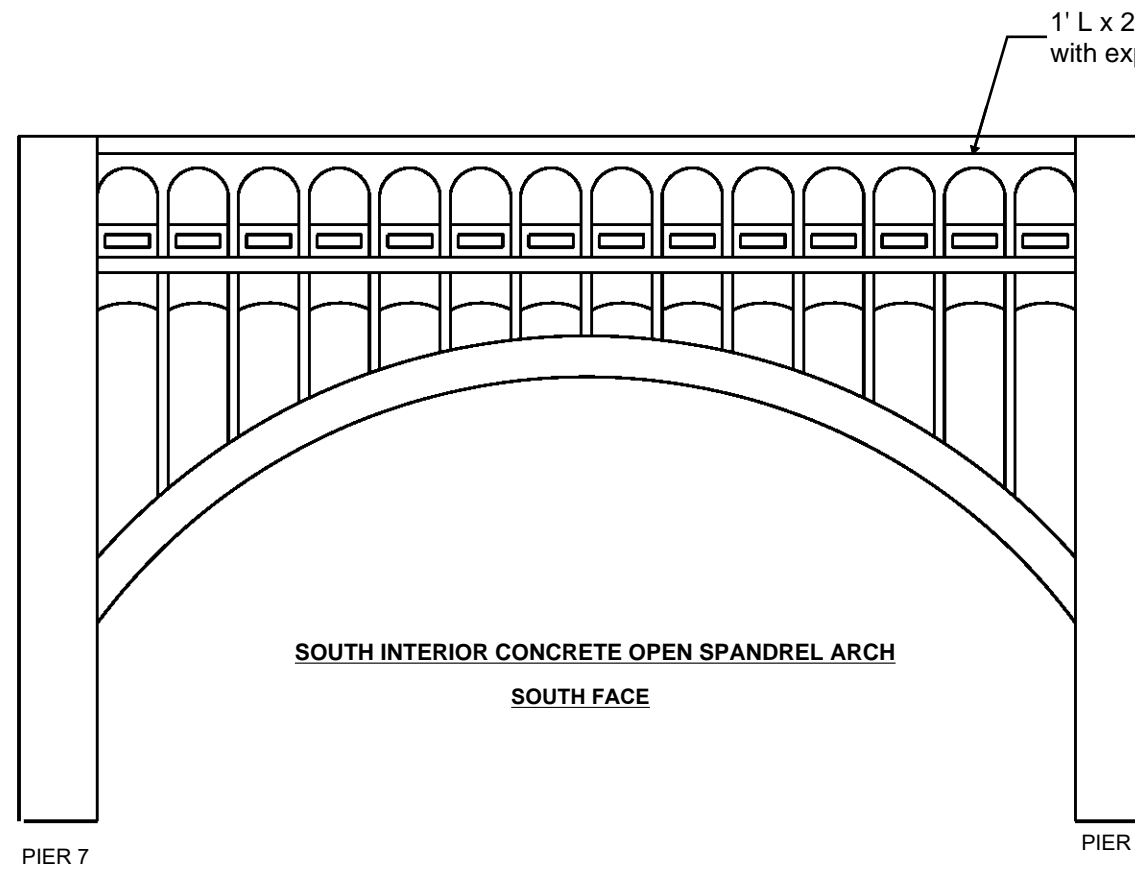


1' L x 2" D spall with exposed rebar

| | | | | |
|---|--|---|--|---|
| <p>GRAPHIC SCALE MEASURED IN FEET</p> <hr/> <p style="text-align: center;">NOT TO SCALE</p> | <p>DATE</p> <p style="text-align: center;">NOV, 2018</p> | <p style="font-size: 8px; margin: 0;">9902 Carver Road
Suite 201
Cincinnati, OH 45242
PH.: 614.699.5000</p> <p style="font-weight: bold; margin: 5px 0 0 0;">INFRASTRUCTURE
ENGINEERS, INC.</p> | <p style="text-align: center; font-weight: bold; font-size: 10px;">DETROIT-SUPERIOR BRIDGE OVER CUYAHOGA RIVER
BRIDGE NO. CUY-6-1465</p> <hr/> <p style="text-align: center; font-weight: bold; font-size: 10px;">STRUCTURE ELEVATION - SPAN 8</p> | <p>PAGE</p> <p style="text-align: center;">A-85</p> |
|---|--|---|--|---|

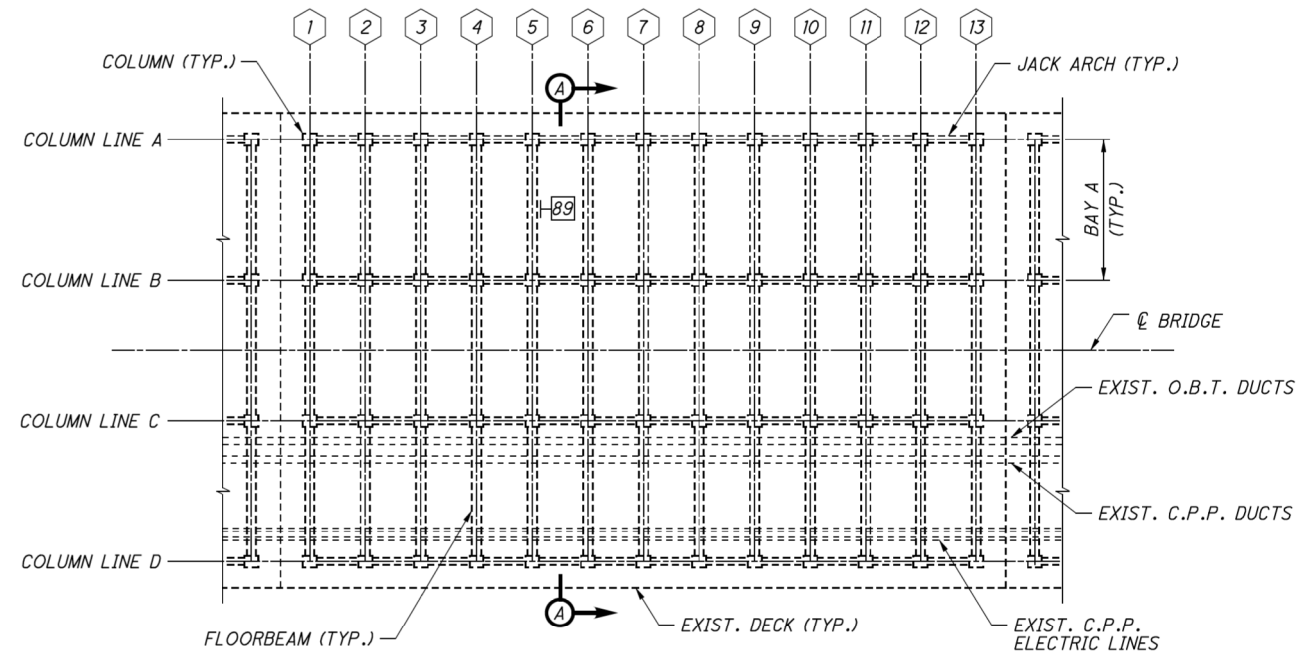

SPAN 9 - UPPER DECK PLAN

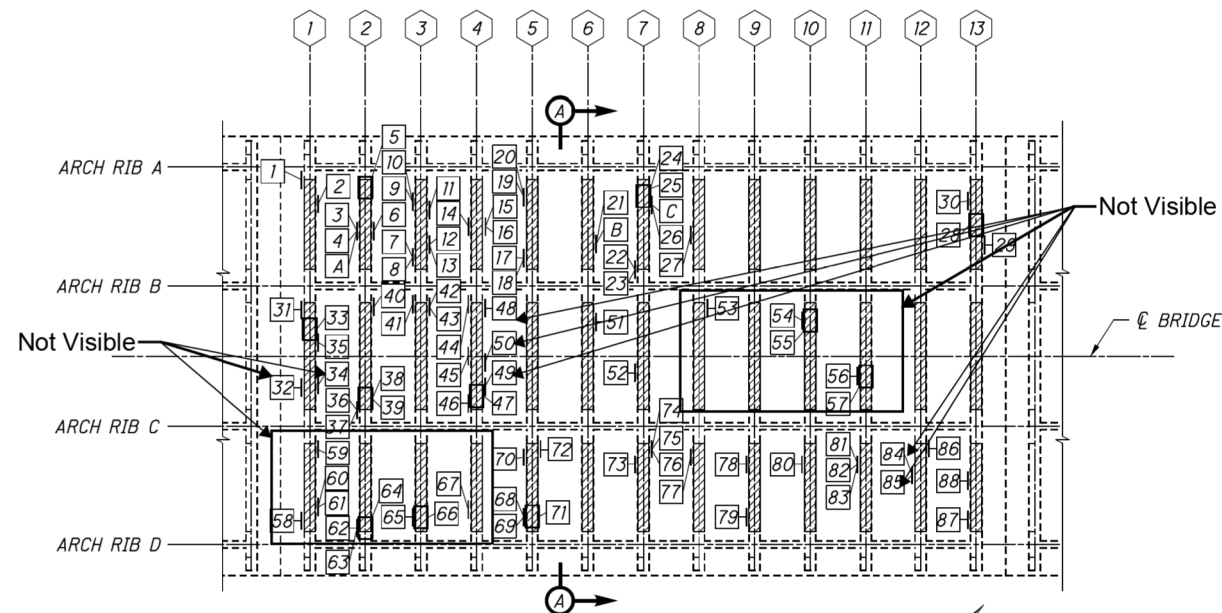

SPAN 9 - LOWER DECK PLAN

TYPICAL NOTES
 NUMEROUS EPOXY INJECTED VERTICAL CRACKS THROUGHOUT THE FLOORBEAMS. VARIOUS ENDS OF THE FLOORBEAMS THROUGHOUT ALL SPANS HAVE BEEN REHABBED.

NOTES:

1. MEASURED QUANTITIES ARE BASED ON THE INSPECTION PERFORMED IN DECEMBER 2016. THE EXACT DIMENSIONS AND LOCATIONS OF PATCHES SHALL BE DETERMINED BY THE ENGINEER IN THE FIELD FOR FINAL PAY QUANTITY.
2. PLAN QUANTITIES INCLUDE 50% CONTINGENCY ADDED TO MEASURED QUANTITIES.
3. ANODES ARE INCLUDED FOR PAYMENT WITH ITEM SPECIAL - PATCHING CONCRETE STRUCTURE, TYPE 1 OR TYPE 2 REPAIR.
4. FOR DETAILS AND MAXIMUM GRID SPACING FOR EMBEDDED GALVANIC ANODES, SEE SHEET 84/89.
5. FOR SECTION A-A, SEE SHEET 34/89.
6. FOR FRP WRAP DETAILS, SEE SHEET 85/89.

| ESTIMATED PATCHING QUANTITIES | | | |
|-------------------------------|-------------|-----------|------------------|
| REPAIR NO. | REPAIR TYPE | AREA (SF) | ANODE QUANTITY** |
| 1 | TYPE 1 | 4 | 1 |
| 2 | TYPE 1 | 5 | 1 |
| 3 | TYPE 1 | 1 | 1 |
| 4 | TYPE 1 | 3 | 1 |
| 5 | TYPE 2 | 9 | 5 |
| 6 | TYPE 1 | 1 | 1 |
| 7 | TYPE 1 | 3 | 1 |
| 8 | TYPE 1 | 4 | 1 |
| 9 | TYPE 1 | 4 | 1 |
| 10 | TYPE 1 | 2 | 1 |
| 11 | TYPE 1 | 4 | 1 |
| 12 | TYPE 1 | 4 | 1 |
| 13 | TYPE 1 | 2 | 1 |
| 14 | TYPE 1 | 24 | 6 |
| 15 | TYPE 1 | 3 | 1 |
| 16 | TYPE 1 | 2 | 1 |
| 17 | TYPE 1 | 3 | 1 |
| 18 | TYPE 1 | 2 | 1 |
| 19 | TYPE 1 | 6 | 2 |
| 20 | TYPE 1 | 3 | 1 |
| 21 | TYPE 1 | 2 | 1 |
| 22 | TYPE 1 | 2 | 1 |
| 23 | TYPE 1 | 1 | 1 |
| 24 | TYPE 2 | 7 | 6 |
| 25 | TYPE 2 | 1 | 1 |
| 26 | TYPE 1 | 3 | 1 |
| 27 | TYPE 1 | 21 | 6 |
| 28 | TYPE 2 | 28 | 11 |
| 29 | TYPE 1 | 18 | 6 |
| 30 | TYPE 1 | 46 | 12 |
| 31 | TYPE 1 | 29 | 8 |
| 32 | TYPE 1 | 19 | 6 |
| 33 | TYPE 2 | 6 | 5 |
| 34 | TYPE 1 | 8 | 2 |
| 35 | TYPE 1 | 3 | 3 |
| 36 | TYPE 1 | 1 | 1 |
| 37 | TYPE 1 | 1 | 1 |
| 38 | TYPE 2 | 2 | 1 |
| 39 | TYPE 2 | 1 | 1 |
| 40 | TYPE 1 | 2 | 1 |
| 41 | TYPE 1 | 2 | 1 |
| 42 | TYPE 1 | 4 | 1 |
| 43 | TYPE 1 | 1 | 1 |
| 44 | TYPE 1 | 2 | 1 |
| 45 | TYPE 1 | 23 | 6 |
| 46 | TYPE 1 | 3 | 1 |

| ESTIMATED PATCHING QUANTITIES | | | |
|-------------------------------|-------------|-----------|------------------|
| REPAIR NO. | REPAIR TYPE | AREA (SF) | ANODE QUANTITY** |
| 47 | TYPE 2 | 3 | 4 |
| 48 | TYPE 1 | 2 | 1 |
| 49 | TYPE 1 | 3 | 3 |
| 50 | TYPE 1 | 3 | 1 |
| 51 | TYPE 1 | 2 | 1 |
| 52 | TYPE 1 | 2 | 1 |
| 53 | TYPE 1 | 2 | 1 |
| 54 | TYPE 1 | 5 | 5 |
| 55 | TYPE 2 | 7 | 7 |
| 56 | TYPE 1 | 4 | 4 |
| 57 | TYPE 2 | 7 | 6 |
| 58 | TYPE 1 | 19 | 6 |
| 59 | TYPE 1 | 5 | 1 |
| 60 | TYPE 1 | 18 | 4 |
| 61 | TYPE 1 | 3 | 1 |
| 62 | TYPE 1 | 6 | 1 |
| 63 | TYPE 1 | 2 | 1 |
| 64 | TYPE 2 | 2 | 1 |
| 65 | TYPE 1 | 2 | 2 |
| 66 | TYPE 2 | 3 | 3 |
| 67 | TYPE 1 | 5 | 2 |
| 68 | TYPE 1 | 4 | 3 |
| 69 | TYPE 1 | 4 | 1 |
| 70 | TYPE 1 | 2 | 1 |
| 71 | TYPE 2 | 4 | 5 |
| 72 | TYPE 1 | 2 | 1 |
| 73 | TYPE 1 | 1 | 1 |
| 74 | TYPE 1 | 1 | 1 |
| 75 | TYPE 1 | 2 | 1 |
| 76 | TYPE 1 | 3 | 2 |
| 77 | TYPE 1 | 4 | 1 |
| 78 | TYPE 1 | 2 | 1 |
| 79 | TYPE 1 | 2 | 1 |
| 80 | TYPE 1 | 2 | 1 |
| 81 | TYPE 1 | 6 | 2 |
| 82 | TYPE 1 | 4 | 2 |
| 83 | TYPE 1 | 3 | 1 |
| 84 | TYPE 1 | 7 | 2 |
| 85 | TYPE 1 | 4 | 1 |
| 86 | TYPE 1 | 2 | 1 |
| 87 | TYPE 1 | 24 | 6 |
| 88 | TYPE 1 | 14 | 4 |
| 89 | TYPE 1 | 1 | 1 |
| MEASURED QUANTITY* | | 528 | - |
| PLAN QUANTITY* | | 792 | 212 |

* SEE NOTES 1 & 2
 ** SEE NOTE 3

LEGEND:


- # FLOORBEAM LINE NUMBER
- # REPAIR NO. OF DEFICIENT CONCRETE TO BE REPAIRED IN ACCORDANCE WITH ITEM SPECIAL - PATCHING CONCRETE STRUCTURE, TYPE 1 OR TYPE 2 REPAIR.
- A REPAIR NO. OF DEFICIENT CONCRETE TO BE REPAIRED IN ACCORDANCE WITH SUPPLEMENTAL SPECIFICATION 843
- AREA TO BE TREATED WITH FRP WRAP PER ITEM SPECIAL - COMPOSITE FIBER WRAP SYSTEM

| | | | |
|--------------------|-------|----|---|
| A | SS843 | 15 | - |
| B | SS843 | 2 | - |
| C | SS843 | 1 | - |
| MEASURED QUANTITY* | | 18 | - |


SHEET QUANTITY SUMMARY

| ITEM | UNIT | QUANTITY |
|---------------|------|----------|
| TYPE 1 REPAIR | SF | 672 |
| TYPE 2 REPAIR | SF | 120 |
| FRP WRAP | SF | 3348 |

| | | | | |
|--------------------------------|--------------|--|--|--------------------------------|
| GRAPHIC SCALE MEASURED IN FEET | DATE | 9902 Carver Road
Suite 201
Cincinnati, OH 45242
PH.: 614.699.5000 | DETROIT-SUPERIOR BRIDGE OVER CUYAHOGA RIVER
BRIDGE NO. CUY-6-1465 | |
| | NOT TO SCALE | | NOV, 2018 | INFRASTRUCTURE ENGINEERS, INC. |
| | | | | PAGE A-86 |

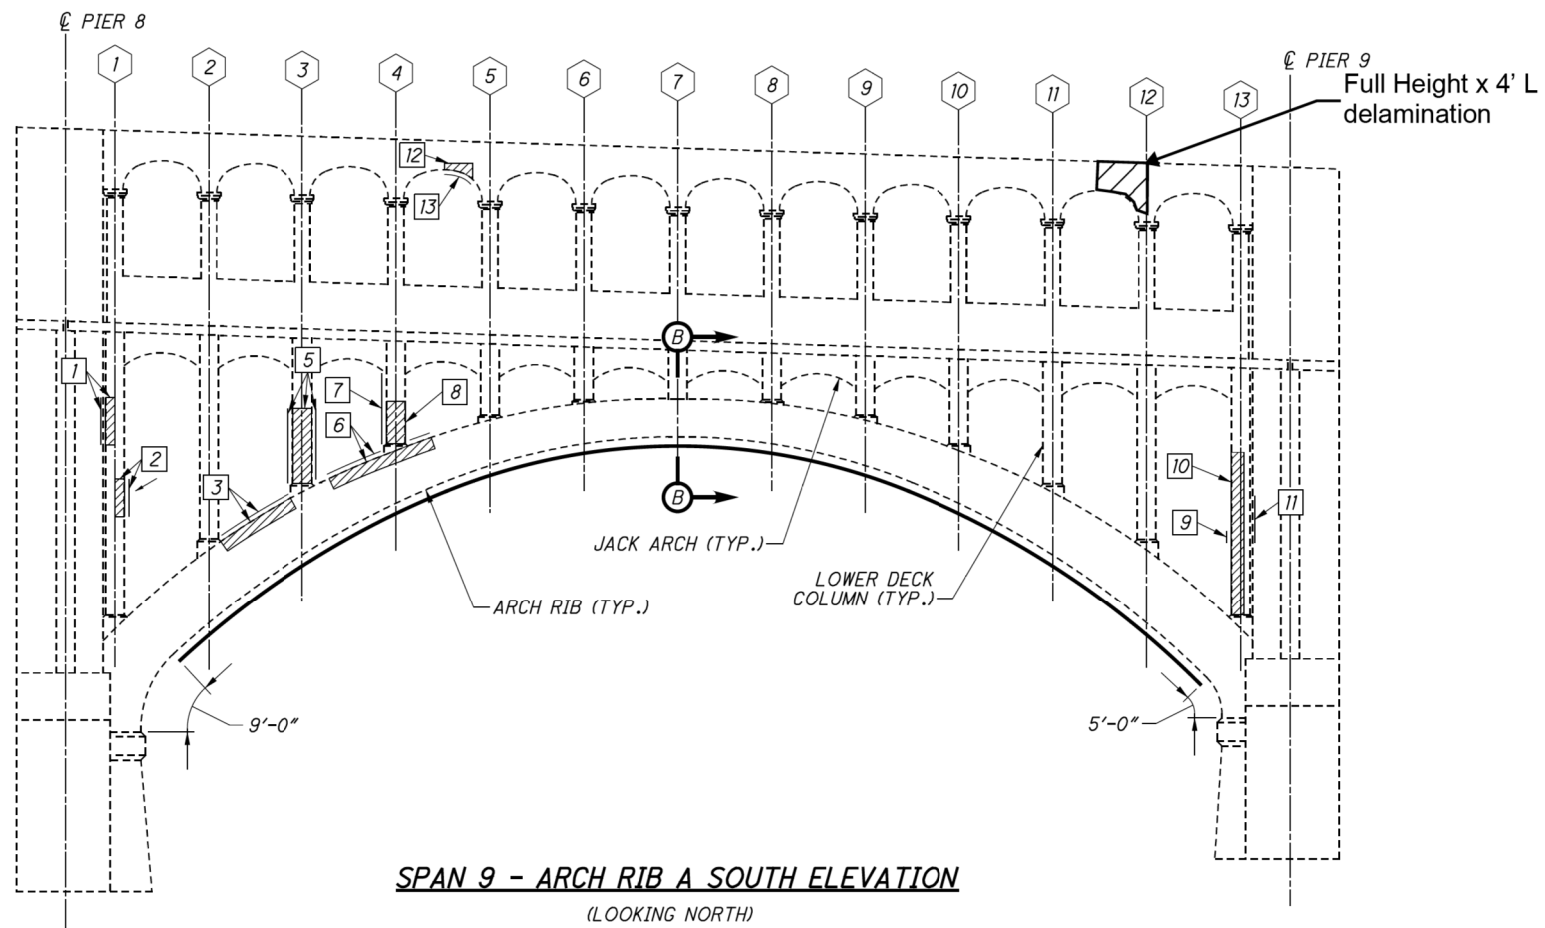

SPAN 9 - ARCH RIB A SOUTH ELEVATION
(LOOKING NORTH)

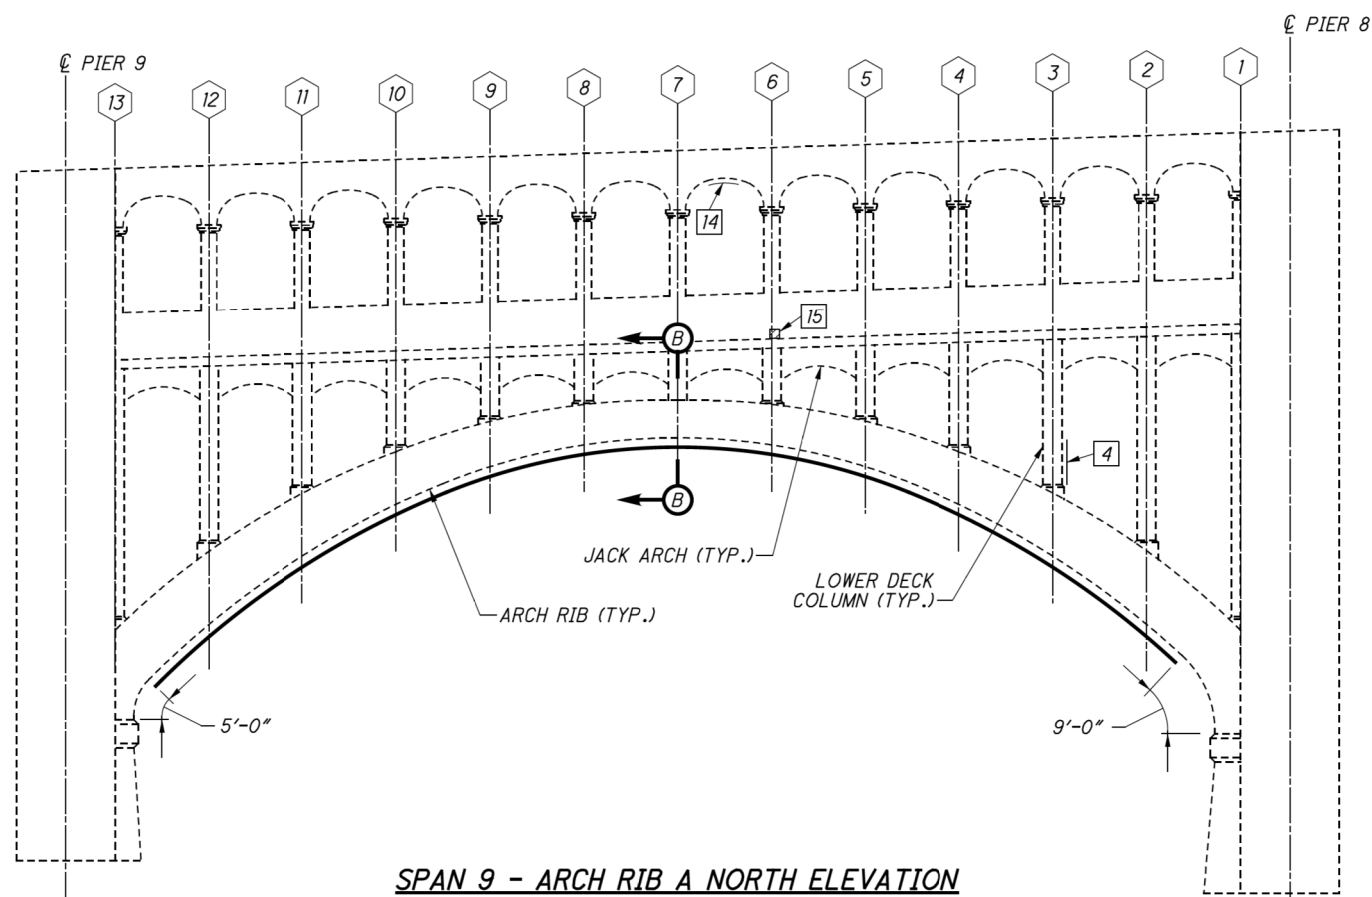

SPAN 9 - ARCH RIB A NORTH ELEVATION

| ESTIMATED PATCHING QUANTITIES | | | |
|-------------------------------|-------------|-----------|------------------|
| REPAIR NO. | REPAIR TYPE | AREA (SF) | ANODE QUANTITY** |
| 1 | TYPE 1 | 10 | 3 |
| 2 | TYPE 1 | 7 | 2 |
| 3 | TYPE 1 | 25 | 6 |
| 4 | TYPE 1 | 18 | 4 |
| 5 | TYPE 1 | 30 | 8 |
| 6 | TYPE 1 | 26 | 7 |
| 7 | TYPE 1 | 32 | 8 |
| 8 | TYPE 1 | 9 | 2 |
| 9 | TYPE 1 | 2 | 1 |
| 10 | TYPE 1 | 24 | 9 |
| 11 | TYPE 1 | 5 | 3 |
| 12 | TYPE 1 | 6 | 2 |
| 13 | TYPE 2 | 3 | 2 |
| 14 | TYPE 2 | 4 | 3 |
| 15 | TYPE 1 | 1 | 1 |
| MEASURED QUANTITY* | | 202 | - |
| PLAN QUANTITY* | | 303 | 61 |

* SEE NOTES 1 & 2
** SEE NOTES 3 & 4

| SHEET QUANTITY SUMMARY | | |
|------------------------|------|----------|
| ITEM | UNIT | QUANTITY |
| TYPE 1 REPAIR | SF | 292 |
| TYPE 2 REPAIR | SF | 11 |
| FRP WRAP | SF | 1358 |


NOTES:

1. MEASURED QUANTITIES ARE BASED ON THE INSPECTION PERFORMED IN DECEMBER 2016. THE EXACT DIMENSIONS AND LOCATIONS OF PATCHES SHALL BE DETERMINED BY THE ENGINEER IN THE FIELD FOR FINAL PAY QUANTITY.
2. PLAN QUANTITIES INCLUDE 50% CONTINGENCY ADDED TO MEASURED QUANTITIES.
3. ANODES ARE INCLUDED FOR PAYMENT WITH ITEM SPECIAL - PATCHING CONCRETE STRUCTURE, TYPE 1 OR TYPE 2 REPAIR.
4. GALVANIC ANODES WILL NOT BE USED FOR PATCHING THE VERTICAL SIDES OF THE UNREINFORCED CONCRETE ARCH RIBS.
5. FOR DETAILS AND MAXIMUM GRID SPACING FOR EMBEDDED GALVANIC ANODES, SEE SHEET [84/89].
6. FOR PIER 8 REPAIR DETAILS, SEE SHEET [28/89]. FOR PIER 9 REPAIR DETAILS, SEE SHEET [29/89].
7. FOR FRP WRAP DETAILS AND SECTION B-B, SEE SHEET [85/89].

LEGEND:


- # SPANDREL COLUMN NUMBER
- # REPAIR NUMBER
- [Hatched Box] LOCATION OF DEFICIENT CONCRETE TO BE REPAIRED IN ACCORDANCE WITH ITEM SPECIAL - PATCHING CONCRETE STRUCTURE, TYPE 1 REPAIR
- [Dashed Box] LOCATION OF DEFICIENT CONCRETE ON PERPENDICULAR FACE (NOT VISIBLE IN ELEVATION VIEW) TO BE REPAIRED IN ACCORDANCE WITH ITEM SPECIAL - PATCHING CONCRETE STRUCTURE, TYPE 1 OR TYPE 2 REPAIR
- [Dotted Box] AREA TO BE TREATED WITH FRP WRAP PER ITEM SPECIAL - COMPOSITE FIBER WRAP SYSTEM

| | | | | |
|--------------------------------|-----------|--|--|--------------------------------|
| GRAPHIC SCALE MEASURED IN FEET | DATE |  9902 Carver Road
Suite 201
Cincinnati, OH 45242
PH.: 614.699.5000 | DETROIT-SUPERIOR BRIDGE OVER CUYAHOGA RIVER
BRIDGE NO. CUY-6-1465 | |
| NOT TO SCALE | NOV, 2018 | | INFRASTRUCTURE ENGINEERS, INC. | SPAN 9 CONCRETE REPAIR DETAILS |

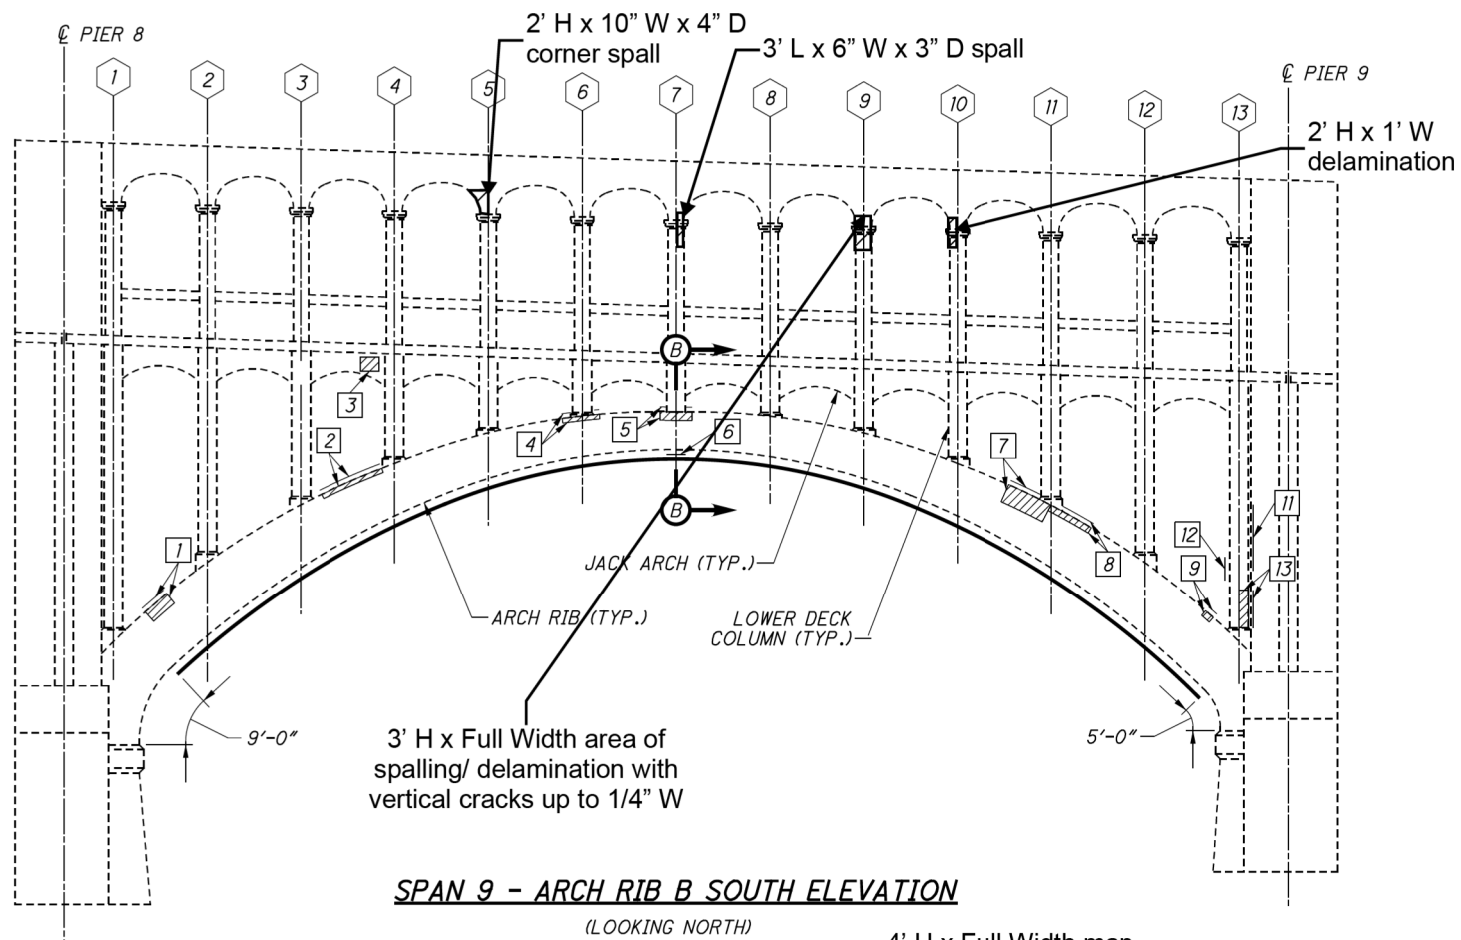

SPAN 9 - ARCH RIB B SOUTH ELEVATION

(LOOKING NORTH)

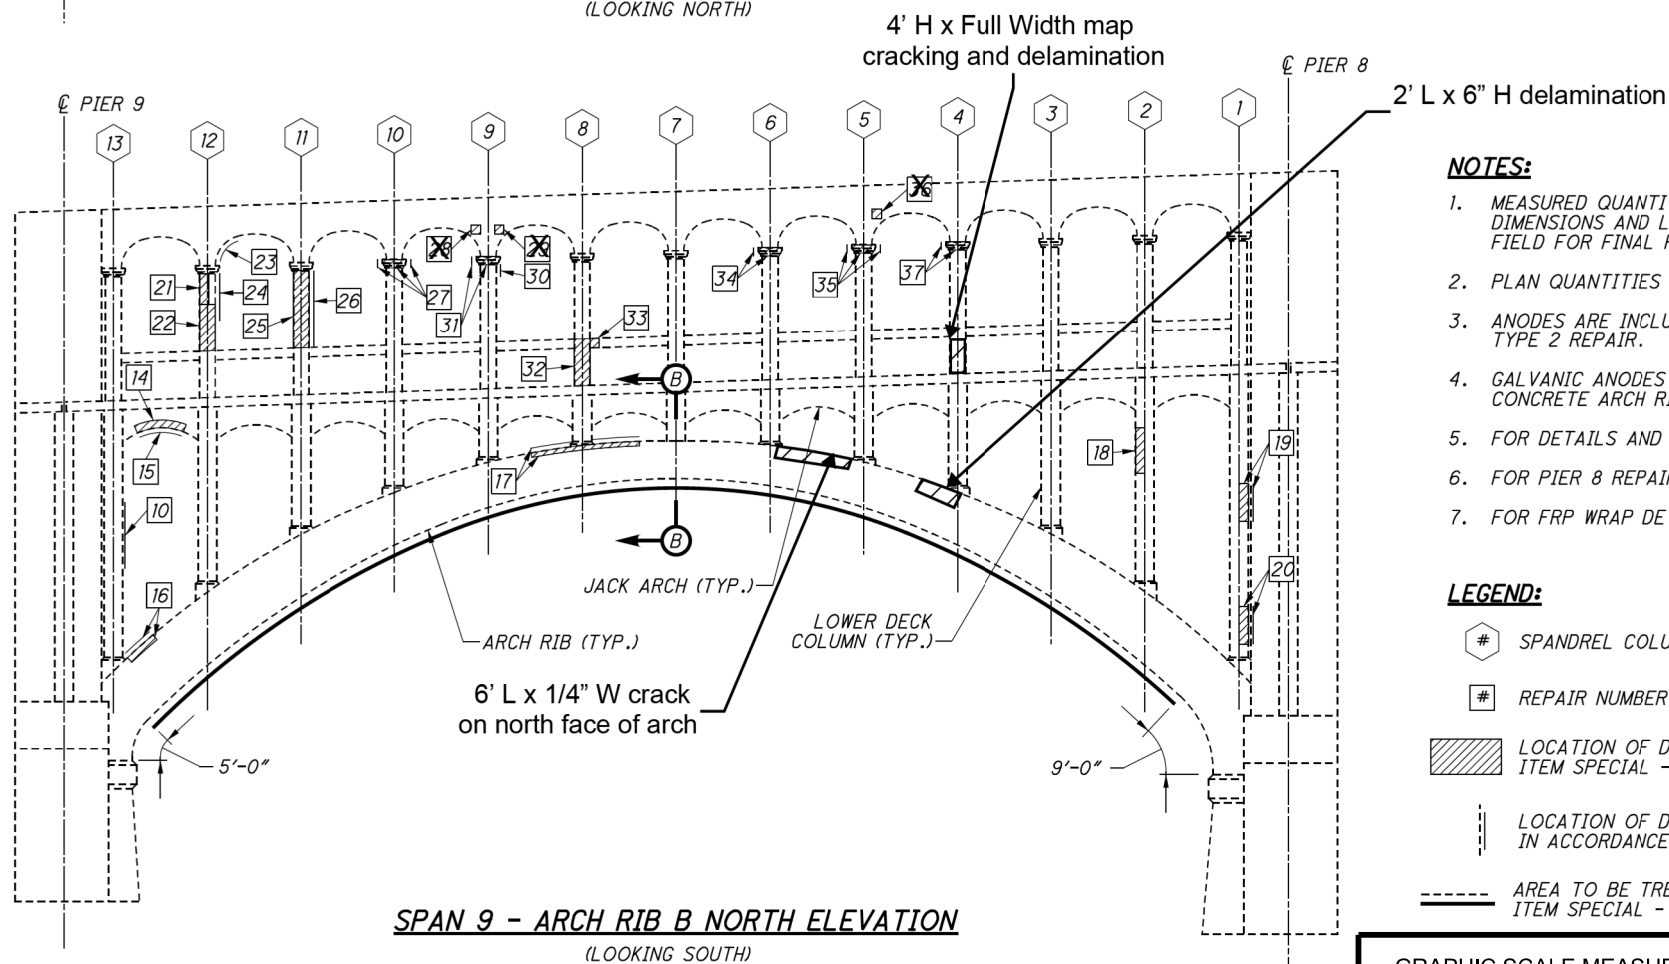

SPAN 9 - ARCH RIB B NORTH ELEVATION

(LOOKING SOUTH)

| ESTIMATED PATCHING QUANTITIES | | | |
|-------------------------------|-------------|-----------|------------------|
| REPAIR NO. | REPAIR TYPE | AREA (SF) | ANODE QUANTITY** |
| 1 | TYPE 1 | 7 | 2 |
| 2 | TYPE 1 | 9 | 5 |
| 3 | TYPE 1 | 3 | 2 |
| 4 | TYPE 1 | 5 | 3 |
| 5 | TYPE 1 | 6 | 2 |
| 6 | TYPE 2 | 2 | 1 |
| 7 | TYPE 1 | 14 | 4 |
| 8 | TYPE 1 | 10 | 3 |
| 9 | TYPE 1 | 2 | 1 |
| 10 | TYPE 1 | 18 | 6 |
| 11 | TYPE 1 | 11 | 4 |
| 12 | TYPE 1 | 4 | 1 |
| 13 | TYPE 1 | 10 | 2 |
| 14 | TYPE 1 | 5 | 5 |
| 15 | TYPE 2 | 5 | 5 |
| 16 | TYPE 1 | 5 | 2 |
| 17 | TYPE 1 | 19 | 9 |
| 18 | TYPE 1 | 5 | 2 |
| 19 | TYPE 1 | 6 | 2 |
| 20 | TYPE 1 | 12 | 2 |
| MEASURED QUANTITY* | | 229 | - |
| PLAN QUANTITY* | | 344 | 109 |

| ESTIMATED PATCHING QUANTITIES | | | |
|-------------------------------|-------------|-----------|------------------|
| REPAIR NO. | REPAIR TYPE | AREA (SF) | ANODE QUANTITY** |
| 21 | TYPE 1 | 3 | 2 |
| 22 | TYPE 1 | 9 | 4 |
| 23 | TYPE 2 | 3 | 2 |
| 24 | TYPE 1 | 5 | 4 |
| 25 | TYPE 1 | 14 | 6 |
| 26 | TYPE 1 | 4 | 6 |
| 27 | TYPE 1 | 4 | 3 |
| 28 | TYPE 1 | 1 | 1 |
| 29 | TYPE 1 | 1 | 1 |
| 30 | TYPE 1 | 2 | 1 |
| 31 | TYPE 1 | 3 | 2 |
| 32 | TYPE 1 | 9 | 4 |
| 33 | TYPE 1 | 1 | 1 |
| 34 | TYPE 1 | 4 | 3 |
| 35 | TYPE 1 | 4 | 3 |
| 36 | TYPE 1 | 1 | 1 |
| 37 | TYPE 1 | 3 | 2 |
| MEASURED QUANTITY* | | 229 | - |
| PLAN QUANTITY* | | 344 | 109 |

* SEE NOTES 1 & 2
** SEE NOTES 3 & 4

SHEET QUANTITY SUMMARY

| ITEM | UNIT | QUANTITY |
|---------------|------|----------|
| TYPE 1 REPAIR | SF | 329 |
| TYPE 2 REPAIR | SF | 15 |
| FRP WRAP | SF | 1605 |

NOTES:

- MEASURED QUANTITIES ARE BASED ON THE INSPECTION PERFORMED IN DECEMBER 2016. THE EXACT DIMENSIONS AND LOCATIONS OF PATCHES SHALL BE DETERMINED BY THE ENGINEER IN THE FIELD FOR FINAL PAY QUANTITY.
- PLAN QUANTITIES INCLUDE 50% CONTINGENCY ADDED TO MEASURED QUANTITIES.
- ANODES ARE INCLUDED FOR PAYMENT WITH ITEM SPECIAL - PATCHING CONCRETE STRUCTURE, TYPE 1 OR TYPE 2 REPAIR.
- GALVANIC ANODES WILL NOT BE USED FOR PATCHING THE VERTICAL SIDES OF THE UNREINFORCED CONCRETE ARCH RIBS.
- FOR DETAILS AND MAXIMUM GRID SPACING FOR EMBEDDED GALVANIC ANODES, SEE SHEET [84/89].
- FOR PIER 8 REPAIR DETAILS, SEE SHEET [28/89]. FOR PIER 9 REPAIR DETAILS, SEE SHEET [29/89].
- FOR FRP WRAP DETAILS AND SECTION B-B, SEE SHEET [85/89].

LEGEND:

- SPANDREL COLUMN NUMBER
- REPAIR NUMBER
- LOCATION OF DEFICIENT CONCRETE TO BE REPAIRED IN ACCORDANCE WITH ITEM SPECIAL - PATCHING CONCRETE STRUCTURE, TYPE 1 REPAIR
- LOCATION OF DEFICIENT CONCRETE ON PERPENDICULAR FACE (NOT VISIBLE IN ELEVATION VIEW) TO BE REPAIRED IN ACCORDANCE WITH ITEM SPECIAL - PATCHING CONCRETE STRUCTURE, TYPE 1 OR TYPE 2 REPAIR
- AREA TO BE TREATED WITH FRP WRAP PER ITEM SPECIAL - COMPOSITE FIBER WRAP SYSTEM

GRAPHIC SCALE MEASURED IN FEET

NOT TO SCALE

DATE

NOV, 2018




9902 Carver Road
Suite 201
Cincinnati, OH 45242
PH.: 614.699.5000

INFRASTRUCTURE
ENGINEERS, INC.

DETROIT-SUPERIOR BRIDGE OVER CUYAHOGA RIVER
BRIDGE NO. CUY-6-1465


SPAN 9 CONCRETE REPAIR DETAILS

PAGE
A-88

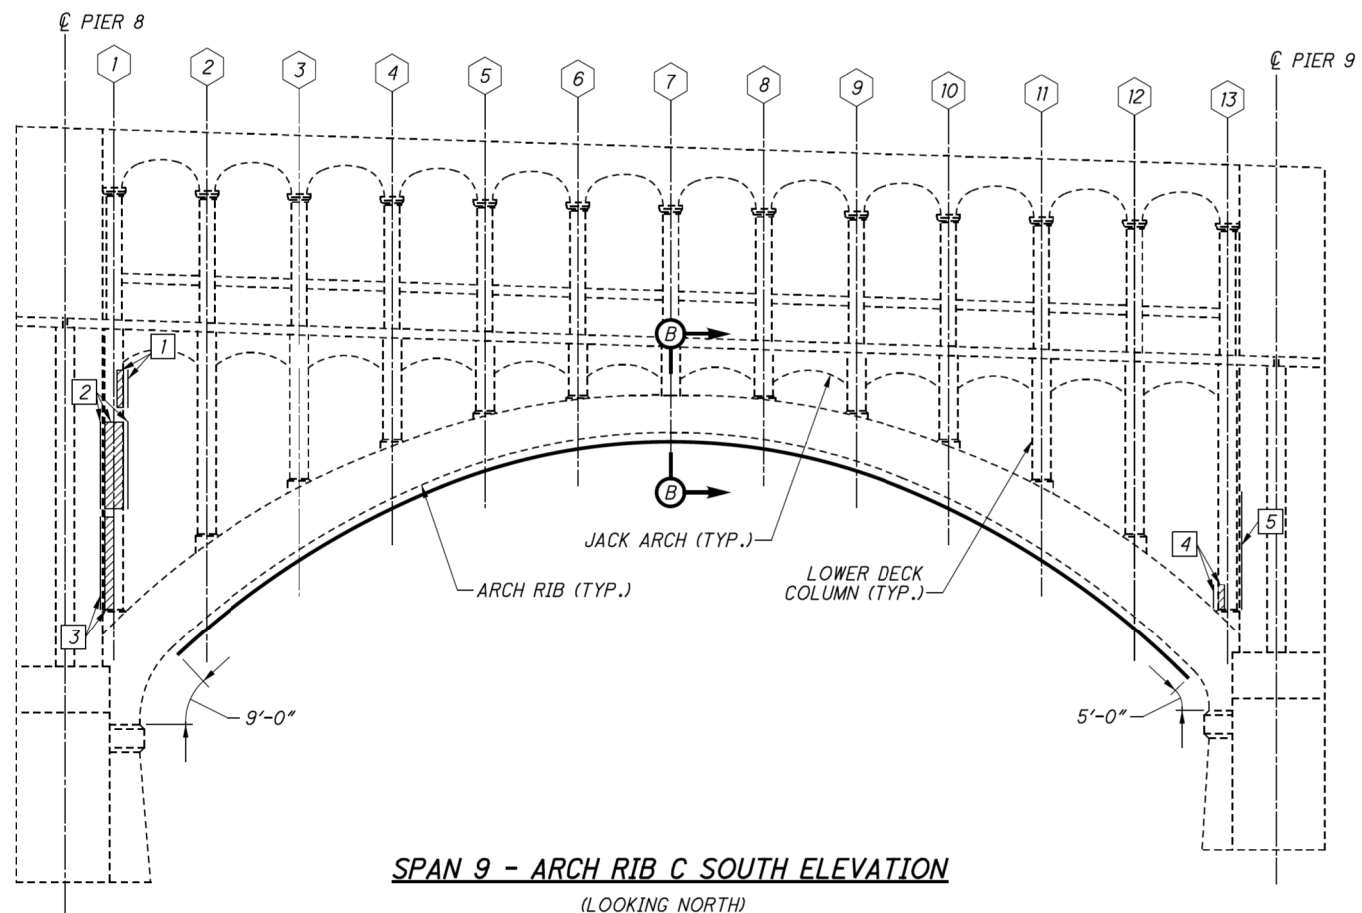

SPAN 9 - ARCH RIB C SOUTH ELEVATION

(LOOKING NORTH)

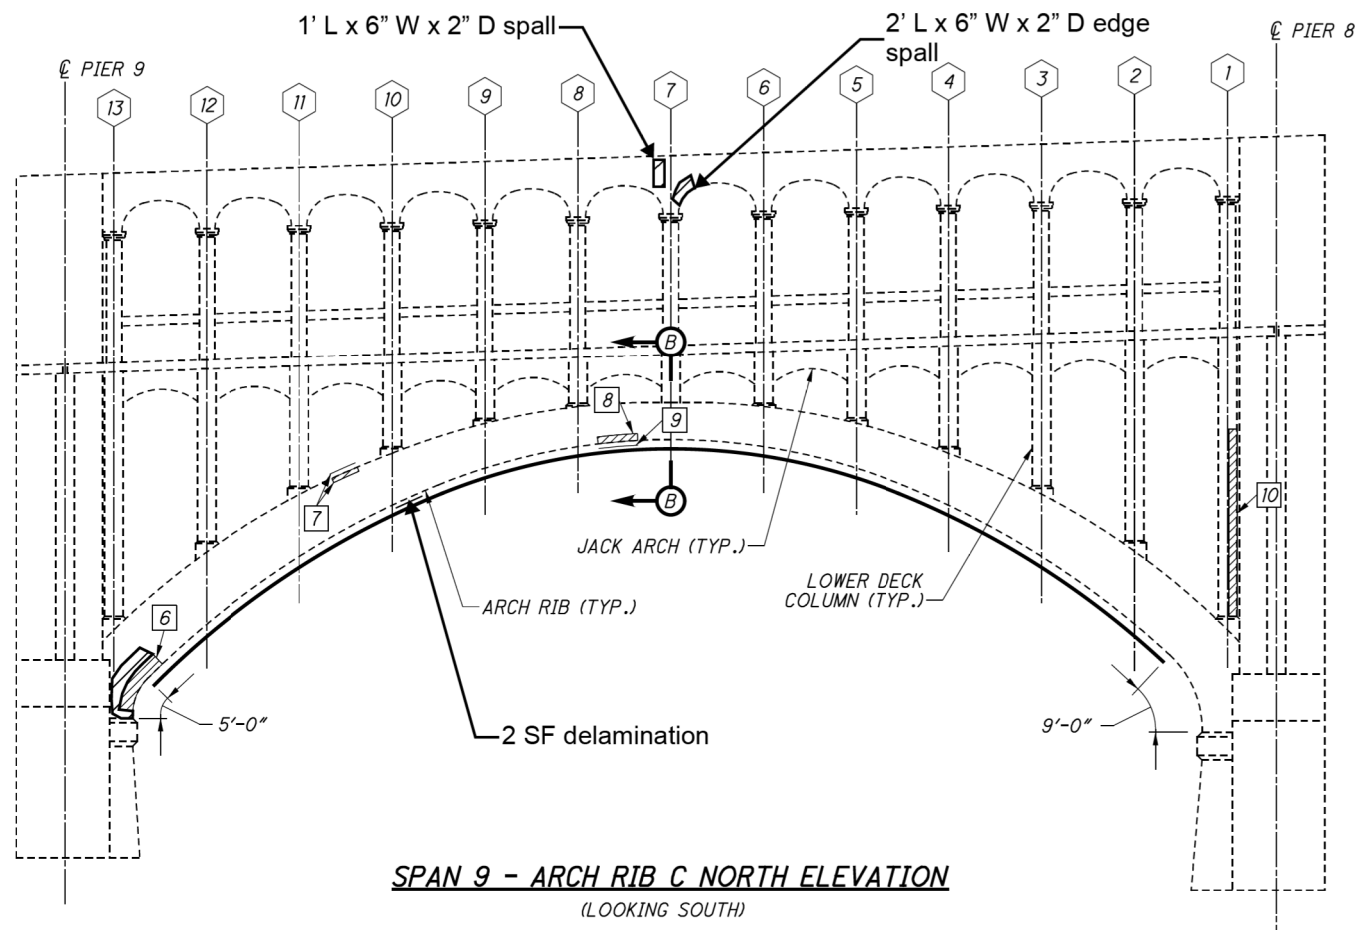

SPAN 9 - ARCH RIB C NORTH ELEVATION

(LOOKING SOUTH)

| ESTIMATED PATCHING QUANTITIES | | | |
|-------------------------------|-------------|-----------|------------------|
| REPAIR NO. | REPAIR TYPE | AREA (SF) | ANODE QUANTITY** |
| 1 | TYPE 1 | 5 | 2 |
| 2 | TYPE 1 | 54 | 12 |
| 3 | TYPE 1 | 43 | 12 |
| 4 | TYPE 1 | 4 | 1 |
| 5 | TYPE 1 | 26 | 6 |
| 6 | TYPE 1 | 10 | - |
| 7 | TYPE 1 | 9 | 4 |
| 8 | TYPE 1 | 4 | - |
| 9 | TYPE 2 | 9 | 3 |
| 10 | TYPE 1 | 17 | 10 |
| MEASURED QUANTITY* | | 181 | - |
| PLAN QUANTITY* | | 272 | 50 |

* SEE NOTES 1 & 2
 ** SEE NOTES 3 & 4

| SHEET QUANTITY SUMMARY | | |
|------------------------|------|----------|
| ITEM | UNIT | QUANTITY |
| TYPE 1 REPAIR | SF | 259 |
| TYPE 2 REPAIR | SF | 13 |
| FRP WRAP | SF | 1605 |



NOTES:

1. MEASURED QUANTITIES ARE BASED ON THE INSPECTION PERFORMED IN DECEMBER 2016. THE EXACT DIMENSIONS AND LOCATIONS OF PATCHES SHALL BE DETERMINED BY THE ENGINEER IN THE FIELD FOR FINAL PAY QUANTITY.
2. PLAN QUANTITIES INCLUDE 50% CONTINGENCY ADDED TO MEASURED QUANTITIES.
3. ANODES ARE INCLUDED FOR PAYMENT WITH ITEM SPECIAL - PATCHING CONCRETE STRUCTURE, TYPE 1 OR TYPE 2 REPAIR.
4. GALVANIC ANODES WILL NOT BE USED FOR PATCHING THE VERTICAL SIDES OF THE UNREINFORCED CONCRETE ARCH RIBS.
5. FOR DETAILS AND MAXIMUM GRID SPACING FOR EMBEDDED GALVANIC ANODES, SEE SHEET [84/89].
6. FOR PIER 8 REPAIR DETAILS, SEE SHEET [28/89]. FOR PIER 9 REPAIR DETAILS, SEE SHEET [29/89].
7. FOR FRP WRAP DETAILS AND SECTION B-B, SEE SHEET [85/89].

LEGEND:

- # SPANDREL COLUMN NUMBER
- # REPAIR NUMBER
- ▨ LOCATION OF DEFICIENT CONCRETE TO BE REPAIRED IN ACCORDANCE WITH ITEM SPECIAL - PATCHING CONCRETE STRUCTURE, TYPE 1 REPAIR
- ▨ LOCATION OF DEFICIENT CONCRETE ON PERPENDICULAR FACE (NOT VISIBLE IN ELEVATION VIEW) TO BE REPAIRED IN ACCORDANCE WITH ITEM SPECIAL - PATCHING CONCRETE STRUCTURE, TYPE 1 OR TYPE 2 REPAIR
- AREA TO BE TREATED WITH FRP WRAP PER ITEM SPECIAL - COMPOSITE FIBER WRAP SYSTEM

| | | | | |
|--------------------------------|--------------------------------|--|---|-----------|
| GRAPHIC SCALE MEASURED IN FEET | DATE |  9902 Carver Road
Suite 201
Cincinnati, OH 45242
PH.: 614.699.5000 | DETROIT-SUPERIOR BRIDGE OVER CUYAHOGA RIVER | |
| | NOV, 2018 | | BRIDGE NO. CUY-6-1465 | |
| NOT TO SCALE | INFRASTRUCTURE ENGINEERS, INC. | | SPAN 9 CONCRETE REPAIR DETAILS | PAGE A-89 |

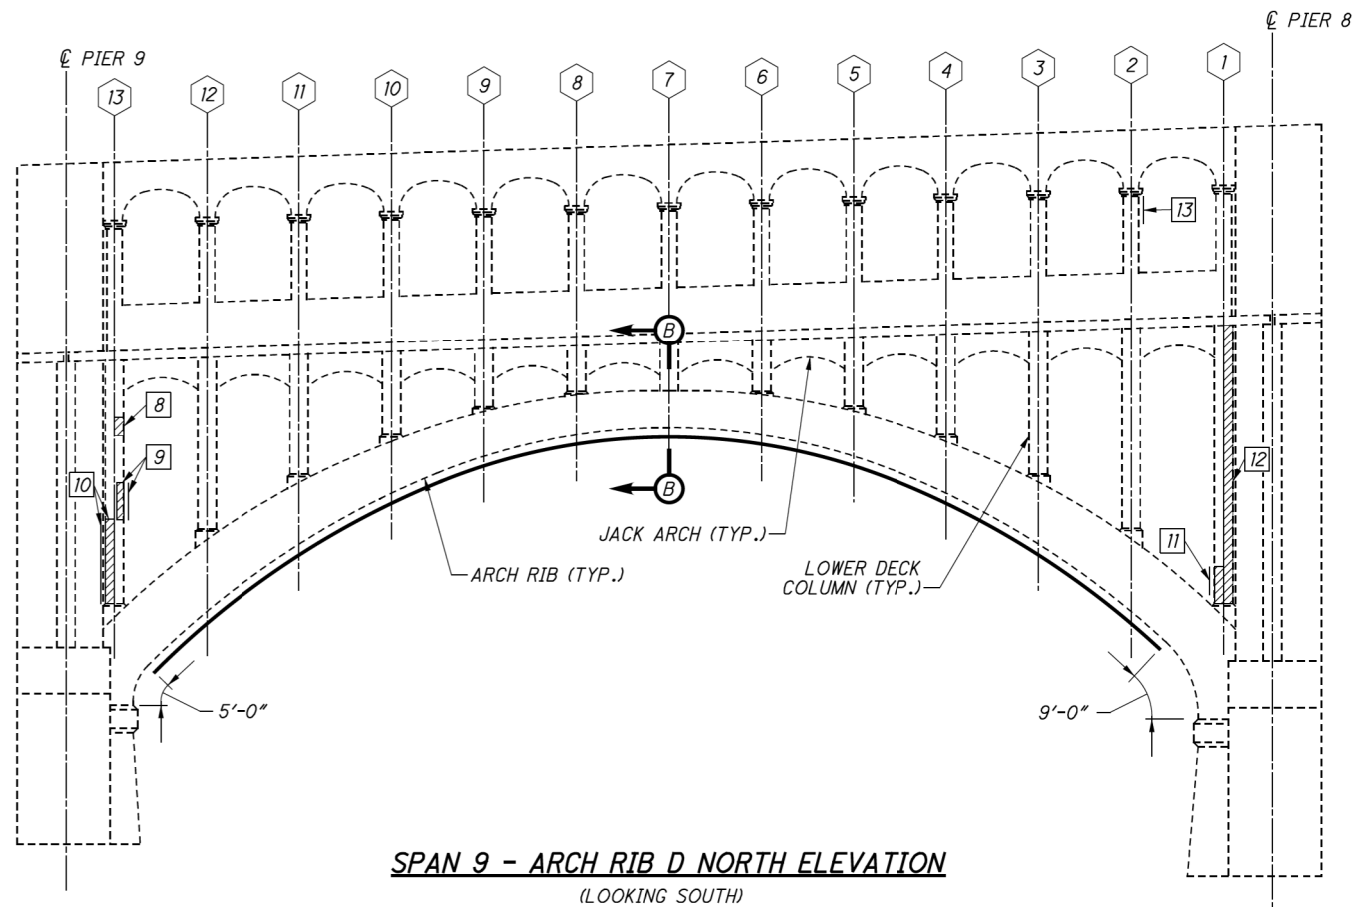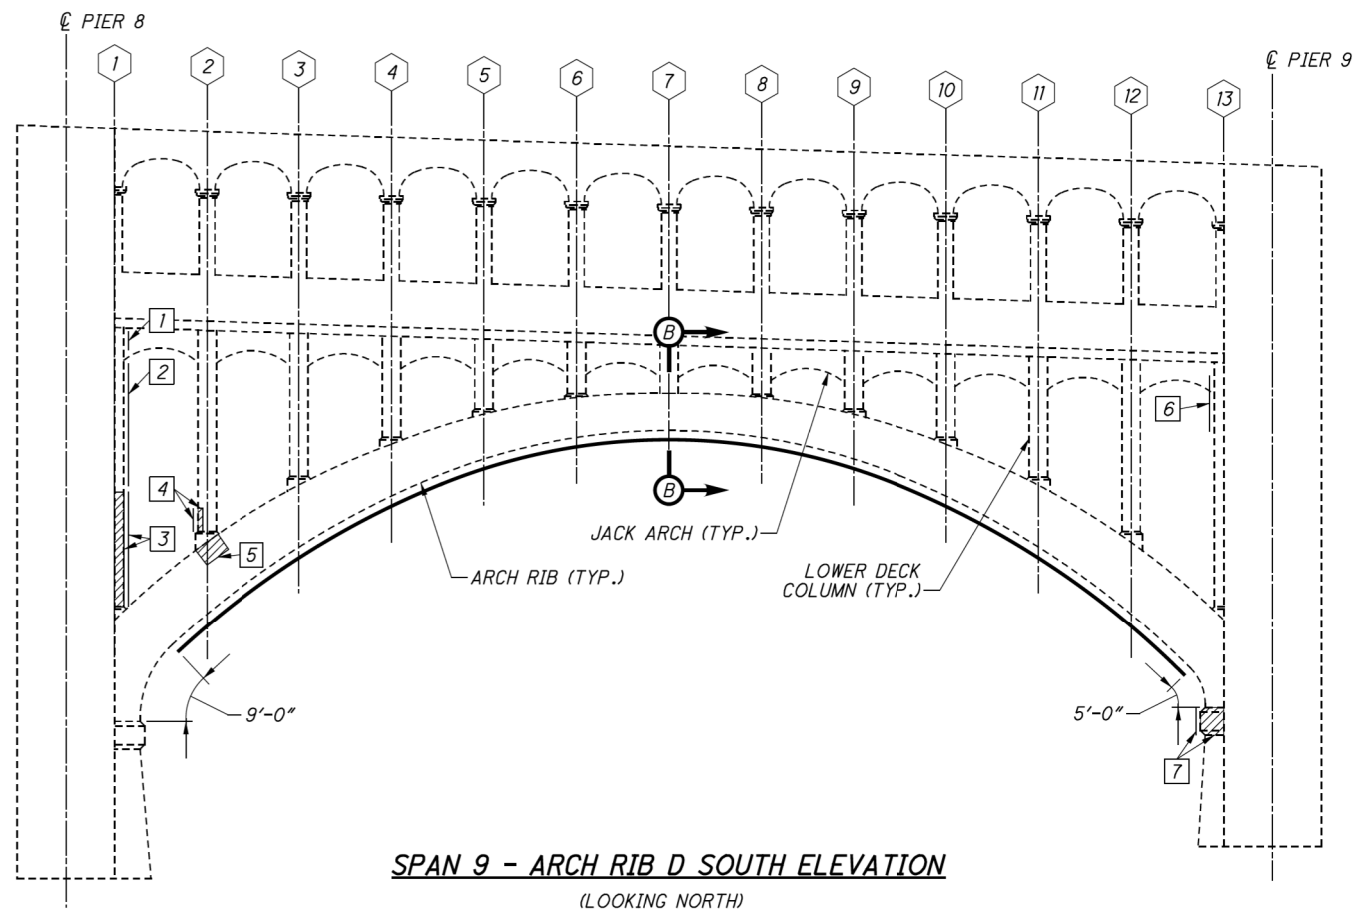

| ESTIMATED PATCHING QUANTITIES | | | |
|-------------------------------|-------------|-----------|------------------|
| REPAIR NO. | REPAIR TYPE | AREA (SF) | ANODE QUANTITY** |
| 1 | TYPE 1 | 4 | 1 |
| 2 | TYPE 1 | 62 | 18 |
| 3 | TYPE 1 | 28 | 6 |
| 4 | TYPE 1 | 3 | 1 |
| 5 | TYPE 1 | 6 | - |
| 6 | TYPE 1 | 18 | 6 |
| 7 | TYPE 1 | 15 | 8 |
| 8 | TYPE 1 | 2 | 1 |
| 9 | TYPE 1 | 6 | 2 |
| 10 | TYPE 1 | 23 | 5 |
| 11 | TYPE 1 | 4 | 2 |
| 12 | TYPE 1 | 34 | 17 |
| 13 | TYPE 1 | 3 | 2 |
| MEASURED QUANTITY* | | 208 | - |
| PLAN QUANTITY* | | 312 | 69 |

* SEE NOTES 1 & 2
** SEE NOTES 3 & 4

| SHEET QUANTITY SUMMARY | | |
|------------------------|------|----------|
| ITEM | UNIT | QUANTITY |
| TYPE 1 REPAIR | SF | 312 |
| TYPE 2 REPAIR | SF | - |
| FRP WRAP | SF | 1358 |



NOTES:

- MEASURED QUANTITIES ARE BASED ON THE INSPECTION PERFORMED IN DECEMBER 2016. THE EXACT DIMENSIONS AND LOCATIONS OF PATCHES SHALL BE DETERMINED BY THE ENGINEER IN THE FIELD FOR FINAL PAY QUANTITY.
- PLAN QUANTITIES INCLUDE 50% CONTINGENCY ADDED TO MEASURED QUANTITIES.
- ANODES ARE INCLUDED FOR PAYMENT WITH ITEM SPECIAL - PATCHING CONCRETE STRUCTURE, TYPE 1 OR TYPE 2 REPAIR.
- GALVANIC ANODES WILL NOT BE USED FOR PATCHING THE VERTICAL SIDES OF THE UNREINFORCED CONCRETE ARCH RIBS.
- FOR DETAILS AND MAXIMUM GRID SPACING FOR EMBEDDED GALVANIC ANODES, SEE SHEET [84/89].
- FOR PIER 8 REPAIR DETAILS, SEE SHEET [28/89]. FOR PIER 9 REPAIR DETAILS, SEE SHEET [29/89].
- FOR FRP WRAP DETAILS AND SECTION B-B, SEE SHEET [85/89].

LEGEND:



- SPANDREL COLUMN NUMBER
- REPAIR NUMBER
- LOCATION OF DEFICIENT CONCRETE TO BE REPAIRED IN ACCORDANCE WITH ITEM SPECIAL - PATCHING CONCRETE STRUCTURE, TYPE 1 REPAIR
- LOCATION OF DEFICIENT CONCRETE ON PERPENDICULAR FACE (NOT VISIBLE IN ELEVATION VIEW) TO BE REPAIRED IN ACCORDANCE WITH ITEM SPECIAL - PATCHING CONCRETE STRUCTURE, TYPE 1 OR TYPE 2 REPAIR
- AREA TO BE TREATED WITH FRP WRAP PER ITEM SPECIAL - COMPOSITE FIBER WRAP SYSTEM

| | | | |
|--------------------------------|-----------|--|--|
| GRAPHIC SCALE MEASURED IN FEET | DATE | 9902 Carver Road
Suite 201
Cincinnati, OH 45242
PH.: 614.699.5000 | DETROIT-SUPERIOR BRIDGE OVER CUYAHOGA RIVER
BRIDGE NO. CUY-6-1465 |
| NOT TO SCALE | NOV, 2018 | INFRASTRUCTURE ENGINEERS, INC. | SPAN 9 CONCRETE REPAIR DETAILS |
| | | | PAGE
A-90 |

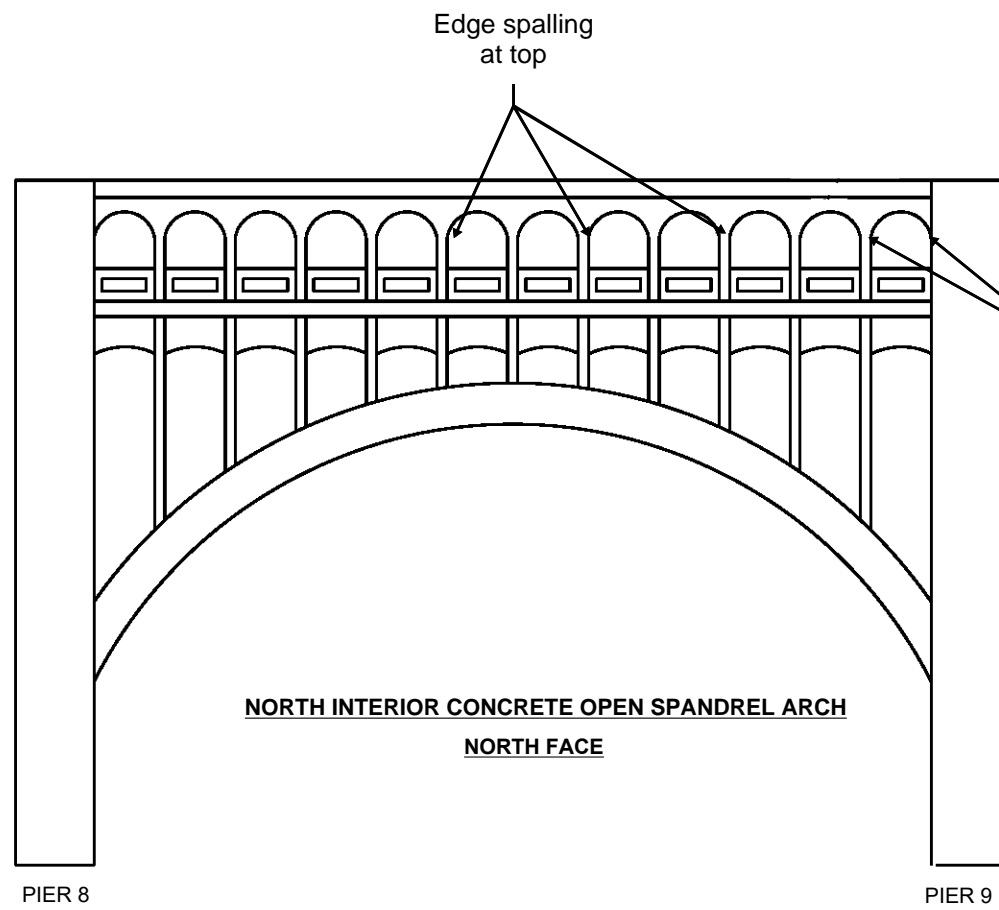
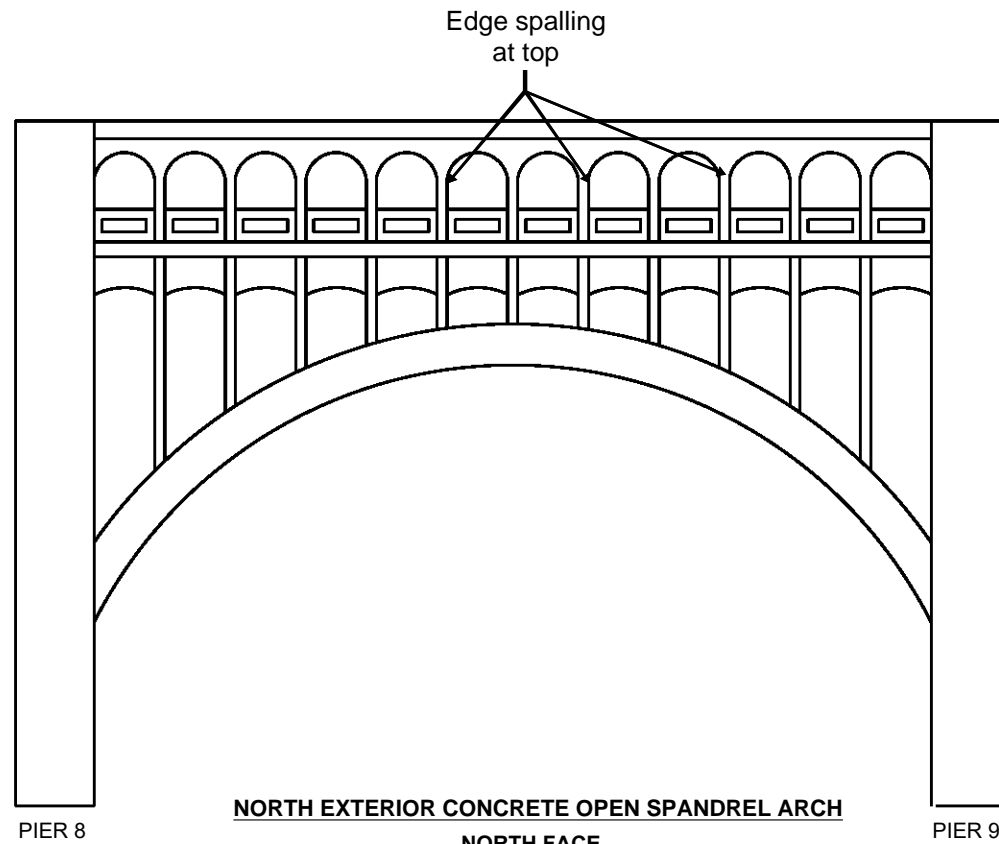


North face of columns have extensive delaminations and spalls along the full height

| | | | | |
|---------------------------------------|------------------|--|--|----------------------|
| <p>GRAPHIC SCALE MEASURED IN FEET</p> | <p>DATE</p> |  <p>9902 Carver Road
Suite 201
Cincinnati, OH 45242
PH.: 614.699.5000</p> | <p>DETROIT-SUPERIOR BRIDGE OVER CUYAHOGA RIVER
BRIDGE NO. CUY-6-1465</p> | |
| <p>NOT TO SCALE</p> | <p>NOV, 2018</p> | <p>INFRASTRUCTURE
ENGINEERS, INC.</p> | <p>STRUCTURE ELEVATION - SPAN 9</p> | <p>PAGE
A-91</p> |

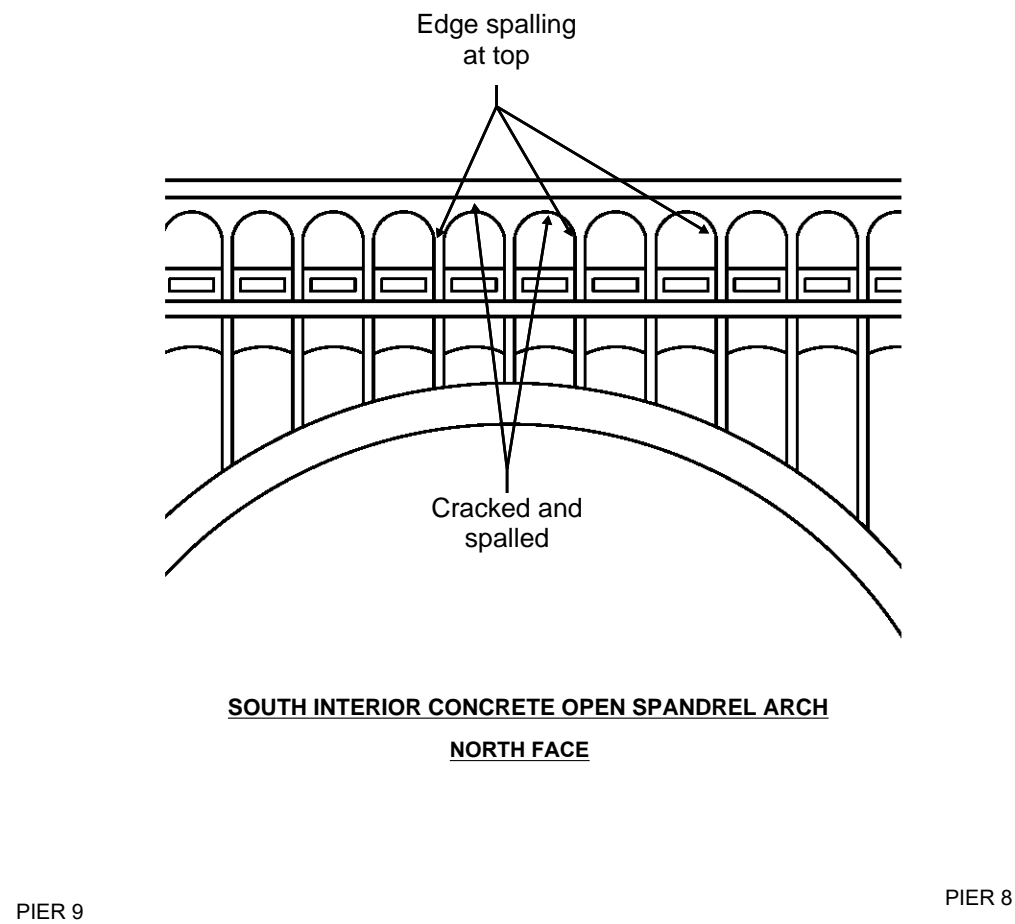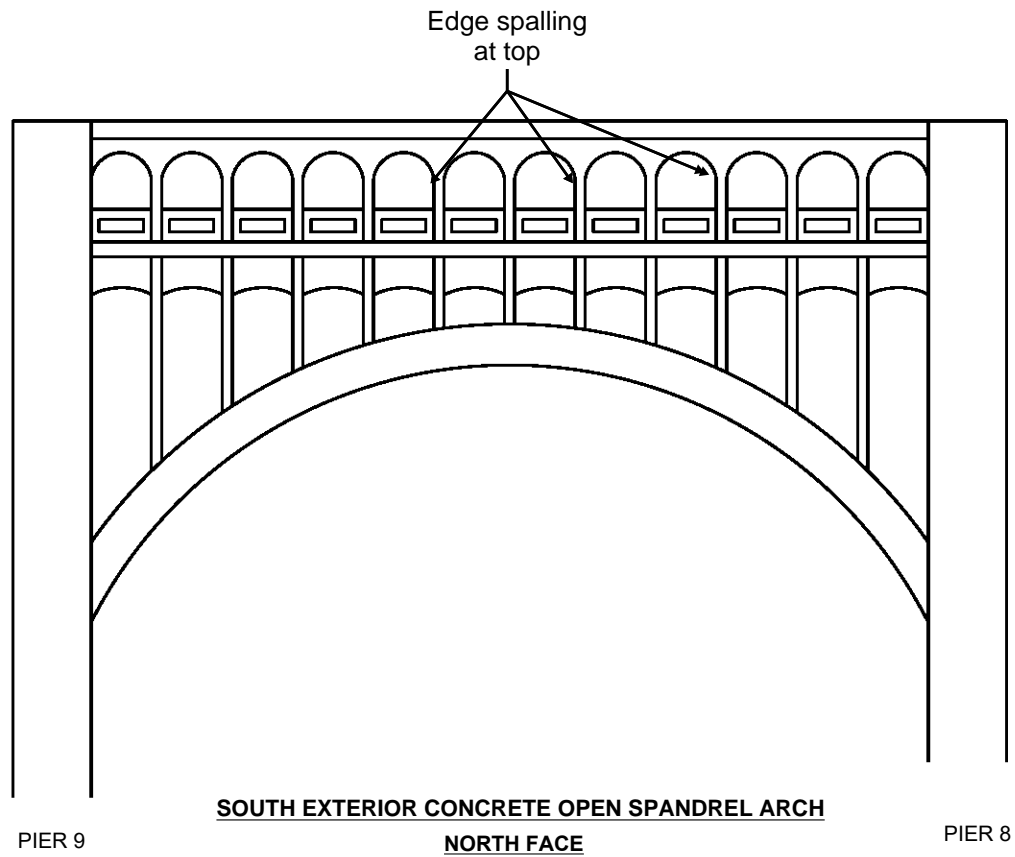

| | | | |
|--------------------------------|-----------|--|--|
| GRAPHIC SCALE MEASURED IN FEET | DATE |  9902 Carver Road
Suite 201
Cincinnati, OH 45242
PH.: 614.699.5000 | DETROIT-SUPERIOR BRIDGE OVER CUYAHOGA RIVER
BRIDGE NO. CUY-6-1465 |
| NOT TO SCALE | NOV, 2018 | INFRASTRUCTURE ENGINEERS, INC. | STRUCTURE ELEVATION - SPAN 9
PAGE A-92 |

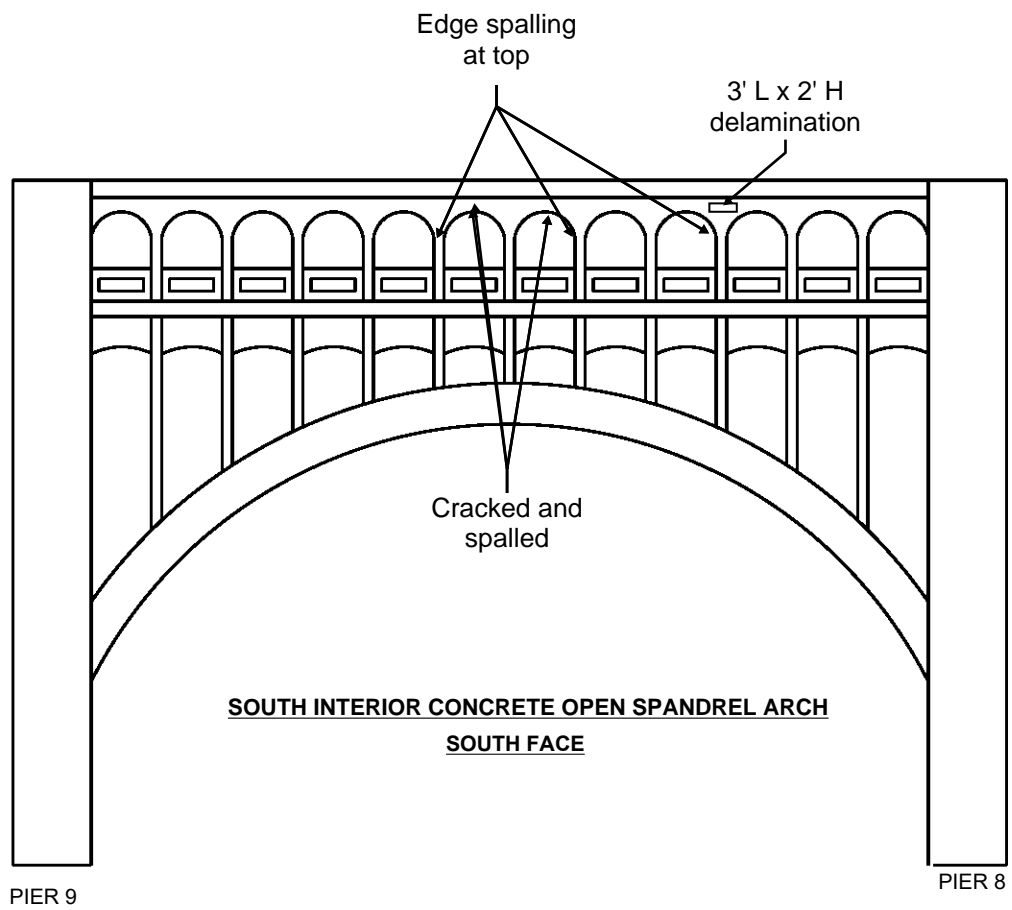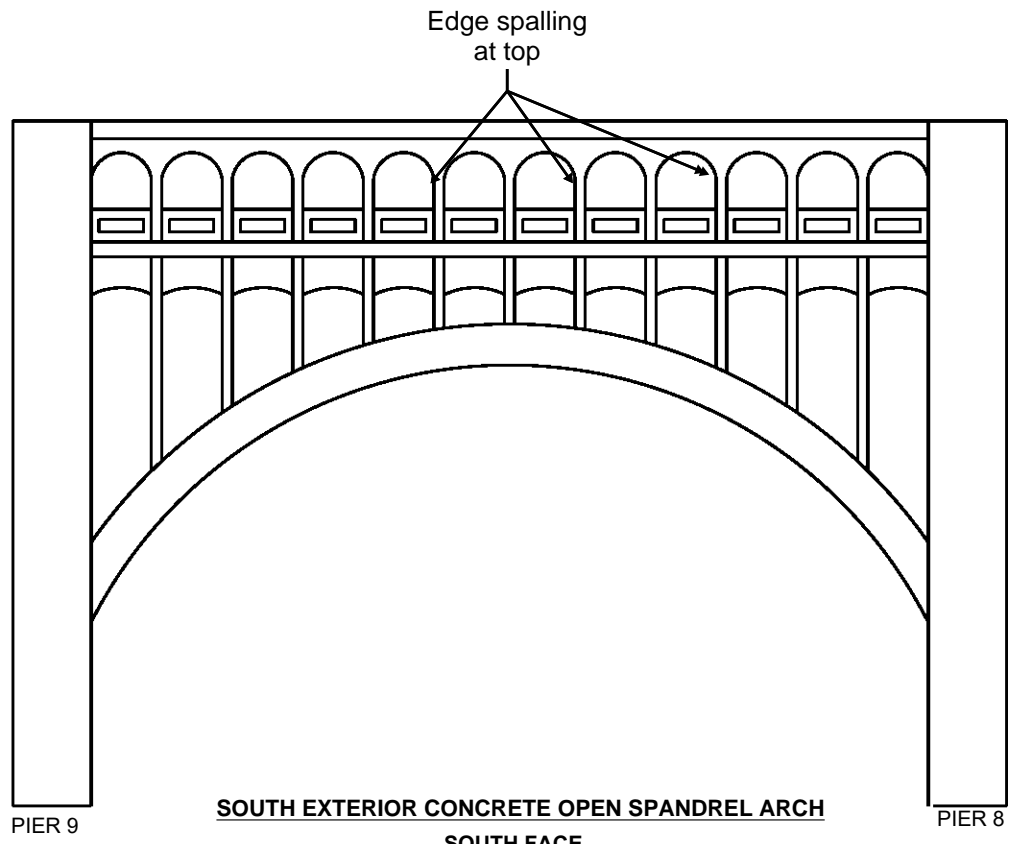

GRAPHIC SCALE MEASURED IN FEET

NOT TO SCALE

DATE

NOV, 2018




9902 Carver Road
Suite 201
Cincinnati, OH 45242
PH.: 614.699.5000

INFRASTRUCTURE
ENGINEERS, INC.


DETROIT-SUPERIOR BRIDGE OVER CUYAHOGA RIVER
BRIDGE NO. CUY-6-1465

STRUCTURE ELEVATION - SPAN 9

PAGE
A-93

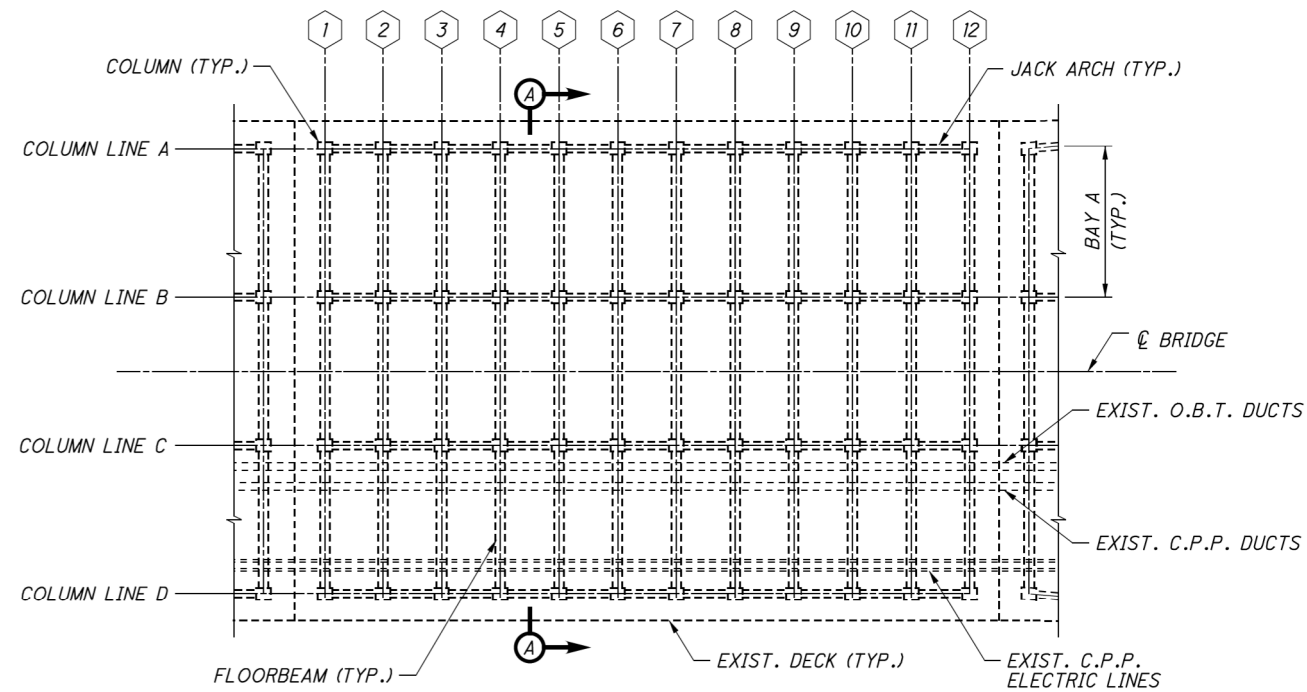

SPAN 10 - UPPER DECK PLAN

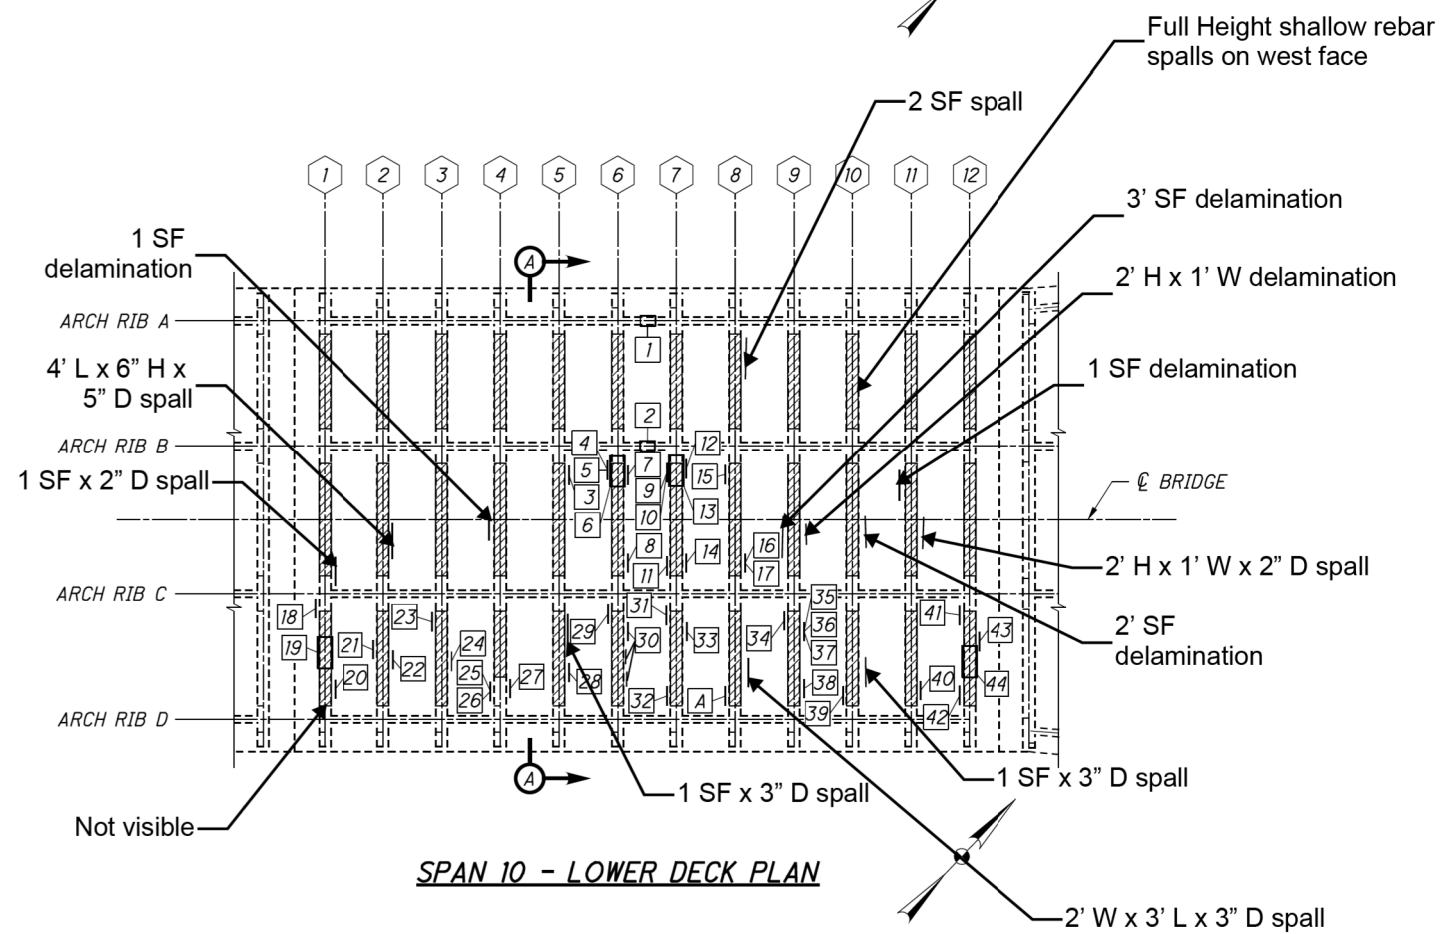

SPAN 10 - LOWER DECK PLAN

ESTIMATED PATCHING QUANTITIES

| REPAIR NO. | REPAIR TYPE | AREA (SF) | ANODE QUANTITY** |
|------------|-------------|-----------|------------------|
| 1 | TYPE 2 | 1 | 1 |
| 2 | TYPE 2 | 1 | 1 |
| 3 | TYPE 1 | 4 | 1 |
| 4 | TYPE 1 | 5 | 1 |
| 5 | TYPE 1 | 4 | 2 |
| 6 | TYPE 2 | 9 | 3 |
| 7 | TYPE 1 | 13 | 2 |
| 8 | TYPE 1 | 2 | 1 |
| 9 | TYPE 1 | 4 | 2 |
| 10 | TYPE 1 | 4 | 1 |
| 11 | TYPE 1 | 15 | 6 |
| 12 | TYPE 1 | 26 | 8 |
| 13 | TYPE 2 | 14 | 5 |
| 14 | TYPE 1 | 8 | 1 |
| 15 | TYPE 1 | 4 | 1 |
| 16 | TYPE 1 | 4 | 1 |
| 17 | TYPE 1 | 4 | 1 |
| 18 | TYPE 1 | 9 | 4 |
| 19 | TYPE 2 | 17 | 7 |
| 20 | TYPE 1 | 21 | 6 |
| 21 | TYPE 1 | 3 | 1 |
| 22 | TYPE 1 | 5 | 2 |
| 23 | TYPE 1 | 2 | 1 |
| 24 | TYPE 1 | 2 | 1 |

ESTIMATED PATCHING QUANTITIES

| REPAIR NO. | REPAIR TYPE | AREA (SF) | ANODE QUANTITY** |
|--------------------|-------------|-----------|------------------|
| 25 | TYPE 1 | 16 | 4 |
| 26 | TYPE 2 | 4 | 3 |
| 27 | TYPE 1 | 2 | 1 |
| 28 | TYPE 1 | 6 | 2 |
| 29 | TYPE 1 | 10 | 2 |
| 30 | TYPE 1 | 19 | 6 |
| 31 | TYPE 1 | 37 | 10 |
| 32 | TYPE 1 | 10 | 2 |
| 33 | TYPE 1 | 12 | 4 |
| 34 | TYPE 1 | 30 | 8 |
| 35 | TYPE 1 | 2 | 1 |
| 36 | TYPE 1 | 4 | 1 |
| 37 | TYPE 1 | 16 | 4 |
| 38 | TYPE 1 | 27 | 8 |
| 39 | TYPE 1 | 34 | 8 |
| 40 | TYPE 1 | 3 | 1 |
| 41 | TYPE 1 | 21 | 8 |
| 42 | TYPE 1 | 11 | 4 |
| 43 | TYPE 1 | 2 | 1 |
| 44 | TYPE 2 | 9 | 3 |
| MEASURED QUANTITY* | | 456 | - |
| PLAN QUANTITY* | | 684 | 141 |

| | | | |
|--------------------|-------|---|---|
| A | SS843 | 8 | - |
| MEASURED QUANTITY* | | 8 | - |

* SEE NOTES 1 & 2
** SEE NOTE 3

SHEET QUANTITY SUMMARY

| ITEM | UNIT | QUANTITY |
|---------------|------|----------|
| TYPE 1 REPAIR | SF | 602 |
| TYPE 2 REPAIR | SF | 82 |
| FRP WRAP | SF | 3090 |


NOTES:

- MEASURED QUANTITIES ARE BASED ON THE INSPECTION PERFORMED IN DECEMBER 2016. THE EXACT DIMENSIONS AND LOCATIONS OF PATCHES SHALL BE DETERMINED BY THE ENGINEER IN THE FIELD FOR FINAL PAY QUANTITY.
- PLAN QUANTITIES INCLUDE 50% CONTINGENCY ADDED TO MEASURED QUANTITIES.
- ANODES ARE INCLUDED FOR PAYMENT WITH ITEM SPECIAL - PATCHING CONCRETE STRUCTURE, TYPE 1 OR TYPE 2 REPAIR.
- FOR DETAILS AND MAXIMUM GRID SPACING FOR EMBEDDED GALVANIC ANODES, SEE SHEET [84/89].
- FOR SECTION A-A, SEE SHEET [34/89].
- FOR FRP WRAP DETAILS, SEE SHEET [85/89].


LEGEND:

- # FLOORBEAM LINE NUMBER
- # REPAIR NO. OF DEFICIENT CONCRETE TO BE REPAIRED IN ACCORDANCE WITH ITEM SPECIAL - PATCHING CONCRETE STRUCTURE, TYPE 1 OR TYPE 2 REPAIR.
- A REPAIR NO. OF DEFICIENT CONCRETE TO BE REPAIRED IN ACCORDANCE WITH SUPPLEMENTAL SPECIFICATION 843.
- AREA TO BE TREATED WITH FRP WRAP PER ITEM SPECIAL - COMPOSITE FIBER WRAP SYSTEM

| | | | | |
|--------------------------------|-----------|--|--|---------------------------------|
| GRAPHIC SCALE MEASURED IN FEET | DATE | 9902 Carver Road
Suite 201
Cincinnati, OH 45242
PH.: 614.699.5000 | DETROIT-SUPERIOR BRIDGE OVER CUYAHOGA RIVER
BRIDGE NO. CUY-6-1465 | |
| NOT TO SCALE | NOV, 2018 | | INFRASTRUCTURE ENGINEERS, INC. | SPAN 10 CONCRETE REPAIR DETAILS |

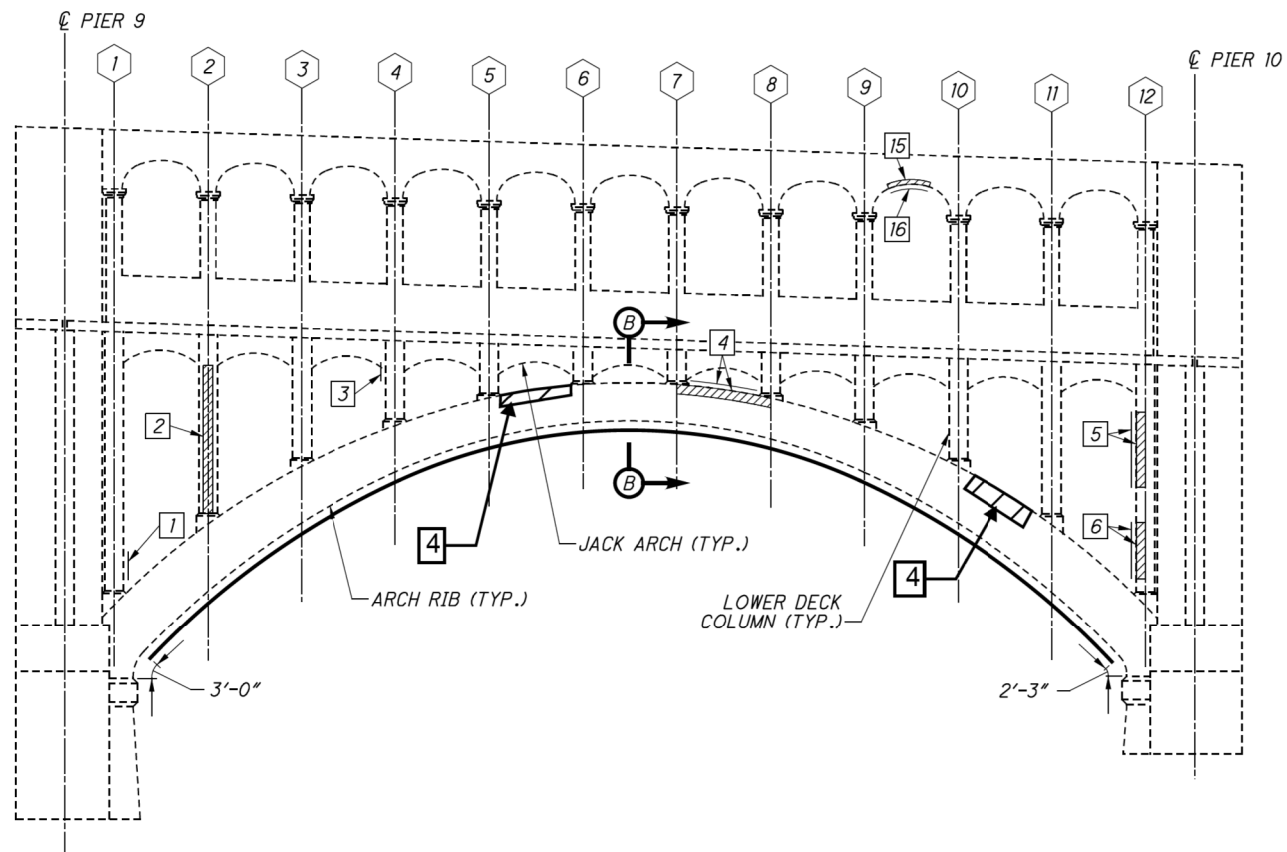

SPAN 10 - ARCH RIB A SOUTH ELEVATION
(LOOKING NORTH)

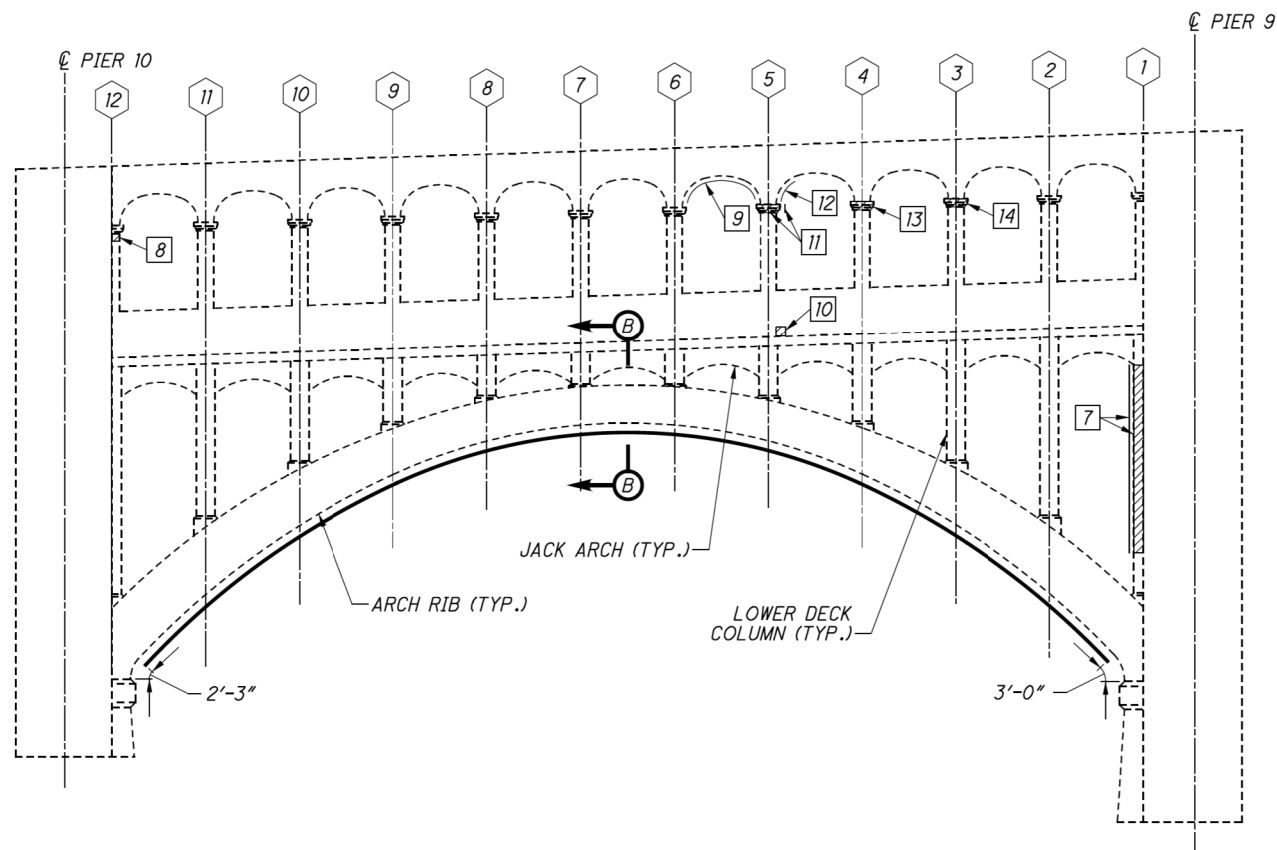

SPAN 10 - ARCH RIB A NORTH ELEVATION
(LOOKING SOUTH)

ESTIMATED PATCHING QUANTITIES

| REPAIR NO. | REPAIR TYPE | AREA (SF) | ANODE QUANTITY** |
|--------------------|-------------|-----------|------------------|
| 1 | TYPE 1 | 3 | 2 |
| 2 | TYPE 1 | 16 | 8 |
| 3 | TYPE 1 | 2 | 1 |
| 4 | TYPE 1 | 20 | 7 |
| 5 | TYPE 1 | 16 | 4 |
| 6 | TYPE 1 | 12 | 3 |
| 7 | TYPE 1 | 40 | 10 |
| 8 | TYPE 1 | 1 | 1 |
| 9 | TYPE 2 | 10 | 7 |
| 10 | TYPE 1 | 1 | 1 |
| 11 | TYPE 1 | 3 | 2 |
| 12 | TYPE 2 | 2 | 1 |
| 13 | TYPE 1 | 2 | 1 |
| 14 | TYPE 1 | 2 | 1 |
| 15 | TYPE 1 | 2 | 2 |
| 16 | TYPE 2 | 2 | 3 |
| MEASURED QUANTITY* | | 134 | - |
| PLAN QUANTITY* | | 201 | 54 |

* SEE NOTES 1 & 2
** SEE NOTES 3 & 4

SHEET QUANTITY SUMMARY

| ITEM | UNIT | QUANTITY |
|---------------|------|----------|
| TYPE 1 REPAIR | SF | 180 |
| TYPE 2 REPAIR | SF | 21 |
| FRP WRAP | SF | 1304 |

NOTES:

- MEASURED QUANTITIES ARE BASED ON THE VISUAL INSPECTION PERFORMED IN NOVEMBER 2017. THE EXACT DIMENSIONS AND LOCATIONS OF PATCHES SHALL BE DETERMINED BY THE ENGINEER IN THE FIELD FOR FINAL PAY QUANTITY.
- PLAN QUANTITIES INCLUDE 50% CONTINGENCY ADDED TO MEASURED QUANTITIES.
- ANODES ARE INCLUDED FOR PAYMENT WITH ITEM SPECIAL - PATCHING CONCRETE STRUCTURE, TYPE 1 OR TYPE 2 REPAIR.
- GALVANIC ANODES WILL NOT BE USED FOR PATCHING THE UNREINFORCED VERTICAL SIDES OF THE CONCRETE ARCH RIBS.
- FOR DETAILS AND MAXIMUM GRID SPACING FOR EMBEDDED GALVANIC ANODES, SEE SHEET [84/89].
- FOR PIER 9 REPAIR DETAILS, SEE SHEET [29/89].
- FOR FRP WRAP DETAILS AND SECTION B-B, SEE SHEET [85/89].

LEGEND:

- SPANDREL COLUMN NUMBER
- REPAIR NUMBER
- LOCATION OF DEFICIENT CONCRETE TO BE REPAIRED IN ACCORDANCE WITH ITEM SPECIAL - PATCHING CONCRETE STRUCTURE, TYPE 1 REPAIR
- LOCATION OF DEFICIENT CONCRETE ON PERPENDICULAR FACE (NOT VISIBLE IN ELEVATION VIEW) TO BE REPAIRED IN ACCORDANCE WITH ITEM SPECIAL - PATCHING CONCRETE STRUCTURE, TYPE 1 OR TYPE 2 REPAIR
- AREA TO BE TREATED WITH FRP WRAP PER ITEM SPECIAL - COMPOSITE FIBER WRAP SYSTEM

GRAPHIC SCALE MEASURED IN FEET

NOT TO SCALE

DATE

NOV, 2018




9902 Carver Road
Suite 201
Cincinnati, OH 45242
PH.: 614.699.5000

INFRASTRUCTURE
ENGINEERS, INC.


DETROIT-SUPERIOR BRIDGE OVER CUYAHOGA RIVER
BRIDGE NO. CUY-6-1465

SPAN 10 CONCRETE REPAIR DETAILS

PAGE
A-95

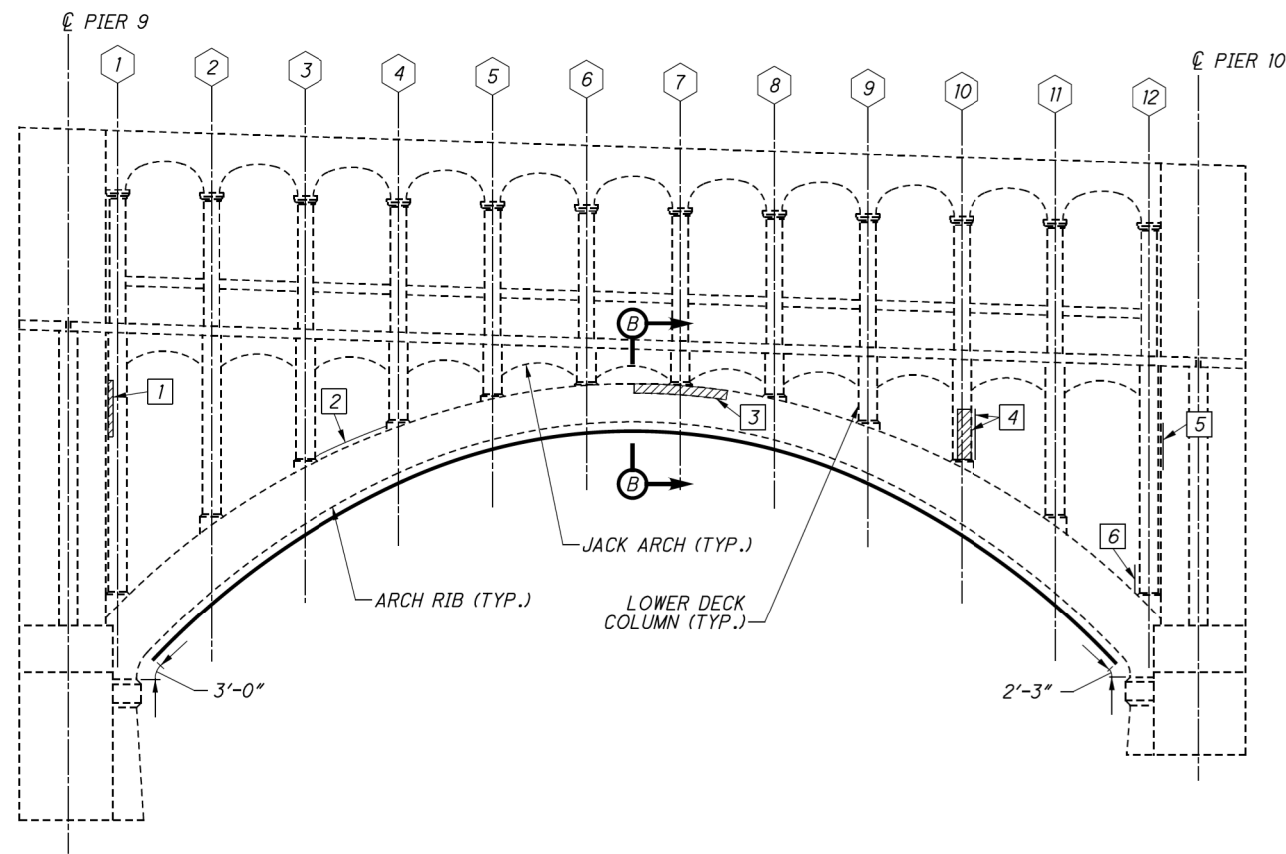

SPAN 10 - ARCH RIB B SOUTH ELEVATION
(LOOKING NORTH)

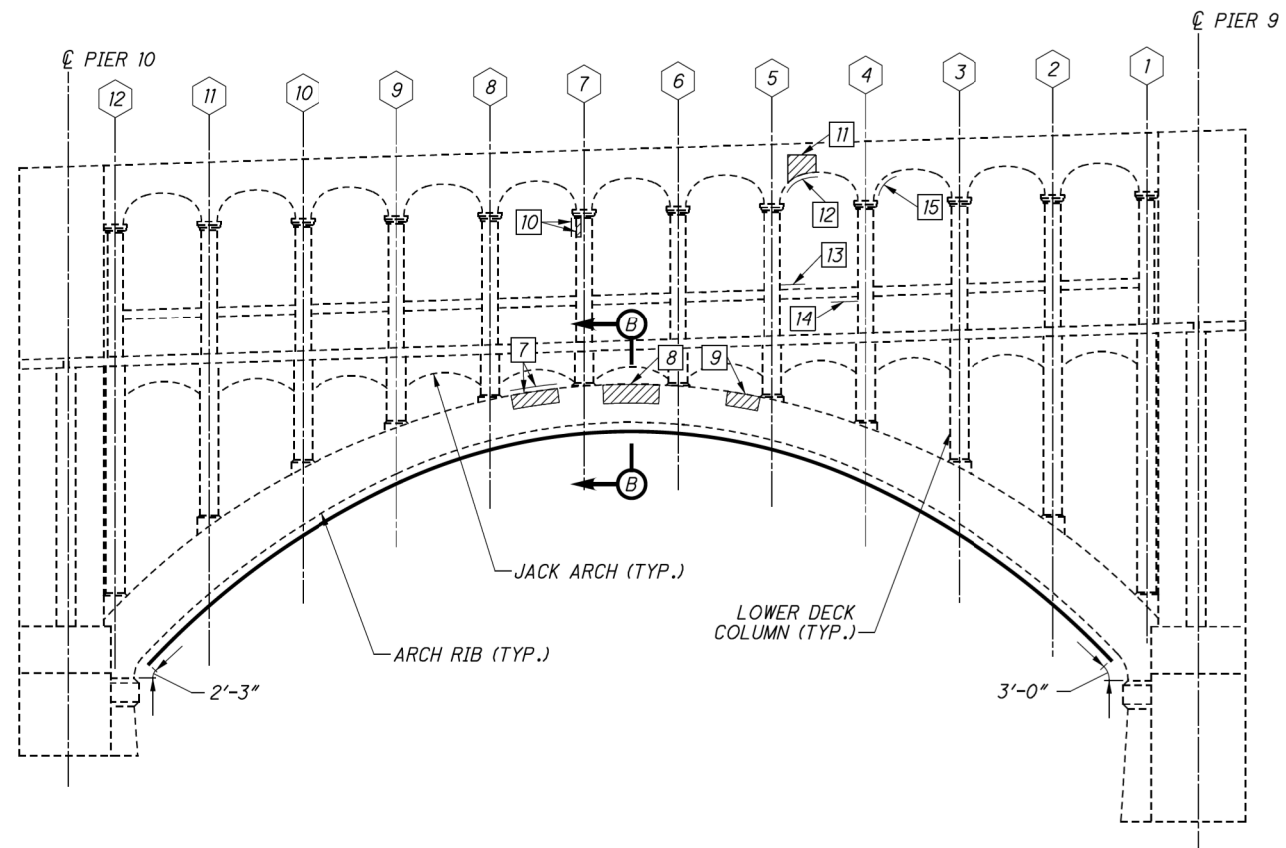

SPAN 10 - ARCH RIB B NORTH ELEVATION
(LOOKING SOUTH)

ESTIMATED PATCHING QUANTITIES

| REPAIR NO. | REPAIR TYPE | AREA (SF) | ANODE QUANTITY** |
|--------------------|-------------|-----------|------------------|
| 1 | TYPE 1 | 3 | 3 |
| 2 | TYPE 1 | 80 | 22 |
| 3 | TYPE 1 | 10 | - |
| 4 | TYPE 1 | 16 | 6 |
| 5 | TYPE 1 | 5 | 3 |
| 6 | TYPE 1 | 6 | 2 |
| 7 | TYPE 1 | 48 | 16 |
| 8 | TYPE 1 | 12 | - |
| 9 | TYPE 1 | 5 | - |
| 10 | TYPE 1 | 1 | 1 |
| 11 | TYPE 1 | 6 | 2 |
| 12 | TYPE 2 | 3 | 2 |
| 13 | TYPE 1 | 3 | 2 |
| 14 | TYPE 2 | 3 | 2 |
| 15 | TYPE 2 | 3 | 2 |
| MEASURED QUANTITY* | | 204 | - |
| PLAN QUANTITY* | | 306 | 63 |

* SEE NOTES 1 & 2
** SEE NOTES 3 & 4

SHEET QUANTITY SUMMARY

| ITEM | UNIT | QUANTITY |
|---------------|------|----------|
| TYPE 1 REPAIR | SF | 293 |
| TYPE 2 REPAIR | SF | 13 |
| FRP WRAP | SF | 1541 |


NOTES:

- MEASURED QUANTITIES ARE BASED ON THE VISUAL INSPECTION PERFORMED IN NOVEMBER 2017. THE EXACT DIMENSIONS AND LOCATIONS OF PATCHES SHALL BE DETERMINED BY THE ENGINEER IN THE FIELD FOR FINAL PAY QUANTITY.
- PLAN QUANTITIES INCLUDE 50% CONTINGENCY ADDED TO MEASURED QUANTITIES.
- ANODES ARE INCLUDED FOR PAYMENT WITH ITEM SPECIAL - PATCHING CONCRETE STRUCTURE, TYPE 1 OR TYPE 2 REPAIR.
- GALVANIC ANODES WILL NOT BE USED FOR PATCHING THE UNREINFORCED VERTICAL SIDES OF THE CONCRETE ARCH RIBS.
- FOR DETAILS AND MAXIMUM GRID SPACING FOR EMBEDDED GALVANIC ANODES, SEE SHEET [84/89].
- FOR PIER 9 REPAIR DETAILS, SEE SHEET [29/89].
- FOR FRP WRAP DETAILS AND SECTION B-B, SEE SHEET [85/89].


LEGEND:

- # SPANDREL COLUMN NUMBER
- # REPAIR NUMBER
- ▨ LOCATION OF DEFICIENT CONCRETE TO BE REPAIRED IN ACCORDANCE WITH ITEM SPECIAL - PATCHING CONCRETE STRUCTURE, TYPE 1 REPAIR
- ⋮ LOCATION OF DEFICIENT CONCRETE ON PERPENDICULAR FACE (NOT VISIBLE IN ELEVATION VIEW) TO BE REPAIRED IN ACCORDANCE WITH ITEM SPECIAL - PATCHING CONCRETE STRUCTURE, TYPE 1 OR TYPE 2 REPAIR
- AREA TO BE TREATED WITH FRP WRAP PER ITEM SPECIAL - COMPOSITE FIBER WRAP SYSTEM

| | | | | |
|--------------------------------|-----------|--|--|---------------------------------|
| GRAPHIC SCALE MEASURED IN FEET | DATE |  9902 Carver Road
Suite 201
Cincinnati, OH 45242
PH.: 614.699.5000 | DETROIT-SUPERIOR BRIDGE OVER CUYAHOGA RIVER
BRIDGE NO. CUY-6-1465 | |
| NOT TO SCALE | NOV, 2018 | | INFRASTRUCTURE ENGINEERS, INC. | SPAN 10 CONCRETE REPAIR DETAILS |

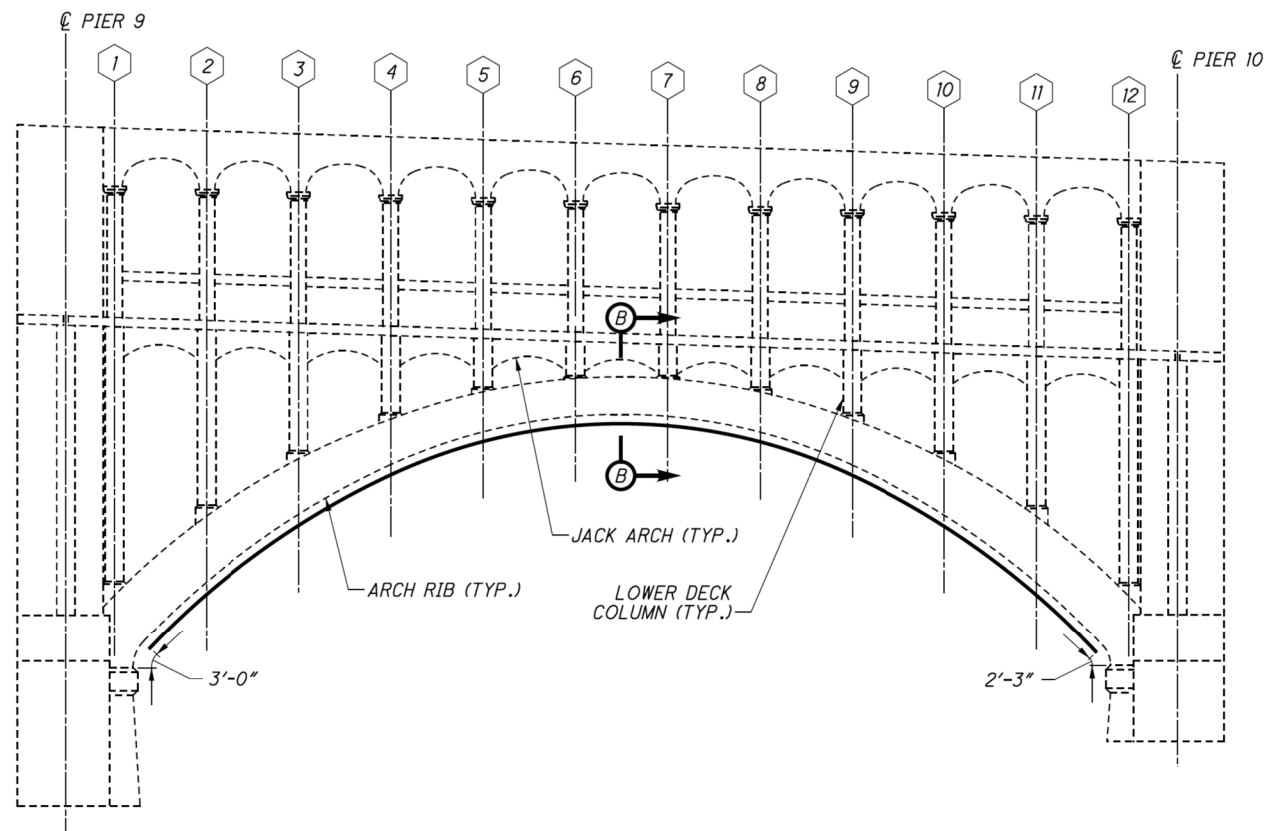

SPAN 10 - ARCH RIB C SOUTH ELEVATION
(LOOKING NORTH)

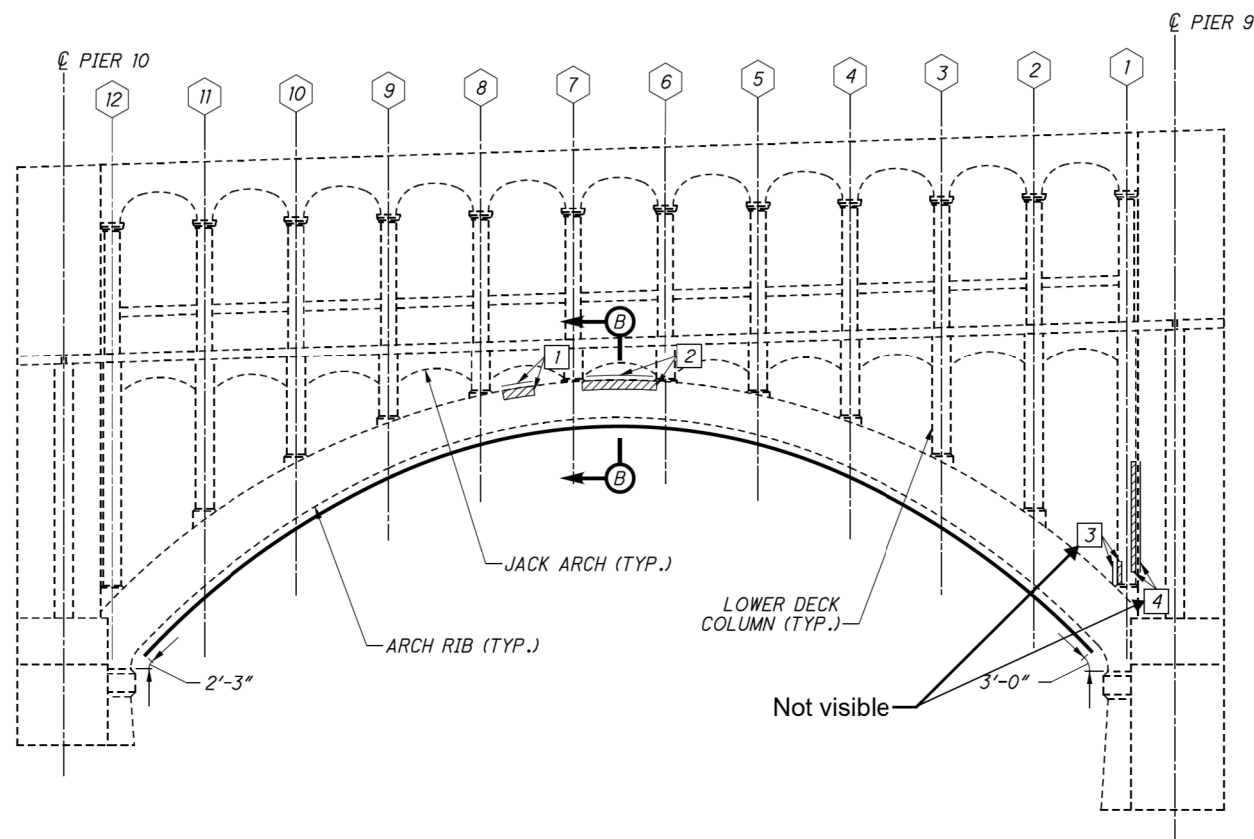

SPAN 10 - ARCH RIB C NORTH ELEVATION
(LOOKING SOUTH)

| ESTIMATED PATCHING QUANTITIES | | | |
|-------------------------------|-------------|-----------|------------------|
| REPAIR NO. | REPAIR TYPE | AREA (SF) | ANODE QUANTITY** |
| 1 | TYPE 1 | 7 | 2 |
| 2 | TYPE 1 | 32 | 12 |
| 3 | TYPE 1 | 3 | 1 |
| 4 | TYPE 1 | 34 | 6 |
| MEASURED QUANTITY* | | 76 | - |
| PLAN QUANTITY* | | 114 | 21 |

* SEE NOTES 1 & 2
** SEE NOTES 3 & 4

| SHEET QUANTITY SUMMARY | | |
|------------------------|------|----------|
| ITEM | UNIT | QUANTITY |
| TYPE 1 REPAIR | SF | 114 |
| TYPE 2 REPAIR | SF | - |
| FRP WRAP | SF | 1541 |


NOTES:

- MEASURED QUANTITIES ARE BASED ON THE VISUAL INSPECTION PERFORMED IN DECEMBER 2016. THE EXACT DIMENSIONS AND LOCATIONS OF PATCHES SHALL BE DETERMINED BY THE ENGINEER IN THE FIELD FOR FINAL PAY QUANTITY.
- PLAN QUANTITIES INCLUDE 50% CONTINGENCY ADDED TO MEASURED QUANTITIES.
- ANODES ARE INCLUDED FOR PAYMENT WITH ITEM SPECIAL - PATCHING CONCRETE STRUCTURE, TYPE 1 OR TYPE 2 REPAIR.
- GALVANIC ANODES WILL NOT BE USED FOR PATCHING THE UNREINFORCED VERTICAL SIDES OF THE CONCRETE ARCH RIBS.
- FOR DETAILS AND MAXIMUM GRID SPACING FOR EMBEDDED GALVANIC ANODES, SEE SHEET [84/89].
- FOR PIER 9 REPAIR DETAILS, SEE SHEET [29/89].
- FOR FRP WRAP DETAILS AND SECTION B-B, SEE SHEET [85/89].


LEGEND:

- # SPANDREL COLUMN NUMBER
- # REPAIR NUMBER
- ▨ LOCATION OF DEFICIENT CONCRETE TO BE REPAIRED IN ACCORDANCE WITH ITEM SPECIAL - PATCHING CONCRETE STRUCTURE, TYPE 1 REPAIR
- || LOCATION OF DEFICIENT CONCRETE ON PERPENDICULAR FACE (NOT VISIBLE IN ELEVATION VIEW) TO BE REPAIRED IN ACCORDANCE WITH ITEM SPECIAL - PATCHING CONCRETE STRUCTURE, TYPE 1 OR TYPE 2 REPAIR
- AREA TO BE TREATED WITH FRP WRAP PER ITEM SPECIAL - COMPOSITE FIBER WRAP SYSTEM

| | | | | |
|--------------------------------|--------------|--|--|--------------------------------|
| GRAPHIC SCALE MEASURED IN FEET | DATE |  9902 Carver Road
Suite 201
Cincinnati, OH 45242
PH.: 614.699.5000 | DETROIT-SUPERIOR BRIDGE OVER CUYAHOGA RIVER
BRIDGE NO. CUY-6-1465 | |
| | NOT TO SCALE | | NOV, 2018 | INFRASTRUCTURE ENGINEERS, INC. |
| | | | | PAGE A-97 |

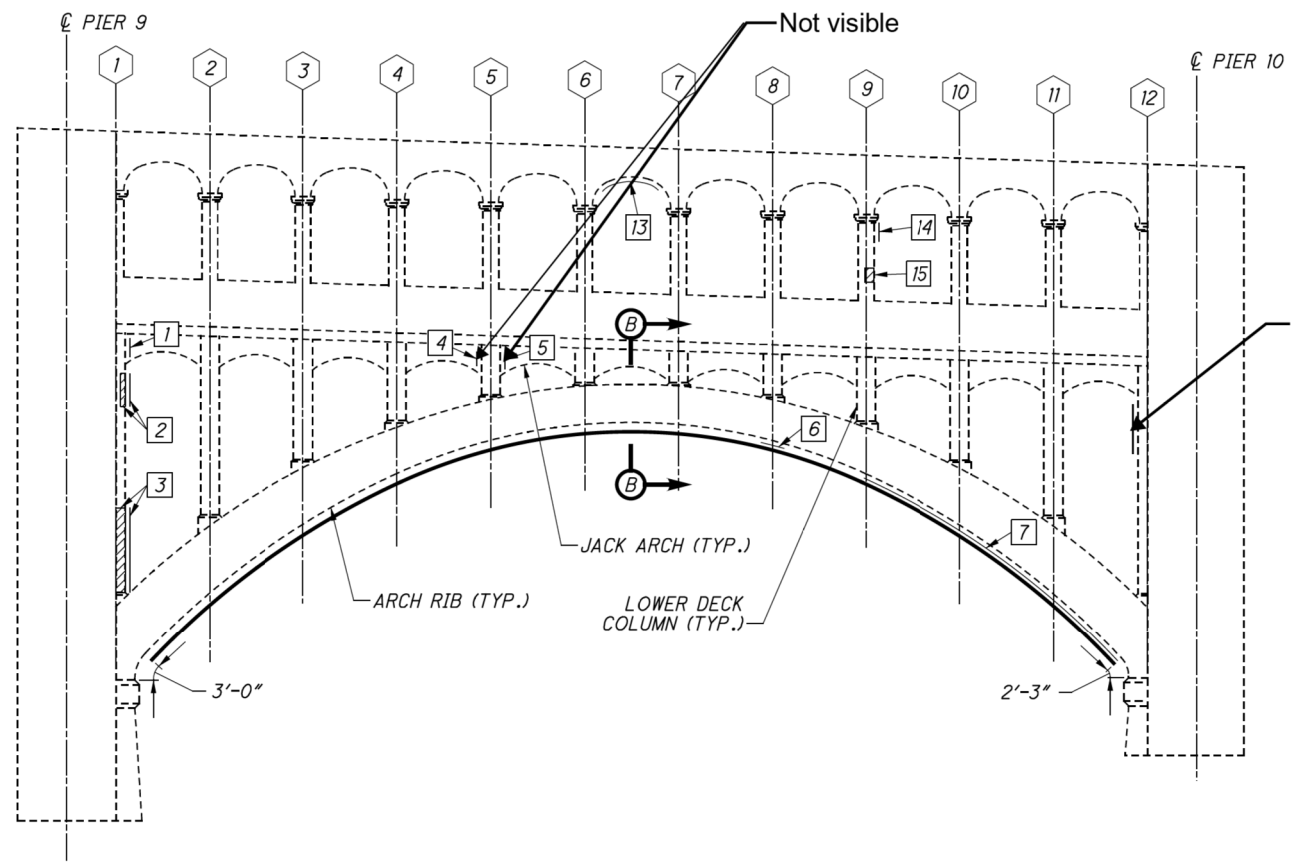

SPAN 10 - ARCH RIB D SOUTH ELEVATION
(LOOKING NORTH)

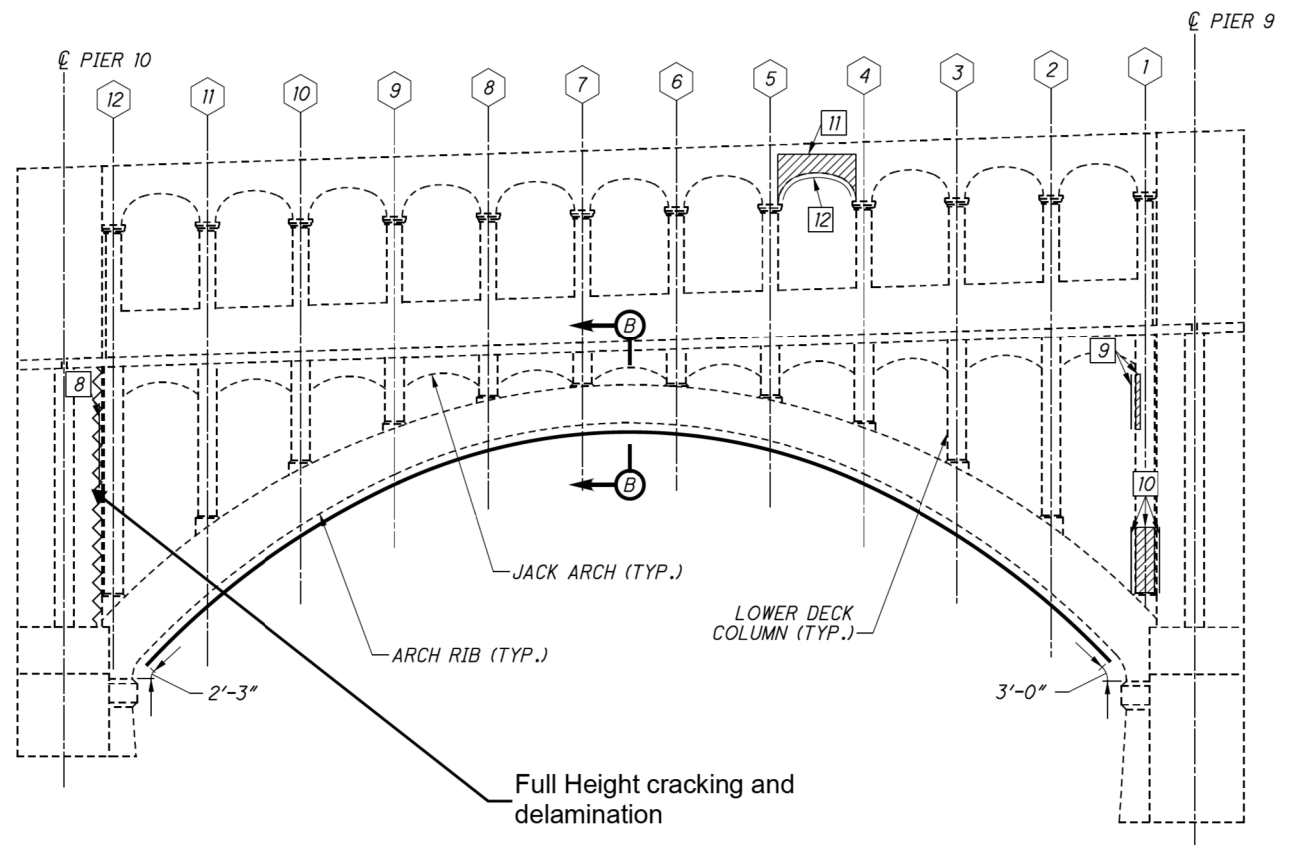

SPAN 10 - ARCH RIB D NORTH ELEVATION
(LOOKING SOUTH)

| ESTIMATED PATCHING QUANTITIES | | | |
|-------------------------------|-------------|-----------|------------------|
| REPAIR NO. | REPAIR TYPE | AREA (SF) | ANODE QUANTITY** |
| 1 | TYPE 1 | 4 | 1 |
| 2 | TYPE 1 | 8 | 3 |
| 3 | TYPE 1 | 21 | 5 |
| 4 | TYPE 1 | 1 | 1 |
| 5 | TYPE 1 | 2 | 1 |
| 6 | TYPE 2 | 4 | 1 |
| 7 | TYPE 2 | 138 | 52 |
| 8 | TYPE 1 | 18 | 5 |
| 9 | TYPE 1 | 6 | 2 |
| 10 | TYPE 1 | 24 | 8 |
| 11 | TYPE 1 | 24 | 8 |
| 12 | TYPE 2 | 18 | 9 |
| 13 | TYPE 2 | 7 | 5 |
| 14 | TYPE 1 | 2 | 1 |
| 15 | TYPE 1 | 2 | 1 |
| MEASURED QUANTITY* | | 279 | - |
| PLAN QUANTITY* | | 419 | 103 |

* SEE NOTES 1 & 2
** SEE NOTES 3 & 4

| SHEET QUANTITY SUMMARY | | |
|------------------------|------|----------|
| ITEM | UNIT | QUANTITY |
| TYPE 1 REPAIR | SF | 168 |
| TYPE 2 REPAIR | SF | 251 |
| FRP WRAP | SF | 1304 |



NOTES:

- MEASURED QUANTITIES ARE BASED ON THE VISUAL INSPECTION PERFORMED IN DECEMBER 2016. THE EXACT DIMENSIONS AND LOCATIONS OF PATCHES SHALL BE DETERMINED BY THE ENGINEER IN THE FIELD FOR FINAL PAY QUANTITY.
- PLAN QUANTITIES INCLUDE 50% CONTINGENCY ADDED TO MEASURED QUANTITIES.
- ANODES ARE INCLUDED FOR PAYMENT WITH ITEM SPECIAL - PATCHING CONCRETE STRUCTURE, TYPE 1 OR TYPE 2 REPAIR.
- GALVANIC ANODES WILL NOT BE USED FOR PATCHING THE UNREINFORCED VERTICAL SIDES OF THE CONCRETE ARCH RIBS.
- FOR DETAILS AND MAXIMUM GRID SPACING FOR EMBEDDED GALVANIC ANODES, SEE SHEET [84/89].
- FOR PIER 9 REPAIR DETAILS, SEE SHEET [29/89].
- FOR FRP WRAP DETAILS AND SECTION B-B, SEE SHEET [85/89].

LEGEND:

- SPANDREL COLUMN NUMBER
- REPAIR NUMBER
- LOCATION OF DEFICIENT CONCRETE TO BE REPAIRED IN ACCORDANCE WITH ITEM SPECIAL - PATCHING CONCRETE STRUCTURE, TYPE 1 REPAIR
- LOCATION OF DEFICIENT CONCRETE ON PERPENDICULAR FACE (NOT VISIBLE IN ELEVATION VIEW) TO BE REPAIRED IN ACCORDANCE WITH ITEM SPECIAL - PATCHING CONCRETE STRUCTURE, TYPE 1 OR TYPE 2 REPAIR
- AREA TO BE TREATED WITH FRP WRAP PER ITEM SPECIAL - COMPOSITE FIBER WRAP SYSTEM


| | | | | |
|--------------------------------|-----------|--|--|---------------------------------|
| GRAPHIC SCALE MEASURED IN FEET | DATE | 9902 Carver Road
Suite 201
Cincinnati, OH 45242
PH.: 614.699.5000 | DETROIT-SUPERIOR BRIDGE OVER CUYAHOGA RIVER
BRIDGE NO. CUY-6-1465 | |
| NOT TO SCALE | NOV, 2018 | | INFRASTRUCTURE ENGINEERS, INC. | SPAN 10 CONCRETE REPAIR DETAILS |

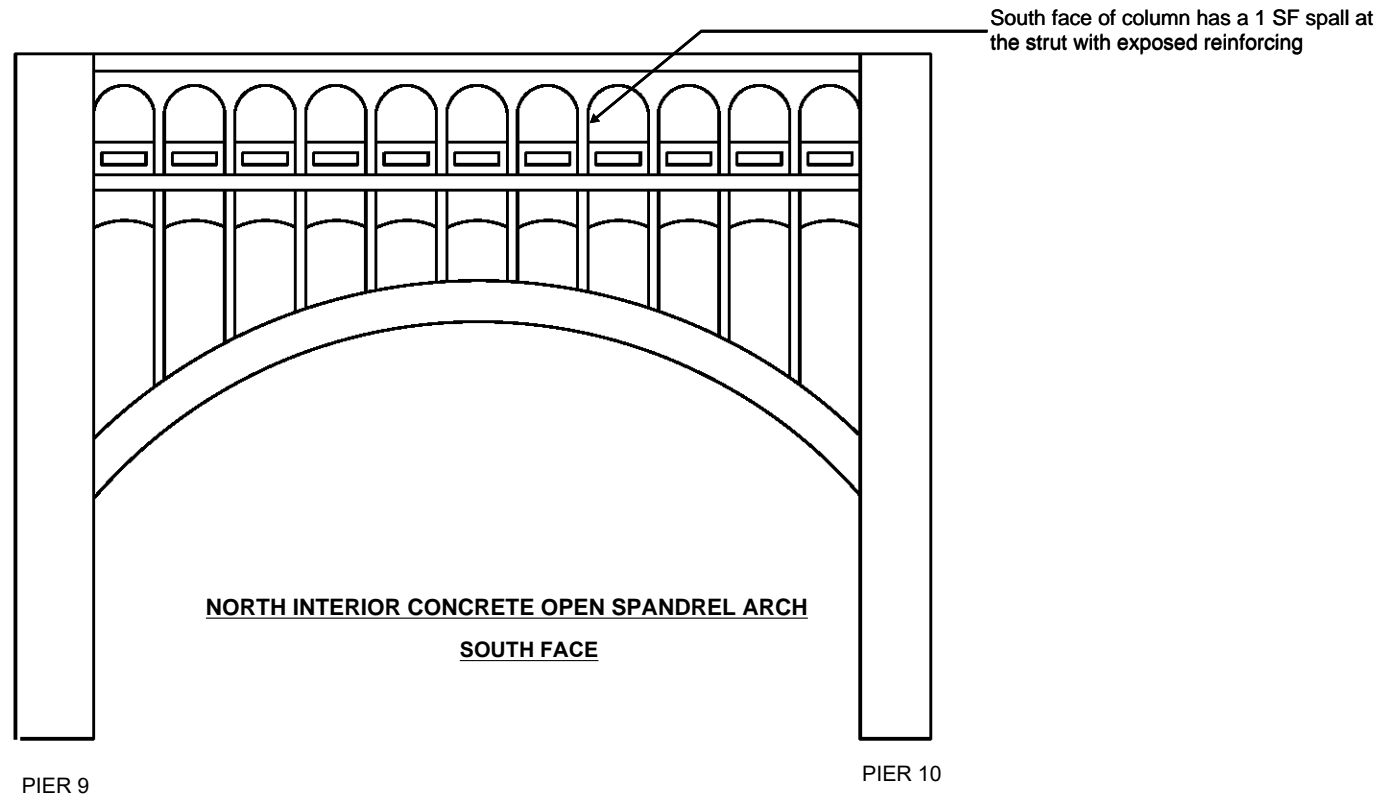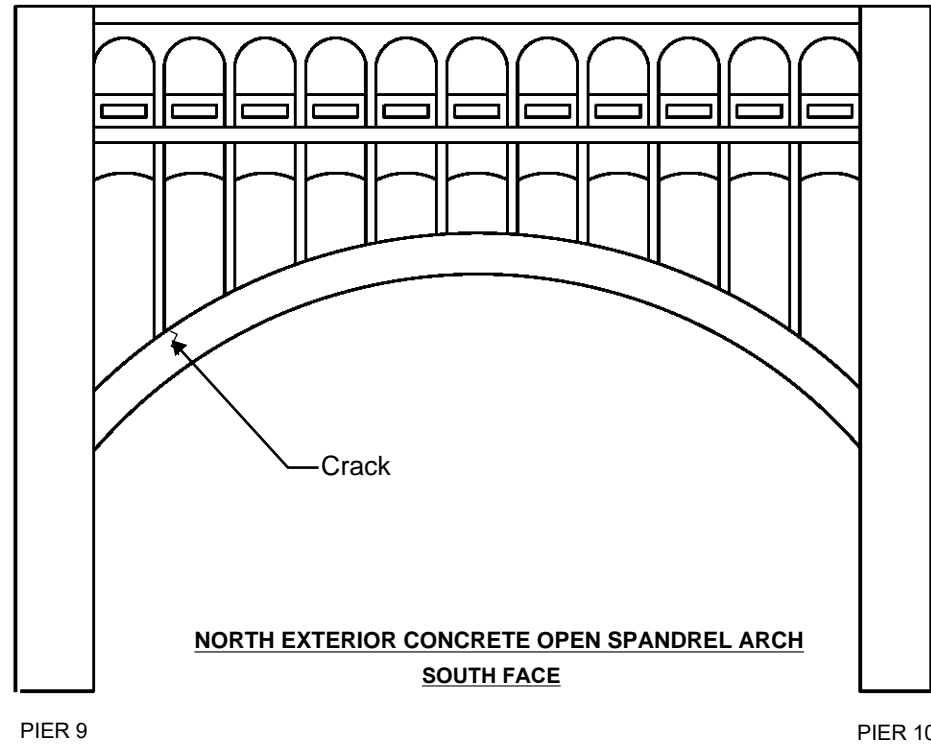

General Notes:

- Floor beams typically have random spalls with exposed corroded reinforcing


| | | | | |
|--------------------------------|-----------|--|--|-------------------------------|
| GRAPHIC SCALE MEASURED IN FEET | DATE |  9902 Carver Road
Suite 201
Cincinnati, OH 45242
PH.: 614.699.5000 | DETROIT-SUPERIOR BRIDGE OVER CUYAHOGA RIVER
BRIDGE NO. CUY-6-1465 | |
| NOT TO SCALE | NOV, 2018 | | INFRASTRUCTURE
ENGINEERS, INC. | STRUCTURE ELEVATION - SPAN 10 |

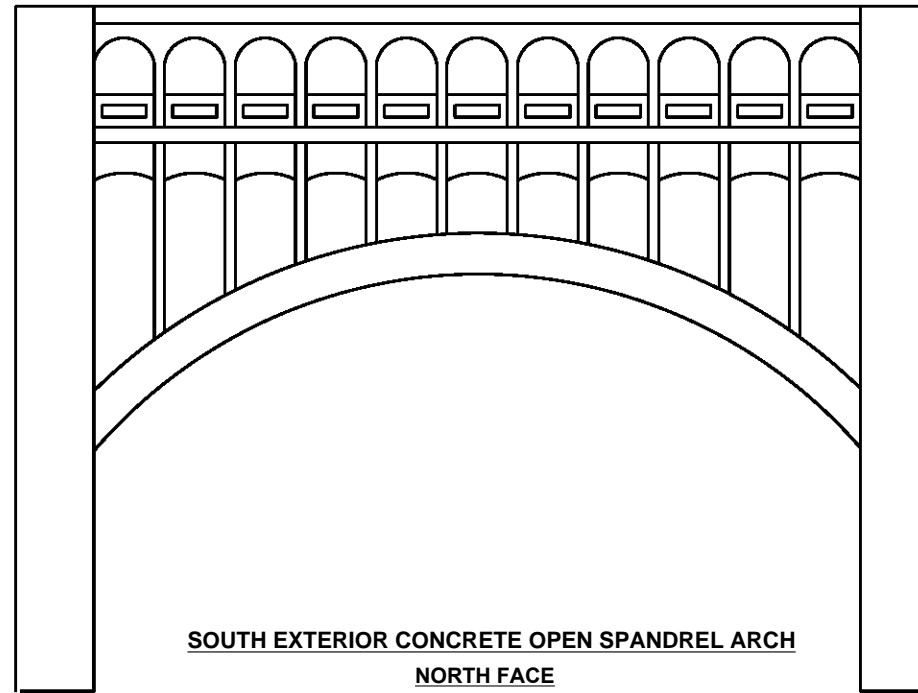

PIER 10

PIER 9


Bottom face: Cracked
and delaminated

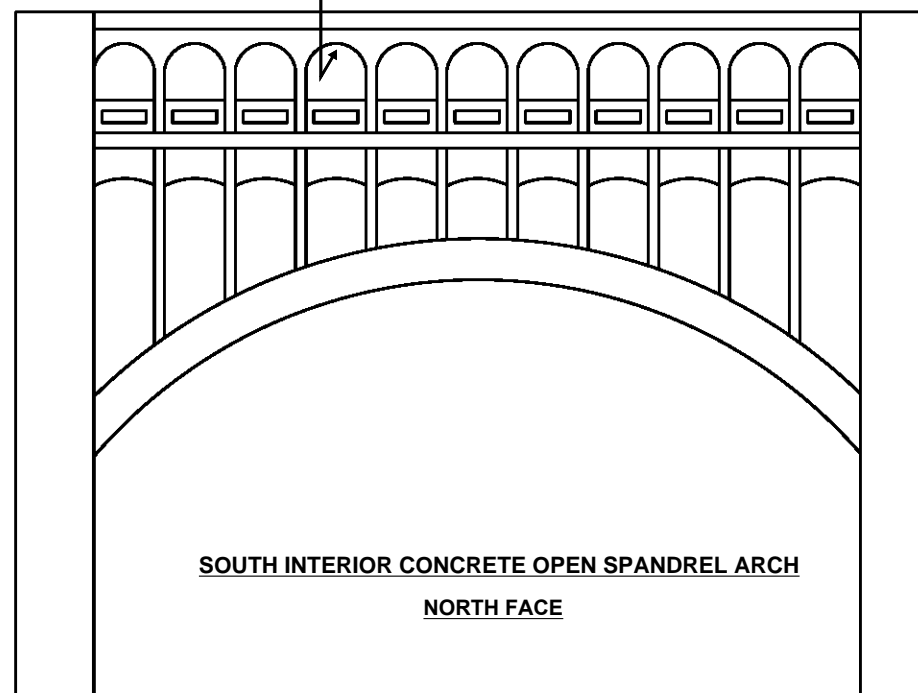

PIER 10

PIER 9

| | | | | |
|---------------------------------------|------------------|--|--|-----------------------|
| <p>GRAPHIC SCALE MEASURED IN FEET</p> | <p>DATE</p> |  <p>9902 Carver Road
Suite 201
Cincinnati, OH 45242
PH.: 614.699.5000</p> | <p>DETROIT-SUPERIOR BRIDGE OVER CUYAHOGA RIVER
BRIDGE NO. CUY-6-1465</p> | |
| <p>NOT TO SCALE</p> | <p>NOV, 2018</p> | <p>INFRASTRUCTURE
ENGINEERS, INC.</p> | <p>STRUCTURE ELEVATION - SPAN 10</p> | <p>PAGE
A-100</p> |

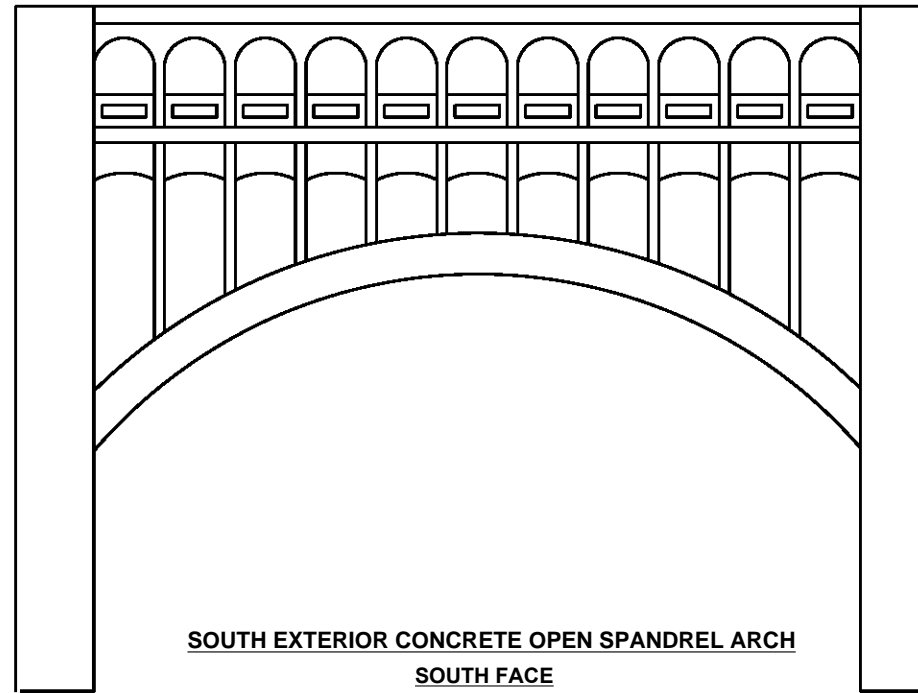


PIER 9

PIER 10

SOUTH EXTERIOR CONCRETE OPEN SPANDREL ARCH
SOUTH FACE

Bottom face: Cracked
and delaminated

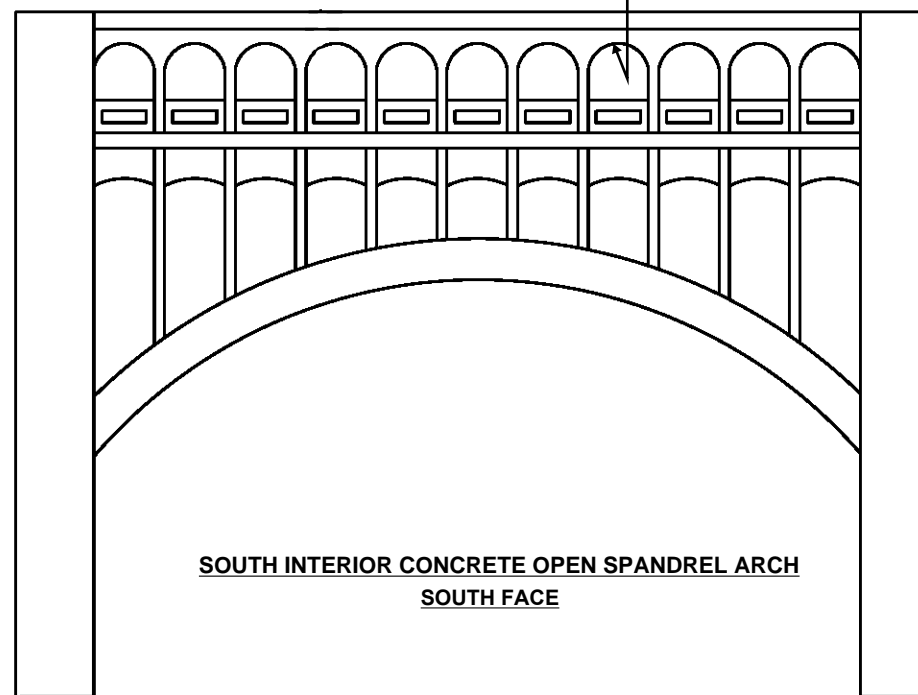

PIER 9

PIER 10

SOUTH INTERIOR CONCRETE OPEN SPANDREL ARCH
SOUTH FACE

GRAPHIC SCALE MEASURED IN FEET

NOT TO SCALE

DATE

NOV, 2018



9902 Carver Road
Suite 201
Cincinnati, OH 45242
PH.: 614.699.5000


INFRASTRUCTURE
ENGINEERS, INC.

DETROIT-SUPERIOR BRIDGE OVER CUYAHOGA RIVER
BRIDGE NO. CUY-6-1465

STRUCTURE ELEVATION - SPAN 10

PAGE

A-101

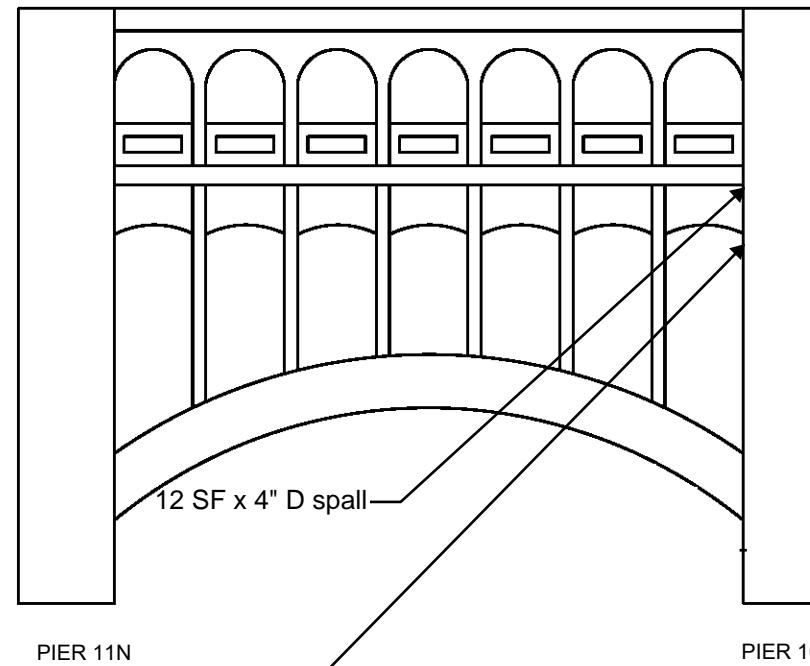


2' horizontal crack with 1'
W x 2" D spall with adjacent
20 SF map cracks

NORTH EXTERIOR CONCRETE OPEN SPANDREL ARCH
NORTH FACE

3' H x 1' W delamination


1 SF x 3" D spall

6' L x 1' H delamination

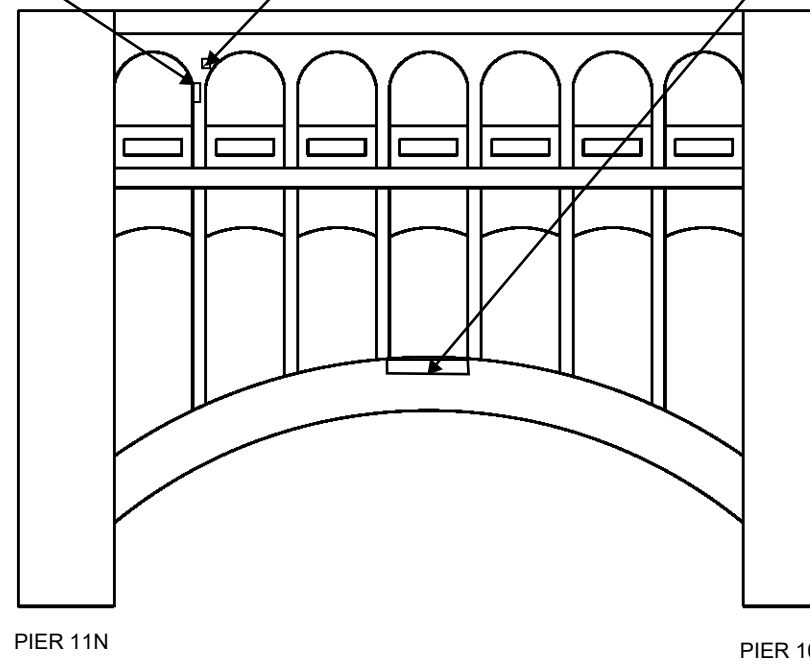

NORTH INTERIOR CONCRETE OPEN SPANDREL ARCH
NORTH FACE


| | | | | |
|---------------------------------------|------------------|--|--|-----------------------|
| <p>GRAPHIC SCALE MEASURED IN FEET</p> | <p>DATE</p> |  <p>9902 Carver Road
Suite 201
Cincinnati, OH 45242
PH.: 614.699.5000</p> | <p>DETROIT-SUPERIOR BRIDGE OVER CUYAHOGA RIVER
BRIDGE NO. CUY-6-1465</p> | |
| <p>NOT TO SCALE</p> | <p>NOV, 2018</p> | <p>INFRASTRUCTURE
ENGINEERS, INC.</p> | <p>STRUCTURE ELEVATION - SPAN 11</p> | <p>PAGE
A-102</p> |

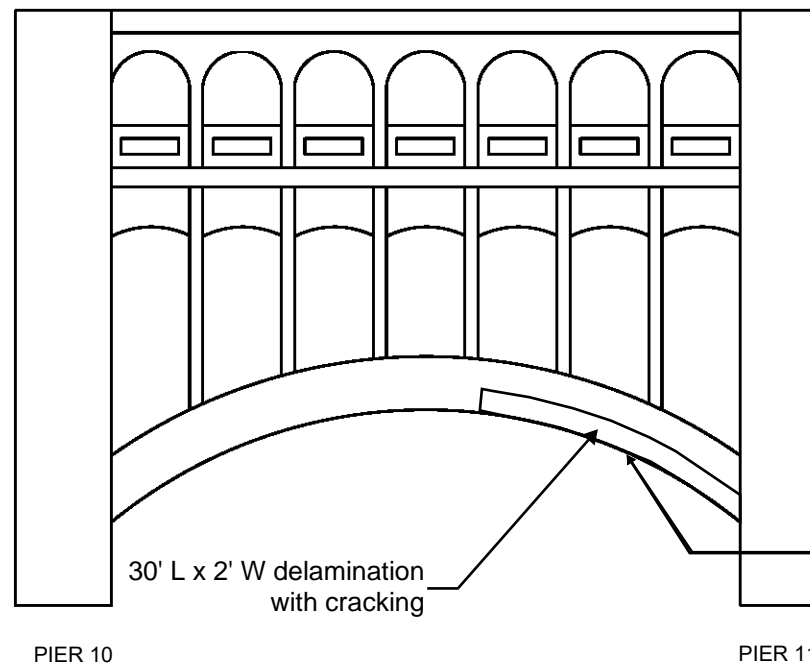

Crack on the south face near the bottom extending from pier 11 to approximately 1/4 the way up the arch


30' L x 2' W delamination with cracking

NORTH EXTERIOR CONCRETE OPEN SPANDREL ARCH
SOUTH FACE

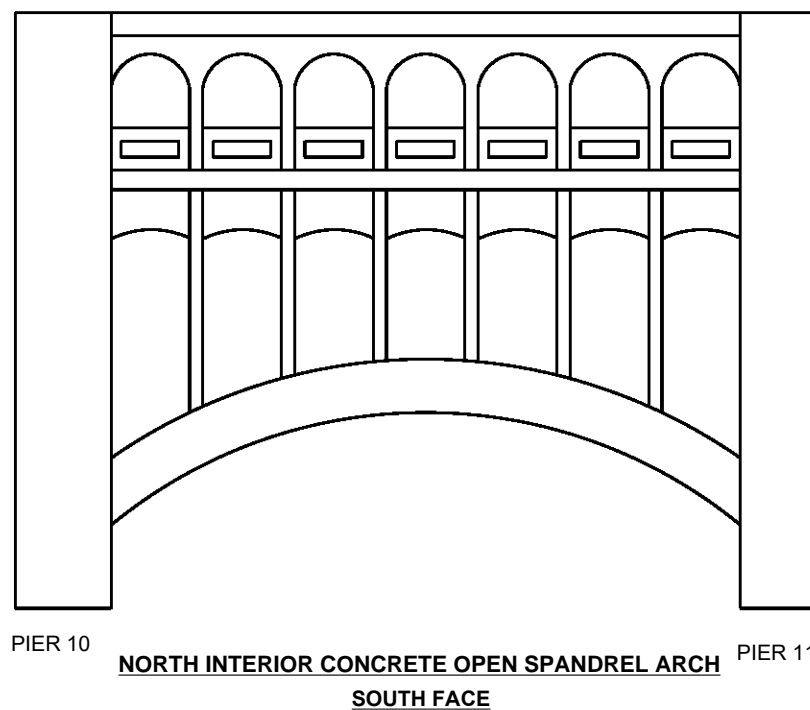


NORTH INTERIOR CONCRETE OPEN SPANDREL ARCH
SOUTH FACE

| | | | |
|---------------------------------------|------------------|--|--|
| <p>GRAPHIC SCALE MEASURED IN FEET</p> | <p>DATE</p> |  <p>9902 Carver Road
Suite 201
Cincinnati, OH 45242
PH.: 614.699.5000</p> | <p>DETROIT-SUPERIOR BRIDGE OVER CUYAHOGA RIVER
BRIDGE NO. CUY-6-1465</p> |
| <p>NOT TO SCALE</p> | <p>NOV, 2018</p> | <p>INFRASTRUCTURE ENGINEERS, INC.</p> | <p>STRUCTURE ELEVATION - SPAN 11</p> <p>PAGE
A-103</p> |

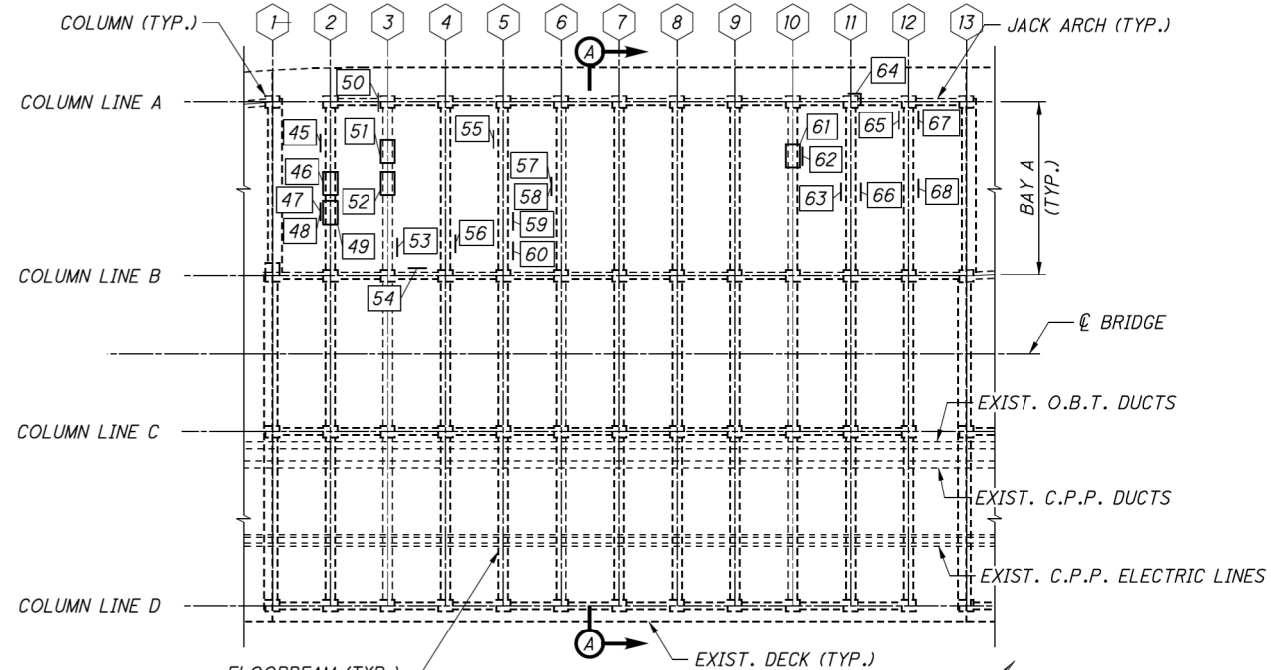

4' L x 2' H x Full Width beam is spalled with exposed steel beam

(3) at 2' W x 2' H delamination
Full Width peeling paint and cracking

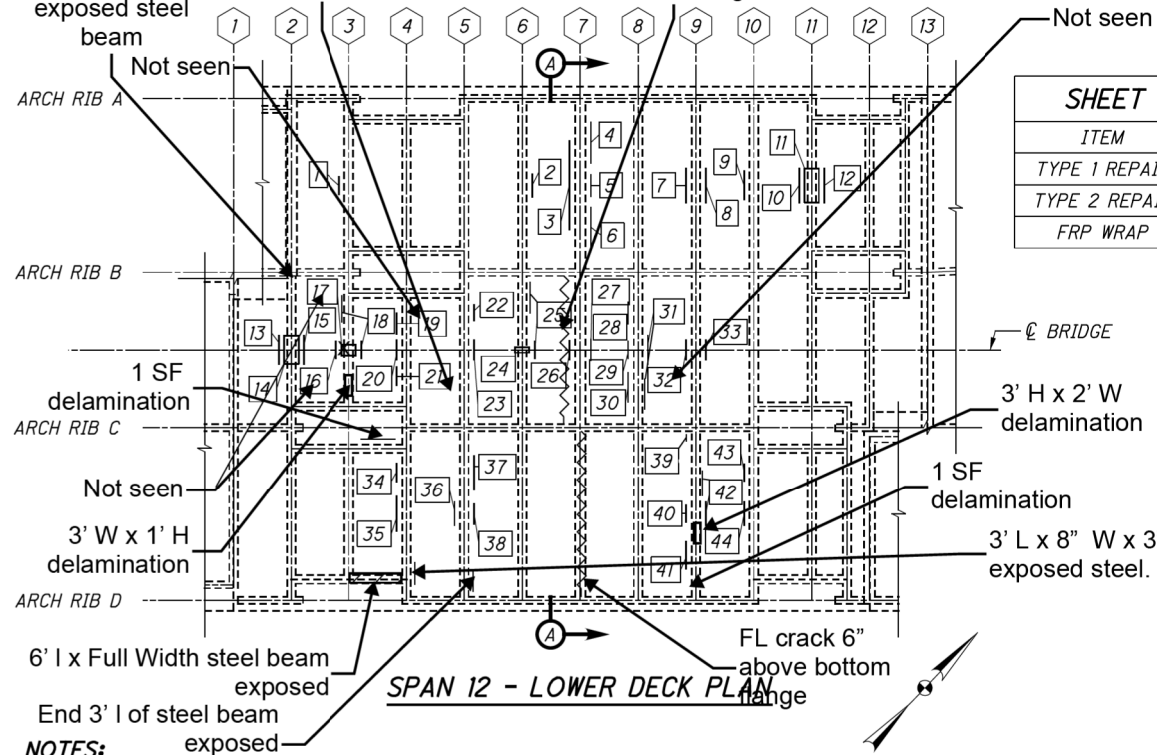


| SHEET QUANTITY SUMMARY | | |
|------------------------|------|----------|
| ITEM | UNIT | QUANTITY |
| TYPE 1 REPAIR | SF | 531 |
| TYPE 2 REPAIR | SF | 44 |
| FRP WRAP | SF | 65 |

| ESTIMATED PATCHING QUANTITIES | | | |
|-------------------------------|-------------|-----------|------------------|
| REPAIR NO. | REPAIR TYPE | AREA (SF) | ANODE QUANTITY** |
| 1 | TYPE 1 | 1 | 1 |
| 2 | TYPE 1 | 6 | 1 |
| 3 | TYPE 1 | 16 | 8 |
| 4 | TYPE 1 | 19 | 4 |
| 5 | TYPE 1 | 5 | 1 |
| 6 | TYPE 1 | 15 | 3 |
| 7 | TYPE 1 | 4 | 1 |
| 8 | TYPE 1 | 4 | 1 |
| 9 | TYPE 1 | 1 | 1 |
| 10 | TYPE 1 | 20 | 6 |
| 11 | TYPE 2 | 6 | 4 |
| 12 | TYPE 1 | 20 | 6 |
| 13 | TYPE 1 | 17 | 6 |
| 14 | TYPE 2 | 5 | 4 |
| 15 | TYPE 1 | 17 | 6 |
| 16 | TYPE 1 | 4 | 2 |
| 17 | TYPE 2 | 2 | 2 |
| 18 | TYPE 1 | 4 | 2 |
| 19 | TYPE 1 | 5 | 1 |
| 20 | TYPE 1 | 2 | 1 |
| 21 | TYPE 1 | 3 | 1 |
| 22 | TYPE 1 | 2 | 1 |
| 23 | TYPE 1 | 3 | 1 |
| 24 | TYPE 2 | 1 | 2 |
| 25 | TYPE 1 | 2 | 1 |
| 26 | TYPE 1 | 2 | 1 |
| 27 | TYPE 1 | 5 | 1 |
| 28 | TYPE 1 | 5 | 1 |
| 29 | TYPE 1 | 2 | 1 |
| 30 | TYPE 1 | 11 | 4 |
| 31 | TYPE 1 | 10 | 4 |
| 32 | TYPE 1 | 3 | 1 |
| 33 | TYPE 1 | 3 | 1 |
| 34 | TYPE 1 | 3 | 1 |
| 35 | TYPE 1 | 14 | 3 |
| 36 | TYPE 1 | 6 | 2 |
| 37 | TYPE 1 | 5 | 3 |

| ESTIMATED PATCHING QUANTITIES | | | |
|-------------------------------|-------------|-----------|------------------|
| REPAIR NO. | REPAIR TYPE | AREA (SF) | ANODE QUANTITY** |
| 38 | TYPE 1 | 4 | 1 |
| 39 | TYPE 1 | 3 | 2 |
| 40 | TYPE 1 | 1 | 1 |
| 41 | TYPE 1 | 10 | 2 |
| 42 | TYPE 1 | 8 | 2 |
| 43 | TYPE 1 | 1 | 1 |
| 44 | TYPE 1 | 2 | 1 |
| 45 | TYPE 1 | 3 | 2 |
| 46 | TYPE 2 | 4 | 3 |
| 47 | TYPE 1 | 1 | 1 |
| 48 | TYPE 1 | 1 | 1 |
| 49 | TYPE 2 | 1 | 1 |
| 50 | TYPE 1 | 2 | 1 |
| 51 | TYPE 2 | 4 | 4 |
| 52 | TYPE 2 | 3 | 3 |
| 53 | TYPE 1 | 2 | 1 |
| 54 | TYPE 1 | 3 | 2 |
| 55 | TYPE 1 | 3 | 2 |
| 56 | TYPE 1 | 1 | 1 |
| 57 | TYPE 1 | 4 | 2 |
| 58 | TYPE 1 | 23 | 5 |
| 59 | TYPE 1 | 6 | 2 |
| 60 | TYPE 1 | 6 | 2 |
| 61 | TYPE 2 | 3 | 3 |
| 62 | TYPE 1 | 10 | 3 |
| 63 | TYPE 1 | 6 | 2 |
| 64 | TYPE 1 | 3 | 2 |
| 65 | TYPE 1 | 1 | 1 |
| 66 | TYPE 1 | 1 | 1 |
| 67 | TYPE 1 | 6 | 2 |
| 68 | TYPE 1 | 4 | 1 |
| MEASURED QUANTITY* | | 383 | - |
| PLAN QUANTITY* | | 575 | 148 |

* SEE NOTES 1 & 2
** SEE NOTE 3

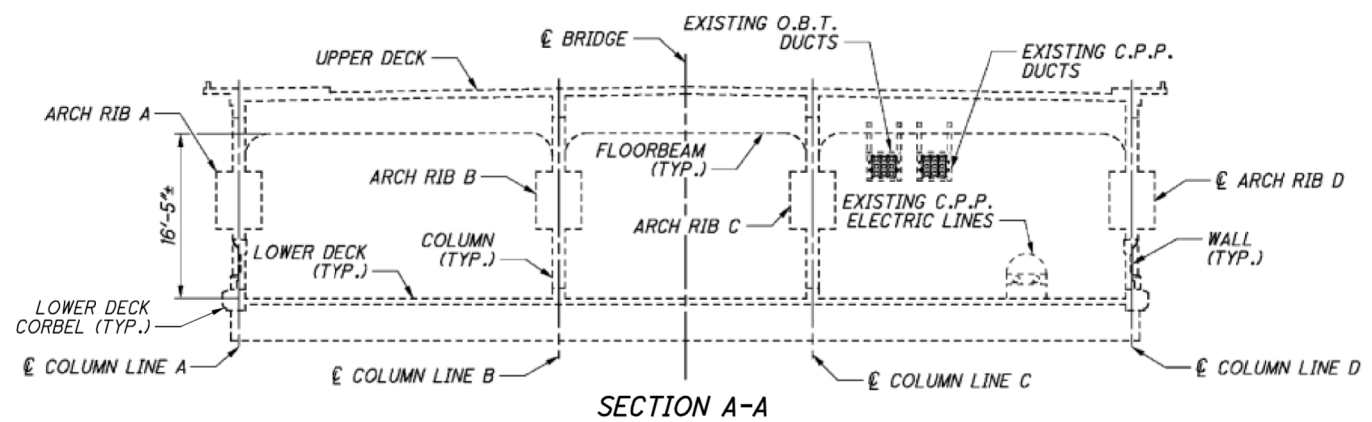

LEGEND:

FLOORBEAM LINE NUMBER


REPAIR NO. OF DEFICIENT CONCRETE TO BE REPAIRED IN ACCORDANCE WITH ITEM SPECIAL - PATCHING CONCRETE STRUCTURE, TYPE 1 OR TYPE 2 REPAIR.

▨ AREA TO BE TREATED WITH FRP WRAP PER ITEM SPECIAL - COMPOSITE FIBER WRAP SYSTEM


NOTES:

- MEASURED QUANTITIES ARE BASED ON THE INSPECTION PERFORMED IN JANUARY 2017. THE EXACT DIMENSIONS AND LOCATIONS OF PATCHES SHALL BE DETERMINED BY THE ENGINEER IN THE FIELD FOR FINAL PAY QUANTITY.
- PLAN QUANTITIES INCLUDE 50% CONTINGENCY ADDED TO MEASURED QUANTITIES.
- THE LOWER DECK FLOORBEAMS ARE CONCRETE ENCASED STEEL GIRDERS AND CONTAIN MINIMAL TEMPERATURE/SHRINKAGE STEEL REINFORCEMENT. PATCH THE VERTICAL SIDES OF THESE MEMBERS IN ACCORDANCE WITH THE STANDARD TYPE 1 REPAIR DETAILS. PATCH THE HORIZONTAL BOTTOM SURFACES IN ACCORDANCE WITH THE DETAILS SHOWN ON SHEET [84/89]. CONNECTION OF THE EMBEDDED GALVANIC ANODES SHALL CONFORM TO THE MANUFACTURER'S RECOMMENDATIONS.
- FOR DETAILS AND MAXIMUM GRID SPACING FOR EMBEDDED GALVANIC ANODES, SEE SHEET [84/89].
- FOR FRP WRAP DETAILS, SEE SHEET [85/89].

| | | | | |
|--------------------------------|-----------|--|--|---------------------------------|
| GRAPHIC SCALE MEASURED IN FEET | DATE | 9902 Carver Road
Suite 201
Cincinnati, OH 45242
PH.: 614.699.5000 | DETROIT-SUPERIOR BRIDGE OVER CUYAHOGA RIVER
BRIDGE NO. CUY-6-1465 | |
| NOT TO SCALE | NOV, 2018 | | INFRASTRUCTURE ENGINEERS, INC. | SPAN 12 CONCRETE REPAIR DETAILS |

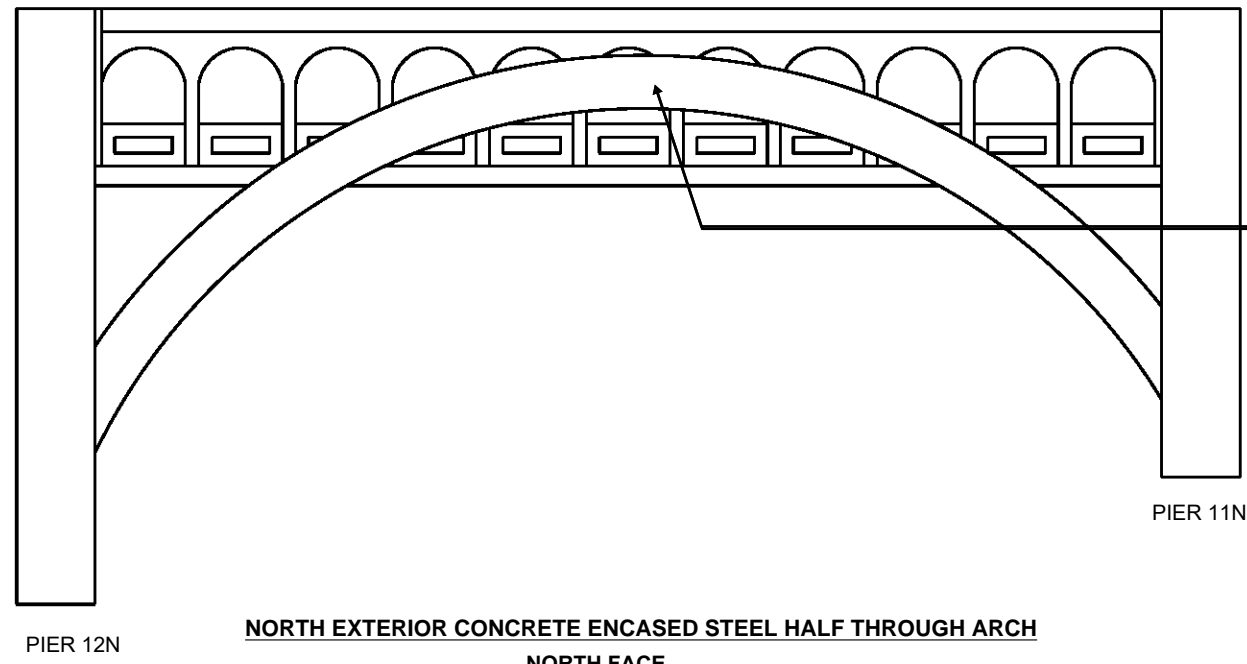

South face of the arch is delaminated with widespread cracking near the bases. 1/2" W crack in the delaminated surface.


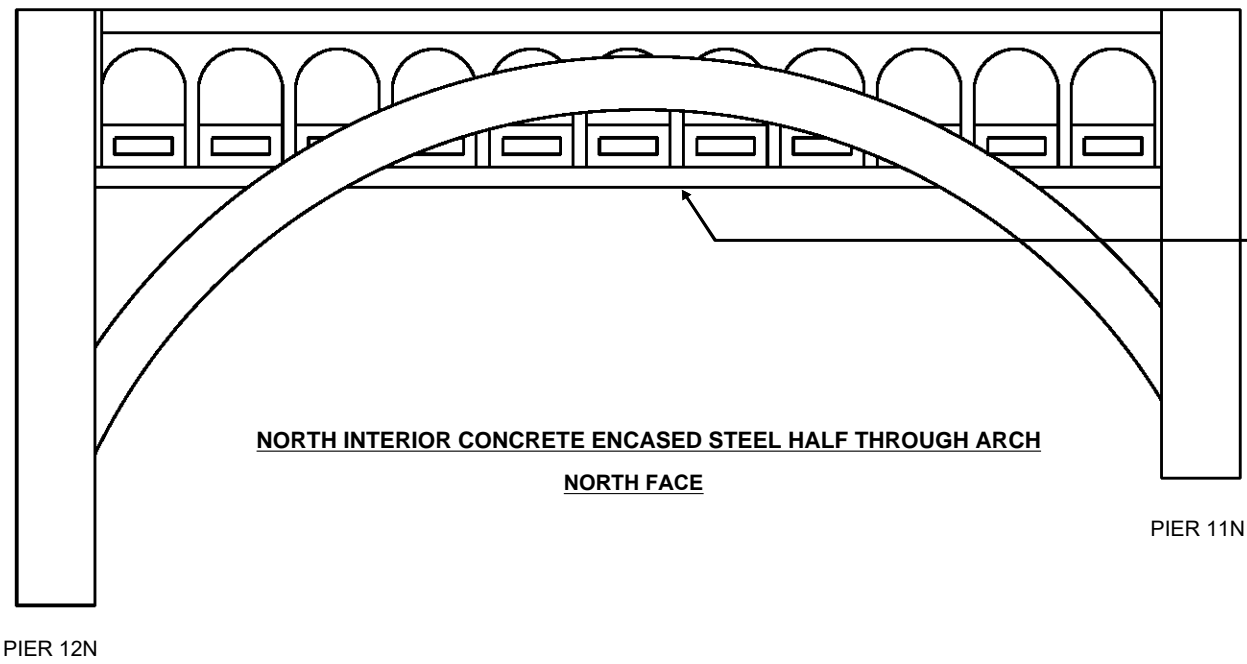


Lower deck floor beam 6 appears to be delaminated along the full length

General Notes:

- Lower deck floorbeams have numerous areas that have been chipped off and painted. Numerous areas are cracked and marked but have not been chipped away.


| | | | | |
|--------------------------------|-----------|--|--|-------------------------------|
| GRAPHIC SCALE MEASURED IN FEET | DATE |  9902 Carver Road
Suite 201
Cincinnati, OH 45242
PH.: 614.699.5000 | DETROIT-SUPERIOR BRIDGE OVER CUYAHOGA RIVER
BRIDGE NO. CUY-6-1465 | |
| NOT TO SCALE | NOV, 2018 | | INFRASTRUCTURE ENGINEERS, INC. | STRUCTURE ELEVATION - SPAN 12 |

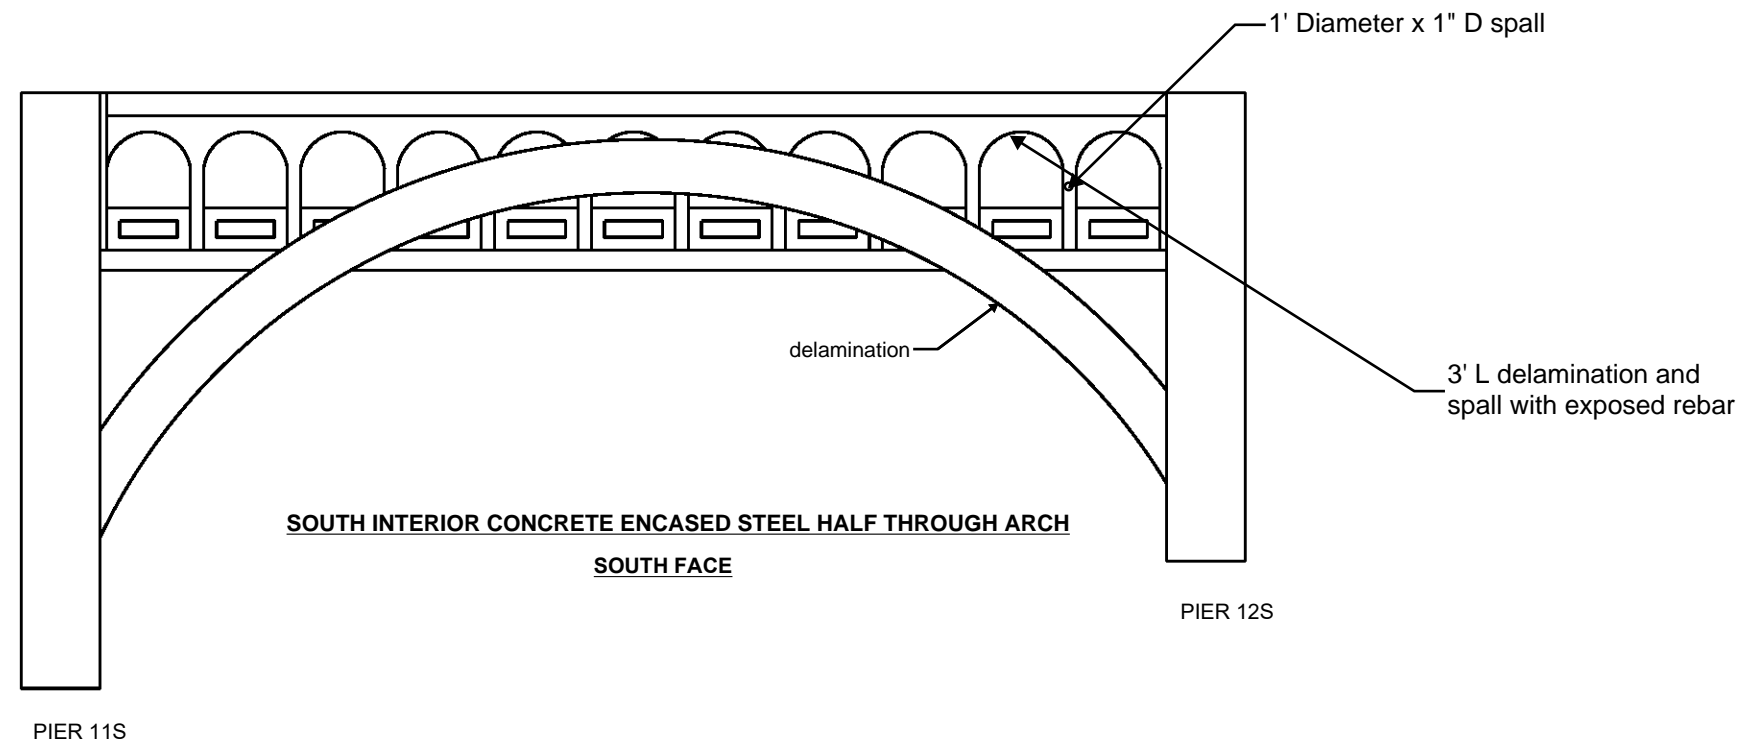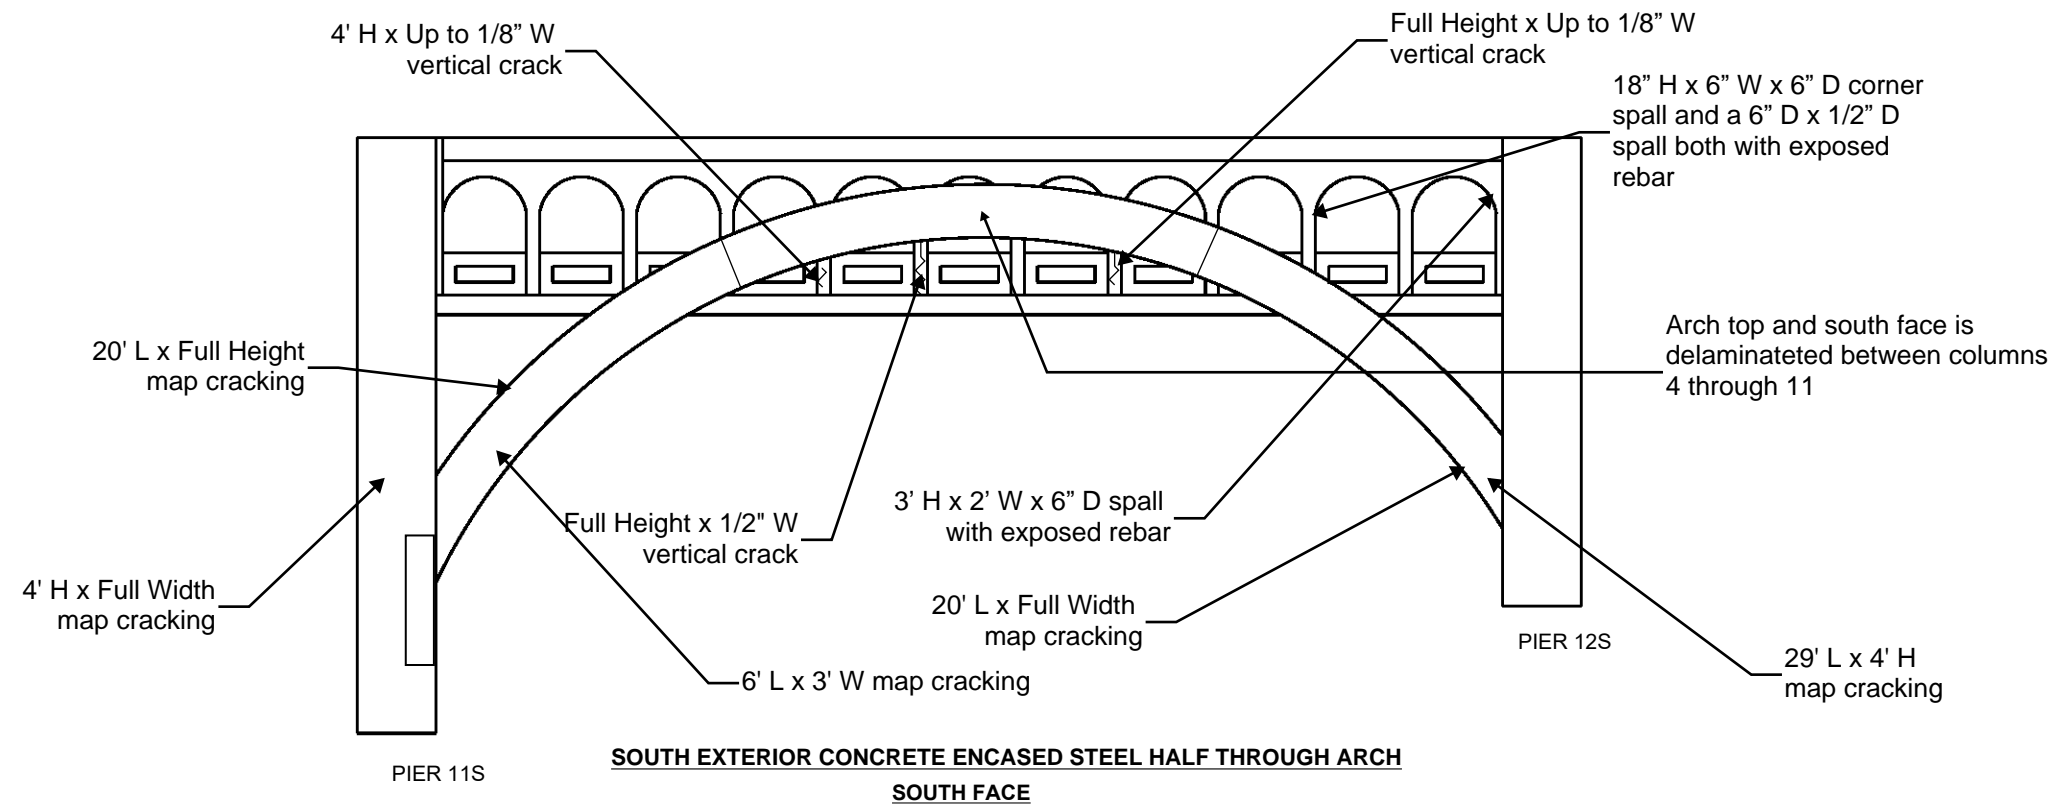


General Notes:

- Lower deck floorbeams have numerous areas that have been chipped off and painted. Numerous areas are cracked and marked but have not been chipped away.

| | | | |
|--------------------------------|-----------|--|--|
| GRAPHIC SCALE MEASURED IN FEET | DATE |
<small>9902 Carver Road
Suite 201
Cincinnati, OH 45242
PH.: 614.699.5000</small> | DETROIT-SUPERIOR BRIDGE OVER CUYAHOGA RIVER
BRIDGE NO. CUY-6-1465 |
| NOT TO SCALE | NOV, 2018 | | INFRASTRUCTURE
ENGINEERS, INC. |
| | | | PAGE
A-106 |

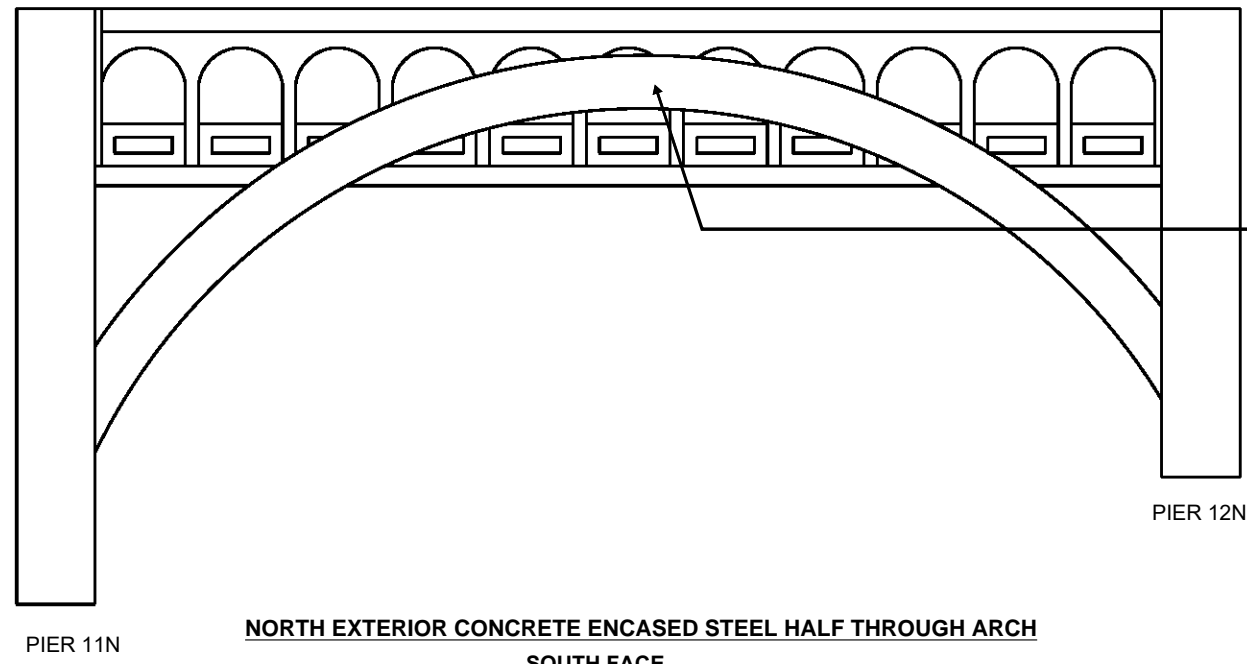

South face of the arch is delaminated with widespread cracking near the bases. 1/2" W crack in the delaminated surface.


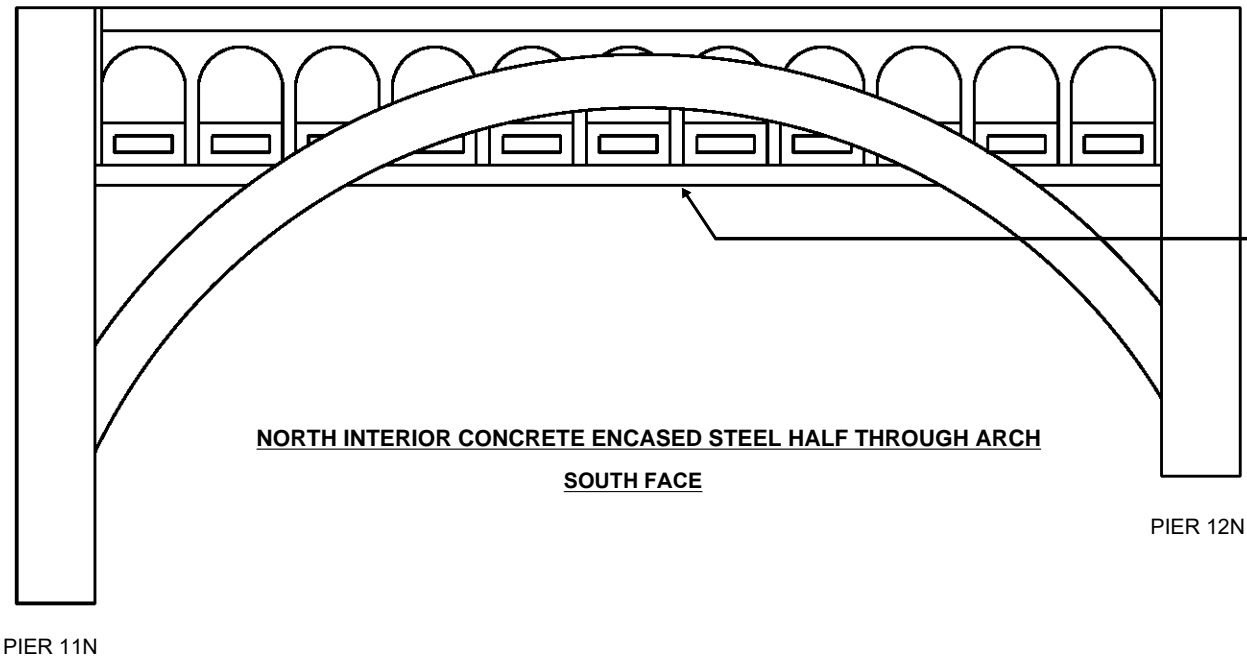


Lower deck floor beam 6 appears to be delaminated along the full length

General Notes:

- Lower deck floorbeams have numerous areas that have been chipped off and painted. Numerous areas are cracked and marked but have not been chipped away.


| | | | | |
|--------------------------------|-----------|--|--|-------------------------------|
| GRAPHIC SCALE MEASURED IN FEET | DATE |  9902 Carver Road
Suite 201
Cincinnati, OH 45242
PH.: 614.699.5000 | DETROIT-SUPERIOR BRIDGE OVER CUYAHOGA RIVER
BRIDGE NO. CUY-6-1465 | |
| NOT TO SCALE | NOV, 2018 | | INFRASTRUCTURE ENGINEERS, INC. | STRUCTURE ELEVATION - SPAN 12 |

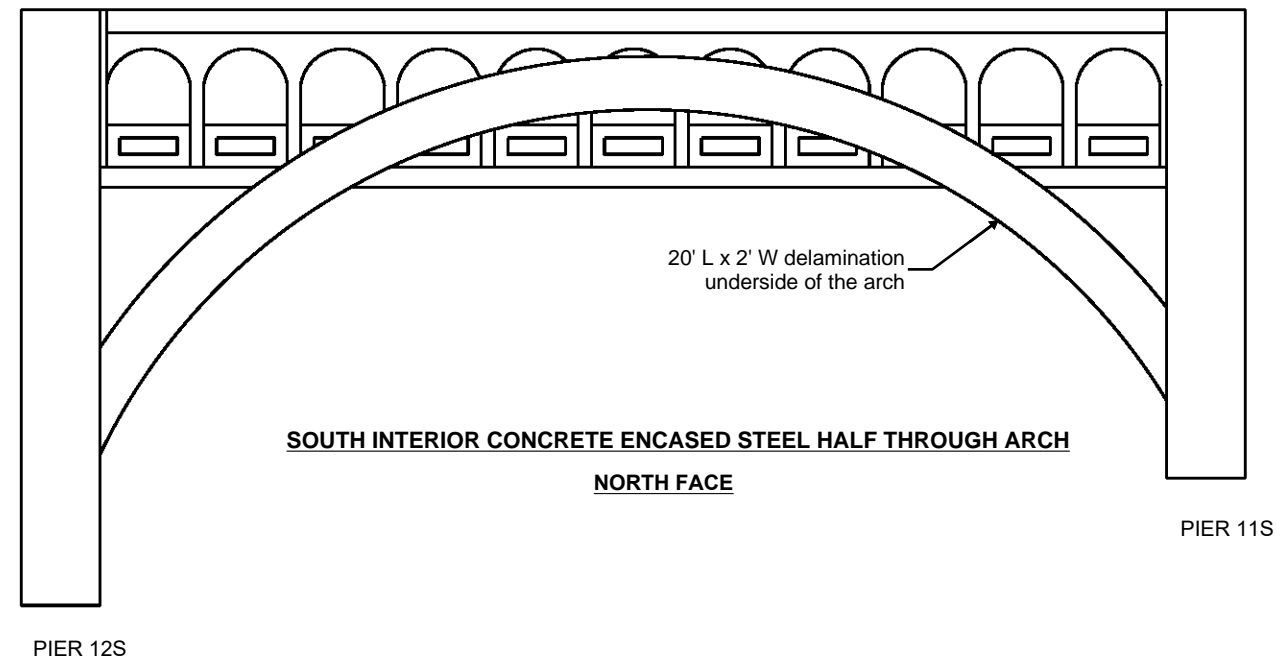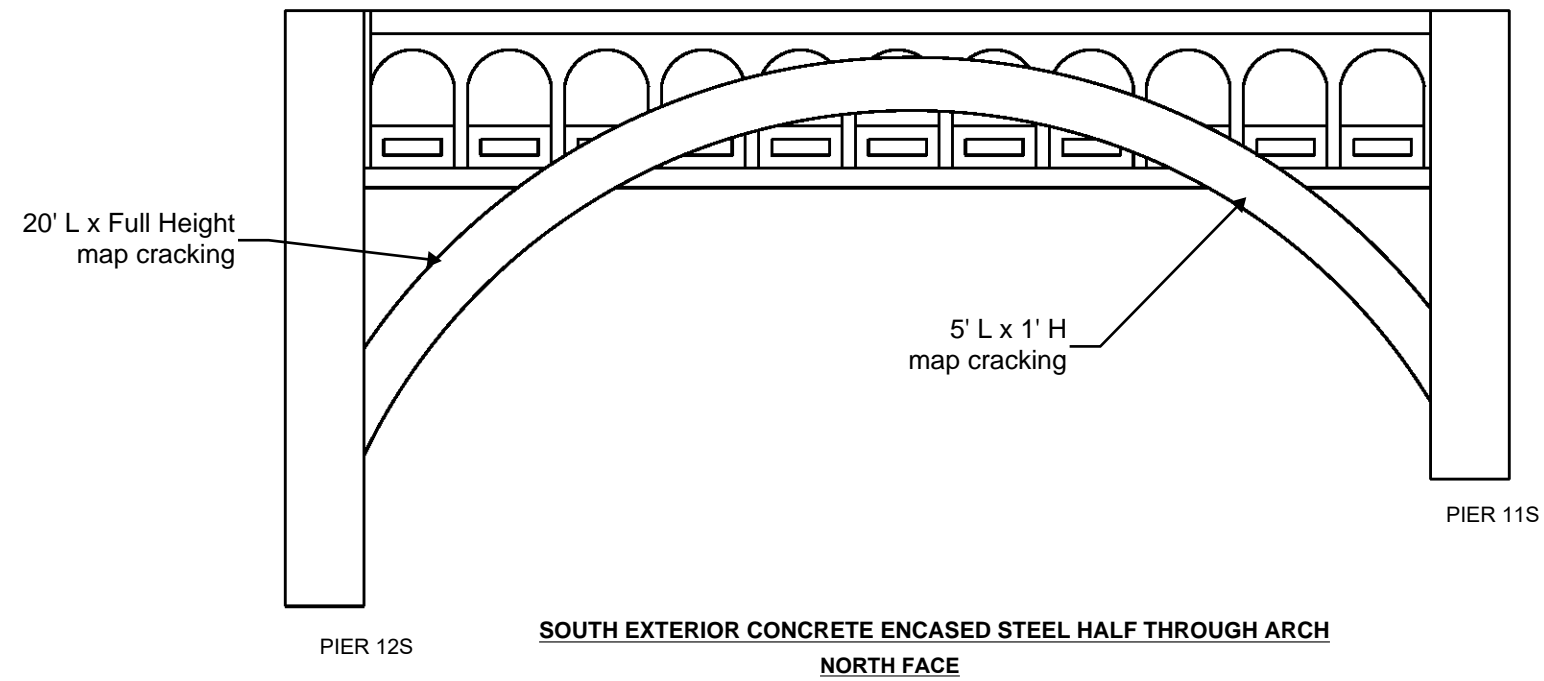


General Notes:

- Lower deck floorbeams have numerous areas that have been chipped off and painted. Numerous areas are cracked and marked but have not been chipped away.

| | | | | |
|--------------------------------|-----------|--|--|-------------------------------|
| GRAPHIC SCALE MEASURED IN FEET | DATE |  9902 Carver Road
Suite 201
Cincinnati, OH 45242
PH.: 614.699.5000 | DETROIT-SUPERIOR BRIDGE OVER CUYAHOGA RIVER
BRIDGE NO. CUY-6-1465 | |
| NOT TO SCALE | NOV, 2018 | | INFRASTRUCTURE ENGINEERS, INC. | STRUCTURE ELEVATION - SPAN 12 |

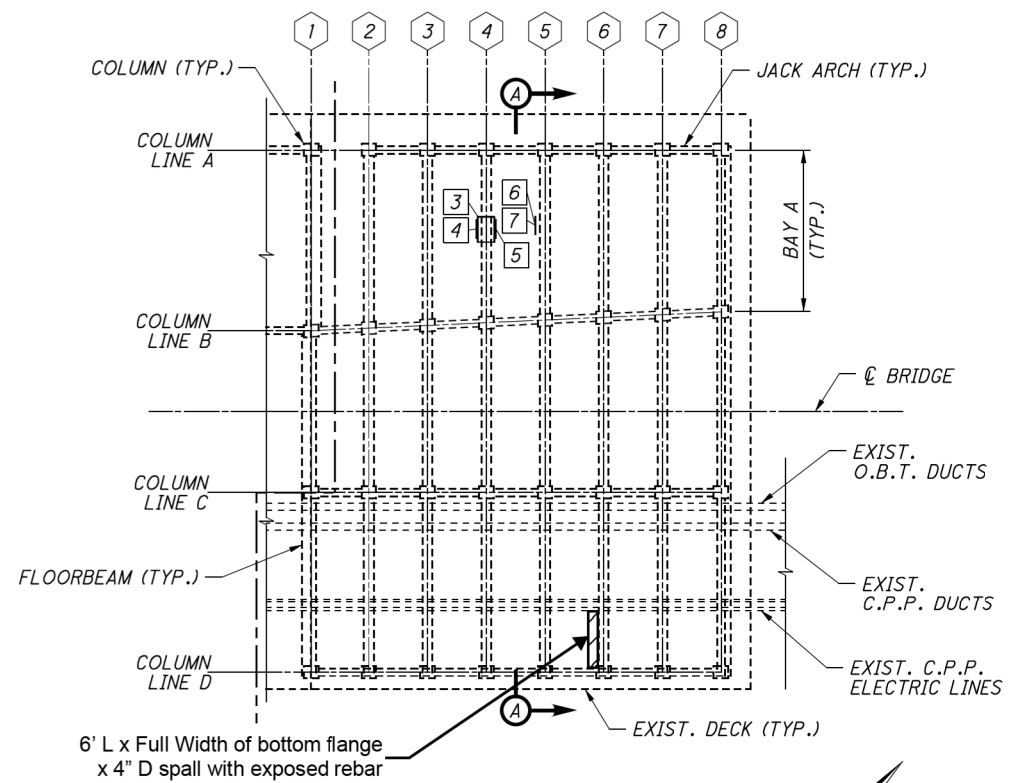

SPAN 13 - UPPER DECK PLAN

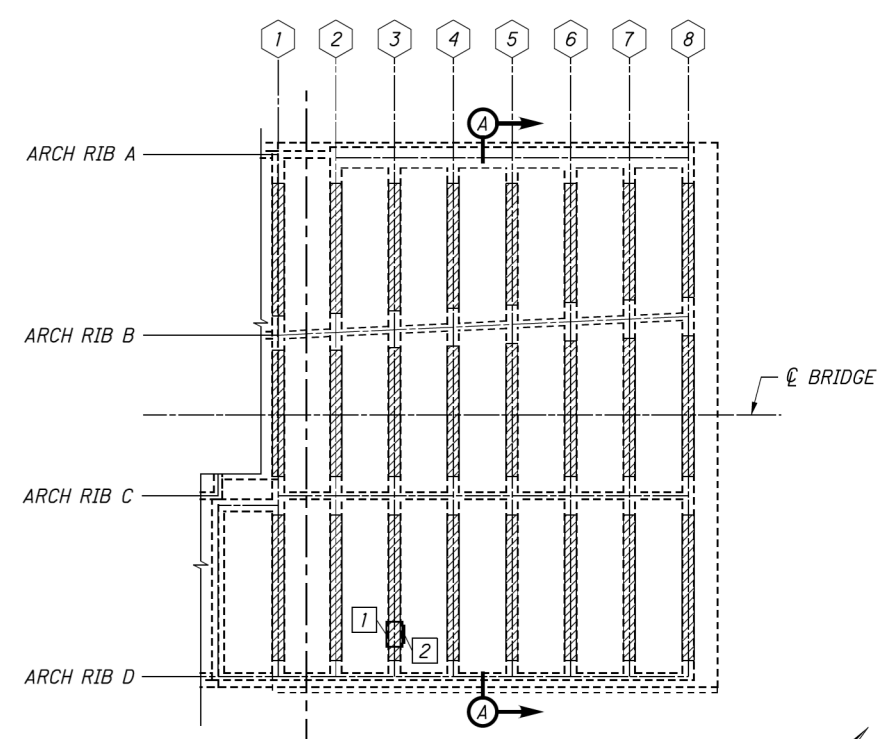

SPAN 13 - LOWER DECK PLAN

| ESTIMATED PATCHING QUANTITIES | | | |
|-------------------------------|-------------|-----------|------------------|
| REPAIR NO. | REPAIR TYPE | AREA (SF) | ANODE QUANTITY** |
| 1 | TYPE 2 | 10 | 6 |
| 2 | TYPE 1 | 6 | 3 |
| 3 | TYPE 2 | 4 | 4 |
| 4 | TYPE 1 | 4 | 1 |
| 5 | TYPE 1 | 2 | 1 |
| 6 | TYPE 1 | 4 | 1 |
| 7 | TYPE 1 | 10 | 3 |
| MEASURED QUANTITY* | | 40 | - |
| PLAN QUANTITY* | | 60 | 19 |

* SEE NOTES 1 & 2
 ** SEE NOTE 3

| SHEET QUANTITY SUMMARY | | |
|------------------------|------|----------|
| ITEM | UNIT | QUANTITY |
| TYPE 1 REPAIR | SF | 39 |
| TYPE 2 REPAIR | SF | 21 |
| FRP WRAP | SF | 2738 |







NOTES:

- MEASURED QUANTITIES ARE BASED ON THE VISUAL INSPECTION PERFORMED IN NOVEMBER 2017. THE EXACT DIMENSIONS AND LOCATIONS OF PATCHES SHALL BE DETERMINED BY THE ENGINEER IN THE FIELD FOR FINAL PAY QUANTITY.
- PLAN QUANTITIES INCLUDE 50% CONTINGENCY ADDED TO MEASURED QUANTITIES.
- ANODES ARE INCLUDED FOR PAYMENT WITH ITEM SPECIAL - PATCHING CONCRETE STRUCTURE, TYPE 1 OR TYPE 2 REPAIR.
- FOR DETAILS AND MAXIMUM GRID SPACING FOR EMBEDDED GALVANIC ANODES, SEE SHEET [84/89].
- FOR SECTION A-A, SEE SHEET [34/89].
- FOR FRP WRAP DETAILS, SEE SHEET [85/89].

LEGEND:

- # FLOORBEAM LINE NUMBER
- # REPAIR NO. OF DEFICIENT CONCRETE TO BE REPAIRED IN ACCORDANCE WITH ITEM SPECIAL - PATCHING CONCRETE STRUCTURE, TYPE 1 OR TYPE 2 REPAIR.
- ▨ AREA TO BE TREATED WITH FRP WRAP PER ITEM SPECIAL - COMPOSITE FIBER WRAP SYSTEM

| | | | |
|--------------------------------|-----------|--|--|
| GRAPHIC SCALE MEASURED IN FEET | DATE | 9902 Carver Road
Suite 201
Cincinnati, OH 45242
PH.: 614.699.5000 | DETROIT-SUPERIOR BRIDGE OVER CUYAHOGA RIVER
BRIDGE NO. CUY-6-1465 |
| NOT TO SCALE | NOV, 2018 | INFRASTRUCTURE ENGINEERS, INC. | SPAN 13 CONCRETE DETAILS |
| | | | PAGE
A-109 |

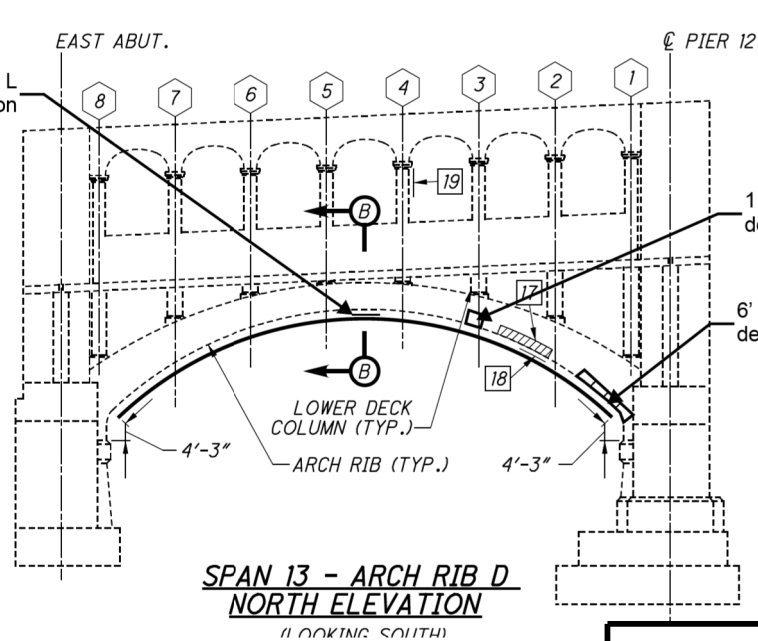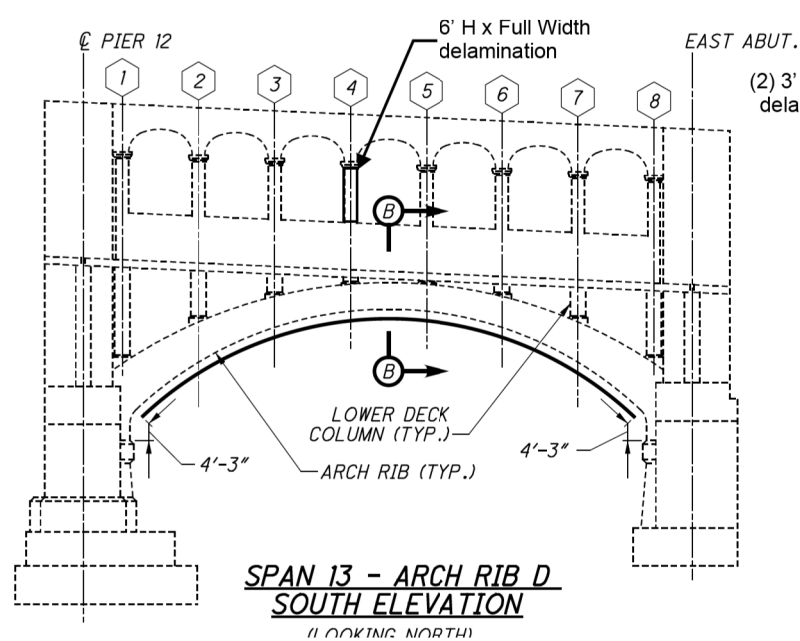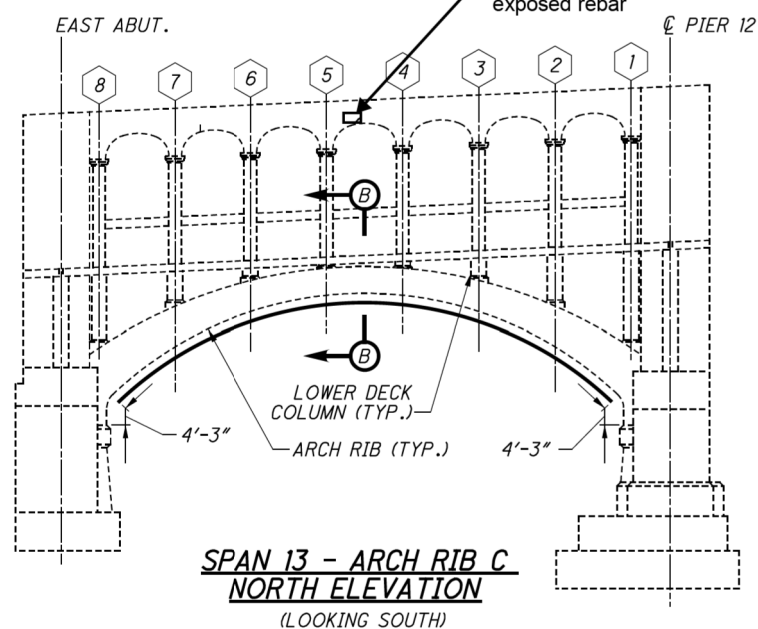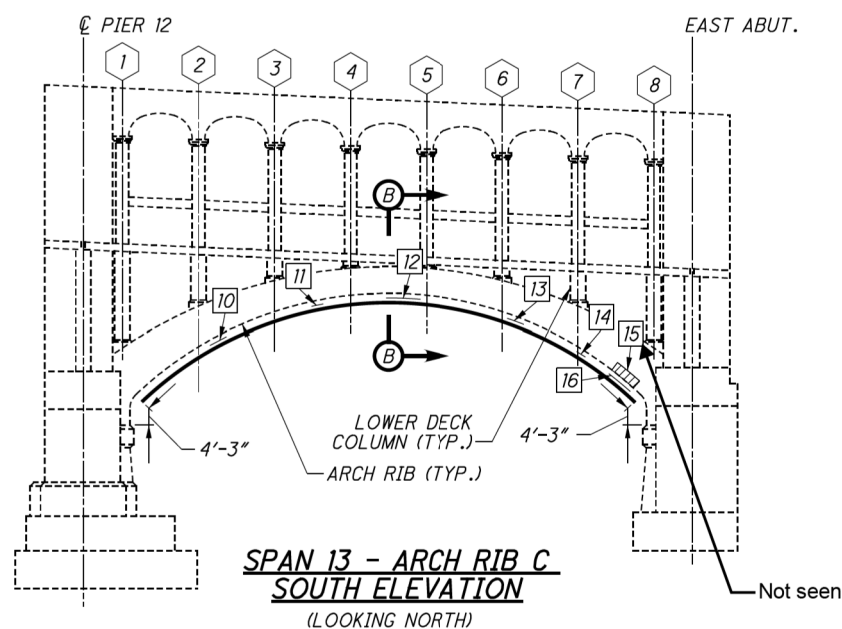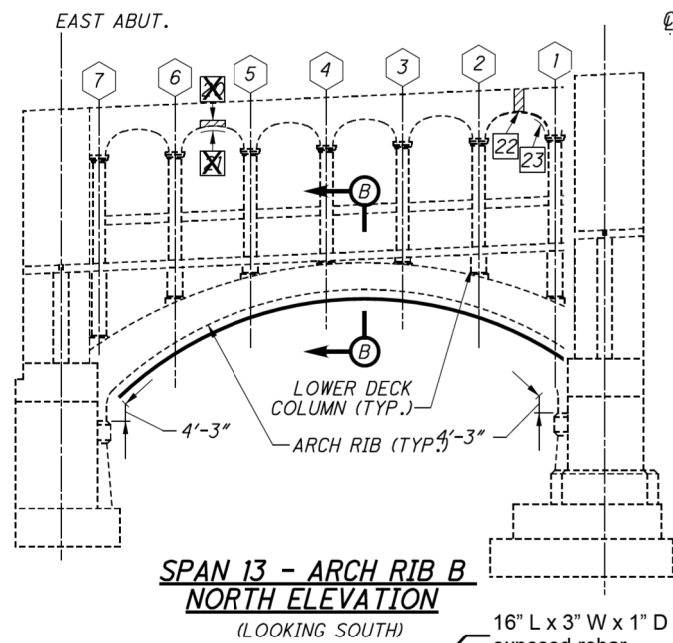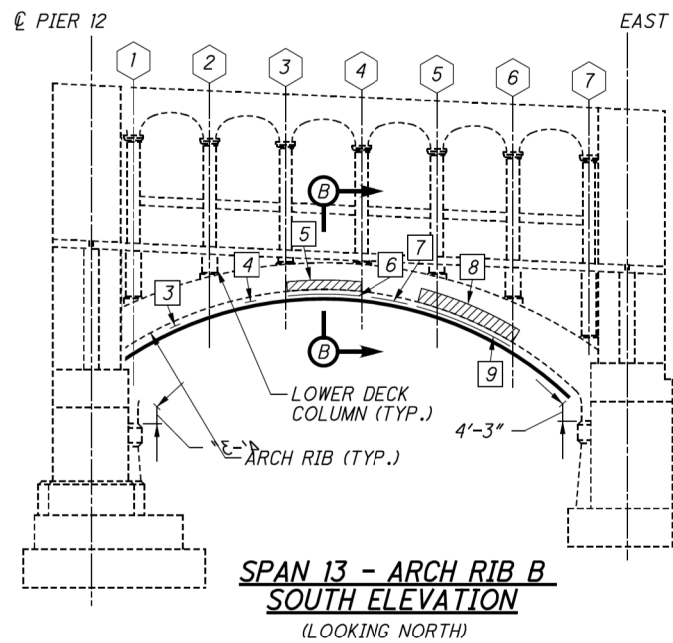

| ESTIMATED PATCHING QUANTITIES | | | |
|-------------------------------|-------------|-----------|------------------|
| REPAIR NO. | REPAIR TYPE | AREA (SF) | ANODE QUANTITY** |
| 1 | TYPE 2 | 1 | 1 |
| 2 | TYPE 2 | 1 | 1 |
| 3 | TYPE 2 | 1 | 1 |
| 4 | TYPE 2 | 1 | 1 |
| 5 | TYPE 1 | 10 | - |
| 6 | TYPE 2 | 40 | 16 |
| 7 | TYPE 2 | 15 | 8 |
| 8 | TYPE 1 | 23 | - |
| 9 | TYPE 2 | 75 | 26 |
| 10 | TYPE 2 | 4 | 1 |
| 11 | TYPE 2 | 1 | 1 |
| 12 | TYPE 2 | 24 | 10 |
| 13 | TYPE 2 | 2 | 1 |
| 14 | TYPE 2 | 1 | 1 |
| 15 | TYPE 1 | 3 | - |
| 16 | TYPE 2 | 3 | 2 |
| 17 | TYPE 1 | 6 | - |
| 18 | TYPE 2 | 5 | 2 |
| 19 | TYPE 1 | 3 | 2 |
| 20 | TYPE 1 | 3 | 2 |
| 21 | TYPE 2 | 4 | 3 |
| 22 | TYPE 1 | 4 | 2 |
| 23 | TYPE 2 | 1 | 1 |
| MEASURED QUANTITY* | | 231 | - |
| PLAN QUANTITY* | | 347 | 82 |

| SHEET QUANTITY SUMMARY | | |
|------------------------|------|----------|
| ITEM | UNIT | QUANTITY |
| TYPE 1 REPAIR | SF | 78 |
| TYPE 2 REPAIR | SF | 269 |
| FRP WRAP | SF | 2491 |

* SEE NOTES 1 & 2
** SEE NOTES 3 & 4

NOTES:


- MEASURED QUANTITIES ARE BASED ON THE VISUAL INSPECTION PERFORMED IN NOVEMBER 2017. THE EXACT DIMENSIONS AND LOCATIONS OF PATCHES SHALL BE DETERMINED BY THE ENGINEER IN THE FIELD FOR FINAL PAY QUANTITY.
- PLAN QUANTITIES INCLUDE 50% CONTINGENCY ADDED TO MEASURED QUANTITIES.
- ANODES ARE INCLUDED FOR PAYMENT WITH ITEM SPECIAL - PATCHING CONCRETE STRUCTURE, TYPE 1 OR TYPE 2 REPAIR.
- GALVANIC ANODES WILL NOT BE USED FOR PATCHING THE UNREINFORCED VERTICAL SIDES OF THE CONCRETE ARCH RIBS.
- FOR DETAILS AND MAXIMUM GRID SPACING FOR EMBEDDED GALVANIC ANODES, SEE SHEET 84/89.
- FOR FRP WRAP DETAILS AND SECTION B-B, SEE SHEET 85/89.

LEGEND:


- # SPANDREL COLUMN NUMBER
- # REPAIR NUMBER
- ▨ LOCATION OF DEFICIENT CONCRETE TO BE REPAIRED IN ACCORDANCE WITH ITEM SPECIAL - PATCHING CONCRETE STRUCTURE, TYPE 1 REPAIR
- ⋮ LOCATION OF DEFICIENT CONCRETE ON PERPENDICULAR FACE (NOT VISIBLE IN ELEVATION VIEW) TO BE REPAIRED IN ACCORDANCE WITH ITEM SPECIAL - PATCHING CONCRETE STRUCTURE, TYPE 1 OR TYPE 2 REPAIR
- AREA TO BE TREATED WITH FRP WRAP PER ITEM SPECIAL - COMPOSITE FIBER WRAP SYSTEM

| | | | | |
|--|-----------|--|--|-------|
| GRAPHIC SCALE MEASURED IN FEET


NOT TO SCALE | DATE | 9902 Carver Road
Suite 201
Cincinnati, OH 45242
PH.: 614.699.5000
INFRASTRUCTURE ENGINEERS, INC. | DETROIT-SUPERIOR BRIDGE OVER CUYAHOGA RIVER
BRIDGE NO. CUY-6-1465 | |
| | NOV, 2018 | | SPAN 13 CONCRETE REPAIR DETAILS | |
| | | | PAGE | A-110 |

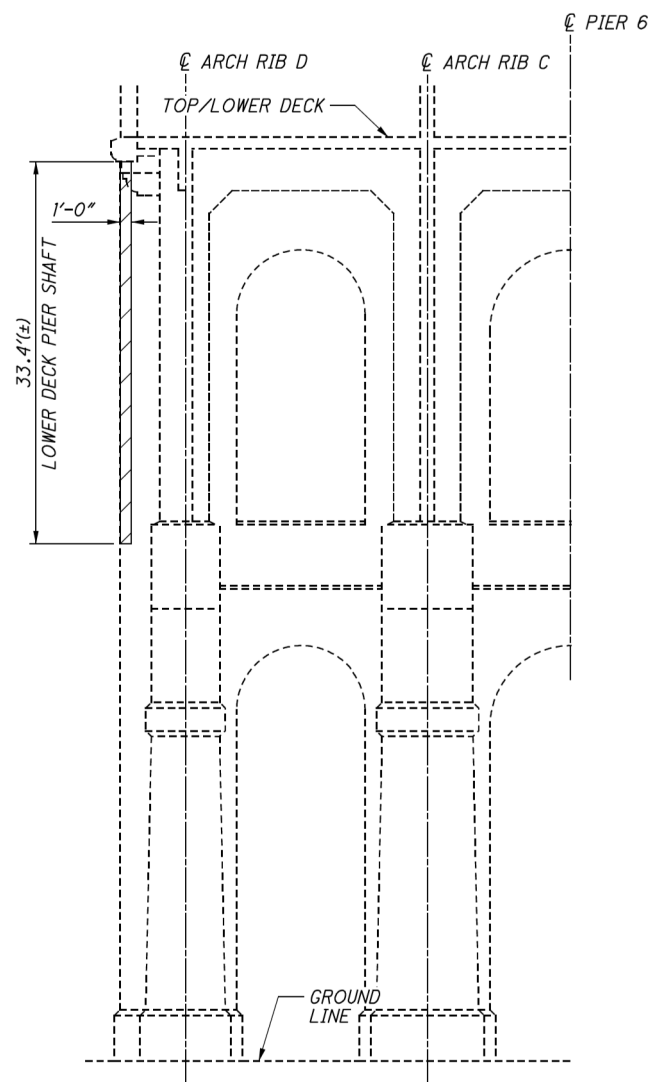


PIER 6 - EAST ELEVATION
SHOWING LIMITS OF REMOVAL

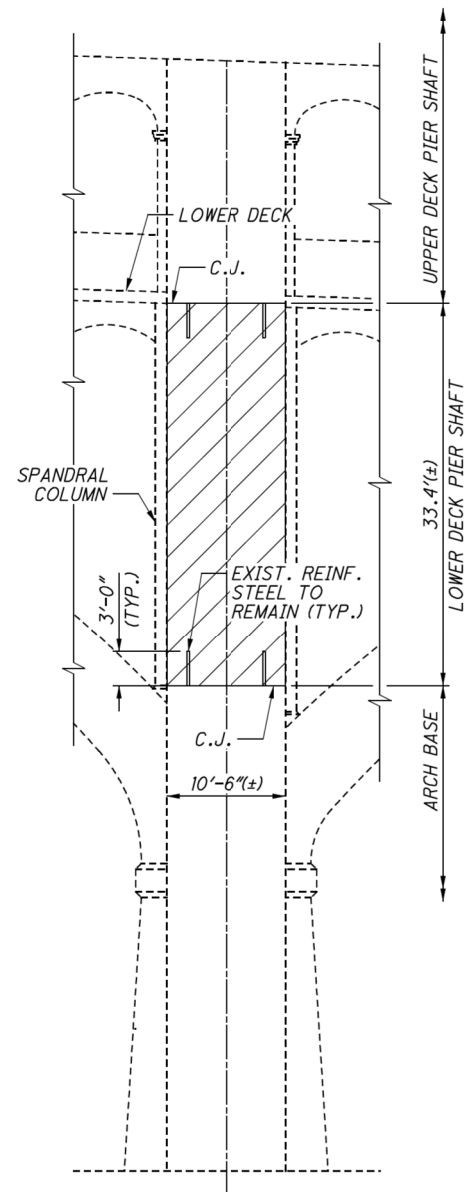

PIER 6 - SOUTH ELEVATION
SHOWING LIMITS OF REMOVAL

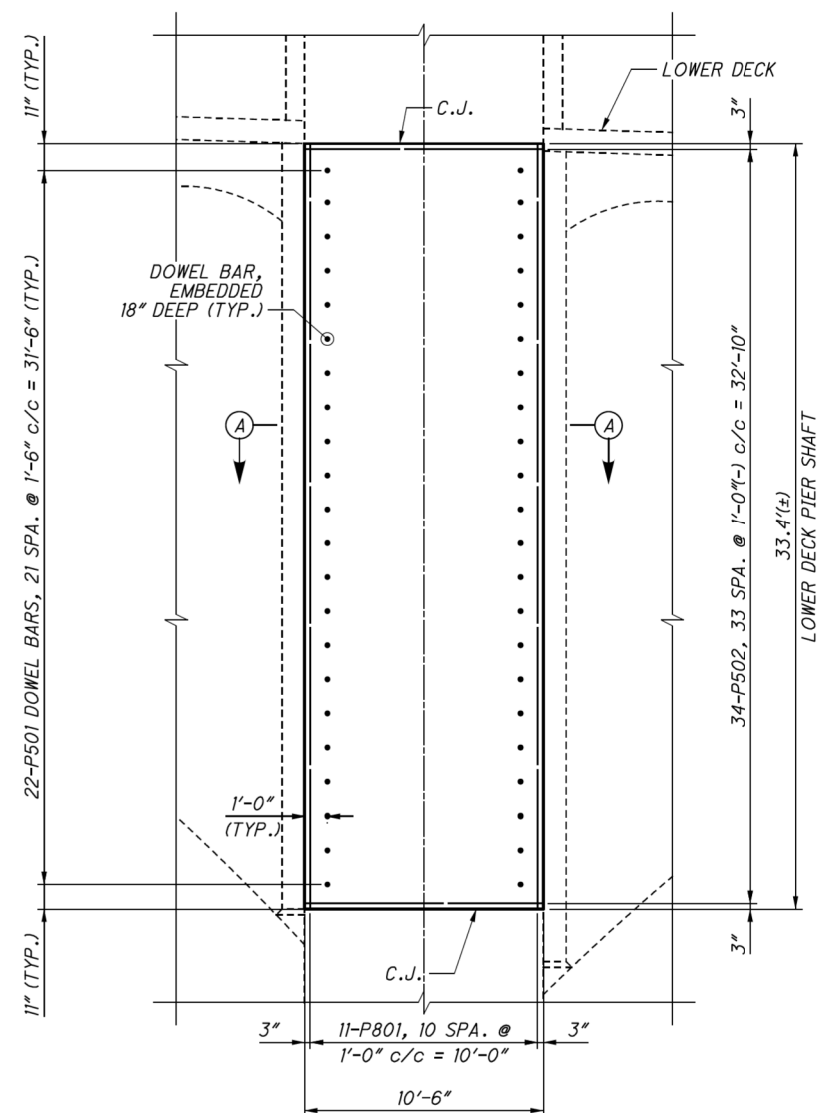

PARTIAL REPLACEMENT
LOWER DECK SHAFT ELEVATION

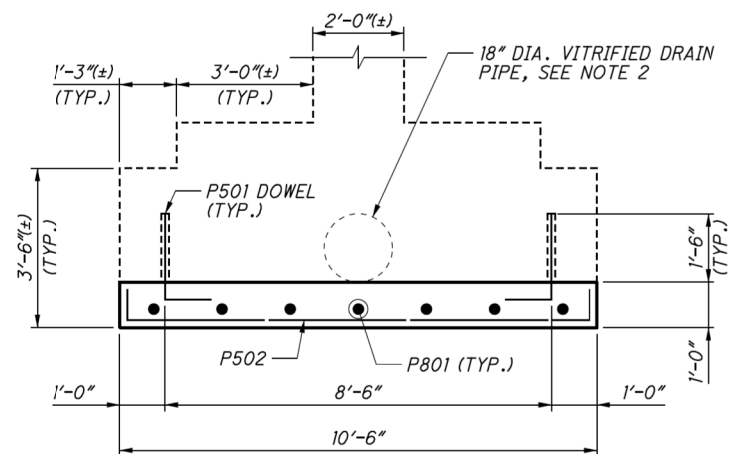

SECTION A-A

LEGEND:

 LOCATION OF DEFICIENT CONCRETE TO BE REPAIRED IN ACCORDANCE WITH ITEM 511 - CONCRETE, MISC.: PIER 6 LOWER DECK SHAFT REPAIR

NOTES:

1. THE DEPTH OF CONCRETE REMOVAL SHALL NOT BE GREATER THAN 12 INCHES.
2. THE ASSUMED POSITION OF THE ORIGINAL ENCASED 18" DIAMETER DRAIN PIPE IS SHOWN. IF THE DRAIN PIPE IS EXPOSED DURING REMOVAL OF DETERIORATED CONCRETE, THE EXISTING PIPE SHALL BE REMOVED. ANY DETERIORATED CONCRETE SURROUNDING THE PIPE BEYOND THE 12" REMOVAL SHALL REMAIN IN PLACE.
3. EMBEDDED GALVANIC ANODES ARE NOT SHOWN FOR CLARITY. FOR DETAILS AND MAXIMUM GRID SPACING FOR EMBEDDED GALVANIC ANODES, SEE SHEET 84/89.

| | | | | |
|--------------------------------|-----------|--|--|---------------------------------|
| GRAPHIC SCALE MEASURED IN FEET | DATE |  9902 Carver Road
Suite 201
Cincinnati, OH 45242
PH.: 614.699.5000 | DETROIT-SUPERIOR BRIDGE OVER CUYAHOGA RIVER
BRIDGE NO. CUY-6-1465 | |
| NOT TO SCALE | NOV, 2018 | | INFRASTRUCTURE ENGINEERS, INC. | PIER 6 LOWER DECK SHAFT REPAIRS |

PHYSICAL CONDITION REPORT


Bridge Number: CUY-6-1456
SFN: 1800930
Inspection Date: October 22-26, 2018

WEST AND EAST ABUTMENT CHAMBER CADD DRAWINGS AND DEFICIENCIES




Infrastructure Engineers, LLC.
9902 Carver Rd.
Suite 201
Cincinnati, OH 45242


www.consoreng.com

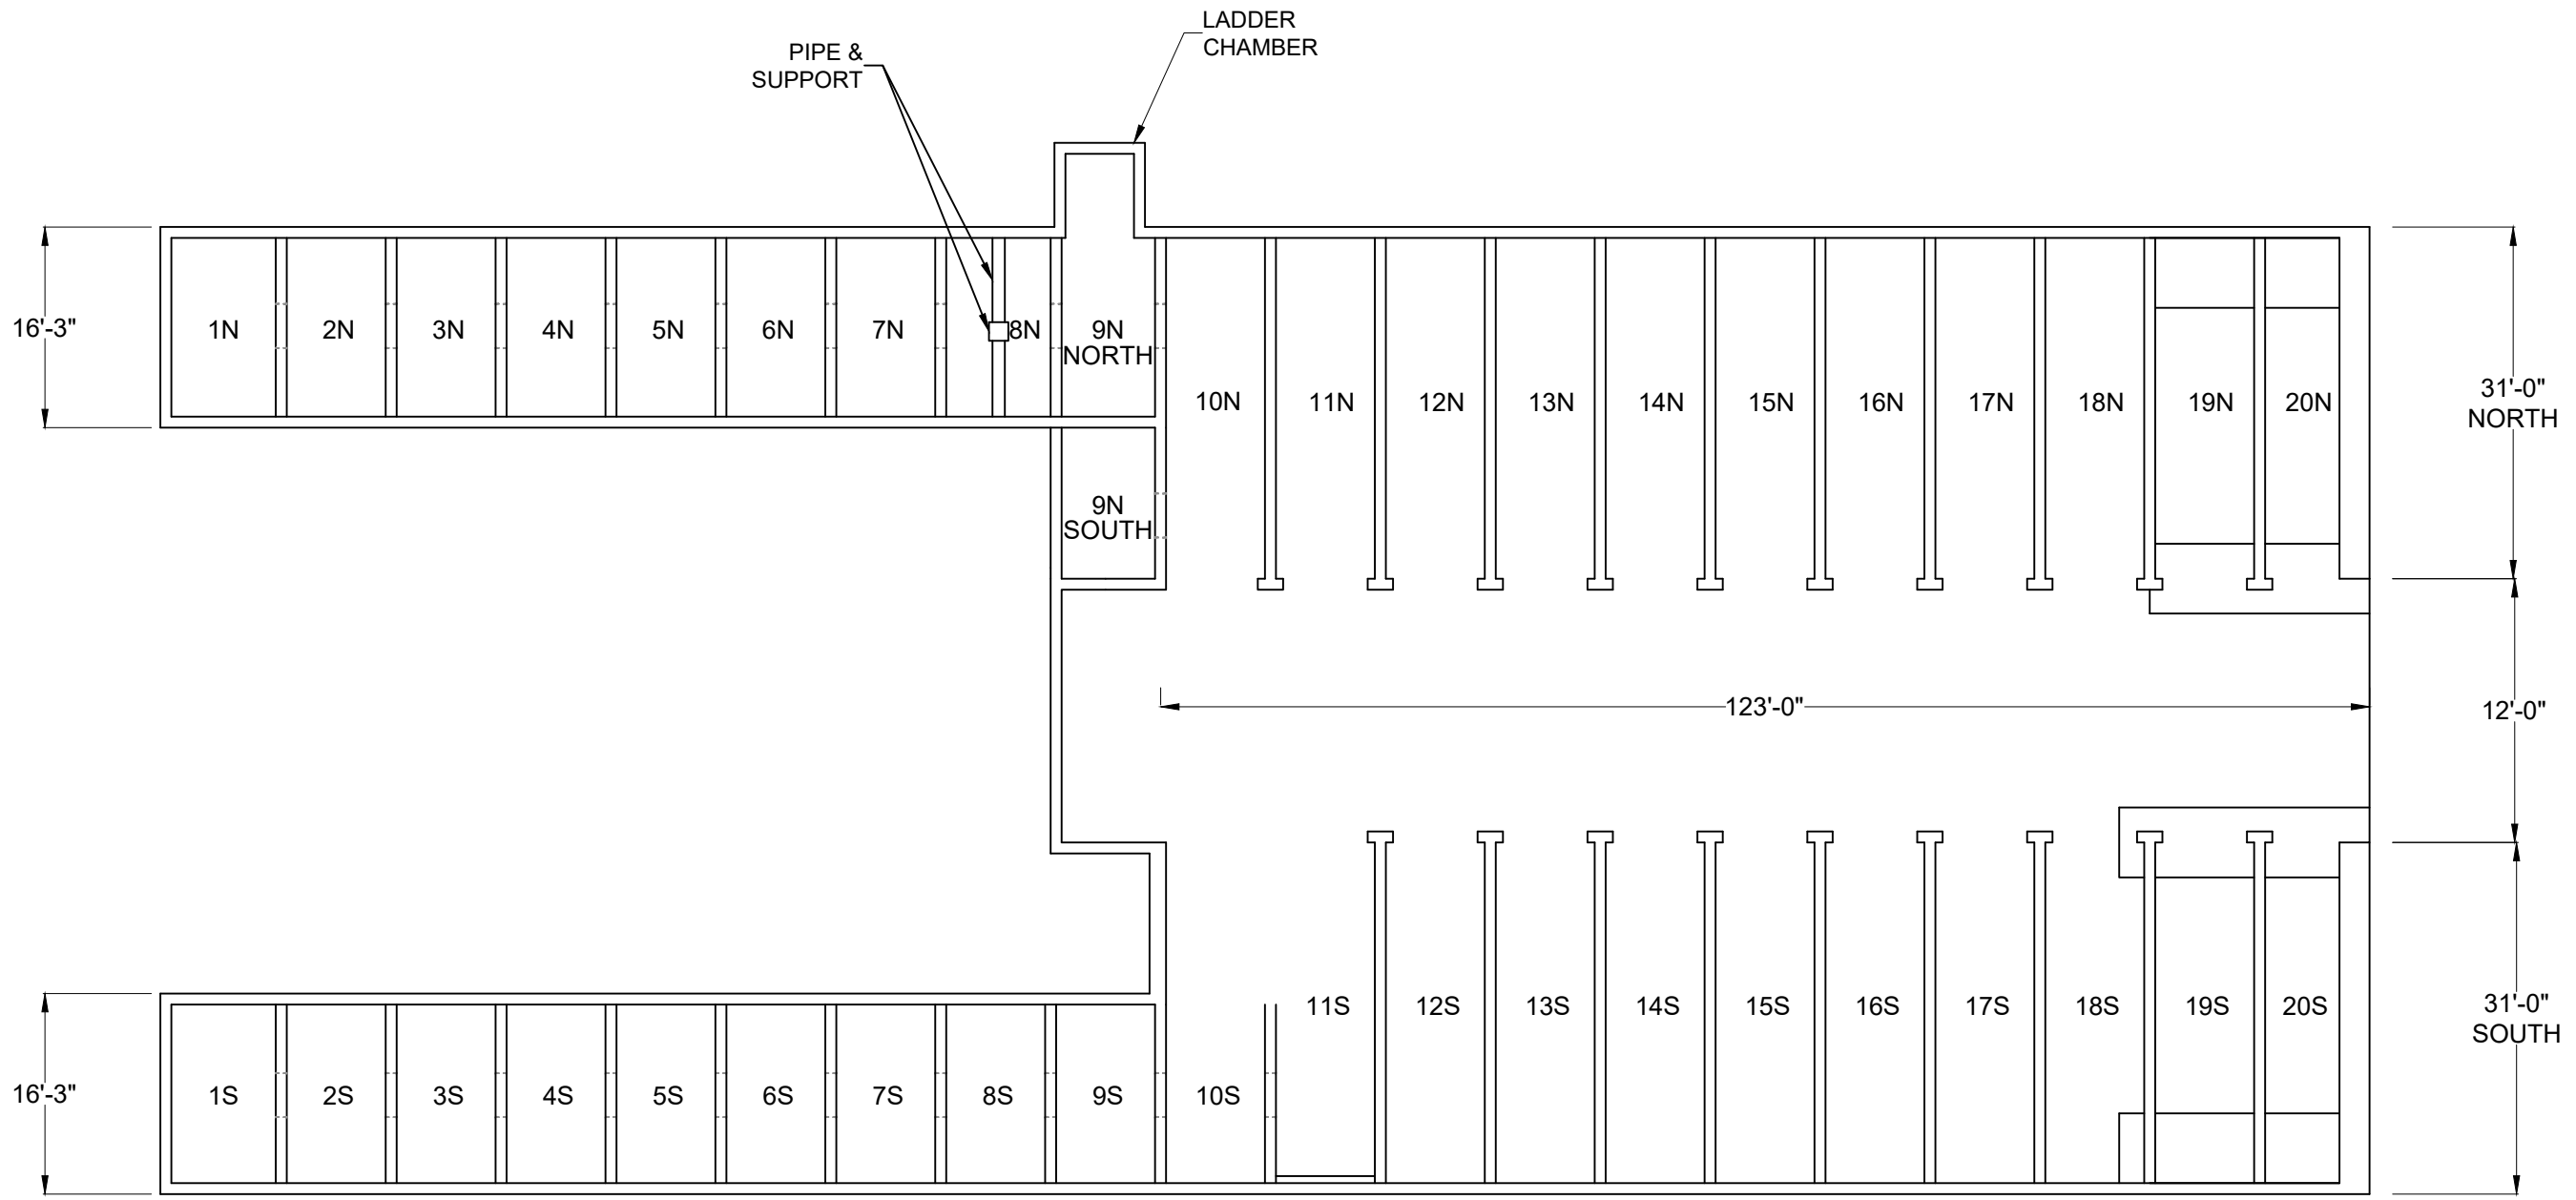

WEST ABUTMENT PLAN


- Notes:**
1. All Dimensions are Field Measurements.
 2. Waterline Reference for soundings is the Top of Angled Nose on the Upstream side of Pier 5 (Top of Nose to Waterline = 11.2')
 3. Stream slope is < 1%.

| | | | | |
|--------|-----------|--|---|--------------|
| SCALE: | DATE: | 
INFRASTRUCTURE
ENGINEERS, INC. | Detroit-Superior Bridge
Structure No. CUY-6-1456 | |
| N.T.S | OCT, 2018 | | West Abutment Plan | PAGE:
A-1 |

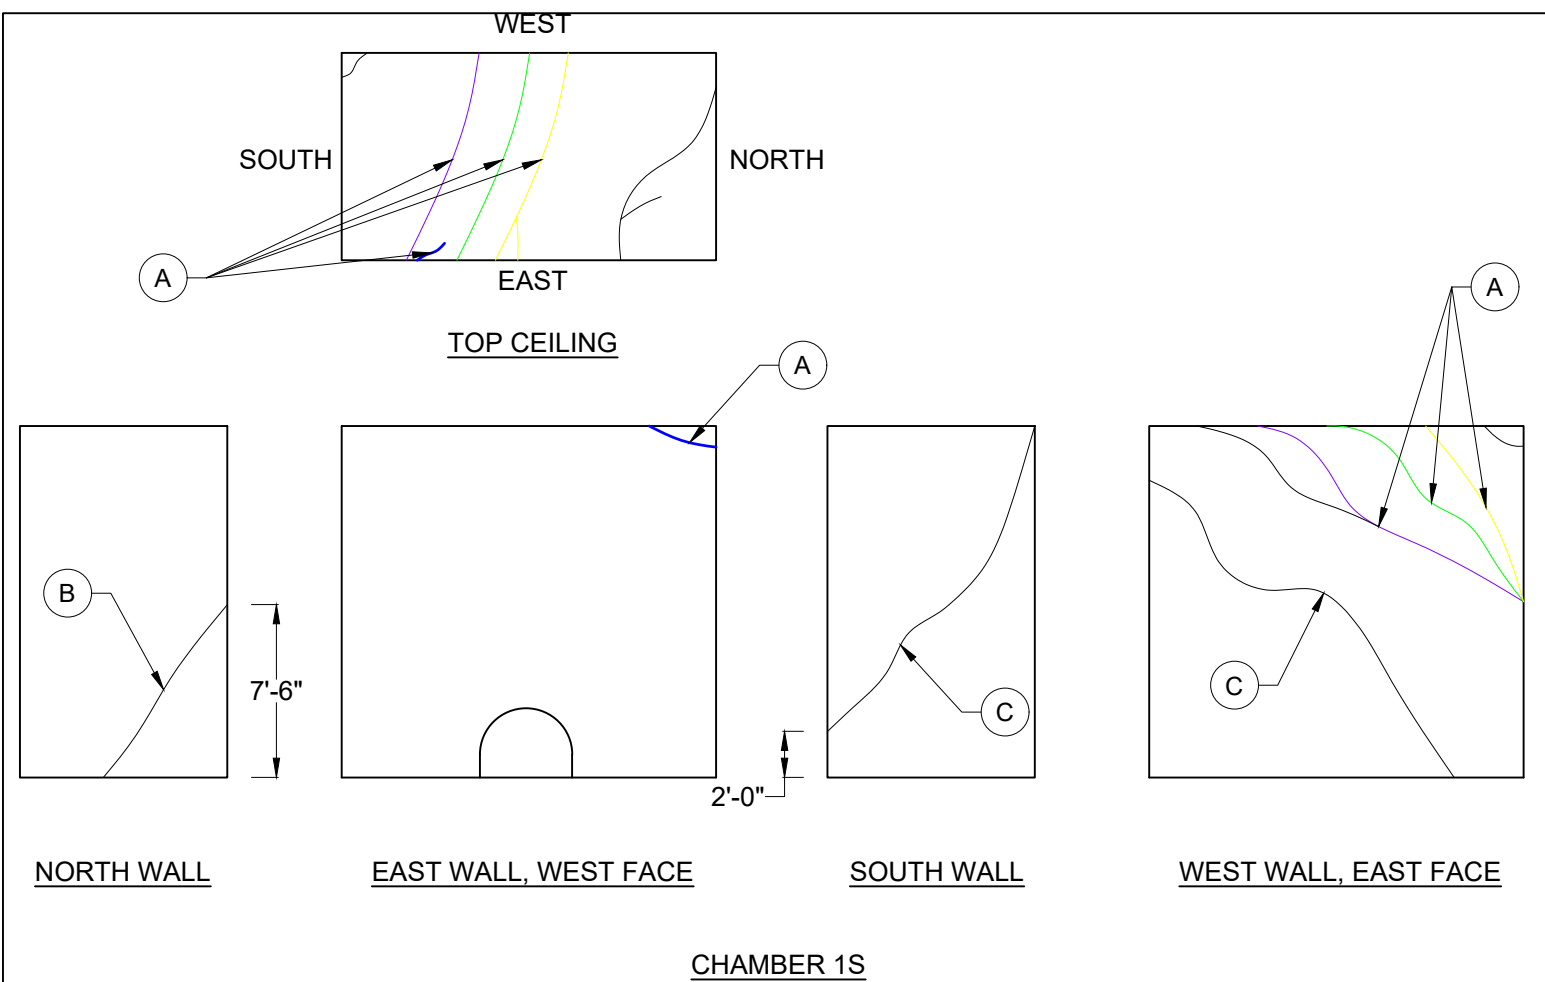


| CHAMBER 1S DEFECT TABLE | | |
|-------------------------|---|------------------|
| CALL OUT # | DEFECT DESCRIPTION | PHOTO # |
| A | Cracks with heav effloresence and moisture staining extending to the East and West walls. | DWN084 to DWN 86 |
| B | Hairline crack | |
| C | 1/32" W Crack | |


- Notes:**
1. All Dimensions are Field Measurements.
 2. Waterline Reference for soundings is the Top of Angled Nose on the Upstream side of Pier 5 (Top of Nose to Waterline = 11.2')
 3. Stream slope is < 1%.

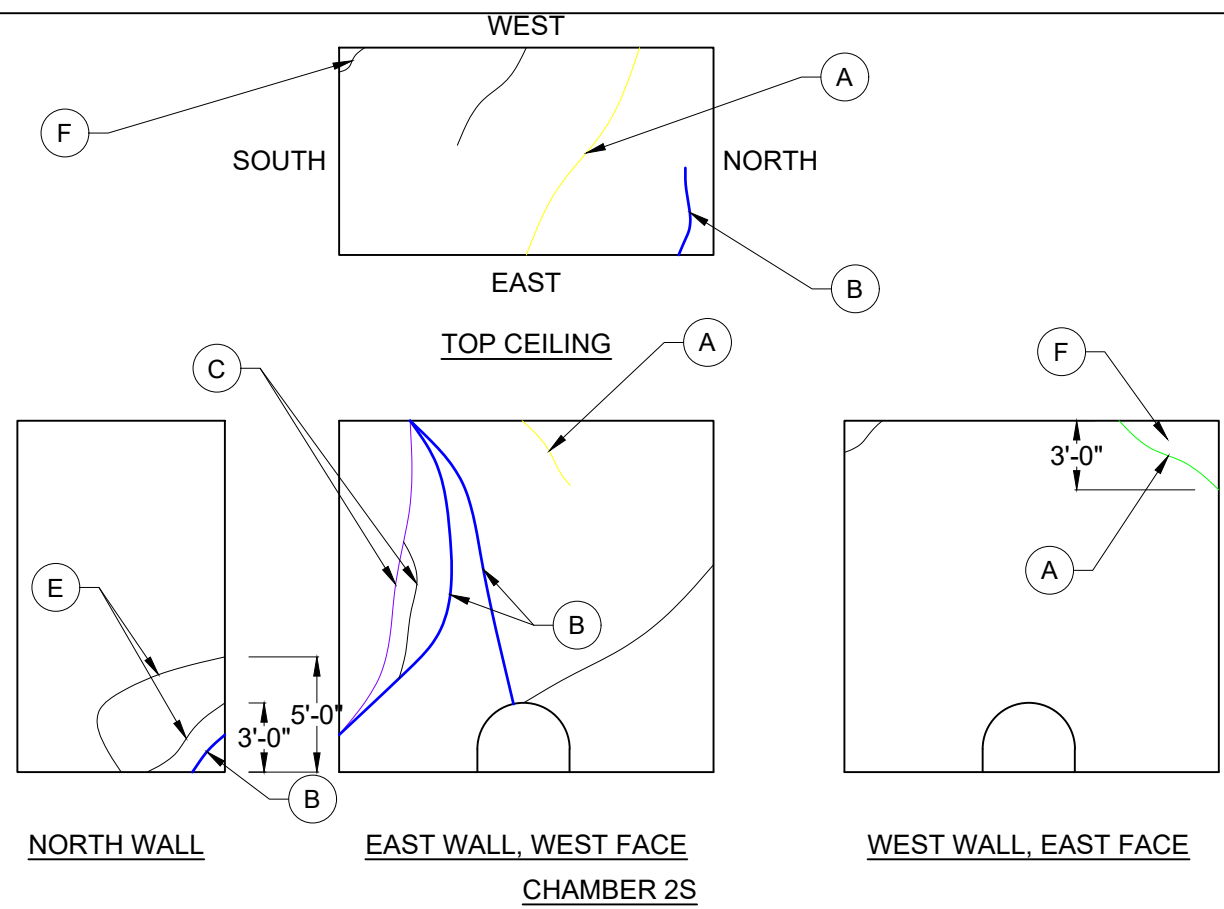

| CHAMBER 2S DEFECT TABLE | | |
|-------------------------|--|------------------|
| CALL OUT # | DEFECT DESCRIPTION | PHOTO # |
| A | 1/16" crack with heavy effloresence from ceiling into the East Wall and ceiling into West Wall 3'-0" from the top. | DWN084 to DWN 86 |
| B | 1/8" crack from ceiling to West wall extending down to 2'-0" above the floor, extending into the North wall. Crack also branches off from the top of the West wall extending into the entrance hole. | DWN077 to 748 |
| C | 1/16" W crack extending down from the Top of West wall connecting to the crack guage. Crack splits off to a 3/8" W crack and reconnects at the crack guage. | DWN077 to 748 |
| D | 1/8" W Crack from entrance hole extending to the south corner of the East wall. | |
| E | Two 1/32" W cracks starting 3'-0" to 5'-0" from the at the East corner of the North wall. | DWN081 |
| F | 1/16" W crack at the southwest corner of ceiling extending down into the top left cornor of the West wall. | DWN082 |

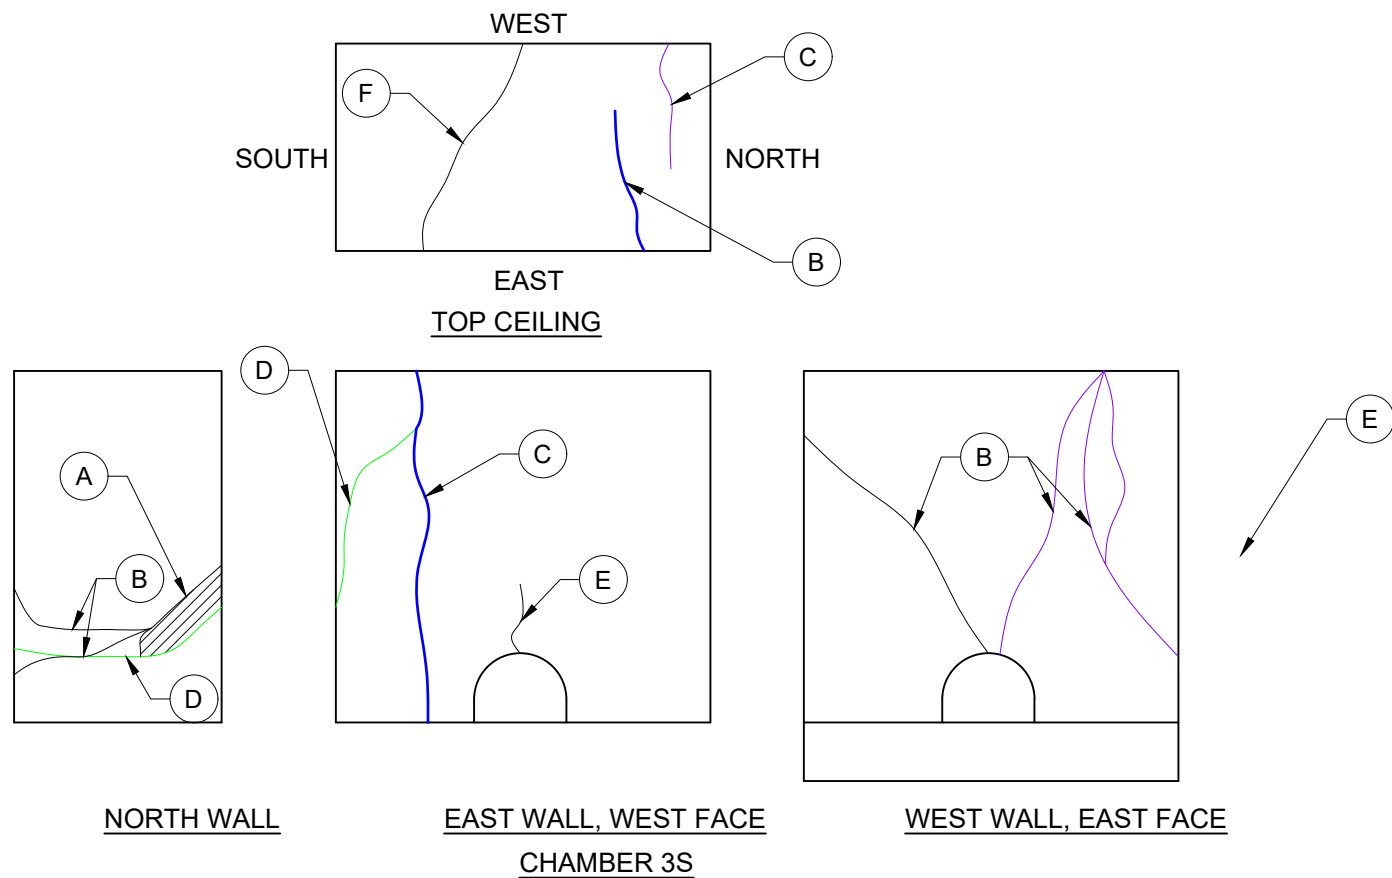


| CALL OUT # | DEFECT DESCRIPTION | PHOTO # |
|------------|--|--------------|
| A | 2'-2" H x 2'-0" W x 3-3/4" D spall | DWN071 & 073 |
| B | 1/8" W Crack | |
| C | 1/16" W crack at 4'-0" from the ground up, 2'-0" away from entrance. | DWN070 |
| D | 1/2" W crack extending up into the ceiling and extends across the full length of the north wall. | |
| E | 1/16" crack 3'-0" from the top of the entrance. | DWN070 |
| F | Crack on ceiling with minor efflorescence. | |

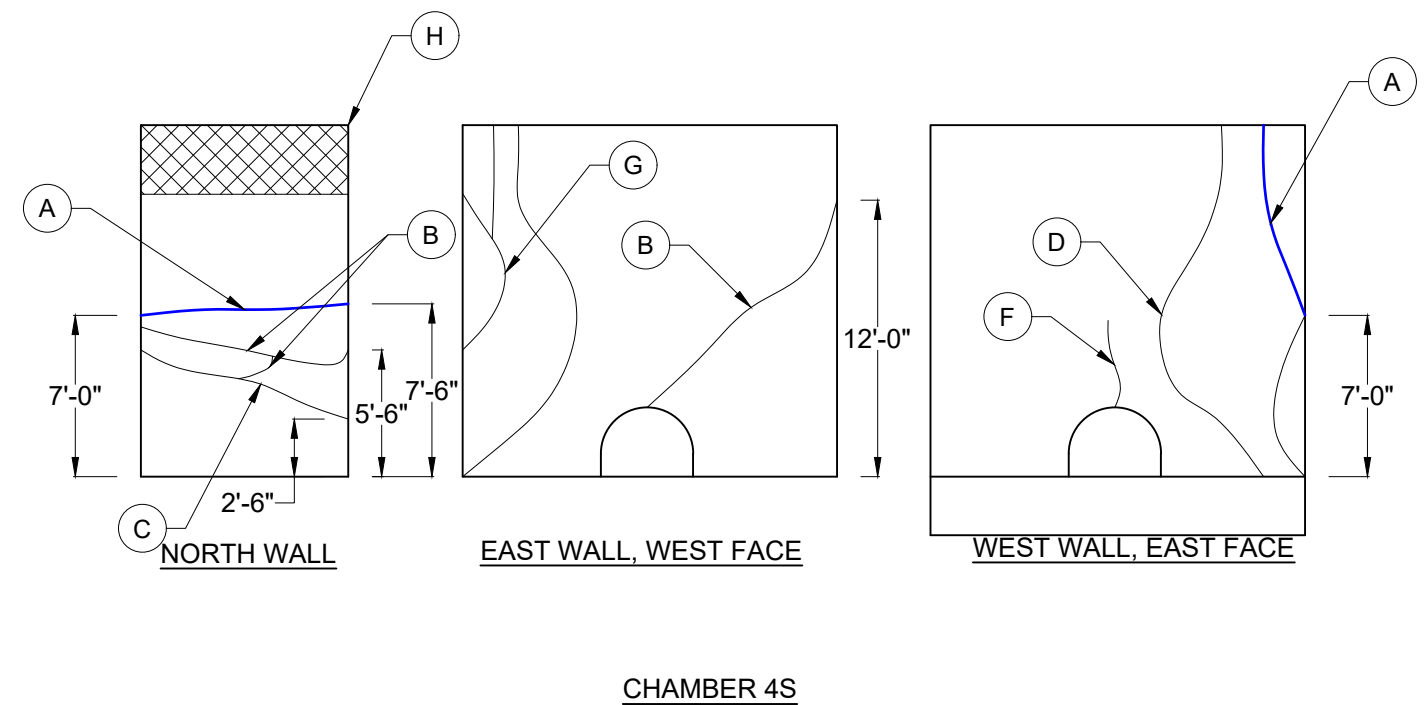

| CALL OUT # | DEFECT DESCRIPTION | PHOTO # |
|------------|---|------------|
| A | 1/16" W crack extends full width of the North wall and connects to the West wall and becomes 1/2" to 1" W crack and extends to the top of the wall. | DWN066/067 |
| B | 1/16" W crack | |
| C | 1/8" w full width of the North wall. | |
| D | 1/8" W crack full height of the West wall. | |
| E | 1/32" W crack extends 7' from the bottom of the floor. | |
| F | 1/16" W crack at the top of entrance on the west wall extends up 3'-6" up. | DWN069 |
| G | 3/4" W crack starting 5'-6" from the bottom of the wall and extend back into the the side of the east wall and to the top of the East wall. | |
| H | 3' H x Full width x 3" D spall. | DWN 68 |
| I | 1/16" W crack full height of the east wall. | |


Notes:

- All Dimensions are Field Measurements.
- Waterline Reference for soundings is the Top of Angled Nose on the Upstream side of Pier 5 (Top of Nose to Waterline = 11.2')
- Stream slope is < 1%.

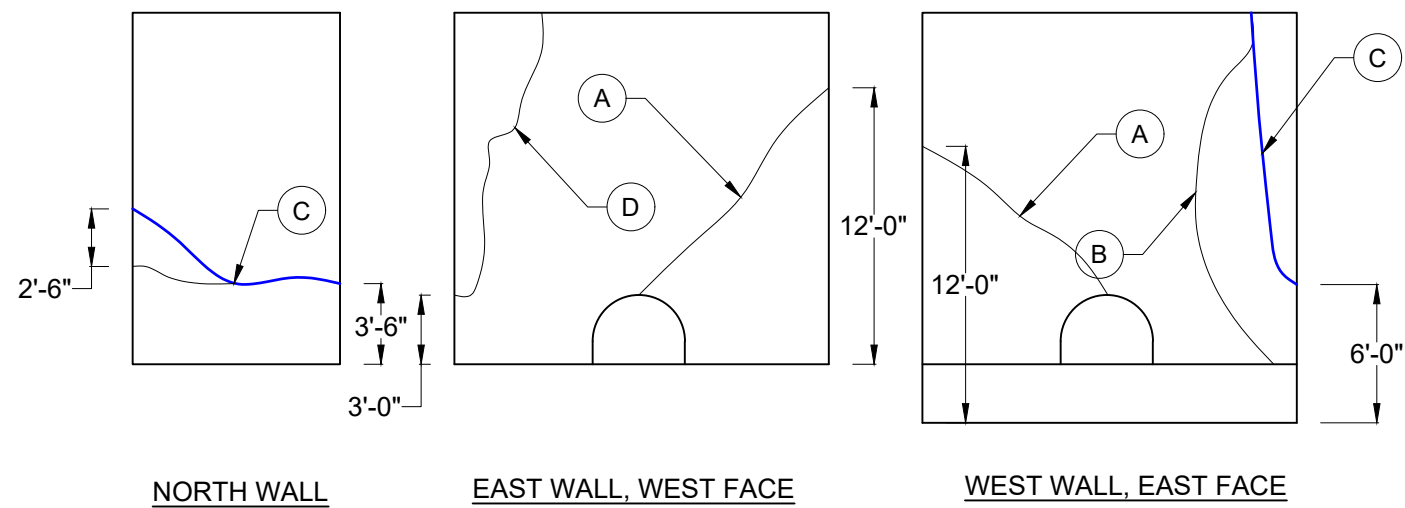

CHAMBER 5S

| CHAMBER 5S DEFECT TABLE | | |
|-------------------------|--|-----------|
| CALL OUT # | DEFECT DESCRIPTION | PHOTO # |
| A | 1/16" W crack from the top of entrance at the West wall extending over to the North of the West wall. | DWN0658 |
| B | 1/8" W crack full height of the West wall. | DWN061-62 |
| C | 1/8" W crack full width of the North wall, becomes a 1/2" W crack at the West Wall extending all the way to the top of the wall. | DWN061-62 |
| D | 3/4" W crack at 7'-6". | DWN059-60 |

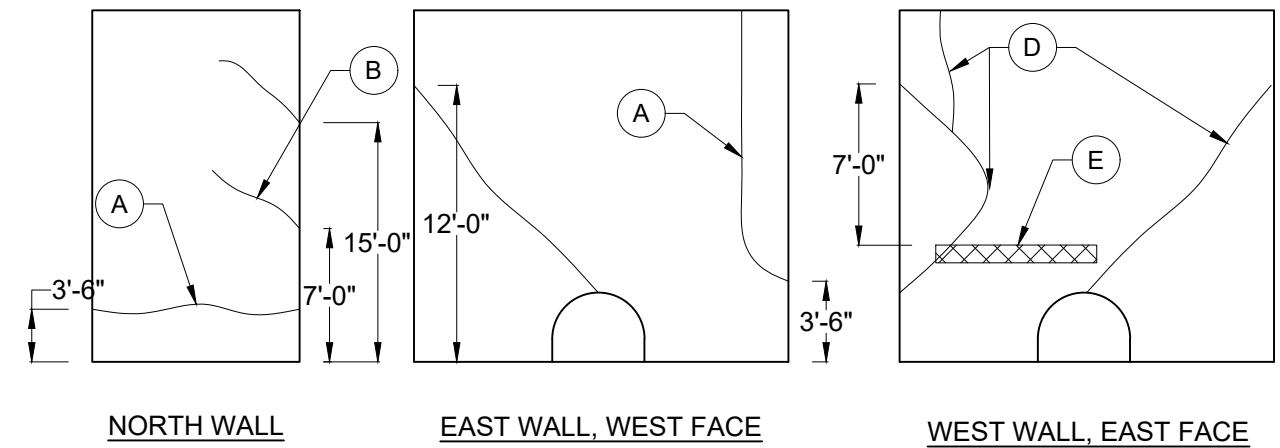


CHAMBER 6S

| CHAMBER 6S DEFECT TABLE | | |
|-------------------------|---|-----------|
| CALL OUT # | DEFECT DESCRIPTION | PHOTO # |
| A | 1/32" W crack along the cold joint connects to the West wall and extends to the top widening to 5/16" W with crack guage. | DWN053/54 |
| B | 1/32" W crack | DWN061-62 |
| C | 1/16" W crack | DWN061-62 |
| D | 1/8" W crack | DWN059-60 |
| E | 7' W x 8" H honeycombing with exposed rebar. | |

Notes:


- All Dimensions are Field Measurements.
- Waterline Reference for soundings is the Top of Angled Nose on the Upstream side of Pier 5 (Top of Nose to Waterline = 11.2')
- Stream slope is < 1%.

| | | | | |
|--------|-----------|---------------------------------------|---|--------------|
| SCALE: | DATE: |
INFRASTRUCTURE
ENGINEERS, INC. | Detroit-Superior Bridge
Structure No. CUY-6-1456 | |
| N.T.S | OCT, 2018 | | South Chamber Details - S5 & S6 | PAGE:
A-4 |

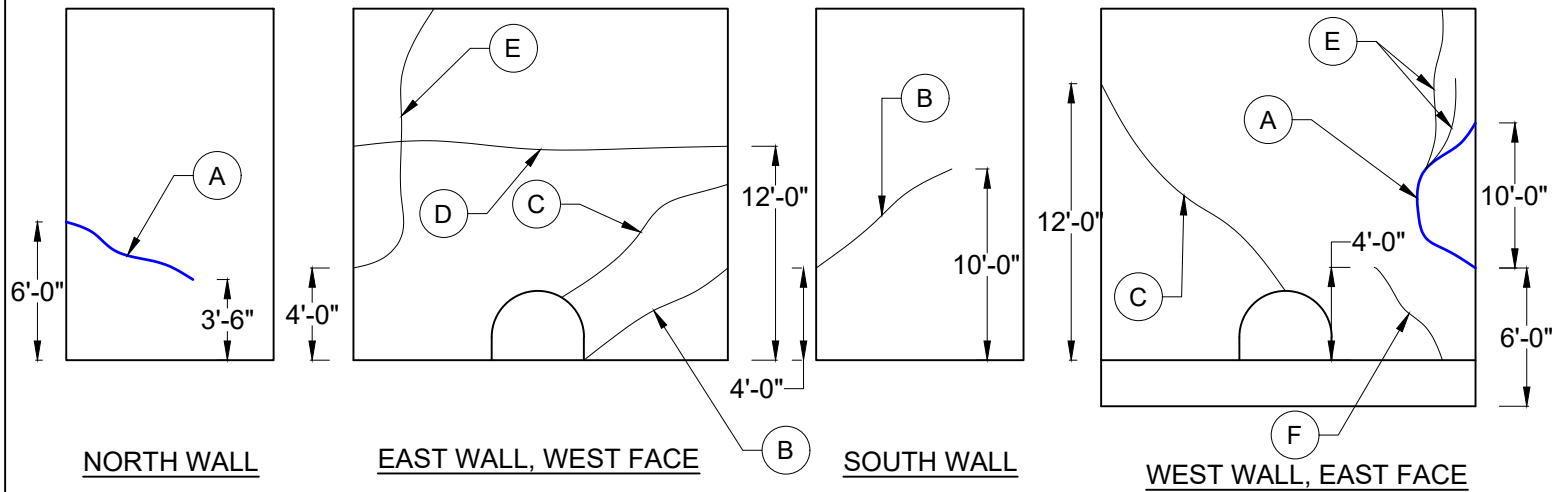

CHAMBER 7S

| CHAMBER 7S DEFECT TABLE | | |
|-------------------------|--|---------|
| CALL OUT # | DEFECT DESCRIPTION | PHOTO # |
| A | 1/32" W diagonal crack 3'-6" from the floor and 3'-6" from the east side of the north wall extending into the west wall widening to a 1/4" W vertical crack. | |
| B | 1/32" W diagonal crack extending from the east wall to the South wall widening to a 1/16" W diagonal crack. | |
| C | 1/16" W diagonal crack | DWN051 |
| D | 1/8" W horizontal crack | DWN052 |
| E | 1/8" W vertical crack | DWN050 |
| F | 1/32" W diagonal crack | |

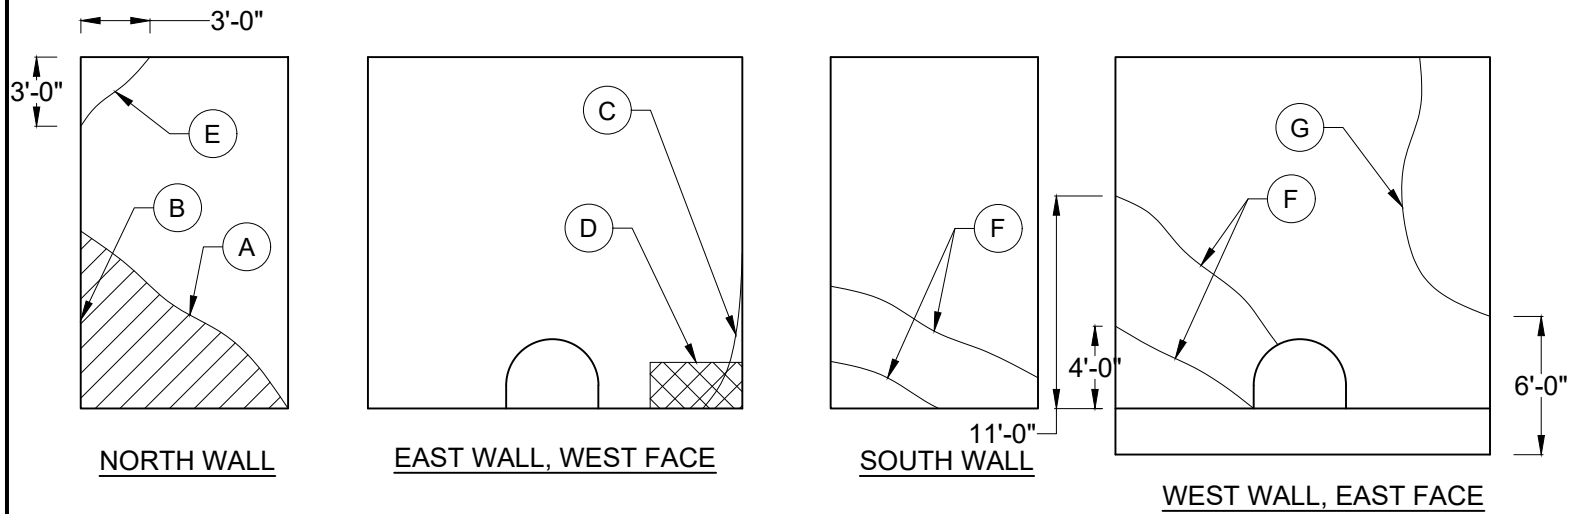


CHAMBER 8S

| CHAMBER 8S DEFECT TABLE | | |
|-------------------------|--|----------------|
| CALL OUT # | DEFECT DESCRIPTION | PHOTO # |
| A | Full depth separation of wall rotation outward. | DWN046 |
| B | 1/8" W separation at 4'-0" | DWN048 |
| C | 5/8" W separation | DWN051 |
| D | 2' H x 4' W x 4" D spall | DWN049 |
| E | 1/8" W diagonal crack with efflorescence. | DWN050 |
| F | 1/32" W diagonal crack with minor efflorescence. | |
| G | 1/8" W vertical crack. | DWN042-04
3 |

Notes:


- All Dimensions are Field Measurements.
- Waterline Reference for soundings is the Top of Angled Nose on the Upstream side of Pier 5 (Top of Nose to Waterline = 11.2')
- Stream slope is < 1%.

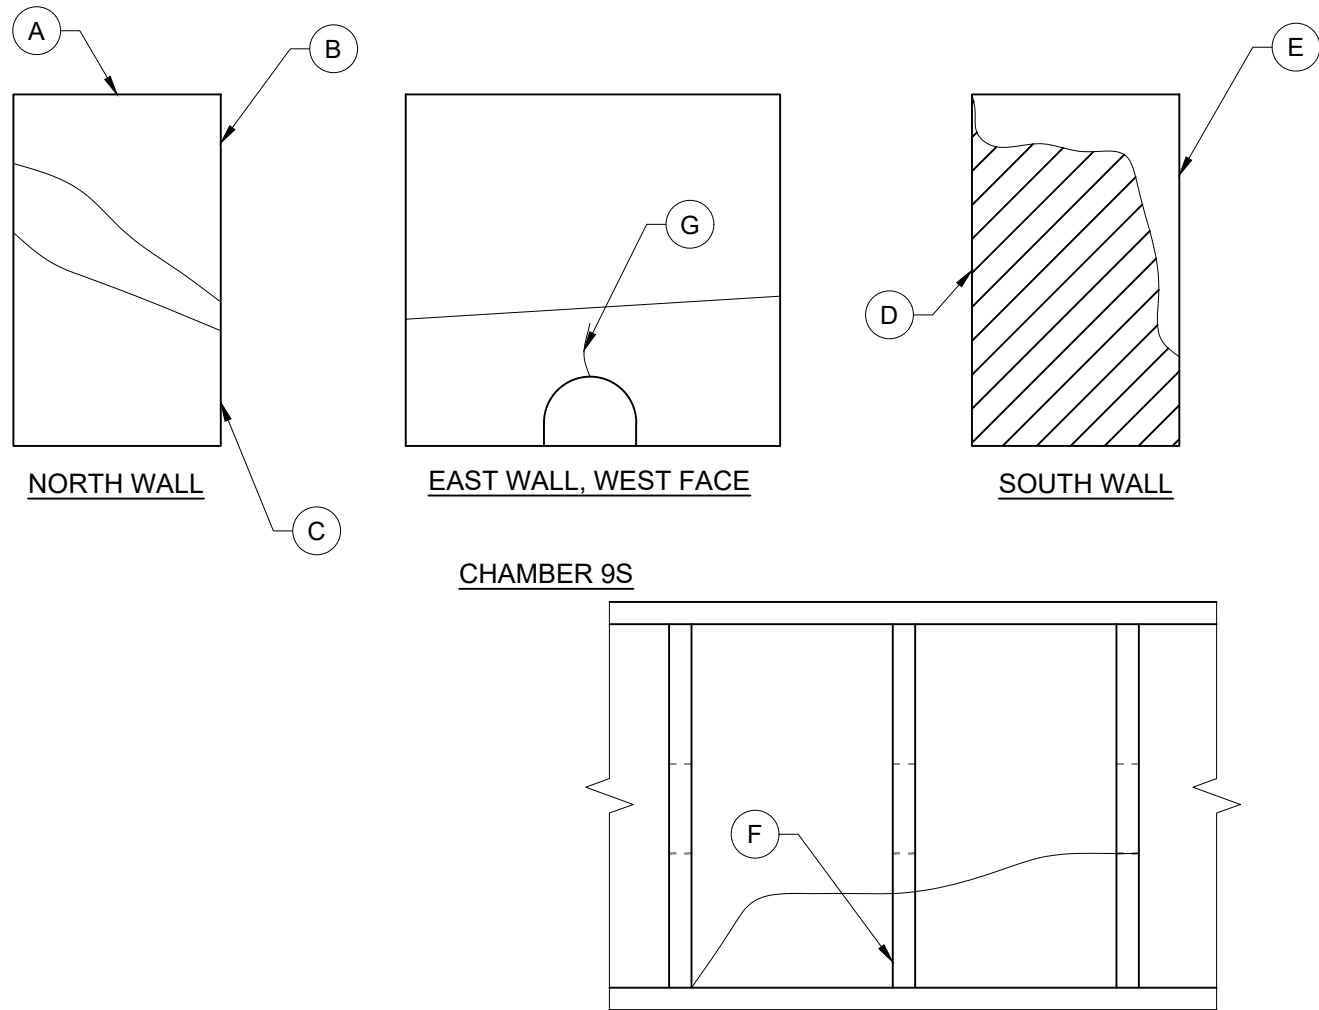

CHAMBER 9S DEFECT TABLE

| CALL OUT # | DEFECT DESCRIPTION | PHOTO # |
|------------|---|--------------|
| A | Seperation at the top of the wall | DWN027/28 |
| B | Full height seperation of the North wall from the east wall. Seperation increases from bottom to top of wall. | FJN632 to 34 |
| C | 7/16" W crack 42" H from base. | |
| D | The east edge of the wall has seperated from the wast wall and has rotated towards the south at 48" H 1-1/2" seperation. | FJN629 |
| E | South wall is roatated S, 1-1/4" at 48" H 7.7' H wall is split Full Depth with edge spalling up to 6" D. The lower portion of the wall has seperated and day light is visible through the seperation. | DWN31-37 |
| F | 1/2" W crack all the Floor full length of chamber 8S and chamber 9S. | |
| G | 22" G x 1/32" W vertical crack. | |

FLOOR CHAMBERS 9 & 8

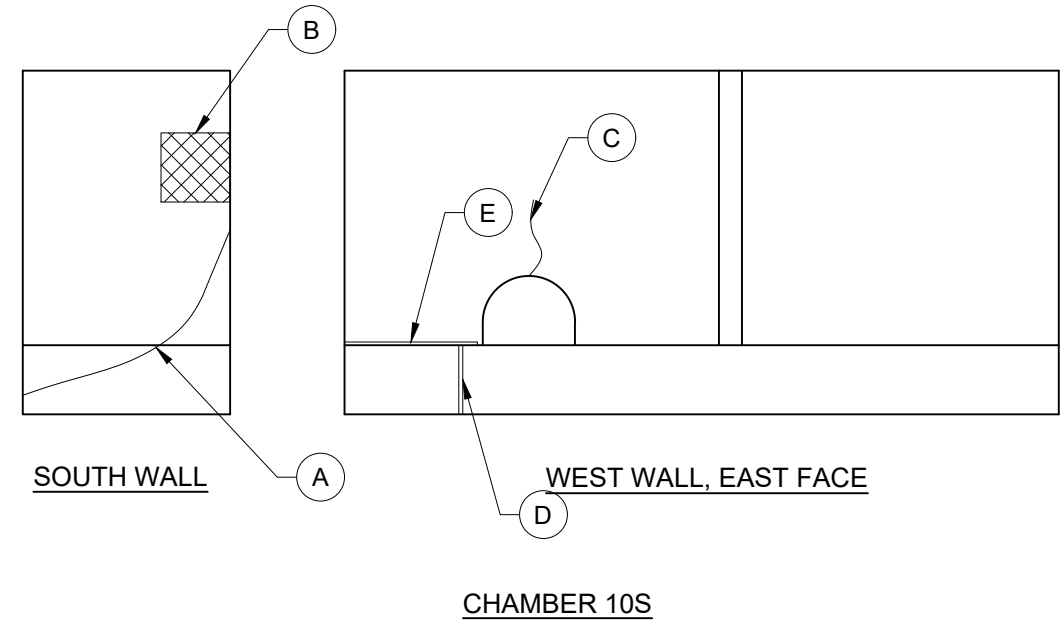

CHAMBER 10S DEFECT TABLE

| CALL OUT # | DEFECT DESCRIPTION | PHOTO # |
|------------|-------------------------------------|---------|
| A | 1/32" Crack | FJN628 |
| B | 6' H x 5' W delam / spall | FJN627 |
| C | 1'-10" H x 1/16" W crack | |
| D | Crack guage on top of step | FJN629 |
| E | Crack guage located at base of wall | FJN630 |

SCALE:
N.T.S





DATE:
OCT, 2018




Detroit-Superior Bridge
Structure No. CUY-6-1456

South Chamber Details - S9 & S10


PAGE:
A-6

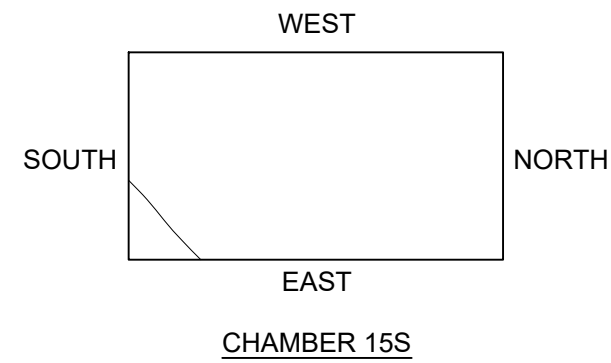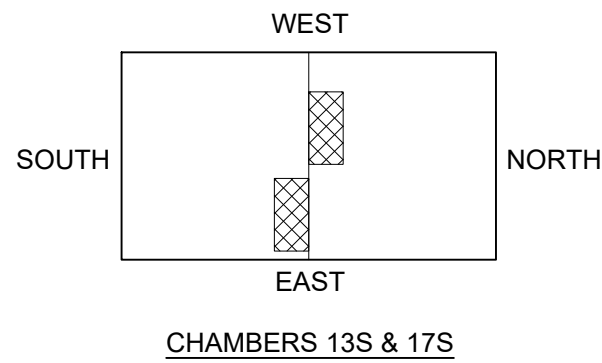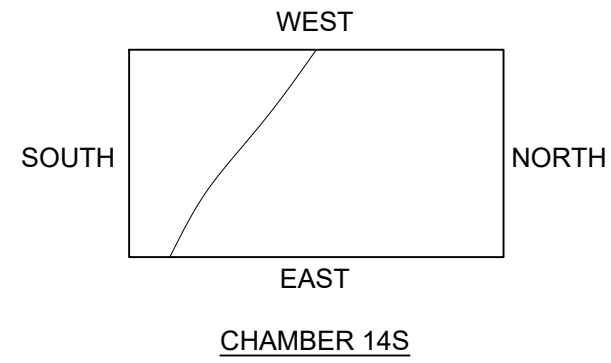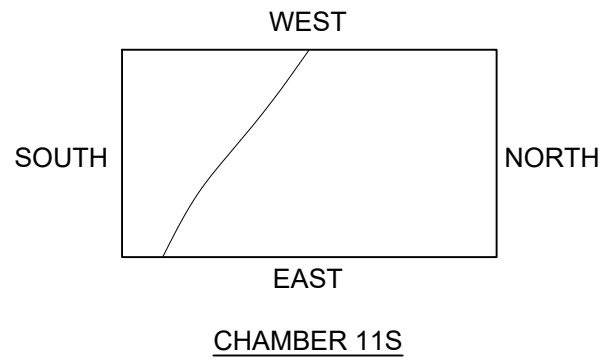


| CHAMBERS 11, 13, 14 & 15S DEFECT TABLE | | |
|--|---|------------------|
| CALL OUT # | DEFECT DESCRIPTION | PHOTO # |
| A | Efflorescence and rust staining | DNW087, 090-092, |
| B | Full width joint in ceiling with typical spalling up to 3'-0" W with exposed reinforcement. | DWN088-089 |

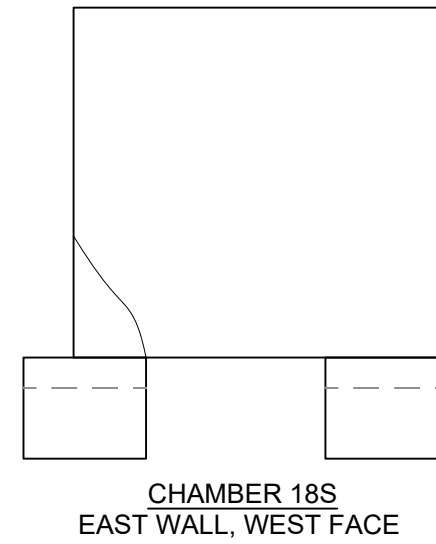

CHAMBER 10S

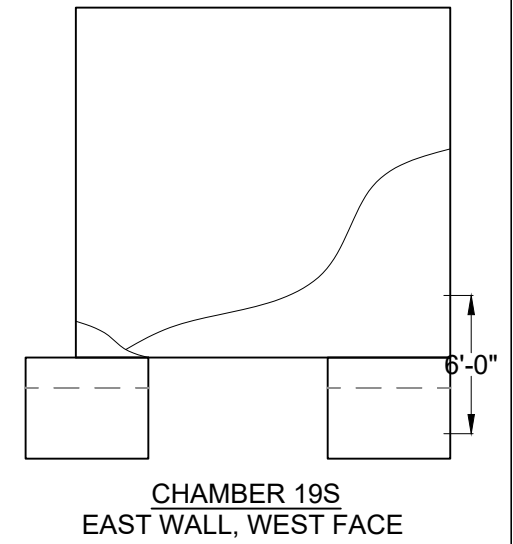


| CHAMBERS 18 & 19s DEFECT TABLE | | |
|--------------------------------|---|------------------|
| CALL OUT # | DEFECT DESCRIPTION | PHOTO # |
| A | 8'-0" L x 1/16" W cracks | |
| B | 1/8" W crack is reflective on the east face of wall | DWN096, 098, 099 |

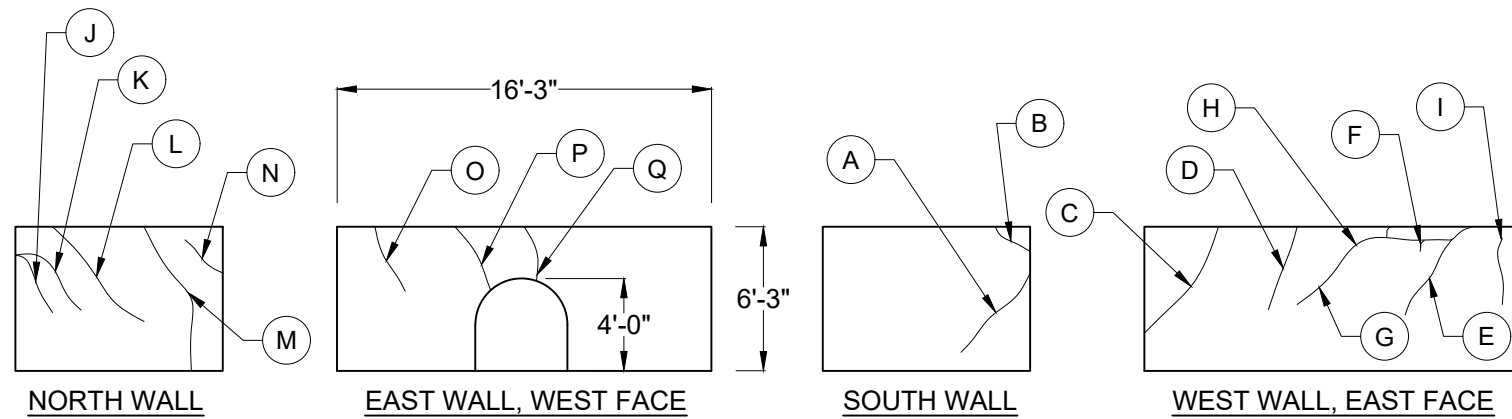


CHAMBER 1N

| CHAMBER 1N DEFECT TABLE | | |
|-------------------------|---|------------|
| CALL OUT # | DEFECT DESCRIPTION | PHOTO # |
| A | 4'-9" L diagonal hairline crack with light efflorescence. | RSF1673 |
| B | 1'-0" diagonal 1/32 W crack. | RSF1674 |
| C | 5'-2" L diagonal hairline crack with light efflorescence. | RSF1680 |
| D | 4'-9" L diagonal 1/32" W crack with light efflorescence. | RSF1679 |
| E | 4'-7" L diagonal / vertical 1/32" W crack with light efflorescence and moisture staining. | RSF1676 |
| F | 3'-1" L horizontal hairline crack with light efflorescence and moisture. | RSF1677 |
| G | 3'-0" L diagonal hairline crack with light efflorescence. | RSF1678 |
| H | 6" L diagonal hairline crack with efflorescence. | RSF1677 |
| I | 8" L diagonal hairline crack with moisture. | RSF1677 |
| J | 4'-0" L vertical hairline crack with light efflorescence. | RSF1675 |
| k | 1'-9" diagonal hairline crack with moderate efflorescence. | RSF1685 |
| L | 4'-2" L hairline crack with heavy efflorescence and rust stain. | RSF1685 |
| M | 6'-9" L x upto 1/32" W crack with heavy efflorescence and rust stain. | RSF1684/83 |
| N | Full height x up to 1/32" W crack with moderate efflorescence and rust stain. | RSF1682 |
| O | 2'-1" L hairline crack with light efflorescence. | RSF1681 |
| P | 3'-9" L hairline crack with light efflorescence. | RSF1686 |
| Q | 3'-0" L x 1/16" W crack with light efflorescence. Crack is failing full depth of wall. | RSF1687 |
| R | 2'-5" L x 1/16" W crack with light efflorescence full depth of wall | RSF1688 |

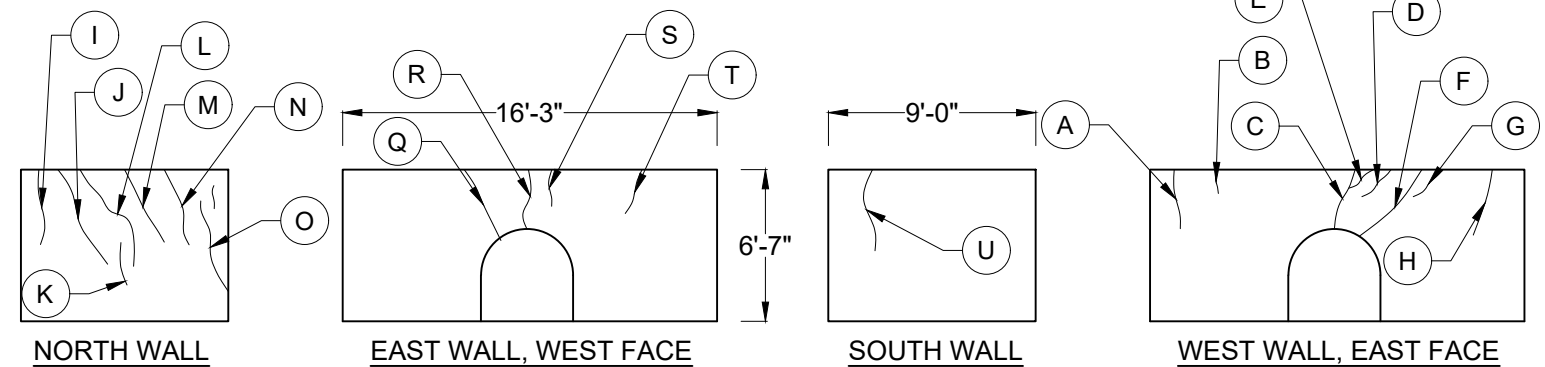

CHAMBER 2N


| CHAMBER 2N DEFECT TABLE | | |
|-------------------------|--|------------|
| CALL OUT # | DEFECT DESCRIPTION | PHOTO # |
| A | 2'-10" Hairline crack | RSF1664 |
| B | 1'-7" L Hairline crack with light efflorescence. | RSF1690 |
| C | 2'-5" L x 1/16" W crack with light efflorescence full depth of wall | RSF1691 |
| D | 1'-7" L Hairline crack with light efflorescence. | |
| E | 9" L fine crack with light efflorescence. | |
| F | 3'-0" L x 1/16" W crack with light efflorescence. Crack is failing full depth of wall. | RSF1692 |
| G | 1'-5" L hairline crack with light efflorescence | RSF1693 |
| H | 3'-5" L hairline crack with light efflorescence. | RSF1694 |
| I | 2'-10" L hairline crack with light efflorescence. | RSF1695 |
| J | 5'-0" L hairline crack with light efflorescence and rust stain. | RSF1696 |
| k | 1' L hairline crack with efflorescence. | RSF1697 |
| L | 5'-1" L hairline crack with light efflorescence. | RSF1697 |
| M | 3'-5" L hairline crack with light efflorescence. | RSF1684/83 |
| N | 4'-2" L hairline crack with light efflorescence. | |
| O | 3'-8" L hairline crack with heavy efflorescence. | RSF1698 |
| P | 9" L hairline crack; | RSF1686 |
| Q | 3'-4" L x 1/32" W crack with light efflorescence goes full depth of wall | RSF1699 |
| R | 2'-7" L x 1/16" W crack goes full depth of wall. | RSF1700 |
| S | 1'-9" L hairline crack with light efflorescence | RSF1701 |
| T | 2'-4" L hairline crack | RSF1702 |
| U | 3'-6" L x 1/32" W crack with moisture stain. | RSF1703 |

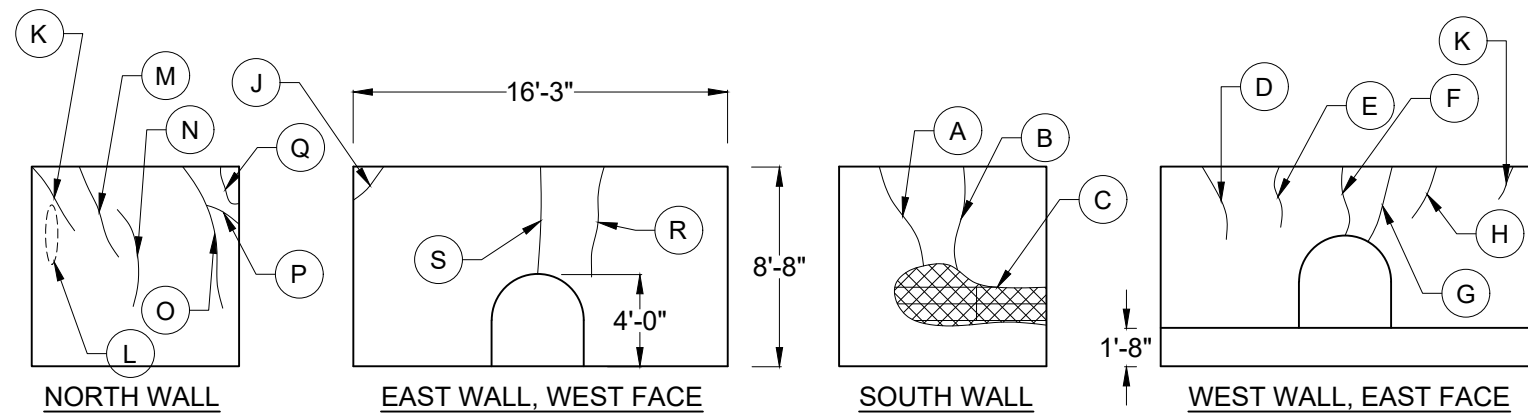

CHAMBER 3N

CHAMBER 3N DEFECT TABLE

| CALL OUT # | DEFECT DESCRIPTION | PHOTO # |
|------------|---|------------|
| A | 5'-6" L Hairline crack | RSF1704 |
| B | 5'-2" L Hairline crack | RSF1706-07 |
| C | 2'-4" H x 6'-7" L x 2" D poor consolidation / spalling with 3 longitudinal and 1 transverse rebar exposed | RSF1706-07 |
| D | 3'-7" L hairline crack with light efflorescence. | RSF1708 |
| E | 2'-5" L hairline crack with minor efflorescence. | RSF1709 |
| F | 2'-7" L x 1/16" W crack goes full depth of wall. | RSF1710 |
| G | 3'-4" L x 1/32" W crack with light efflorescence goes full depth of wall | RSF1711 |
| H | 2'-2" L hairline crack with light efflorescence. | RSF1712 |
| I | 1'-8" L hairline horizontal crack with light efflorescence. | RSF1713 |
| J | 4'-7" L hairline crack with efflorescence and rust stain. | RSF1714 |
| k | Area of heavy efflorescence. | |
| L | 5' L hairline crack with heavy efflorescence and light rust. | RSF1715 |
| M | 4'-2" L hairline crack with moderate efflorescence. | RSF1715 |
| N | 6'-11" L hairline crack with heavy efflorescence and rust stain. | RSF1716 |
| O | 2'-6" L hairline crack with light efflorescence. | RSF1716 |
| P | 2'-2" IL hariline crack with light efflorescence and moisture. | RSF1716 |
| Q | 1' L hairline crack with efflorescence. | RSF1717 |
| R | 4'-8" L x 1/8 W crack. Crack is full depth of wall. | RSF1718 |
| S | 5'-2" L x 1/32" W crack with light efflorescence. | RSF1719 |

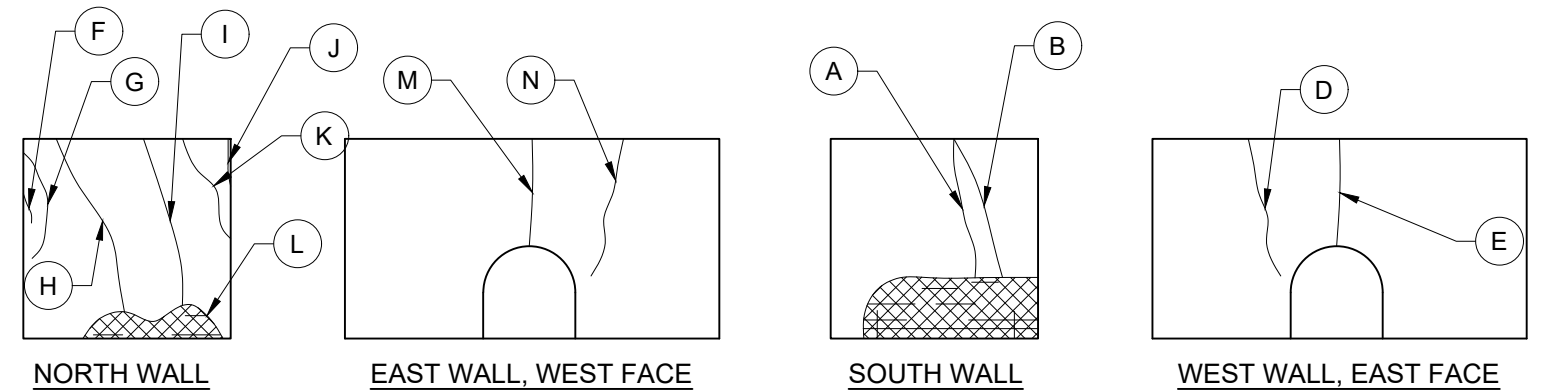

CHAMBER 4N

CHAMBER 4N DEFECT TABLE

| CALL OUT # | DEFECT DESCRIPTION | PHOTO # |
|------------|---|------------|
| A | 5'-9" L hairline crack. | RSF1704 |
| B | 5'-10" L x 1/32" W crack with light efflorescence. | RSF1706-07 |
| C | 7'-6" W x 3' H poor consolidated concrete kup to 1-1/2" D with 5 longitudinal and 2 vertical exposed rebar. | RSF1706-07 |
| D | 5'-7" L x 1/32" W crack with light efflorescence. Crack maybe full depth of wall. | RSF1708 |
| E | 2'-6" L hairline crack with light efflorescence. | RSF1709 |
| F | 1' L fine crackwith light efflorescence. | RSF1710 |
| G | 5'-3" L hairline crack with light efflorescence. | RSF1711 |
| H | 7'-9" L hairline crack with moderate efflorescence. | RSF1712 |
| I | 7'-10" L hairline crack with heavy efflorescence. | RSF1713 |
| J | 6'-5" L hairline crack with light efflorescence. | RSF1714 |
| k | 2'-6" L hairline crackwith heavy efflorescence. | |
| L | 5'-8" L x 1'-0" H x 1" D poor consolidation poor consolidation with 2 longitudinal rebar exposed. | RSF1715 |
| M | 4'-8" L x 1/8 W crack with 1/2" spalling along the bottom. | RSF1715 |
| N | 5'-8" L x up to 1/32" /w crack with light efflorescence. | RSF1716 |

SCALE:

N.T.S

DATE:

OCT, 2018




INFRASTRUCTURE ENGINEERS, INC.


Detroit-Superior Bridge
Structure No. CUY-6-1456

North Chamber Details - 3N & 4N

PAGE:
A-9

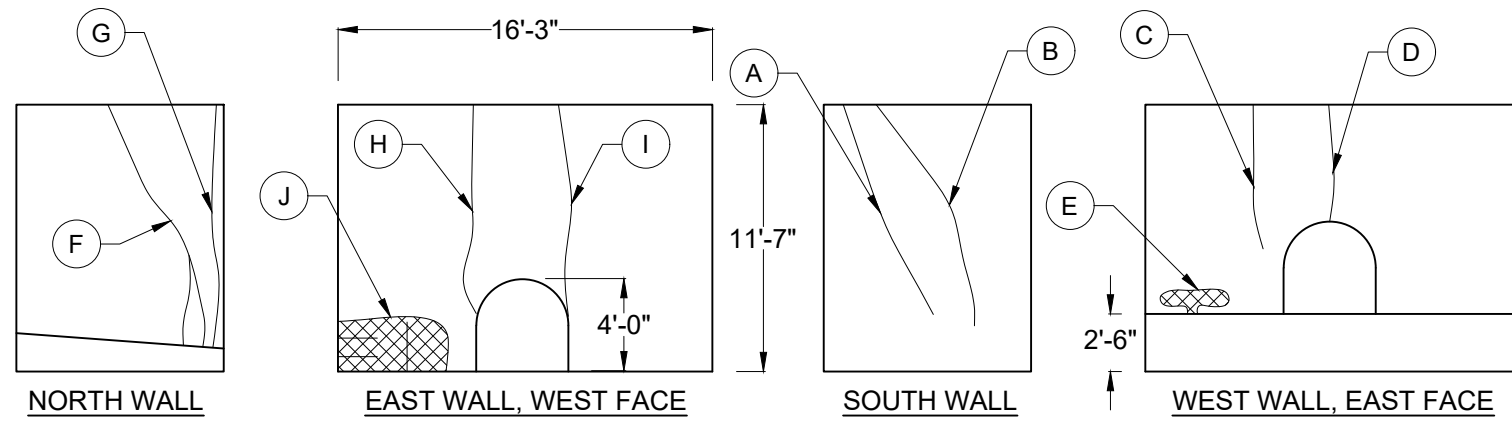

CHAMBER 5N

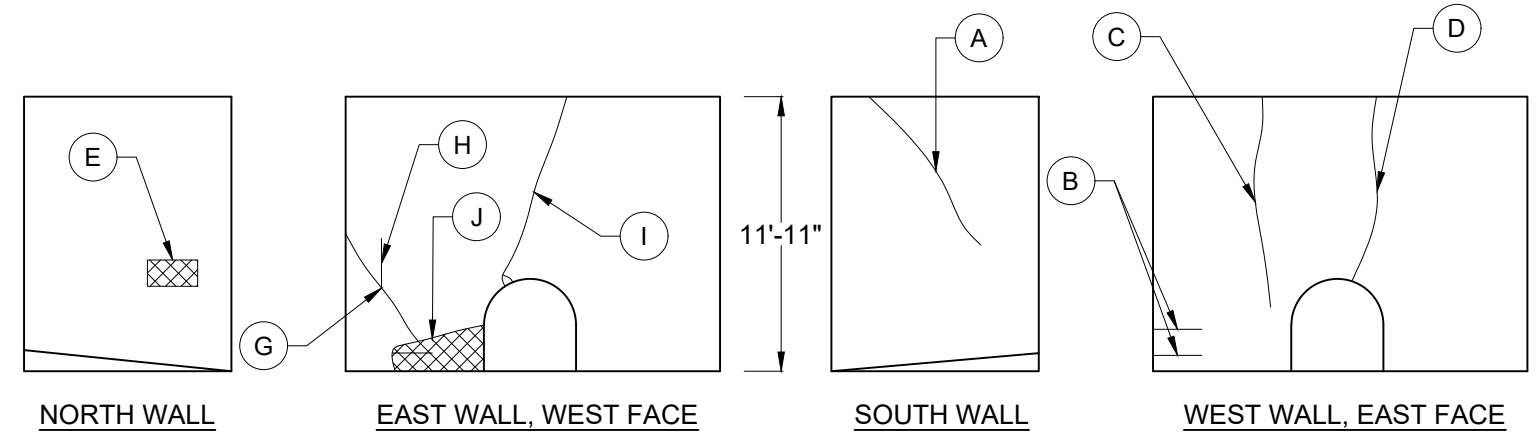

CHAMBER 6N

CHAMBER 5N DEFECT TABLE

| CALL OUT # | DEFECT DESCRIPTION | PHOTO # |
|------------|--|------------|
| A | 10'-9" L hairline crack | RSF1704 |
| B | 9'-9" L hairline crack with light efflorescence. | RSF1706-07 |
| C | 6'-3" L x 1/32" W crack, might line up with 4 N. | RSF1706-07 |
| D | 4'-8" L x 1/8 W crack with 1/2" spalling along the bottom. | RSF1708 |
| E | 4' L x 1' H x 2" D poor consolidation with one longitudinal rebar exposed. | RSF1709 |
| F | 11'-2" L hairline crack splits into 2 cracks at bottom 3'-0" with moderate efflorescence. | RSF1710 |
| G | 10'-7" L hairline crack with light efflorescence. | RSF1711 |
| H | 8'-3" L x 1/16" W crack full depth. | RSF1712 |
| I | 7'-10" L x 1/32" W crack with light efflorescence. | RSF1713 |
| J | 4'-6" L x 1'-10" H x 1-1/2" D poor consolidation with 2 longitudinal and 1 vertical rebar exposed. | RSF1714 |

CHAMBER 6N DEFECT TABLE

| CALL OUT # | DEFECT DESCRIPTION | PHOTO # |
|------------|---|------------|
| A | 10'-8" L hairline crack with light efflorescence. | RSF1704 |
| B | (2) 2' L rebar exposed. | RSF1706-07 |
| C | 8'-3" L x 1/32" W crack with light efflorescence may line up with 5N. | RSF1706-07 |
| D | 8'-3" L x 1/16" W crack full depth. | RSF1708 |
| E | 2' L x 1' H poor consolidation with moderate efflorescence and rust. | RSF1709 |
| F | 4' L piece of rebar exposed. | RSF1710 |
| G | 6'-7" L hairline crack. | RSF1711 |
| H | 1'-7" L hairline crack. | RSF1712 |
| I | 8'3" L x 1/8" W crack. Crack is full depth of wall. | RSF1713 |
| J | 4' L 2' H x 1" D spall with one exposed long rebar. | RSF1714 |

SCALE:
N.T.S

DATE:
OCT, 2018




INFRASTRUCTURE
ENGINEERS, INC.


Detroit-Superior Bridge
Structure No. CUY-6-1456

North Chamber Details - 5N & 6N


PAGE:
A-10

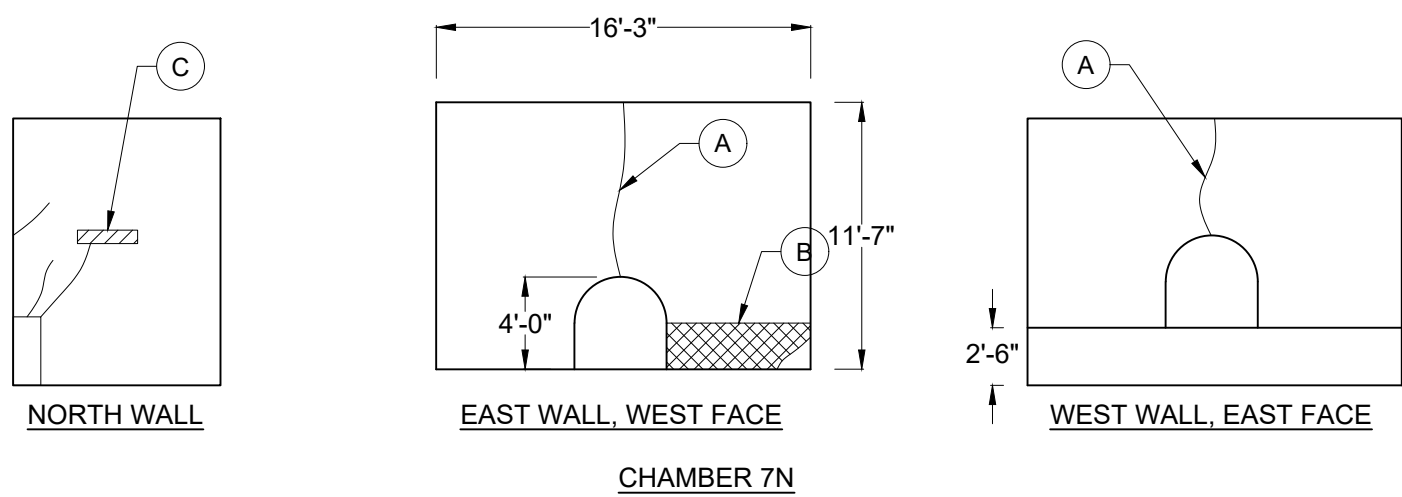


| CHAMBER 7N DEFECT TABLE | | |
|-------------------------|---|---------|
| CALL OUT # | DEFECT DESCRIPTION | PHOTO # |
| A | Full Height x 1/8" W crack | DWN133 |
| B | 4' L x 1'-8" H spall. | DWN132 |
| C | 1'-6" L x 2'-0" delamination with heavy efflorescence and moisture. | DWN134 |

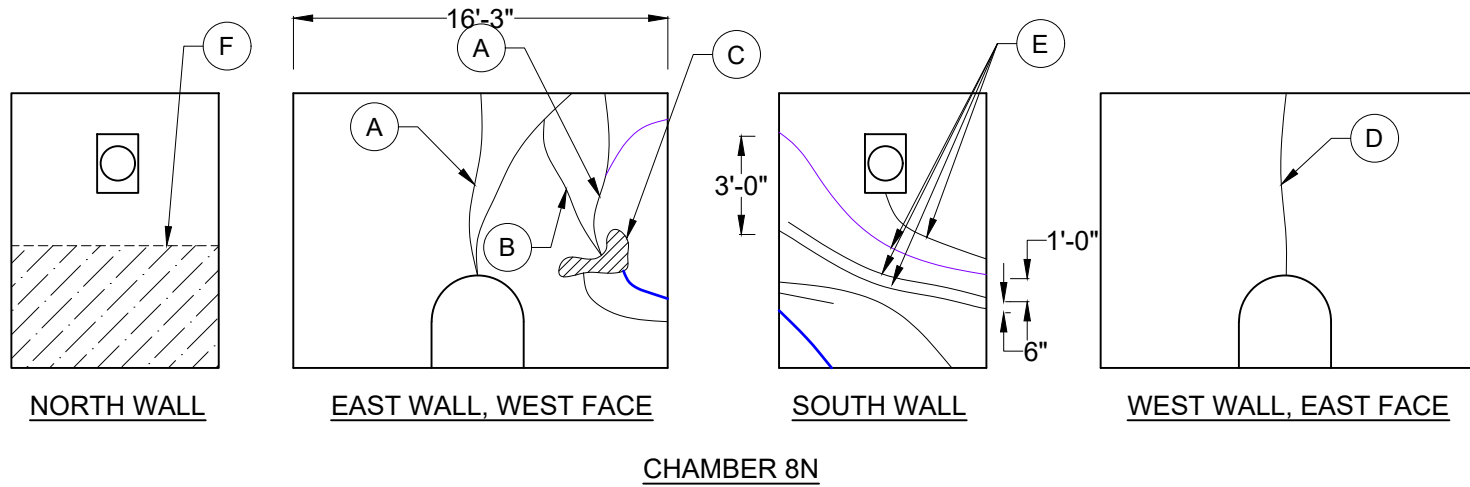

| CHAMBER 8N DEFECT TABLE | | |
|-------------------------|--|-----------|
| CALL OUT # | DEFECT DESCRIPTION | PHOTO # |
| A | 1/4" W crack | DWN127-28 |
| B | 1/16" W crack | |
| C | spall with cracks extending from it. | |
| D | 1/8" W crack from the top of entrance to the ceiling. | DWN130 |
| E | Multiple hailine cracks about full width of South wall. | DWN129 |
| F | Lower half of north wall, heavy efflorescence and rust staining. | DWN131 |

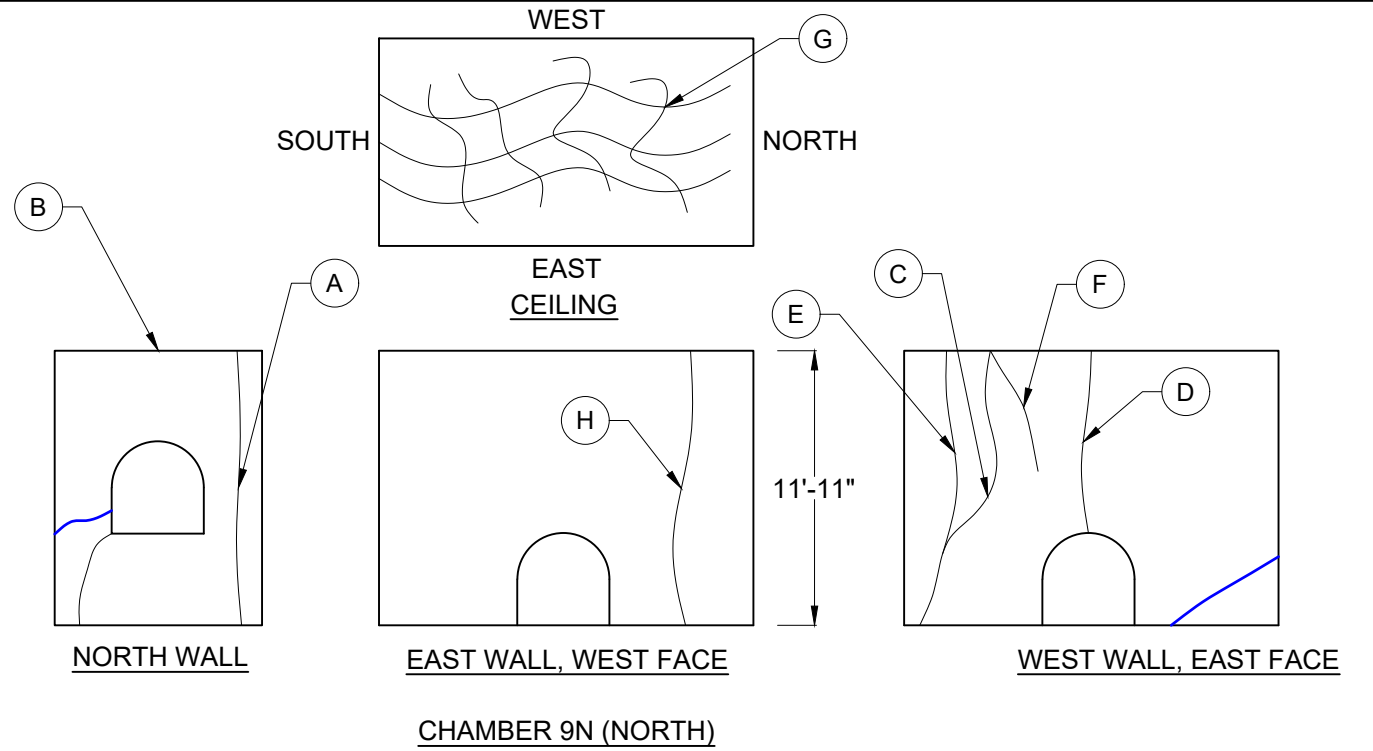


| CHAMBER 9N (NORTH) DEFECT TABLE | | |
|---------------------------------|---|------------|
| CALL OUT # | DEFECT DESCRIPTION | PHOTO # |
| A | Full Height x +/- 1/8" W crack/joint | DWN125 |
| B | 1" W gap | |
| C | 1/8" W crack full height of wall | DWN123-124 |
| D | 1/8" W crack from the top of entrance to the ceiling. | DWN123-124 |
| E | 1/4" W crack branching from crack in note C. | DWN123-124 |
| F | Hairline crack branching crack in note C. | DWN123-124 |
| G | Hairline map cracking with efflorescence | DWN126 |
| H | Full Height x 1/16" W crack | |

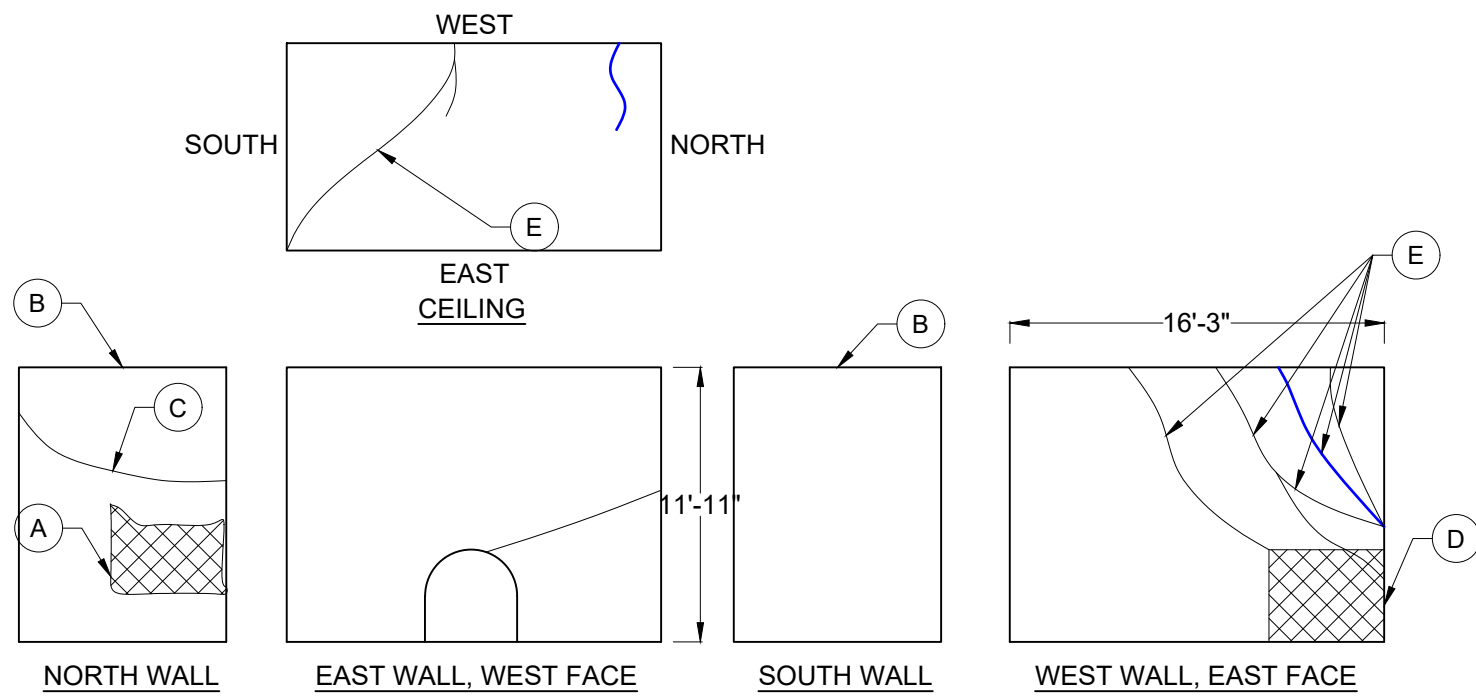


CHAMBER 9N (SOUTH)

| CHAMBER 9N (SOUTH) DEFECT TABLE | | |
|---------------------------------|--|------------|
| CALL OUT # | DEFECT DESCRIPTION | PHOTO # |
| A | 3' H x 5' W area of honeycombing | DWN125 |
| B | 1" W gap | |
| C | 1/32" W crack full width of the north wall | DWN123-124 |
| D | 5' L x 4' H delam / Spall. | DWN123-124 |
| E | Hairline to 1/8" W cracks | DWN123-124 |
| F | 1/16" W crack | DWN123-124 |

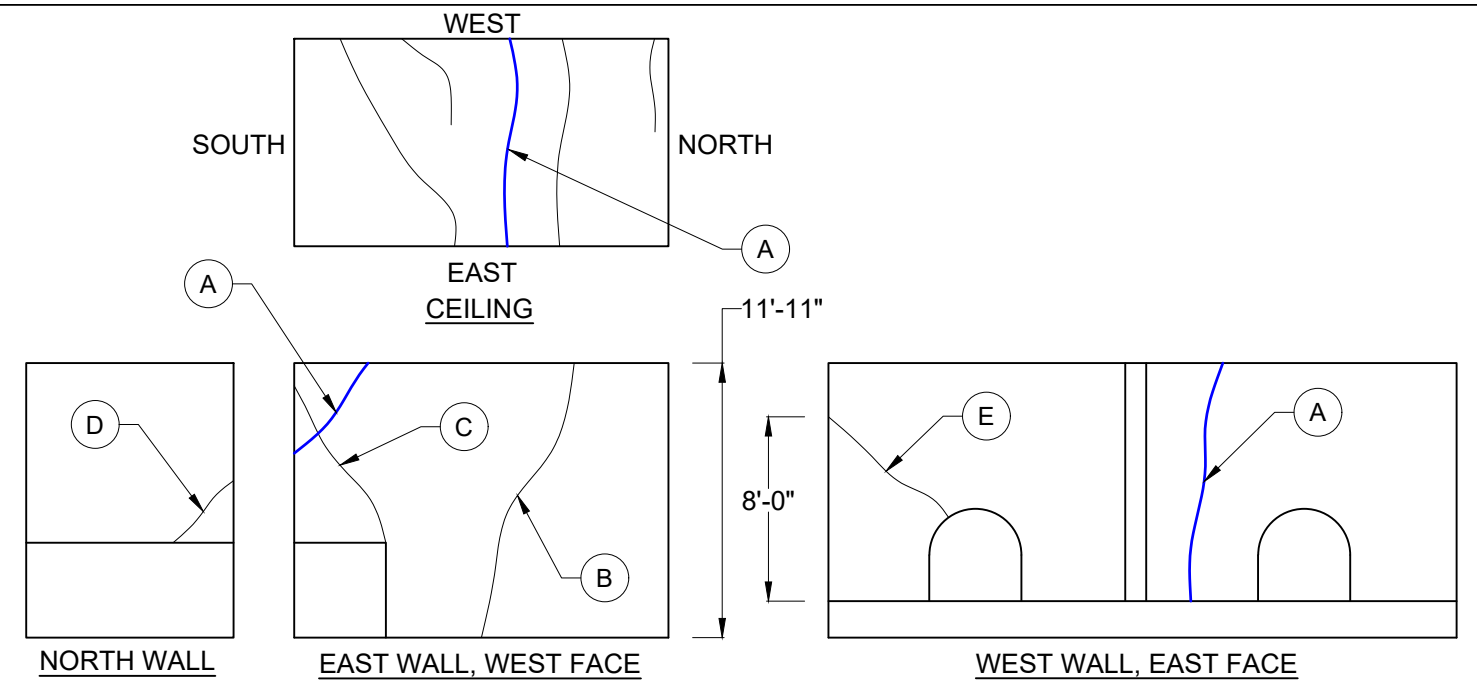


CHAMBER 10N


| CHAMBER 10N DEFECT TABLE | | |
|--------------------------|---|------------|
| CALL OUT # | DEFECT DESCRIPTION | PHOTO # |
| A | 1/32" W crack full height of west connects to ceiling goes full width of ceiling connects to the east wall. | DWN117-118 |
| B | Full height hairline on the East wall | |
| C | Diagonal hairline crack from cold joint to the south side. | |
| D | 3' L x Hairline on the North wall. | |
| E | 1/8" W from the top of south entrance to the south end 8'-0" from the bottom. | DWN117 |
| F | 1/16" W crack | |

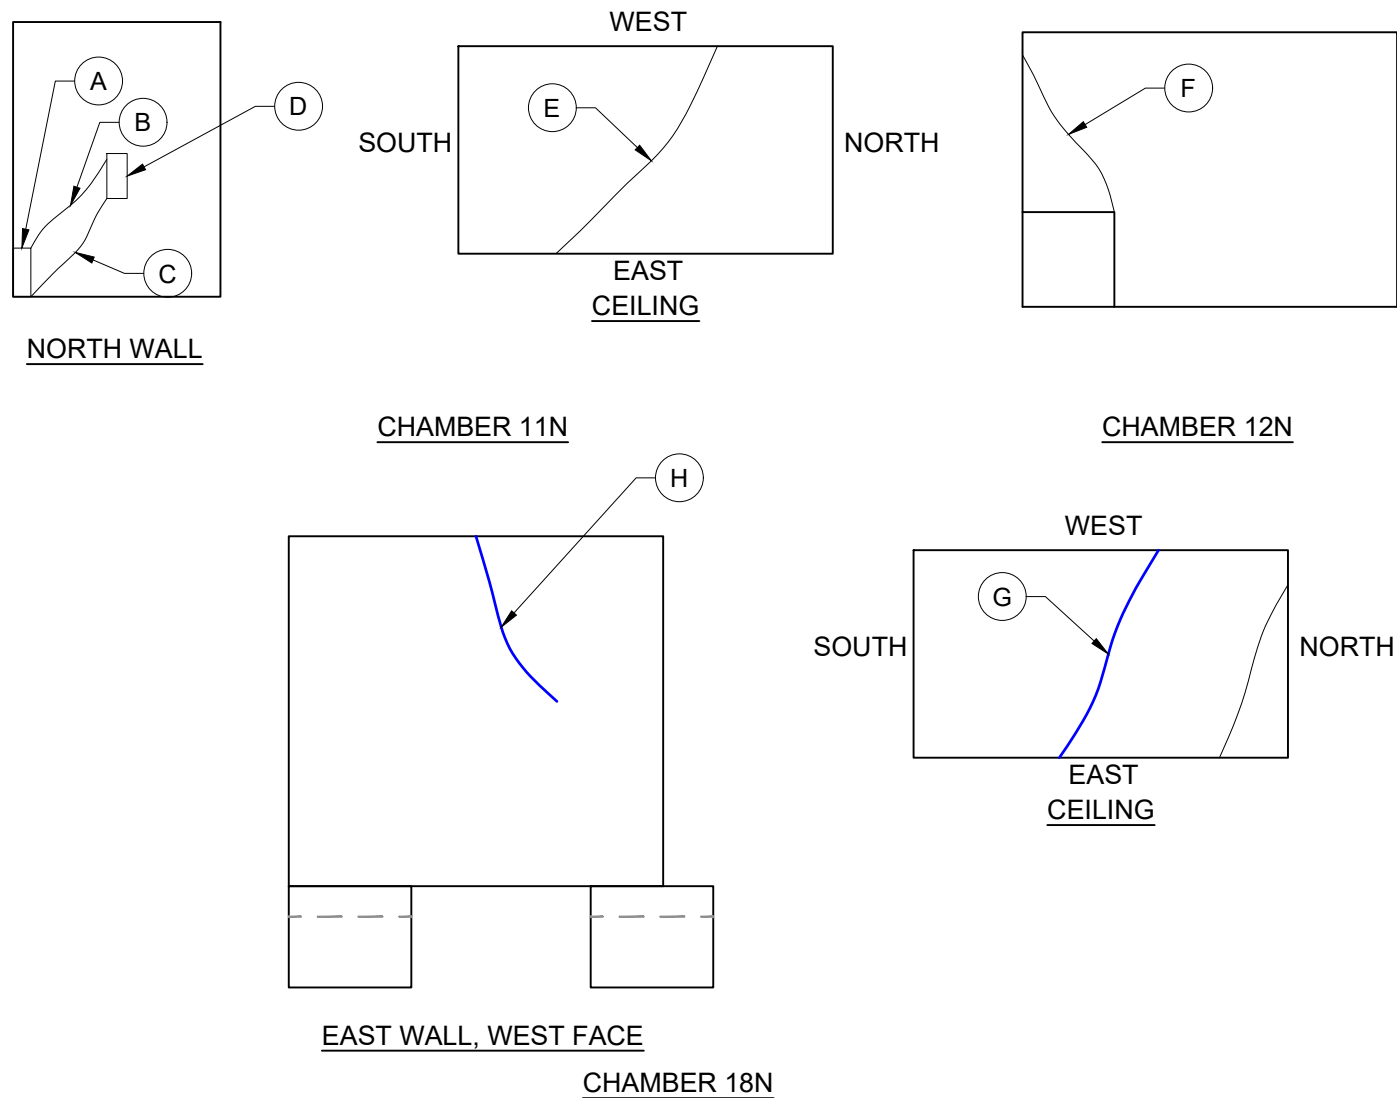

| CALL OUT # | DEFECT DESCRIPTION | PHOTO # |
|------------|---|---------|
| A | Delamination | DWN103 |
| B | 1/16" W crack from delam to steel plate | DWN103 |
| C | 1/8" W crack from delam to steel plate. | DWN103 |
| D | Steel plate | |
| E | Diagonal crack full width of ceiling with minor efflorescence | |
| F | Hairline crack reflective on the East face. Same crack and joints on Chamber 13N, West and East face of wall. (Wall between 13N-14N). | DWN104 |
| G | Crack with heavy efflorescence and moisture full width of the ceiling connects to the east wall extending halfway down the east wall. | DWN105 |
| H | diagonal crack with heavy efflorescence and moisture. | DWN106 |

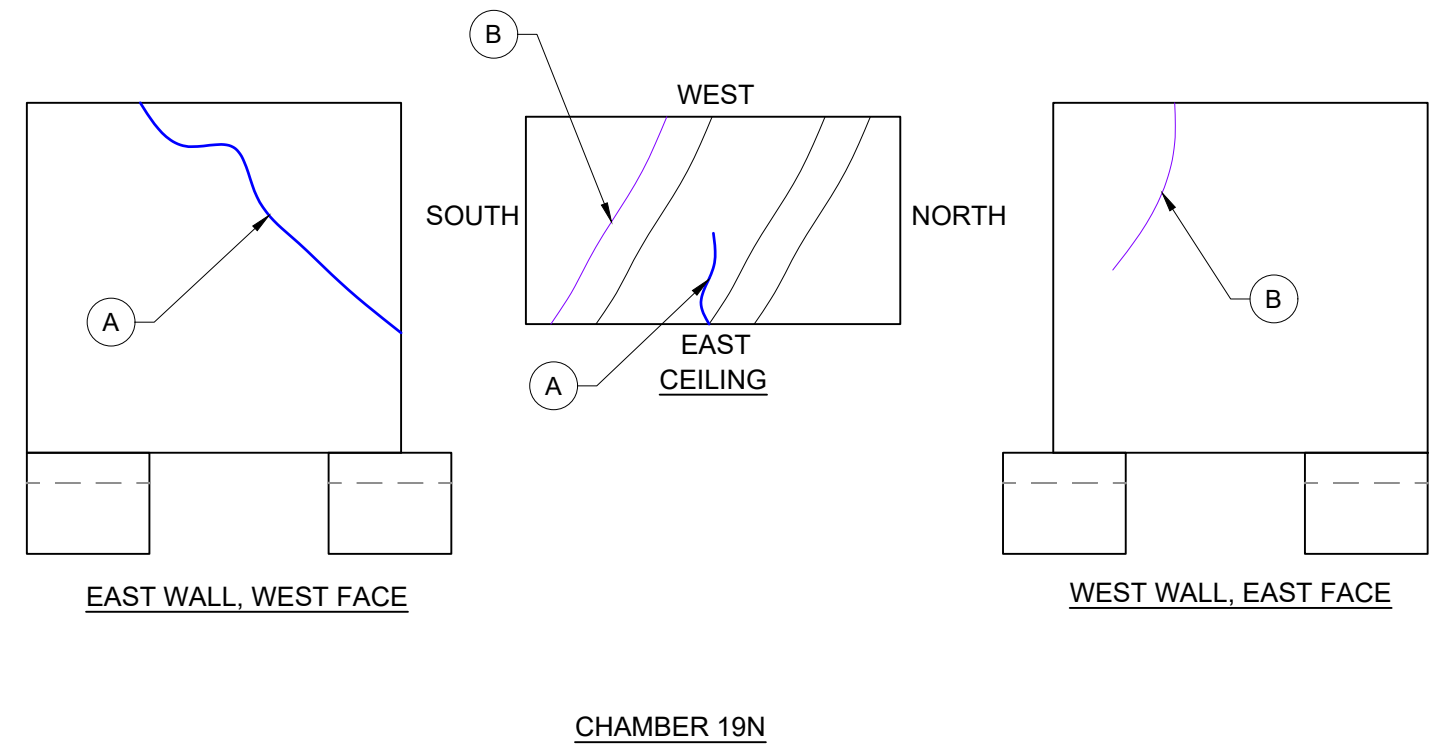

| CALL OUT # | DEFECT DESCRIPTION | PHOTO # |
|------------|---|------------|
| A | Crack with efflorescence, rust and moisture connects to the east wall and extends diagonally downward to the north edge of the east wall. | DWN108-109 |
| B | Diagonal crack full width of ceiling with efflorescence, rust and moisture connecting to the west wal and extends halfway down the west wall. | DWN106-108 |
| C | Diagonal cracks full width of ceiling with efflorescence, rust and moisture. | DWN108 |

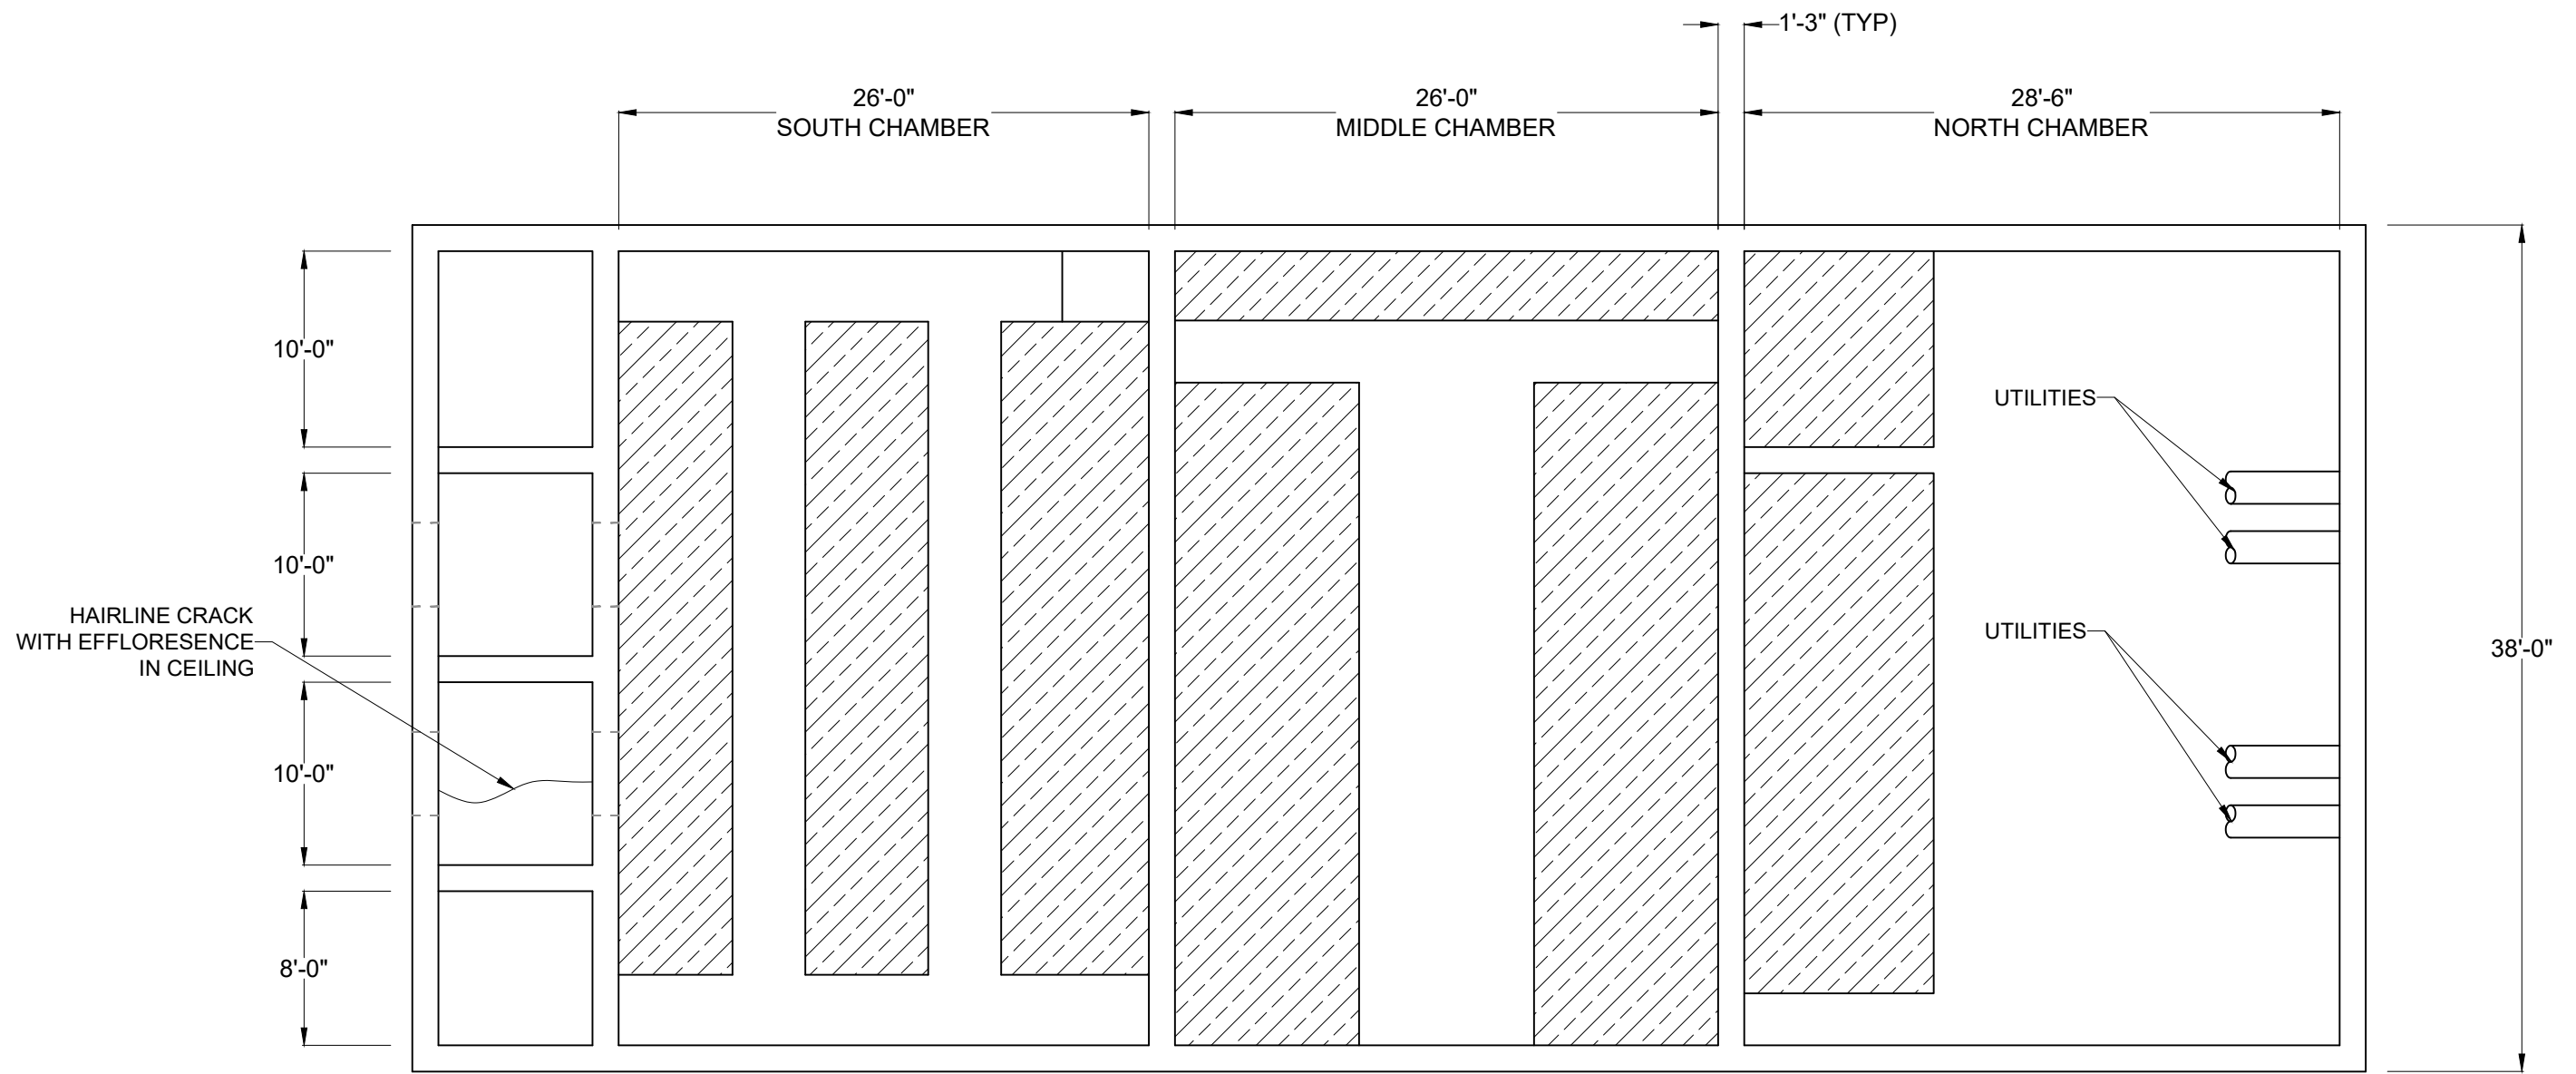


EAST ABUTMENT PLAN


LEGEND

 DEBRIS, CONCRETE AND DIRT


Typical Notes:

1. Exposed rebar and shallow spalls throughout.
2. Exposed rebar ties typically 2'-0" L throughout, sticking out of wall / FBS.
3. If no detail sketch no significant defects were found.
4. Floors are covered with debris, concrete and dirt throughout.


| | | | | |
|-----------------|--------------------|--|---|---------------|
| SCALE:
N.T.S | DATE:
OCT, 2018 | 
INFRASTRUCTURE
ENGINEERS, INC. | Detroit-Superior Bridge
Structure No. CUY-6-1456 | |
| | | | East Abutment Plan | PAGE:
A-14 |

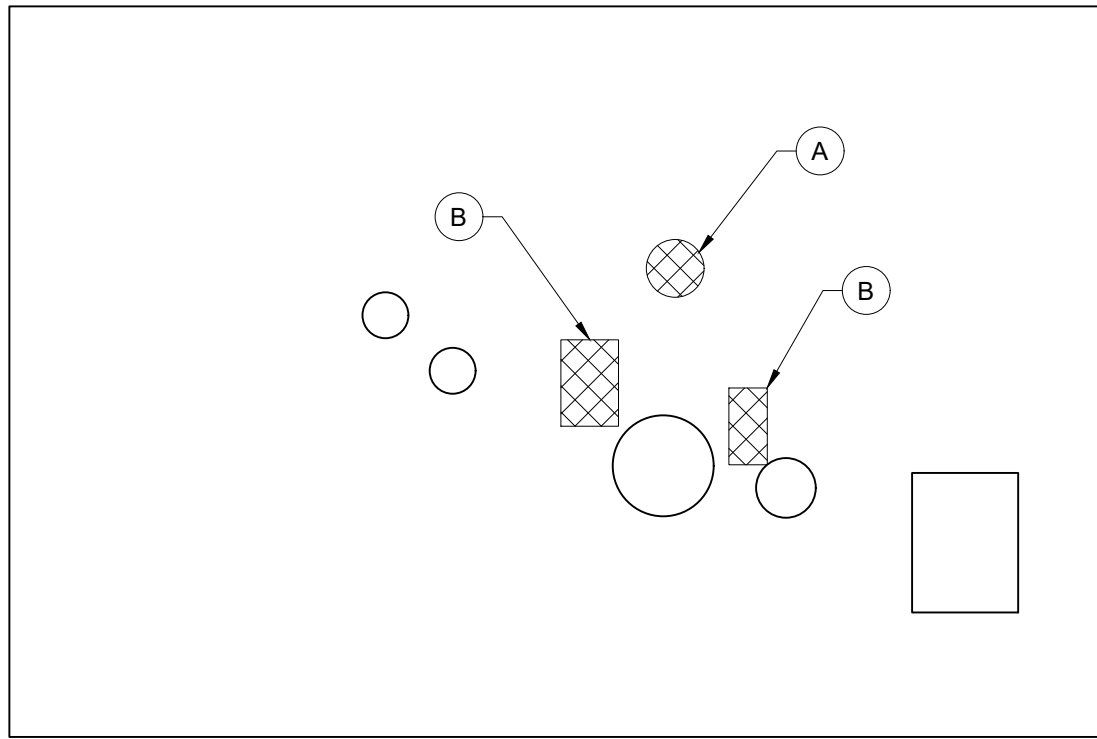

NORTH WALL

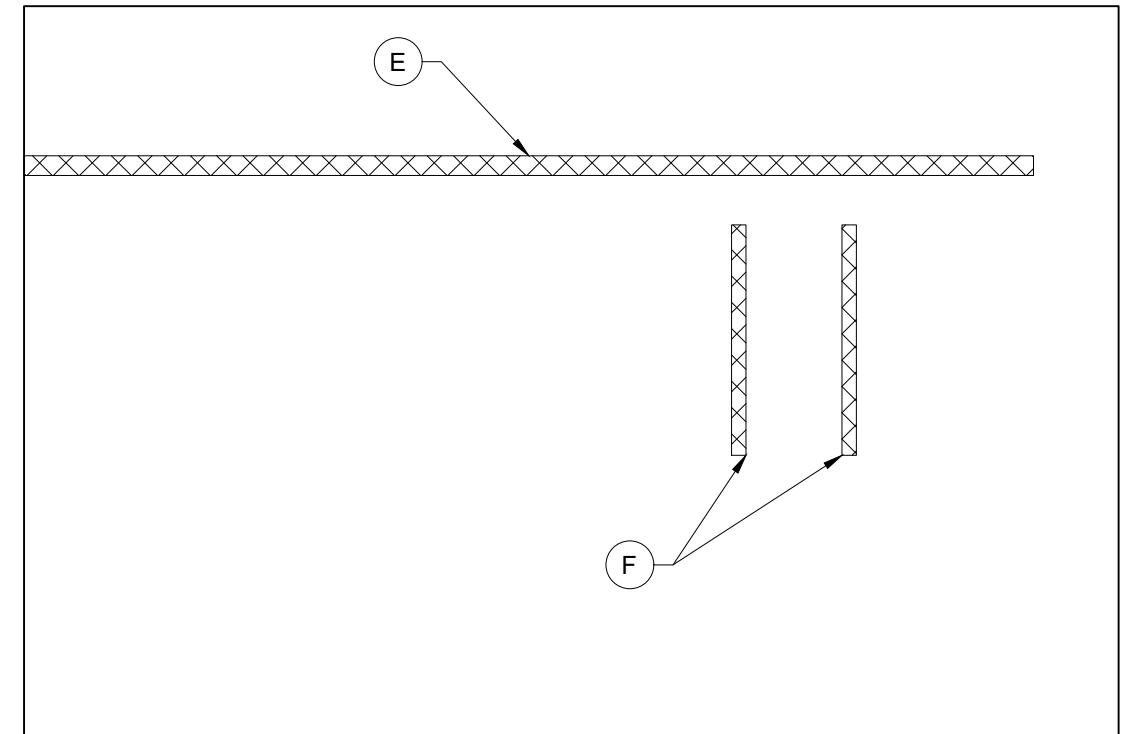

WEST WALL

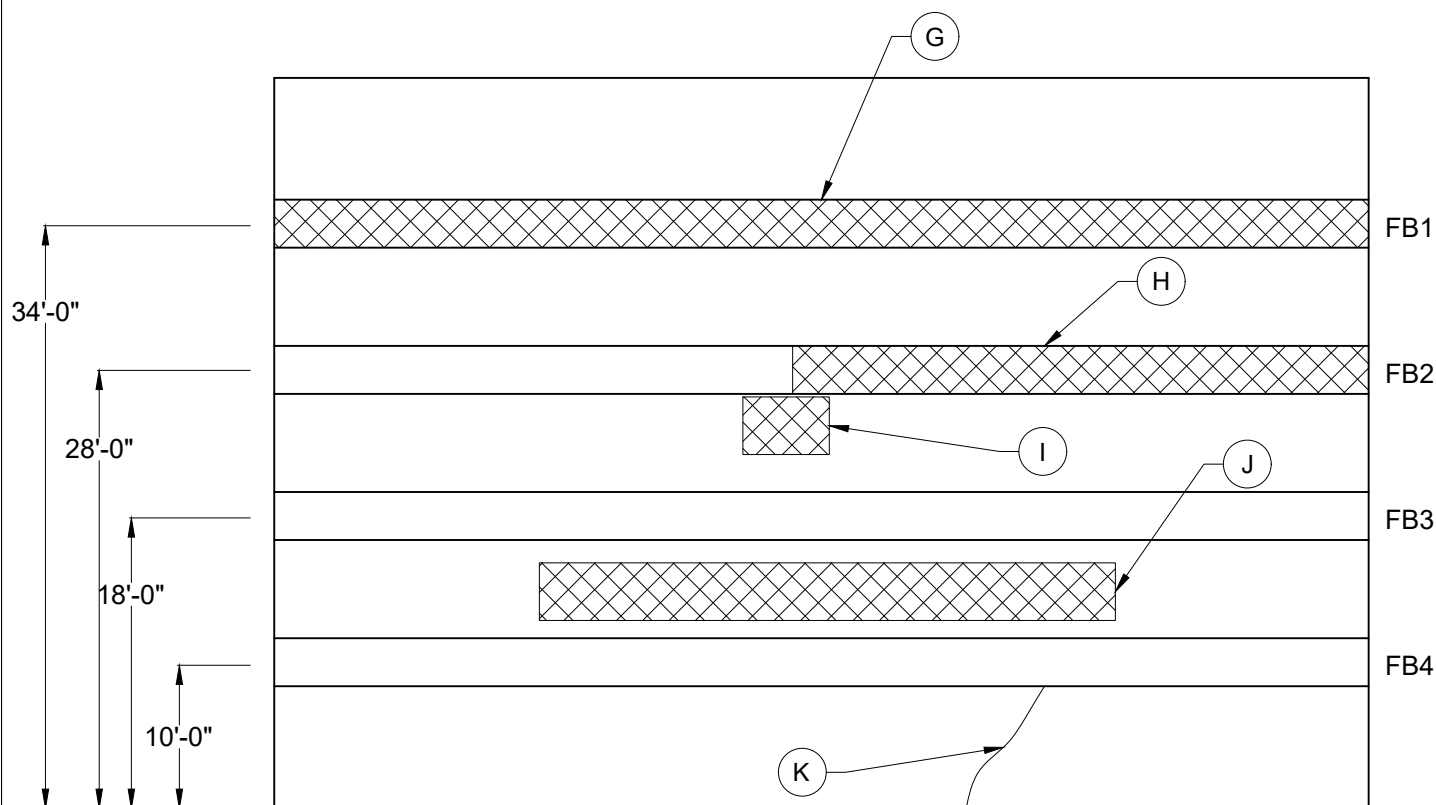

CEILING

NORTH CHAMBER DEFECT TABLE

| CALL OUT # | DEFECT DESCRIPTION | PHOTO # |
|------------|---|---------|
| A | 1'-0" Diameter x 1" D spall. | |
| B | 3'-0" H x 2'-0" W x 2" D spall. | |
| C | 2'-9" H x 1'-4" W x 2-1/2" D spall. | |
| D | (4) abandoned breaker boxes. | |
| E | 8" H x Full width x 4" D spall. | |
| F | (2) 8'-0" H x 6" W x 1" D spall with exposed rebar. | |
| G | Bottom of floorbeam, full length x 8" D spall with exposed rusted rebar. | ADZ638 |
| H | Bottom of floorbeam, 20' L x full width x 4" D with exposed rusted rebar. | ADZ637 |
| I | 2'-0" L x 3'-0" W x 1-1/2" D spall. | |
| J | 20'-0" L x 2'-0" W x 1-1/2" D spall with exposed rebar. | |
| K | Full with crack with efflorescence. | |

SCALE:
N.T.S


DATE:
OCT, 2018




Detroit-Superior Bridge
Structure No. CUY-6-1456


East Abutment - N. Chamber Details

PAGE:
A-15

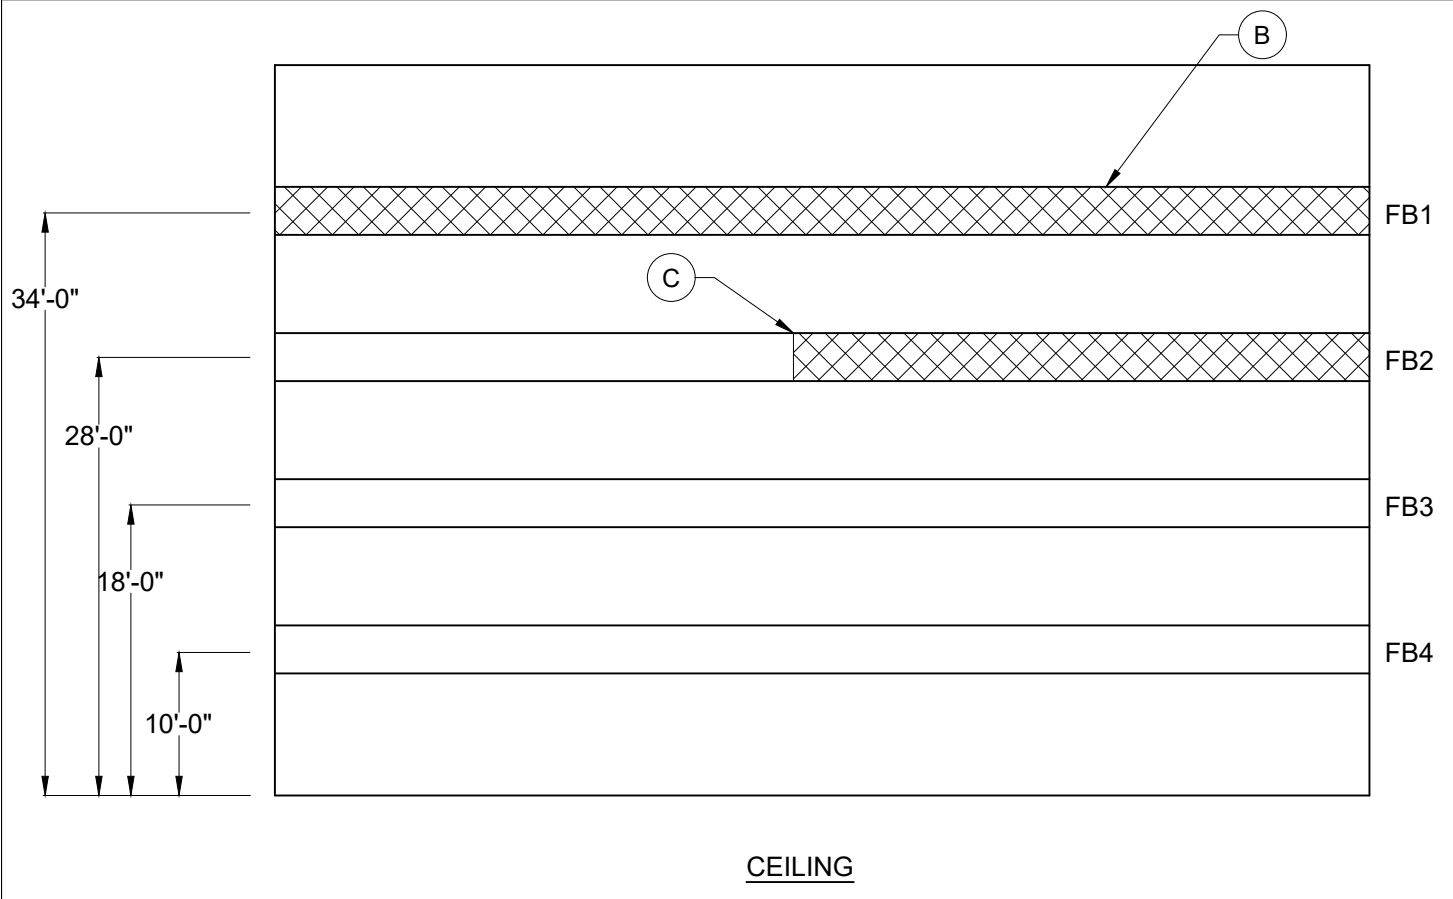


| MIDDLE CHAMBER DEFECT TABLE | | |
|-----------------------------|---|---------|
| CALL OUT # | DEFECT DESCRIPTION | PHOTO # |
| A | 8'-0" L X up to 3'-0" H delamination | |
| B | 2'-0" L x 3'-0" W x 1-1/2" D spall. | |
| C | 20'-0" L x 2'-0" W x 1-1/2" D spall with exposed rebar. | |

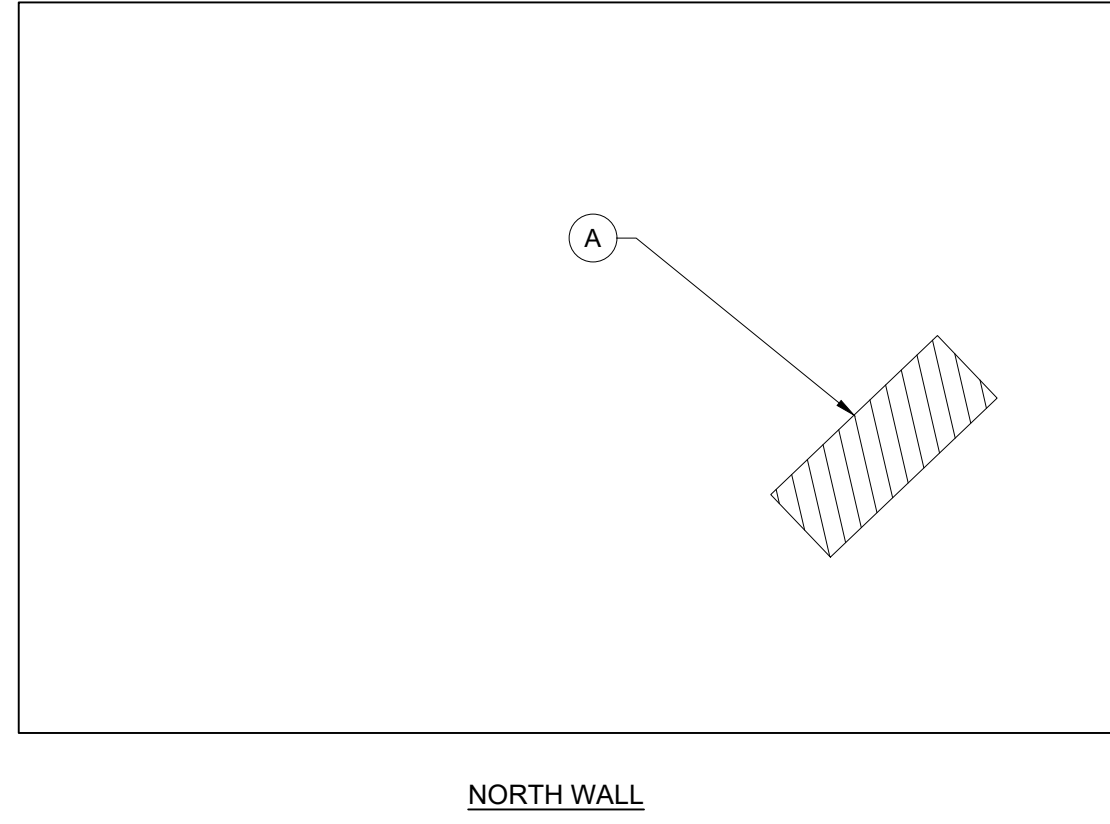


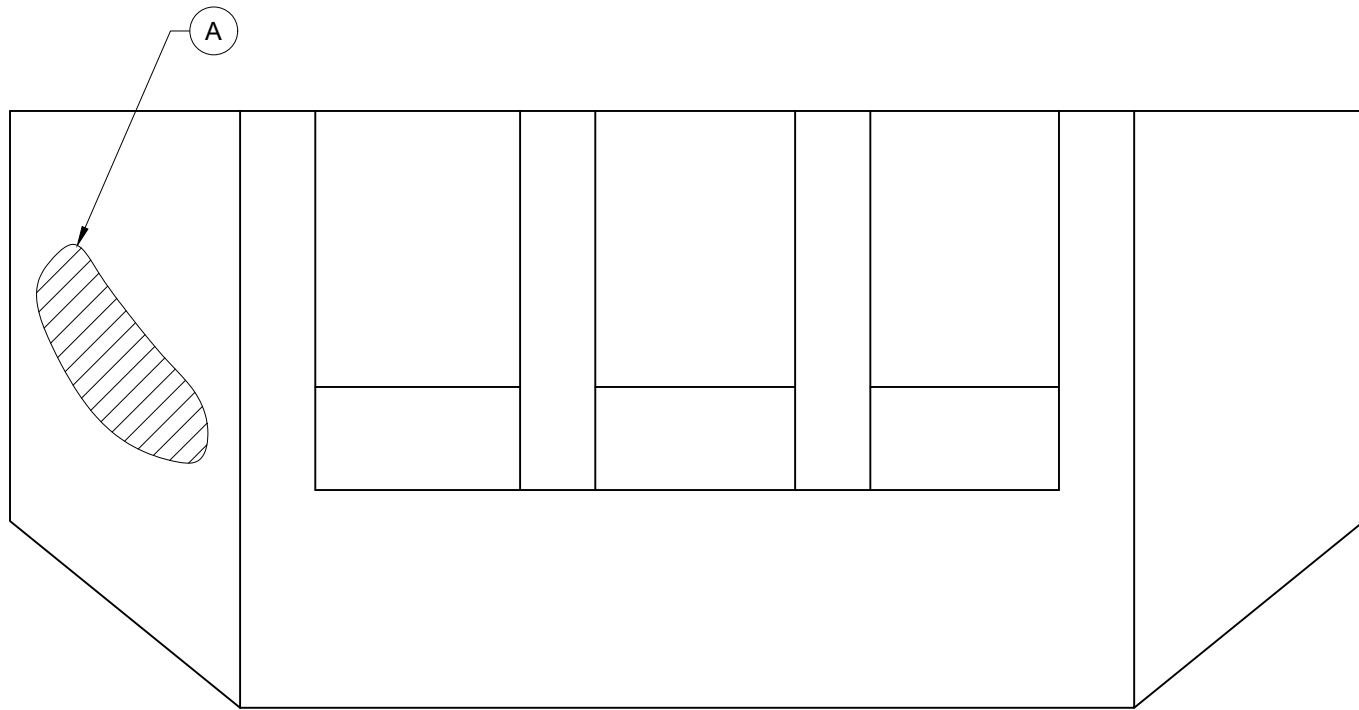

NORTH WALL

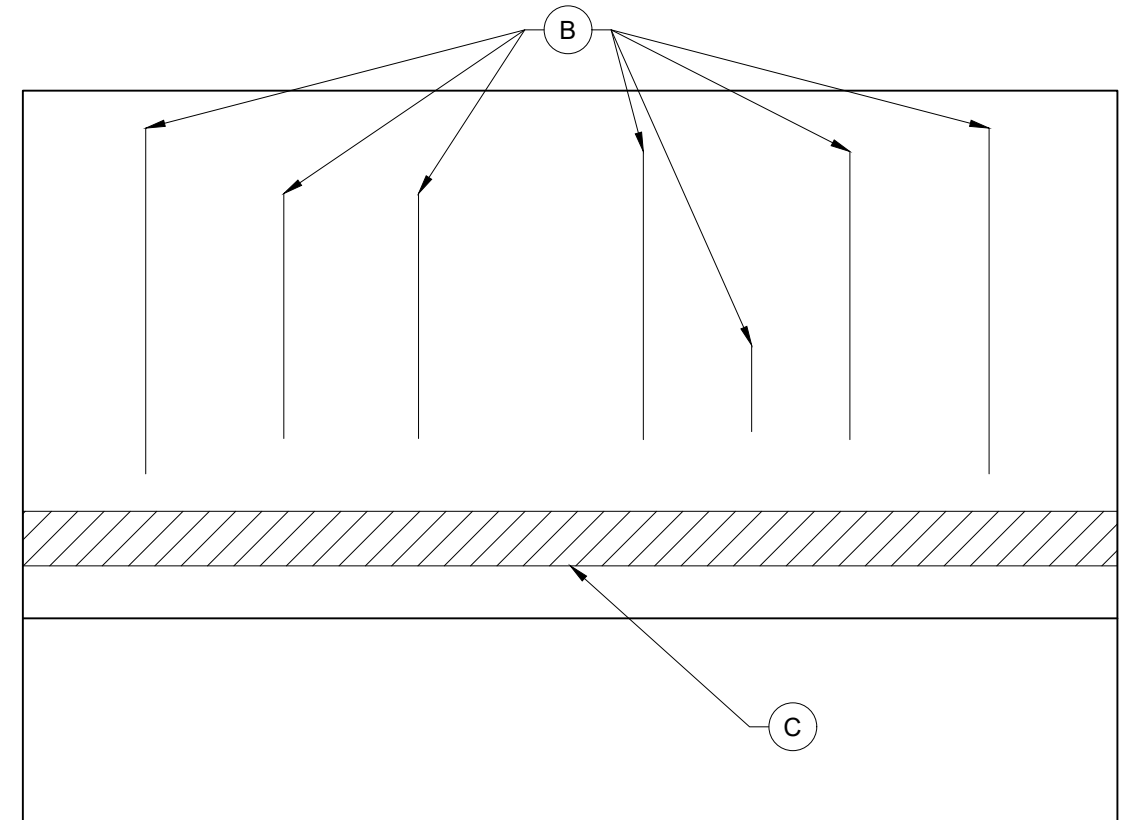

WEST WALL

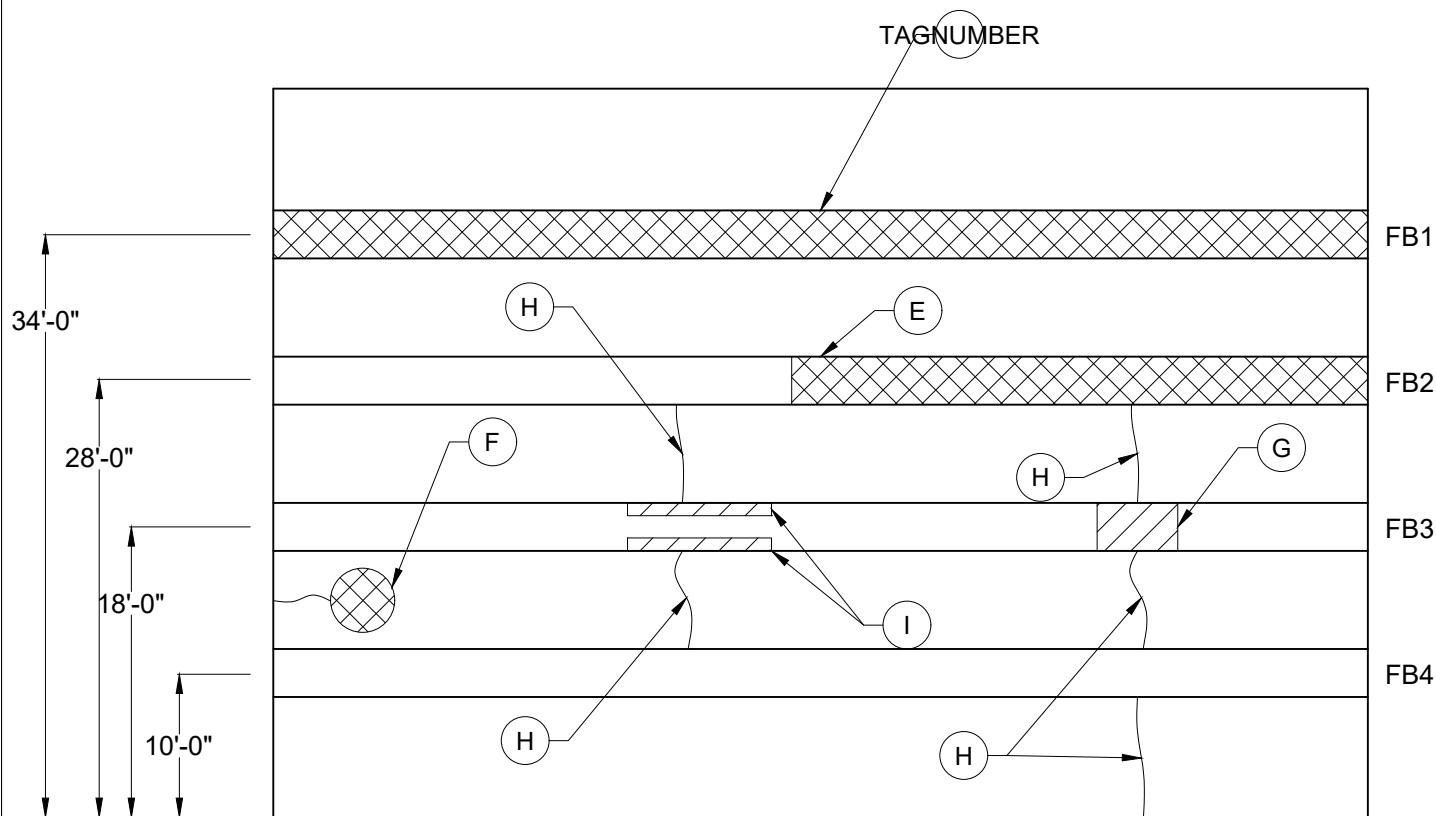

CEILING

SOUTH CHAMBER DEFECT TABLE

| CALL OUT # | DEFECT DESCRIPTION | PHOTO # |
|------------|---|------------|
| A | 20'-0" L x up to 2'-0" H delamination. | ADZ644 |
| B | 3'-0" up to 12'-0" H exposed rebar. | ADZ641-642 |
| C | Full Length x 2'-0" H delamination. | ADZ641-642 |
| D | Bottom of floorbeam, full length x 8" D spall with exposed rusted rebar. | |
| E | Bottom of floorbeam, 20' L x full width x 4" D with exposed rusted rebar. | |
| F | 18" Diameter x 1-1/2" D spall. | |
| G | 3'-0" L x Full Width delamination. | |
| H | Full width hairline cracks with efflorescence | |
| I | 5'-0" L x up to 3'-0" H delamination. | |

SCALE:
N.T.S

DATE:
OCT, 2018



Detroit-Superior Bridge
Structure No. CUY-6-1456

East Abutment - S. Chamber Details

PAGE:
A-17