
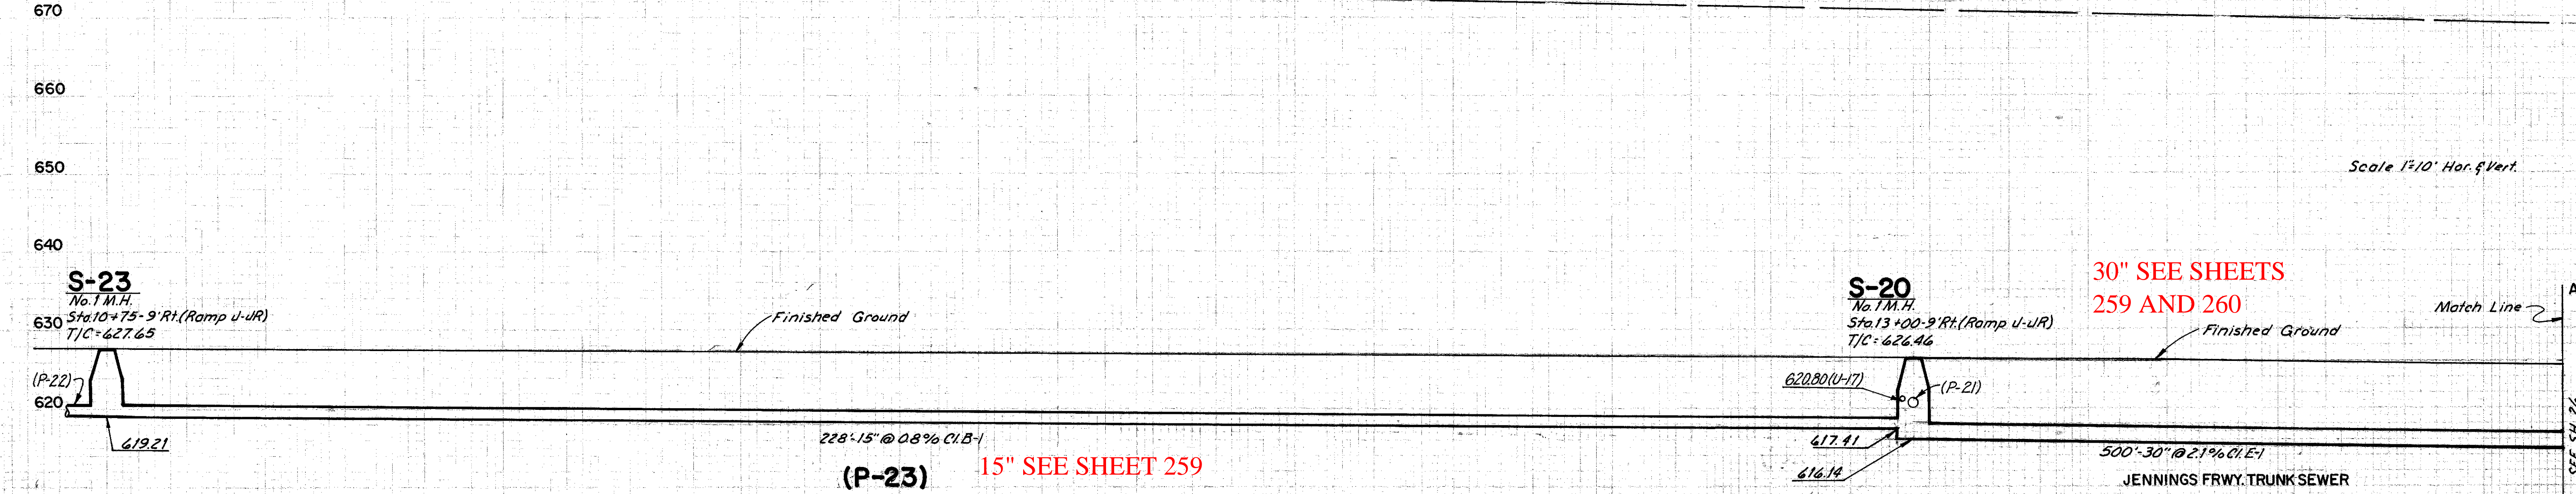
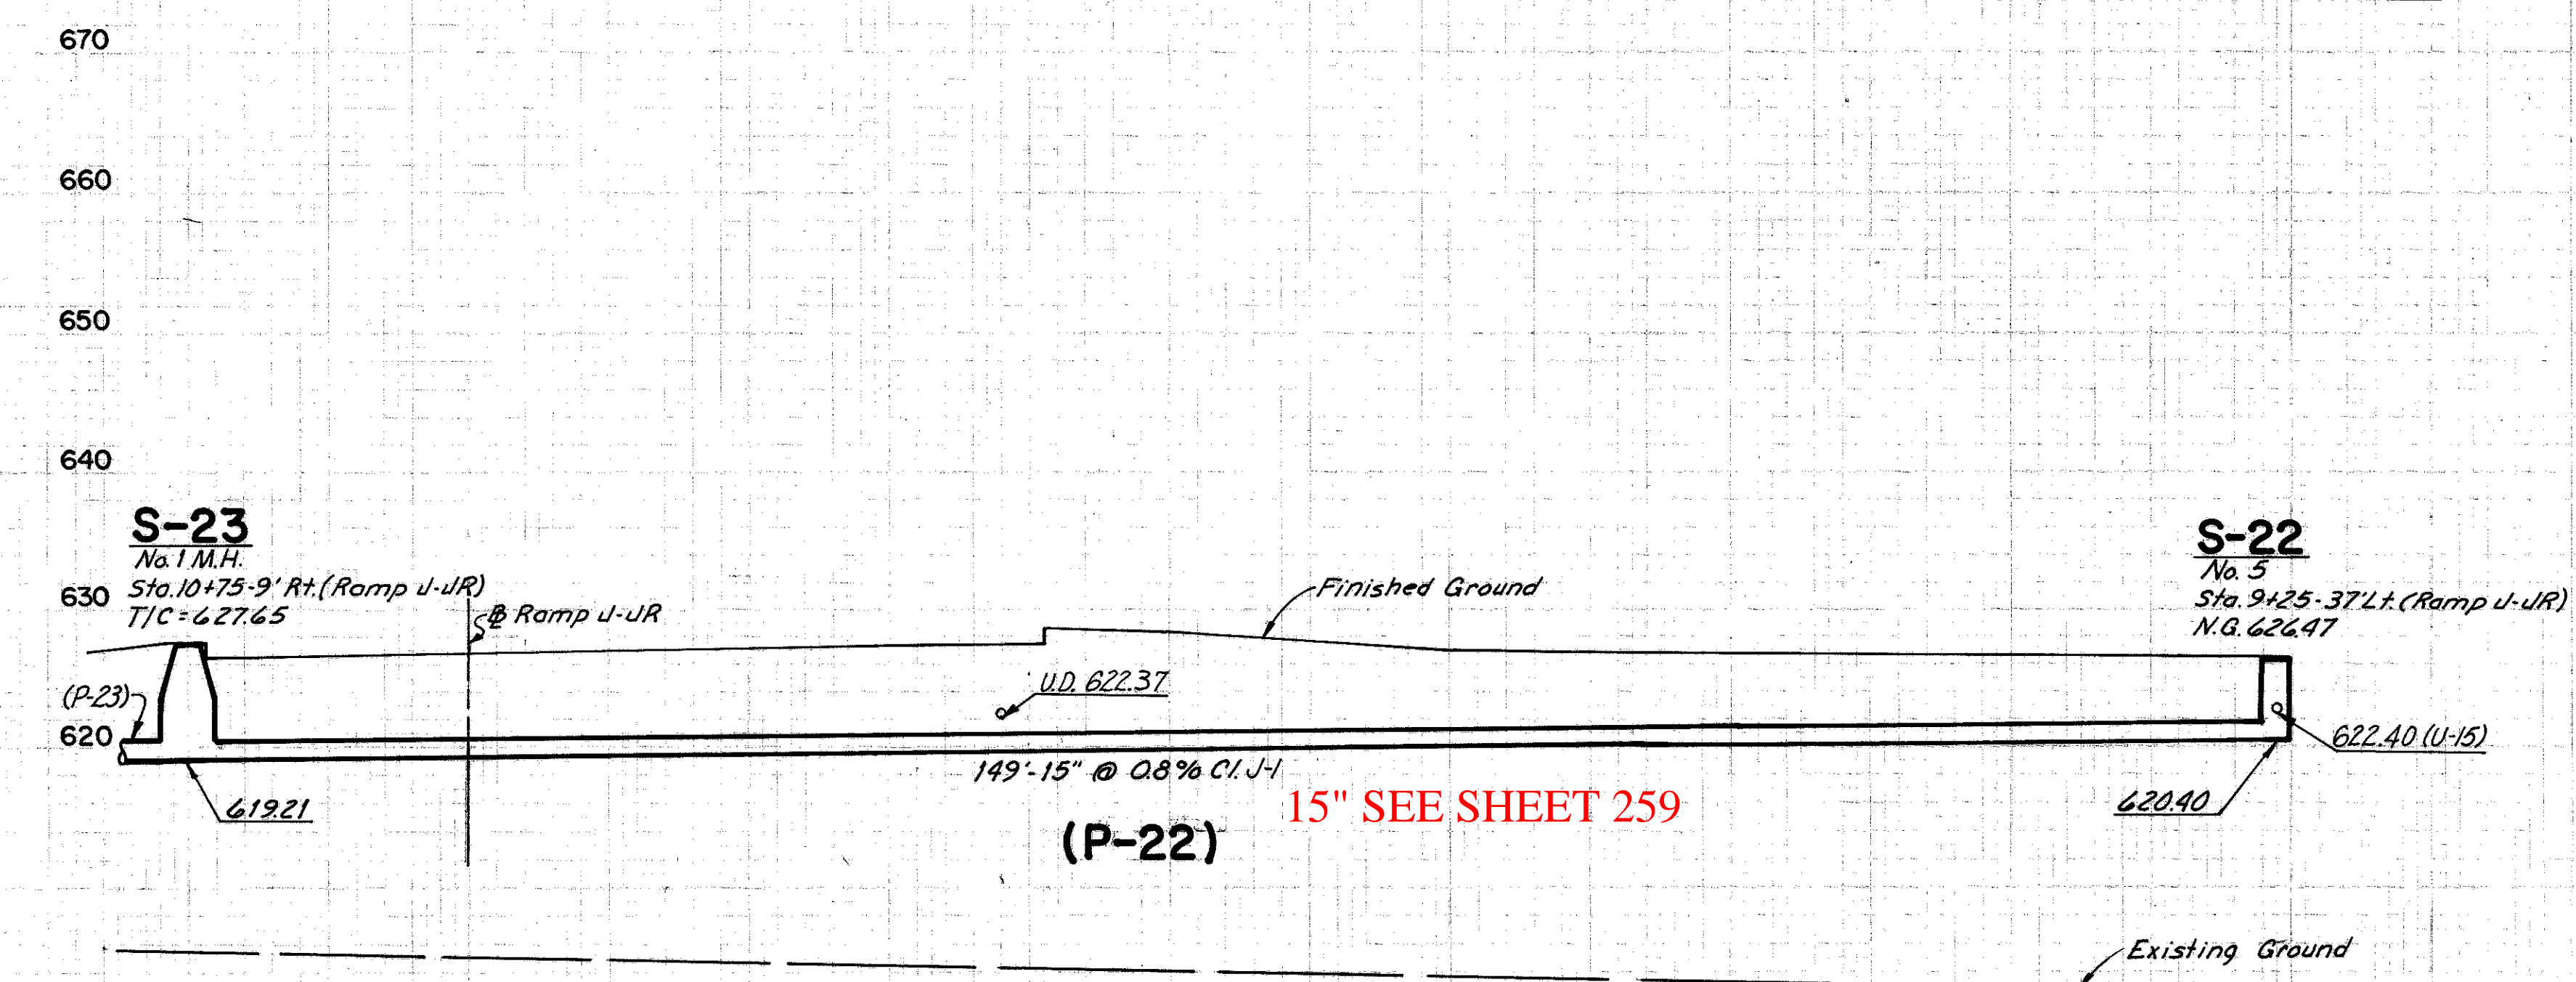


FED. RD. DIVISION	STATE	PROJECT
2	OHIO	

276
646

CUYAHOGA COUNTY
CUY-71-17.83
CUY-176-12.76

25
54

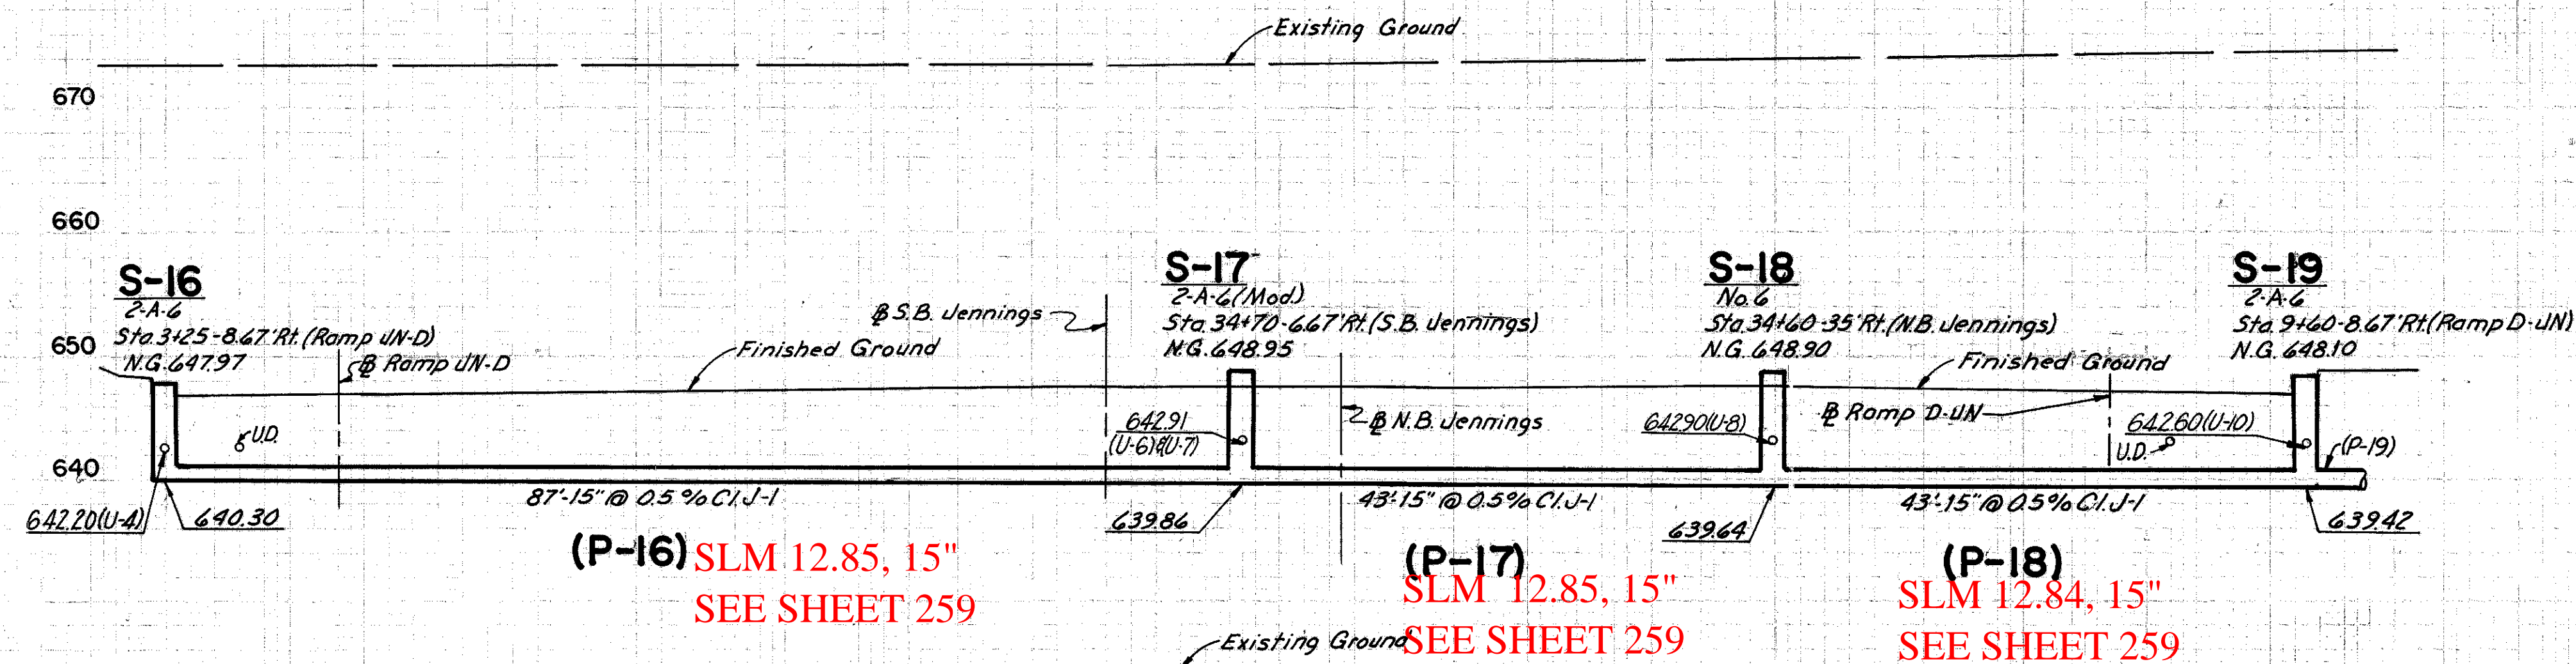

HOWARD, NEEDLES, TAMMEN & BERGENDOFF
CONSULTING ENGINEERS
KANSAS CITY CLEVELAND NEW YORK

(P-24)

P-19 to P-21 SEE SH. 24

R.D.J. 8-13-64
U.M.D. 10-19-64