

FED. RD. DIVISION	STATE	PROJECT
2	OHIO	



282  
646

CUYAHOGA COUNTY  
CUY-71-17.83  
CUY-176-12.76


31  
54

S-71

No. 2 M.H. (Mod) as per General Notes  
Sta. 50+50-43.5' Rt.  
(N.B. Jennings)  
TIC=641.42

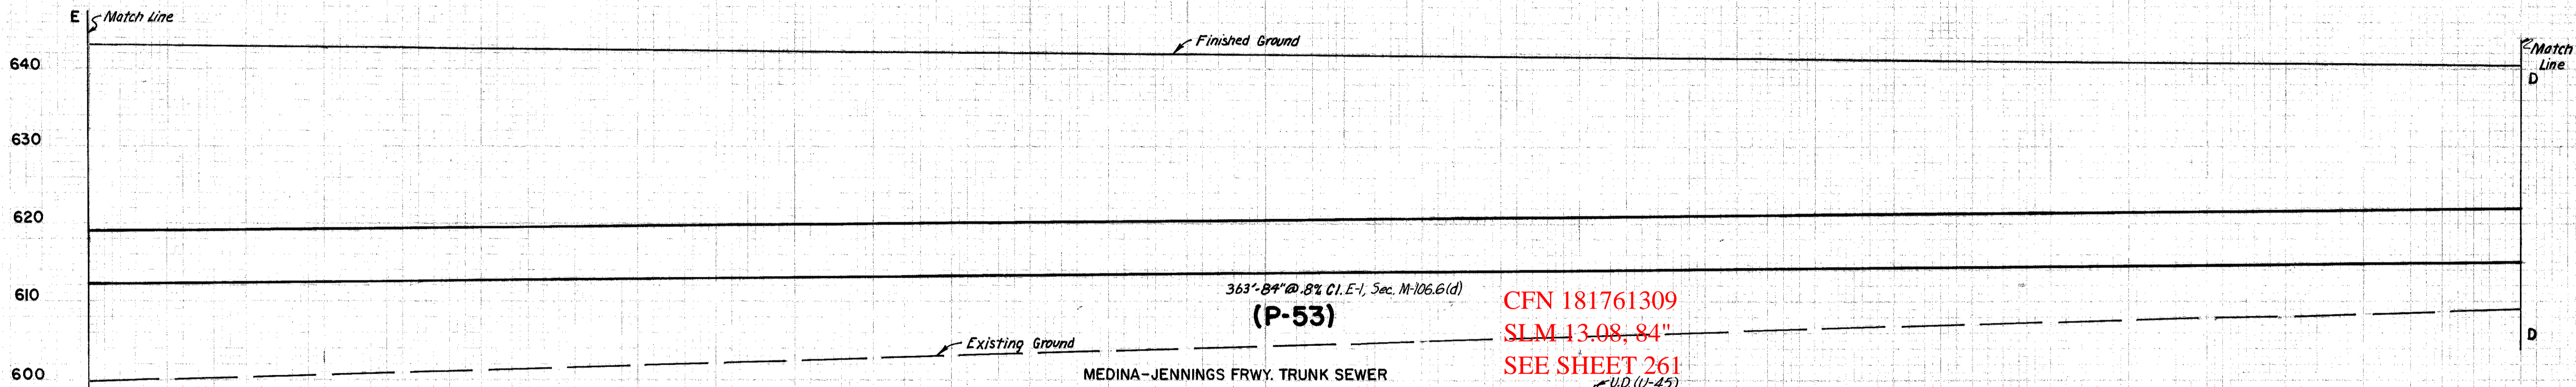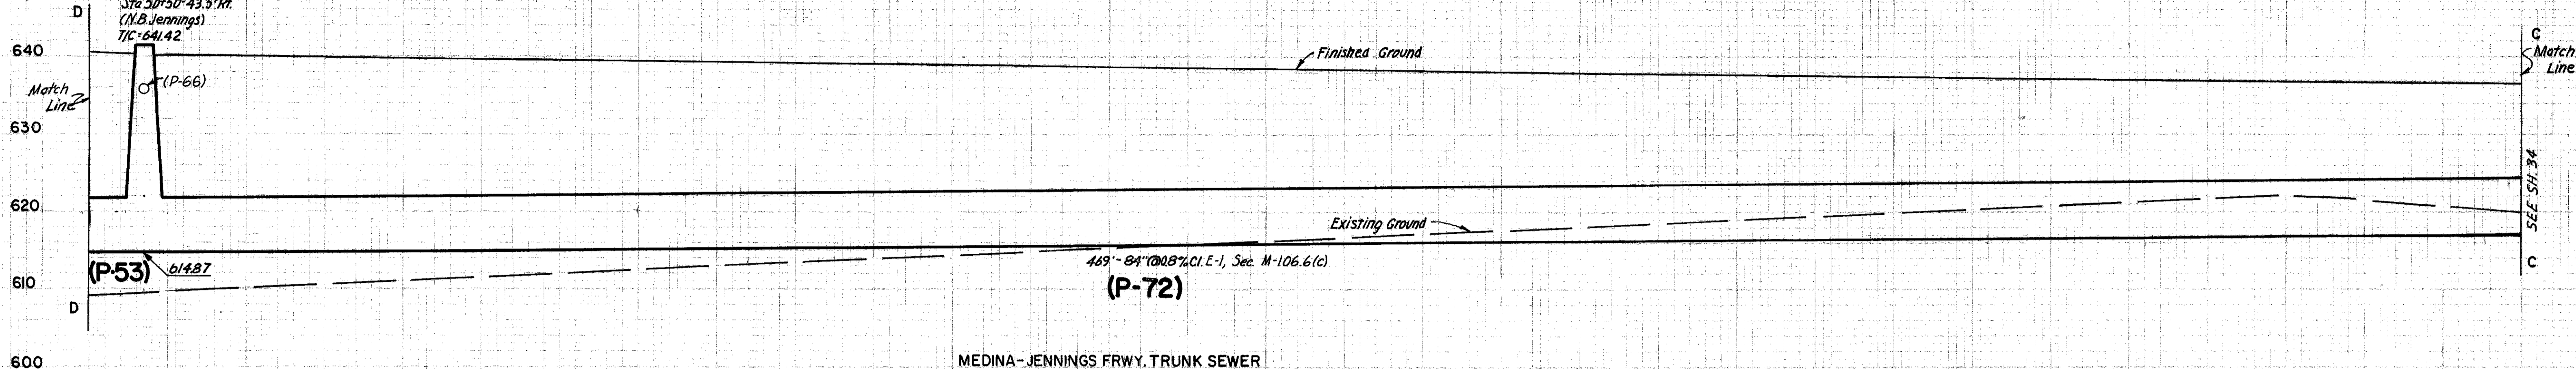

CFN 181761309  
SLM 13.08, 84"  
SEE SHEET 261  
U.D. (U-45)

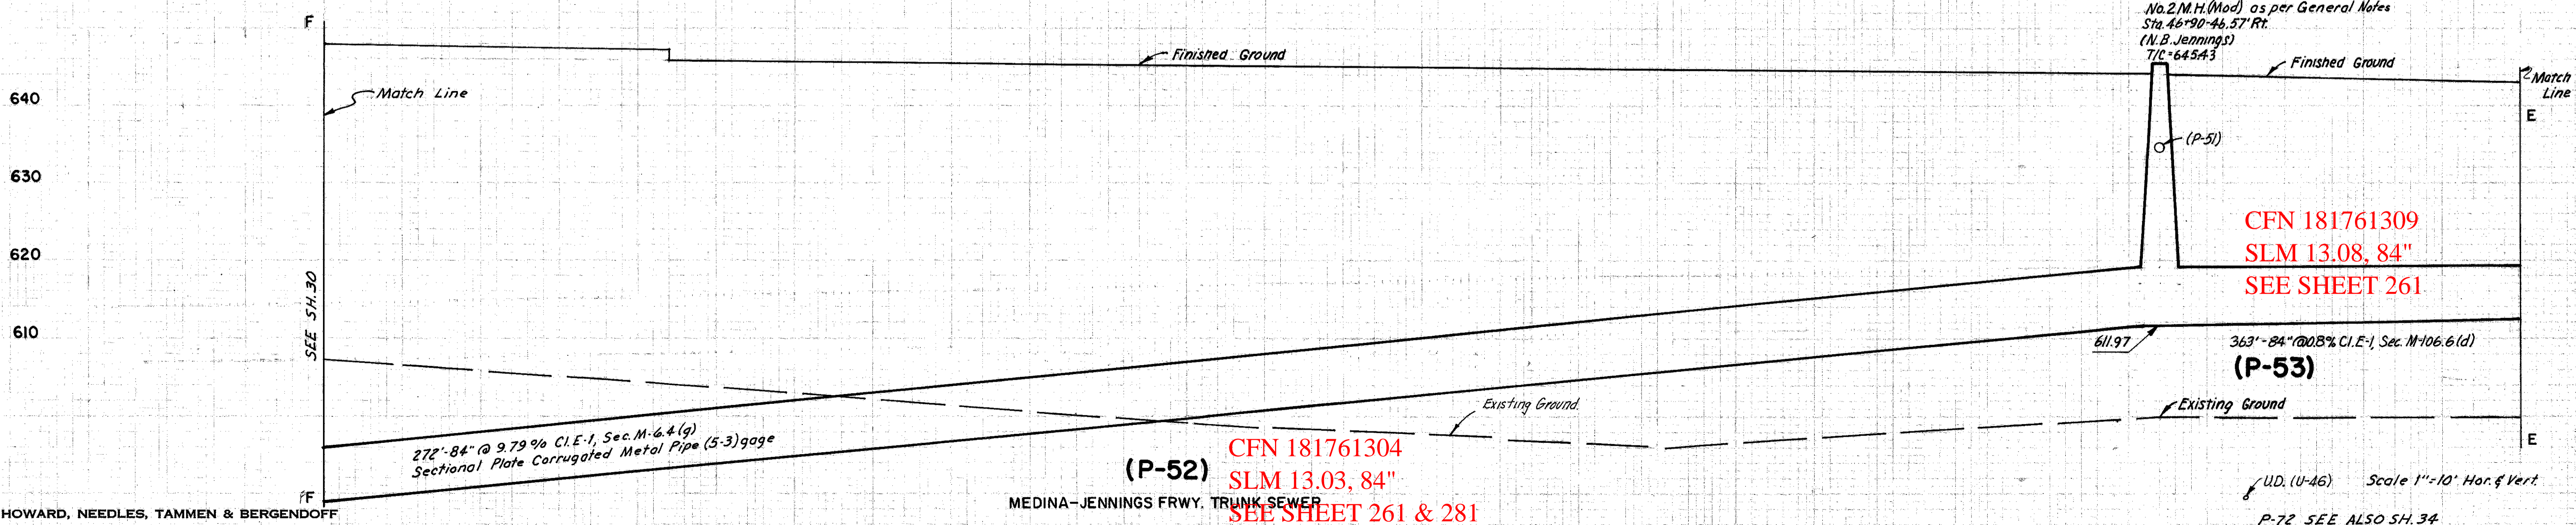

CFN 181761304  
SLM 13.03, 84"  
SEE SHEET 261 & 281  
U.D. (U-46)

Scale 1"=10' Hor. & Vert.  
P-72 SEE ALSO SH. 34

HOWARD, NEEDLES, TAMMEN & BERGENDOFF  
CONSULTING ENGINEERS  
KANSAS CITY CLEVELAND NEW YORK