

**DRAINAGE LEGEND**


- PROPOSED STORM SEWER MANHOLE
- PROPOSED SANITARY MANHOLE
- PROPOSED PAVED SHOULDER INLET, MEDIAN INLET, & PAVEMENT INLET
- PROPOSED DITCH CATCH BASIN
- PROPOSED PAVEMENT CATCH BASIN
- PROPOSED STORM SEWER
- PROPOSED SANITARY SEWER
- EXISTING MANHOLE
- EXISTING CATCH BASIN
- EXISTING STORM OR SANITARY SEWER
- ▨ JUTE MATTING
- ▨ PAVED GUTTER
- ▨ SODDED DITCH
- EXISTING SEWER TO BE ABANDONED
- EXISTING HOUSE CONNECTIONS TO BE PLUGGED & ABANDONED
- ..... PROPOSED UNDERDRAINS

\* See General Note Sheet No. 19  
"RECONNECTION OF EXISTING HOUSE CONNECTIONS"

FED. RD.	STATE	PROJECT
2	OHIO	

55  
540

CUYAHOGA COUNTY  
CUY - 90 - 8.34

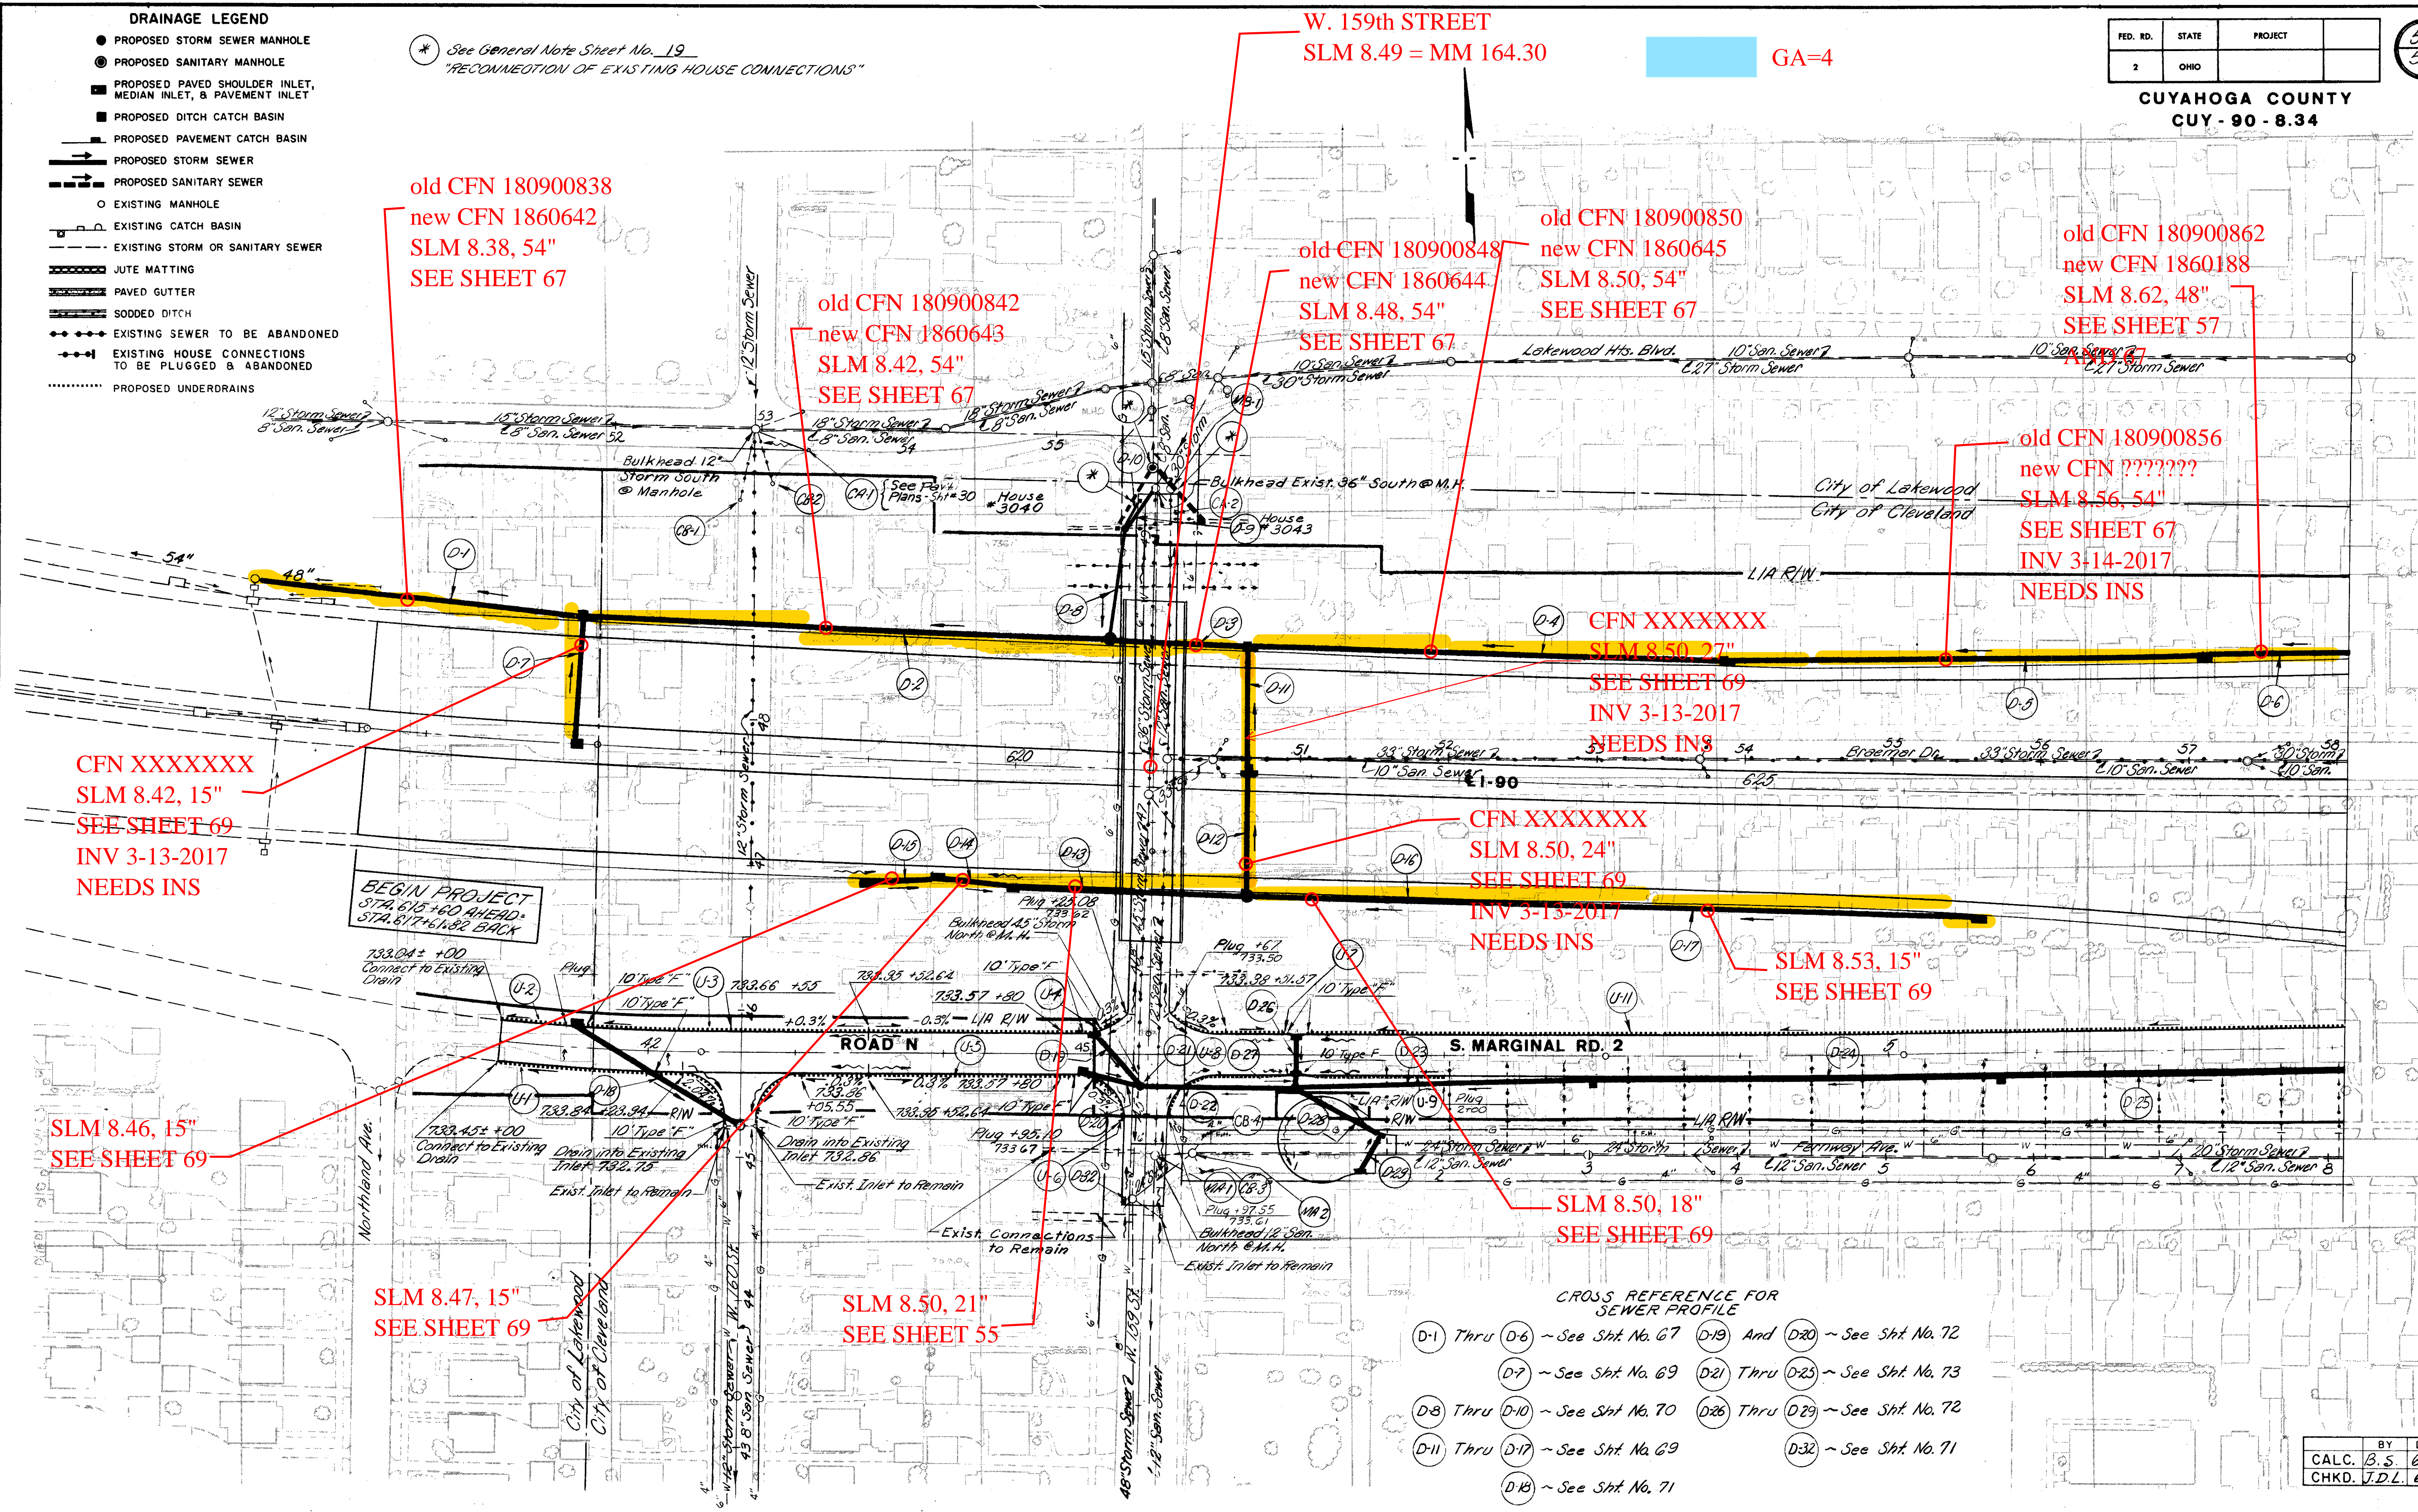

old CFN 180900838  
new CFN 1860642  
SLM 8.38, 54"  
SEE SHEET 67

old CFN 180900842  
new CFN 1860643  
SLM 8.42, 54"  
SEE SHEET 67

old CFN 180900848  
new CFN 1860644  
SLM 8.48, 54"  
SEE SHEET 67

old CFN 180900850  
new CFN 1860645  
SLM 8.50, 54"  
SEE SHEET 67

old CFN 180900862  
new CFN 1860188  
SLM 8.62, 48"  
SEE SHEET 57

old CFN 180900856  
new CFN ???????  
SLM 8.56, 54"  
SEE SHEET 67  
INV 3-14-2017  
NEEDS INS

CFN XXXXXXX  
SLM 8.50, 27"  
SEE SHEET 69  
INV 3-13-2017  
NEEDS INS

CFN XXXXXXX  
SLM 8.50, 24"  
SEE SHEET 69  
INV 3-13-2017  
NEEDS INS

SLM 8.53, 15"  
SEE SHEET 69

CFN XXXXXXX  
SLM 8.42, 15"  
SEE SHEET 69  
INV 3-13-2017  
NEEDS INS

SLM 8.46, 15"  
SEE SHEET 69

SLM 8.47, 15"  
SEE SHEET 69

SLM 8.50, 21"  
SEE SHEET 55

SLM 8.50, 18"  
SEE SHEET 69

- CROSS REFERENCE FOR SEWER PROFILE
- D-1 Thru ○ D-6 ~ See Sht. No. 67    ○ D-19 And ○ D-20 ~ See Sht. No. 72
  - D-7 ~ See Sht. No. 69    ○ D-21 Thru ○ D-25 ~ See Sht. No. 73
  - D-8 Thru ○ D-10 ~ See Sht. No. 70    ○ D-26 Thru ○ D-29 ~ See Sht. No. 72
  - D-11 Thru ○ D-17 ~ See Sht. No. 69    ○ D-32 ~ See Sht. No. 71
  - D-18 ~ See Sht. No. 71

BY	DATE
CALC. B.S.	6/73
CHKD. J.D.L.	6/73