
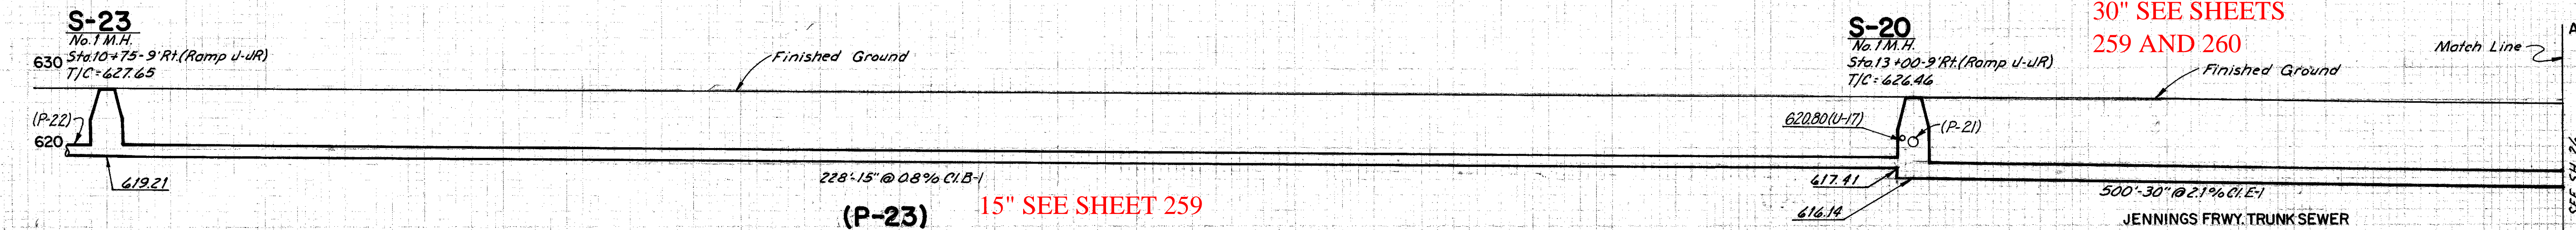
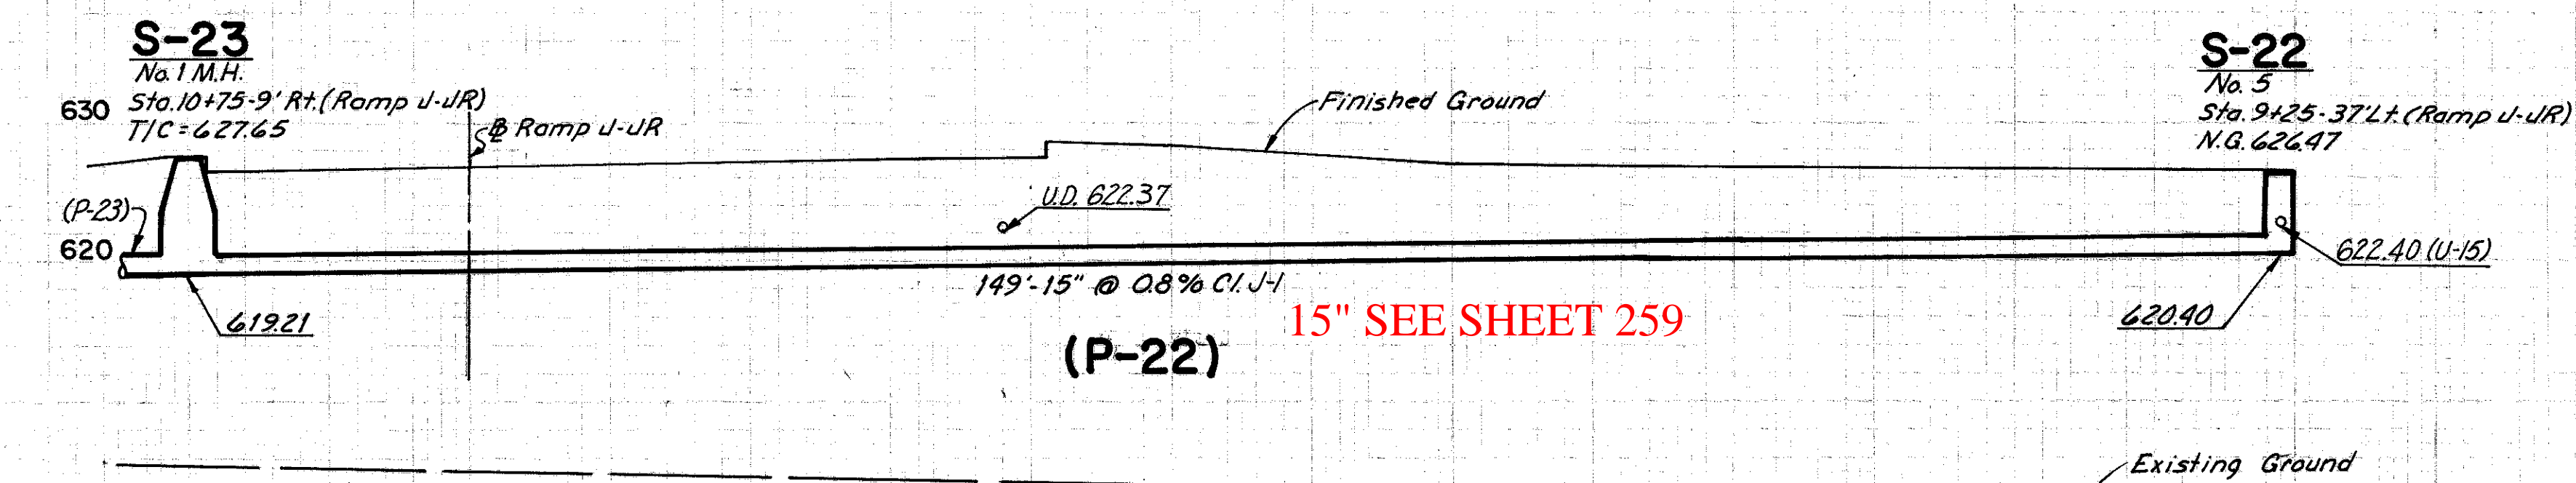


FED. RD. DIVISION	STATE	PROJECT
2	OHIO	

276
646

CUYAHOGA COUNTY
CUY-71-17.83
CUY-176-12.76

25
54

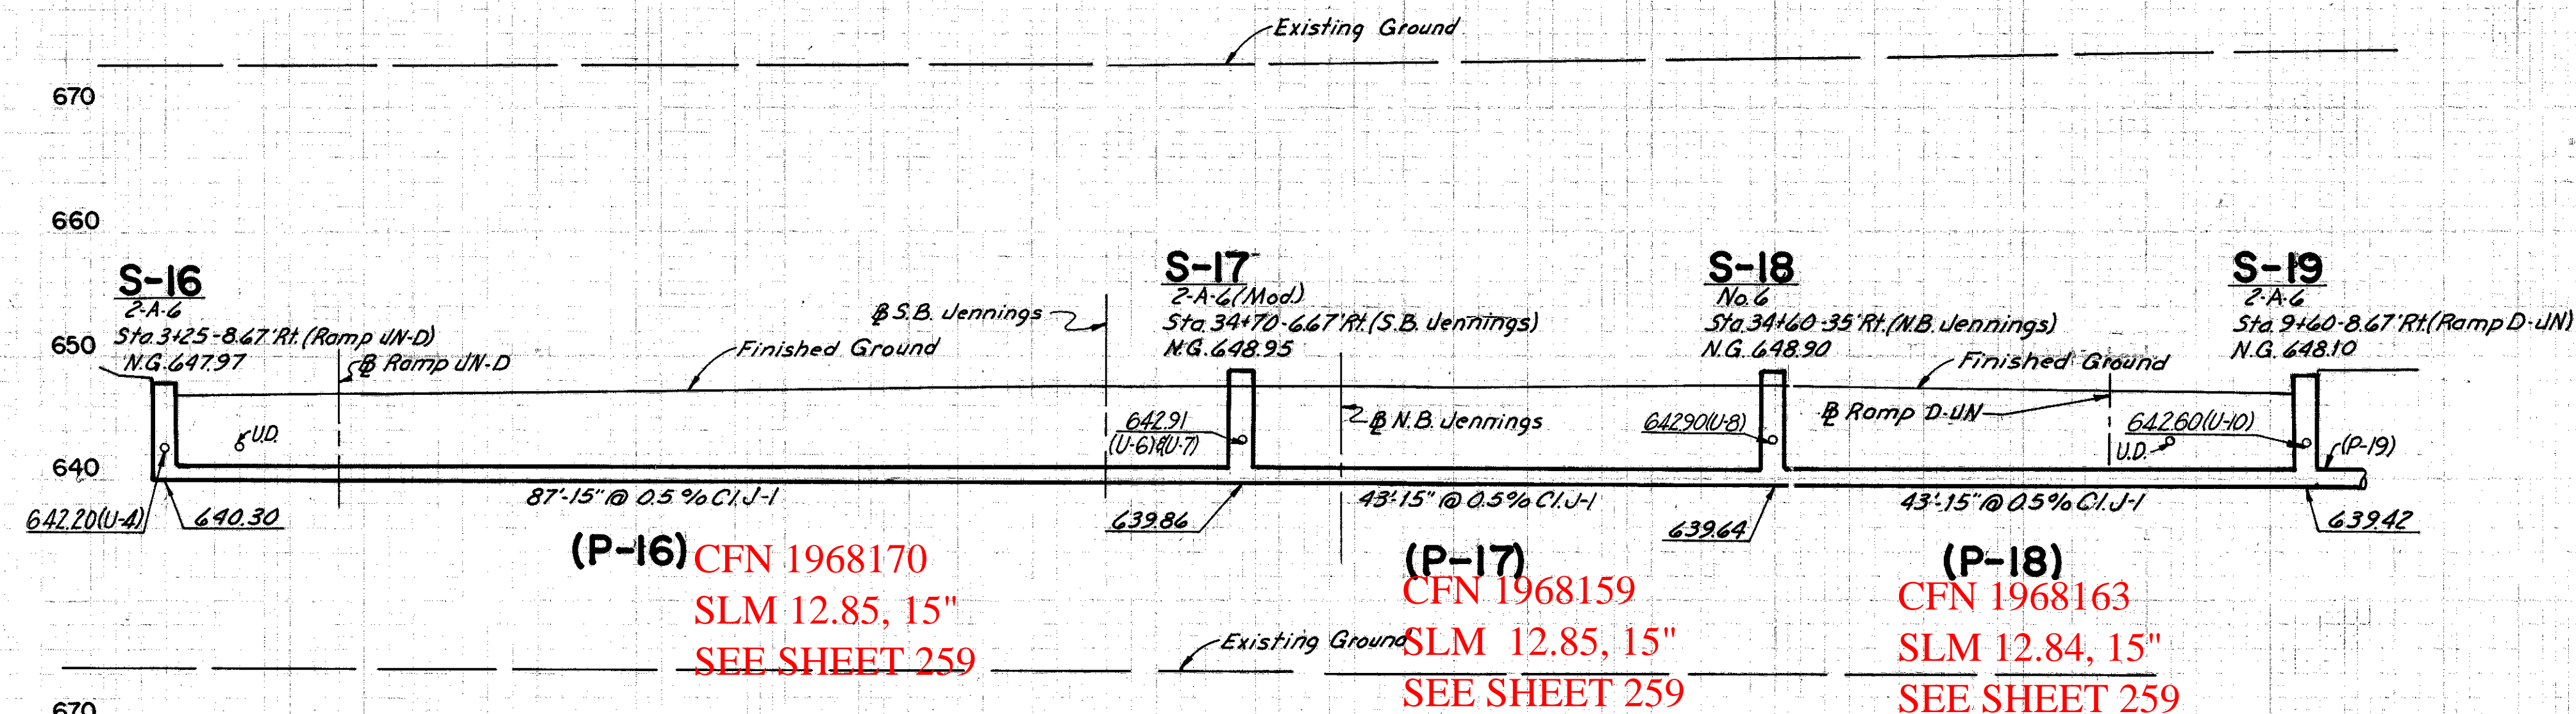

30" SEE SHEETS
259 AND 260

Scale 1"=10' Hor. & Vert.

HOWARD, NEEDLES, TAMMEN & BERGENDOFF
CONSULTING ENGINEERS
KANSAS CITY CLEVELAND NEW YORK

JENNINGS FRWY. TRUNK SEWER
(P-24)
P-19 to P-21 SEE SH. 24

R.D.J. 8-13-64
U.M.D. 10-19-64