


BENCH MARK: T&M 78-TOPOG. DRILL HOLE IN NE COR. 1/2" RAD. 18" N. 3" W. OF S.W. COR. BLDG. 115-4660 HINGKLEY IND. PARKWAY ELEV = 719.90

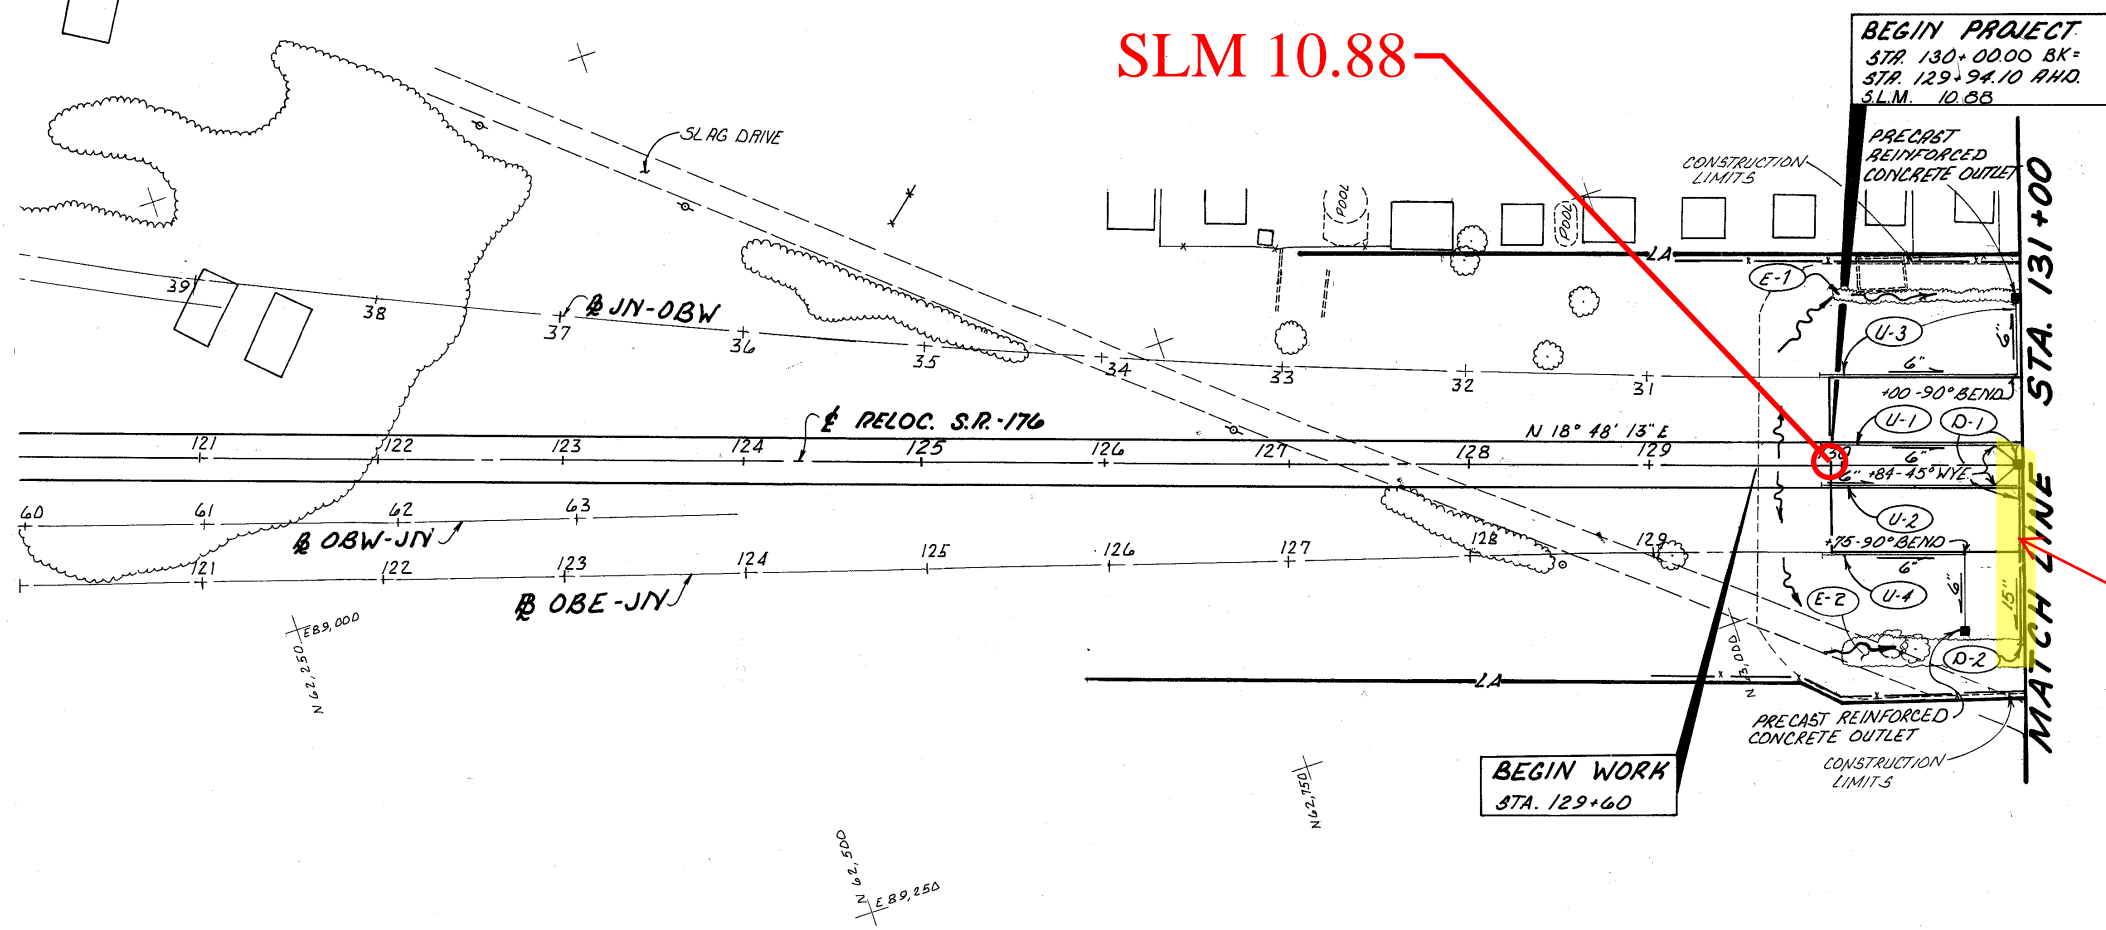

DRAINAGE STRUCTURE DATA


- (D-1) STA 131+00, 6" INLET
N^o 38.50, TIG 713.49
- (D-2) STA 131+00, 100' AT.
HW-4B

CFN 1968043
SLM 10.90, 15"
SEE SHEET 81

REFERENCES SHEET NUMBERS

QUANTITIES FOR REFERENCED ITEMS . . . 57

| SEWER PROFILES | SHEET NUMBERS |
|----------------|---------------|
| D-1 & D-2 | 81 |
| U-3 | 81 |
| U-4 | 81 |

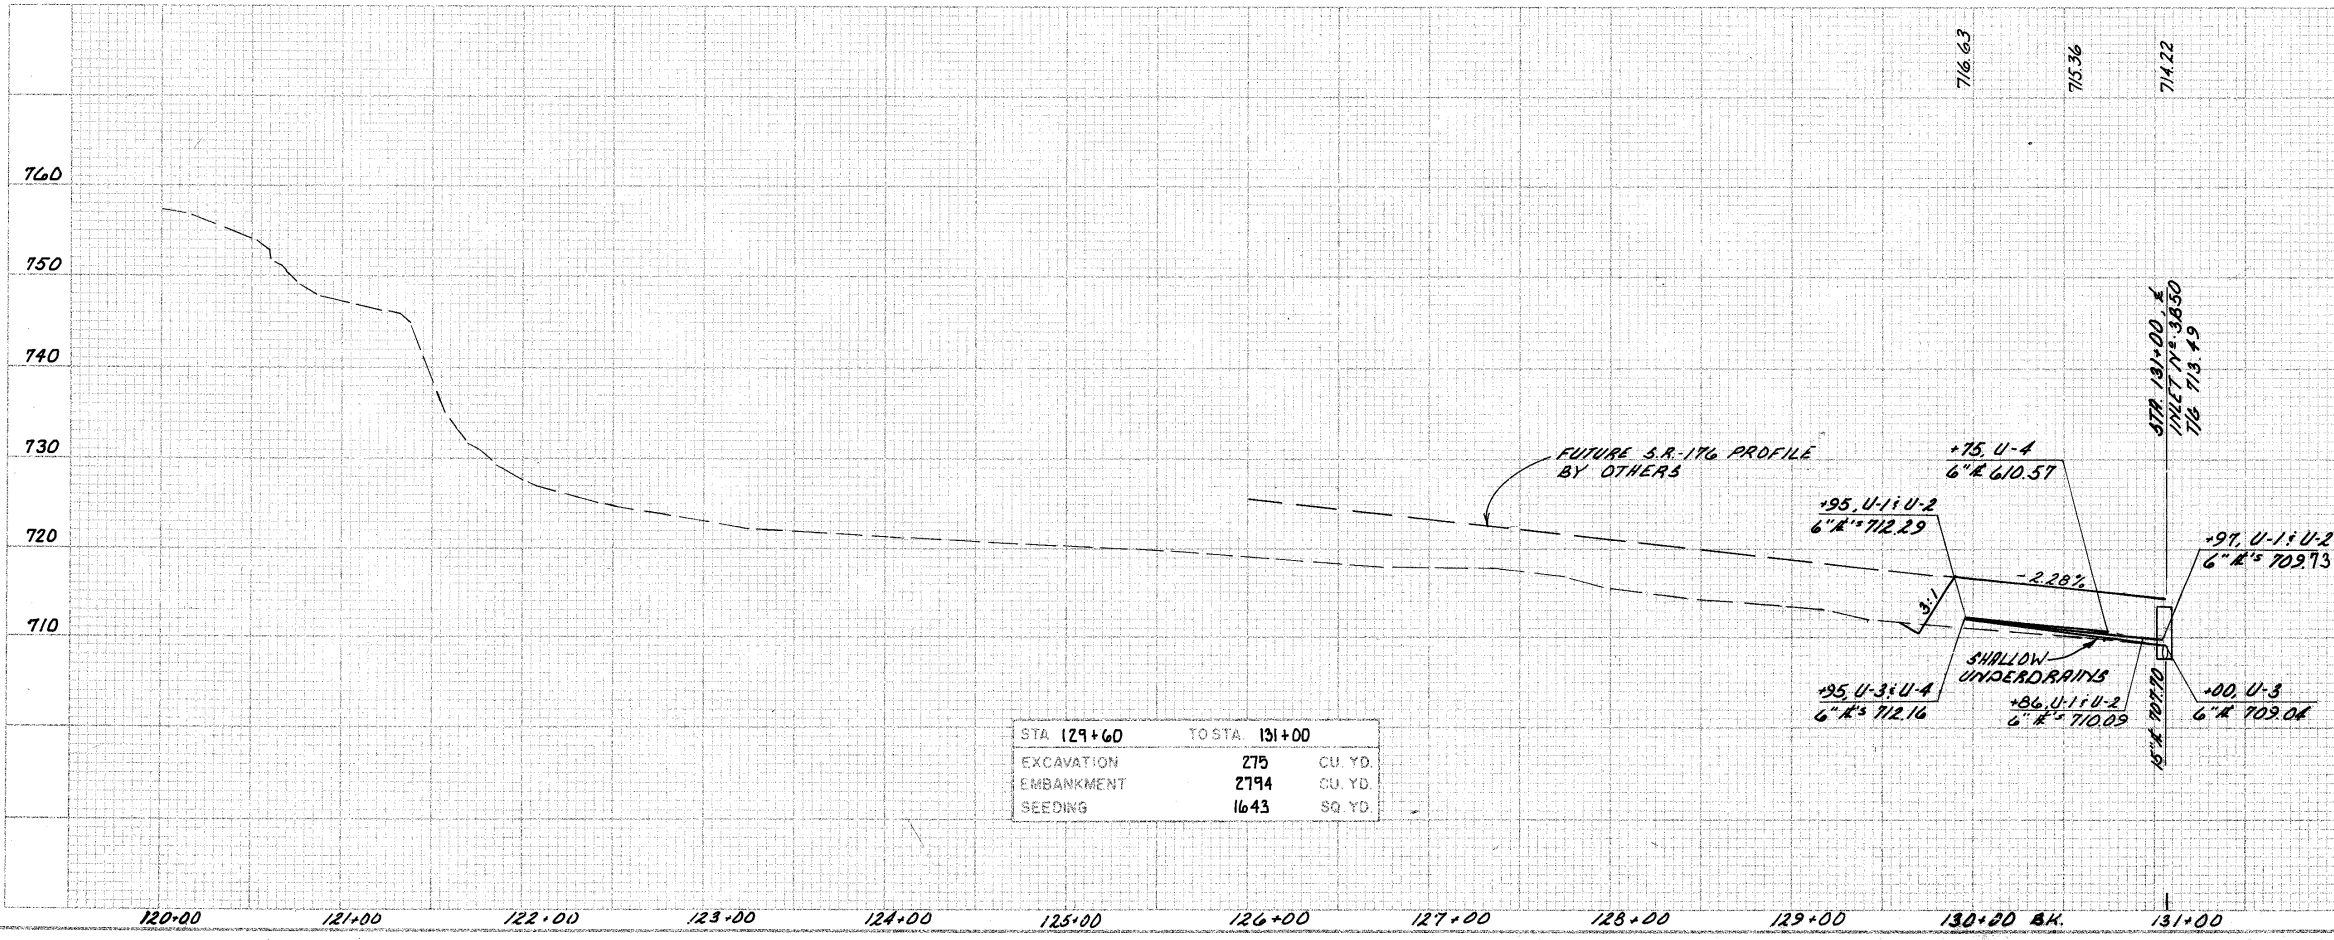

| STA 129+60 | TO STA 131+00 | | |
|------------|---------------|---------|--|
| EXCAVATION | 275 | CU. YD. | |
| EMBANKMENT | 2794 | CU. YD. | |
| SEEDING | 1643 | SQ. YD. | |

RELOC. S.R.-176