


BENCH MARK: TBM 75-CHISELED + ON S.W. LY. COR. MDY. BOX AT GEORGETTE LN. + 65' NN. LY. OF JENNINGS RD. ELEV = 696.501

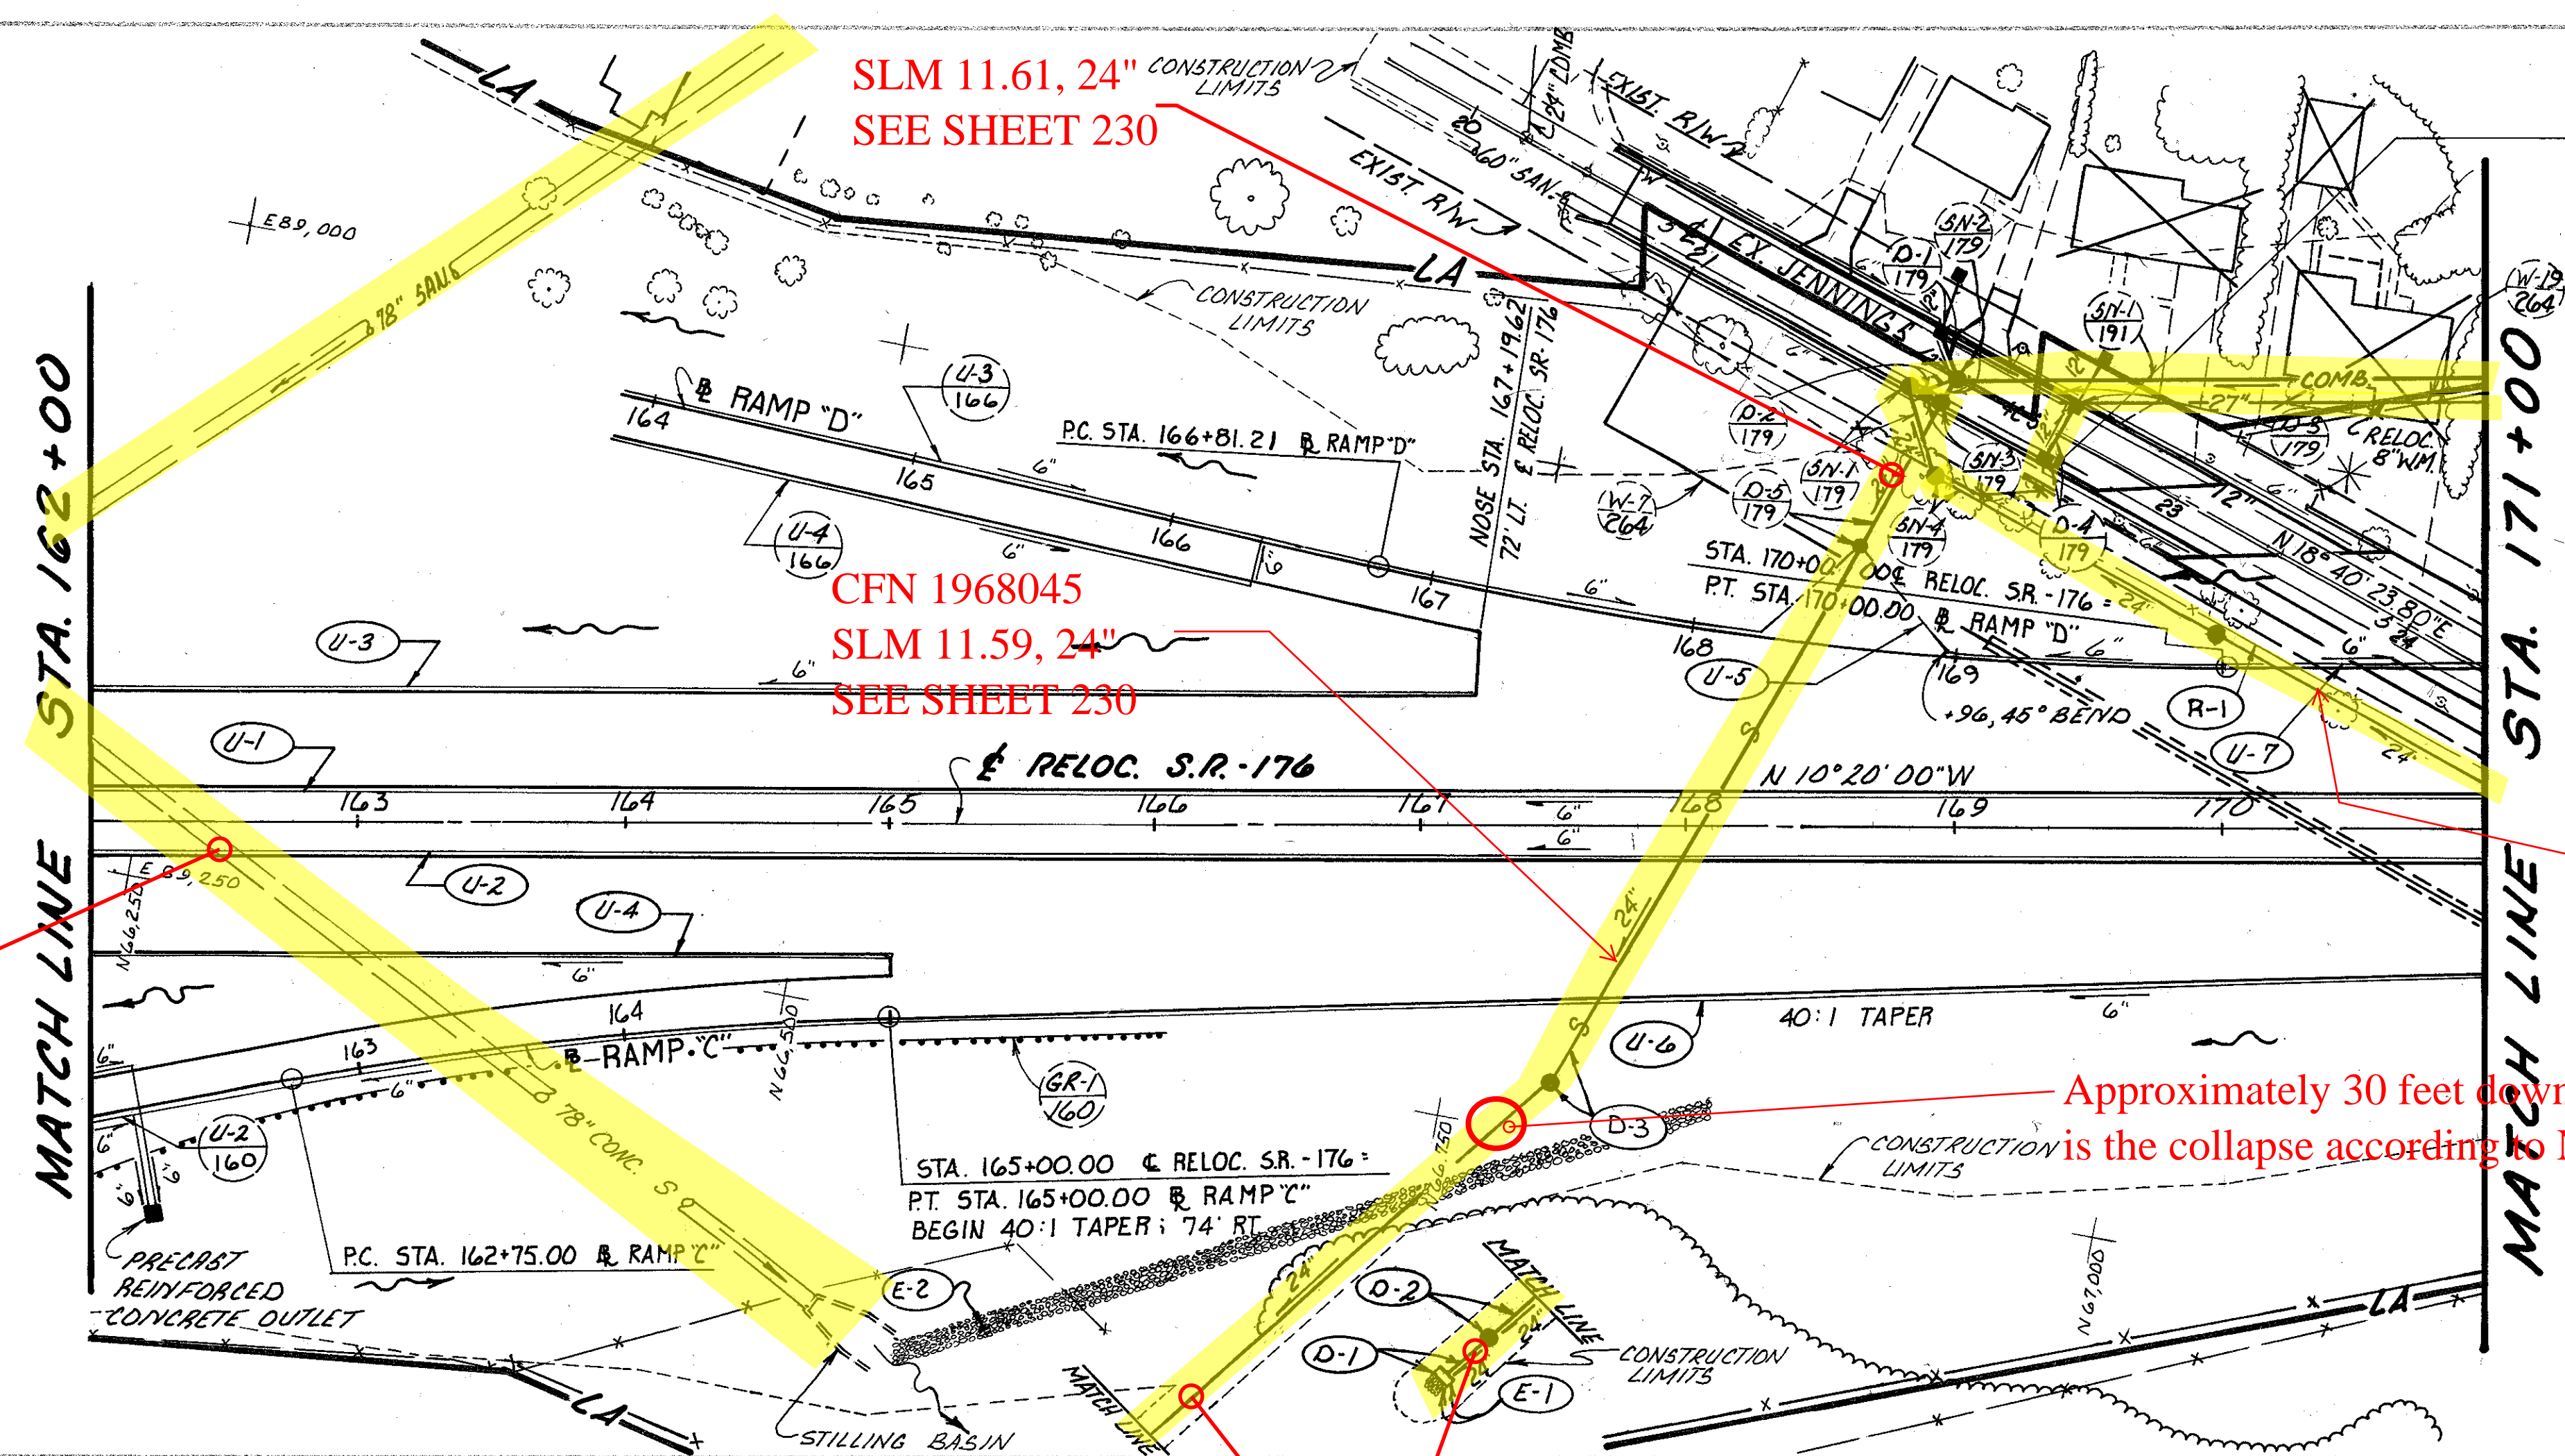

ATTACH PROPOSED FENCE TO WINGWALL AS PER F-3 AND F-5

old CFN 181761146
 new CFN 1803545
 SLM 11.45, 78"

SLM 11.61, 24"
 SEE SHEET 230


CFN 1968045
 SLM 11.59, 24"
 SEE SHEET 230

CFN 1968046
 SLM XX, 24"
 SEE SHEET 66
 AND 231

Approximately 30 feet downstream of MH is the collapse according to NEORS.D.

SLM 11.56, 30"
 SEE SHEET 230

50 L.F. @ 1.1%, TYPE F CONDUIT
 707.17 NON-PERFORATED ASTM
 D-3034, S.O.D.-35, 35931 OR 35941

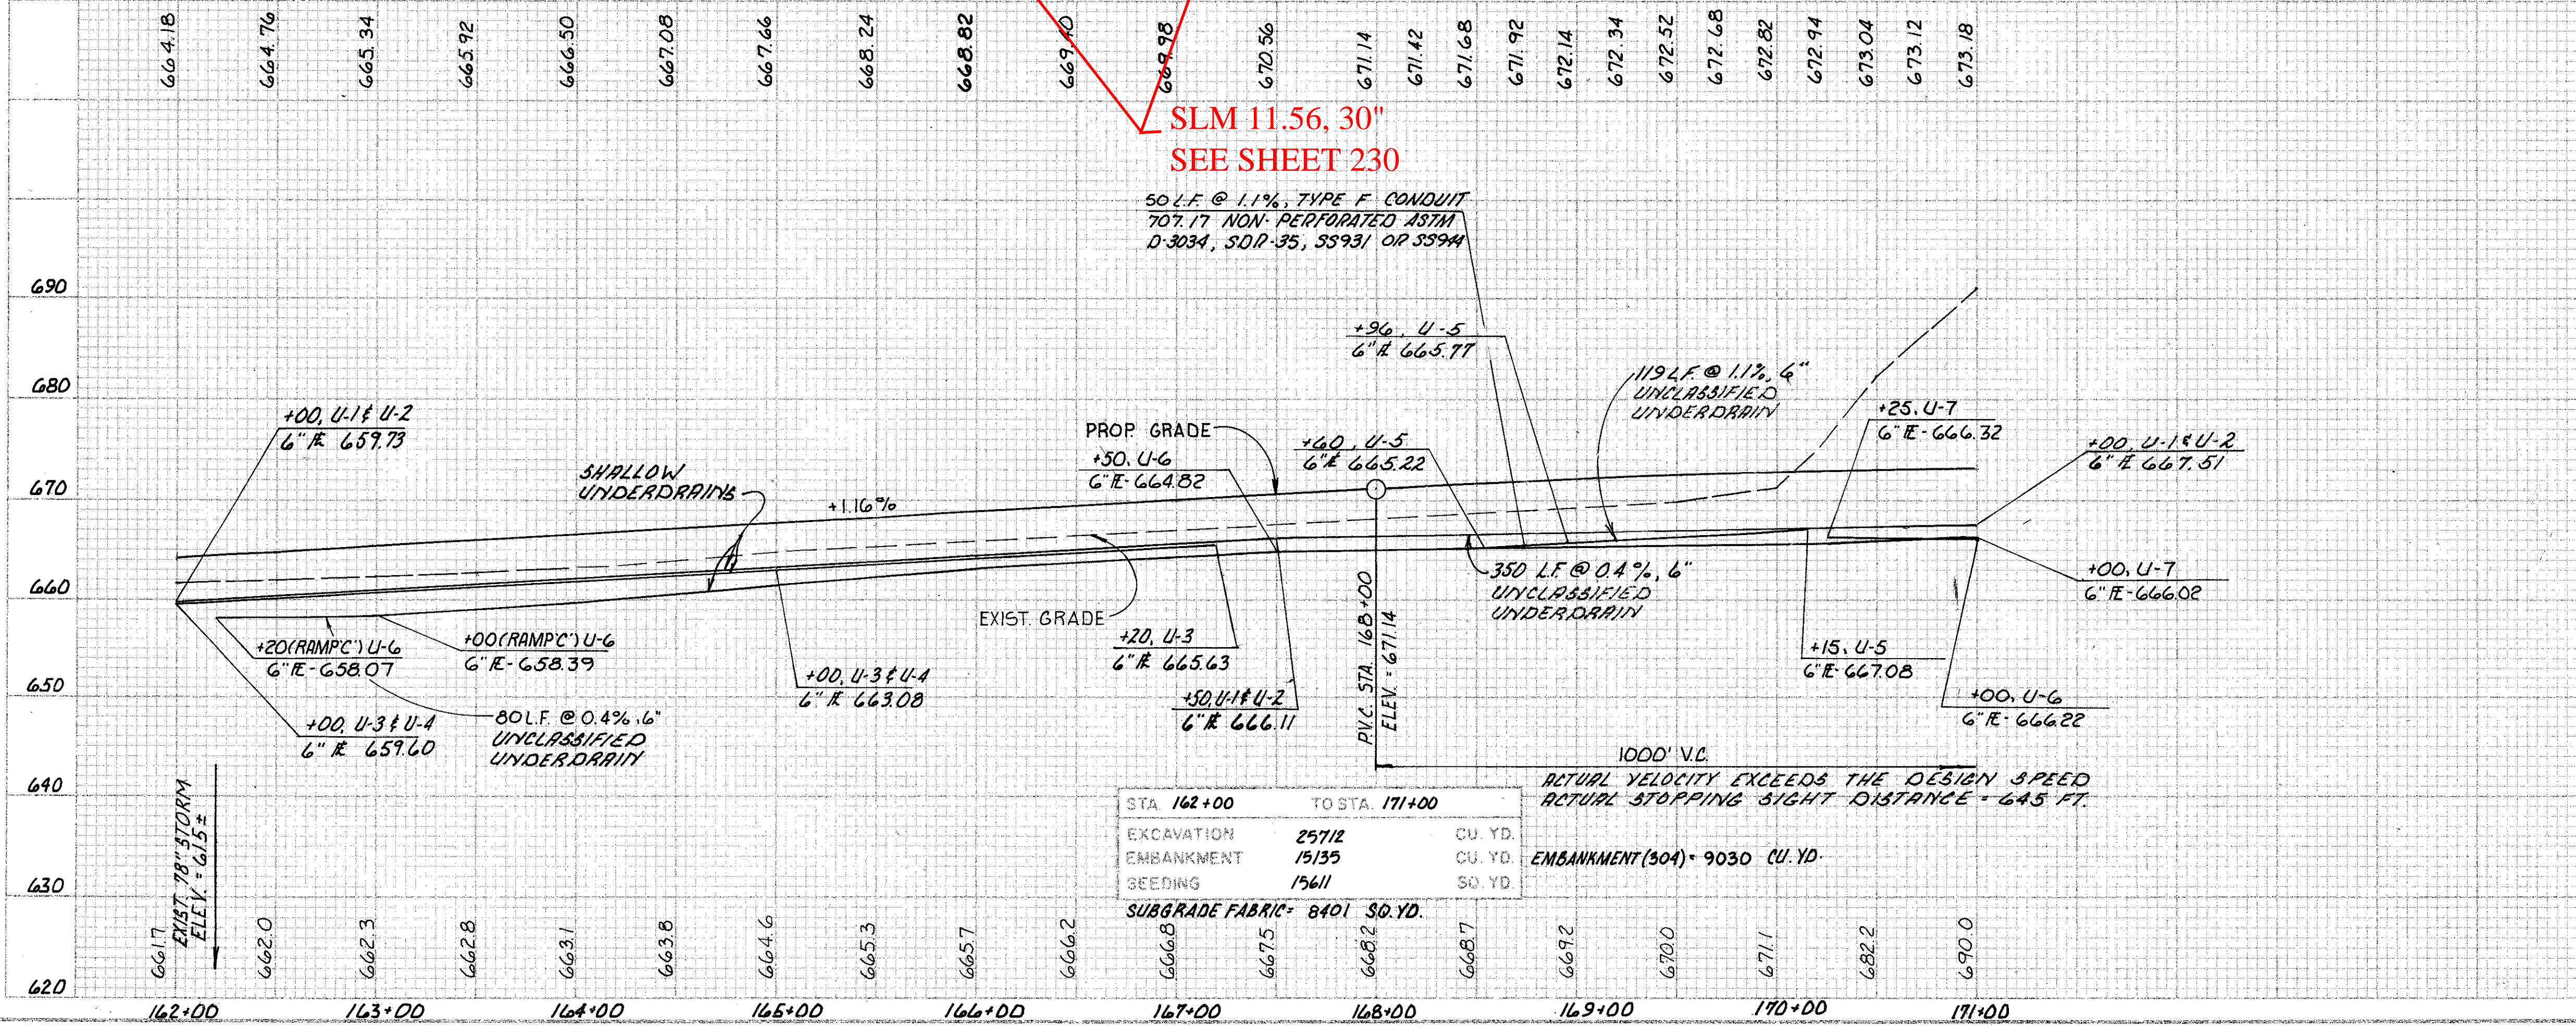

DRAINAGE STRUCTURE DATA

- D-1 STA. 165+55, 271.5' RT. HW-4A
- D-2 STA. 165+70, 258' RT. MH. 17" x 3', AS PER PLAN T/C-618.30
- D-3 STA. 167+50, 94' RT. MH. 17" x 3', AS PER PLAN T/C-667.50

REFERENCE SHEET NUMBERS

REFERENCE	SHEET NUMBERS
QUANTITIES FOR REFERENCED ITEMS	65
RAMP "C" PLAN & PROFILE	160
RAMP "D" PLAN & PROFILE	166
D-1, D-2 & D-3	230
PAVEMENT DETAILS	219-220
JENNINGS ROAD PLAN & PROFILES	179 & 181
GRADING PLAN	79

RELOC. S.R.-176