

FED. RD. DIVISION	STATE	PROJECT
2	OHIO	


257R  
313

CUYAHOGA COUNTY  
CUY-1-2.20

1210

DATE	6-12-61
BY	JAG
PROJECT	533-1
NO.	6-12-61


DATE	6-10-59
BY	M.H. 8-9-59
PROJECT	533-1
NO.	6-10-59

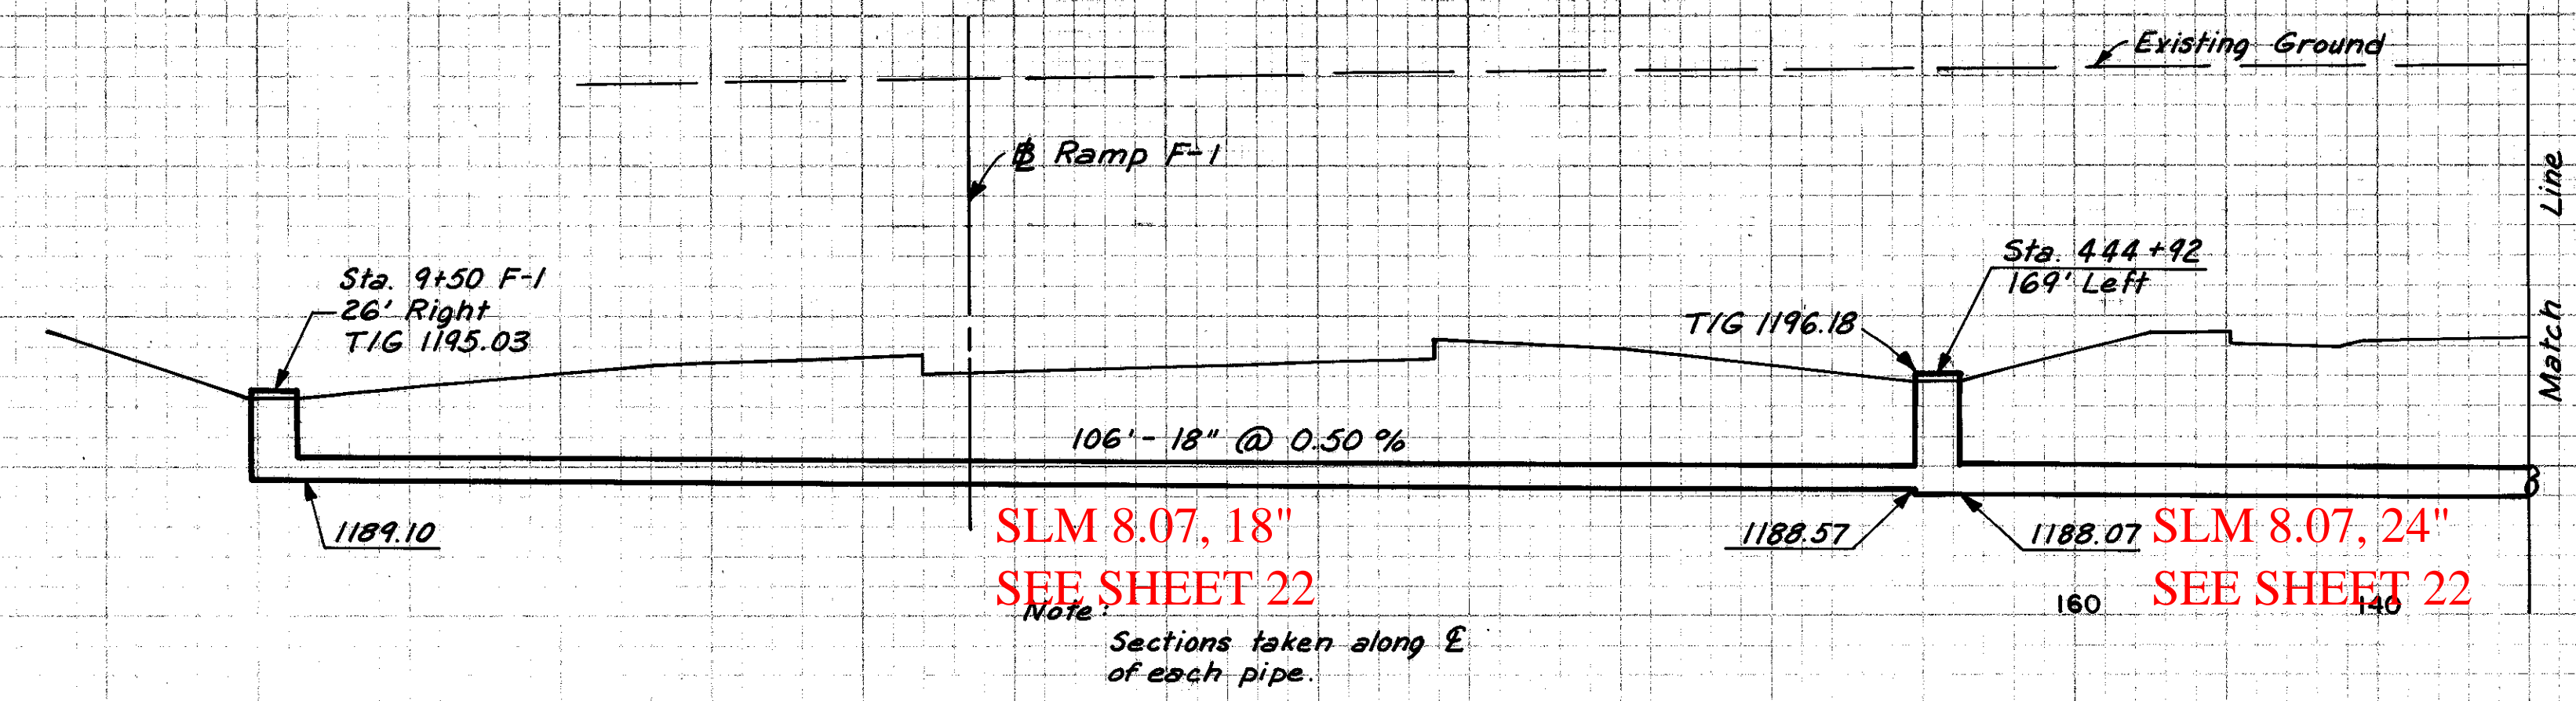

SLM 8.07, 18"  
SEE SHEET 22

SLM 8.07, 24"  
SEE SHEET 22

Note: Sections taken along E of each pipe.

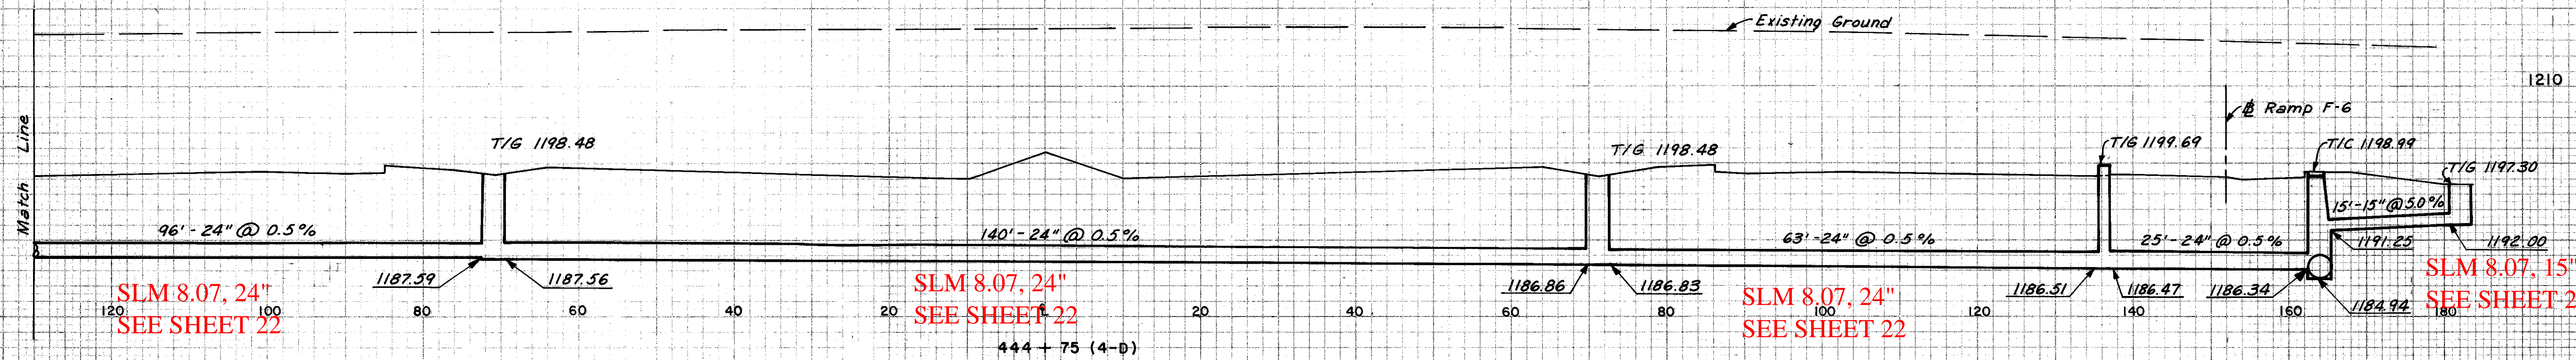


SLM 8.07, 24"  
SEE SHEET 22


SLM 8.07, 24"  
SEE SHEET 22

SLM 8.07, 24"  
SEE SHEET 22

SLM 8.07, 15"  
SEE SHEET 22

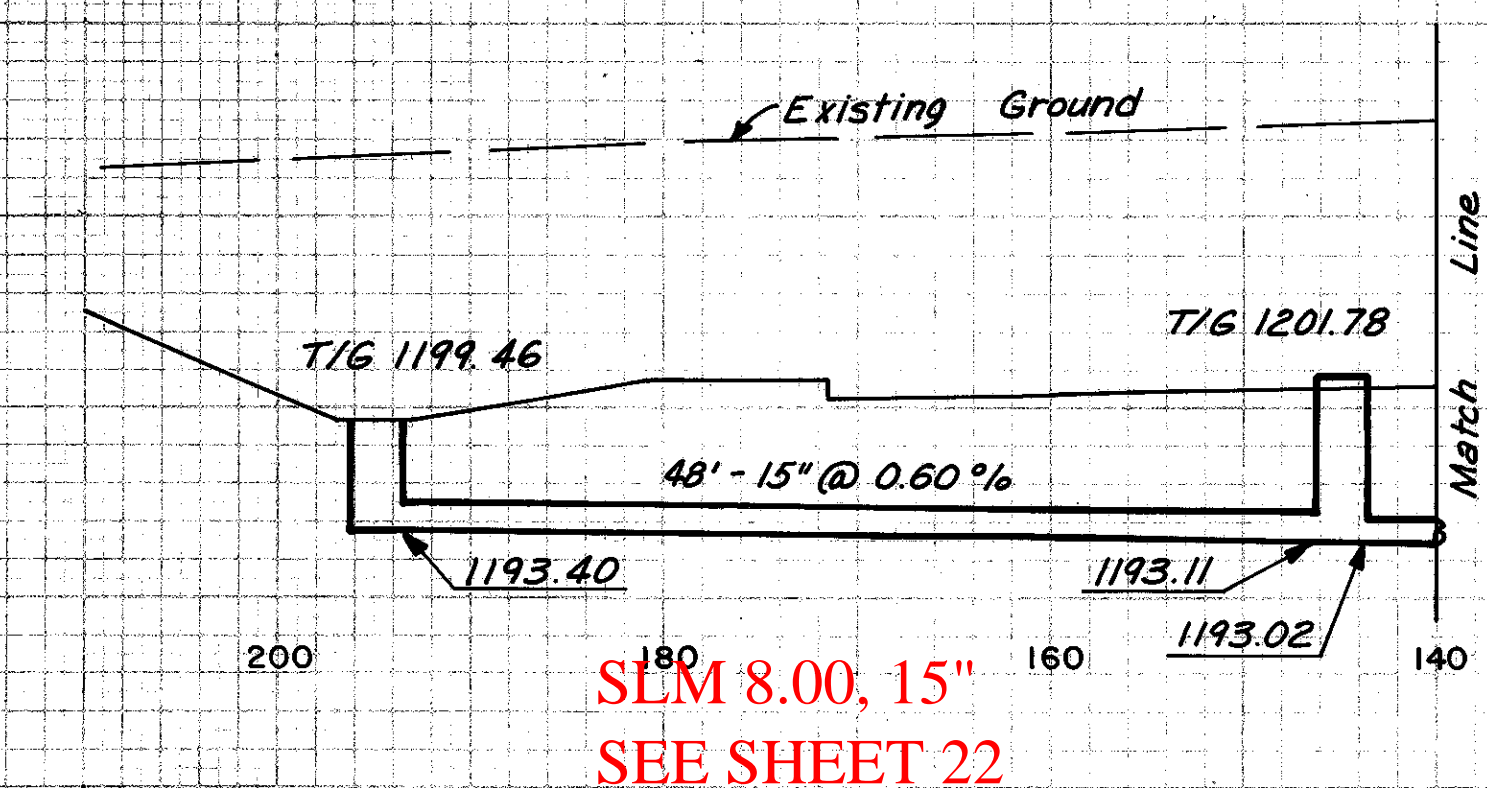

SLM 8.00, 15"  
SEE SHEET 22

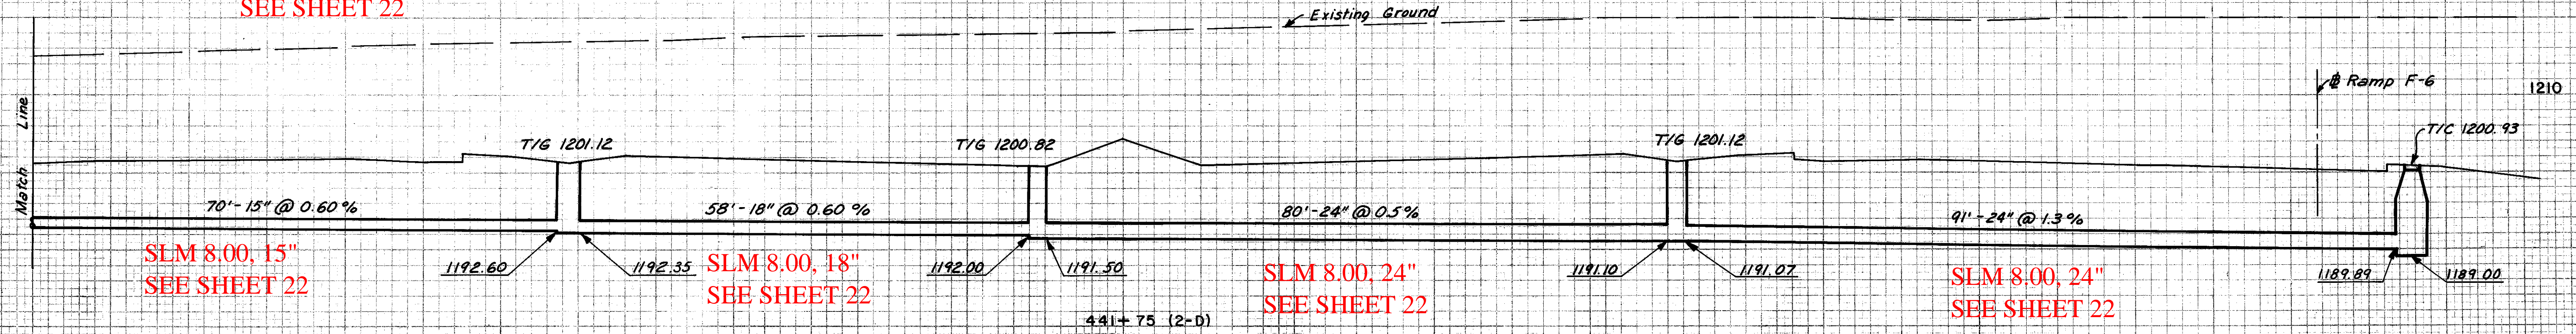

SLM 8.00, 15"  
SEE SHEET 22

SLM 8.00, 18"  
SEE SHEET 22

SLM 8.00, 24"  
SEE SHEET 22

SLM 8.00, 24"  
SEE SHEET 22

HOWARD, NEEDLES, TAMMEN & BERGENDOFF  
CONSULTING ENGINEERS

KANSAS CITY CLEVELAND NEW YORK