

CALC. BY: EJK
 DATE: 4/94
 CHKD. BY: DSB
 DATE: 4/94

CUY-271-6.53

OHIO
 F.H.W.A. REGION 5
 394

CUYAHOGA COUNTY


CITY OF WARRENSVILLE HEIGHTS

BEGIN PAVEMENT
 STA.62+00
 RAMP G-1

CFN 182710644
 SLM 6.43, 48"

SEE SHEET NO. 67
 MATCH LINE STA. 360+00

MATCH LINE STA. 372+00
 SEE SHEET NO. 69

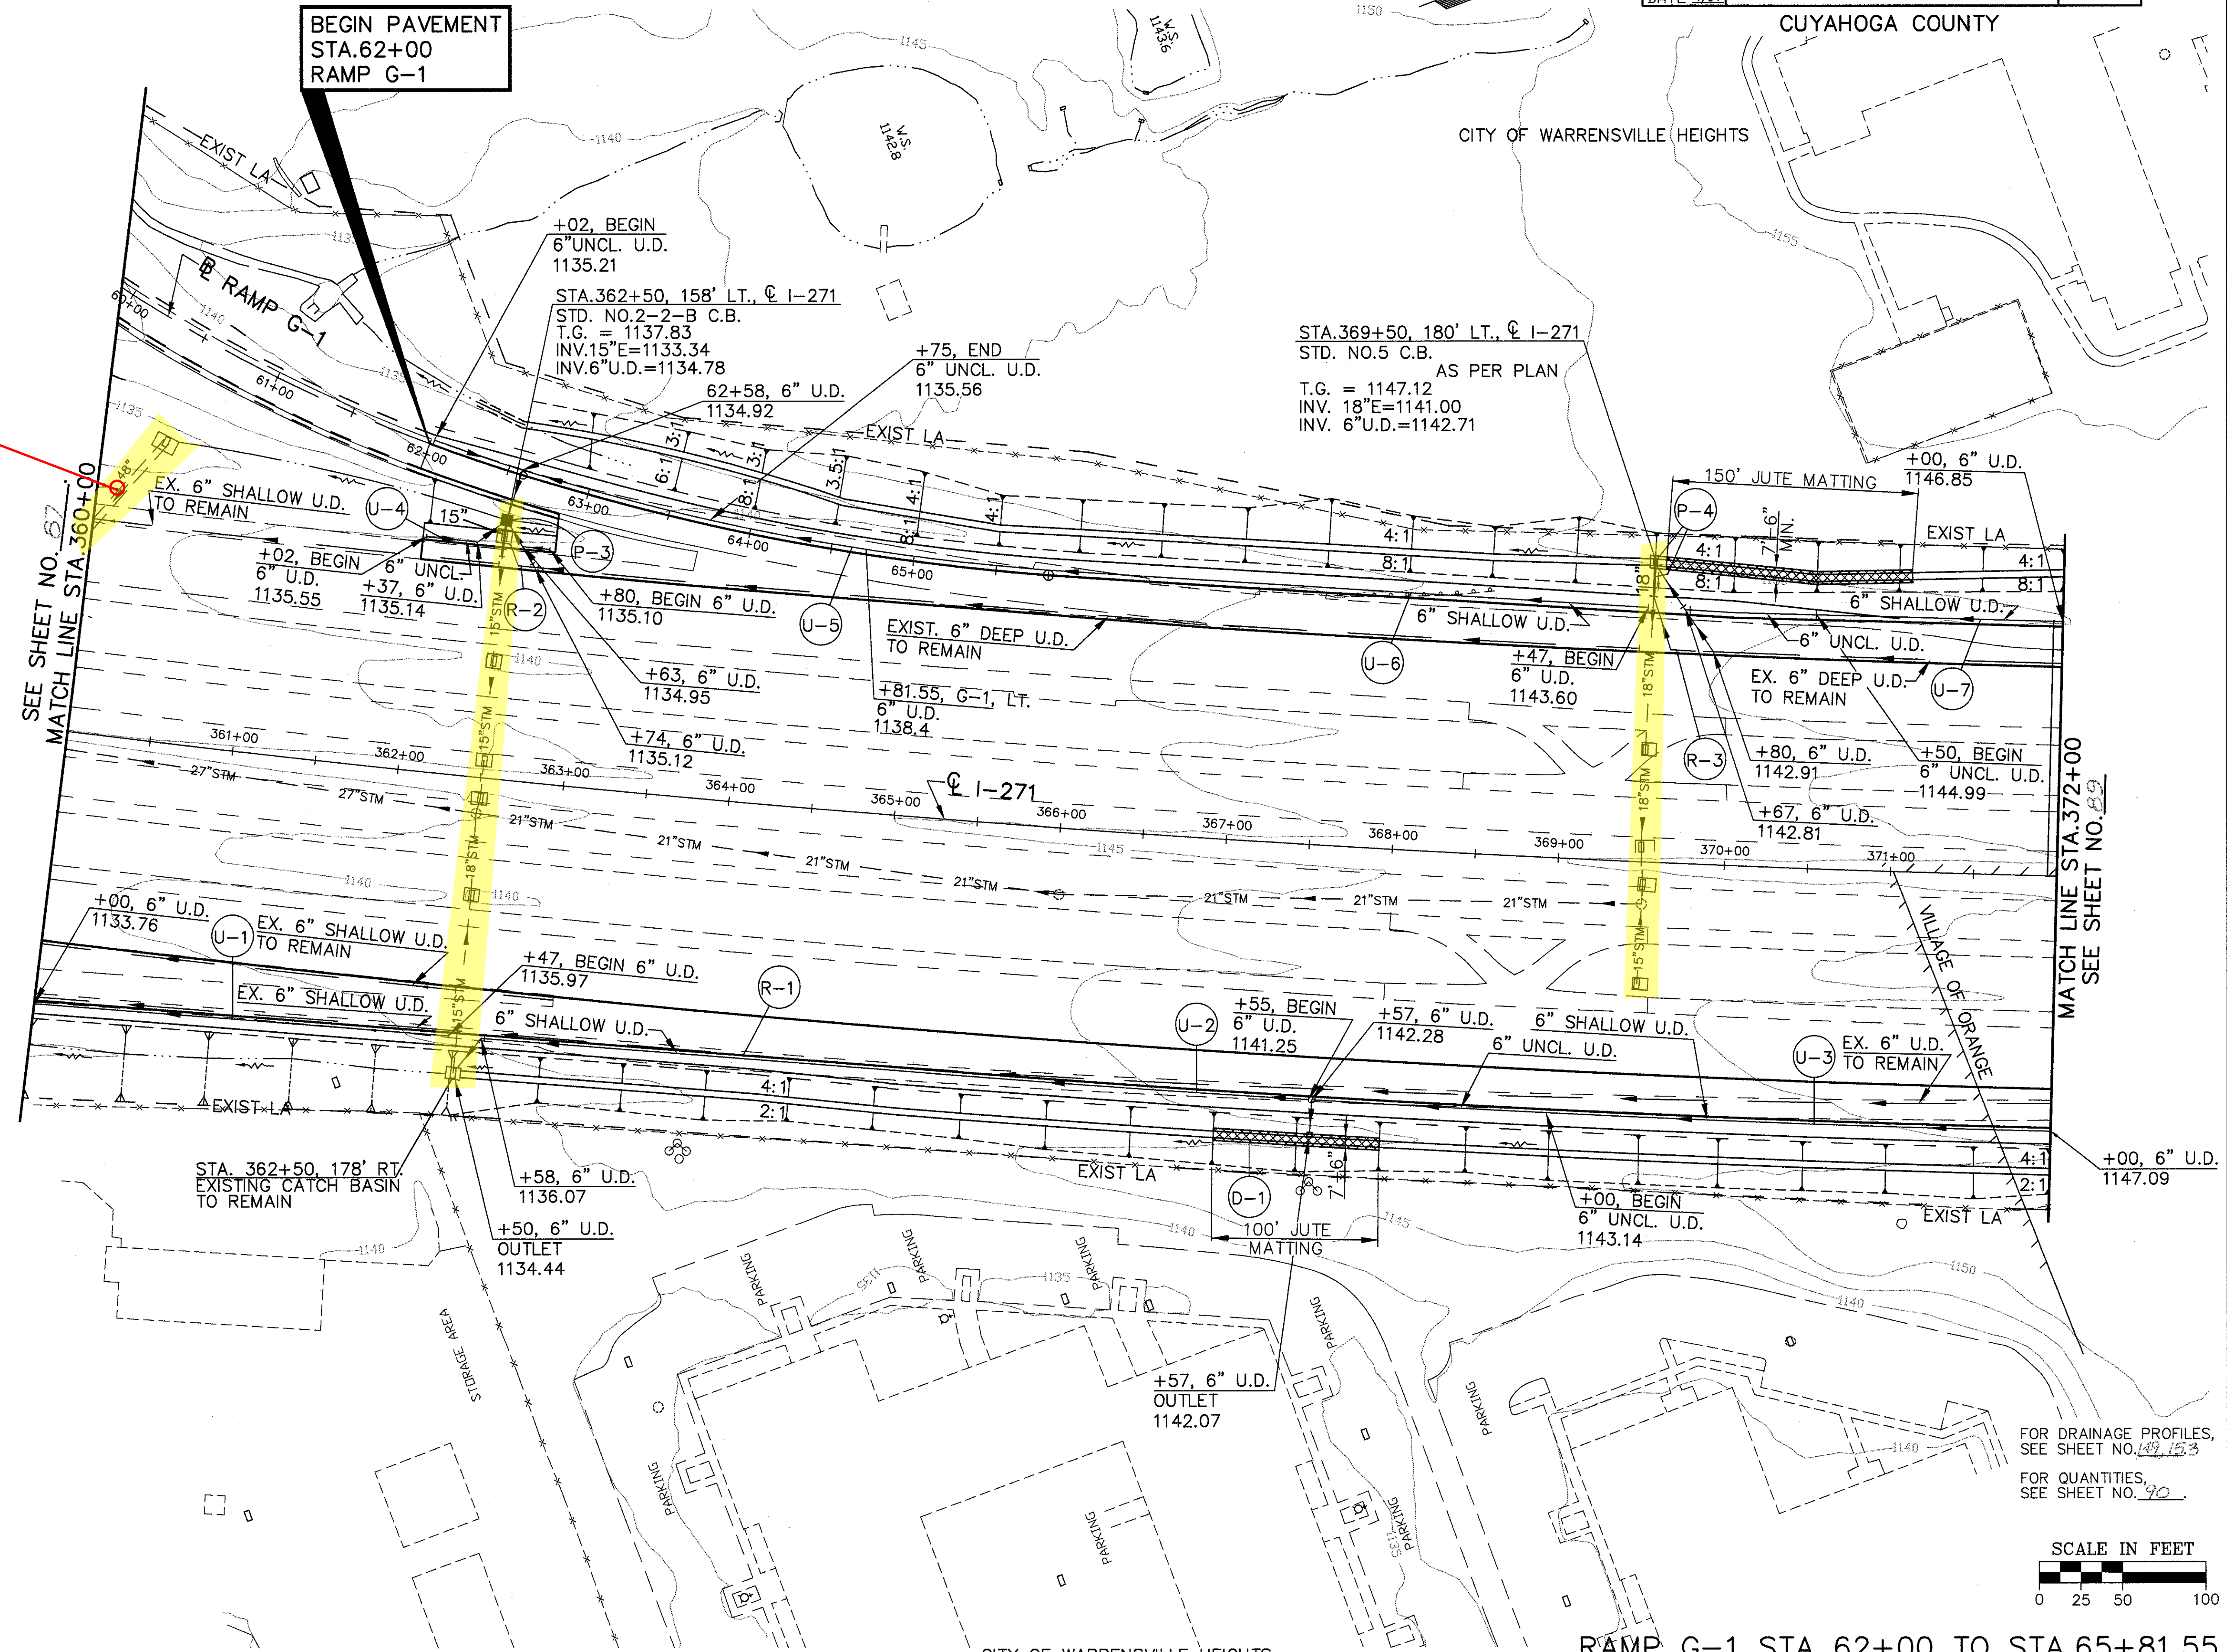


DESIGNED BY: EJK
 DATE: 4/19/93
 DRAWN BY: T.K.I.
 DATE: 9/10/93
 CAD FILE NAME: 7014900-271DRAN1

CHECKED BY: DSB
 DATE: 4/8/94
 REVISED BY: J.E.D.
 DATE: 4/14/94

FOR DRAINAGE PROFILES,
 SEE SHEET NO. 149, 153

FOR QUANTITIES,
 SEE SHEET NO. 90

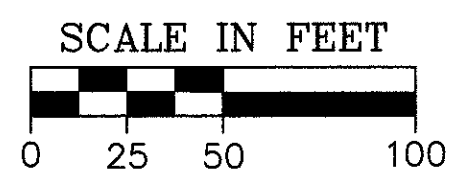

RAMP G-1 STA 62+00 TO STA.65+81.55
 I-271 DRAINAGE PLAN STA. 360+00 TO STA. 372+00