




**D-27**  
SLM 25.05, 15"  
SEE SHEET 44

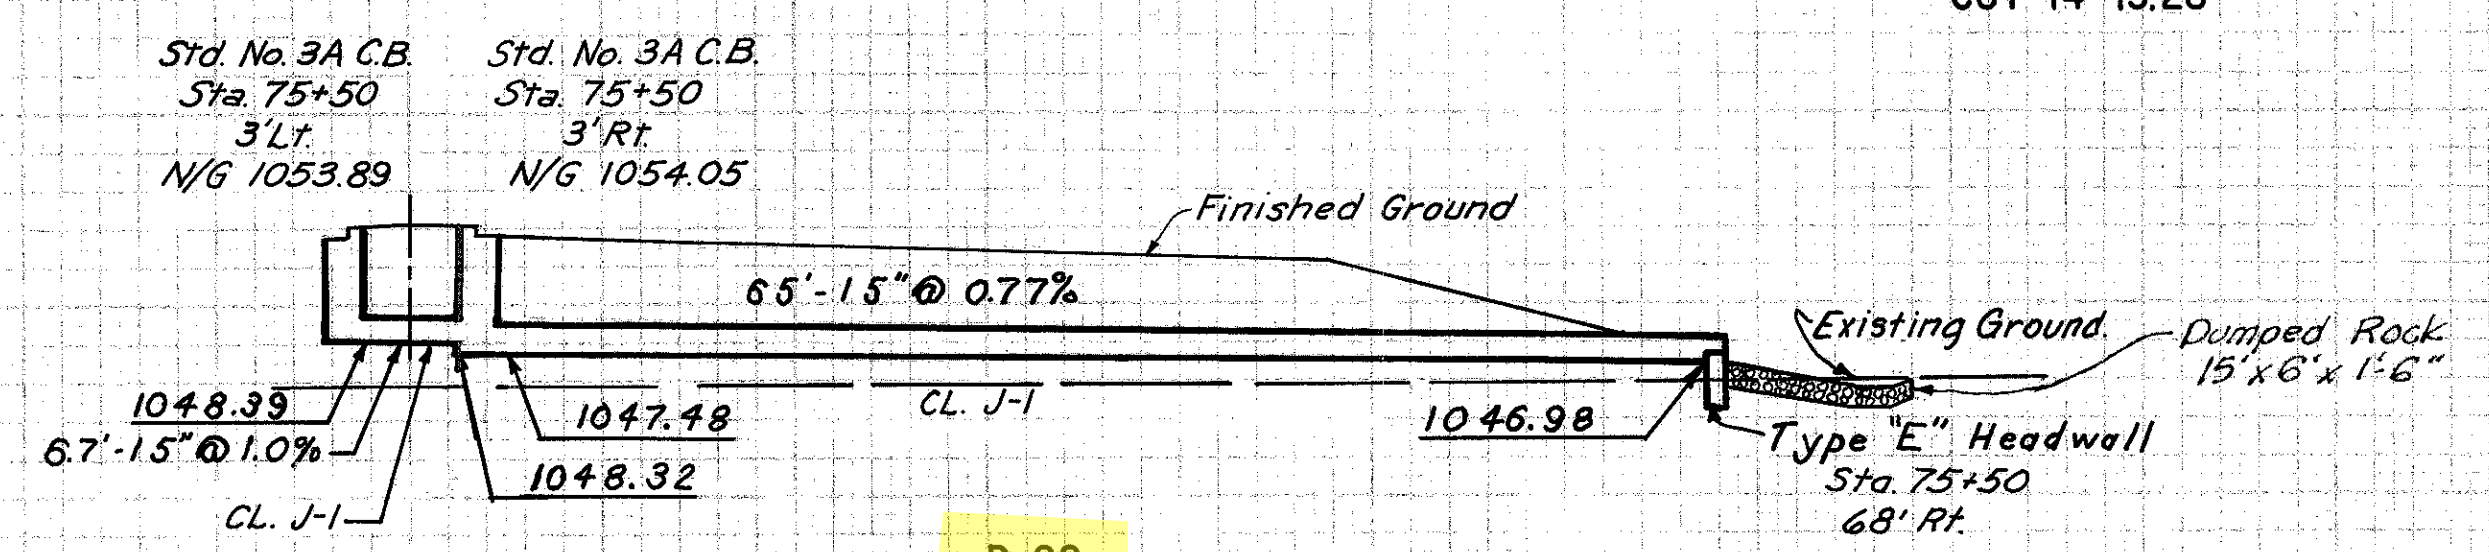


**D-28**  
SLM 25.12, 15"  
SEE SHEET 44

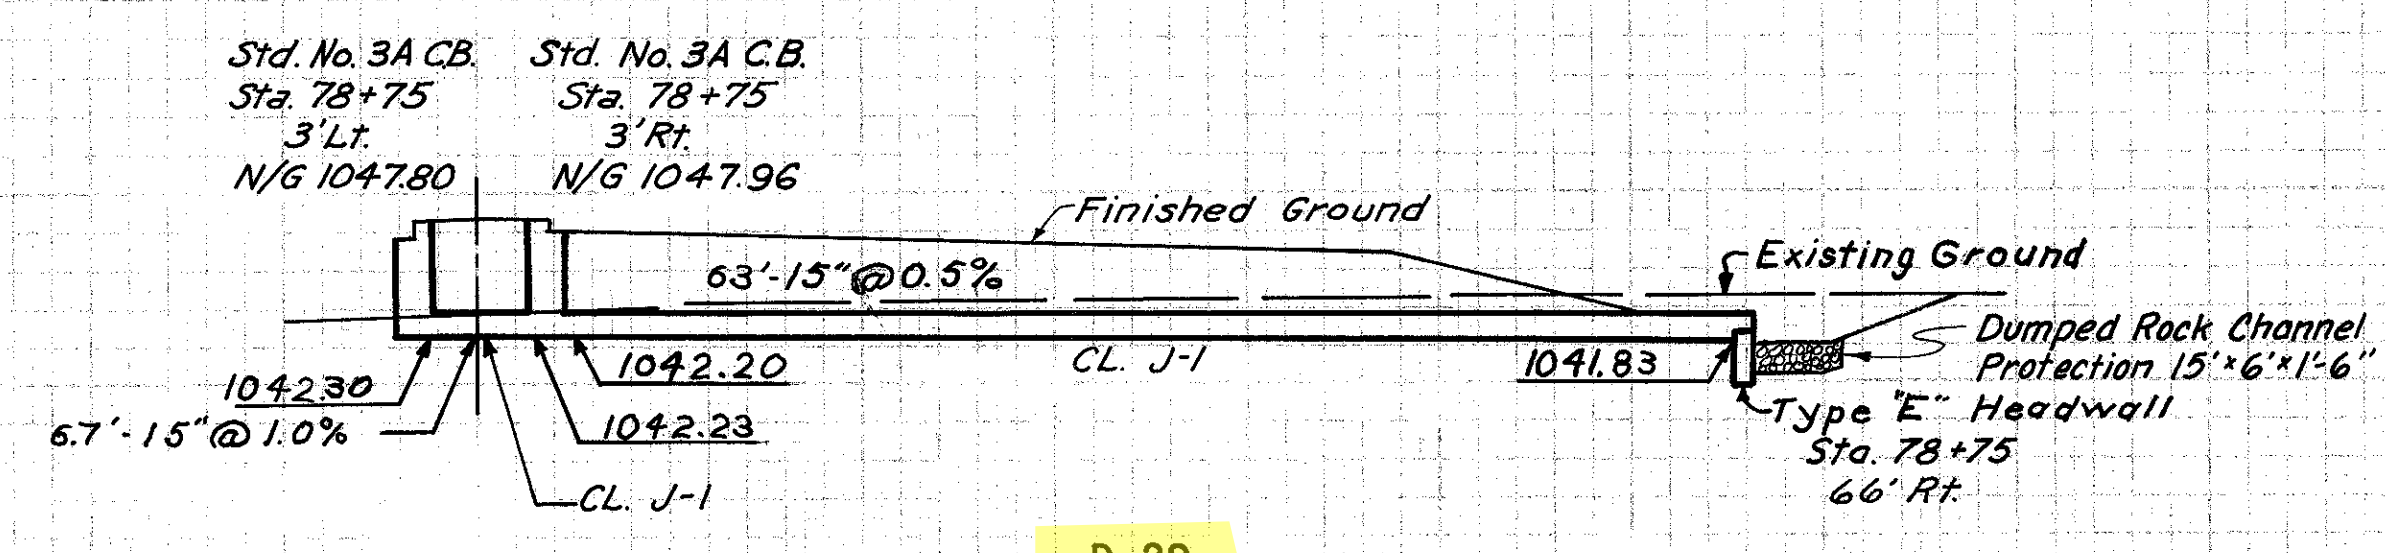

**D-29**  
CFN 1970106  
SLM 25.18, 15"  
SEE SHEET 44

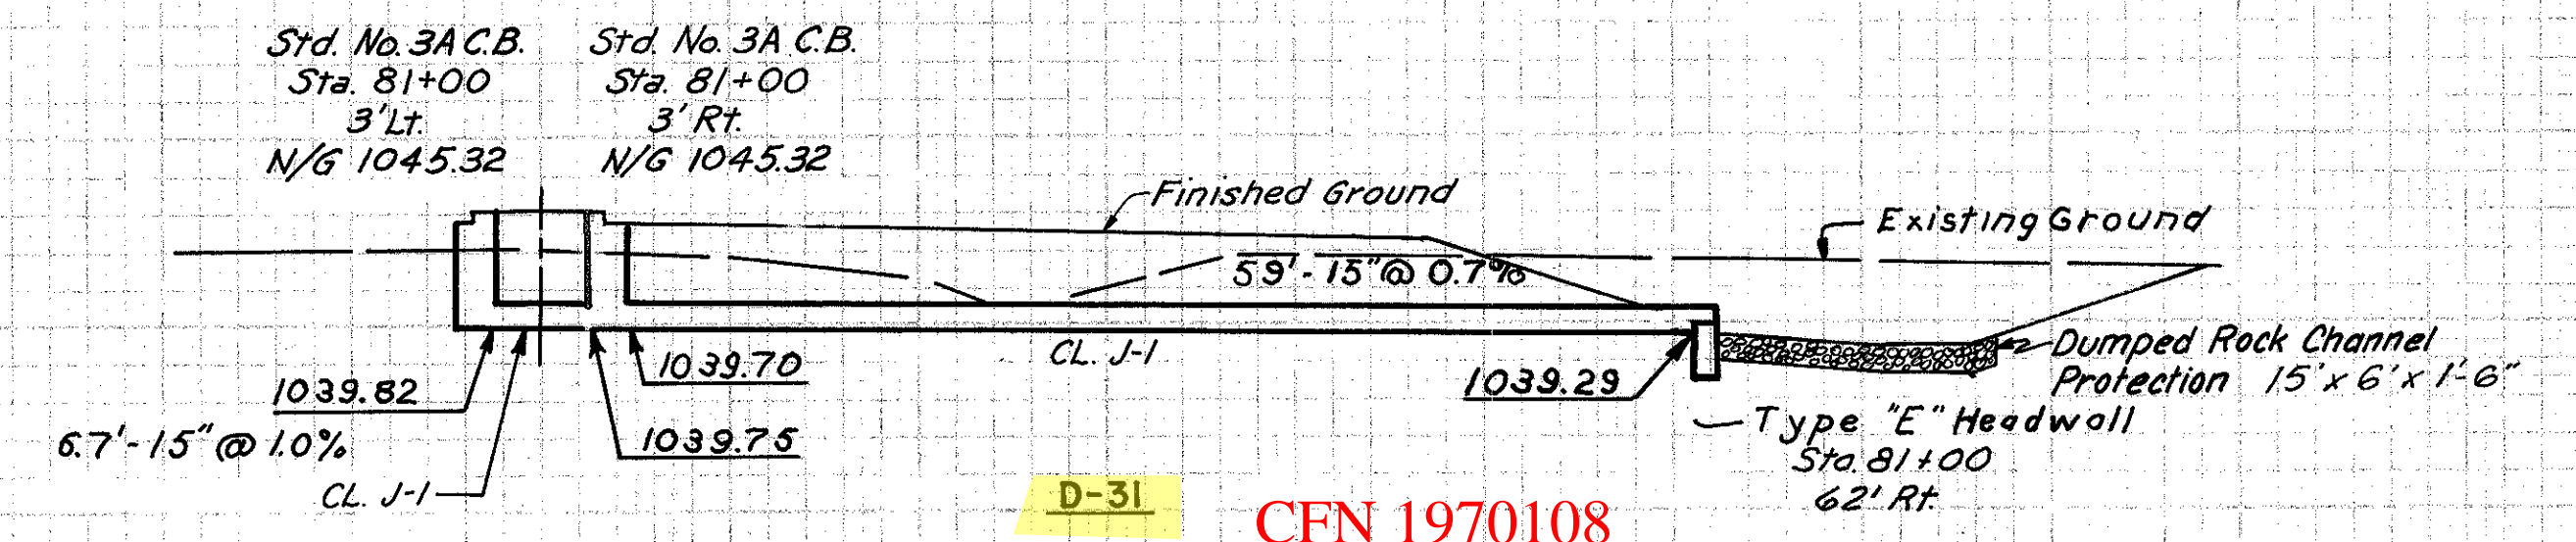


**D-31**  
CFN 1970108  
SLM 25.22, 15"  
SEE SHEET 45

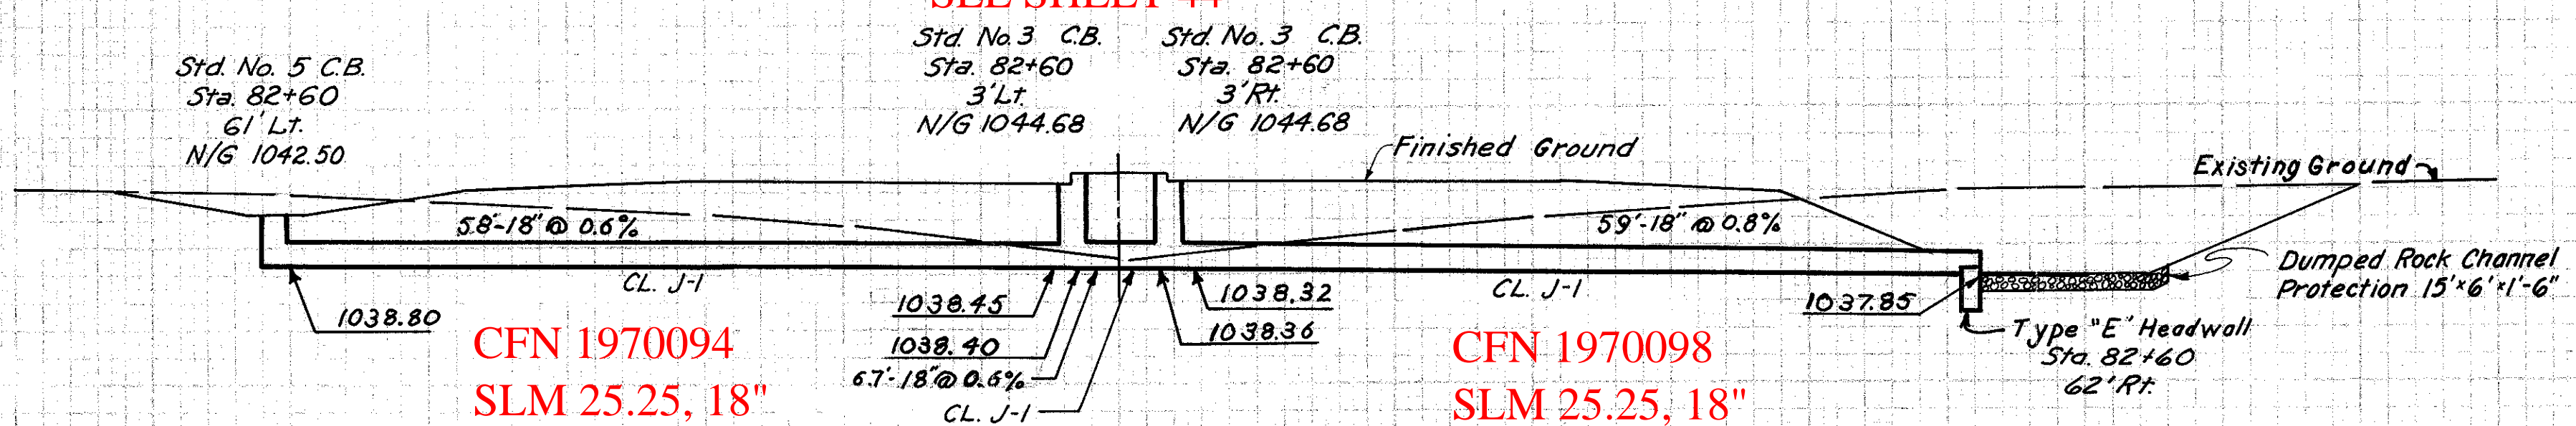


**D-32**  
CFN 1970094  
SLM 25.25, 18"  
SEE SHEET 45

**D-32**  
CFN 1970098  
SLM 25.25, 18"  
SEE SHEET 45

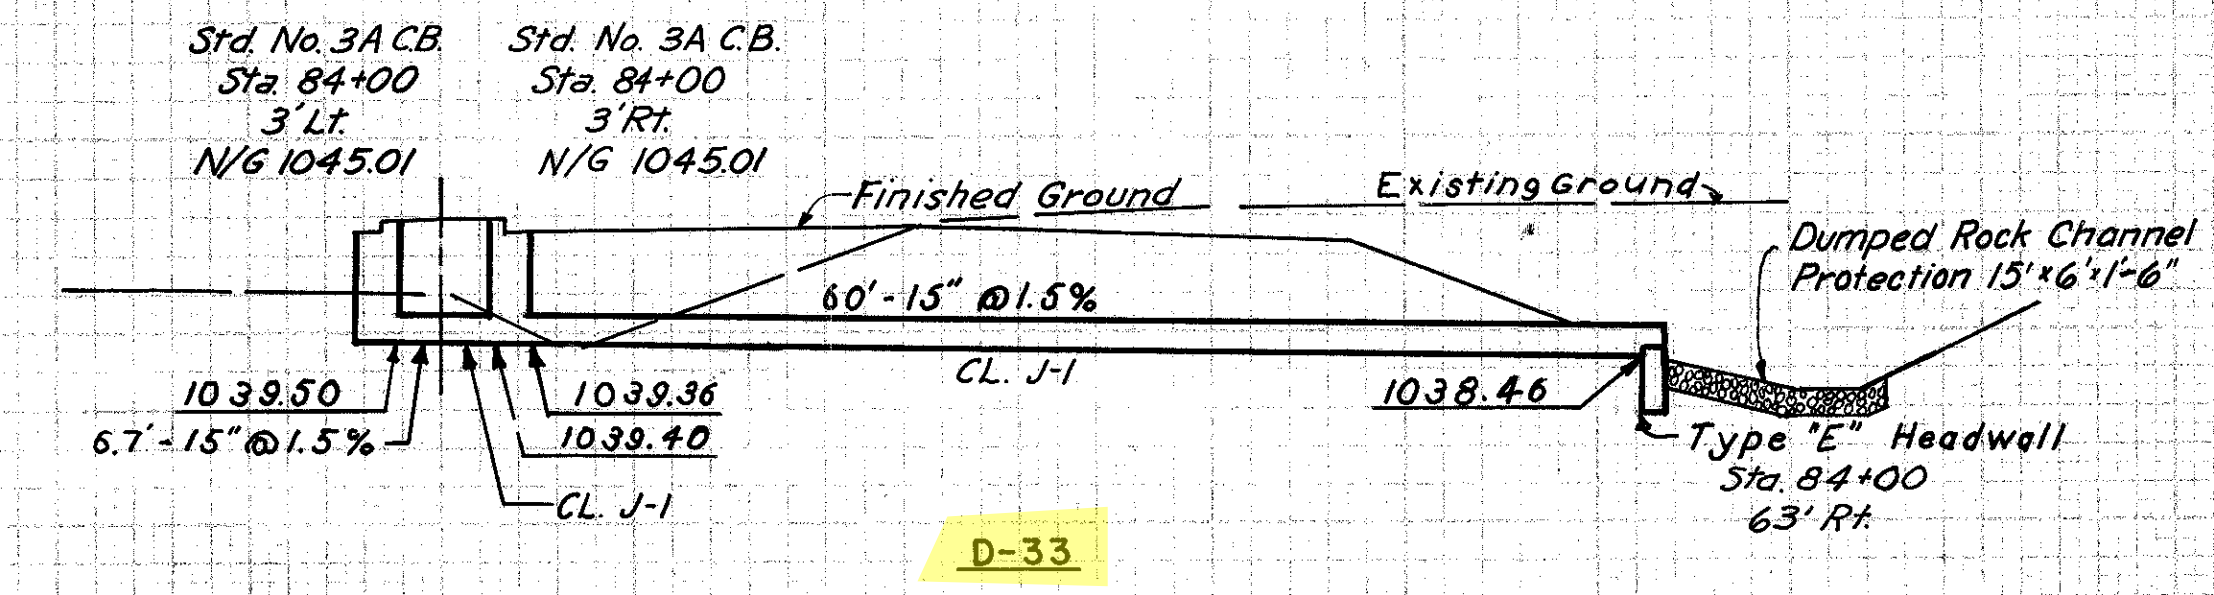

**D-33**  
CFN 1970101  
SLM 25.28, 15"  
SEE SHEET 45

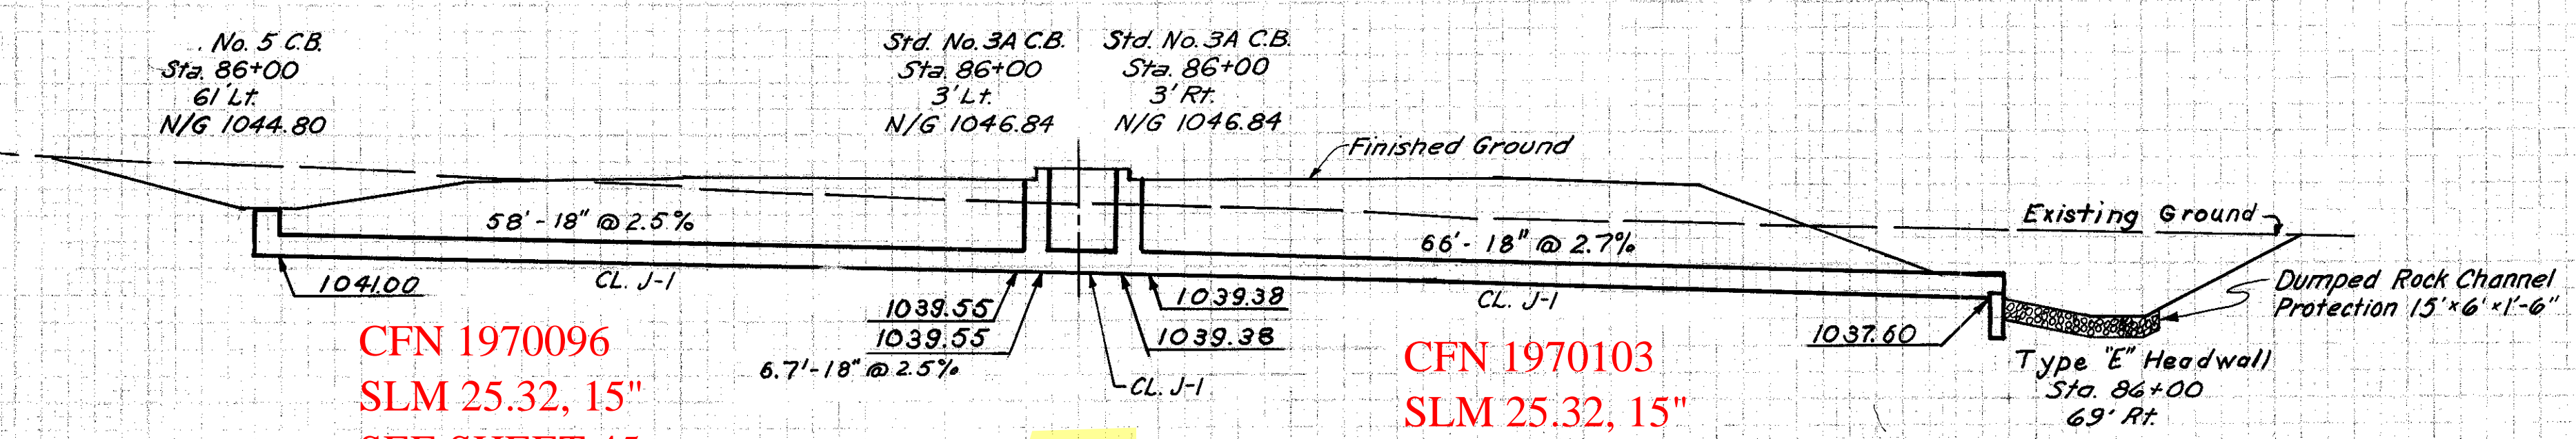

**D-34**  
CFN 1970096  
SLM 25.32, 15"  
SEE SHEET 45

**D-34**  
CFN 1970103  
SLM 25.32, 15"  
SEE SHEET 45