



BENCH MARK 114C
"x" cut in S.E. corner of concrete base of Gulf sign at S.E. corner of gas station 125' Left of Sta. 71+55.
Elev 1054.23

Note:
For detail of Culvert S-1 (Cuy-14-1345 see sheet 140.
For storm sewer profile D-27 thru D-29, see sheet 147.
For sanitary sewer detail D-18 & D-19, see sheet 69.

CURVE DATA
P.I. Sta. 73+22.32
Δ = 21°03'50"
D = 1°28'00"
R = 3906.53'
T = 726.28'
L = 1436.17'
E = 66.93'

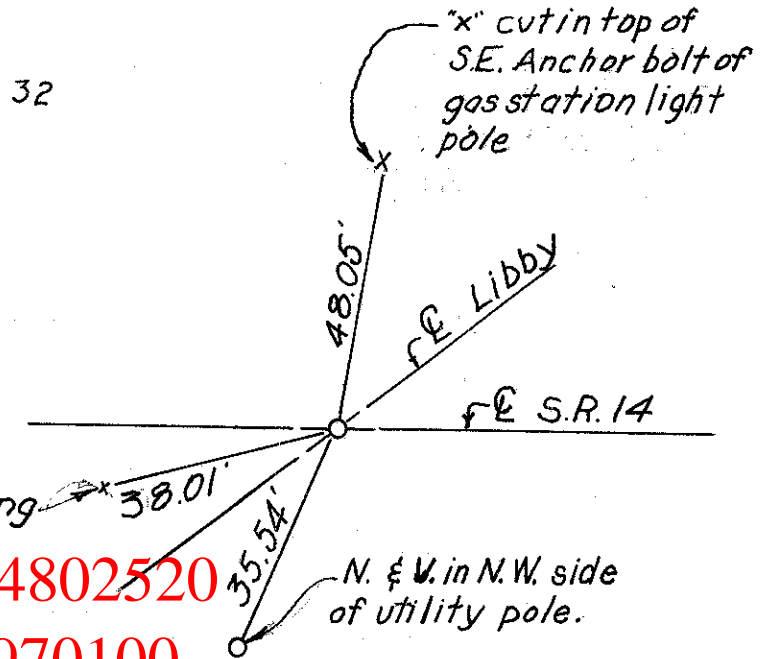

old CFN 184802520
new CFN 1970100
SLM 25.20, 48" REFERENCE POINT
SEE SHEET 140

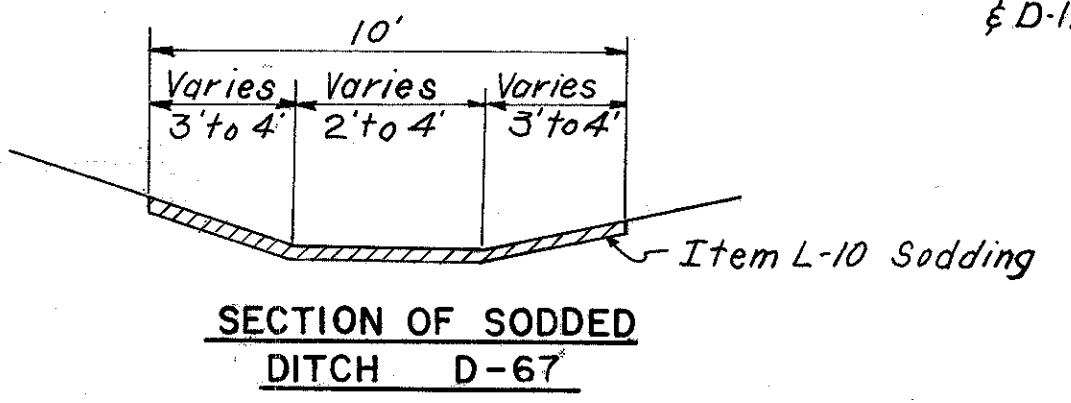


Ref. No.	Station	Side	DRAINAGE					
			I-1	I-2	I-8	I-10	L-10	
			Class J-1 15"	Masonry 3-A C.B.	Std. C.B.	Dumped Rock Channel Protection	Sodding	
	From	To	Lin. Ft.	Cu Yds.	Each	Cu Yds.	Sq. Yds.	
D-27	72+00		Rt.	69	0.3	2	5	
D-28	75+50		Rt.	72	0.3	2	5	
D-29	78+75		Rt.	70	0.3	2	5	
D-67	76+00	79+55	Rt.					405
	Total			211	0.9	6	15	405


Ref. No.	Station	Side	GUARD RAIL			
			I-15		Guard Rail	
			Steel Beam	Temporary		
	From	To	Type (Deep)	Type (Barrier)	Lin. Ft.	
R-22	77+25	80+00	Rt.	223		
R-23	78+60	79+86	Lt.	125		
R-24	71+55	80+00	Lt.		844.5	
R-45	70+15	80+00	Rt.		1000	
	Total			348	844.5	1000

Ref. No.	Station	Side	UNDERDRAINS				
			I-1				
			CI. F-4	CI. F-4	CI. I-3	CI. I-1	CI. I-3
	From	To	Lin. Ft.	Each			
82U	70+00	80+00	Lt.	10	990		
83U	70+00	72+00	Lt.	10	90	100	
84U	71+00	71+95	Rt.	10	115	1	
85U	72+00	75+50	Lt.	10	340		
86U	72+00	78+70	Rt.	10	680	1	
87U	75+50	78+75	Lt.	10	315		
88U	78+75	80+00	Lt.	10	115		
89U	78+75	80+00	Rt.	10	115		
	Total			60	30	2760	100

Excavation	809	Cu. Yds.
Embankment	21,852	Cu. Yds.
Embankment +18%	25,785	Cu. Yds.

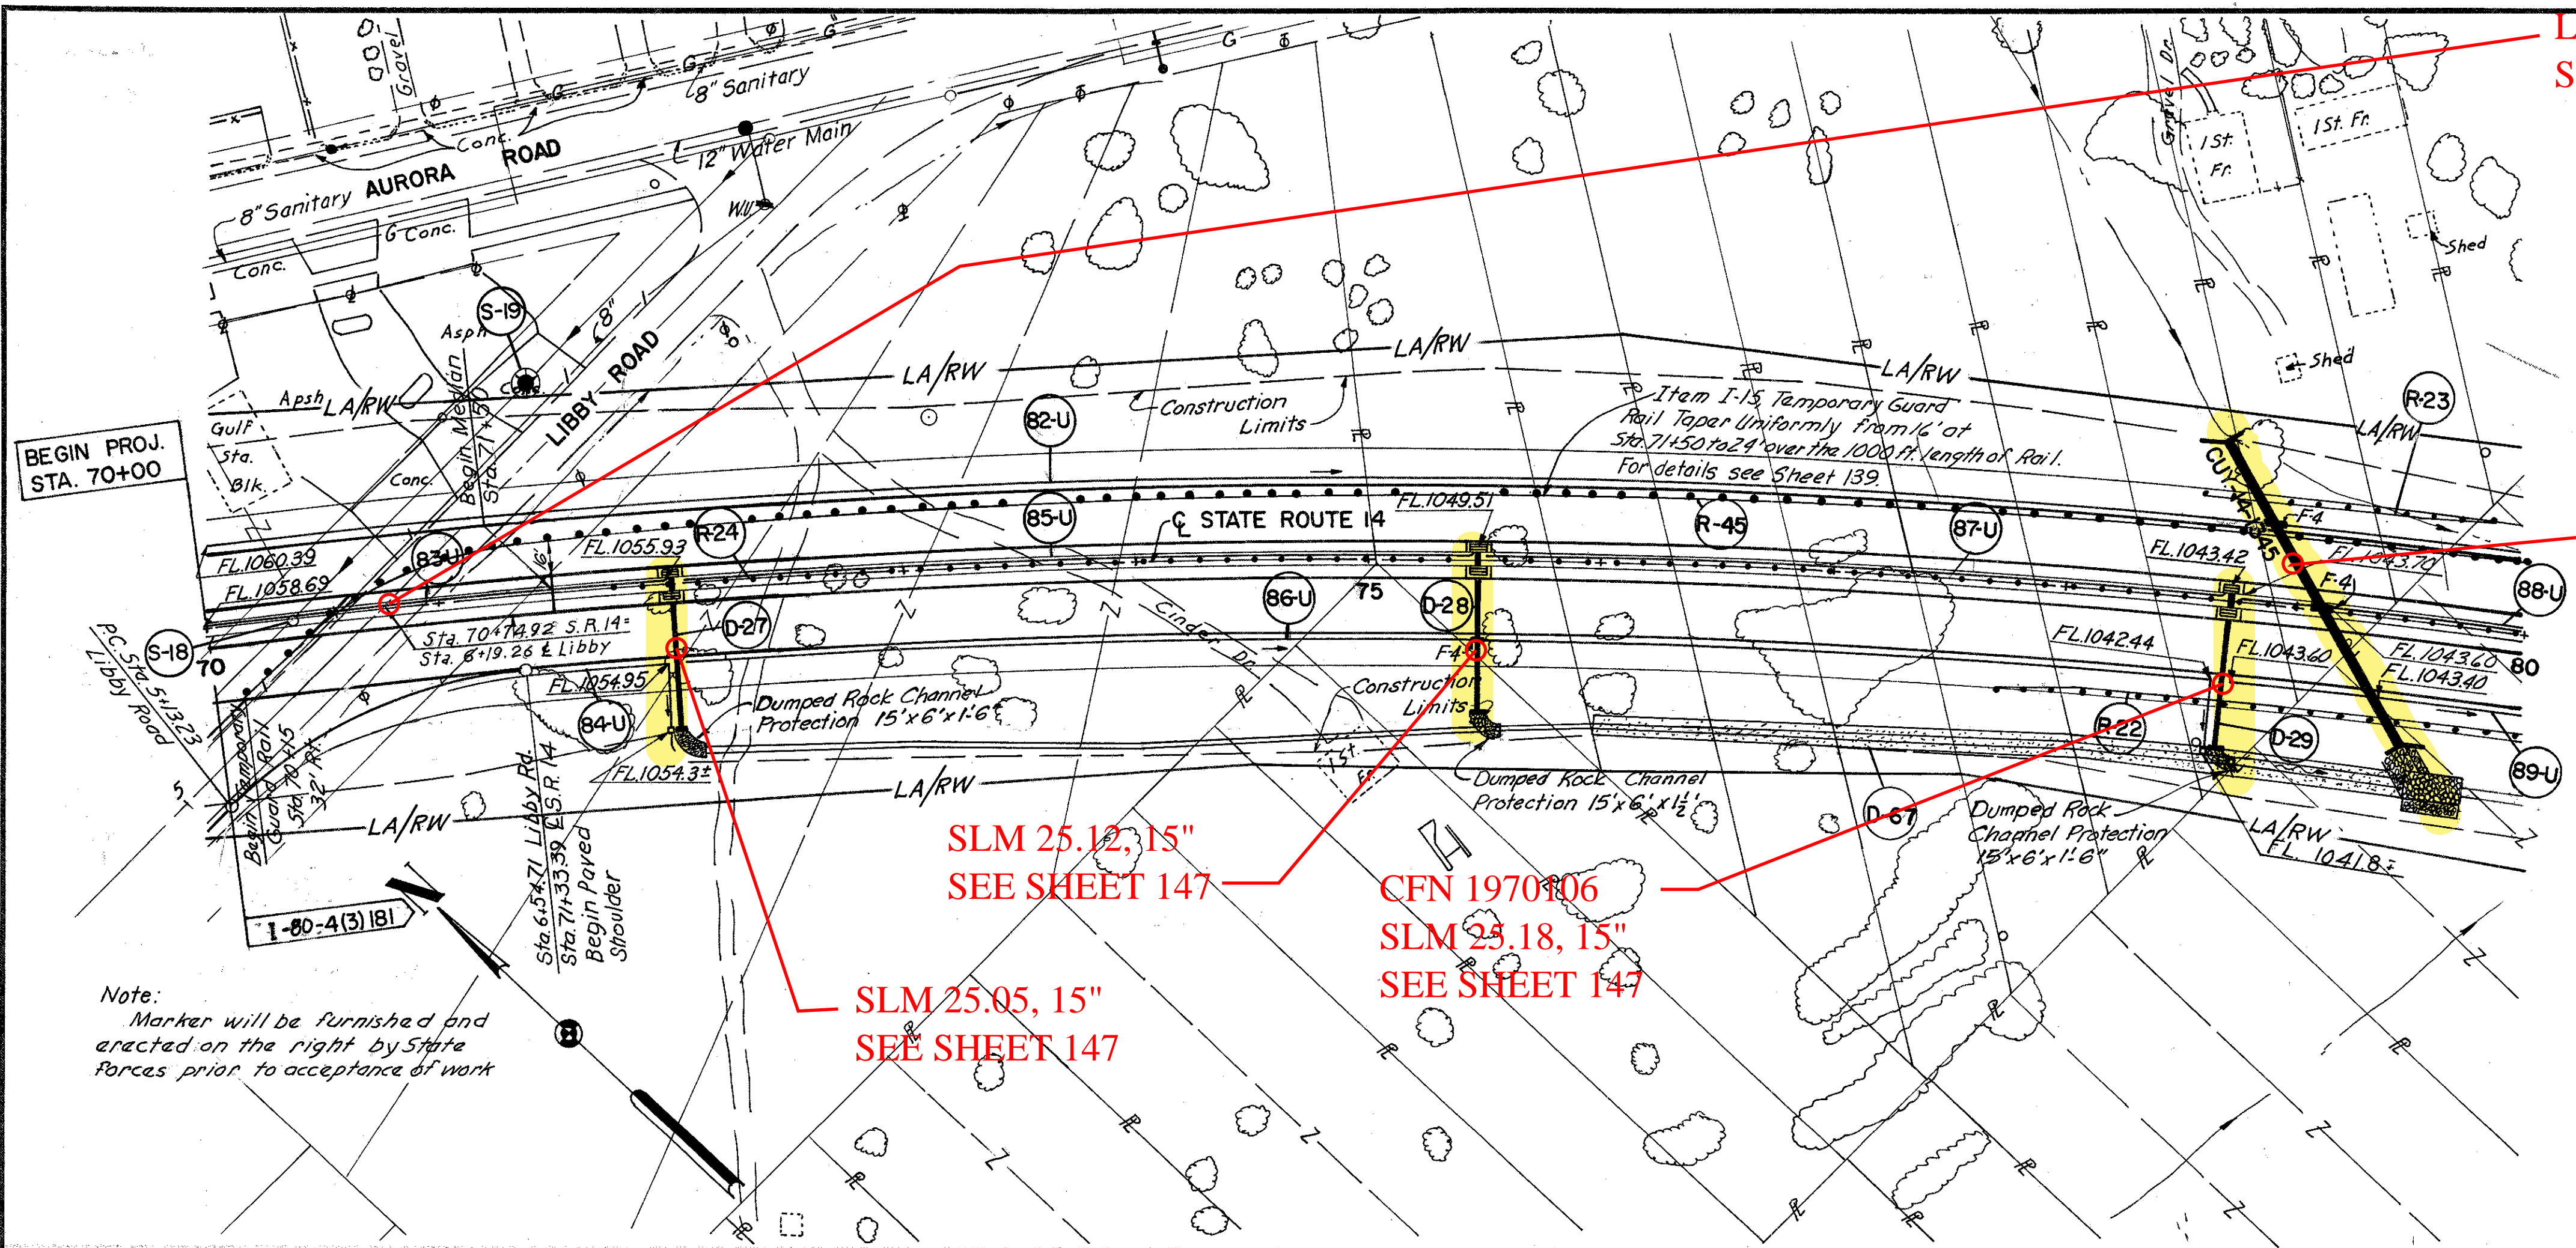

SLM 25.12, 15" SEE SHEET 147
CFN 1970106 SLM 23.18, 15" SEE SHEET 147
SLM 25.05, 15" SEE SHEET 147

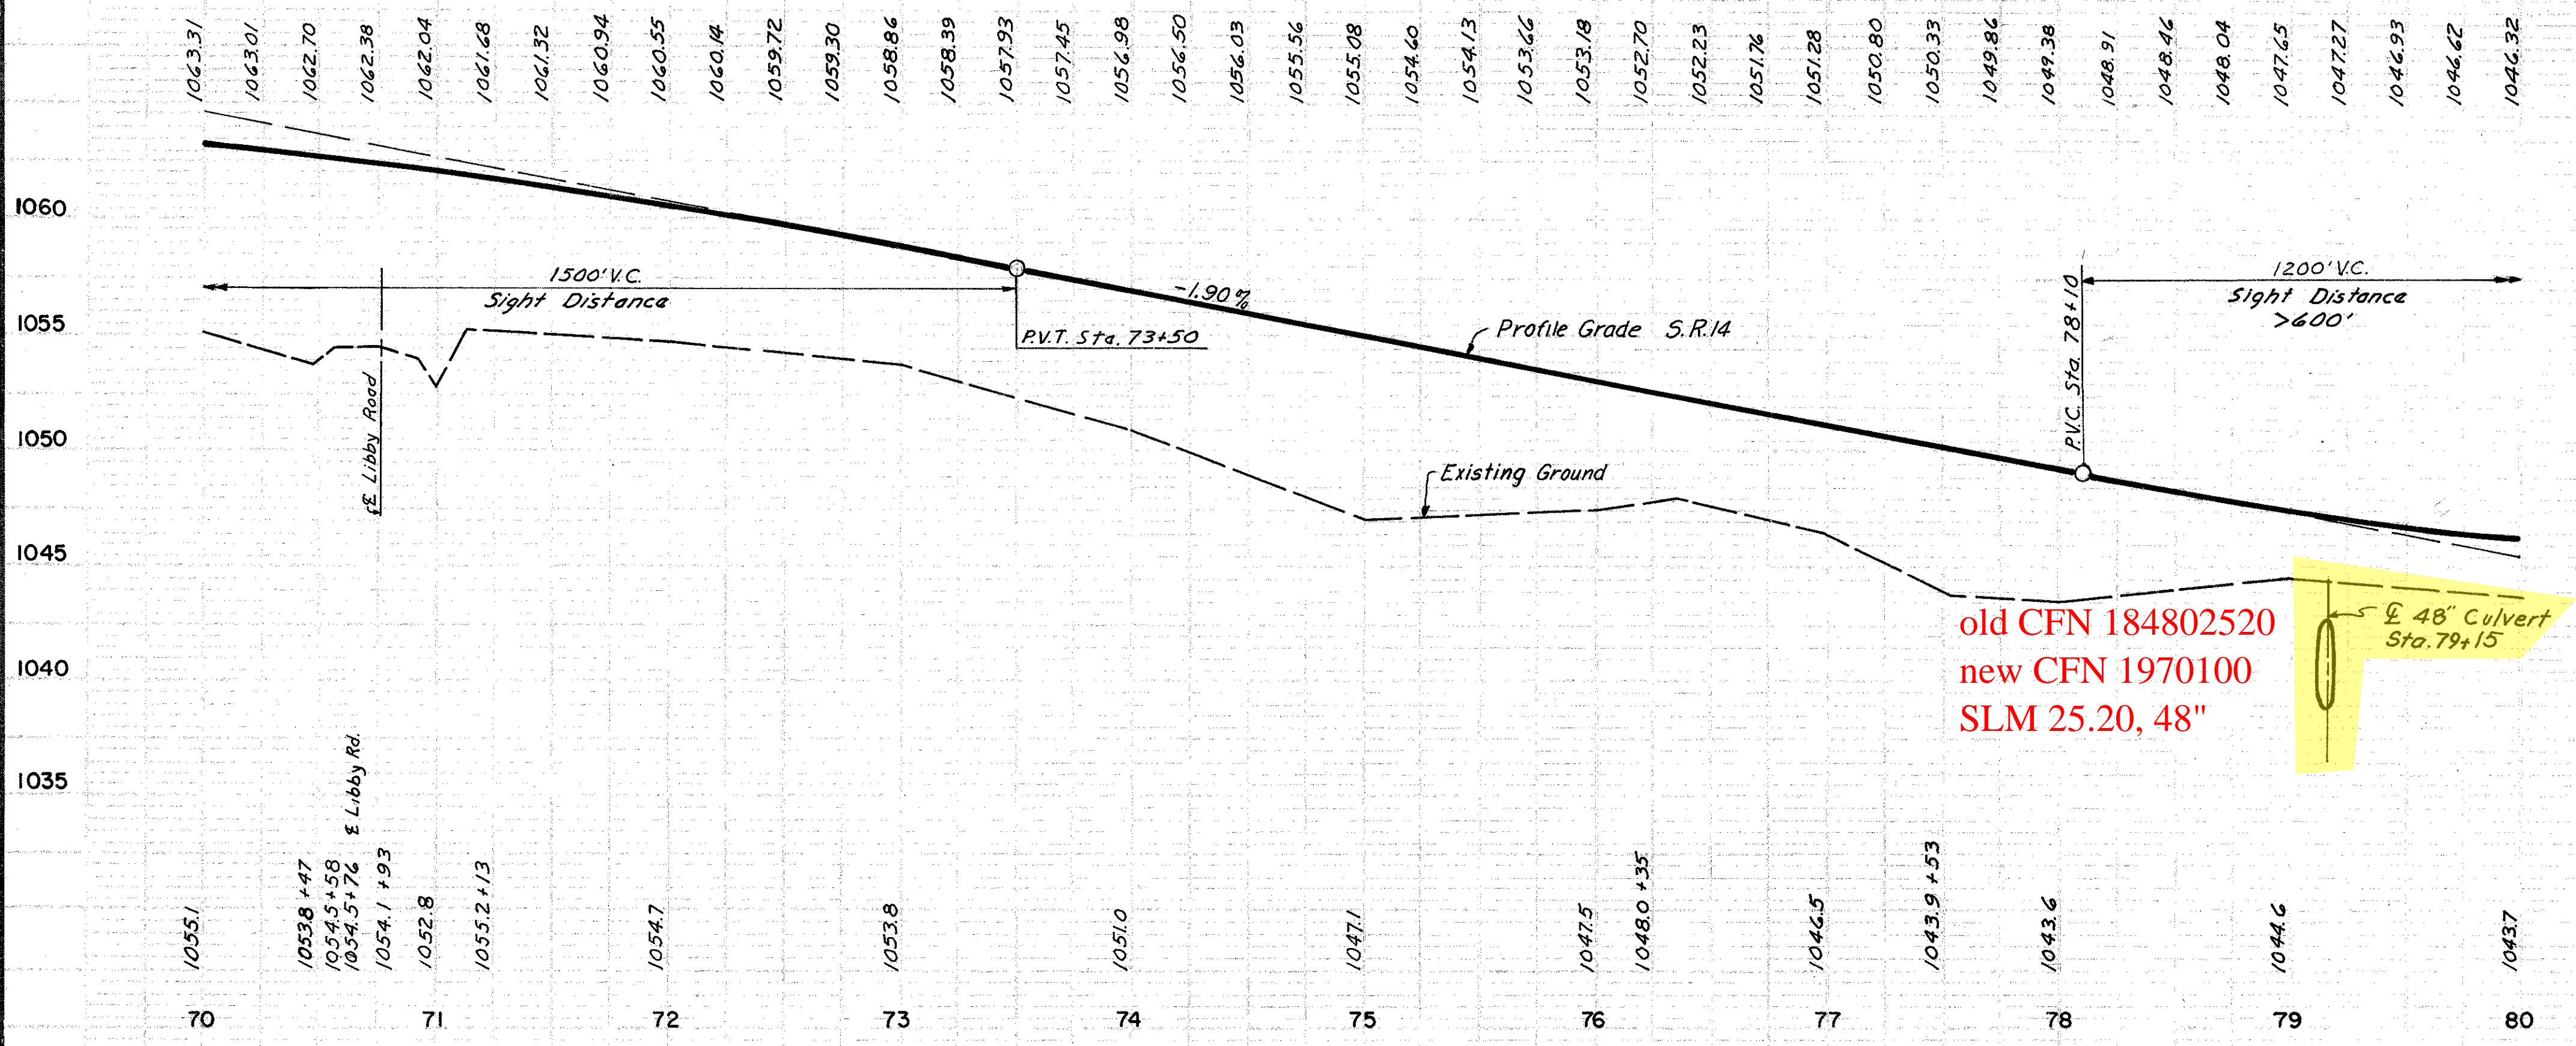

old CFN 184802520
new CFN 1970100
SLM 25.20, 48"
48" Culvert Sta. 79+15

PLAN
DATE: 7/26/43
BY: R.O.J.
SURVEYED: []
PLOTTED: []
NOTE BOOK: []
ALIGNMENT CHECKED: []
RT. OF WAY CHECKED: []

PROFILE
DATE: 7/26/43
BY: R.O.J.
SURVEYED: []
PLOTTED: []
NOTE BOOK: []
GRADES CHECKED: []
STRUCTURE NOTATIONS: []