


FED. RD. DIVISION	STATE	PROJECT
2	OHIO	

80
110

CUYAHOGA COUNTY
CUY-77-8.69
CUY-80-17.37

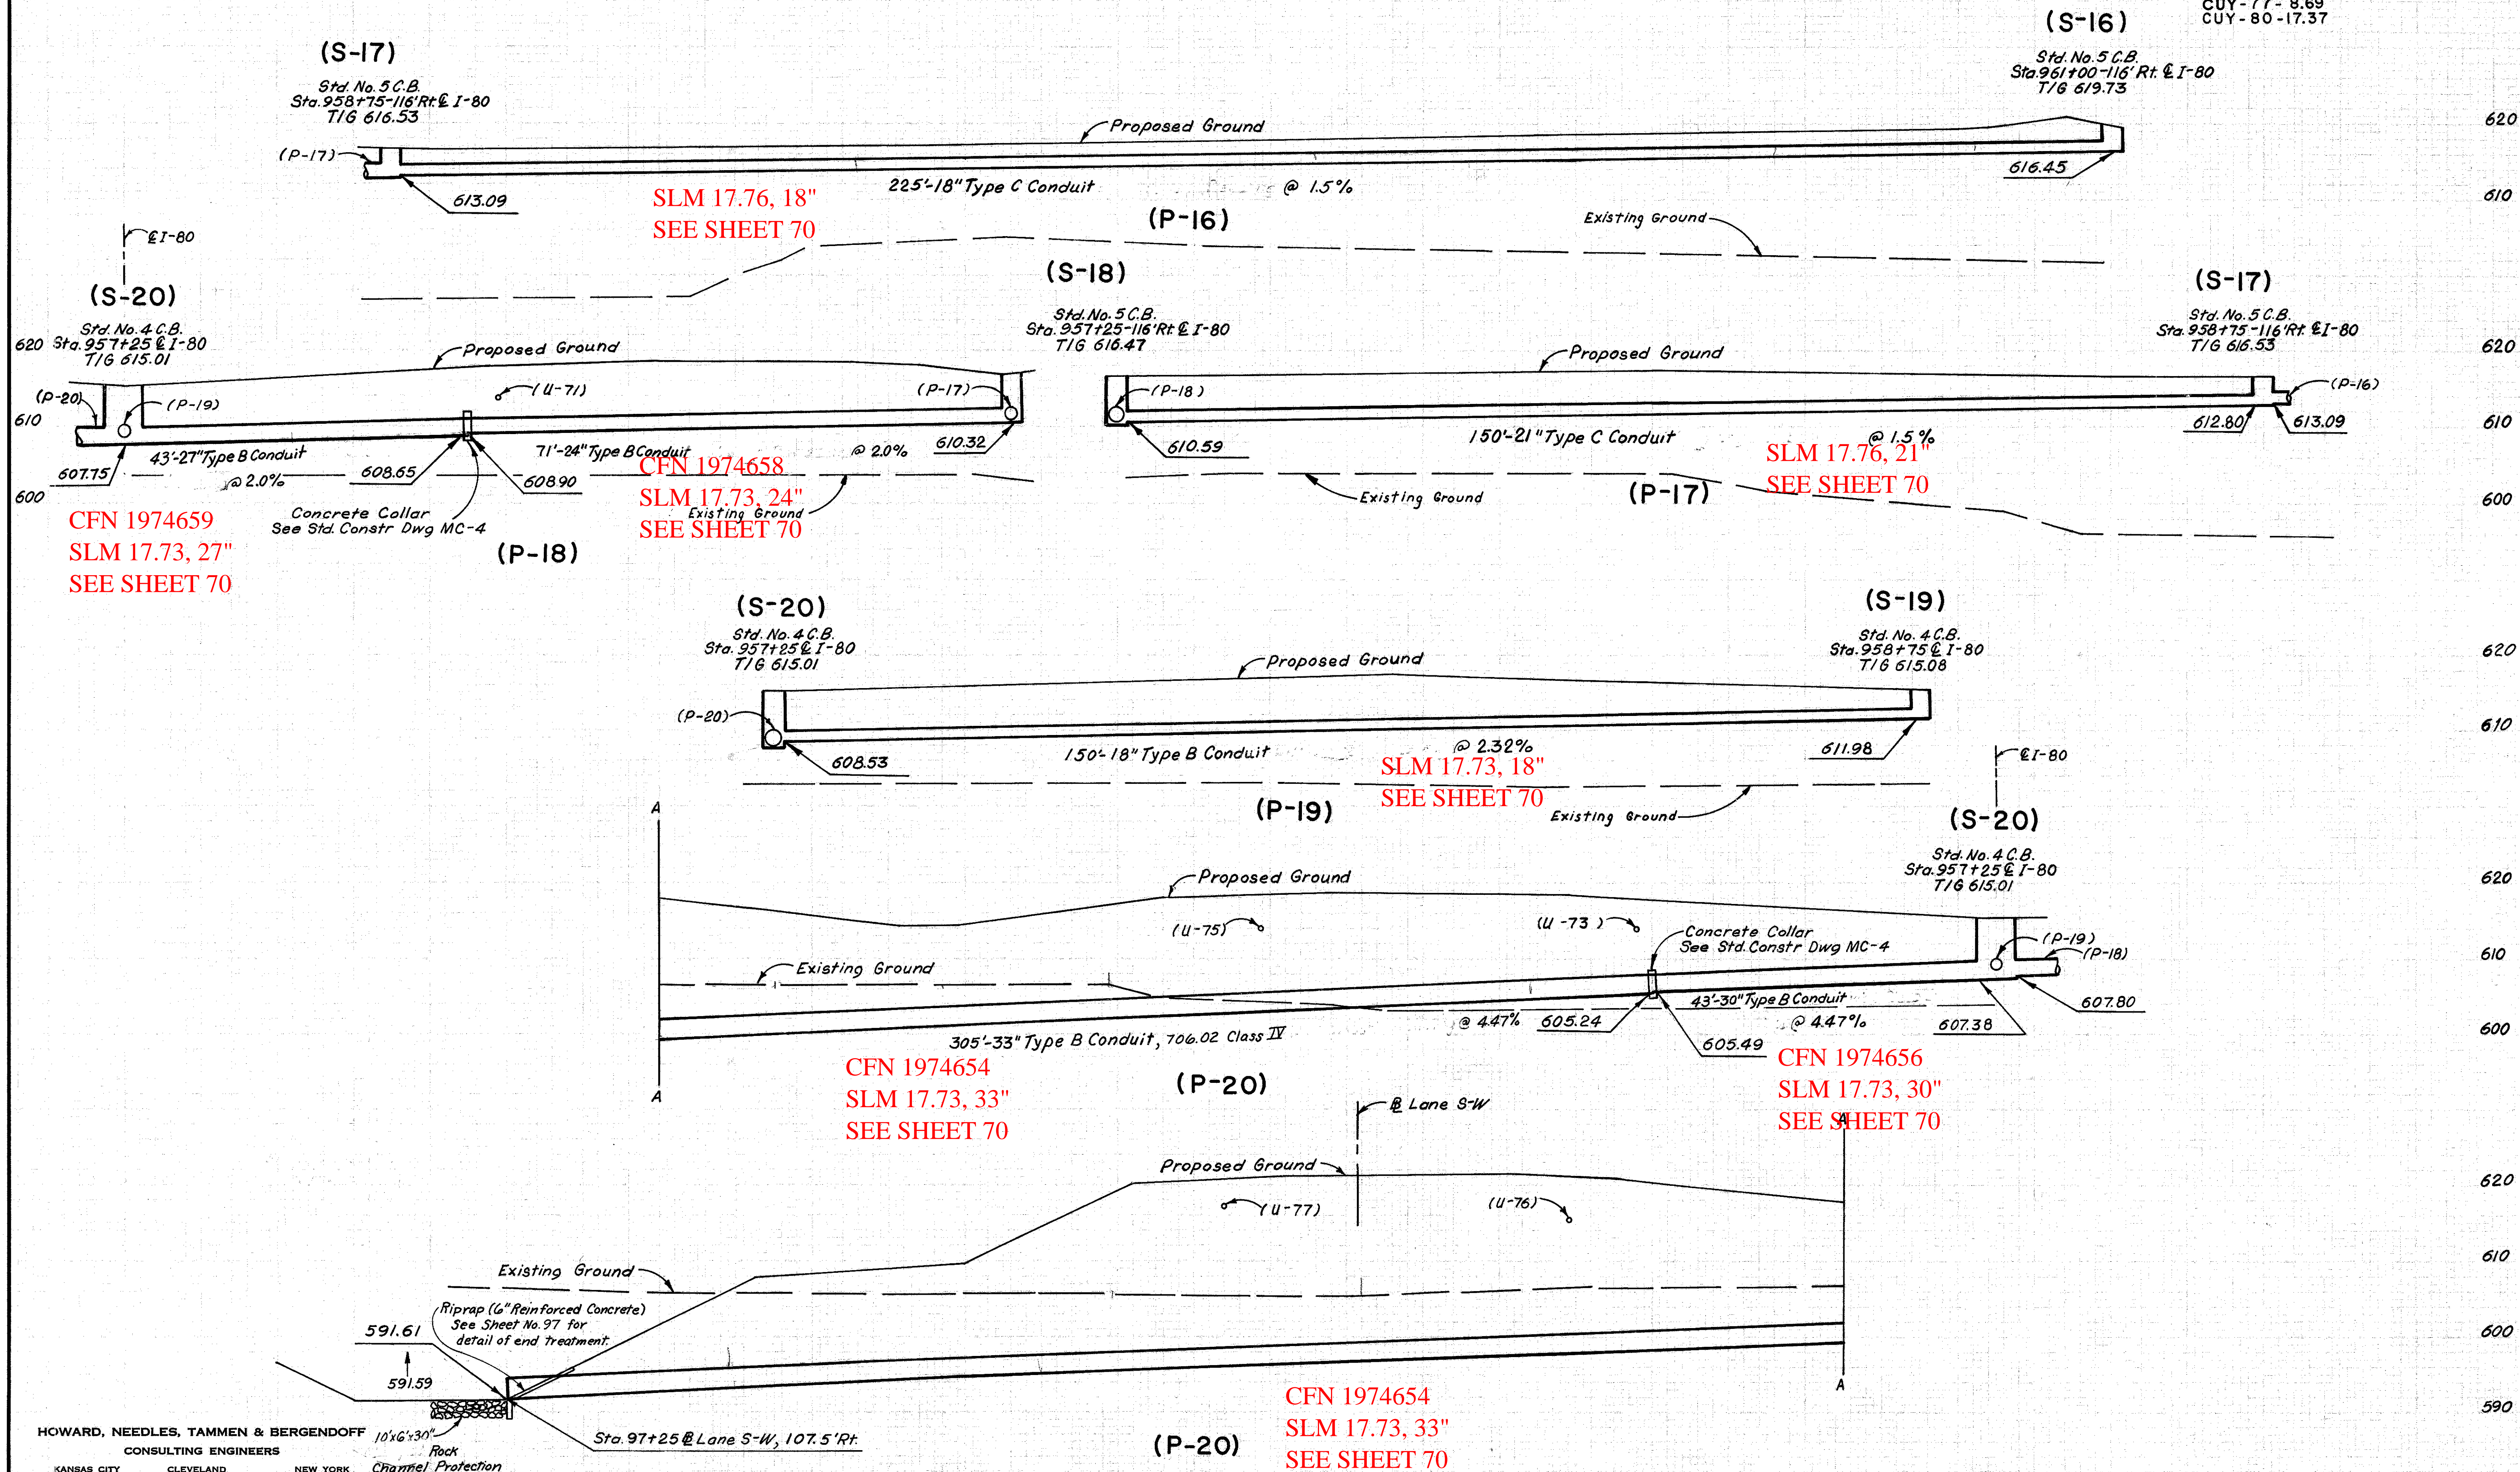

HOWARD, NEEDLES, TAMMEN & BERGENDOFF
CONSULTING ENGINEERS
KANSAS CITY CLEVELAND NEW YORK