

SLM 19.10, 8"
SEE SHEET 34

SLM 19.10, 12"
SEE SHEET 34

SLM 19.10, 14"
SEE SHEET 34

SLM 19.19, 15"
SEE SHEET 35

CFN 1974717
SLM 19.22, 18"
SEE SHEET 35

SLM 19.22, 12"
SEE SHEET 35

old CFN 184801928
new CFN 1849835
SLM 19.28, 33"
SEE SHEET 32

old CFN 184801893
new CFN 1885309
SLM 18.93, 72"
SEE SHEET 29
AND 30

old CFN 184801910
new CFN 1885380
SLM 19.10, 54"
SEE SHEET 30
SLM 19.11, 48"
SEE SHEET 37

old CFN 184801913
new CFN 1849834
SLM 19.13, 36"
SEE SHEET 30
AND 31
SLM 19.11, 54"
SEE SHEET 30


old CFN 184801906
new CFN 1885379
SLM 19.06, 54"
SEE SHEET 30

old CFN 184801919
new CFN 1849836
SLM 19.19, 54"
SEE SHEET 31

SLM 19.22, 48"
SEE SHEET 31

SLM 19.28, 48"
SEE SHEET 32

Note: 10' Lengths of 6" Type "F" Underdrain outlet pipe at Catch Basin S-23 are Part I construction. Provide a temporary Bulk Head as a part of this 603 Item.
See Sheet No. 24 for Drainage Quantities:

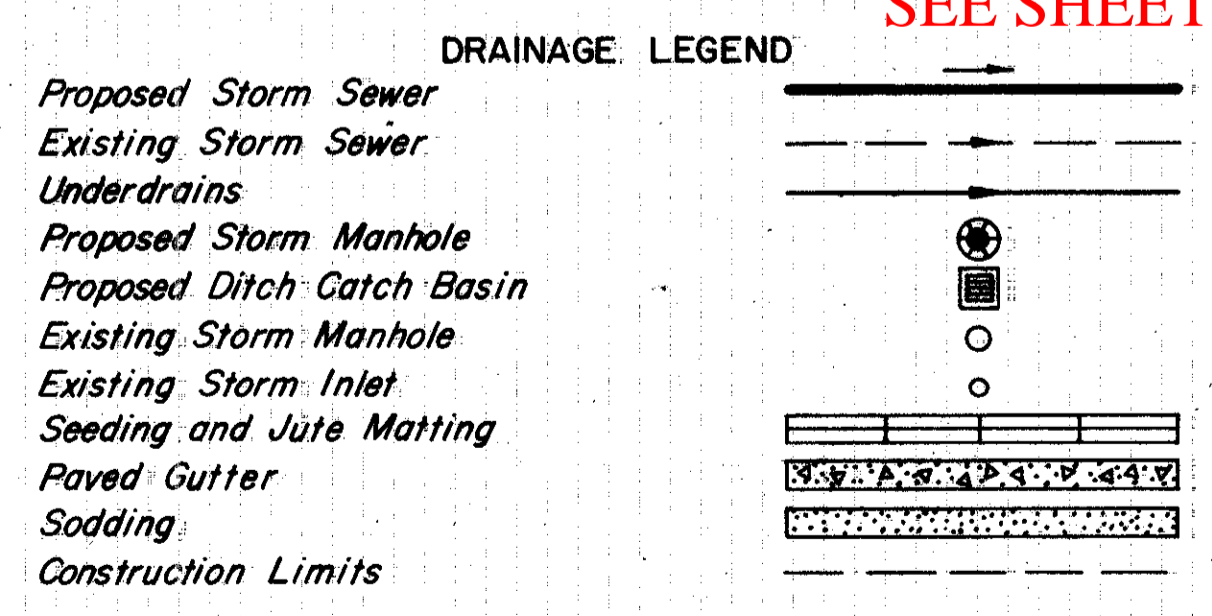

SCALE 1" = 50'
HOWARD, NEEDLES, TAMMEN & BERGENDOFF
MADE D.D.S. DATE 10-10-69 CONSULTING ENGINEERS
TRCD J.M.C. DATE 10-15-69
CKD N.N.B. DATE 11-18-69 KANSAS CITY CLEVELAND NEW YORK