


FED. RD. DIVISION	STATE	PROJECT
2	OHIO	

CUYAHOGA COUNTY
CUY-480-18.43

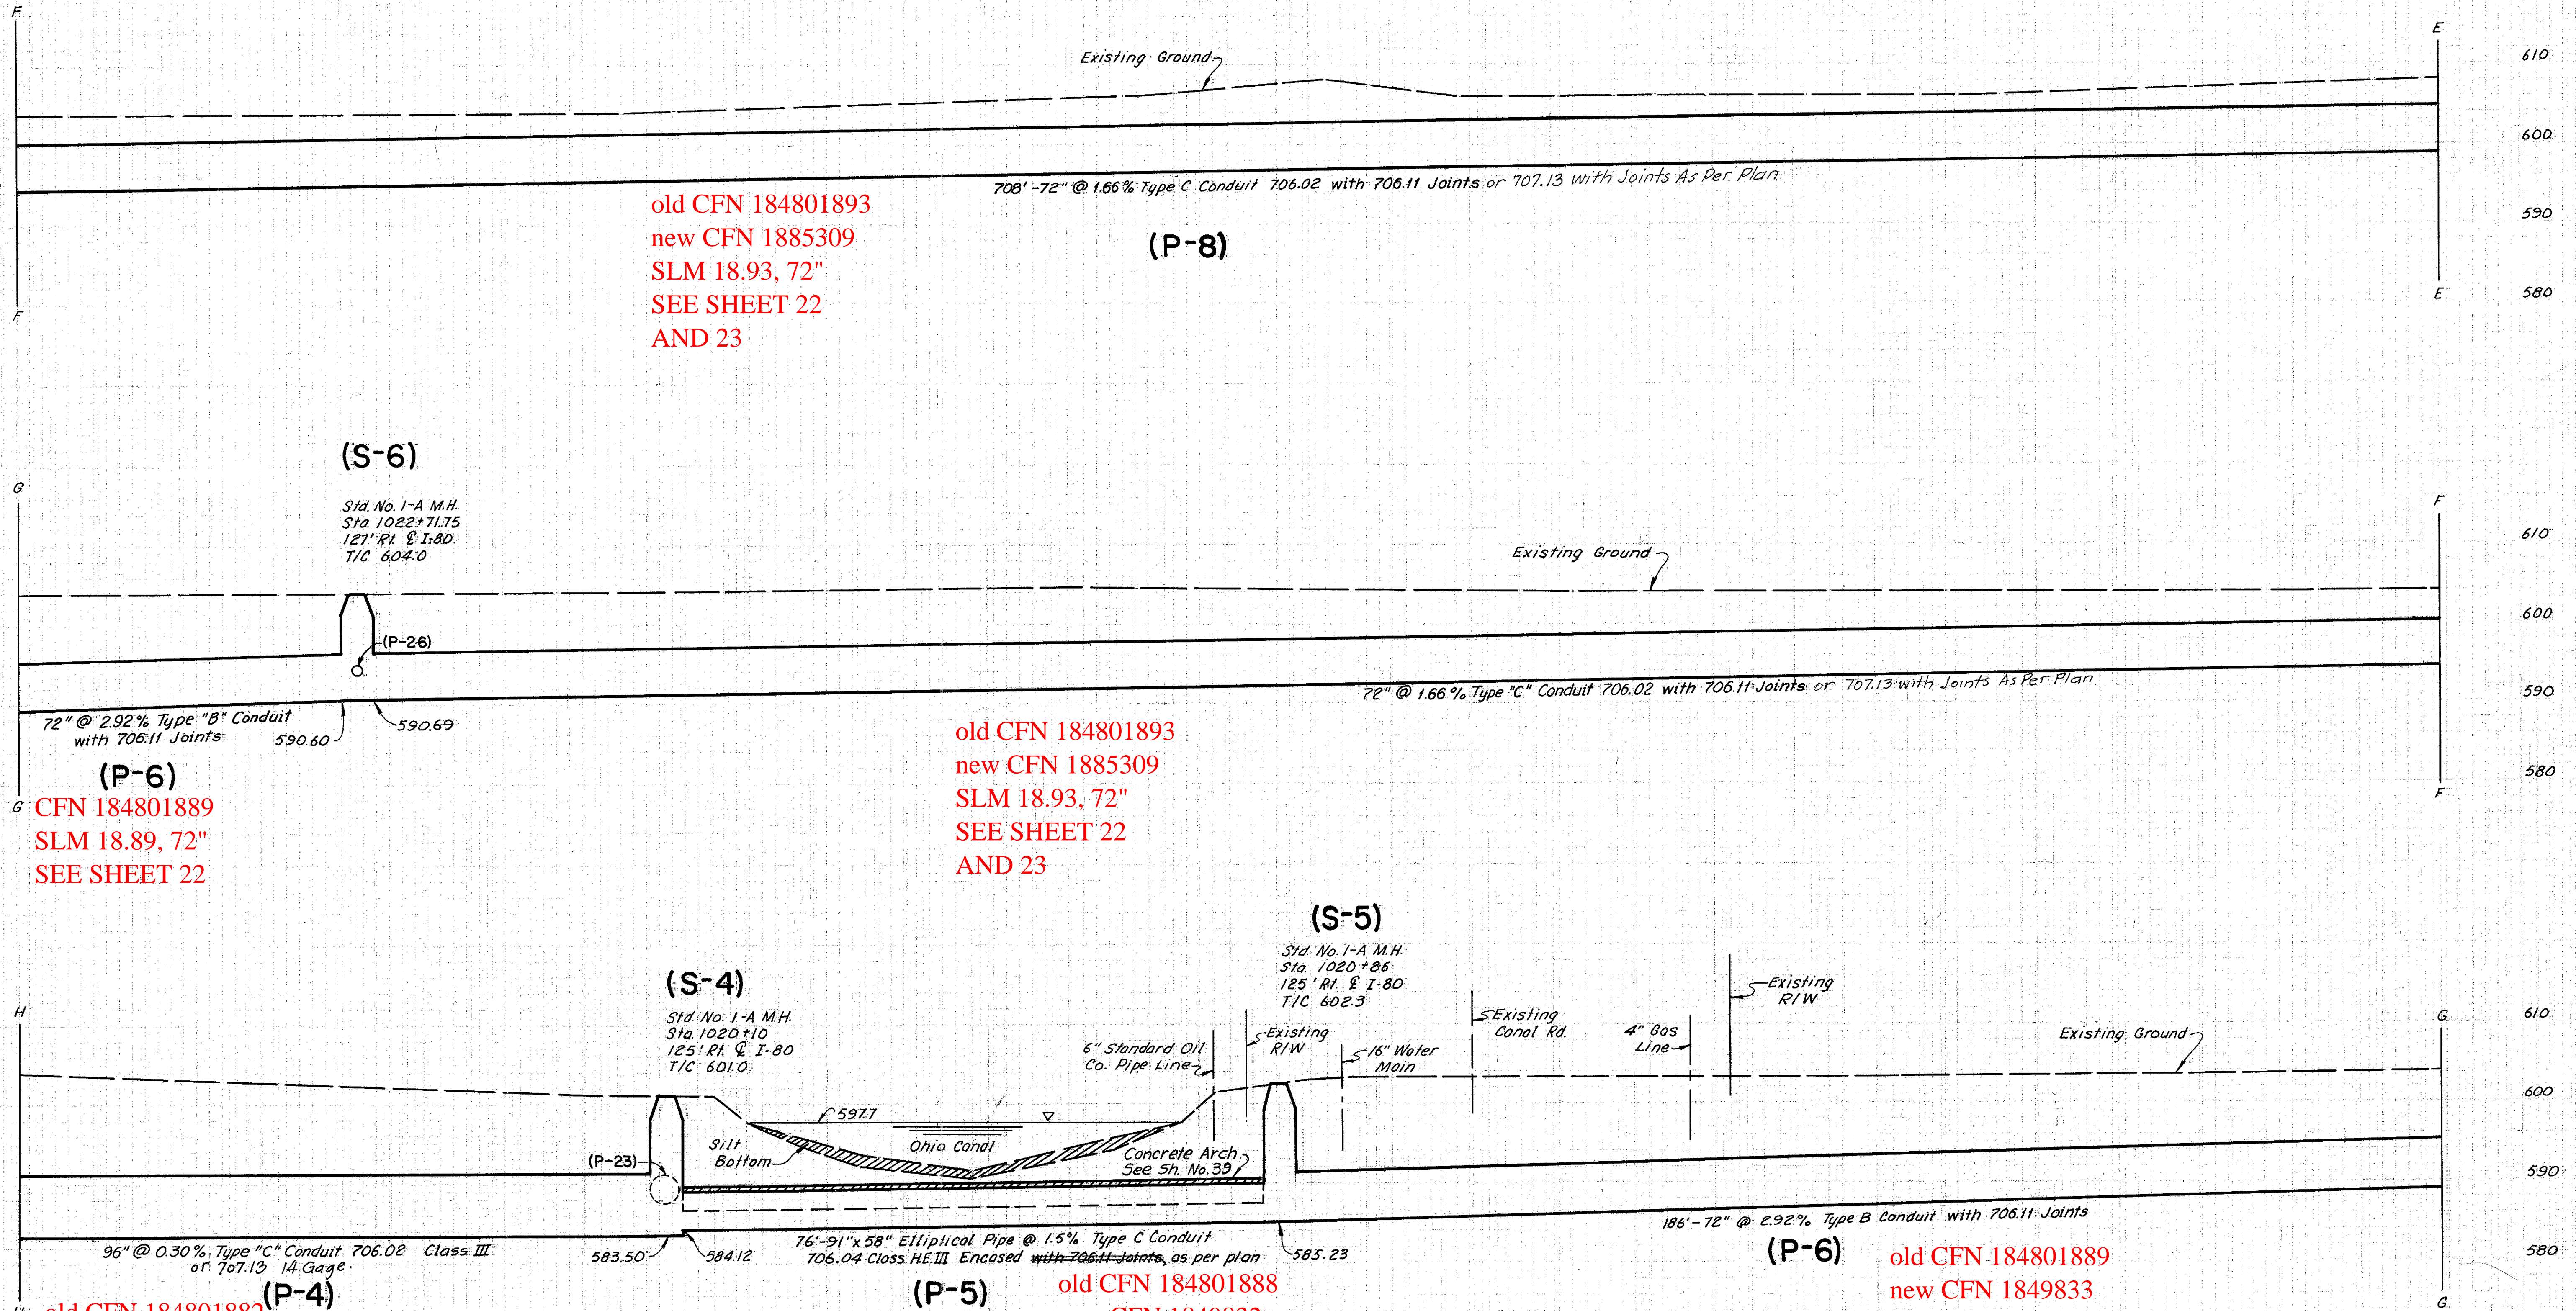

old CFN 184801893
new CFN 1885309
SLM 18.93, 72"
SEE SHEET 22
AND 23

(P-8)

(S-6)

Std. No. 1-A M.H.
Sta. 1022+71.75
127' R.I. & I-80
T/C 604.0

(P-6)

CFN 184801889
SLM 18.89, 72"
SEE SHEET 22

old CFN 184801893
new CFN 1885309
SLM 18.93, 72"
SEE SHEET 22
AND 23

(S-5)

Std. No. 1-A M.H.
Sta. 1020+86
125' R.I. & I-80
T/C 602.3

(S-4)

Std. No. 1-A M.H.
Sta. 1020+10
125' R.I. & I-80
T/C 601.0

(P-4)

old CFN 184801882
new CFN 1885308
SLM 18.82, 96"
SEE SHEET 22
AND 23


(P-5)

old CFN 184801888
new CFN 1849832
SLM 18.89, 72"
SEE SHEET 22
AND 23

(P-6)

old CFN 184801889
new CFN 1849833
SLM 18.89, 72"
SEE SHEET 22

Note:
A minimum flow of 53 cubic feet per second must be maintained in the Ohio Canal at all times. The contractor is directed to furnish the Engineer his construction procedure for the proposed storm sewer under the canal for the Engineer's approval prior to the beginning of construction of the sewer.

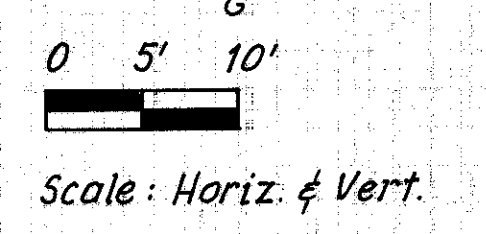

P.D.S. N.N.B. 10-20-69
 10-20-68
 10-20-69
 D.D.S.
 I.M.