
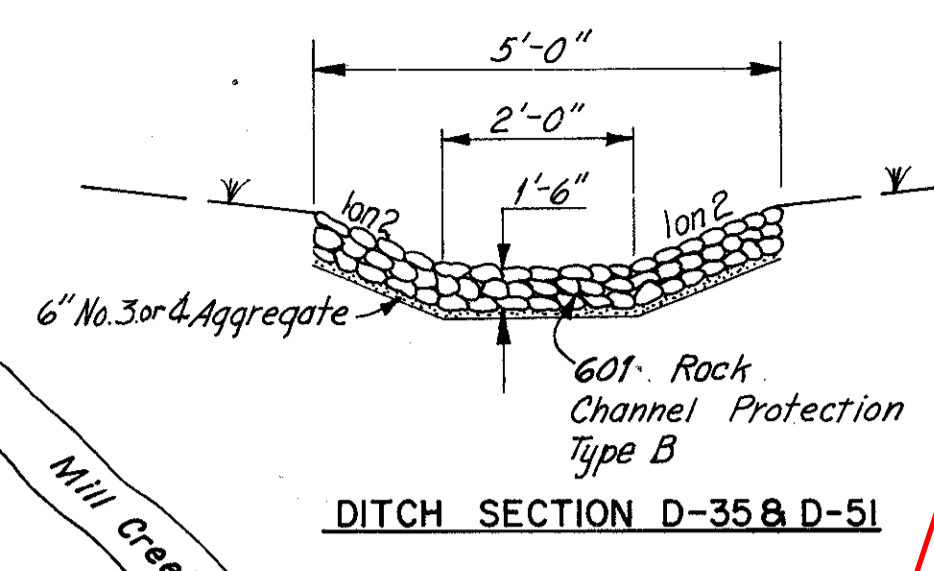
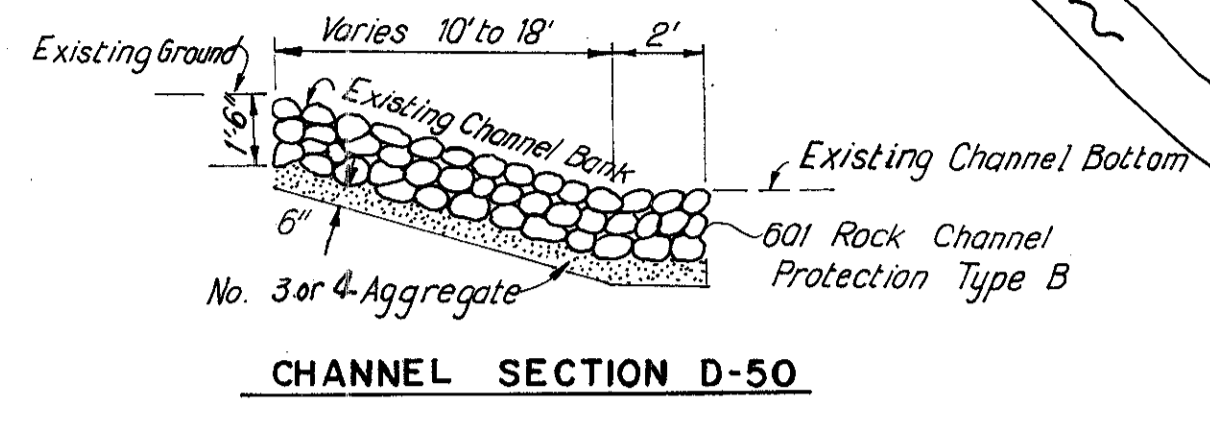
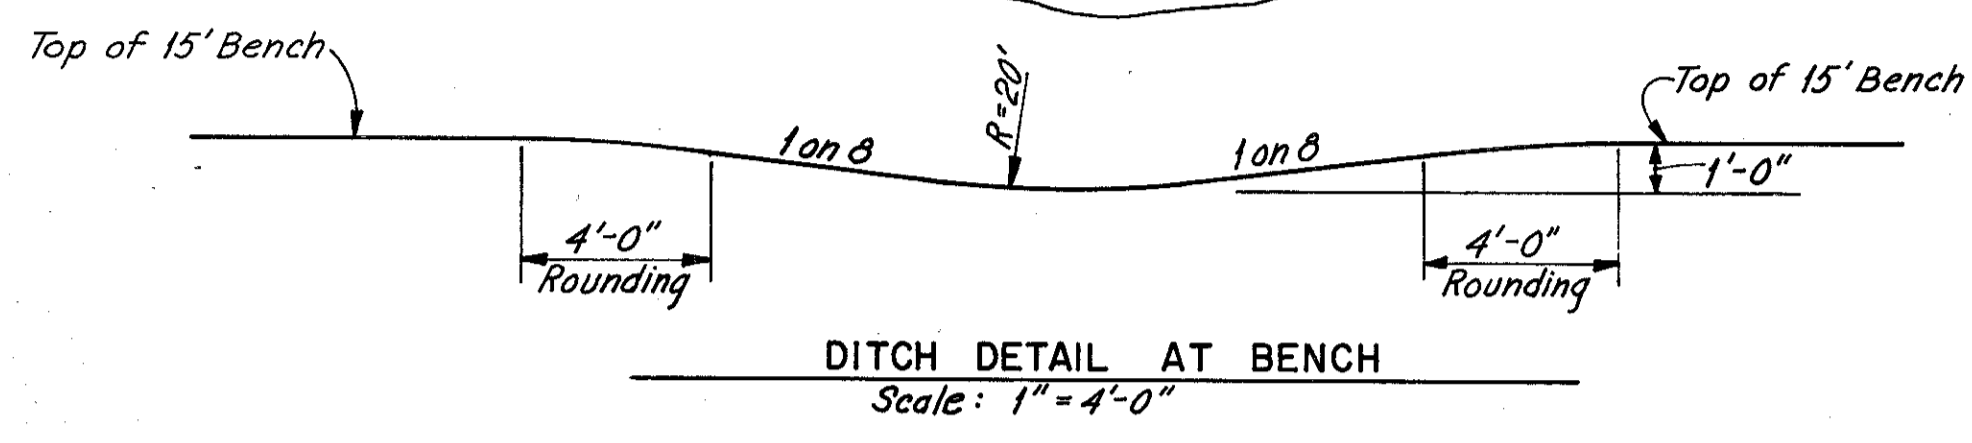


CFN 1974778
SLM 22.90, 15"
MM 25.07
SEE SHEET 179

CFN 1974777
SLM 22.90, 24"
MM 25.07
SEE SHEET 96
20'x40' CHANNEL
EASEMENT. SEE
ROW SHEET 16

SLM 22.96=MM 25.13

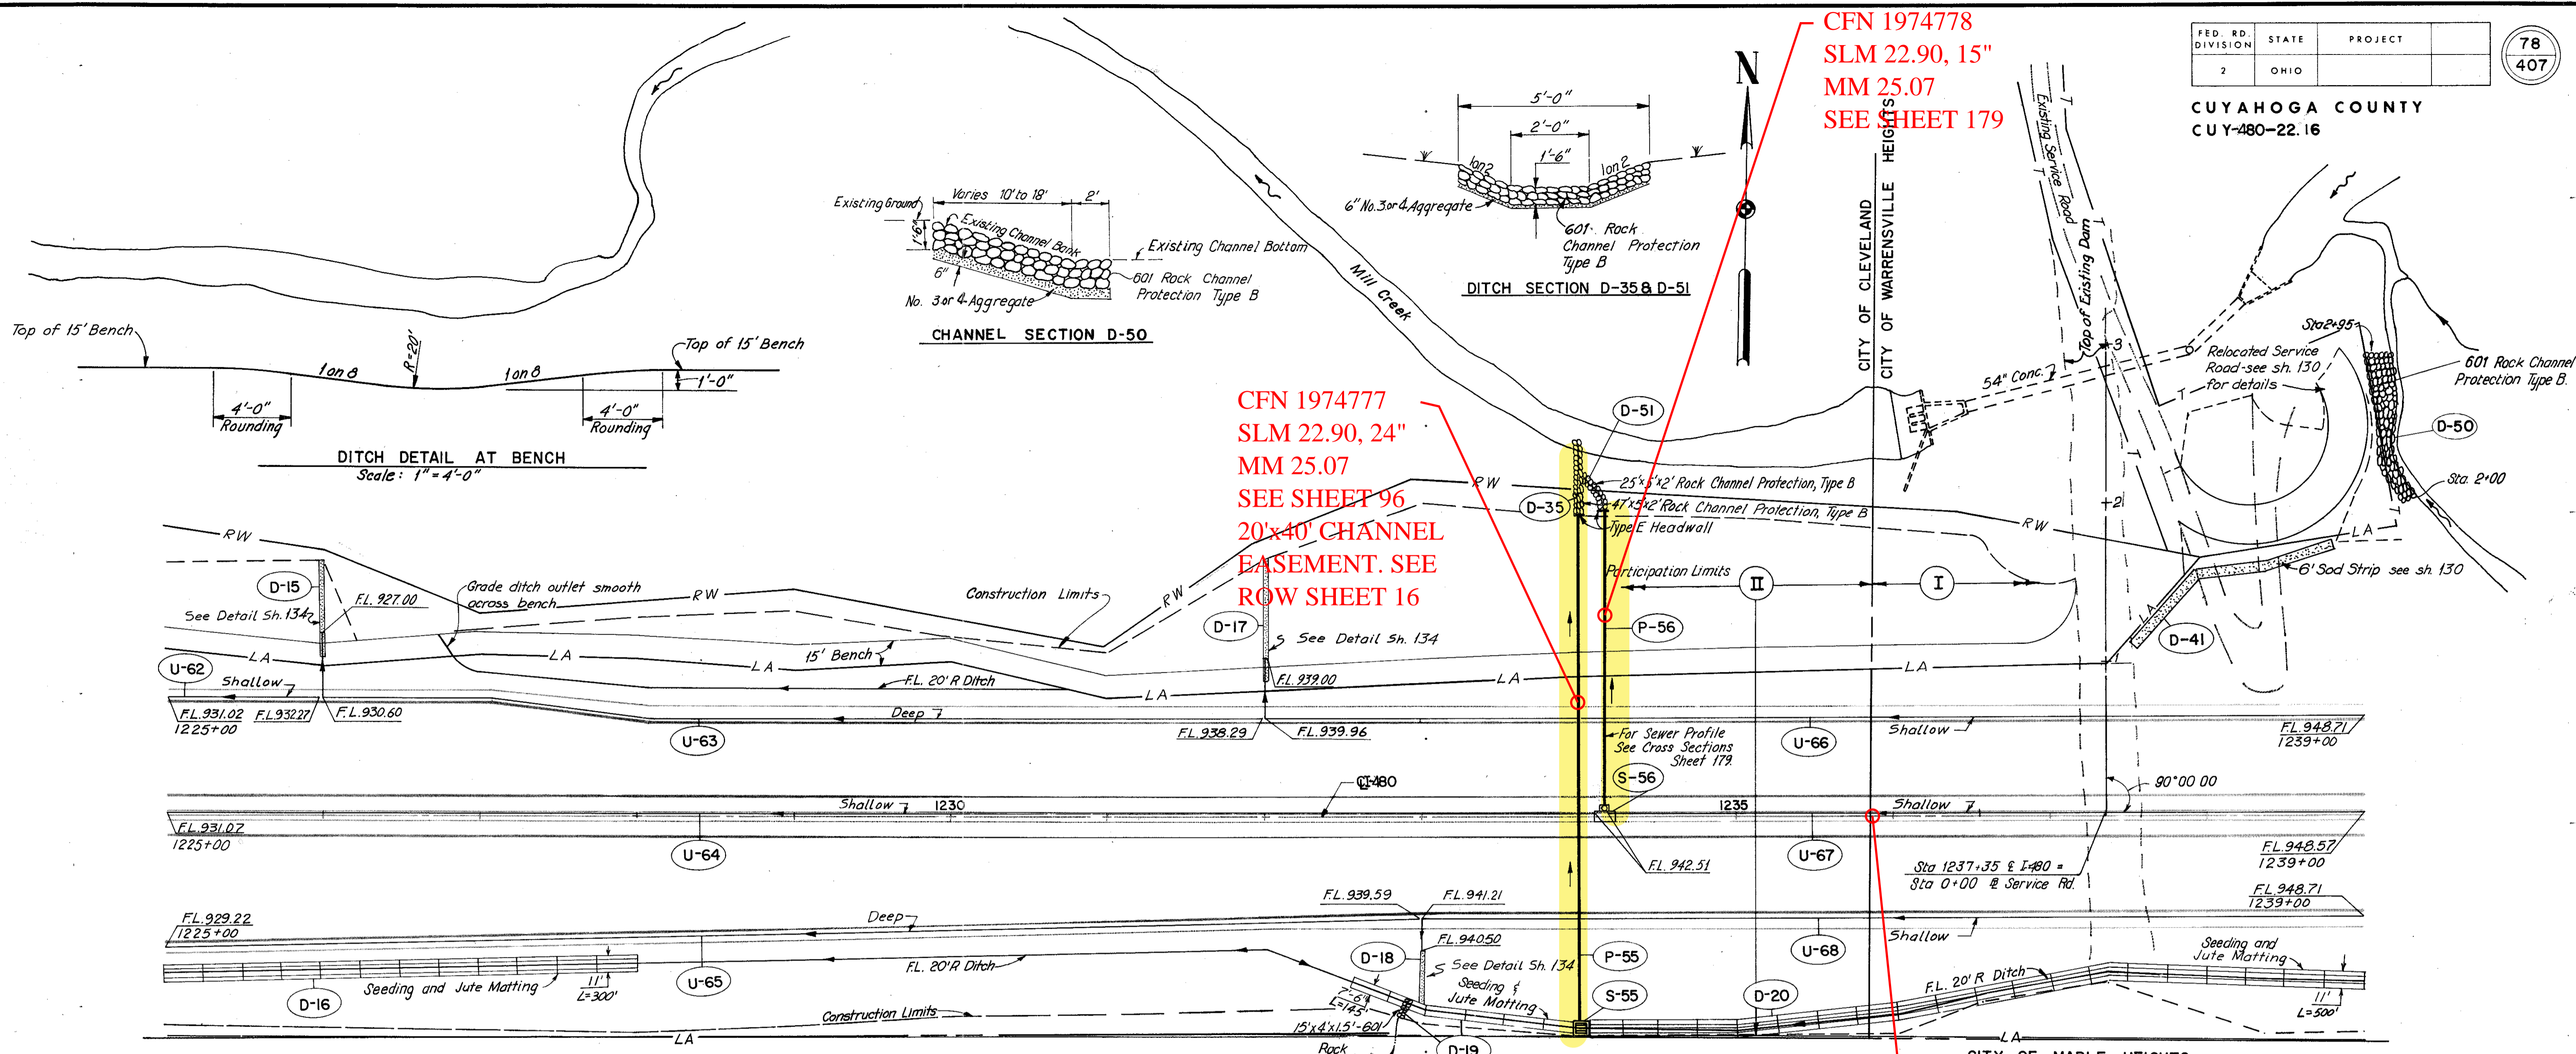

DRAINAGE LEGEND

- Proposed Storm and Sanitary Sewers ———→
- Existing Storm Sewer and Sanitary Sewer - - - - -→
- Proposed Storm Manhole (circle with cross)
- Proposed Sanitary Manhole (circle with dot)
- Proposed Paved Shoulder Inlet (circle with horizontal line)
- Proposed Paved Shoulder Inlet Manhole (circle with horizontal line and dot)
- Proposed Ditch Catch Basin (rectangle with cross-hatch)
- Proposed Pavement Catch Basin (rectangle with diagonal lines)
- Existing Storm and Sanitary Manhole (circle)
- Existing Storm Inlet (square)
- Seeding and Jute Matting (rectangle with wavy lines)
- Paved Gutter (rectangle with horizontal lines)
- Sodding (rectangle with vertical lines)
- Top of Cut Slope (dashed line)
- Toe of Fill Slope (dashed line)



SCALE 1"=50'
HOWARD, NEEDLES, TAMMEN & BERGENDOFF
MADE D.O.S. DATE 4-2-68 CONSULTING ENGINEERS
TRCD. DATE KANSAS CITY CLEVELAND NEW YORK
CKD_DCF DATE 8-22-69

Note:
See Sheet 79 for Drainage Quantities.
NOV 3 1970