


CUYAHOGA COUNTY  
CUY 480-21.40

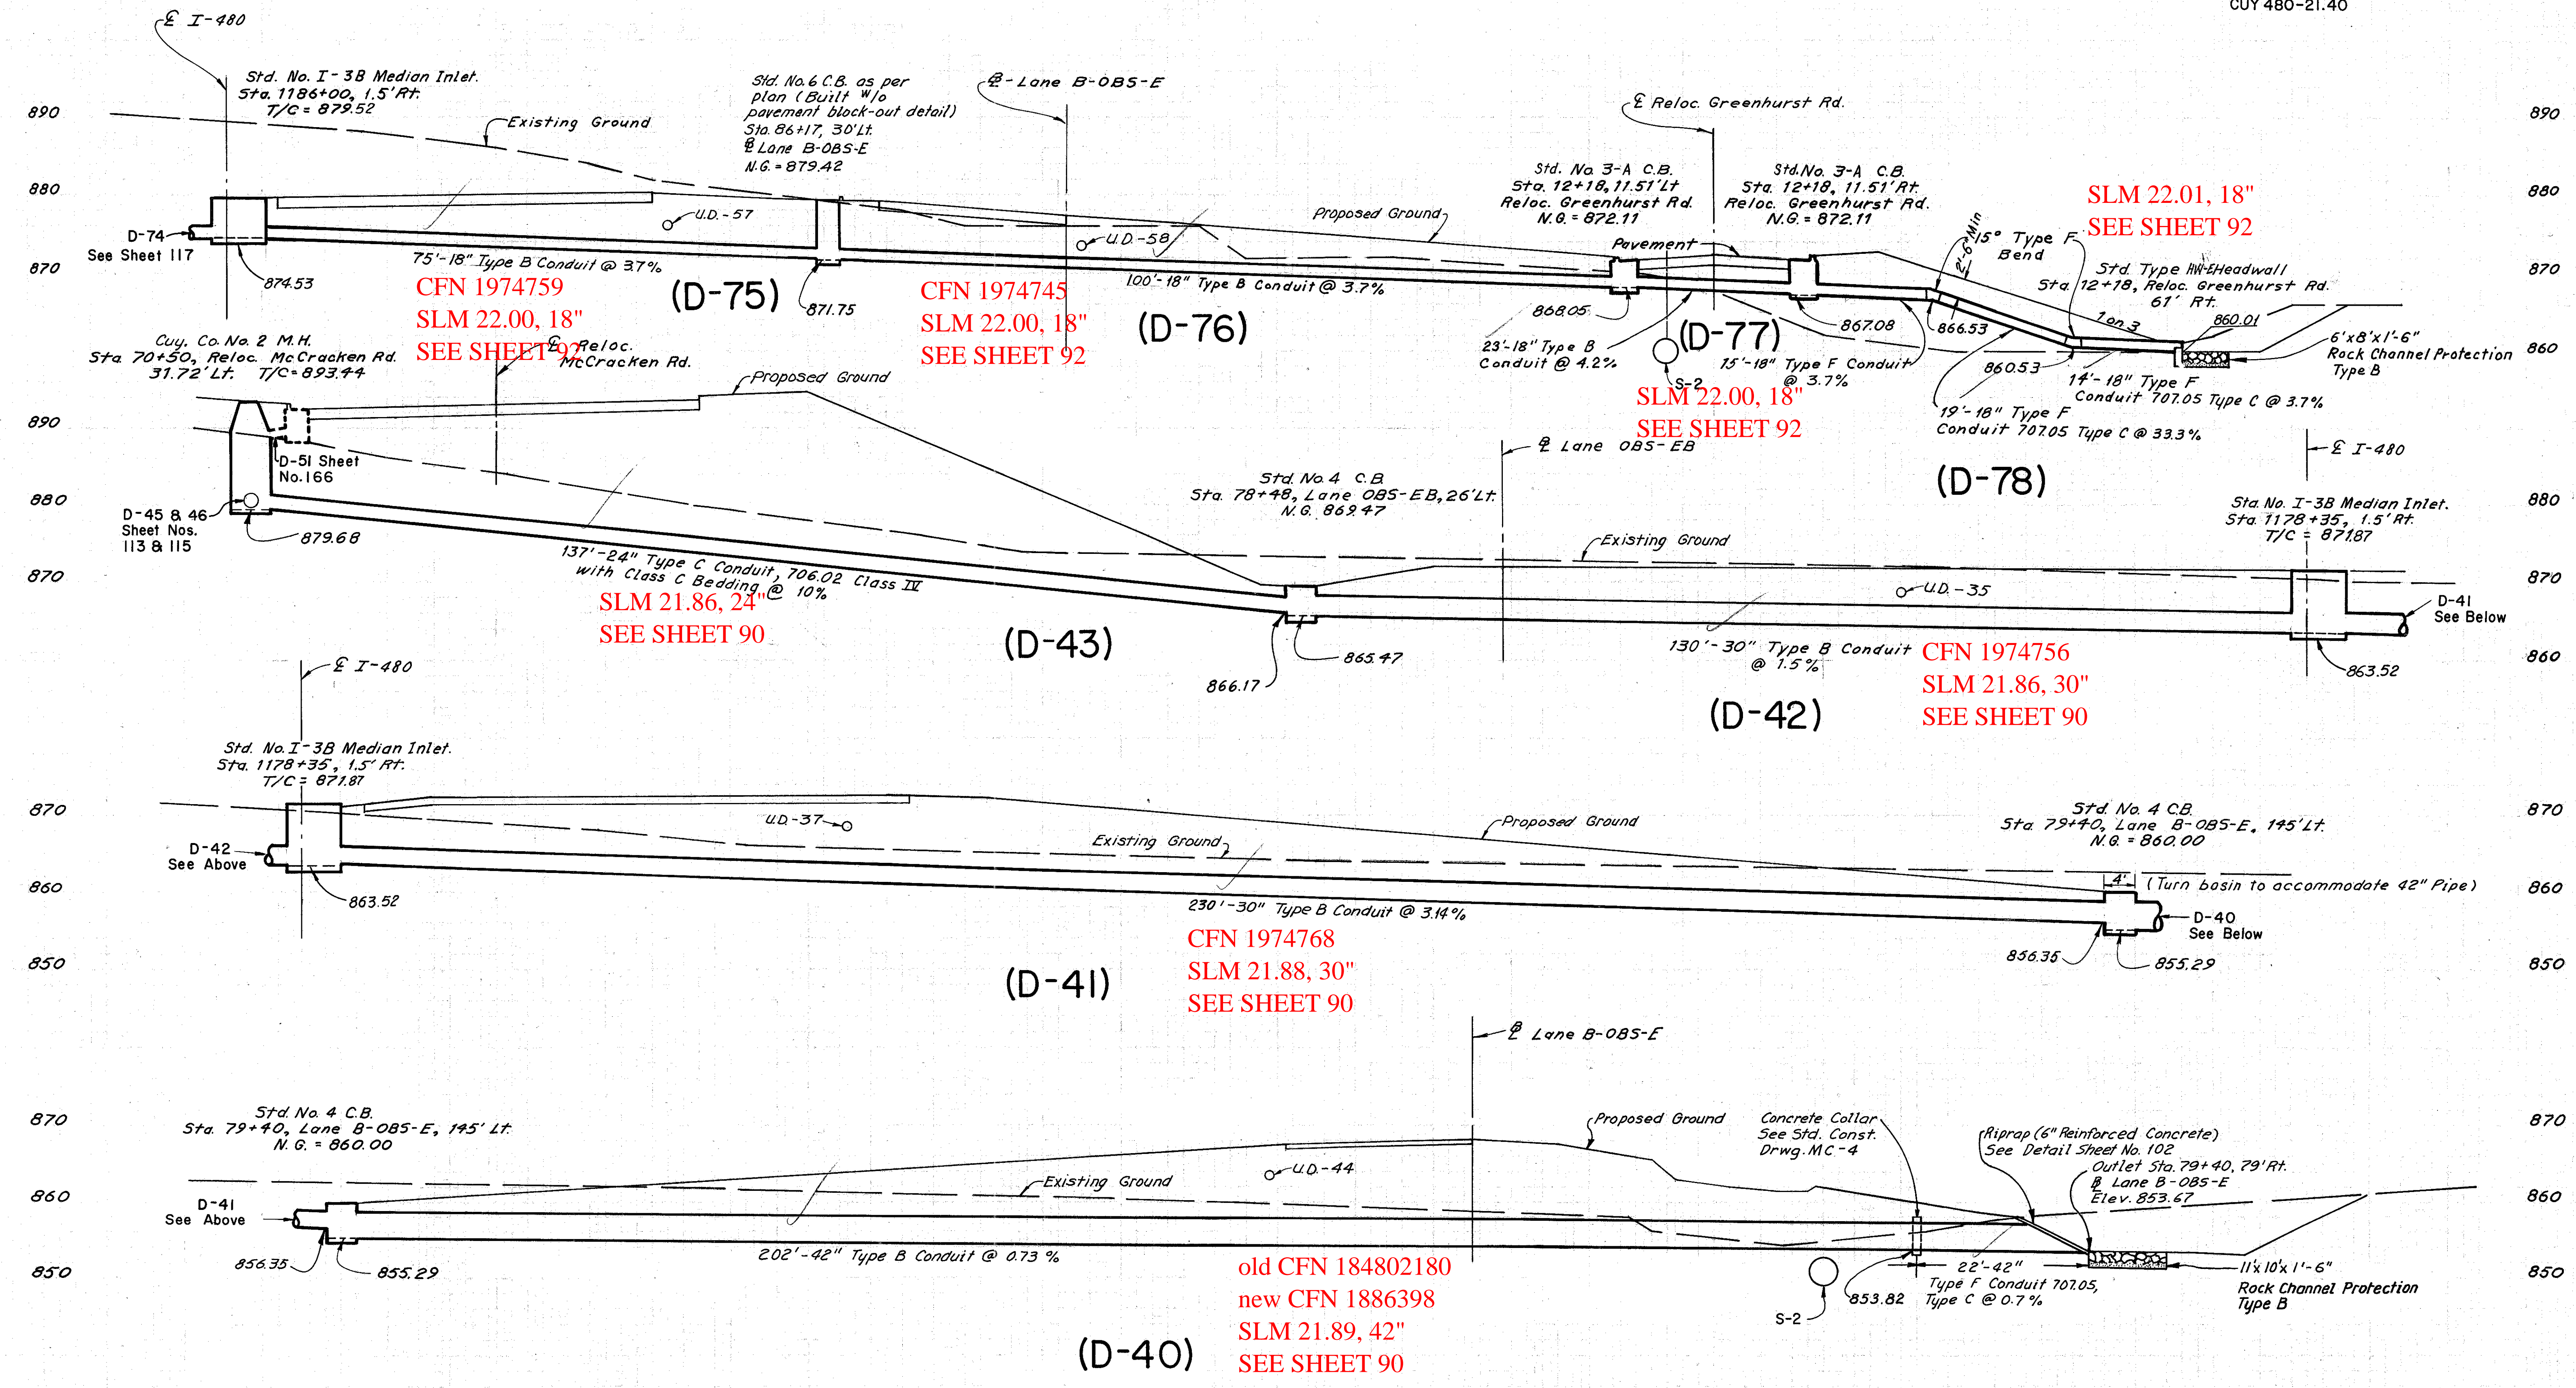

CFN 1974759  
SLM 22.00, 18"  
SEE SHEET 92

CFN 1974745  
SLM 22.00, 18"  
SEE SHEET 92

SLM 22.00, 18"  
SEE SHEET 92

SLM 22.01, 18"  
SEE SHEET 92

SLM 21.86, 24"  
SEE SHEET 90

CFN 1974756  
SLM 21.86, 30"  
SEE SHEET 90

CFN 1974768  
SLM 21.88, 30"  
SEE SHEET 90

old CFN 184802180  
new CFN 1886398  
SLM 21.89, 42"  
SEE SHEET 90

3-10-69  
3-20-69  
I.M.  
E.R.A.  
Made  
Checked