


FED. RD. DIVISION	STATE	PROJECT
2	OHIO	

143
478

QUANTITY CALC S
 Made by C.P.L. Date 4-15-70
 Checked by K.A.V. Date 5-21-70

CUYAHOGA COUNTY
 CUY-480-19.43

Sewer Profile
 Made 4-15-70
 Checked 5-21-70
 C.P.L.
 K.A.V.

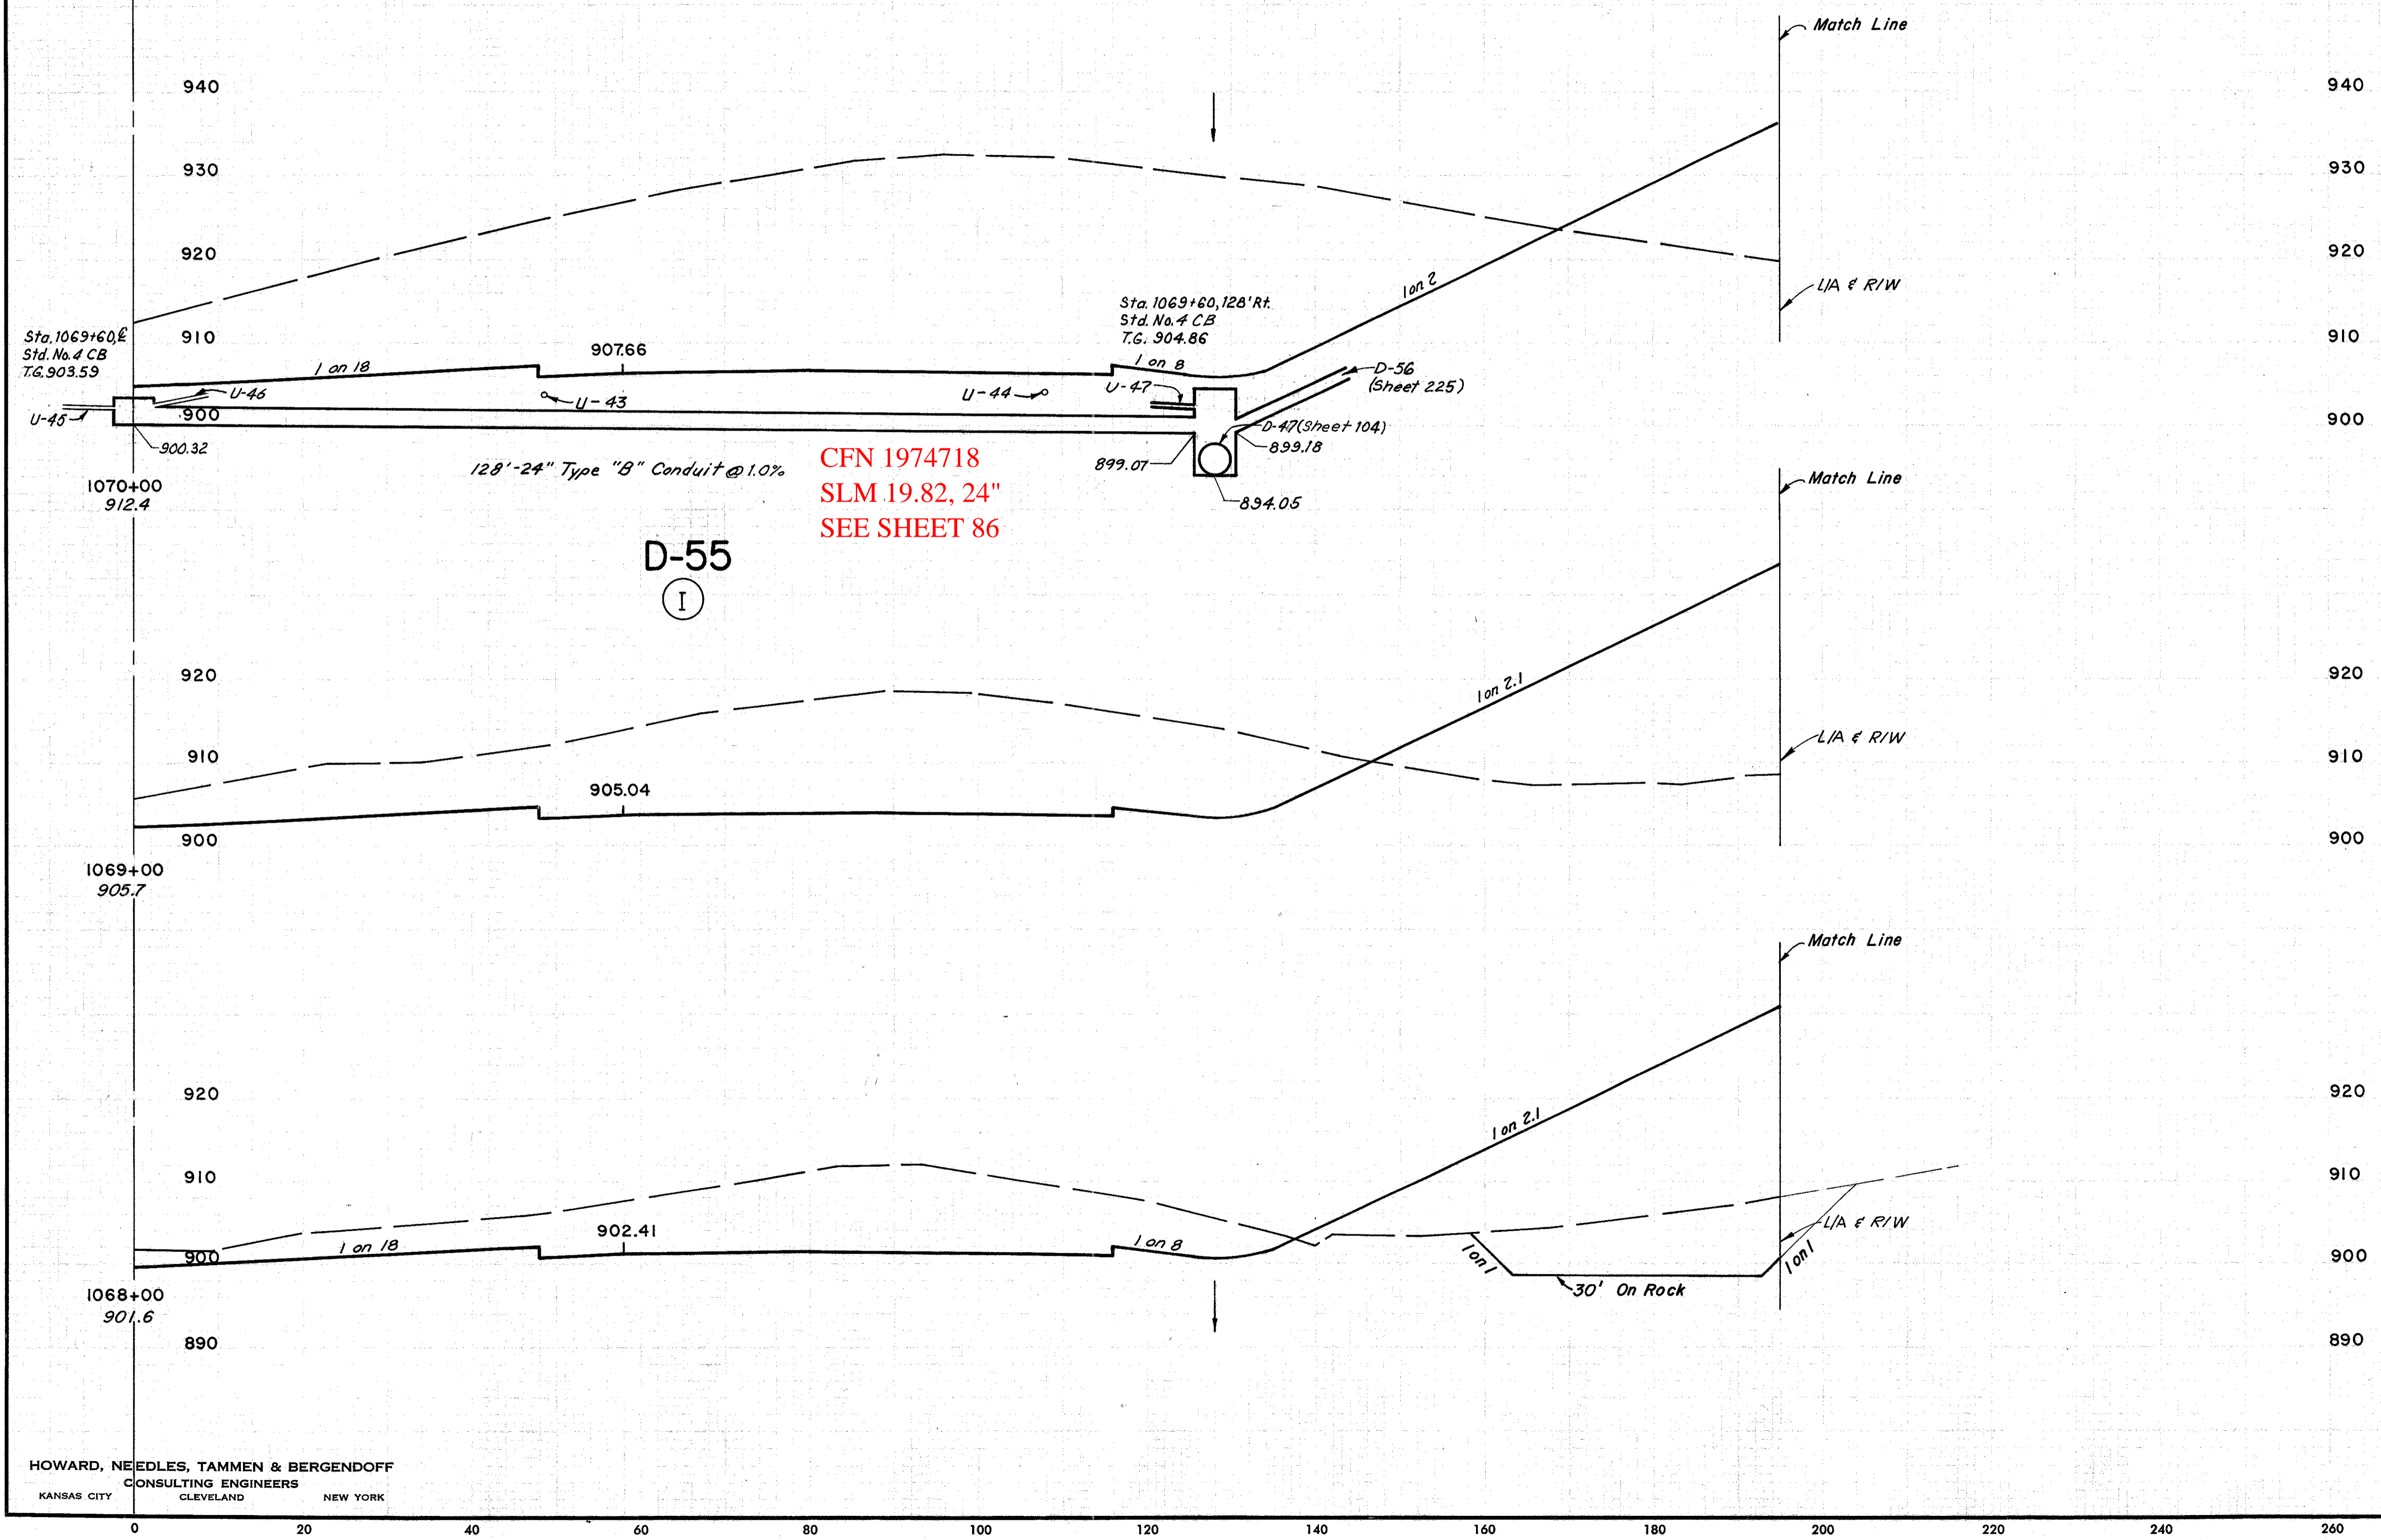

CFN 1974718
 SLM 19.82, 24"
 SEE SHEET 86

EARTHWORK			
END	AREA	VOLUME	
EXC.	EMB.	EXC.	EMB.
		3080	224
		1398	545
		1,112	972
		586	832
		8293	1424
		4,648	2,809
		3,144	3,341

HOWARD, NEEDLES, TAMMEN & BERGENDOFF
 CONSULTING ENGINEERS
 KANSAS CITY CLEVELAND NEW YORK

I