

120 100 80 60 40 20 0 20 40 60 80 100 120

QUANTITY CALC'S


Made by N.N.B. Date 7-24-72
 Checked by E.R.A. Date 7-25-72

FED. RD. DIVISION	STATE	PROJECT	
2	OHIO		

186
478

CUYAHOGA COUNTY
 CUY-480-19.43

Sewer Profile
 3-29-72
 3-29-72
 3-29-72
 E.R.A.
 R.A.E.
 Made
 Traced
 Checked
 3-29-72
 3-29-72
 C.P.H.

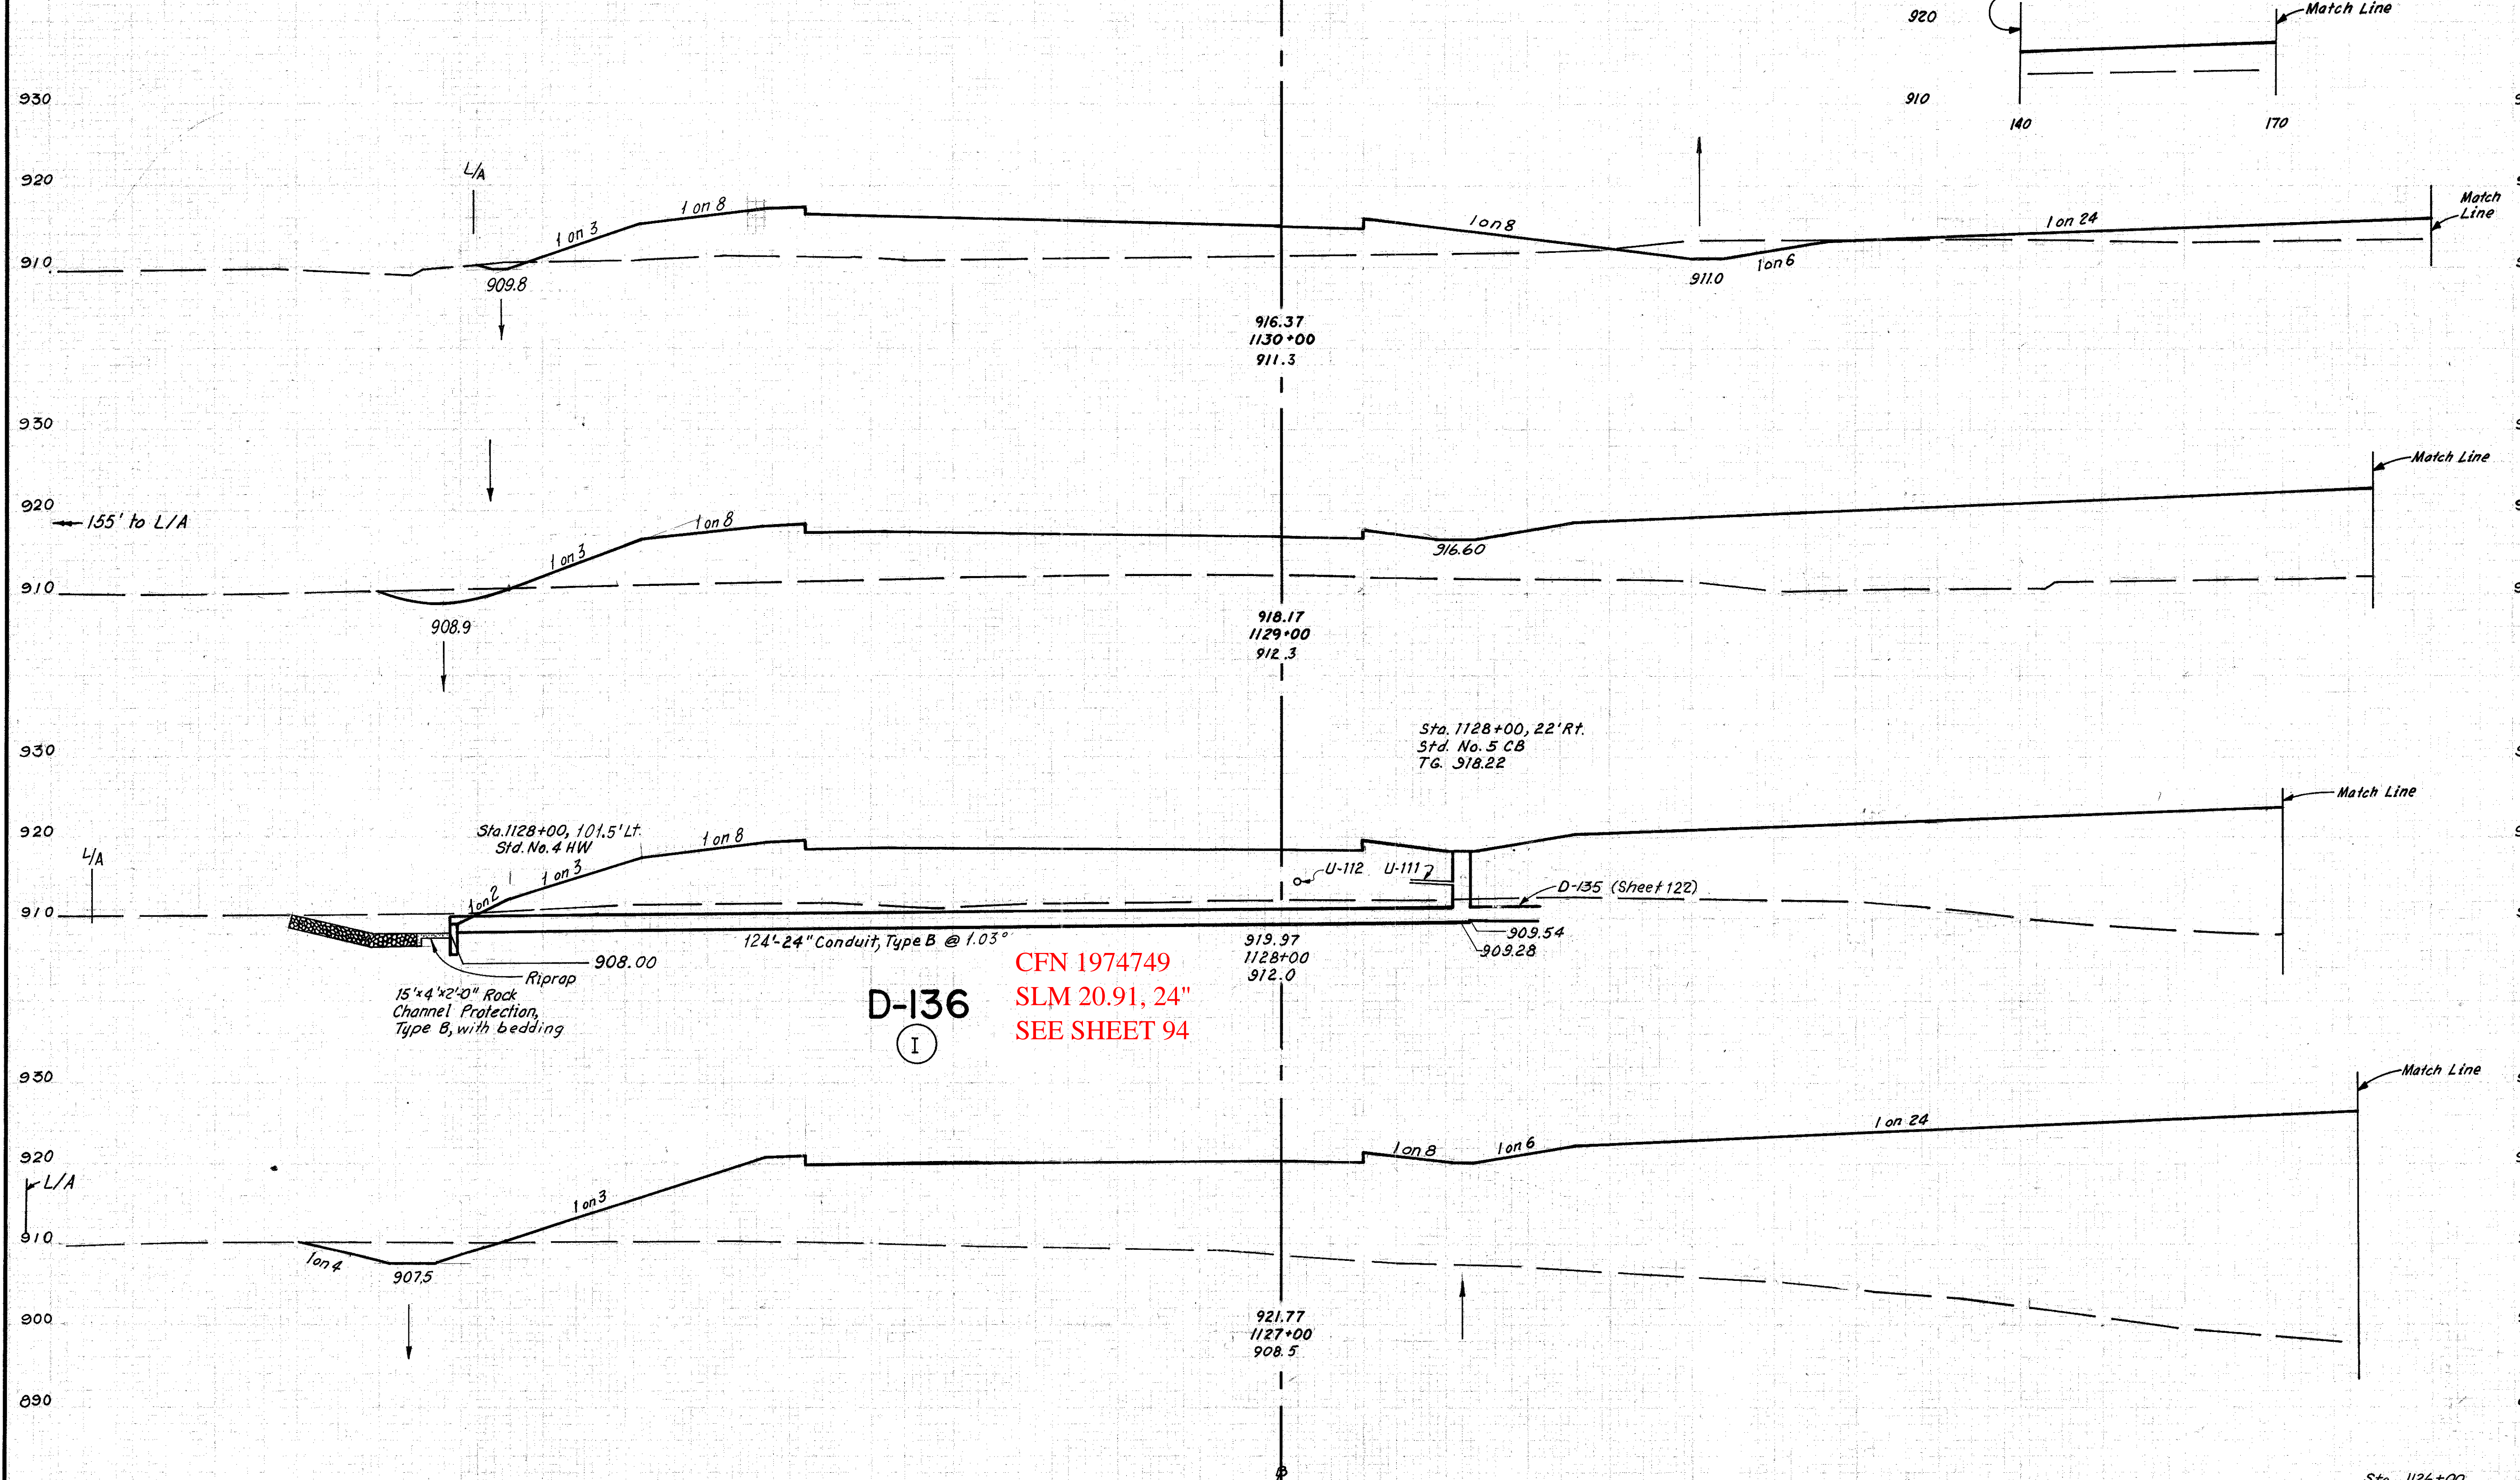

EARTHWORK			
END	AREA	VOLUME	
EXC.	EMB.	EXC.	EMB.
930			
920			
910	45	716	
930			
920			123
910	21	1507	
930			
920			111
910	39	1842	
930			
920			128
910			
900	30	3370	
890			63
	4	6924	

CFN 1974749
 SLM 20.91, 24"
 SEE SHEET 94

D-136
 I

HOWARD, NEEDLES, TAMMEN & BERGENDOFF
 CONSULTING ENGINEERS
 KANSAS CITY CLEVELAND NEW YORK