



| CROSS REFERENCE |                      |
|-----------------|----------------------|
| Sht. No.        | Item                 |
| 107,109         | Cross Sections       |
| 20,21           | Drainage Details     |
| 39              | Superelevation Table |

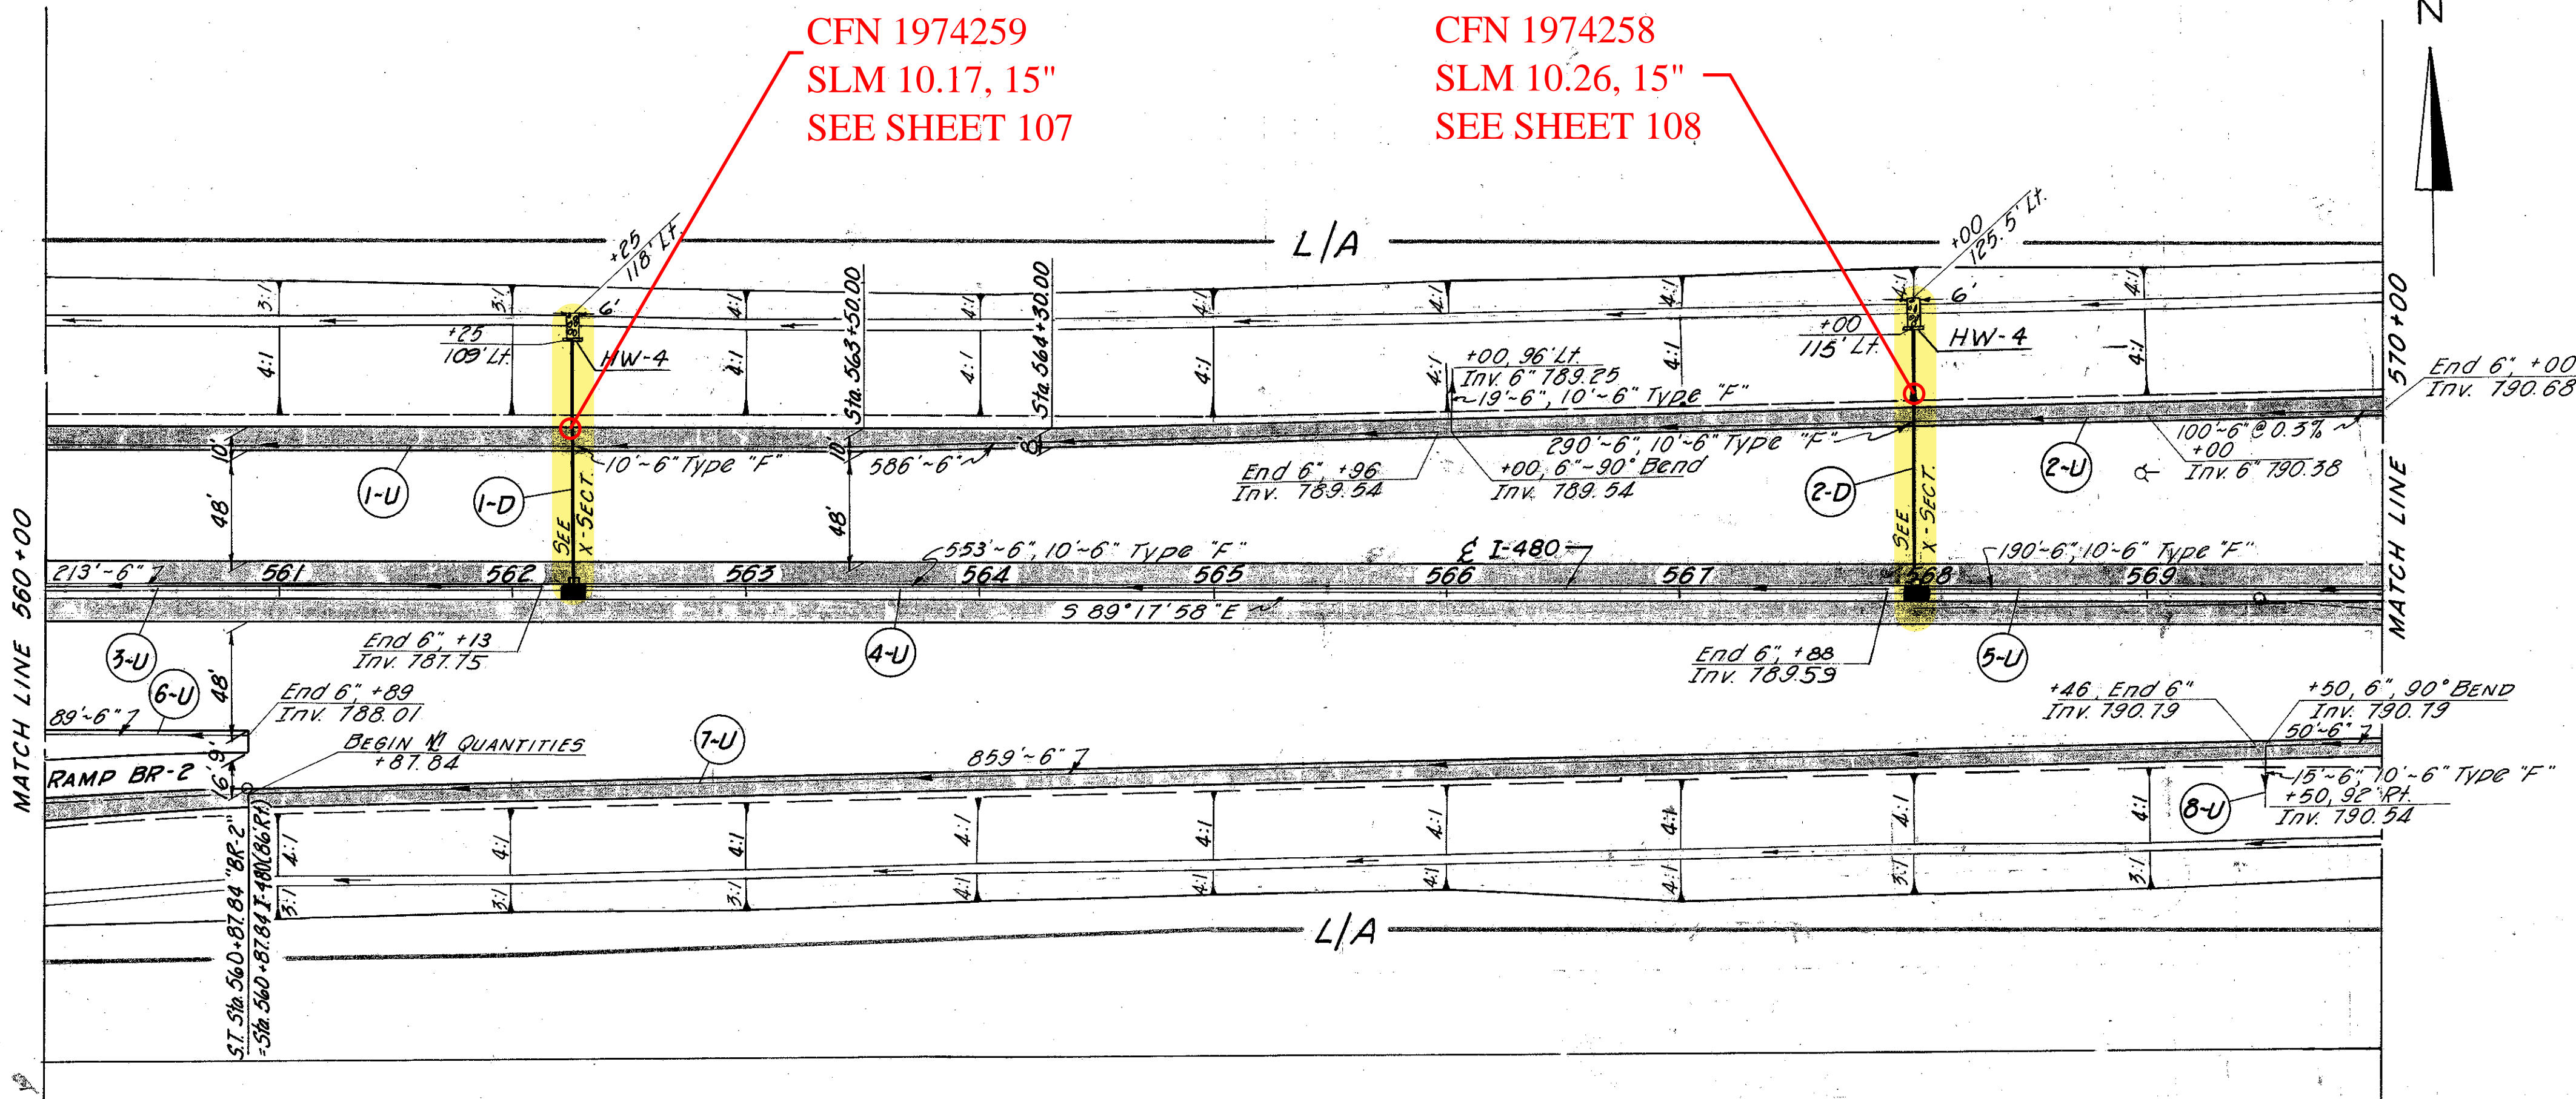

| ESTIMATED QUANTITIES | REF. SIDE | LOCATION            | 601                            |                  | 602    |        | 603 CONDUIT |                | 605       |  | 604 |      | Storm Sewer Profile |
|----------------------|-----------|---------------------|--------------------------------|------------------|--------|--------|-------------|----------------|-----------|--|-----|------|---------------------|
|                      |           |                     | Rock Cham. Prof. Type B w/ Bed | Concrete Masonry | Type B | Type F | Branches    | Shallow Under. | I-3 Inlet |  |     |      |                     |
|                      |           |                     | C.Y.                           | C.Y.             | L.F.   | L.F.   |             |                |           |  |     |      | Sht.#               |
|                      | 1-D L     | 562+25              | 3                              | .25              | 109    |        |             |                |           |  |     |      | 107                 |
|                      | 2-D L     | 563+00              | 3.5                            | .25              | 115    |        |             |                |           |  |     |      | 108                 |
|                      | 1-U L     | 560+00 to 565+96    |                                |                  |        | 10     |             |                |           |  |     |      |                     |
|                      | 2-U L     | 566+00 to 570+00    |                                |                  |        | 20     |             |                |           |  |     |      |                     |
|                      | 3-U Med   | 560+00 to 562+13    |                                |                  |        |        |             |                |           |  |     |      |                     |
|                      | 4-U Med   | 562+25 to 567+88    |                                |                  |        |        |             |                |           |  |     |      |                     |
|                      | 5-U Med   | 568+00 to 570+00    |                                |                  |        |        |             |                |           |  |     |      |                     |
|                      | 6-U R     | 560+00 to 560+89    |                                |                  |        |        |             |                |           |  |     |      |                     |
|                      | 7-U R     | 560+87.84 to 569+46 |                                |                  |        |        |             |                |           |  |     |      |                     |
|                      | 8-U R     | 569+50 to 570+00    |                                |                  |        |        |             |                |           |  |     |      |                     |
| TOTALS TO GEN. SUM.  |           |                     | 6.5                            | .50              | 224    | 60     |             |                |           |  |     | 2964 | 2                   |

For Ramp BR-2, Roadway Design Details, See Sheet No. 55  
 For Ramp BR-2, Pavement Elevations & Pavement Details, See Sheet Nos. 69-70  
 For I-80 Centerline Control Data, See Sheet No. 332.

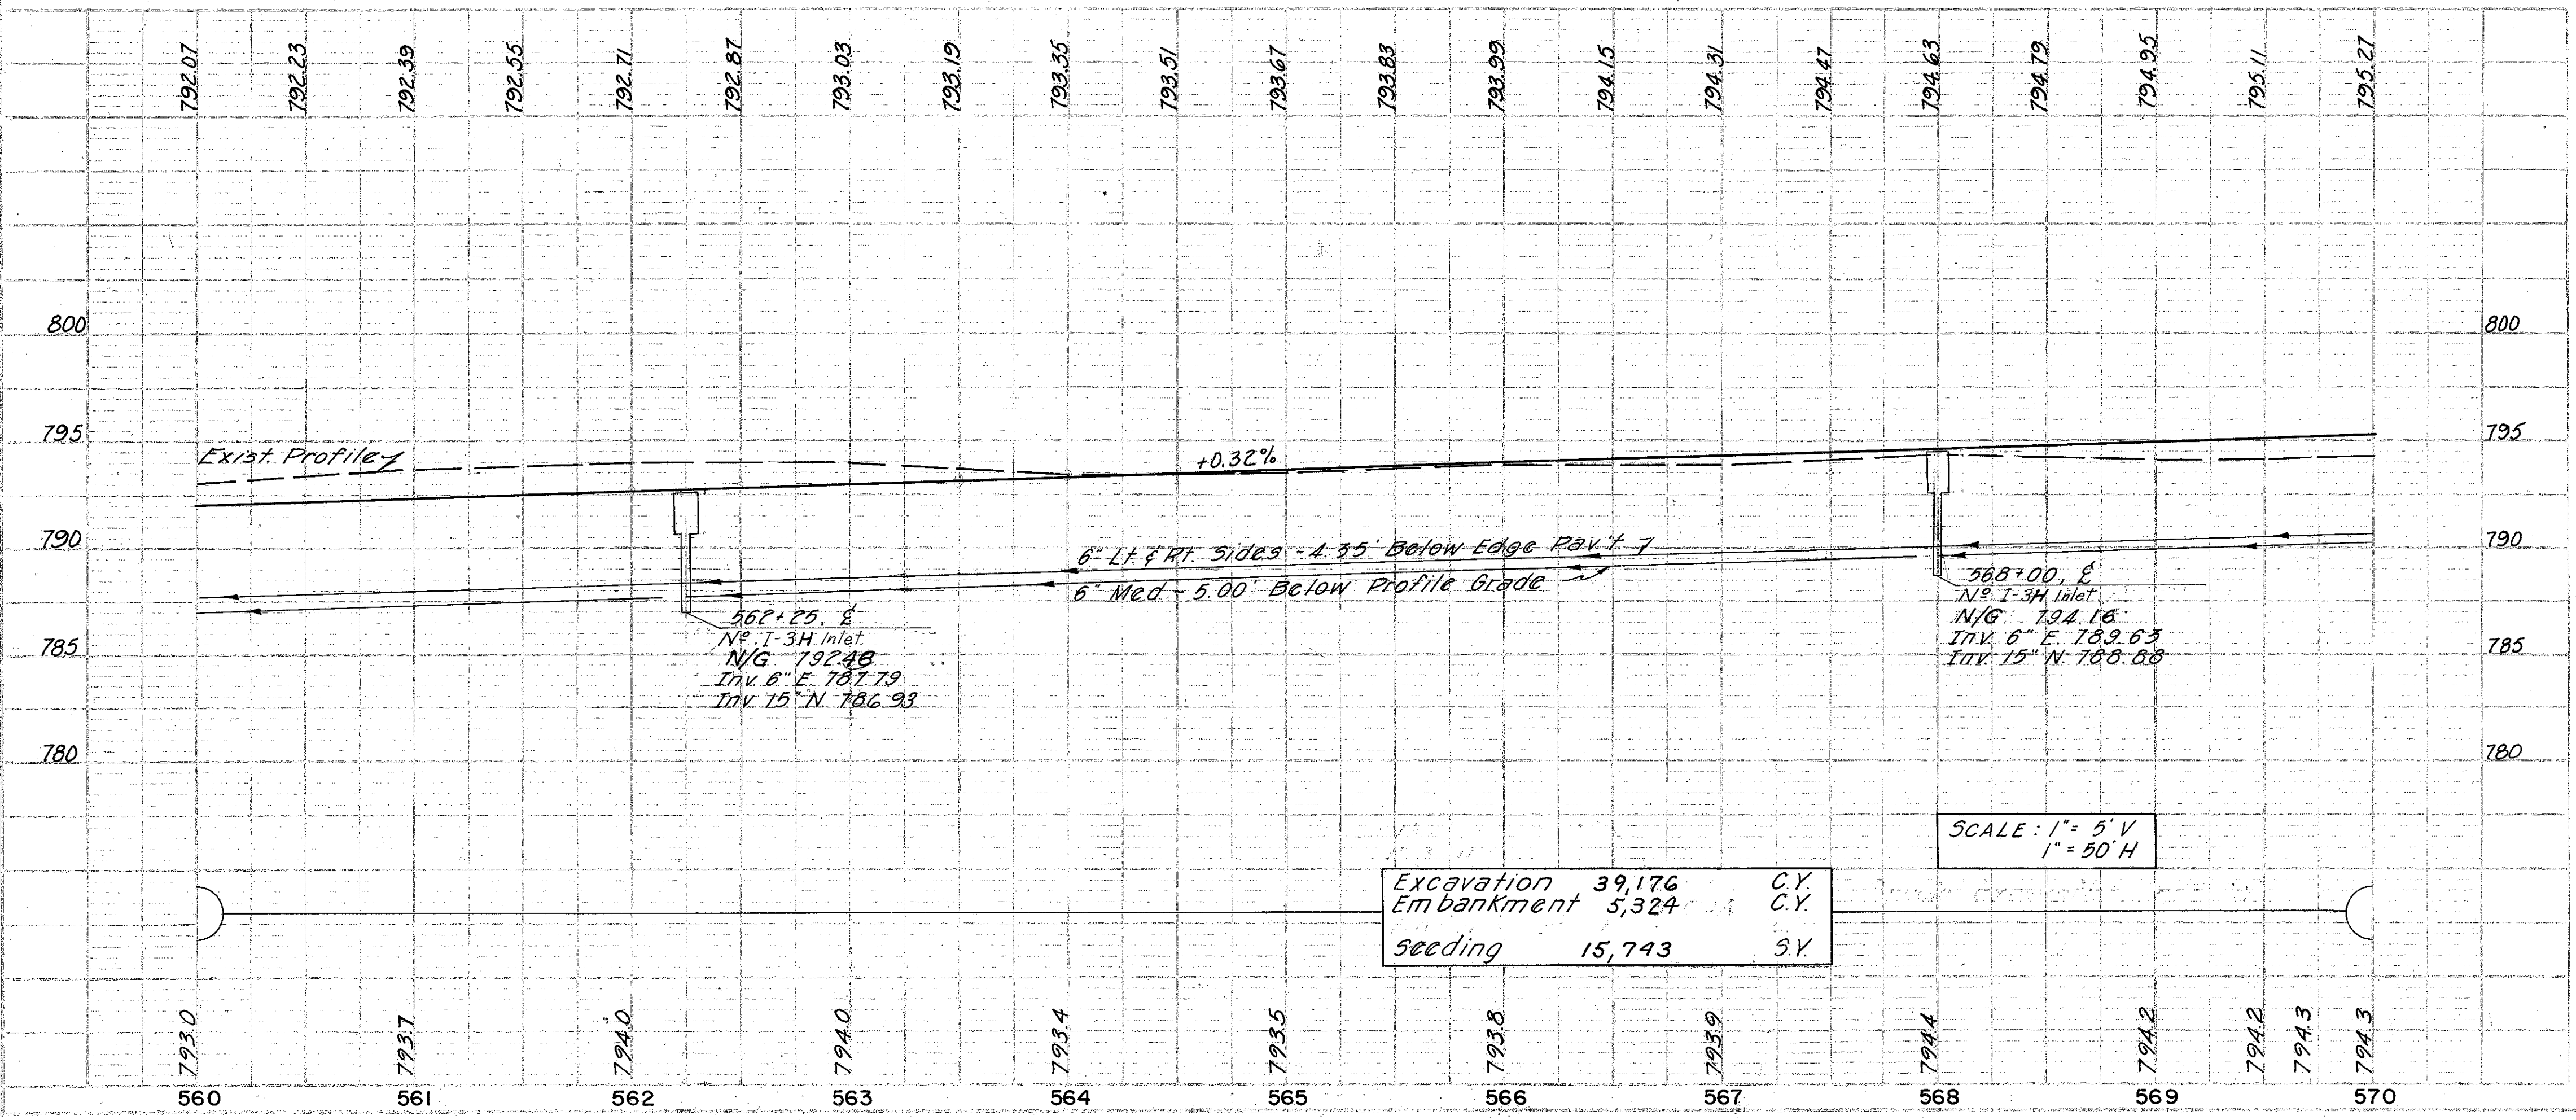

|            |        |      |
|------------|--------|------|
| Excavation | 39,176 | C.Y. |
| Embankment | 5,324  | C.Y. |
| Seeding    | 15,743 | S.Y. |

SCALE: 1" = 5' V  
1" = 50' H

| TREE REMOVAL<br>560+00 to 570+00 |     |
|----------------------------------|-----|
| SIZE                             | No. |
|                                  |     |

Rev. D.R.S. 1-3-78  
 F.O. 3-2-66  
 T.J.S. 3-8-66