

SLM 15.25, 66"
SEE SHEET 39

CFN 1974369
SLM 15.22, 15"
SEE SHEET 45

CFN 1974371
SLM 15.22, 15"
SEE SHEET 45

SLM 15.38, 54"
SEE BELOW

SLM 15.27, 54"
SEE BELOW

CURVE DATA @ I-480

PI Sta. 824+98.87
Δ = 5°-47'-45"
Dc = 0°-28'-00"
R = 12,277.67'
T = 621.50'
L = 1,241.95'
E = 15.72'

CALC. BY A.C. DATE 3-78
CHKD. BY T.E.B. DATE 2-79

FHWA REGION	STATE	PROJECT	TYPE PLAN	27
5	OHIO			172


CUYAHOGA COUNTY
CUY-480-15.22

I. PIN SET PI
Sta. 824+98.87

SHT. NO.	CROSS SECTION
44-47	CROSS SECTIONS
19	MISC. DETAILS

CFN 1974370
SLM 15.27, 15"
SEE SHEET 46

STATION	ITEM	QUANTITY	UNIT
823+00	SOODING	250	S.Y.
823+00	BENDS & BRANCHES	250	EA.
823+00	DEEP UNDERDRAIN	556	L.F.
823+00	SHALLOW UNDERDRAIN	540	L.F.
823+00	STD. No. I-3B ⁵⁰ MED. INLET	1	EA.
823+00	STD. No. 5 C.B.	1	EA.
823+00	STD. No. 5-A C.B.	1	EA.
823+00	STD. No. 5 M.H. WITH DROP PIPE	1	EA.
823+00	TYPE "B"	200	L.F.
823+00	TYPE "C" 706.02 WITH 706.11 JOINTS	264	L.F.
823+00	TYPE "C" 706.02 1250 D-LOAD OR 707.14	300	L.F.
823+00	TYPE "F"	29	L.F.
823+00	MANHOLE ABANDONED	1	EA.
823+00	CATCH BASIN ABANDONED	1	EA.
823+00	MANHOLE REMOVED	2	EA.
823+00	PIPE REMOVED OVER 24"	70	L.F.

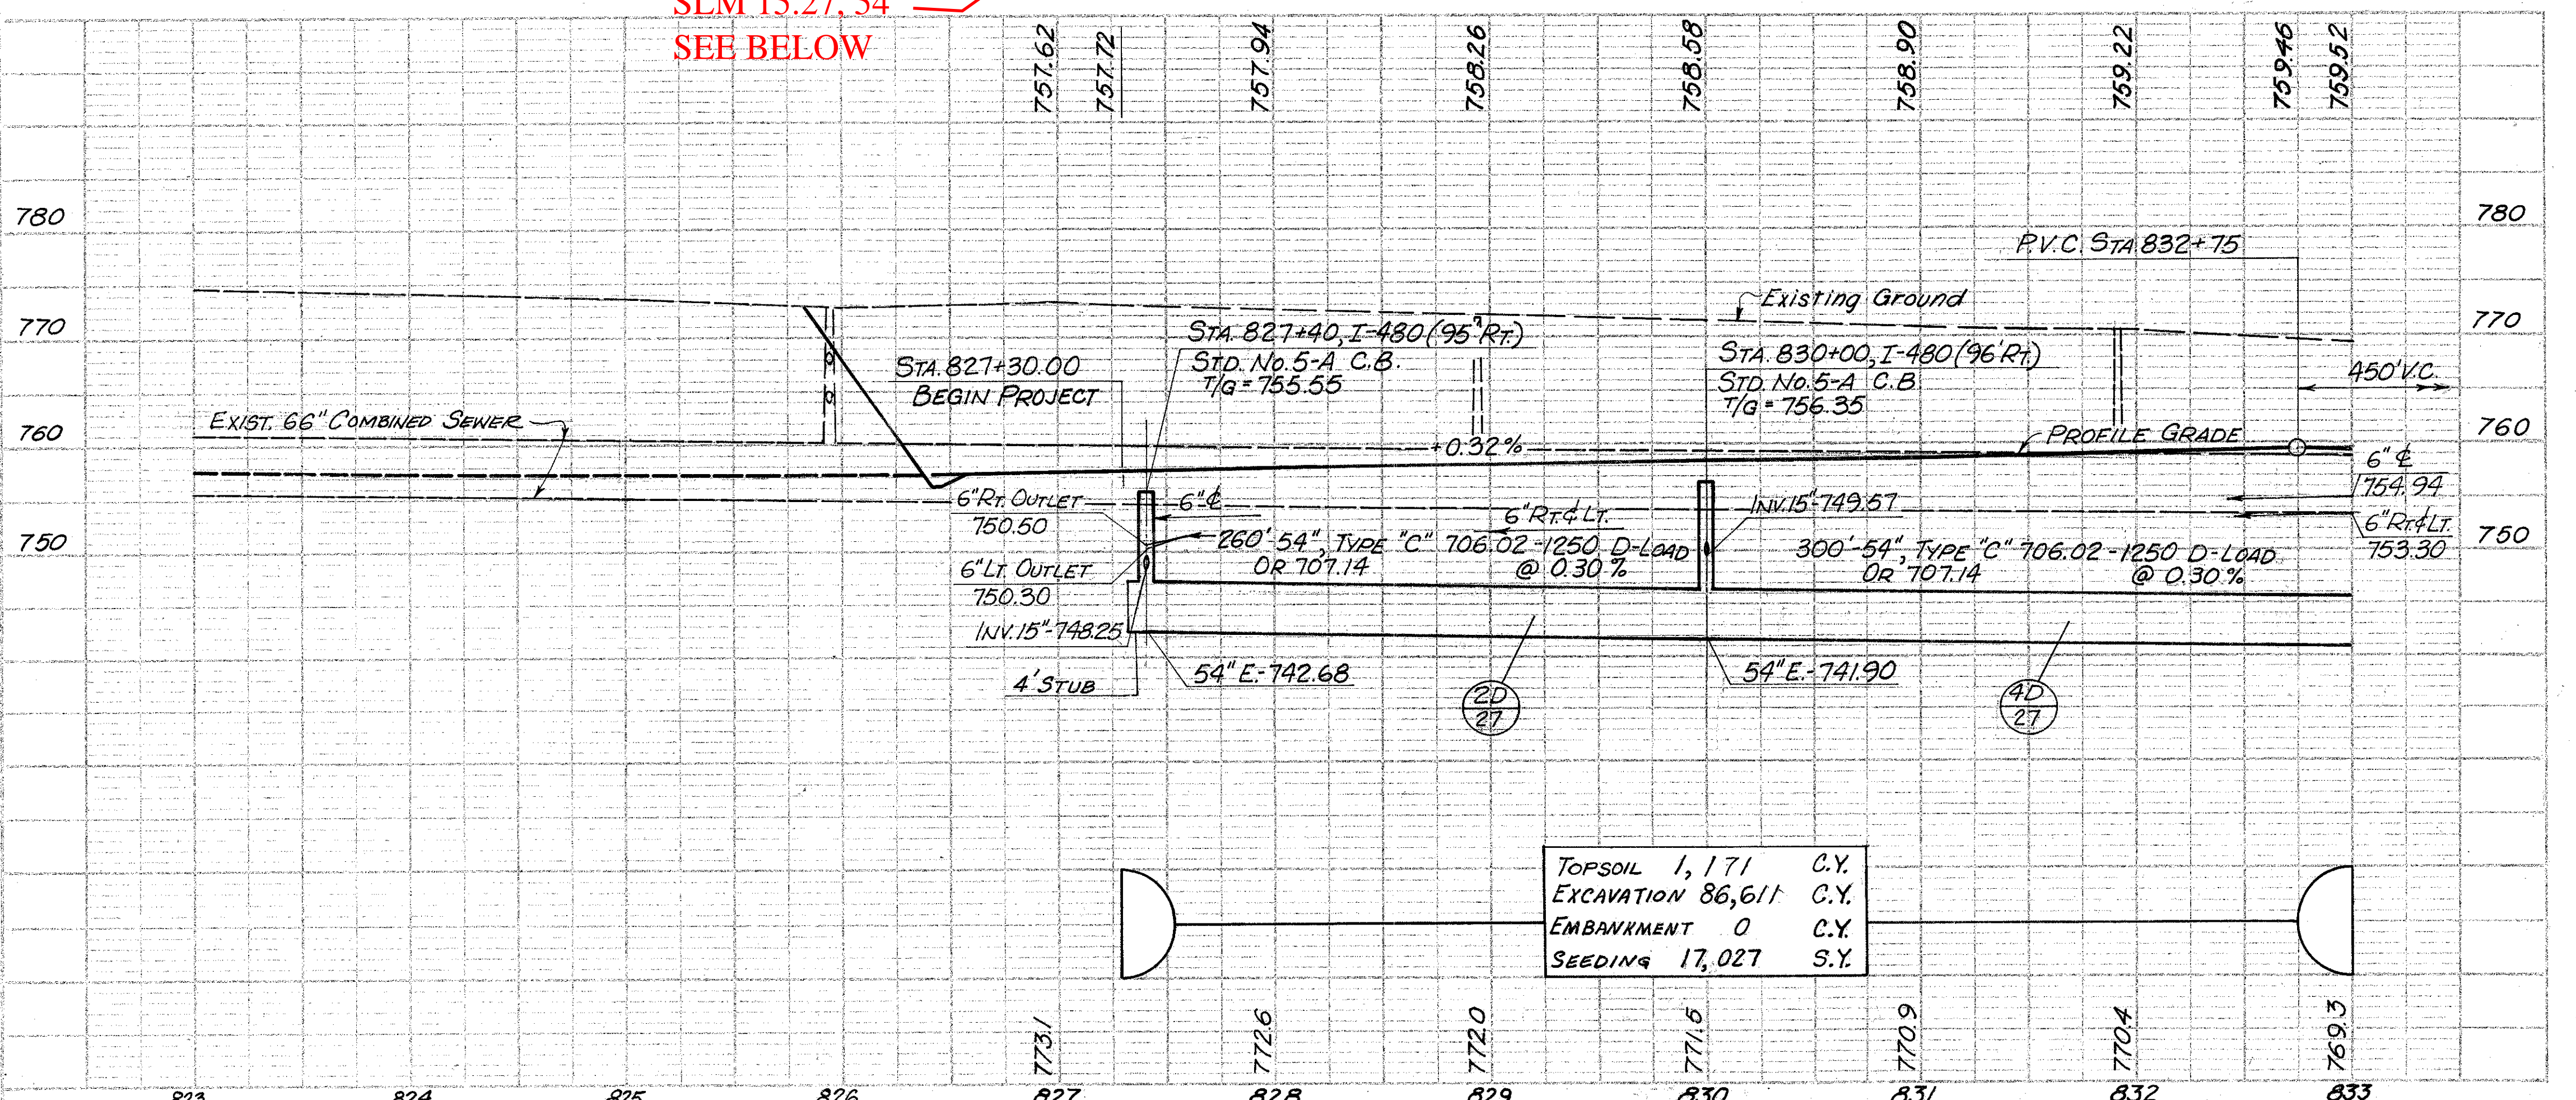

TOPSOIL	1,171	C.Y.
EXCAVATION	86,611	C.Y.
EMBANKMENT	0	C.Y.
SEEDING	17,027	S.Y.

* As Per Plan