

CFN 1972282
SLM 6.12, 12"
SEE SHEET 184

BRIDGE
SFN 1804172
SEE SHEET 199

old CFN 180710620
new CFN 1873586
SLM 6.20, 30"
SEE SHEET 200

FOR PROFILE OF STORM SEWER D-14, D-10, D-13
SEE SHEET 184

FED. RD. DIVISION 2	STATE OHIO	PROJECT	FISCAL YEAR 26 353
------------------------	---------------	---------	--------------------------


CUYAHOGA COUNTY
CUY-71-5.72

REF. NO.	STATION		SIDE	STEEL BEAM (DEEP)	
	FROM	TO		STANDARD	BARRIER
GR-15	809+00	819+00	RT.	991	-
GR-9	809+00	819+00	LT.	1009	-
GR-10	817+00	819+00	M	-	200
TOTAL				2000	200

DRAINAGE

REF. NO.	STATION	SIDE	I-1		I-5		I-8		I-2		I-10		L-10		L-120		I-8	
			6" PIPE CLASS I-3	6" PIPE CLASS F-4	12" PIPE CLASS J-1	12" PIPE CLASS F-4	6"x90" BENDS I-3	12"x25" BENDS F-4	STD-8 CATCH BASIN	MASONRY	DUMPED ROCK	SODDING	JUTE MATTING	STD-2-A-8 PAVED SHLD.	INLET			
D-3	809+00	810+80	CL															
D-4	809+24	DITCH	LT	80	28			2		0.23								
D-5	809+90	811+10	RT.															80
D-6	811+50	812+10	LT															32
D-7	813+17	815+10	LT															94
D-8	813+72	815+10	RT.															95
D-9	816+00		CL															2
D-10	816+00	DITCH	RT.			71	31		2		0.23	3.2		1				
D-11	809+00	819+00	LT.	1000	20													
D-12	809+00	819+00	RT.	1000	20													
D-13	812+00	DITCH	RT.			80	43		2		0.23	3.2		1		142		2
TOTAL				2000	40	231	102		2	6	1	0.69	6.4	304	284			4


REF. NO.	STATION	SIDE	I-1		I-10		E-3		I-2		L-10	
			30" PIPE CLASS A-1	30" PIPE CLASS M-3.4(d)	30" PIPE CLASS GAGE 10	RIP-RAP SLAB	DUMPED ROCK	CHANNEL EXC.	MASONRY	SOD		
D-1	809+23	812+51.5	LT&RT	436	70	74	590	22	35			
D-2	813+19	814+65	LT&RT	317			81	7.6	4			
TOTAL				317	436	70	74	671	29.6	39		

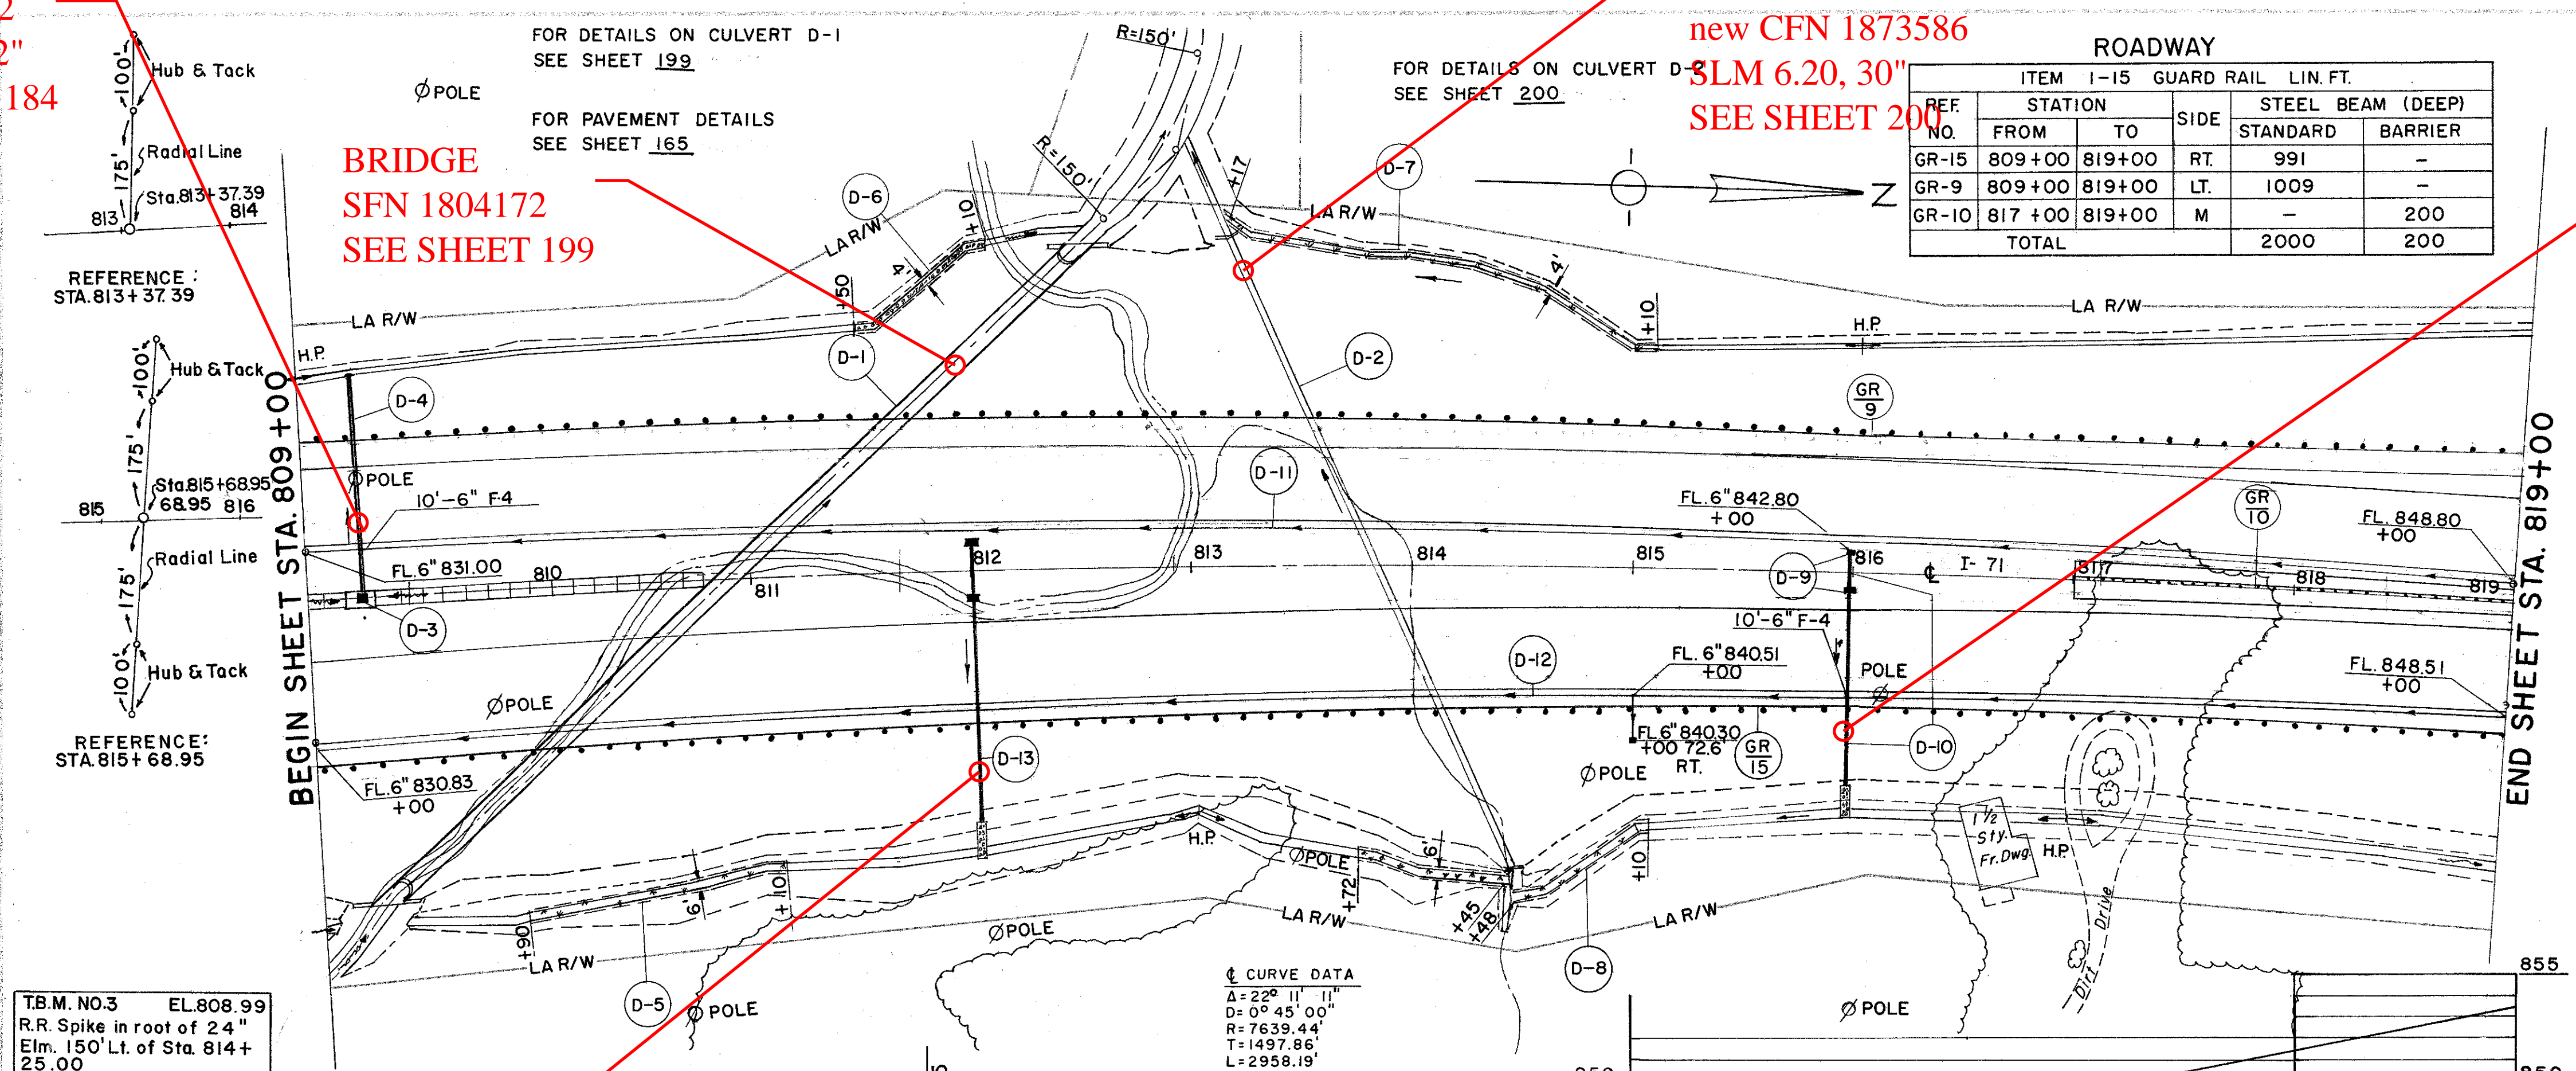

T.B.M. NO.3 EL.808.99
R.R. Spike in root of 24"
Elev. 150' Lt. of Sta. 814+25.00

CFN 1972257
SLM 6.17, 12"
SEE SHEET 184

CURVE DATA
Δ = 22° 11' 11"
D = 0° 45' 00"
R = 7639.44'
T = 1497.86'
L = 2958.19'

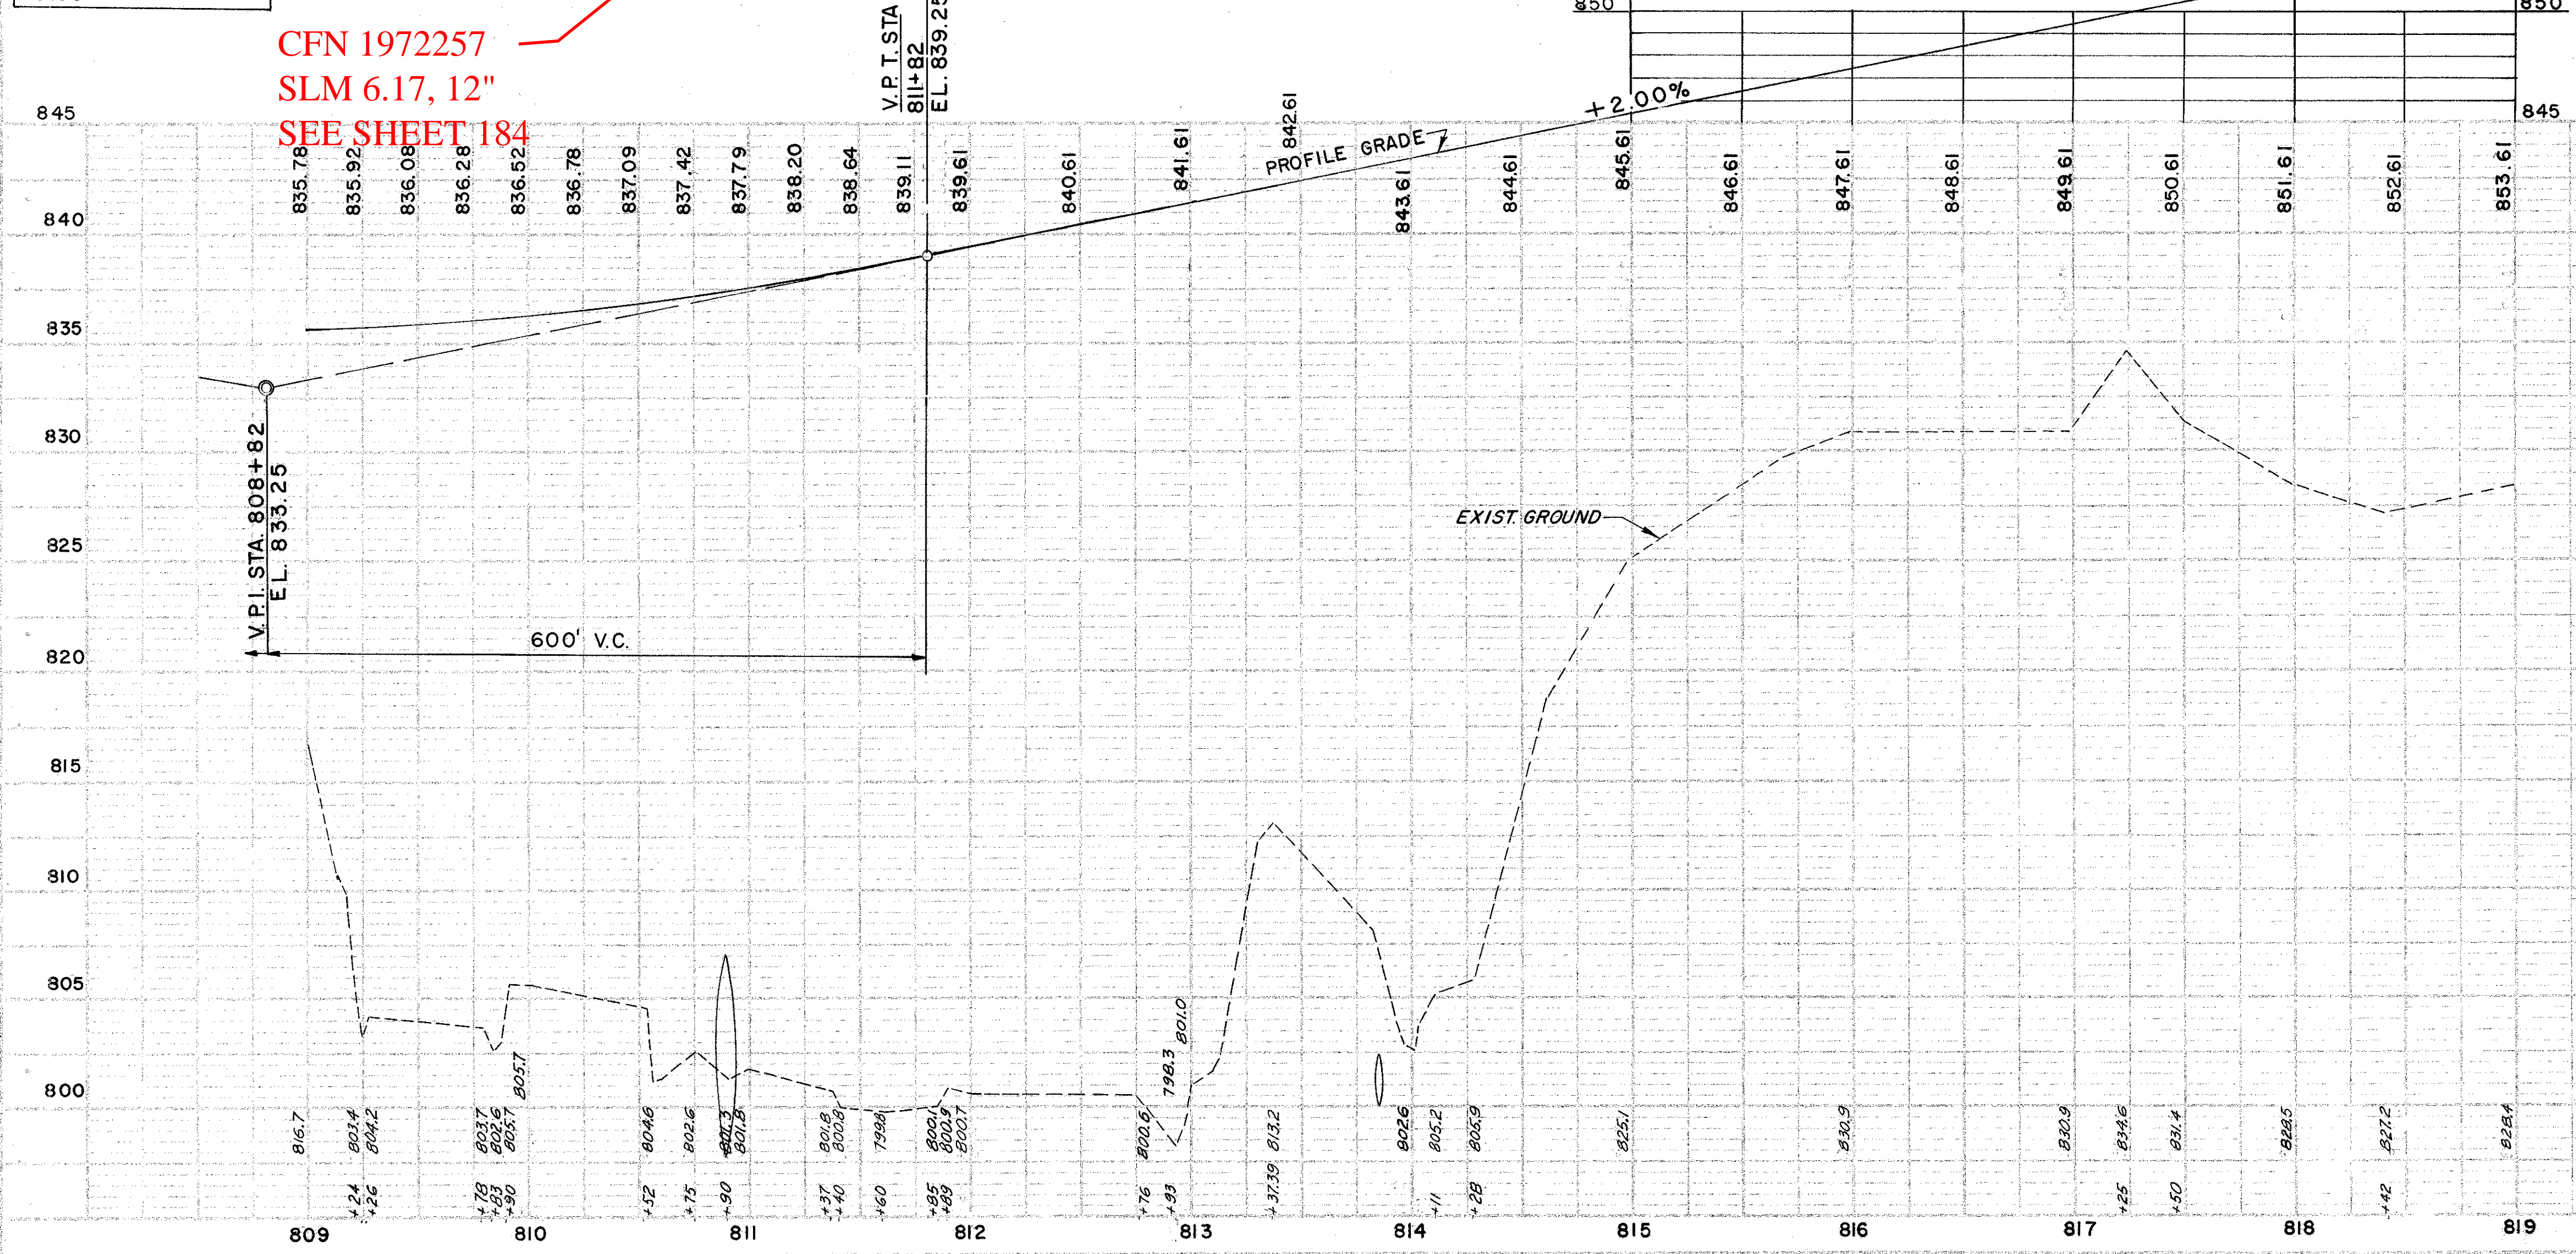

PLAN & PROFILE- STA.809+00 TO STA.819+00