

CFN 1972300  
SLM 7.25, 12"  
SEE SHEET 186

CFN 1972292  
SLM 7.28, 12"  
SEE SHEET 186

CFN 1972278  
SLM 7.30, 12"  
SEE SHEET 186

old CFN 180710731  
new CFN 1844609  
SLM 7.31, 24"  
SEE SHEET 204

CFN 1972275  
SLM 7.36, 12"  
SEE SHEET 186

CFN 1972291  
SLM 7.41, 12"  
SEE SHEET 186

FED. RD. DIVISION	STATE	PROJECT	FISCAL YEAR
2	OHIO		

32  
353


CUYAHOGA COUNTY  
CUY-71-5.72

D DRAINAGE

REF. NO.	STATION	SIDE	SHALLOW		I-1		I-5		I-8		I-2		I-10		I-3	
			6" PIPE CLASS I-3	6" PIPE CLASS I-4	12" PIPE CLASS J-1	12" PIPE CLASS E-1	24" PIPE CLASS A-1	6" x 6" TEE CLASS I-3	24" x 12" TEE CLASS A-1	MOD. 2-A-G PAVED SHULDR INLET	MASONRY	SODDING	DUMPED ROCK CHANNEL PROTECT	CHANNEL EXCAVATION		
D-1	869+00 TO 879+00	LT.	1018	40				2								
D-2	869+00 TO 879+00	CL	940	60												
D-3	869+00 TO 879+00	RT.	1044	40				3								
D-4	871+00	CL-LT			76					1	0.23	2				
D-5	872+17.65	CL-LT			85					1	0.23	2	2			
D-6	873+00	LT-RT					148			1	6.6	7			65	
D-7	873+00 TO 873+61	CL				61										
D-8	876+23	CL-RT			71					1	0.23	2				
D-9	878+85	CL-RT			76					1	0.23	2	2			
TOTAL			3002	140	308	61	148	5	1	5	7.52	15	4	65		

ROADWAY


REF. NO.	STATION	SIDE	ITEM I-15 GUARD RAIL LIN. FT.	
			STEEL BEAM (DEEP) AS PER PLAN	BARRIER
GR-34	869+00 TO 879+00	CL		1000
GR-35	872+53 TO 873+03	RT.	50	
TOTAL			50	1000

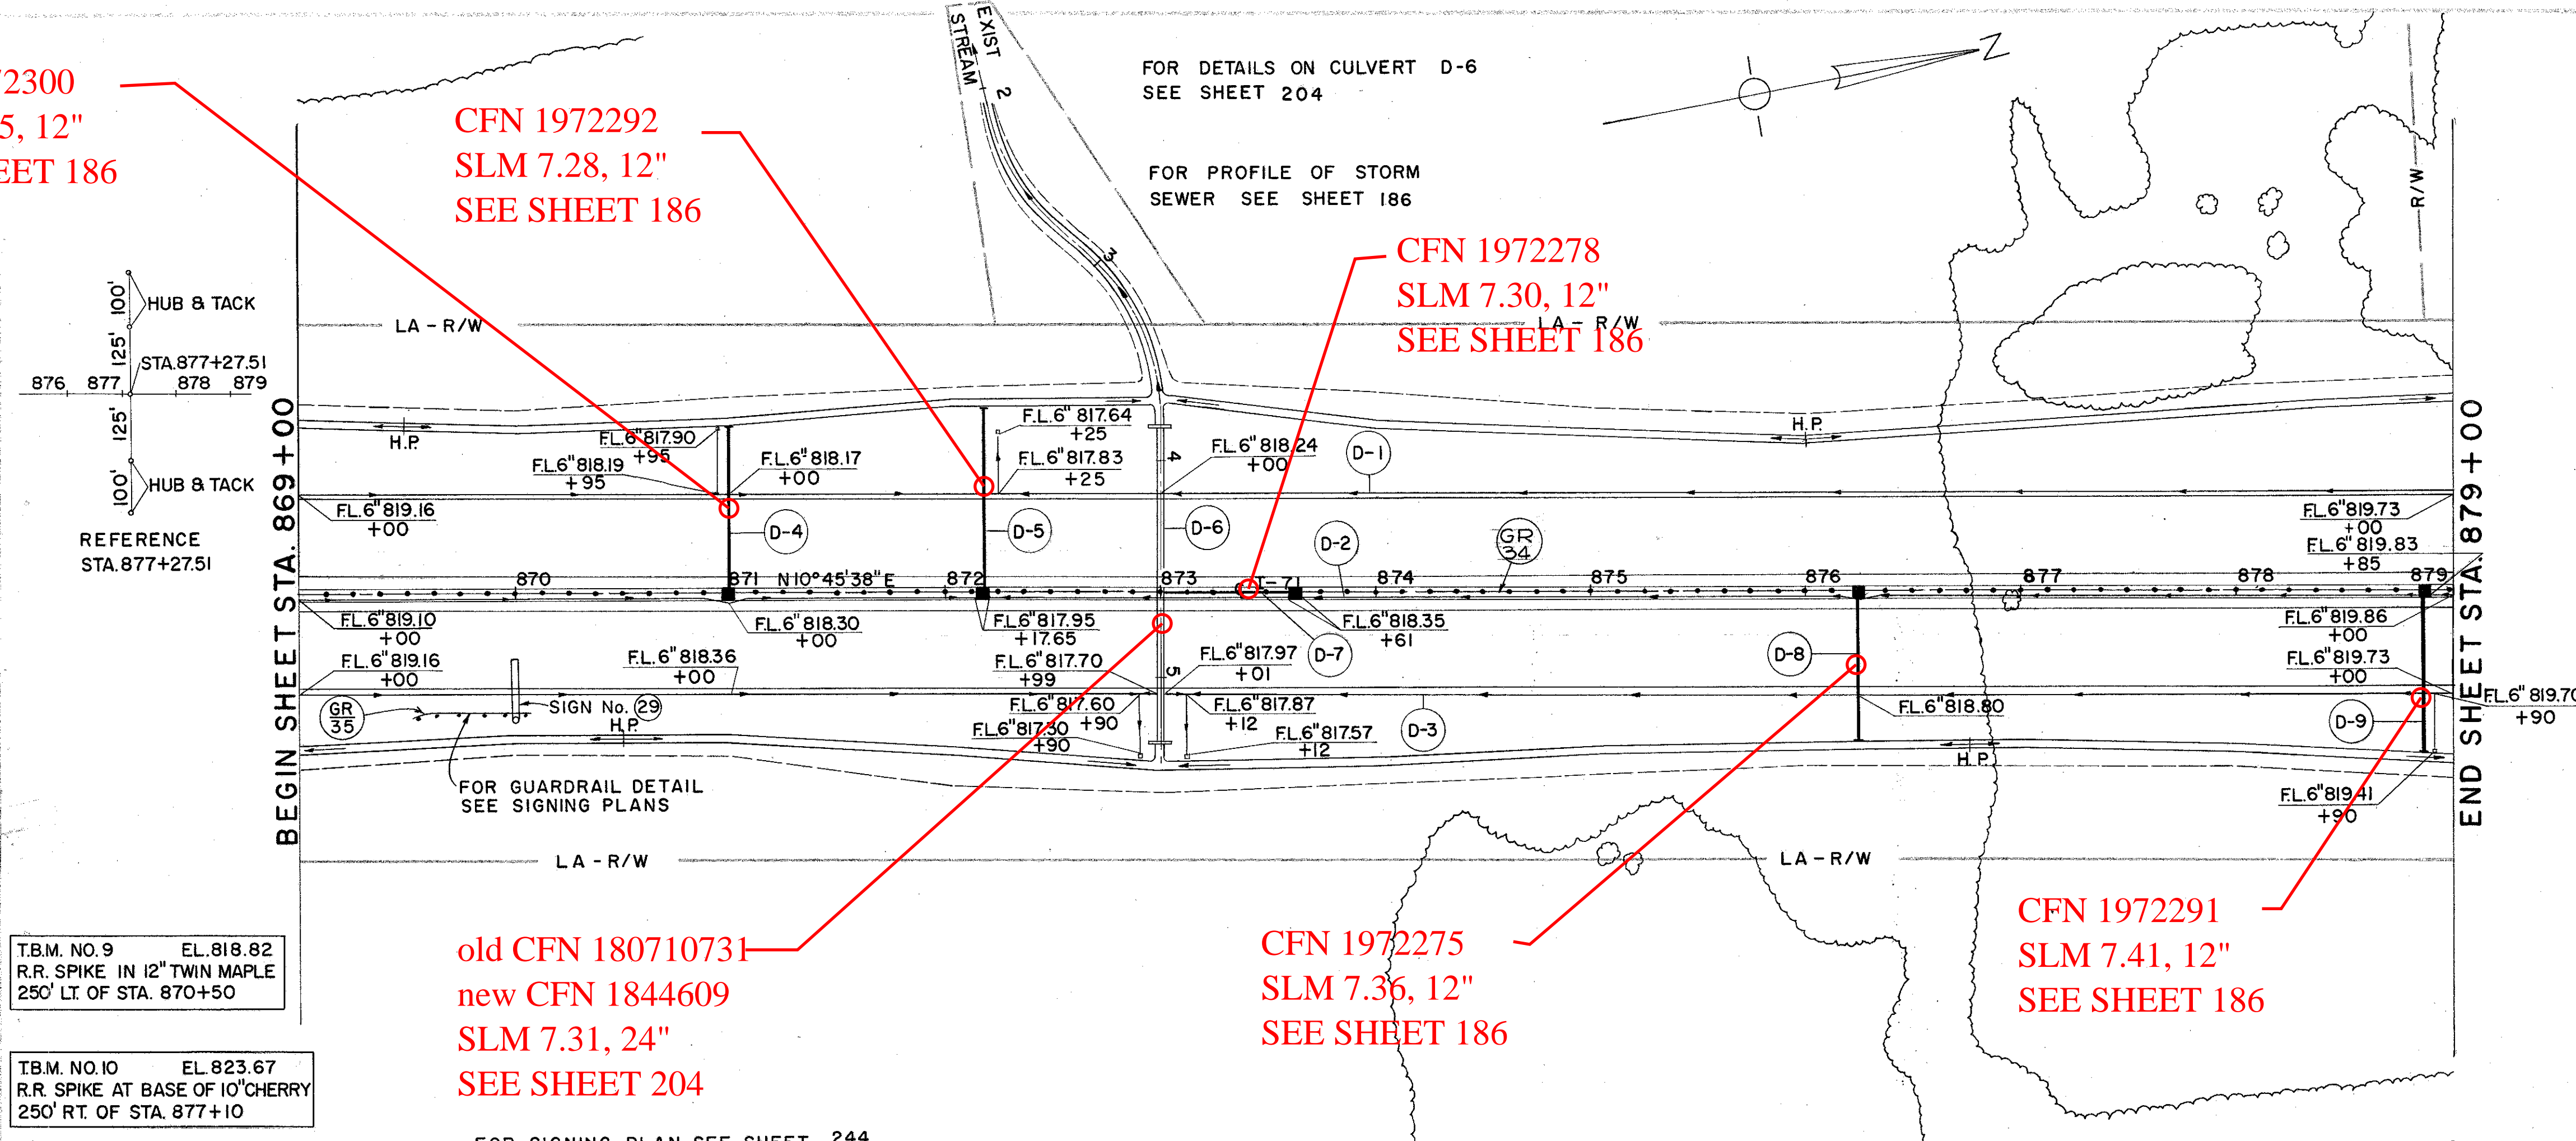

T.B.M. NO. 9 EL. 818.82  
R.R. SPIKE IN 12" TWIN MAPLE  
250' LT. OF STA. 870+50

T.B.M. NO. 10 EL. 823.67  
R.R. SPIKE AT BASE OF 10" CHERRY  
250' RT. OF STA. 877+10

FOR SIGNING PLAN SEE SHEET 244

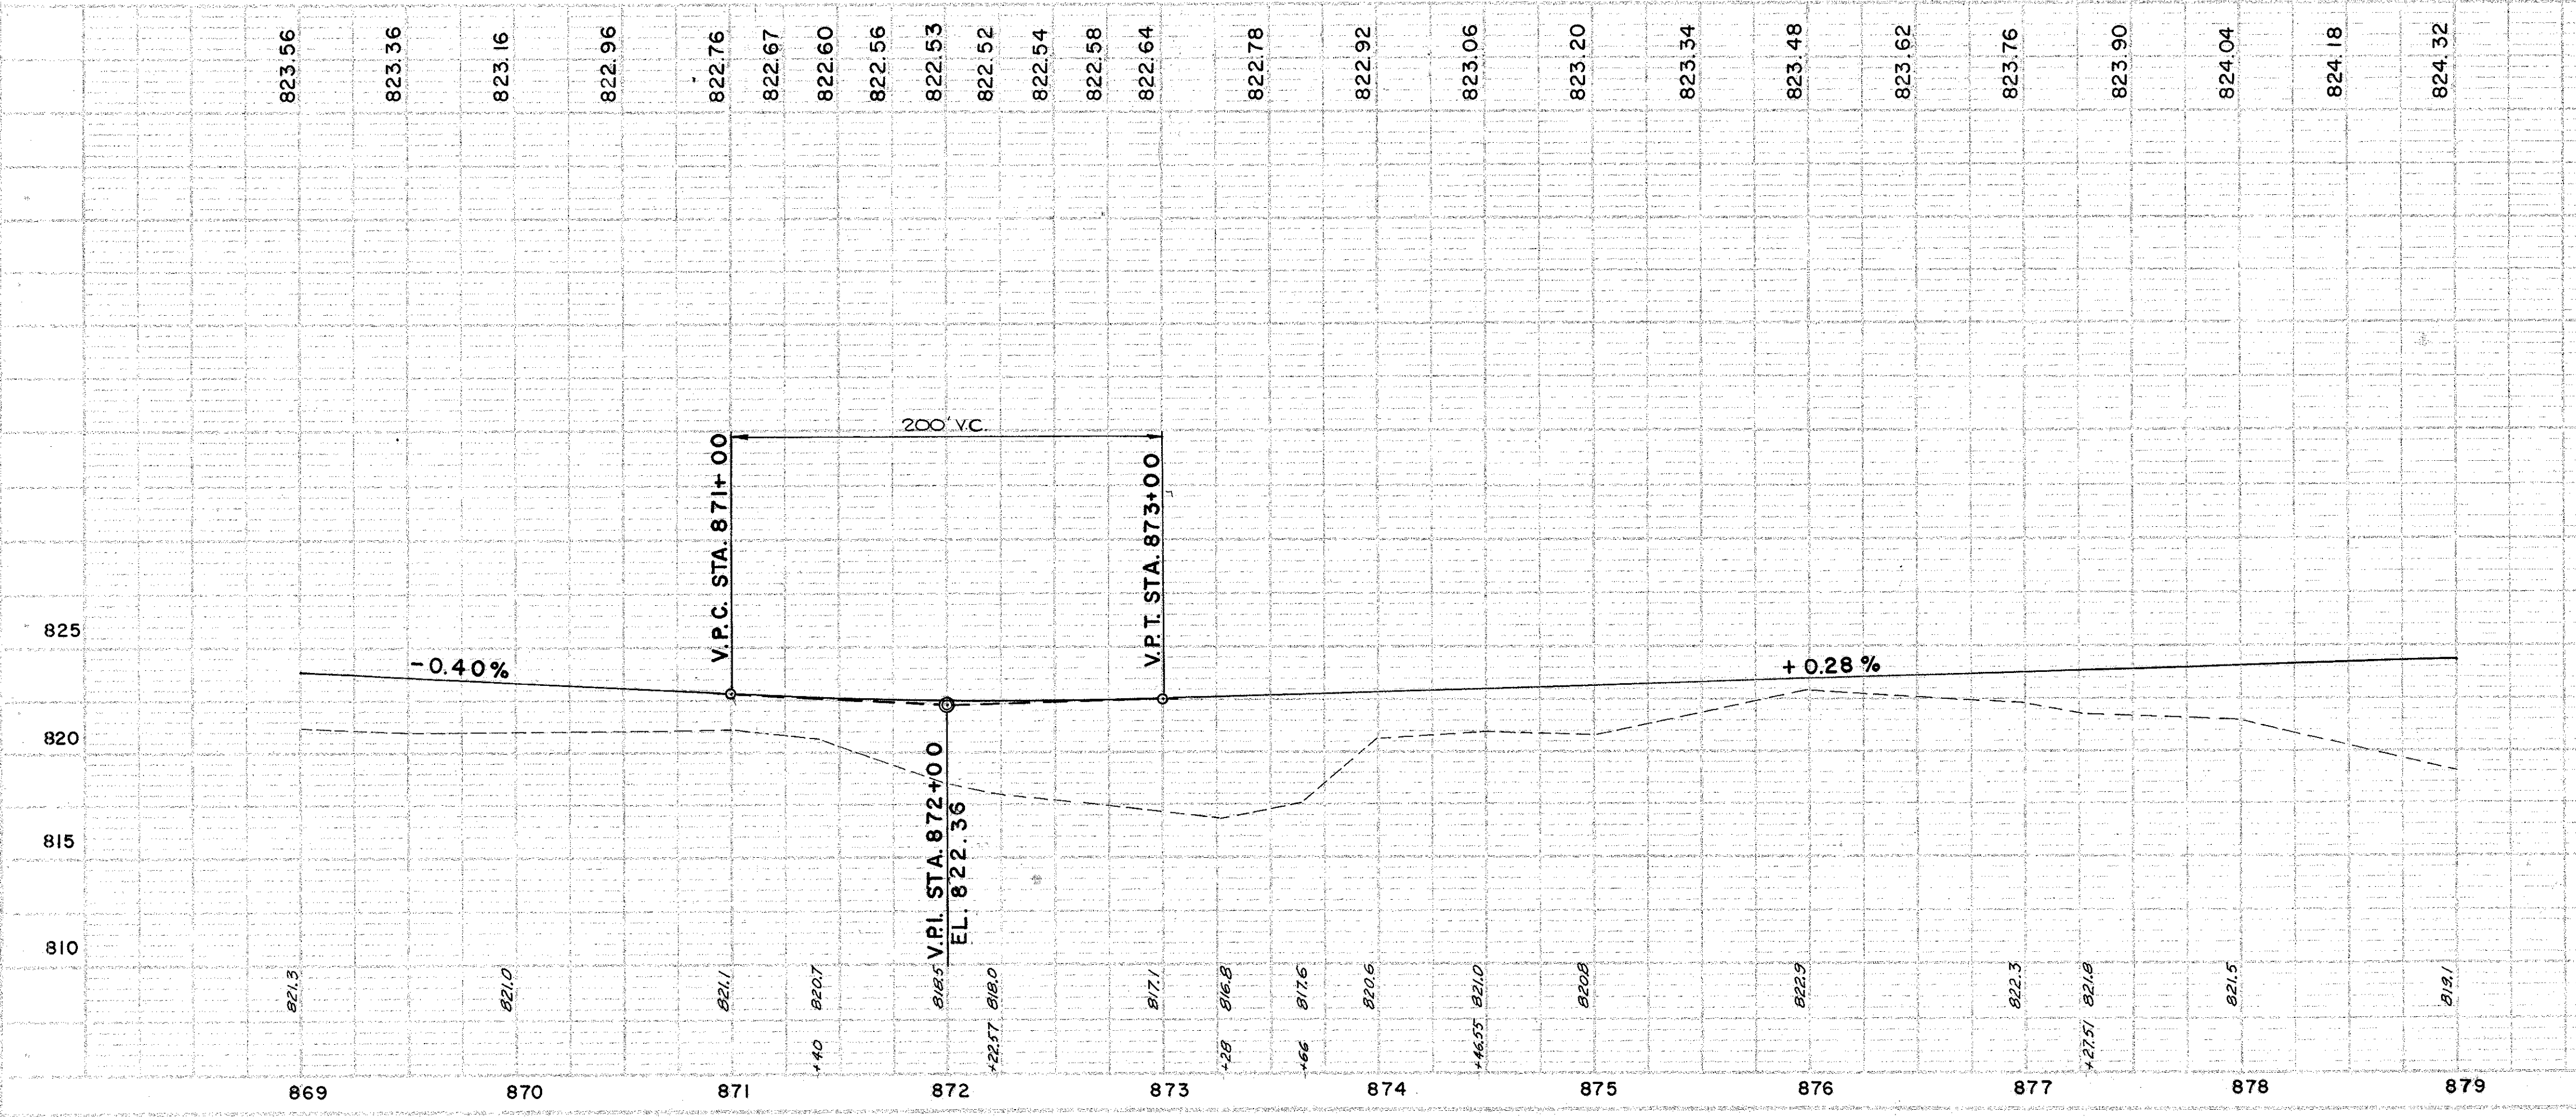

PLAN & PROFILE - STA. 869+00 TO STA. 879+00