


CFN 1972279
SLM 7.60, 12"
SEE SHEET 186

CFN 1972285
SLM 7.81, 12"
SEE SHEET 186

FED. RD. DIVISION 2	STATE OHIO	PROJECT	FISCAL YEAR
------------------------	---------------	---------	-------------

CUYAHOGA COUNTY
CUY-71-5.72

34
353

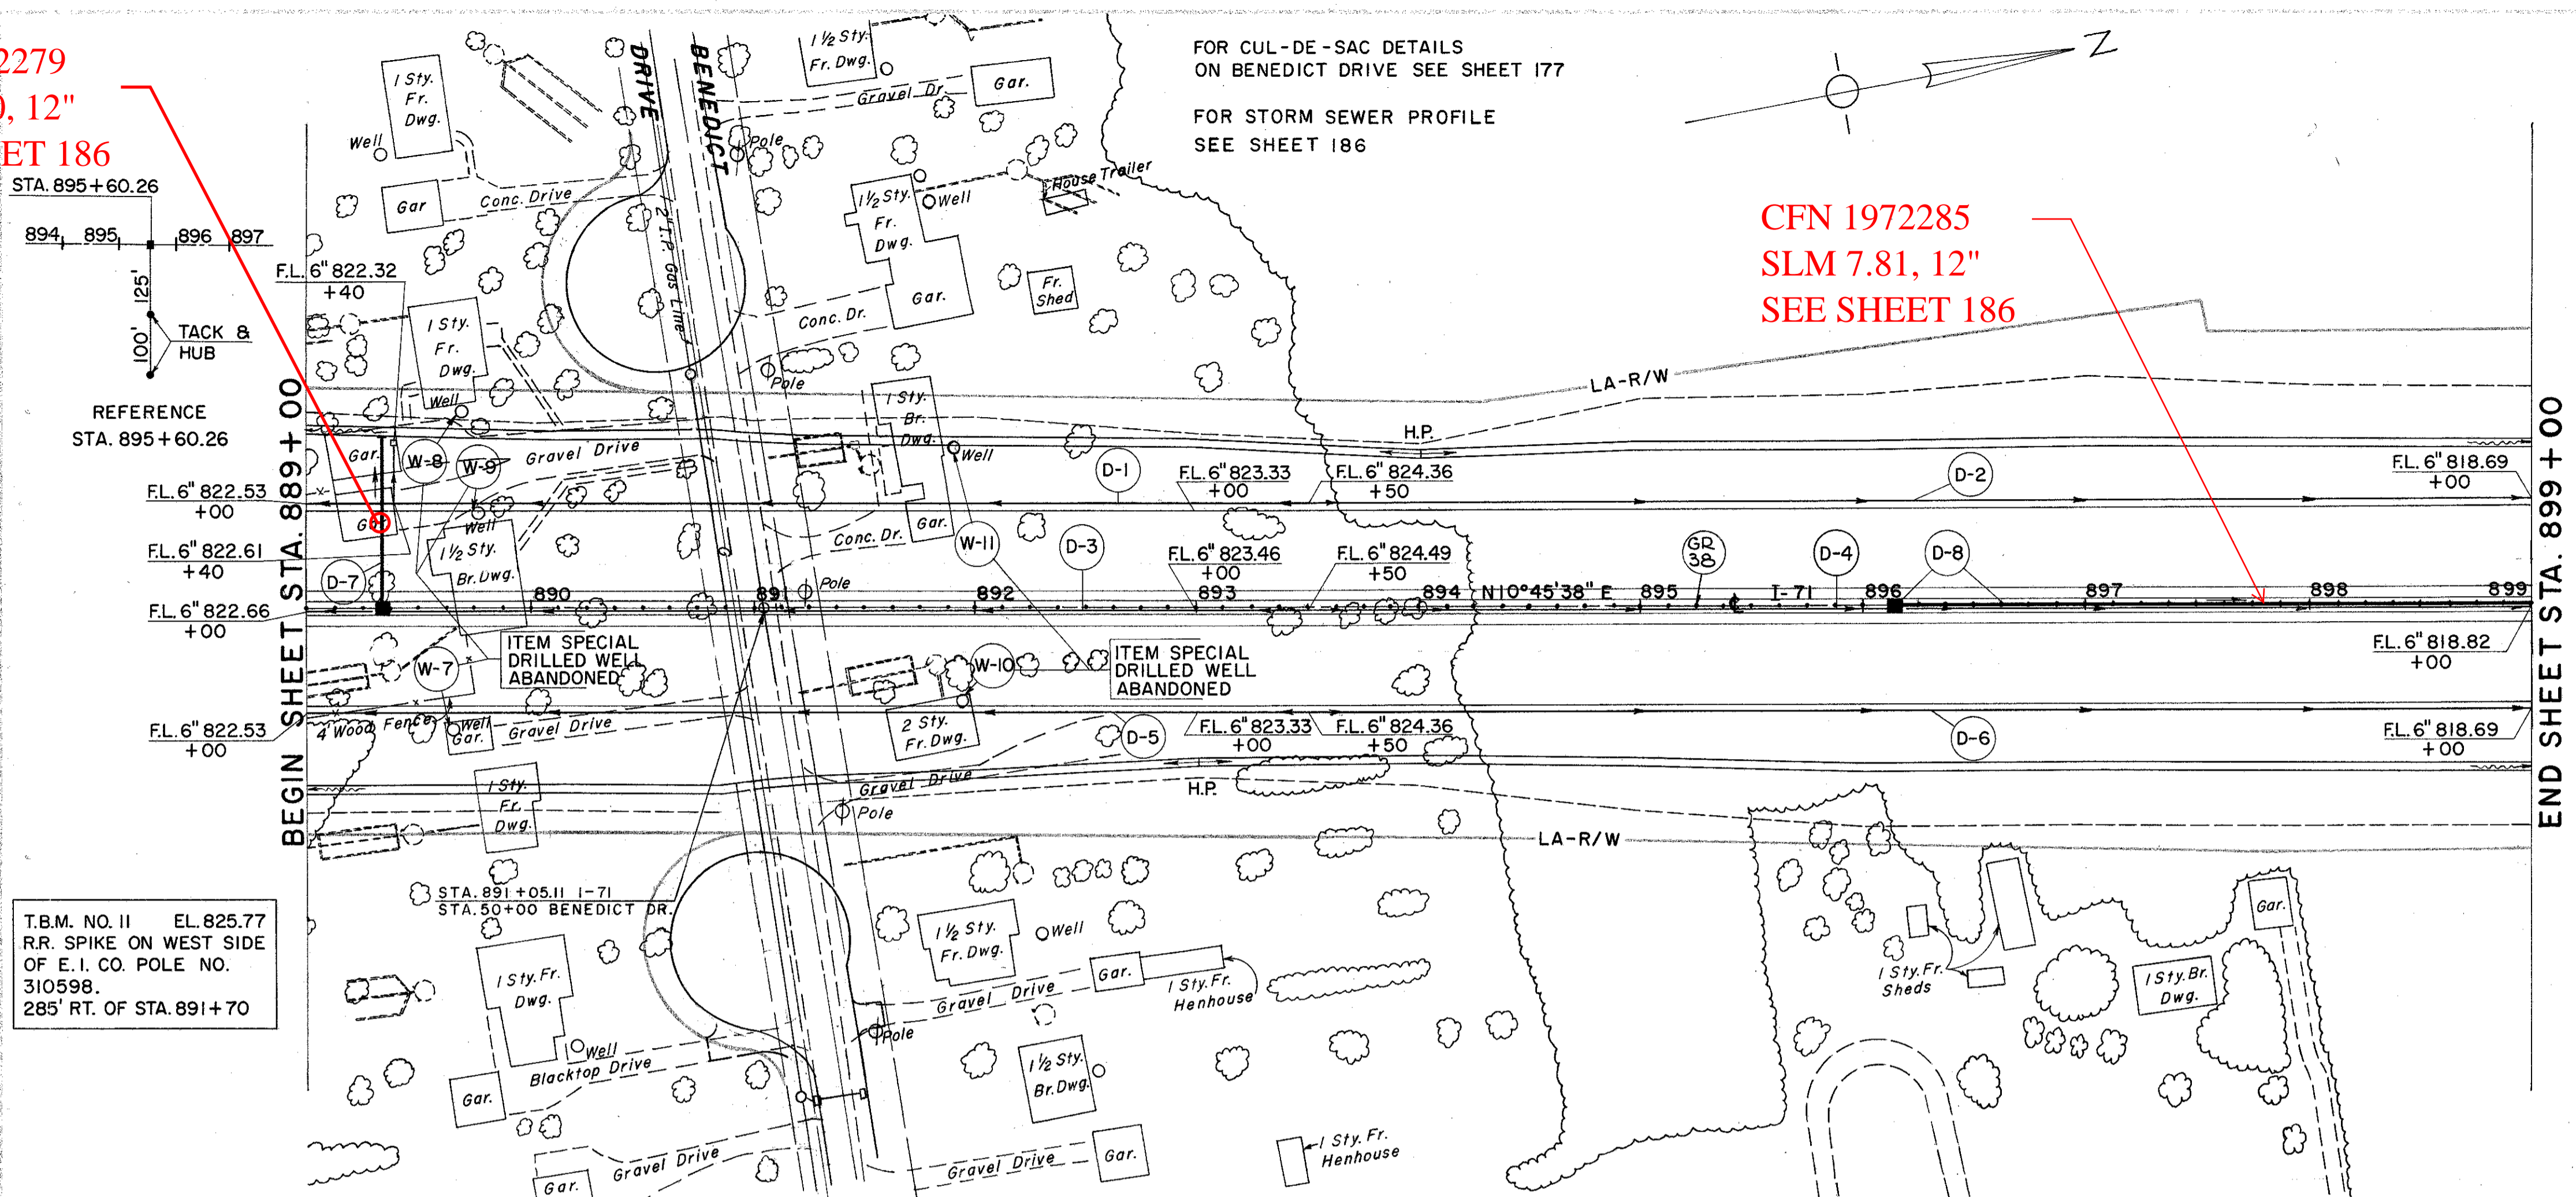


DRAINAGE

REF. NO.	STATION	SIDE	SHALLOW					I-1		I-5	I-8	I-2	L-10	I-10			
			6" PIPE CL. I-3	6" PIPE CL. F-4	6" PIPE CL. I-5 M=6.4 (ft)	12" PIPE CLASS J-1	12" PIPE CLASS E-1	6" x 6" TEE CLASS I-3	MOD. 2'-6" PAVED SHIR INLET	MOD. 2'-8" PAVED SHIR INLET	MASONRY	SODDING	DUMPED ROCK	CH. PROTECT.			
D-1	889+00	893+50	LT.	468	10												
D-2	893+50	899+00	LT.			550											
D-3	889+00	893+50	℄	440	10												
D-4	893+50	899+00	℄			10	540										
D-5	889+00	893+50	RT.	450													
D-6	893+50	899+00	RT.			550											
D-7	889+00		℄-LT				78					1	0.23	2			
D-8	896+15	899+00	℄					285						2			
TOTAL				1358	30	1640	78	285				1	1	1	3.63	4	2

ITEM REF.	SPECIAL DRILLED WELLS ABAND.	LOCATION	ABAND. EACH
W-7	889+66	55' RT.	1
W-8	889+70	88' LT.	1
W-9	889+78	43' LT.	1
W-10	891+94	45' RT.	1
W-11	891+96	70' LT.	1
TOTAL			5

ROADWAY

REF. NO.	STATION	SIDE	GUARD RAIL (LIN. FT.)	
			STEEL BEAM (DEEP) STANDARD	BARRIER
GR-38	889+00	899+00	℄	1000
TOTAL				1000

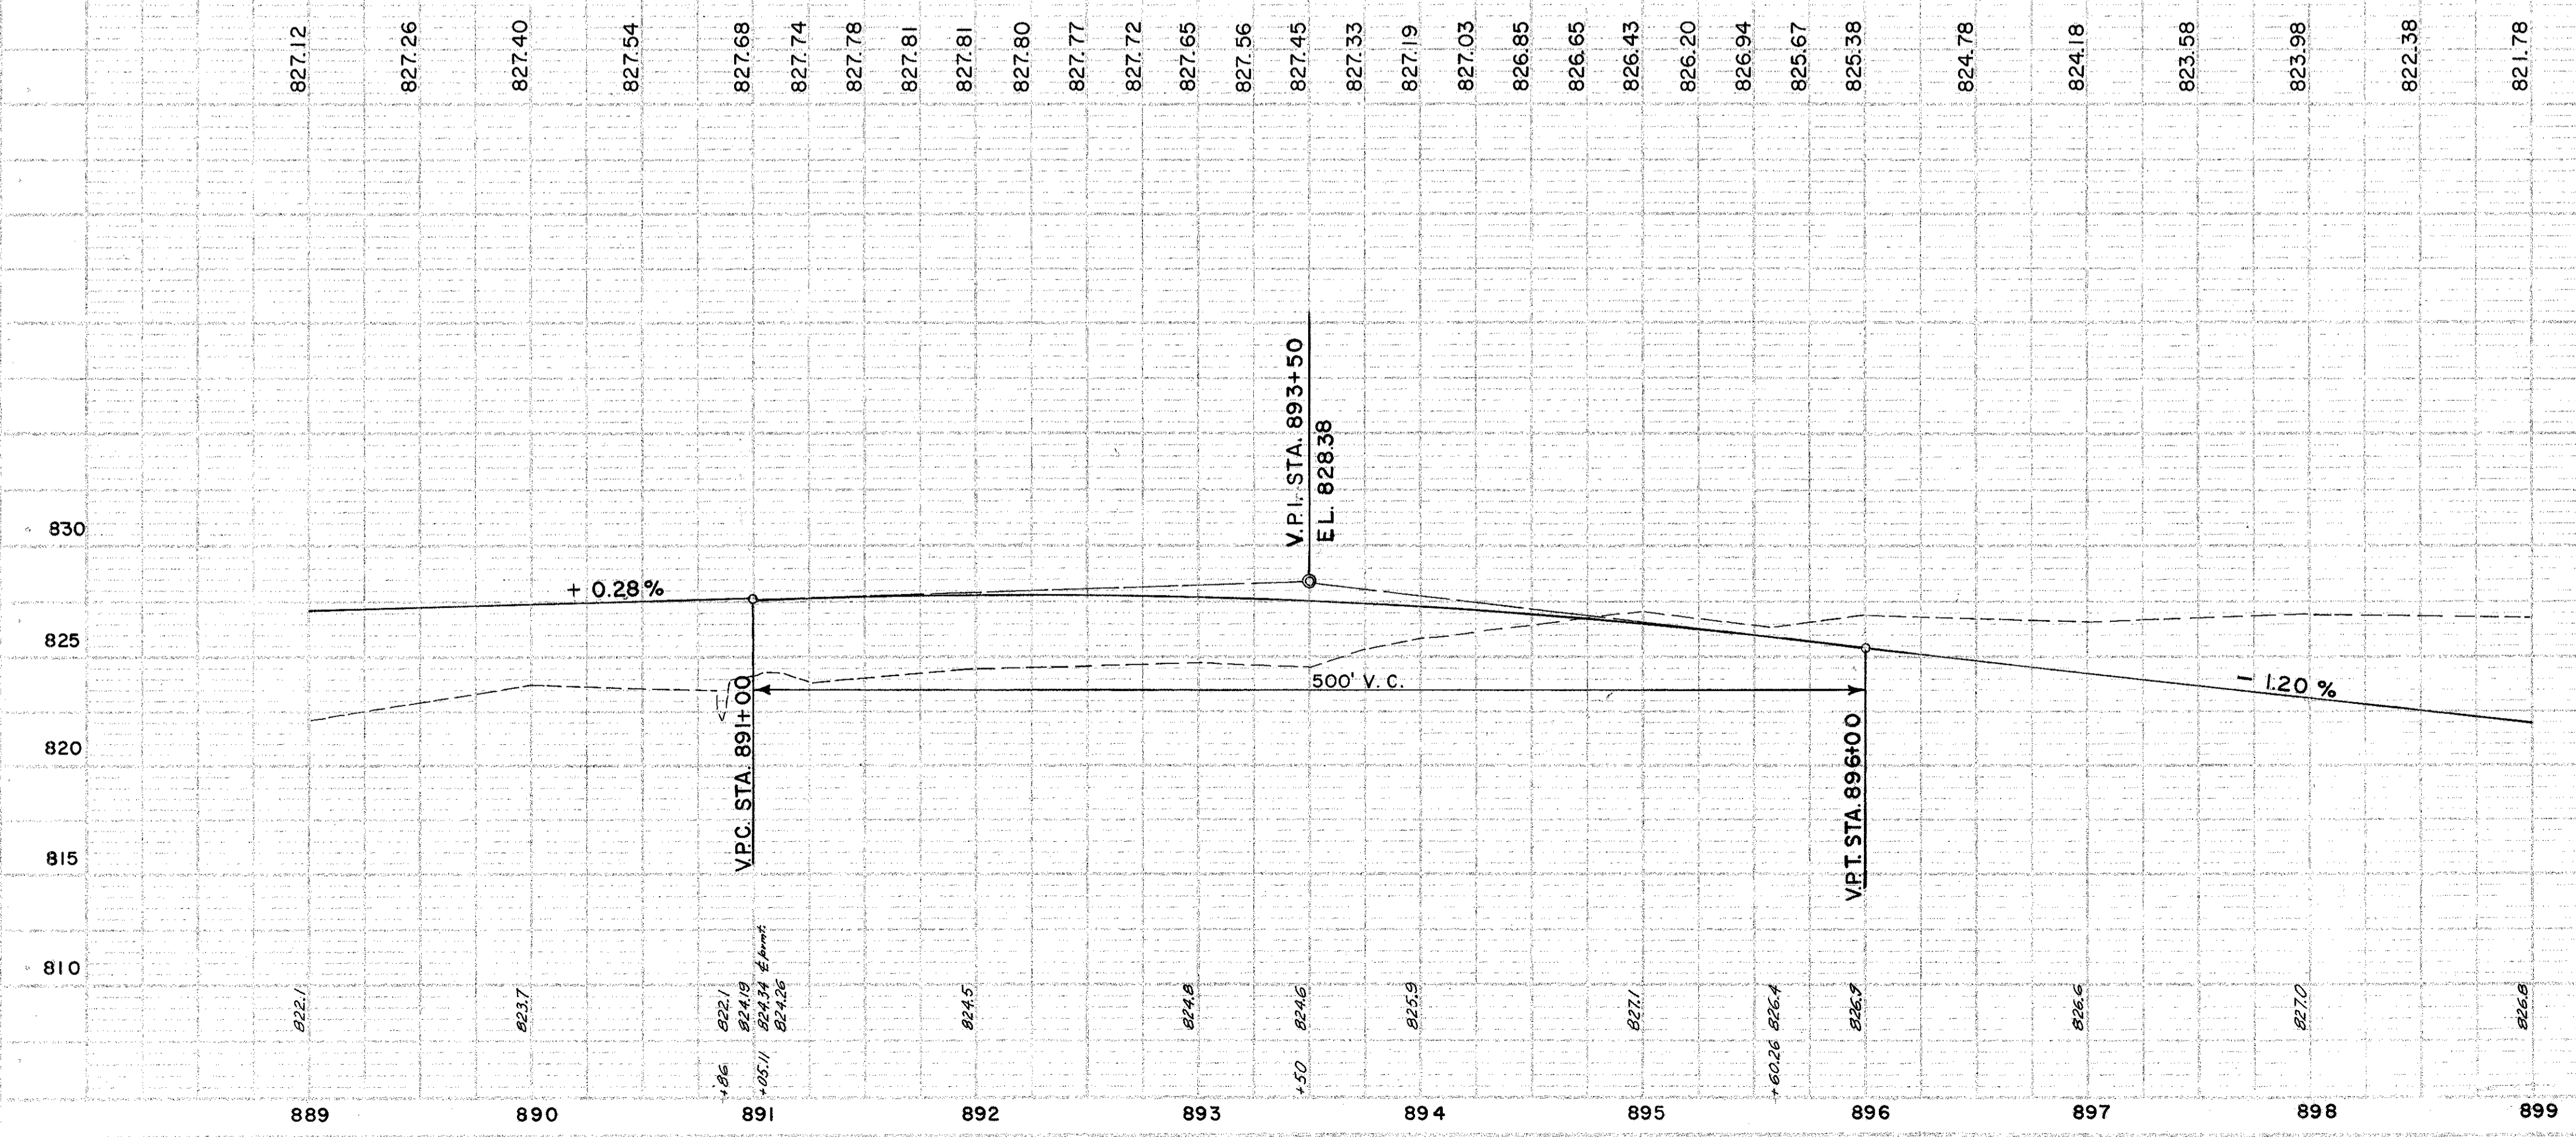

PLAN & PROFILE - STA. 889+00 TO STA. 899+00