


FED. RD. DIVISION	STATE	PROJECT	FISCAL YEAR
2	OHIO		

187
353

CUYAHOGA COUNTY
CUY - 71 - 5.72

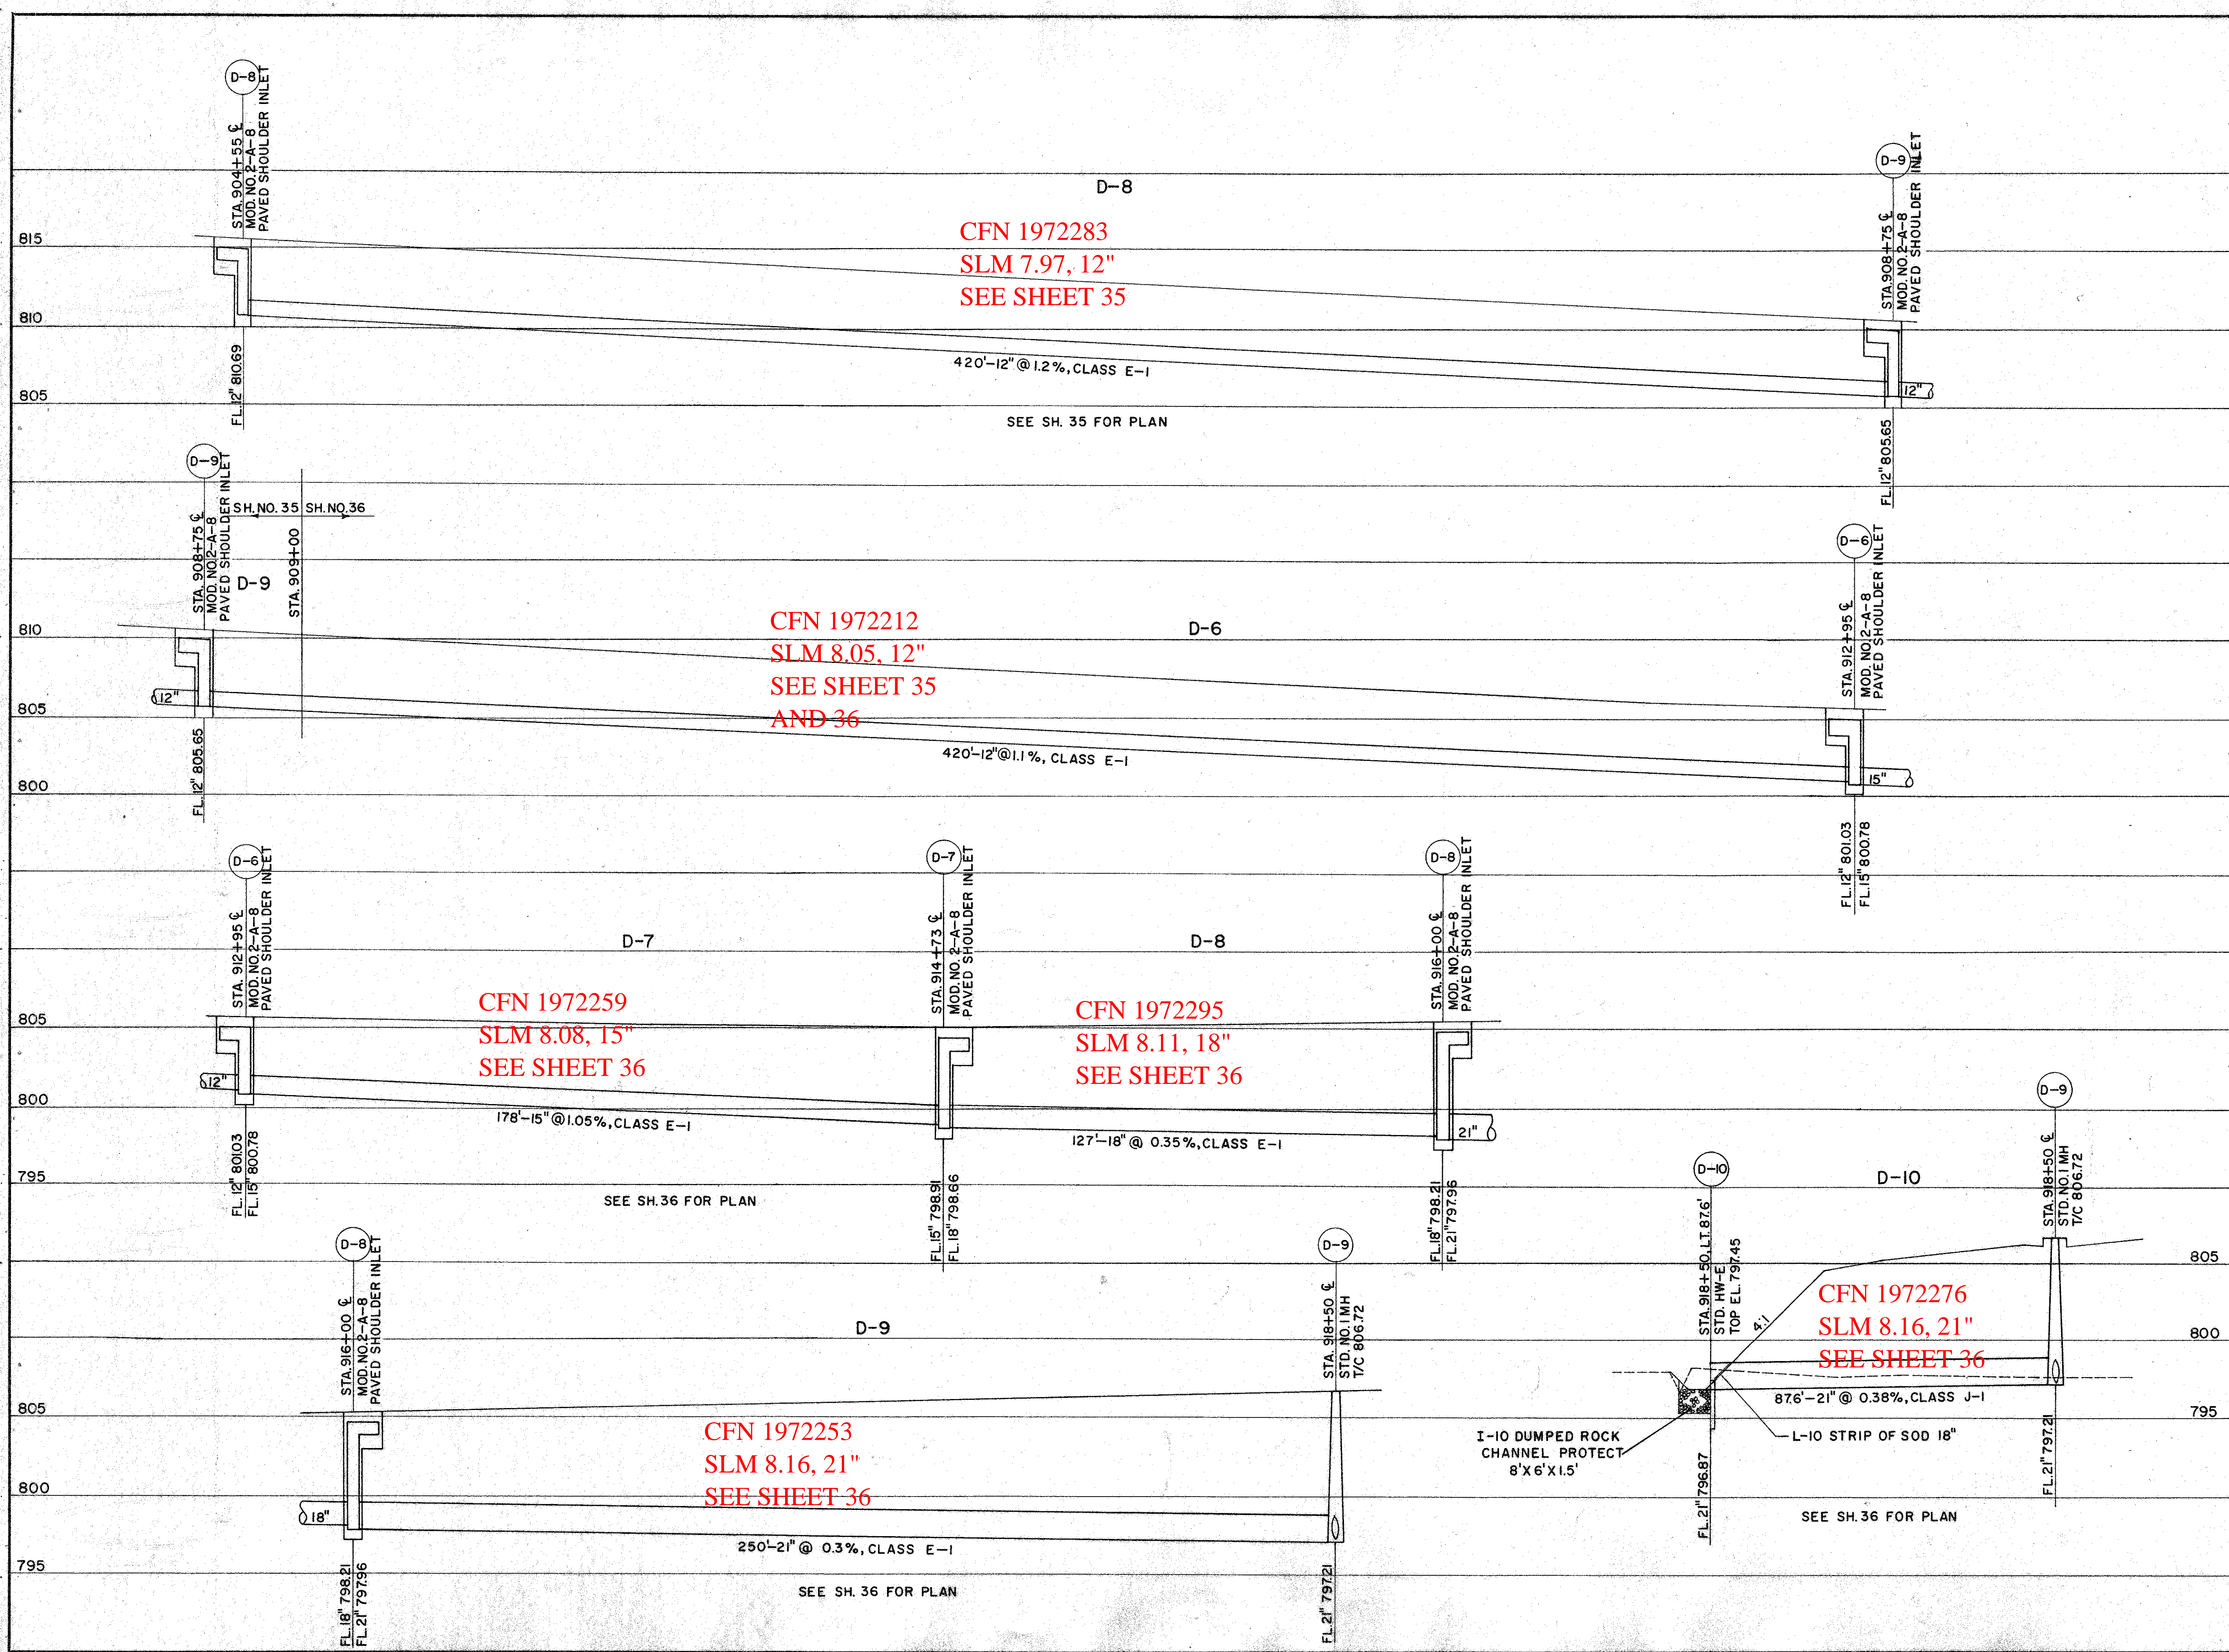

PACE ASSOCIATES OF OHIO
4500 EUCLID AVE. CLEVELAND 3, OHIO

I-71
SEWER PROFILES

SCALE		DATE			
DESIGNED	DRAWN	TRACED	CHECKED	REVIEWED	DATE