

CFN 1972342
SLM 9.10, 21"
SEE SHEET 114

CFN 1972350
SLM 9.04, 15"
SEE SHEET 113

CFN 1972349
SLM 8.99, 15"
SEE SHEET 113

SLM 8.99, 76"x48"
SEE SHEET 113

FOR DETAIL ON CULVERT D-7
SEE SHEET 118

FOR PROFILE OF STORM SEWERS
SEE SHEET 113 & 114

FOR STRUCTURE DATA SEE SHEET 23

SLM 9.14, 30"
SEE SHEET 118

FED. RD. DIVISION 2	STATE OHIO	PROJECT	FISCAL YEAR
------------------------	---------------	---------	-------------

22
230


CUYAHOGA COUNTY
CUY - 71-8.41

REF. NO.	STATION	M-O-U	LIN. FT.																				
			I-1		I-2		I-3		I-4		I-5		I-6										
FROM	TO		EA	C.Y.	EA	C.Y.	EA	C.Y.	EA	C.Y.	EA	C.Y.	EA	C.Y.									
D-1	959+00	61+58	RT																				
D-2	63+93	62+07												177									
D-3	961+30	61+58	RT																				
D-4	964+50		LT																				
D-5	66+05	967+40																					
D-6	65+78	968+00	RT																				
D-7	47+56	969+00	RT																				
D-8	65+34.6	67+67	LT	232																			
D-9	959+00	968+20	RT	300	20																		
D-10	959+00	966+00	RT	680	20																		
D-11	966+00	968+82	RT	282																			
D-12	959+80	964+60	LT										334										
D-13	959+00	963+10	RT										272										
D-14	959+00	61+58	RT											254									
D-15	967+62		LT											159									
D-15	968+97		RT																				
TOTAL				2094	40	17	234	106	324	68	216	260	1	1	2	1	3	7.86	47	645	354	159	254

T.B.M. NO. 17 EL. 786.85
CHISELED □ ON LARGE ROCK,
200' RT. STA. 960+00.

CURVE DATA
Δ=18°14'32"
D=19'0"
R=5729.58'
T=919.89'
L=1824.22'

FOR SIGN PLAN SEE SHEET NO. 137
FOR PAVEMENT DETAILS SEE SHEET 93

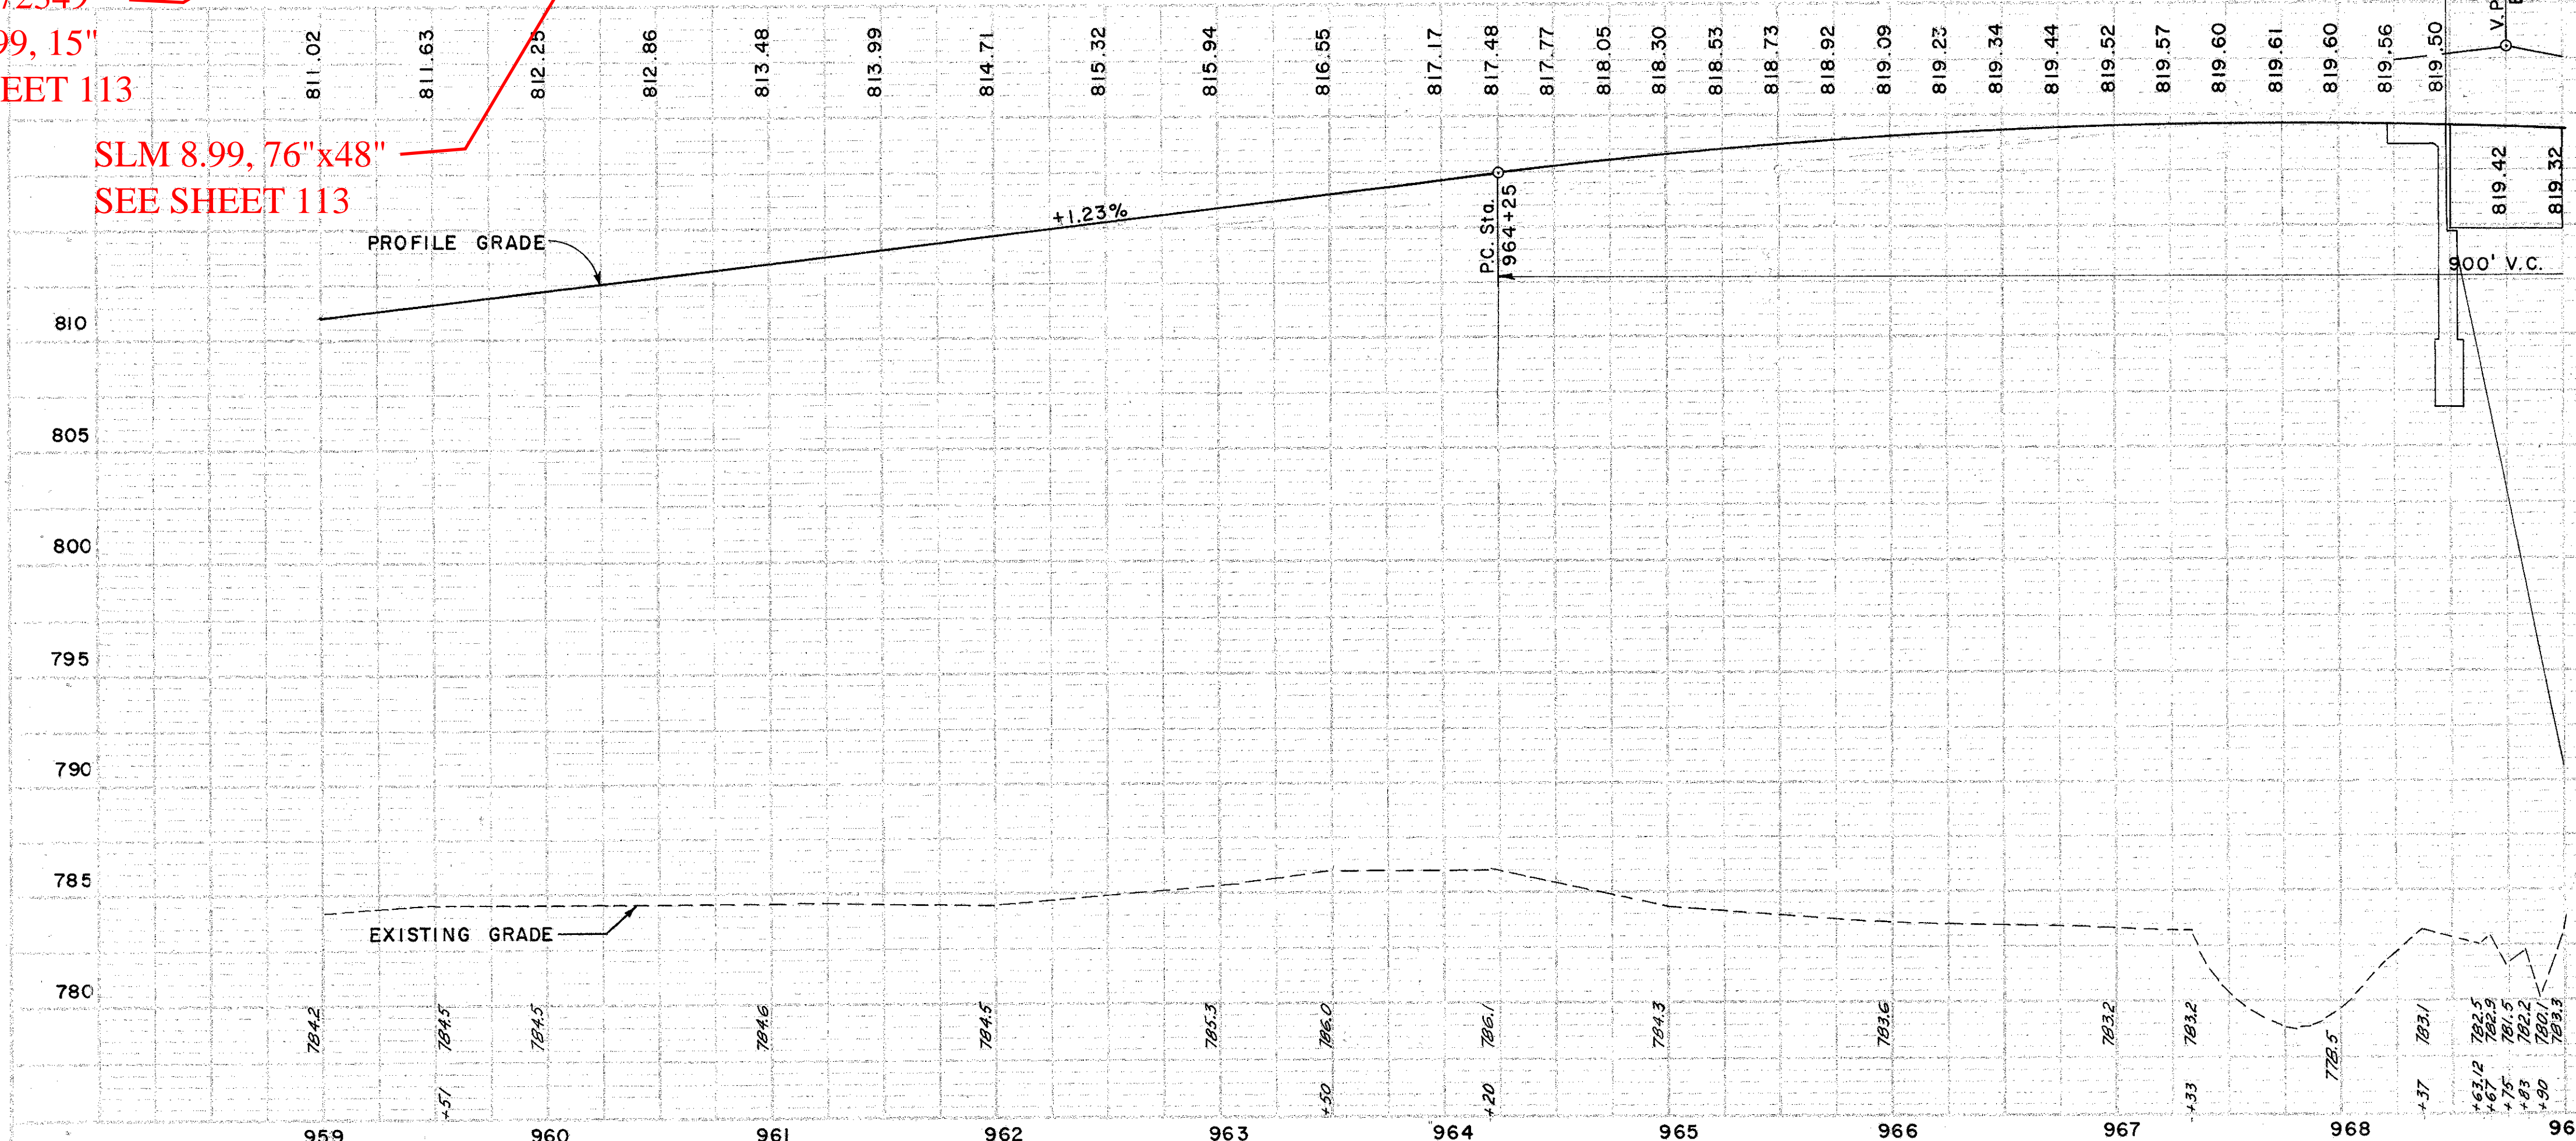

REF. NO.	STATION	M-O-U	STEEL BEAM (DEEP)	
			STANDARD	BARRIER
R-1	959+00	960+00	LT.	200
R-2	965+36	967+64	LT.	228
R-3	966+00	968+97	RT.	297
R-4	959+00	968+63.12	℄	963.12
TOTAL				725
				963.12

PLAN & PROFILE - STA. 959+00 TO STA. 969+00