

CFN 1972341
SLM 9.51, 15"
SEE SHEET 112

CFN 1972346
SLM 9.54, 15"
SEE SHEET 112



CFN 1972344
SLM 9.60, 15"
SEE SHEET 112

NOTE: PROPOSED TYPICAL SECTION
OF ADJOINING PROJECT SAME AS
SHOWN FOR THIS PROJECT ON
SHEET

FOR PROFILE OF STORM SEWERS SEE SHEET 112
FOR PAVEMENT DETAILS SEE SHEET 95
FOR SIGN PLAN SEE SHEET NO. 135

DRAINAGE	STATION	SIDE	I-1				I-2	I-5	I-8	
			6" PIPE CLASS I-3	6" PIPE CLASS F-4	8" PIPE CLASS F-4	15" PIPE CLASS J-1	MASONRY	6" TEE CLASS I-3	MOD. 2-A-6 PAVED SHOULDER	
			LIN. FT.				CY.	EA.	EA.	
D-1	989+20	DITCH				88	.26	1		
D-2	990+55	DITCH				86	.26	1		
D-3	993+80	DITCH				86	.26	1		
D-4	989+00	994+00	LT.	514	10			1		
D-5	989+00	994+00	CL.	442	40					
D-6	989+00	994+00	RT.	520	30	10		1		
TOTAL				1476	70	20	260	.78	2	3

ROADWAY	STATION		SIDE	I-15	
	FROM	TO		GUARD RAIL	STEEL BEAM (DEEP)
	LIN. FT.			STANDARD BARRIER	
R-1	989+00	994+00	CL.	500	
TOTAL				500	

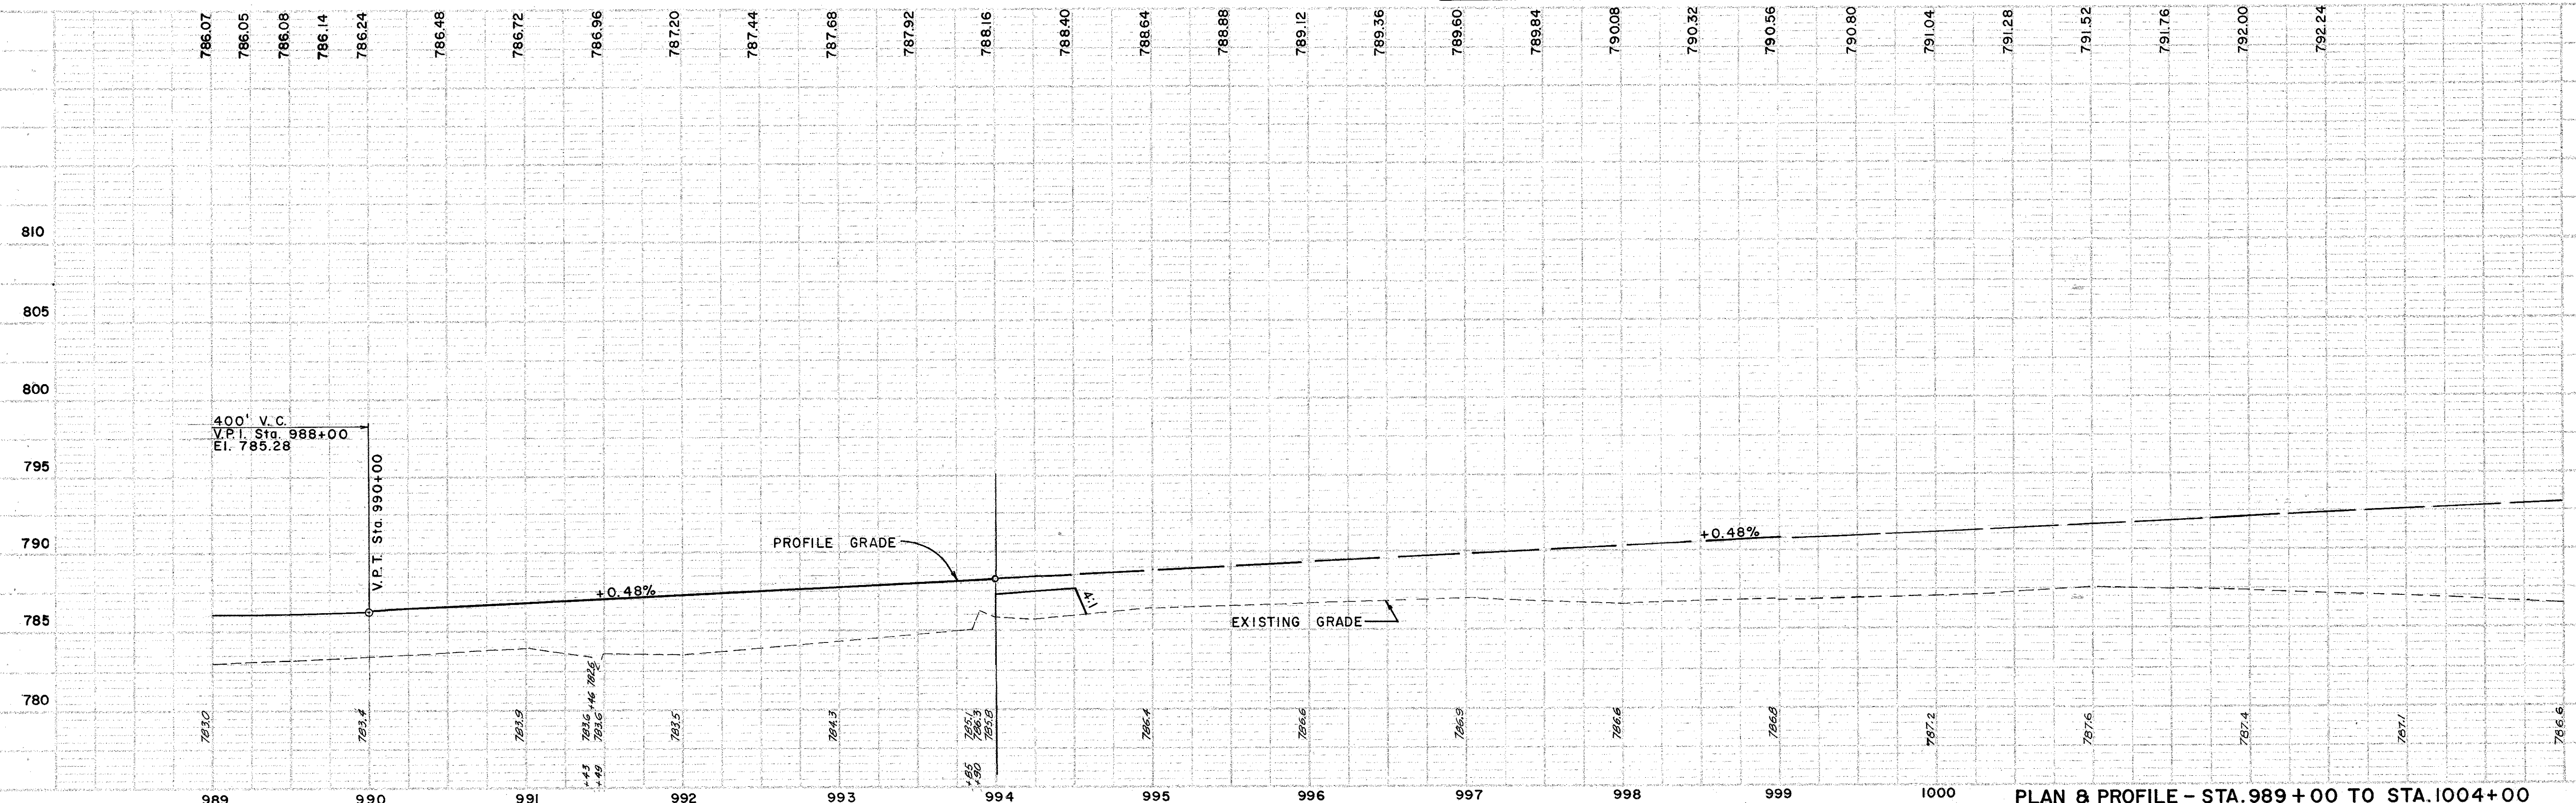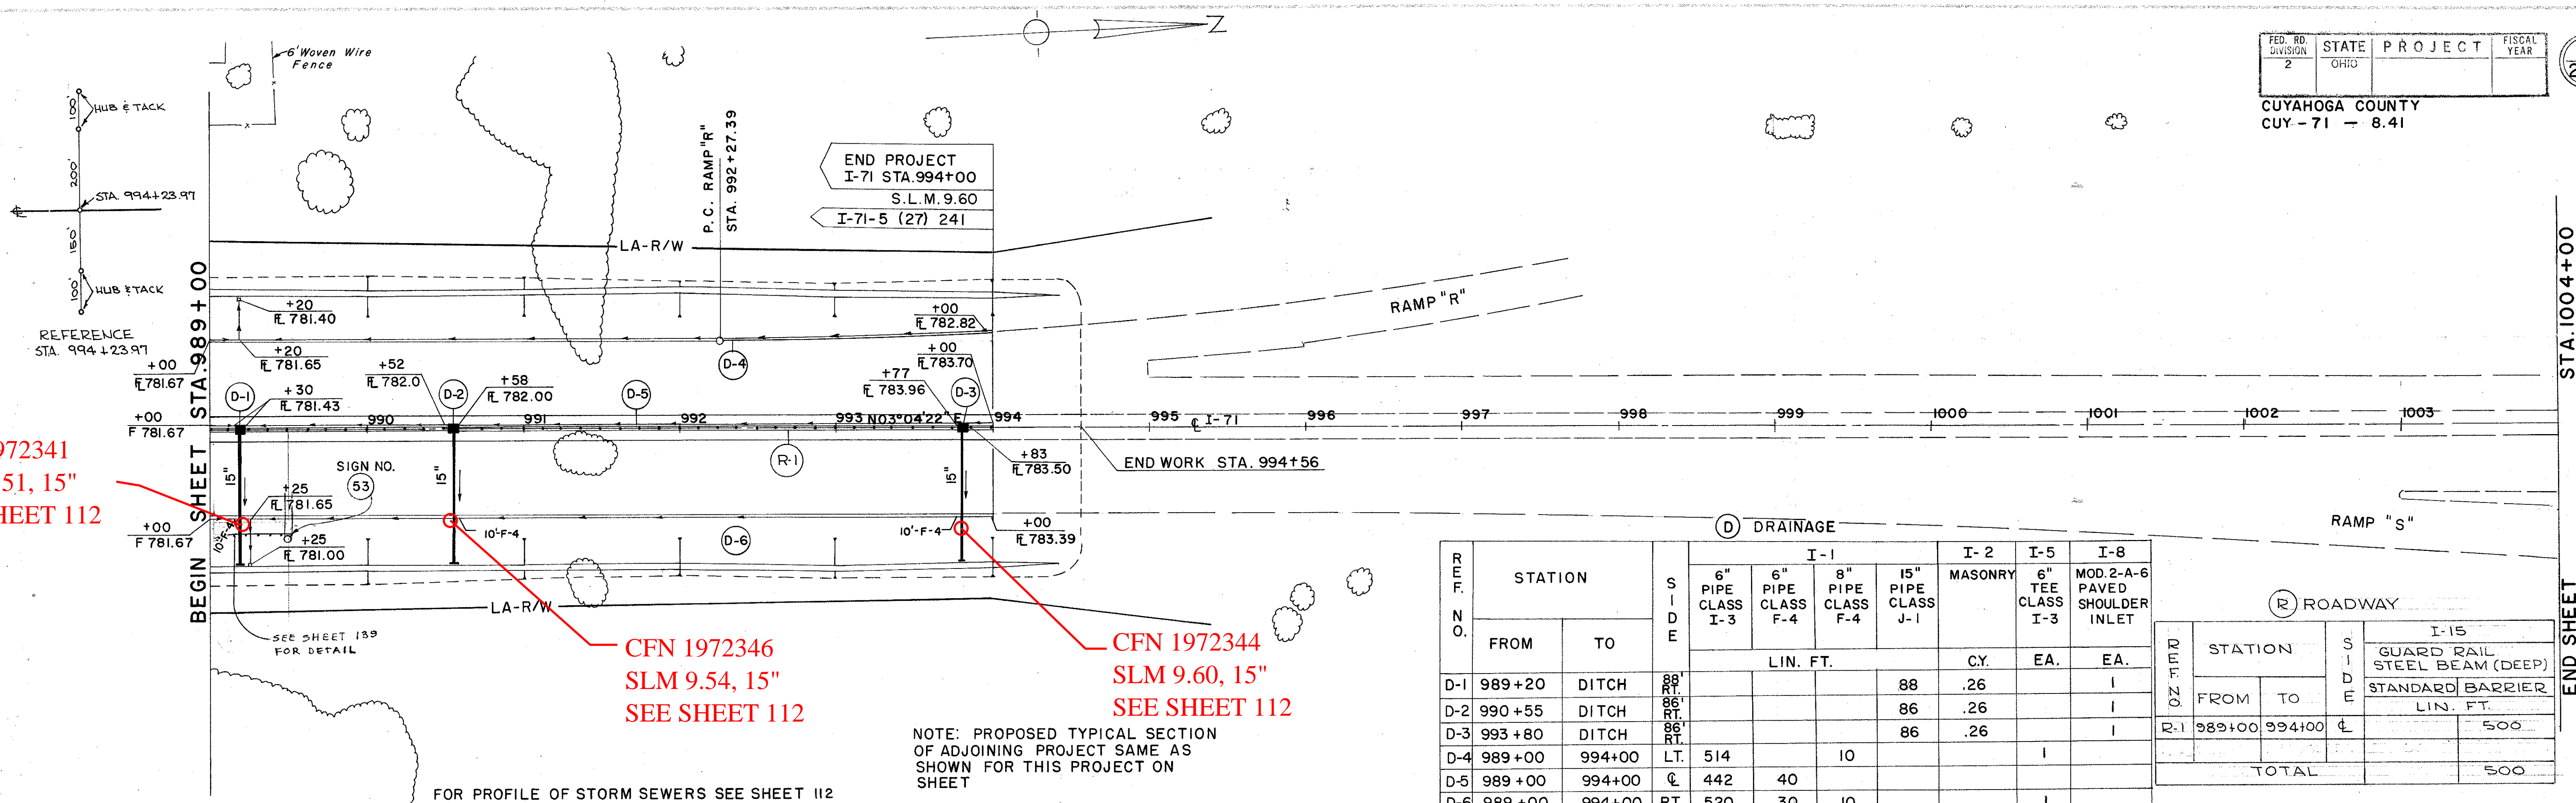

PLAN & PROFILE - STA. 989 + 00 TO STA. 1004 + 00