


FED. RD. DIVISION	STATE	PROJECT
2	OHIO	

110
230

CUYAHOGA COUNTY
CUY-71-8.41

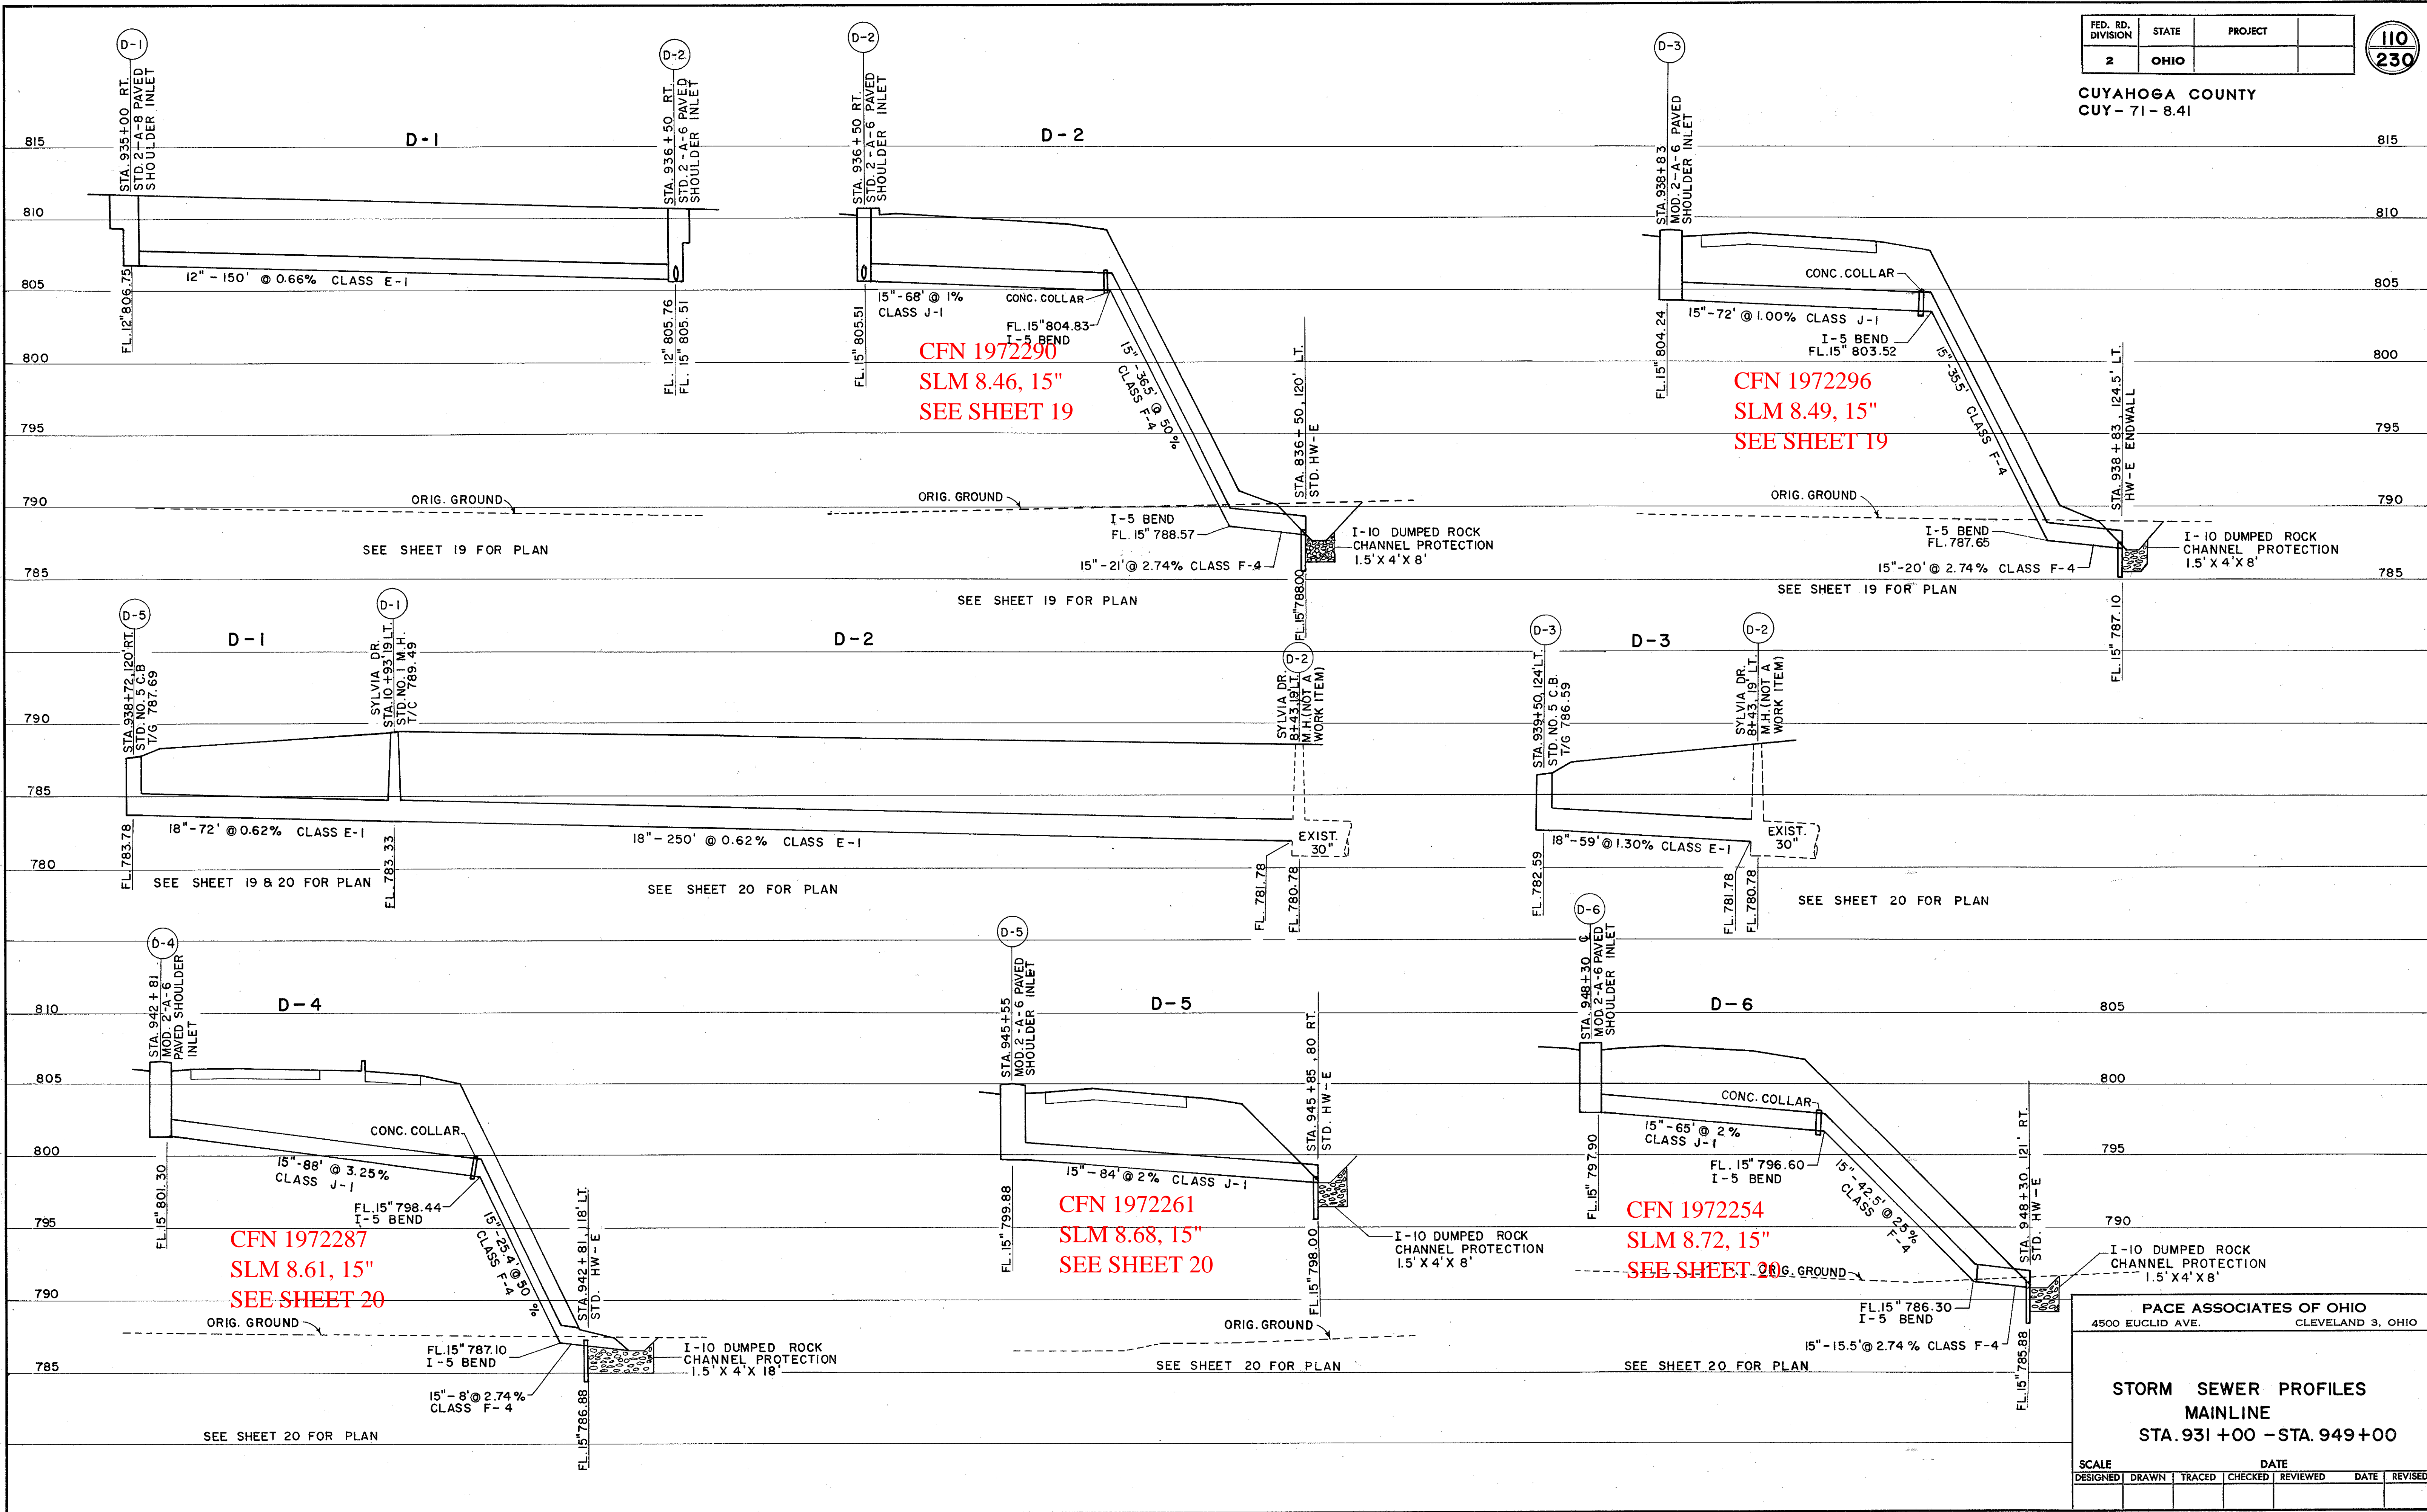

CFN 1972290
SLM 8.46, 15"
SEE SHEET 19

CFN 1972296
SLM 8.49, 15"
SEE SHEET 19

CFN 1972287
SLM 8.61, 15"
SEE SHEET 20

CFN 1972261
SLM 8.68, 15"
SEE SHEET 20

CFN 1972254
SLM 8.72, 15"
SEE SHEET 20

PACE ASSOCIATES OF OHIO
4500 EUCLID AVE. CLEVELAND 3, OHIO

STORM SEWER PROFILES
MAINLINE
STA. 931+00 - STA. 949+00

SCALE		DATE			
DESIGNED	DRAWN	TRACED	CHECKED	REVIEWED	DATE