
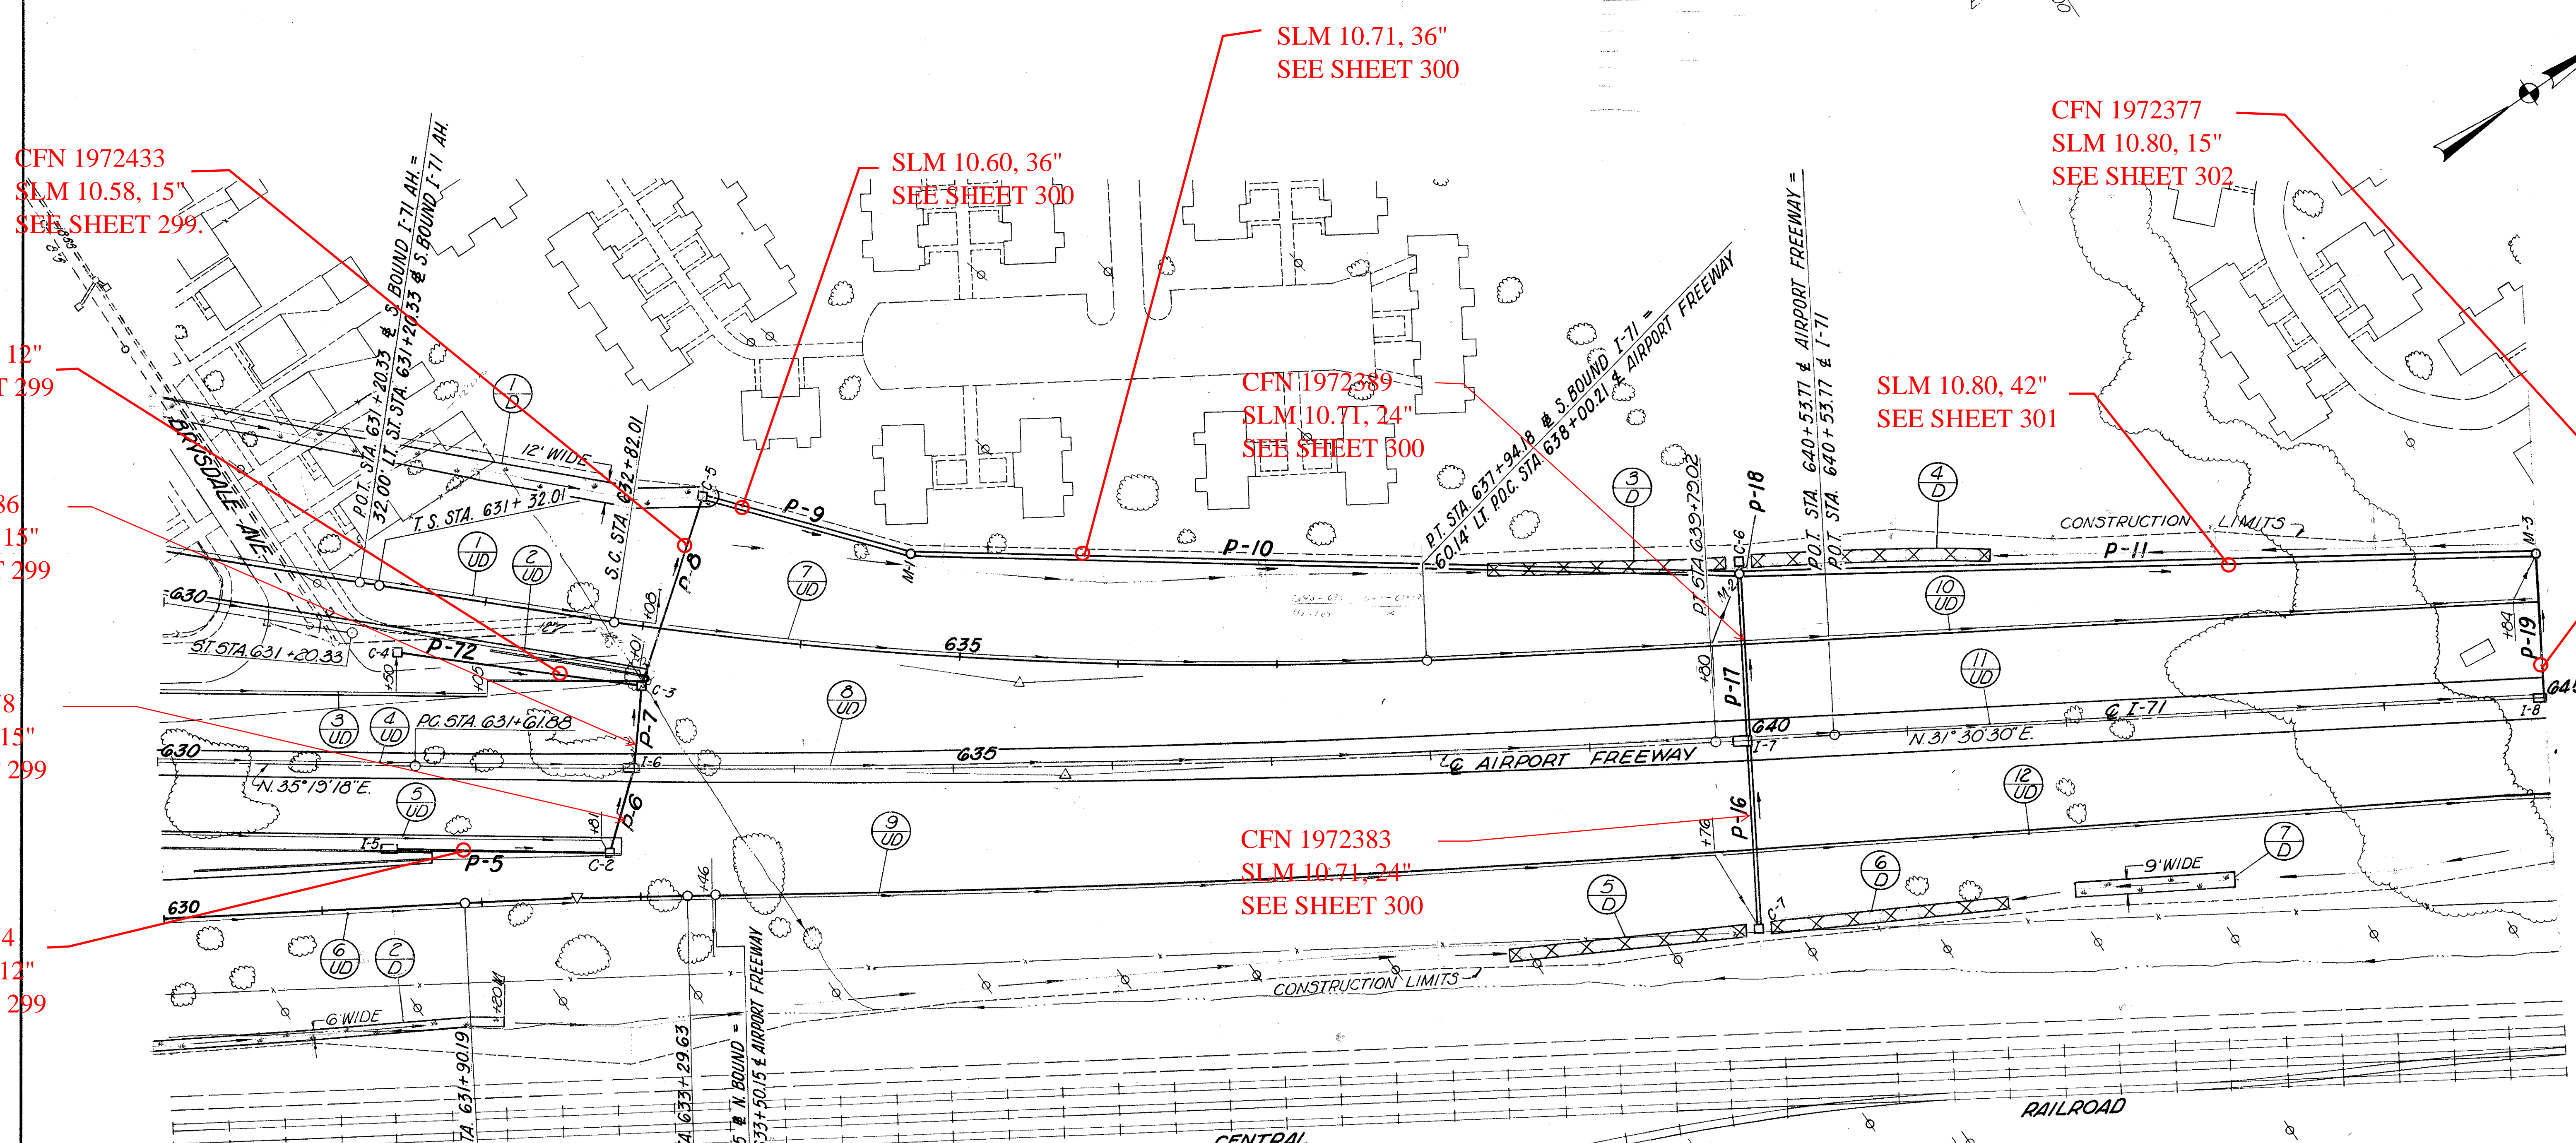


E 52'000
N 62'000

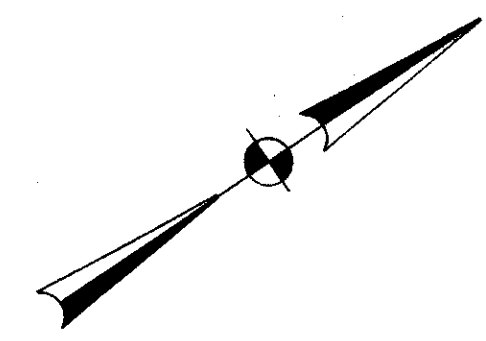

CFN 1972433
 SLM 10.58, 15"
 SEE SHEET 299.

SLM 10.60, 36"
 SEE SHEET 300

SLM 10.71, 36"
 SEE SHEET 300

CFN 1972377
 SLM 10.80, 15"
 SEE SHEET 302

CFN 1972389
 SLM 10.71, 24"
 SEE SHEET 300

SLM 10.80, 42"
 SEE SHEET 301

SLM 10.57, 12"
 SEE SHEET 299

CFN 1972386
 SLM 10.57, 15"
 SEE SHEET 299

CFN 1972378
 SLM 10.57, 15"
 SEE SHEET 299

CFN 1972383
 SLM 10.71, 24"
 SEE SHEET 300

CFN 1972374
 SLM 10.57, 12"
 SEE SHEET 299

NOTE
 FOR DRAINAGE PROFILES
 SEE SHEET NO. 299, 300, & 301.

REF.	STATION TO STATION	SIDE	L-10		L-120	
			SODDING	JUTE MATTING	SODDING	JUTE MATTING
1-D	630+00 to 633+48	LT	50.00	50.00		
2-D	630+00 to 632+20	RT	147			
3-D	638+45 to 639+95	LT		125		
4-D	640+05 to 640+55	LT		125		
5-D	638+45 to 639+95	RT		125		
6-D	640+05 to 641+55	RT		125		
7-D	642+00 to 643+00	RT	100			
TOTALS			714	500		

REF.	STATION TO STATION	SIDE	I-1				I-5, PIPE SPL		
			Class F-4		Class I-3		6x6 Class I-3		
			M-6.40	SHALLOW	DEEP	BENDS	TEE/WYE		
			6"	8"	6"	6"	60"	90"	60"
			LIN. FT.			EACH			
1-UD	630+00.58 to 633+08.58	LT		10					
2-UD	630+00.58 to 633+05.58	LT		7					
3-UD	630+00 to 632+05	LT		10					
4-UD	630+00 to 633+00	E		10					
5-UD	630+00 to 632+85	RT		10					
6-UD	630+00 NB to 633+46 NB	RT		10					
7-UD	633+16.58 to 640+00	LT		10					
8-UD	633+04 to 640+00	E		10					
9-UD	633+54 to 640+00	RT		10					
10-UD	639+84 to 645+00	LT		10					
11-UD	640+00 to 645+00	E		10					
12-UD	639+80 to 645+00	RT		10					
TOTALS			87	??	5425				8