


FED. RD. DIVISION	STATE	PROJECT
2	OHIO	

289
646

CUYAHOGA COUNTY
CUY-71-17.83
CUY-176-12.76

38
54

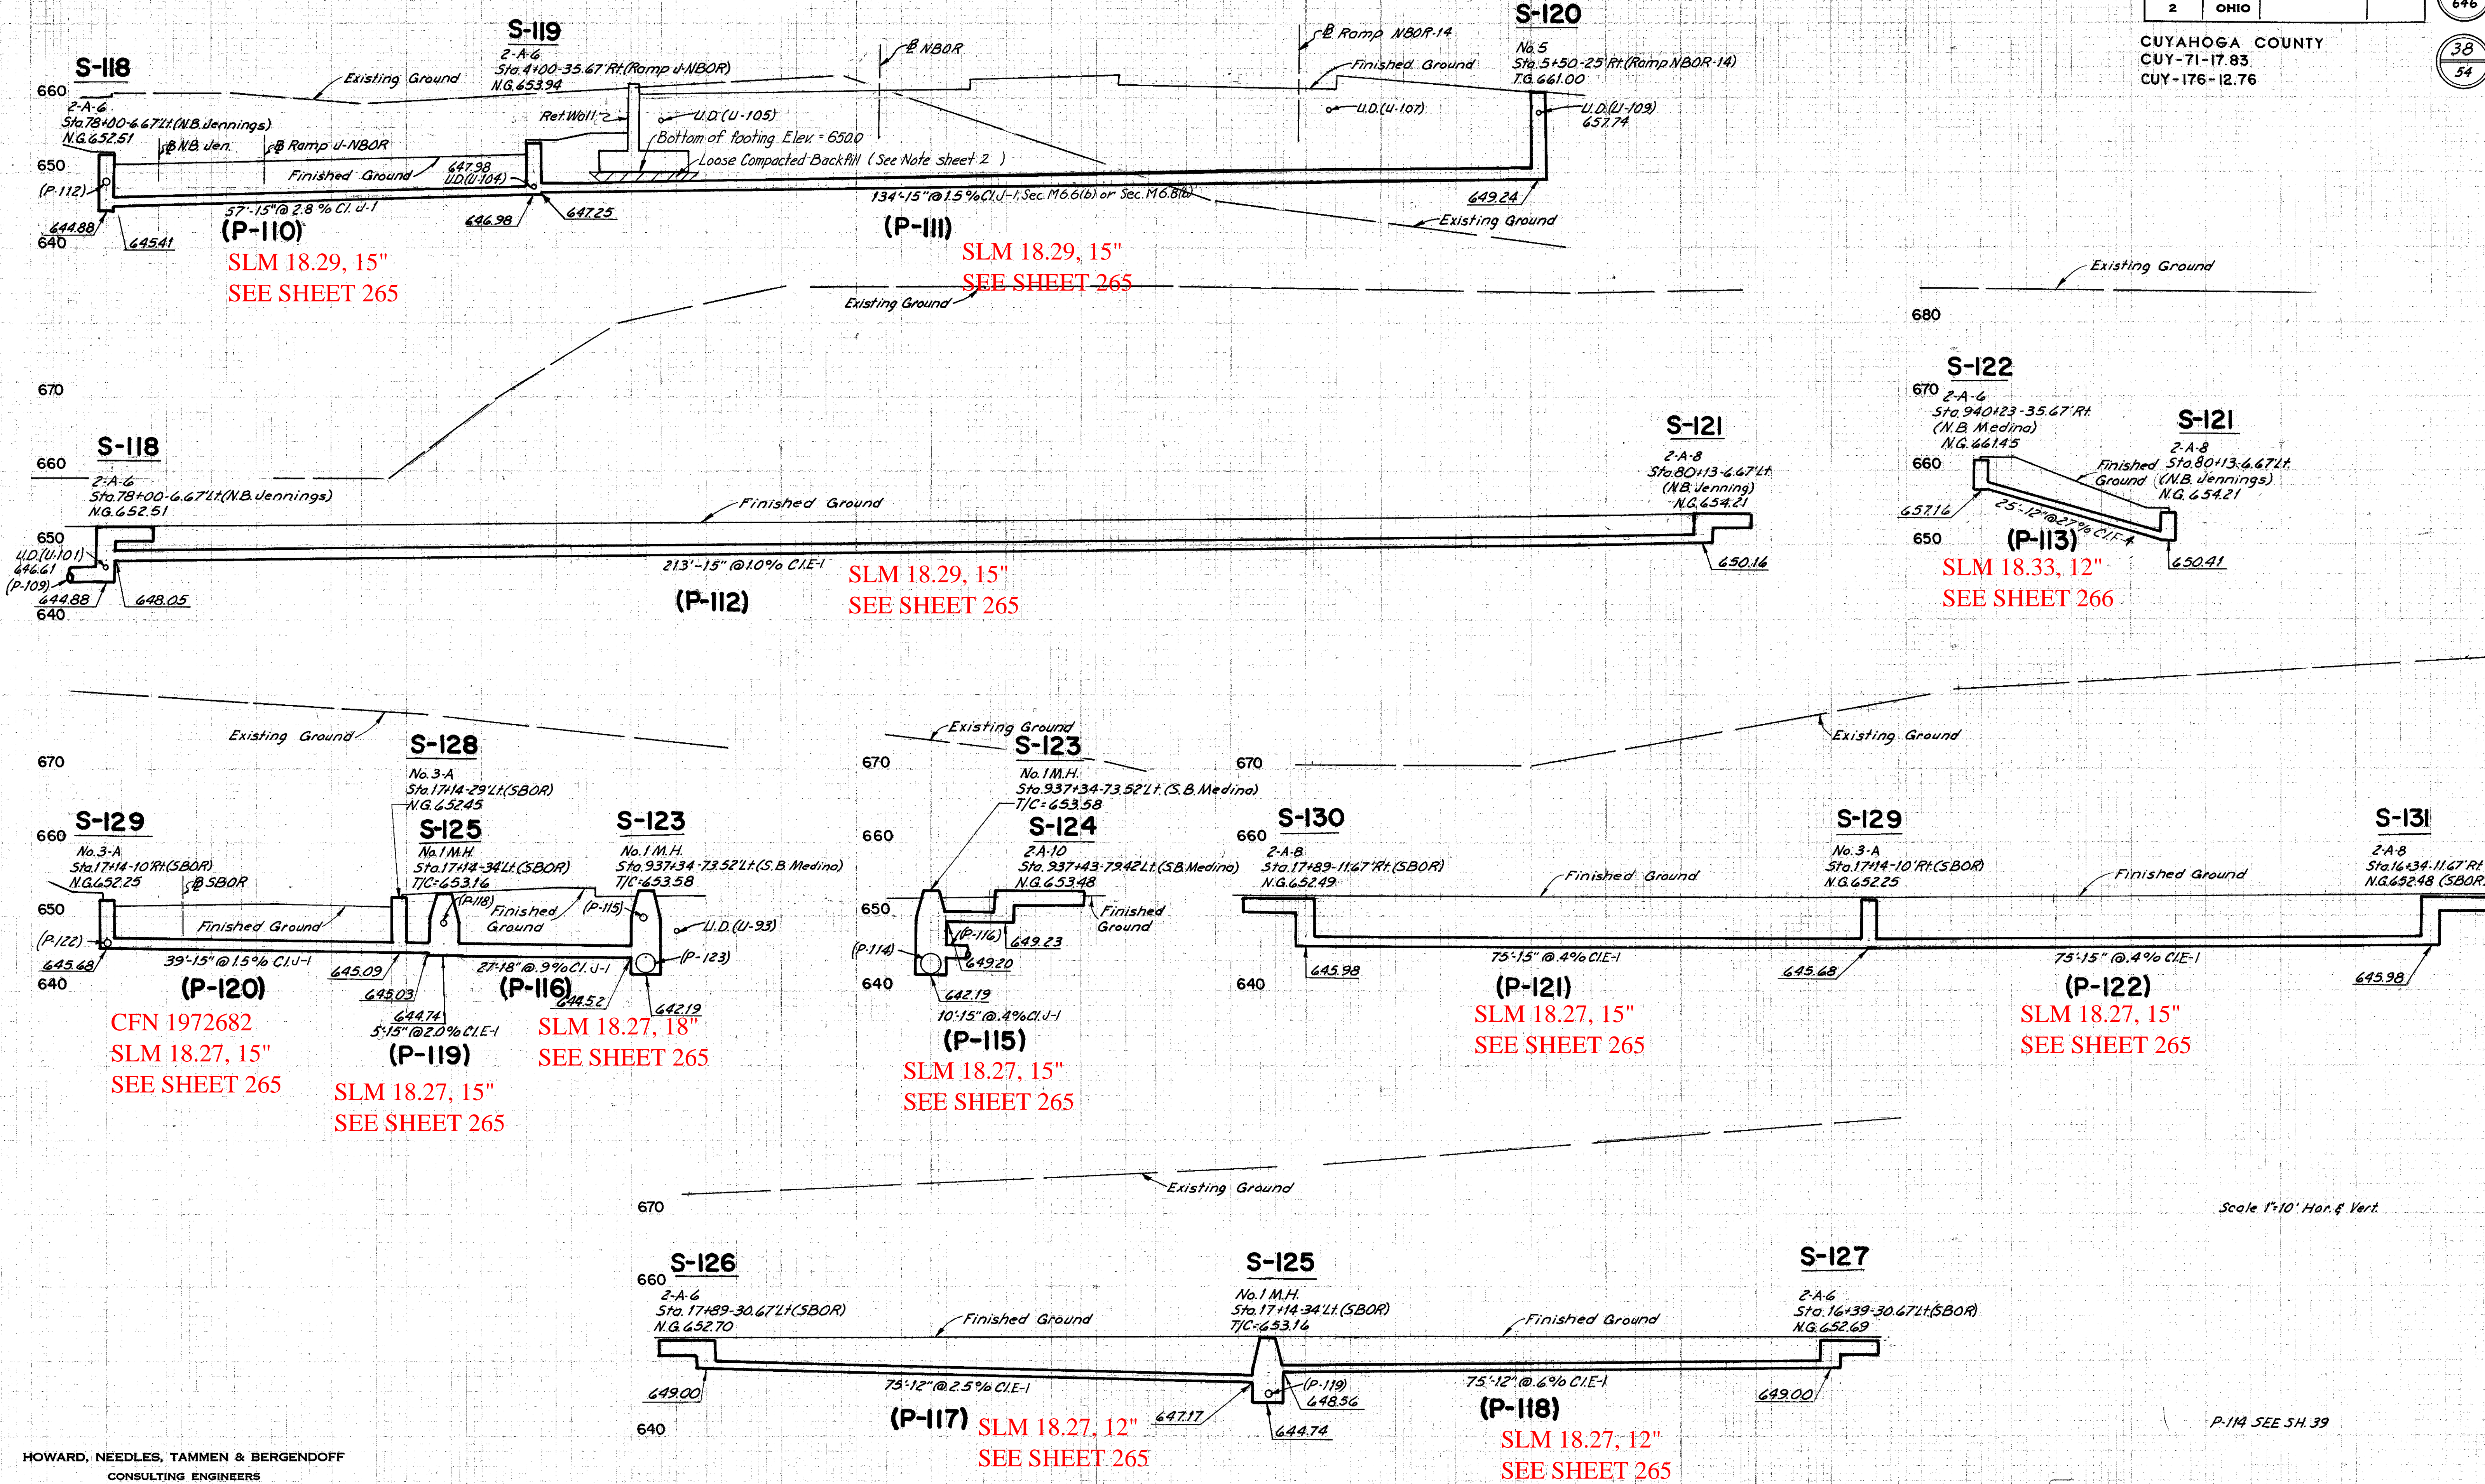

SLM 18.29, 15"
SEE SHEET 265

SLM 18.29, 15"
SEE SHEET 265

SLM 18.29, 15"
SEE SHEET 265

SLM 18.33, 12"
SEE SHEET 266

CFN 1972682
SLM 18.27, 15"
SEE SHEET 265

SLM 18.27, 15"
SEE SHEET 265

SLM 18.27, 18"
SEE SHEET 265

SLM 18.27, 15"
SEE SHEET 265

SLM 18.27, 15"
SEE SHEET 265

SLM 18.27, 15"
SEE SHEET 265

(P-I17) SLM 18.27, 12"
SEE SHEET 265

(P-I18) SLM 18.27, 12"
SEE SHEET 265

R.D.V. 9-16-64
J.M.C. 10-27-64