


FED. RD. DIVISION	STATE	PROJECT
2	OHIO	

290
646

CUYAHOGA COUNTY
CUY-71-17.83
CUY-176-12.76

39
54

RDJ 9-22-64
J.M.O. 10-13-64

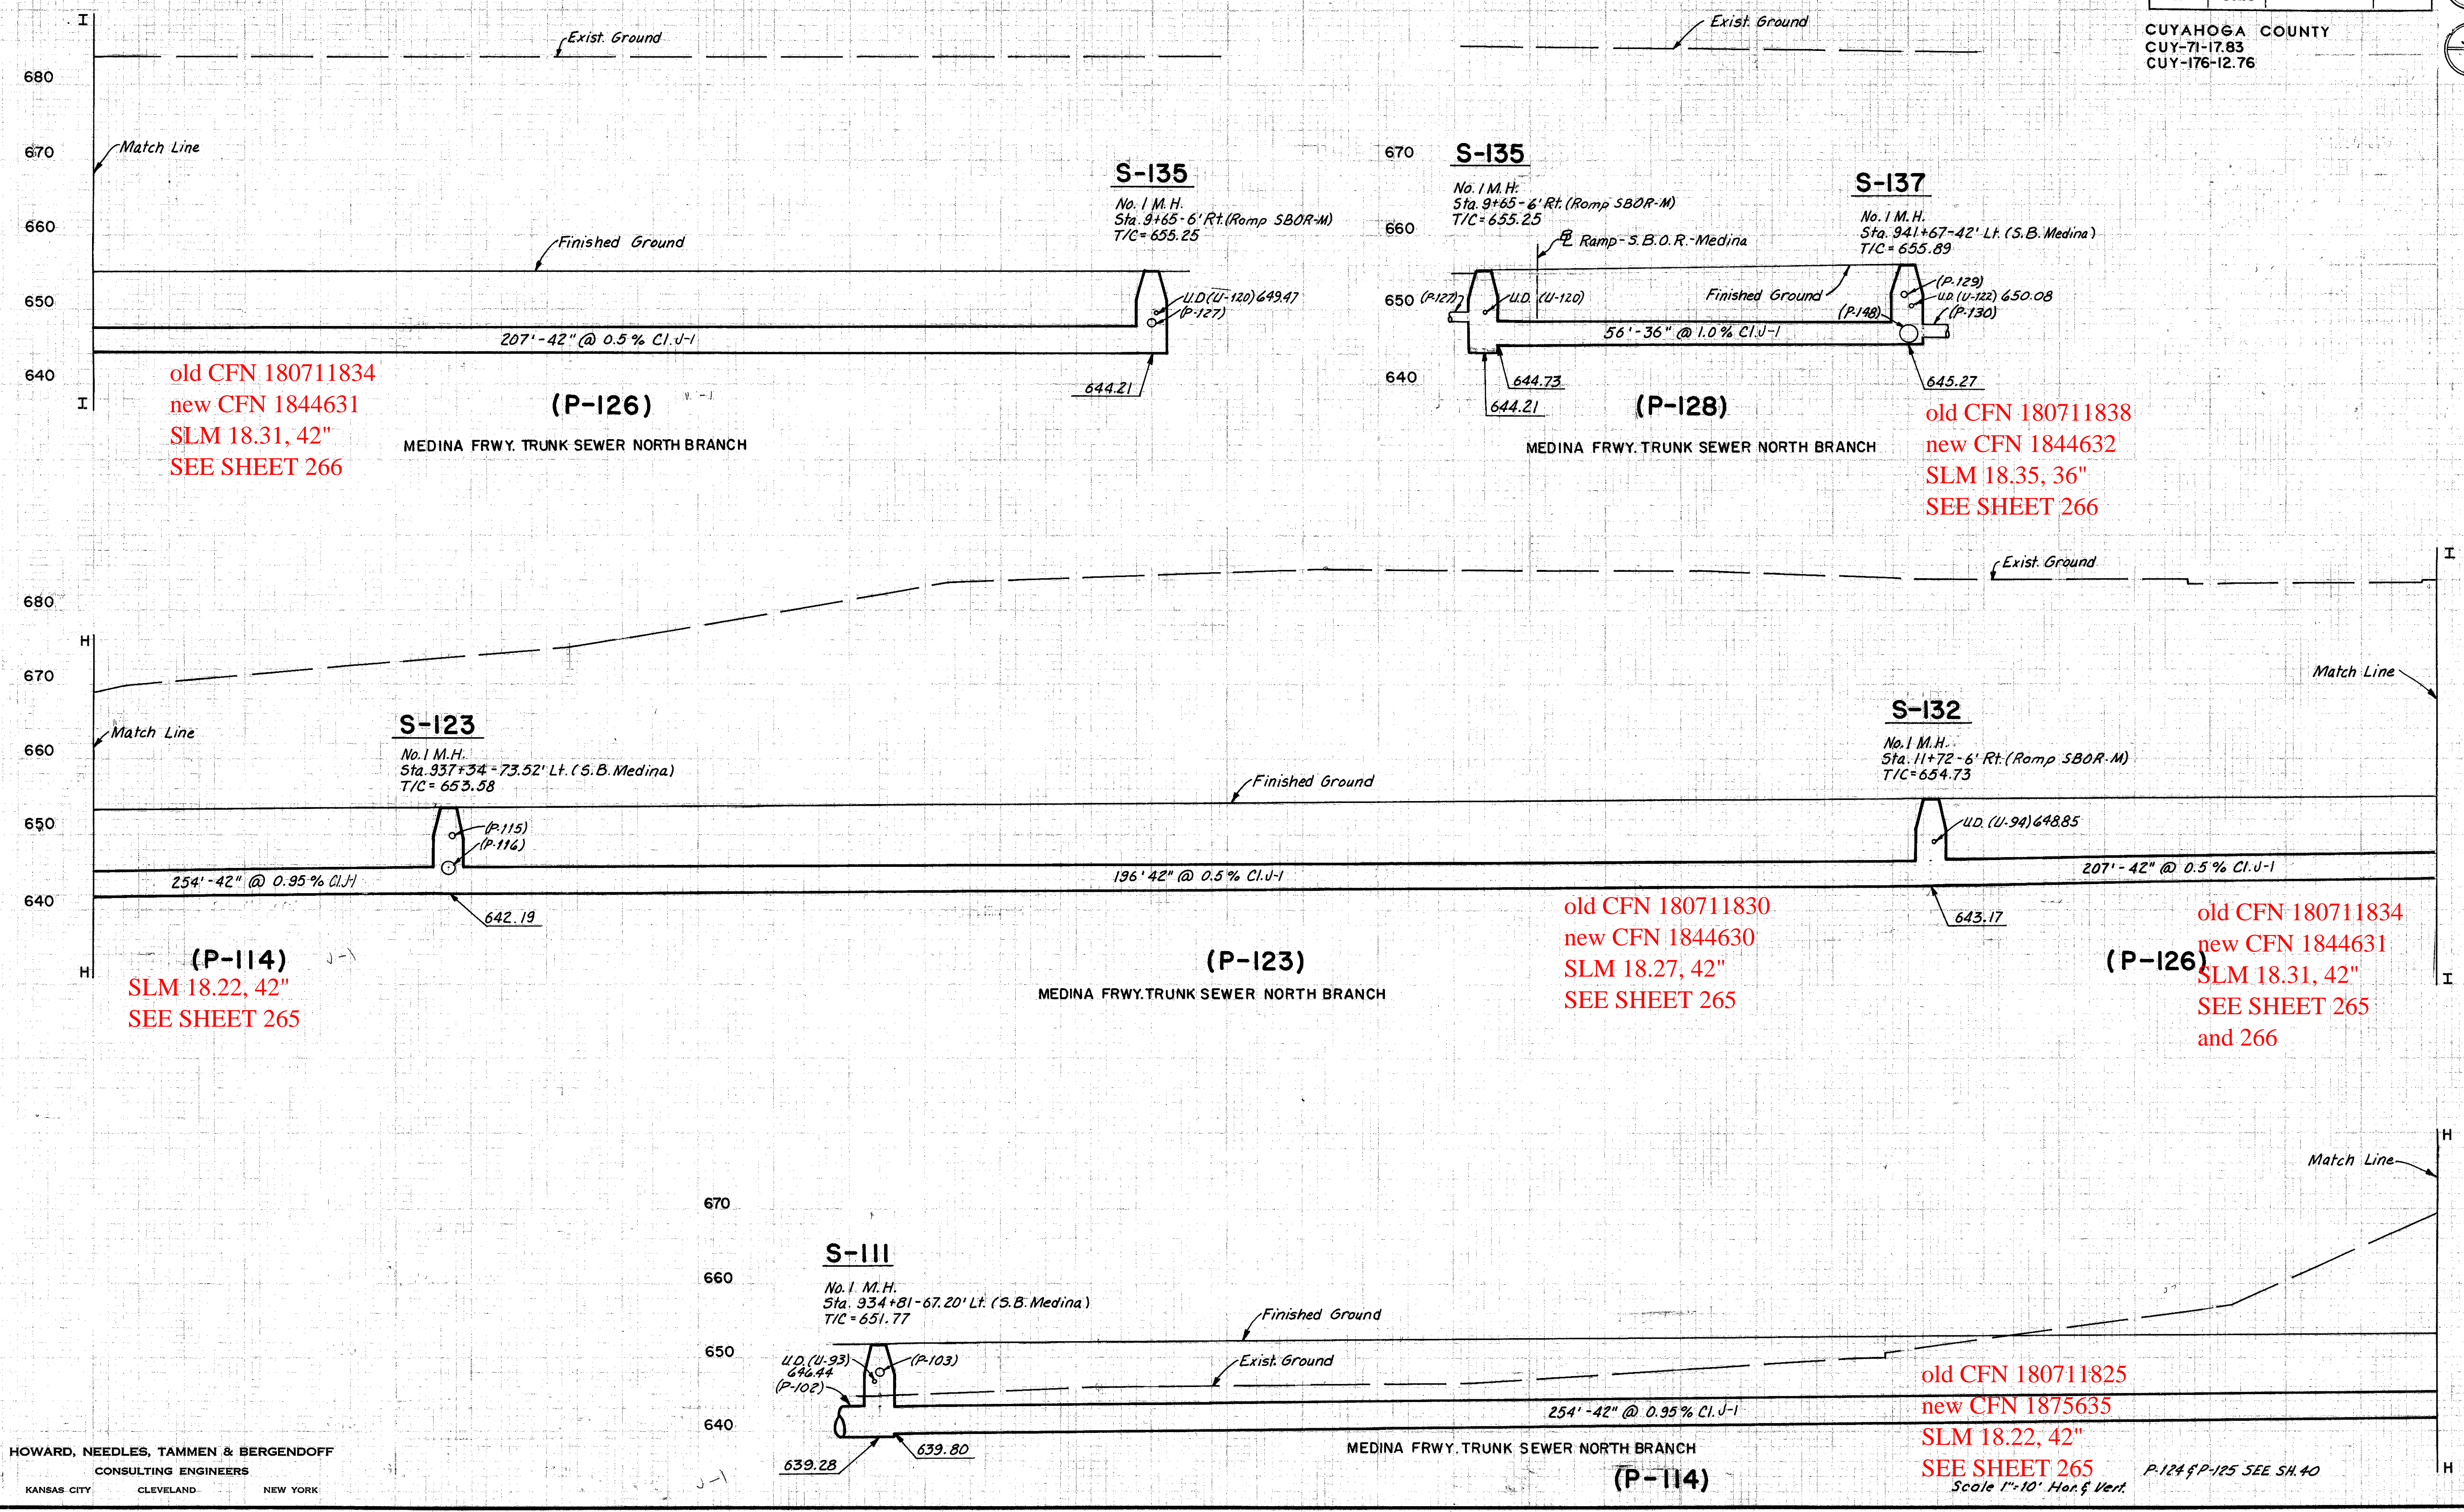

old CFN 180711834
new CFN 1844631
SLM 18.31, 42"
SEE SHEET 266

old CFN 180711838
new CFN 1844632
SLM 18.35, 36"
SEE SHEET 266

(P-114)
SLM 18.22, 42"
SEE SHEET 265

old CFN 180711830
new CFN 1844630
SLM 18.27, 42"
SEE SHEET 265

old CFN 180711834
new CFN 1844631
SLM 18.31, 42"
SEE SHEET 265
and 266

old CFN 180711825
new CFN 1875635
SLM 18.22, 42"
SEE SHEET 265

HOWARD, NEEDLES, TAMMEN & BERGENDOFF
CONSULTING ENGINEERS
KANSAS CITY CLEVELAND NEW YORK

P-124 & P-125 SEE SH. 40