


FED. RD. DIVISION	STATE	PROJECT
2	OHIO	

285  
646

34  
54

CUYAHOGA COUNTY  
CUY-71-17.83  
CUY-176-12.76

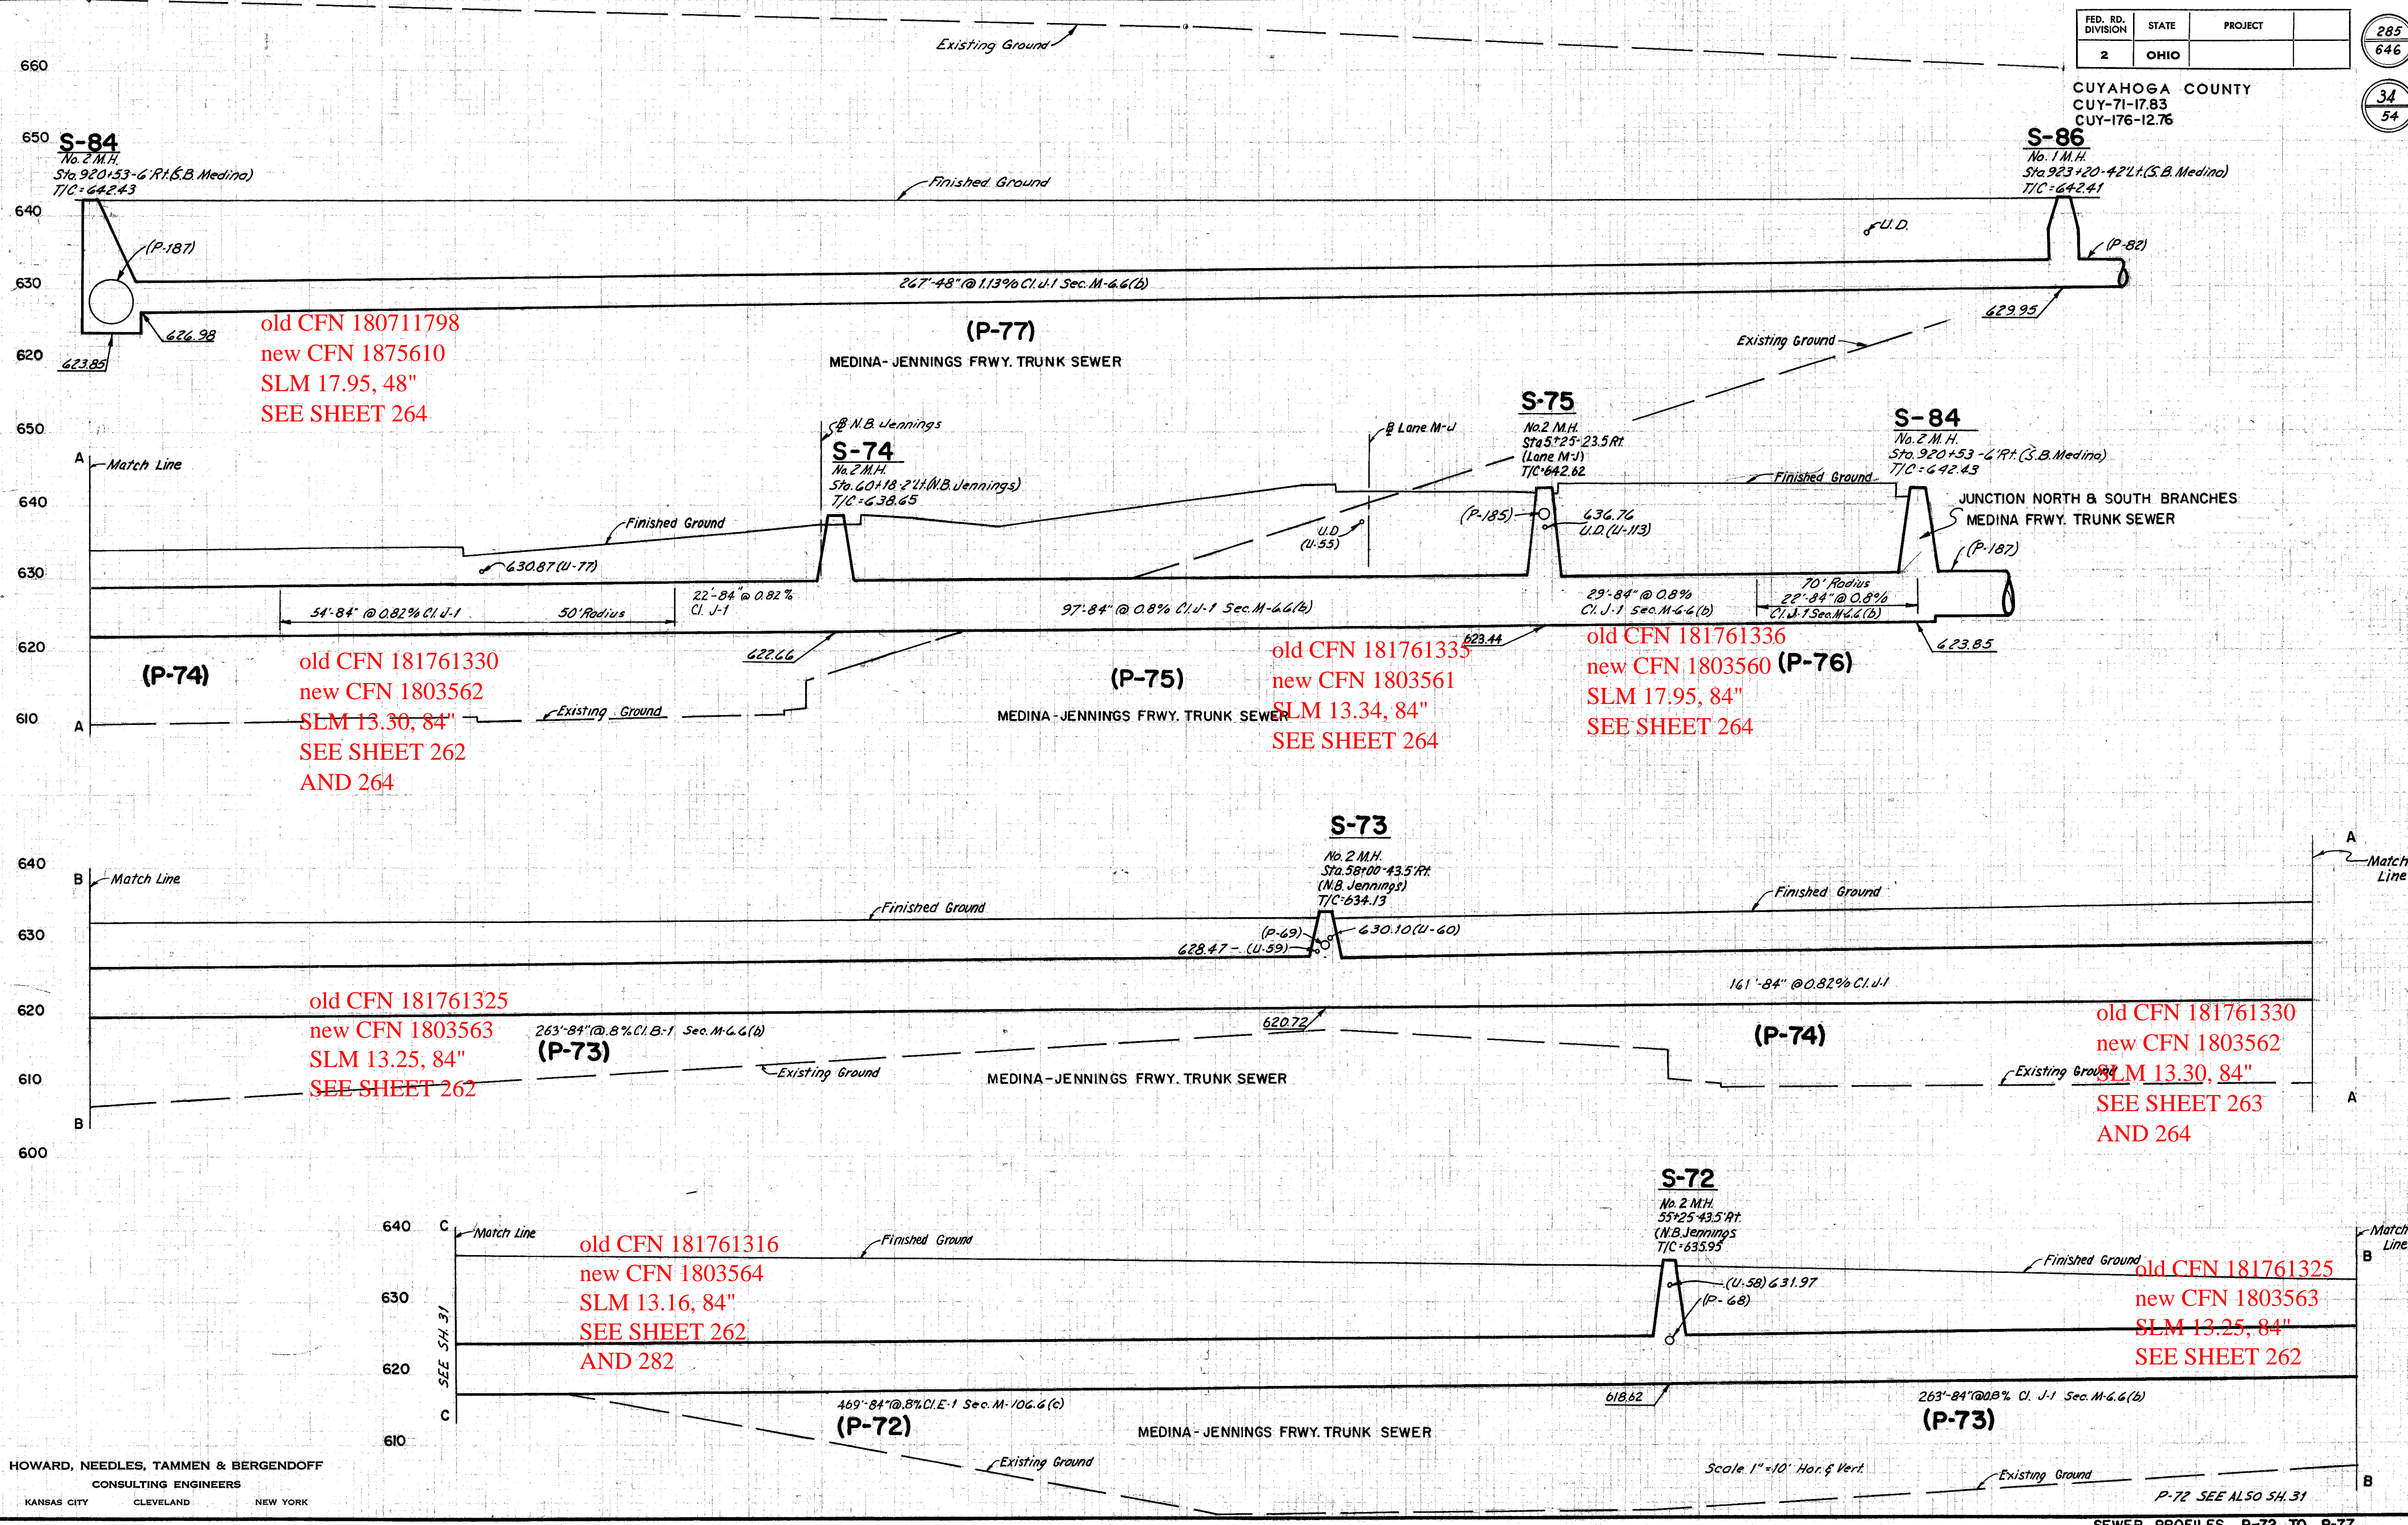

old CFN 180711798  
new CFN 1875610  
SLM 17.95, 48"  
SEE SHEET 264

old CFN 181761330  
new CFN 1803562  
SLM 13.30, 84"  
SEE SHEET 262  
AND 264

old CFN 181761335  
new CFN 1803561  
SLM 13.34, 84"  
SEE SHEET 264

old CFN 181761336  
new CFN 1803560 (P-76)  
SLM 17.95, 84"  
SEE SHEET 264

old CFN 181761325  
new CFN 1803563  
SLM 13.25, 84"  
SEE SHEET 262

old CFN 181761330  
new CFN 1803562  
SLM 13.30, 84"  
SEE SHEET 263  
AND 264

old CFN 181761316  
new CFN 1803564  
SLM 13.16, 84"  
SEE SHEET 262  
AND 282

old CFN 181761325  
new CFN 1803563  
SLM 13.25, 84"  
SEE SHEET 262

HOWARD, NEEDLES, TAMMEN & BERGENDOFF  
CONSULTING ENGINEERS  
KANSAS CITY CLEVELAND NEW YORK

Scale 1" = 10' Hor. & Vert.

P-72 SEE ALSO SH. 31

SEWER PROFILES P-72 TO P-77

R.O.J. 10-9-68  
L.M.O. 10-14-68