


FED. RD. DIVISION	STATE	PROJECT	
2	OHIO		

110
347

CUYAHOGA COUNTY
CUY. 77-6.45

END	EARTHWORK		VOLUME	
	EXC.	EMB.	EXC.	EMB.
840	2553	0		
830			9517	0
840	2586	0		
830			9433	0
840	2508	0		
830			9391	0
840	2563	0		
830			9452	7
Sta 406+00	2541	4		

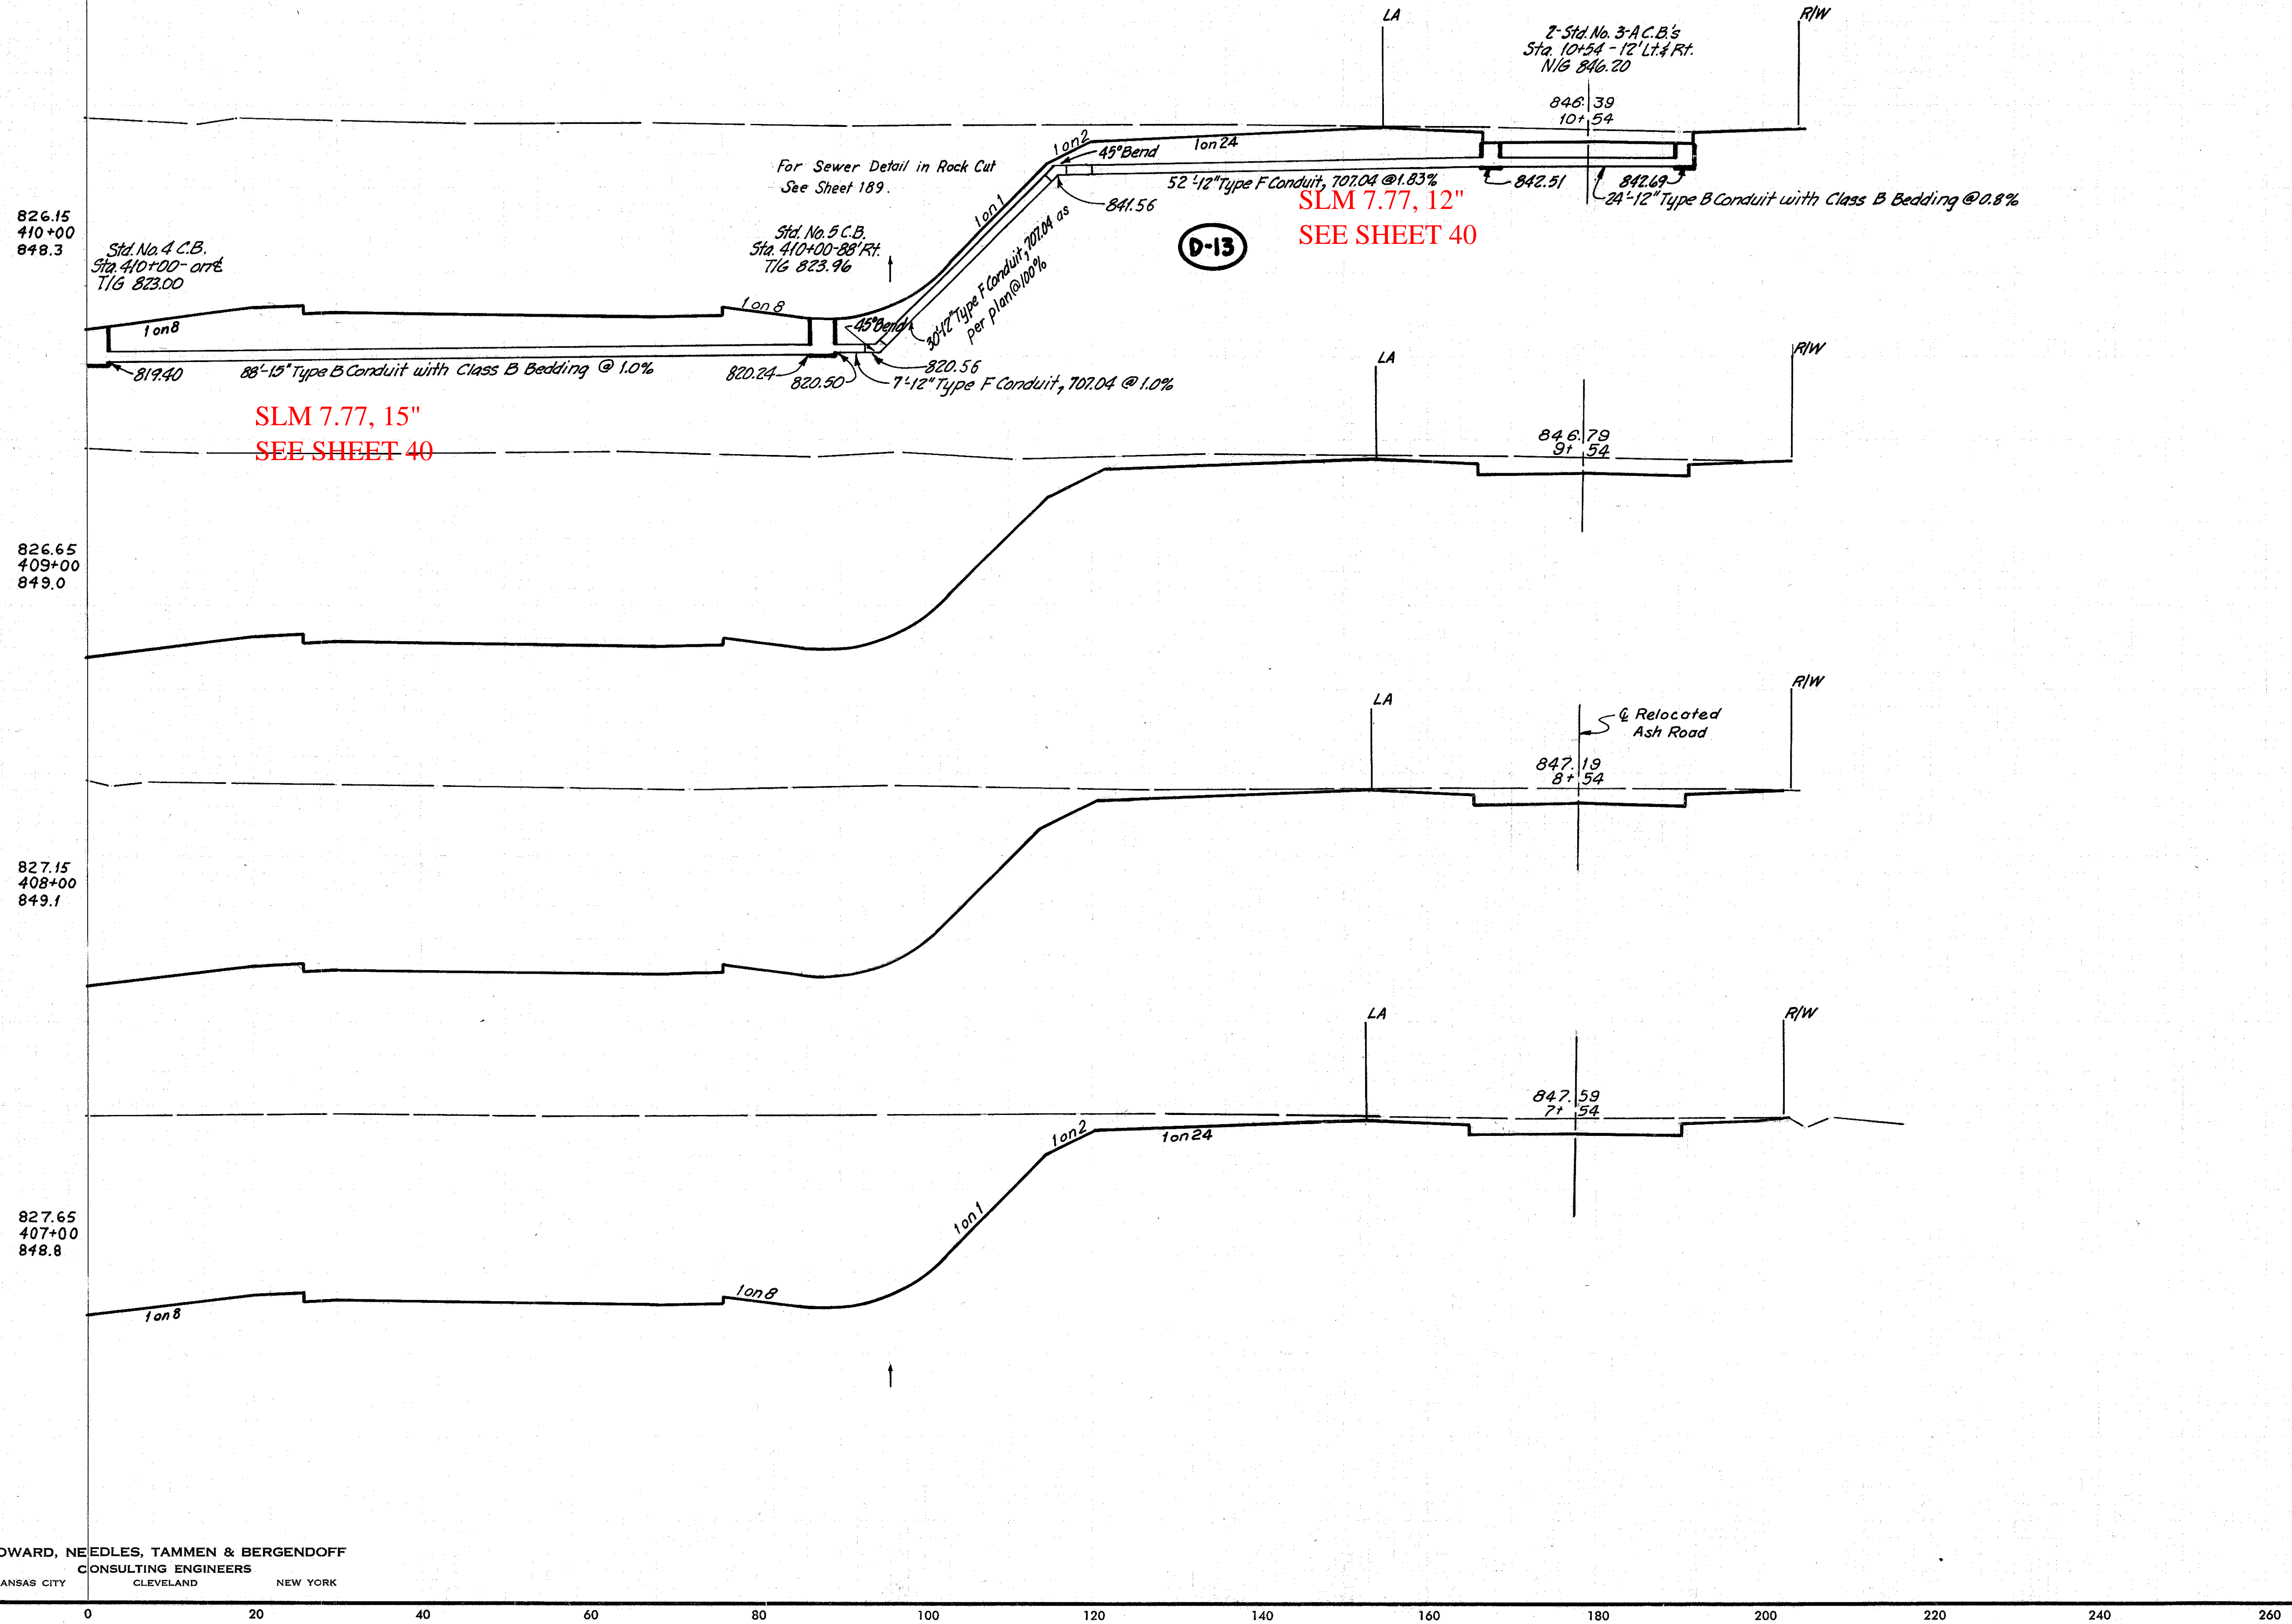

SLM 7.77, 15"
SEE SHEET 40

SLM 7.77, 12"
SEE SHEET 40

D-13

D.A.G. 6-8-66 J.B.C.H. 7-11-66
 B.C.H. 6-29-66 V.P.P.P. 9-19-66
 W.H.S. 4-18-67

HOWARD, NEEDLES, TAMMEN & BERGENDOFF
CONSULTING ENGINEERS
KANSAS CITY CLEVELAND NEW YORK

0 20 40 60 80 100 120 140 160 180 200 220 240 260

RIGHT HALF
STA. 407+00 TO STA. 410+00