


SEE 1967 CUY-77-4.07 PLANS
FOR THE ORIGINAL CONSTRUCTION
OF CULVERTS AND STORM SEWERS

BM 44 - CENTER LINE MONUMENT RECORD LOCATION
HILLSIDE ROAD, @ WEST ELEV.-918.27
BM 31 - CENTER LINE MONUMENT RECORD LOCATION
STA. 345+00, @ ELEV.-922.33

SEE 1977 CUY-77-6.35 PLANS
FOR THE ORIGINAL CONSTRUCTION
OF CULVERTS AND STORM SEWERS

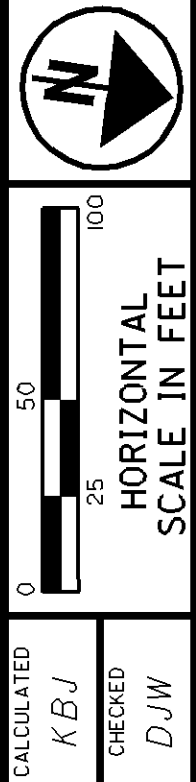

PLAN
STA. 337+50.00 TO STA. 347+50.00

CUY-77-1.89

331
1386

SLM 6.41, 15"
SEE SHEET 332

SLM 6.41, 15"
SEE SHEET 445

old CFN 180770641
new CFN 1877747
SLM 6.41, 54"
SEE SHEET 445

SLM 6.45, 15"
SEE SHEET 446

SLM 6.45, 15"
SEE SHEET 446

SLM 6.45, 15"
SEE SHEET 446

SLM 6.49, 15"
SEE SHEET 447


SLM 6.51, 15"
SEE SHEET 448

old CFN 180770655
new CFN 1862356
SLM 6.55, 42"

SLM 6.60, 15"
SEE SHEET 332

SLM 6.49, 15"
SEE SHEET 447

HILLSIDE RD.
SLM 6.45 = MM 153.58

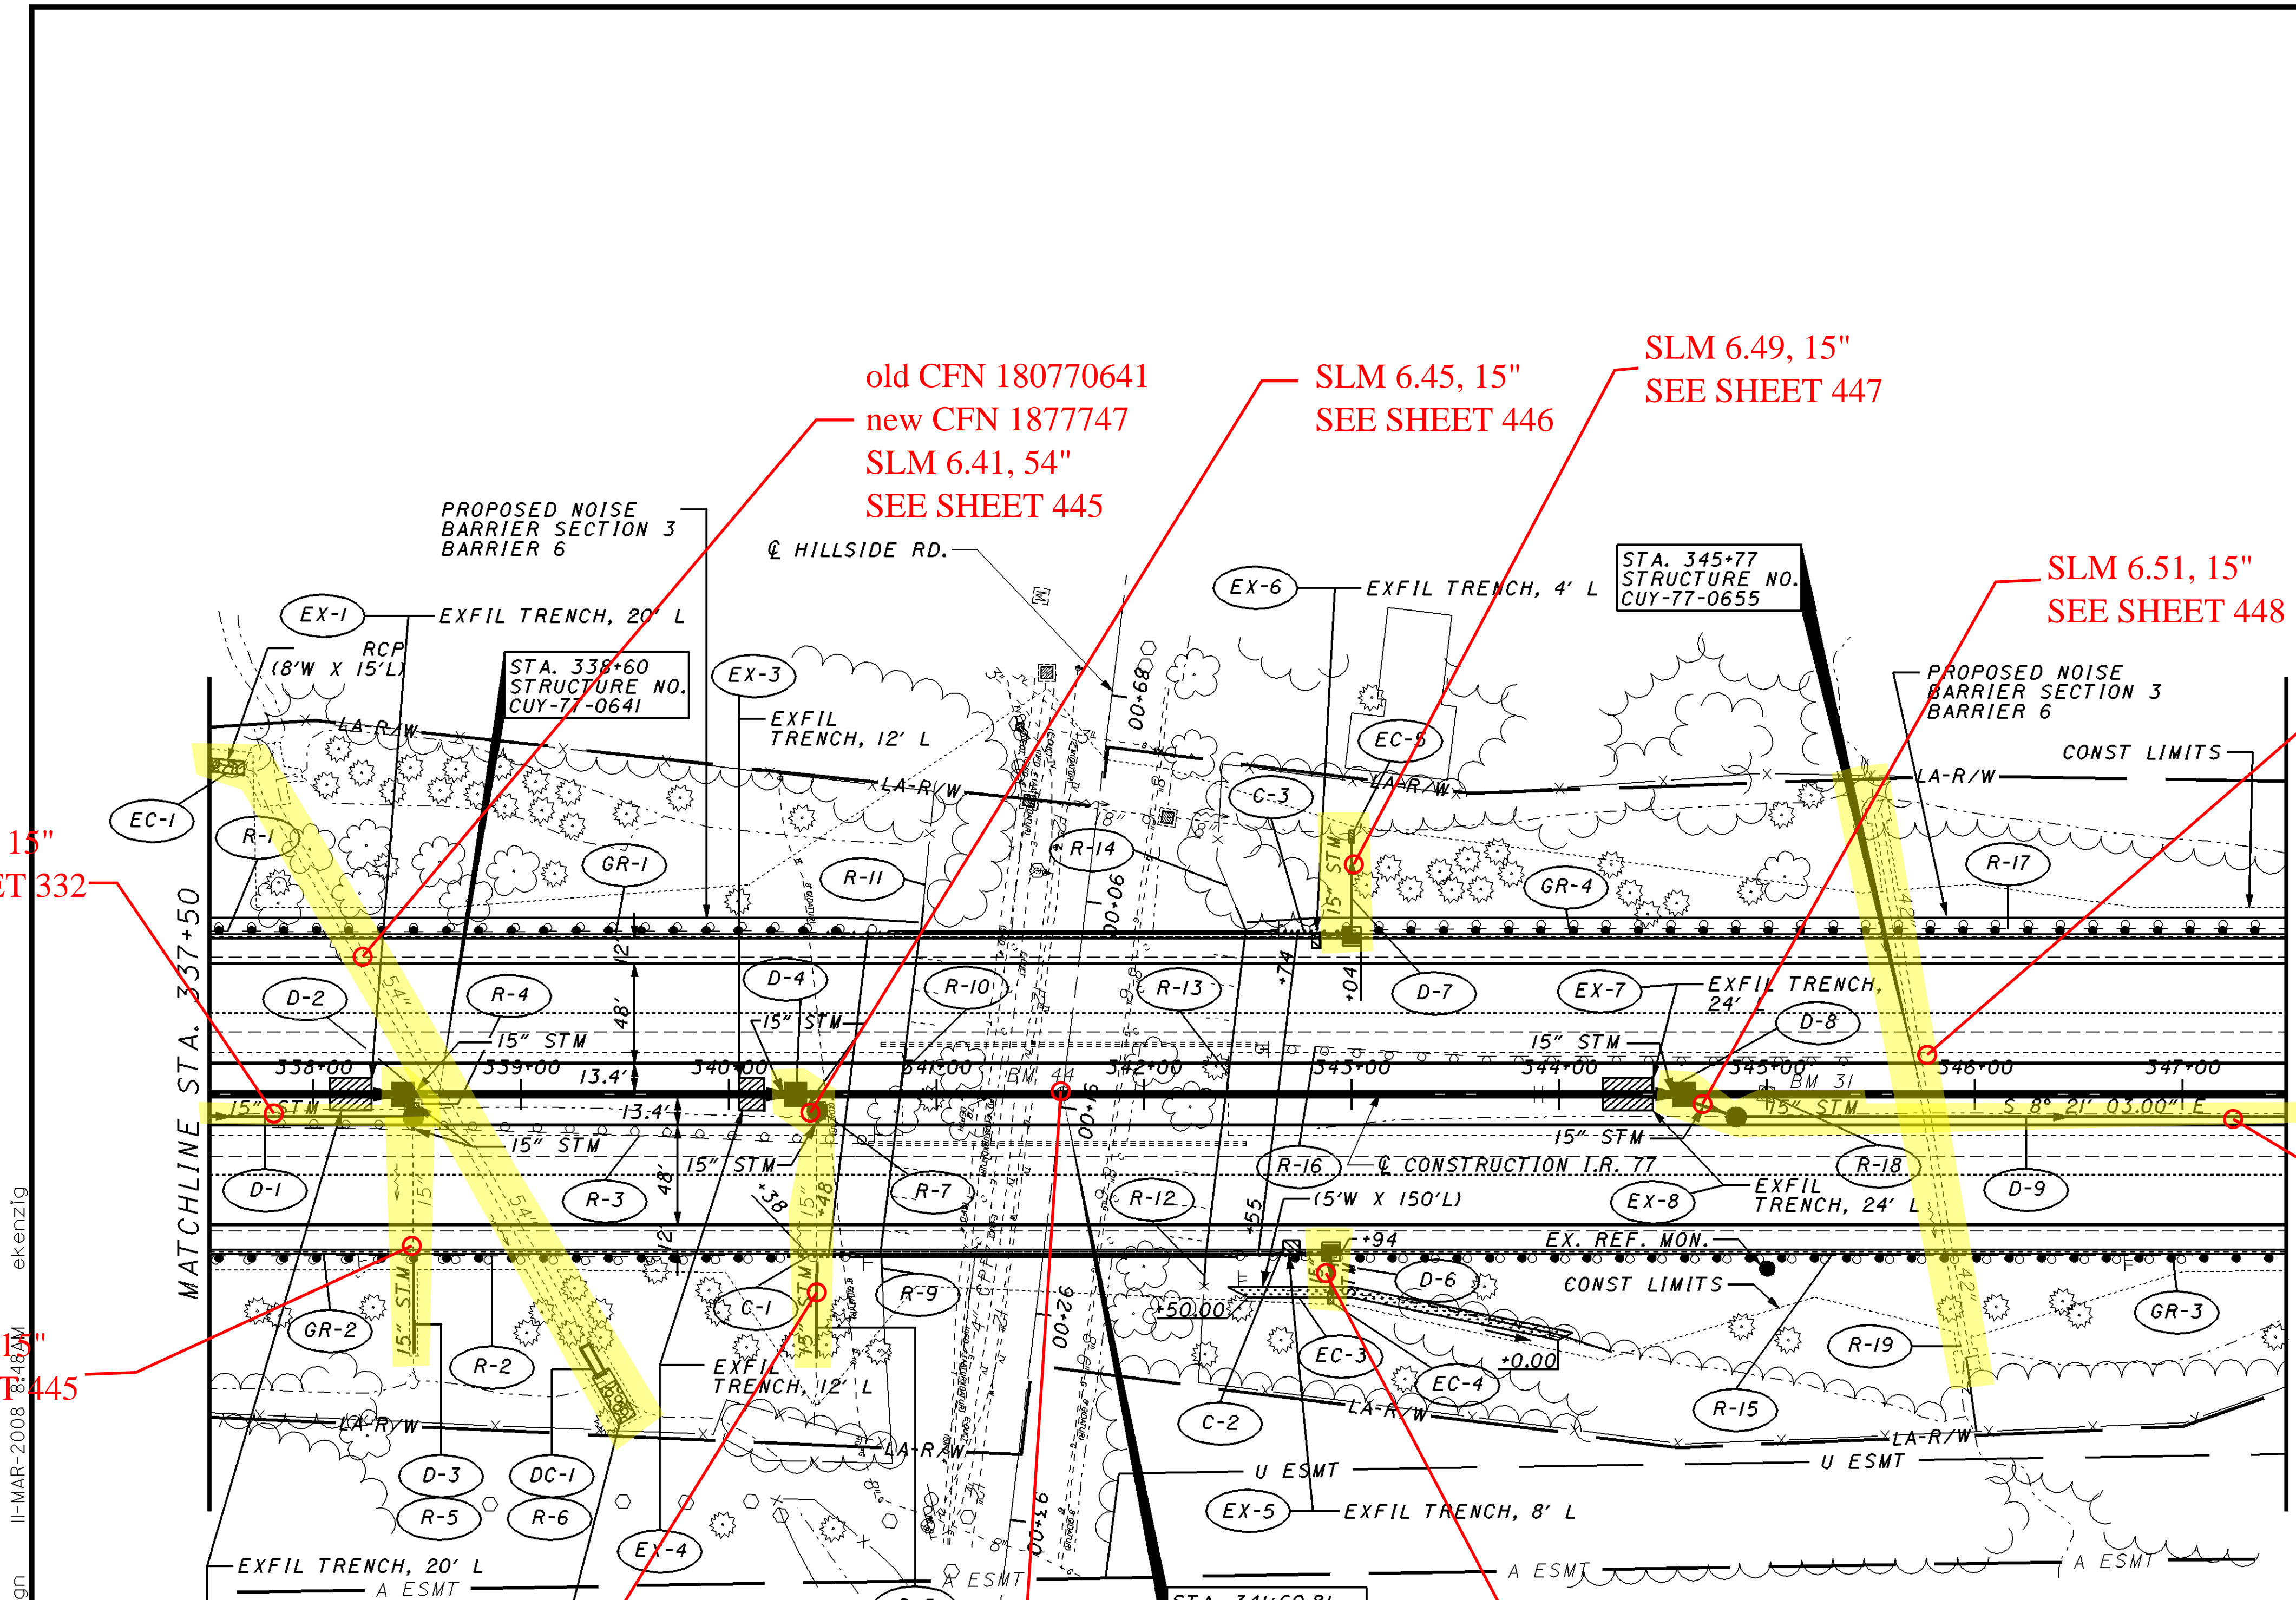

FOR REFERENCE TIES SEE SHEET 7
FOR GEOMETRIC LAYOUT SEE SHEETS 8 TO 13
FOR TYPICAL SECTIONS SEE SHEETS 14 TO 30
FOR CROSS SECTIONS SEE SHEETS 349 TO 489
FOR UNDERDRAIN PLAN SEE SHEETS 643 TO 658
FOR CALCULATIONS AND QUANTITIES SEE SHEETS 223 TO 285
FOR MAINTENANCE OF TRAFFIC PLANS SEE SHEETS 43 TO 217
FOR SIGNING AND PAVEMENT MARKING PLANS SEE SHEETS 735 TO 768
FOR NOISE BARRIER PLANS SEE SHEETS 985 TO 1010
FOR LIGHTING PLANS SEE SHEETS 885 TO 912
FOR RETAINING WALL PLANS SEE SHEETS 1015 TO 1034
FOR PROFILE SEE SHEET 332
FOR STRUCTURE PLANS SEE SHEETS 1259 TO 1298

LEGEND

	ROCK CHANNEL PROTECTION
	DITCH EROSION PROTECTION

I:\PROJECTS\PI\22222\dgn\TSC_2008-03-10\22222-0331.dgn 11-MAR-2008 8:48 AM ekenzig