


SANDUSKY-CLEVELAND EASTERN RD.
 CLEVELAND (PT.)
 S.H. NO. 3 SECTION & BRATEN AHL (PT.)
 CUYAHOGA COUNTY

STATION 124+30 DRAINAGE STRUCTURE 5-C OF SHEET NO. 11

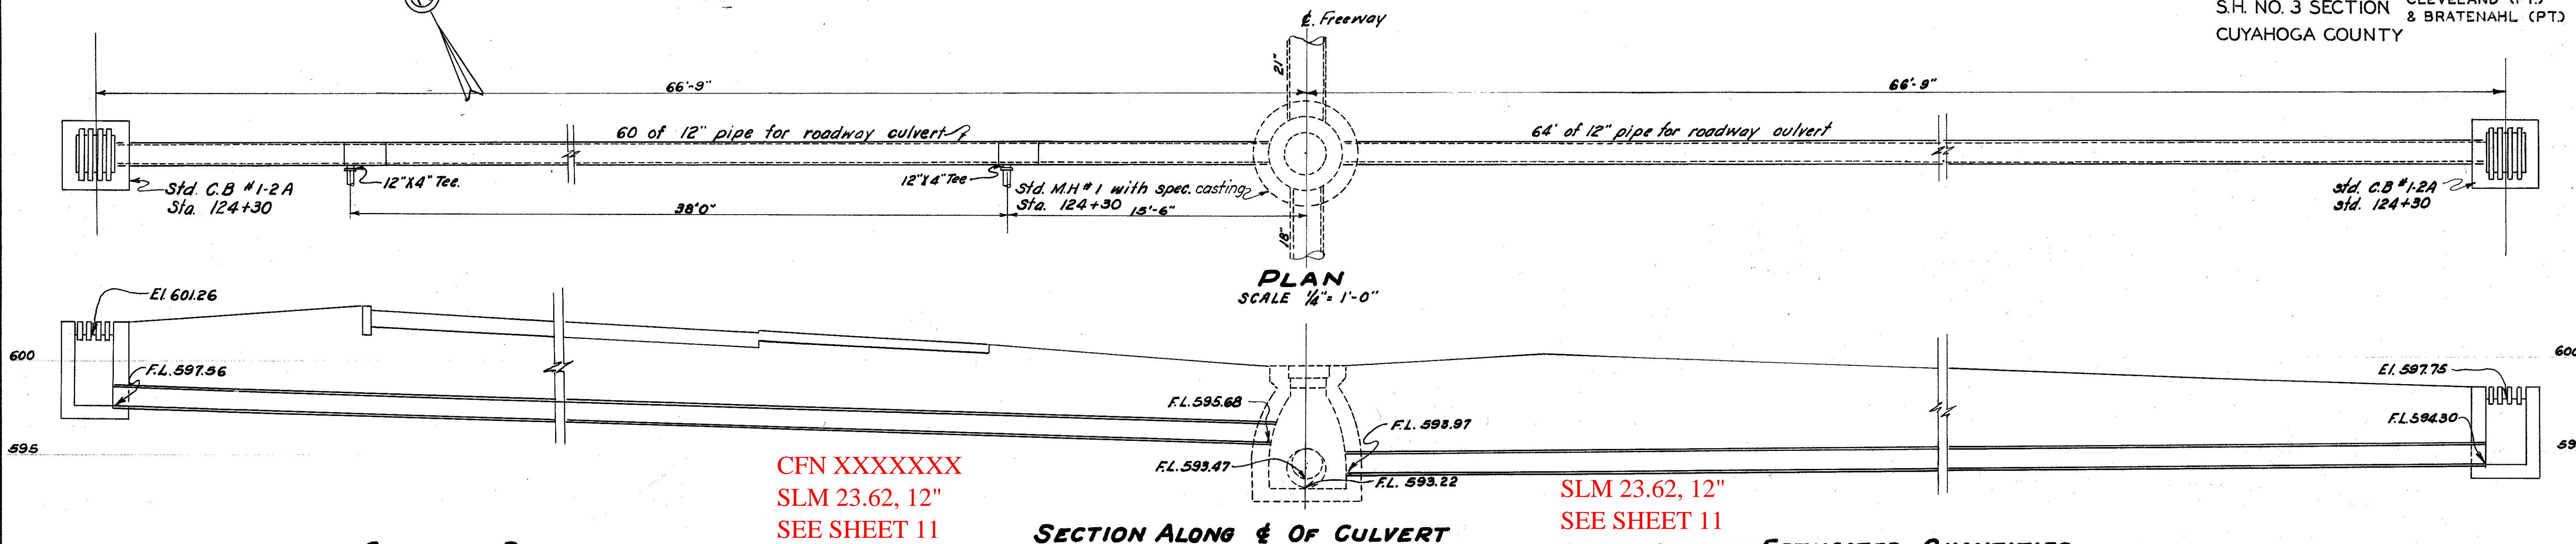

CFN XXXXXXXX
 SLM 23.62, 12"
 SEE SHEET 11


SLM 23.62, 12"
 SEE SHEET 11

ABANDONED IN ESTIMATED QUANTITIES

Excavation	42 Cu. Yds.
12" pipe for roadway culvert	124 Lin. Ft.
Standard catch basin #1-2A	2 Complete
12" X 4" Tee	2 Complete

CULVERT DATA.
 Type: Pipe Culvert Std. Drwg. S-27-PC.3
 Size: 12" X 124'-0"
 Work Req'd: Build std. C.B.#1-2A on left and right side and connect to std. M.H.#1 on & with 60' and 64' of 12" pipe for roadway culvert. Place 12" X 4" Tees as shown.

STATION 126+50 DRAINAGE STRUCTURE 6-C OF SHEET NO. 11

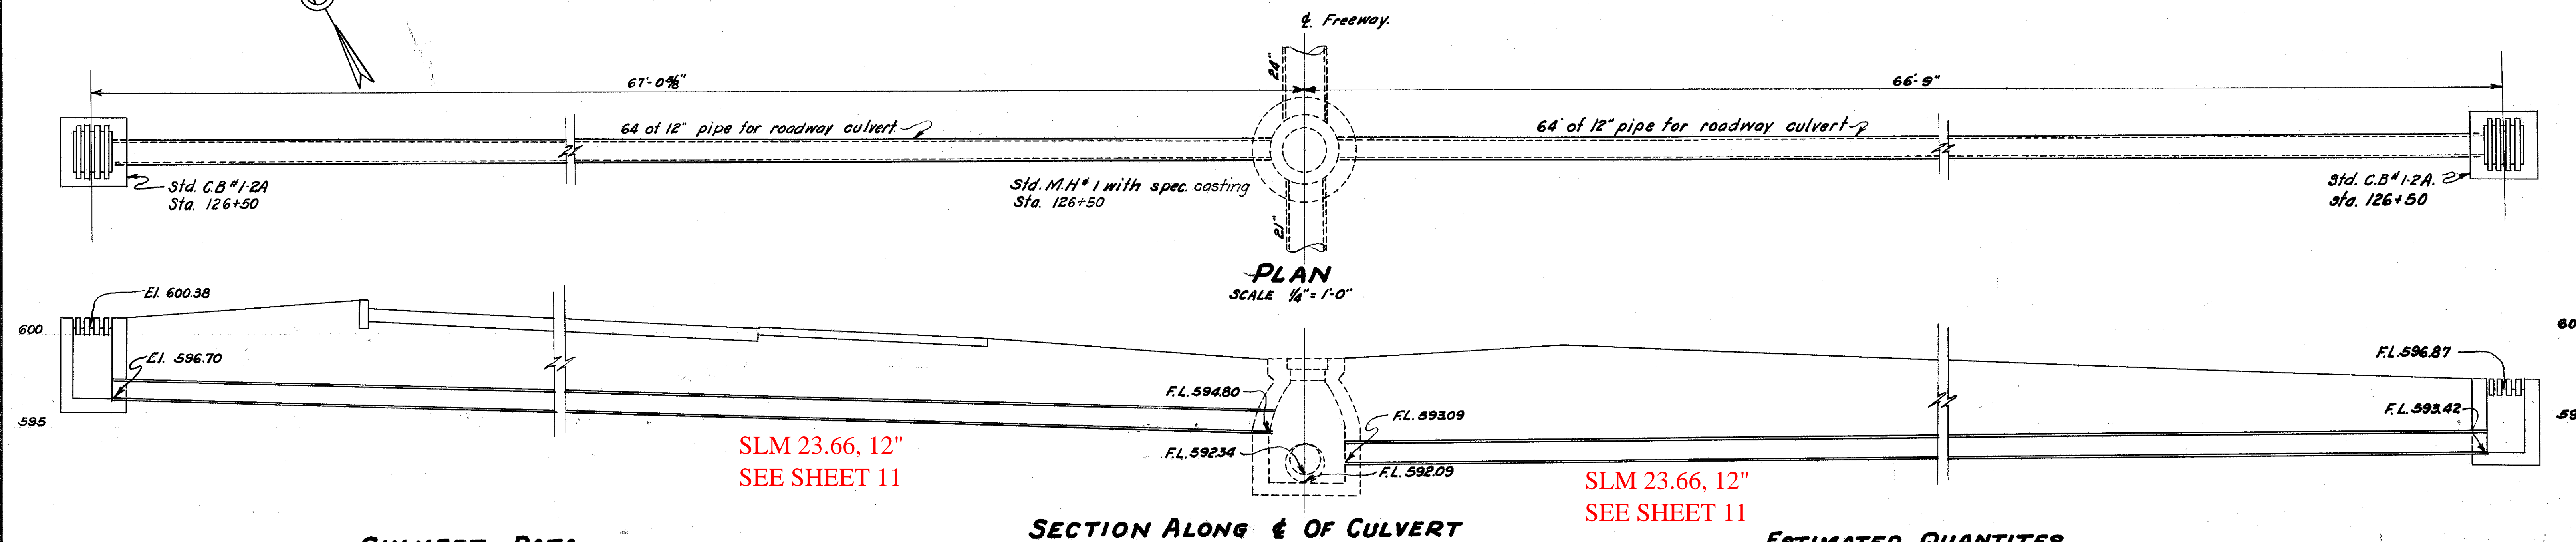

SLM 23.66, 12"
 SEE SHEET 11

SLM 23.66, 12"
 SEE SHEET 11

ESTIMATED QUANTITIES

Excavation	42 Cu. Yds.
12" pipe for roadway culvert	128 Lin. Ft.
Standard catch basin #1-2A	2 Complete

CULVERT DATA
 Type: Pipe Culvert Std. Drwg. S-27-PC.3
 Size: 12 X 128'0"
 Work Req'd: Build std. C.B.#1-2A on left and right side and connect to std. M.H.#1 on & with 64' of 12" pipe for roadway culvert.