

Curve 2 Data:
 P.I. Sta = 108+56.02
 Delta = 19°55' 22.33" (LT)
 Degree = 1°28'00.00"
 T = 686.12
 L = 1,358.38
 R = 3,906.53
 E = 59.79
 LC = 1,351.54
 PC Sta = 101+69.90
 PT Sta = 115+28.28



FOR MEDIAN GRADING DETAIL, SEE SHEET 341.
 SEE SHEETS 547 TO 581 FOR NOISE BARRIER PROFILES

BENCHMARK: IRON PIN IN MONUMENT BOX
 STA. 51+56± @ CAHOON RD.
 ELEV.= 684.92
 BENCHMARK: IRON PIN IN MONUMENT BOX
 STA. 47+00± @ CAHOON RD.
 ELEV.= 678.12

CFN XXXXXXXX
 SLM XX, 21"
 SEE SHEET 252
 INV. 3/6/2017
 NEEDS INS

STRUCTURE NO.
 CUY-90-0124
 CFN XXXXXXXX
 SLM XX, 21"
 SEE SHEET 153
 AND 257
 INV. 3/6/2017
 NEEDS INS

SITE 8
 BEGIN NOISE BARRIER
 N.B. STA 10+00 =
 @ I-90
 STA 106+70, 80.70' LT.

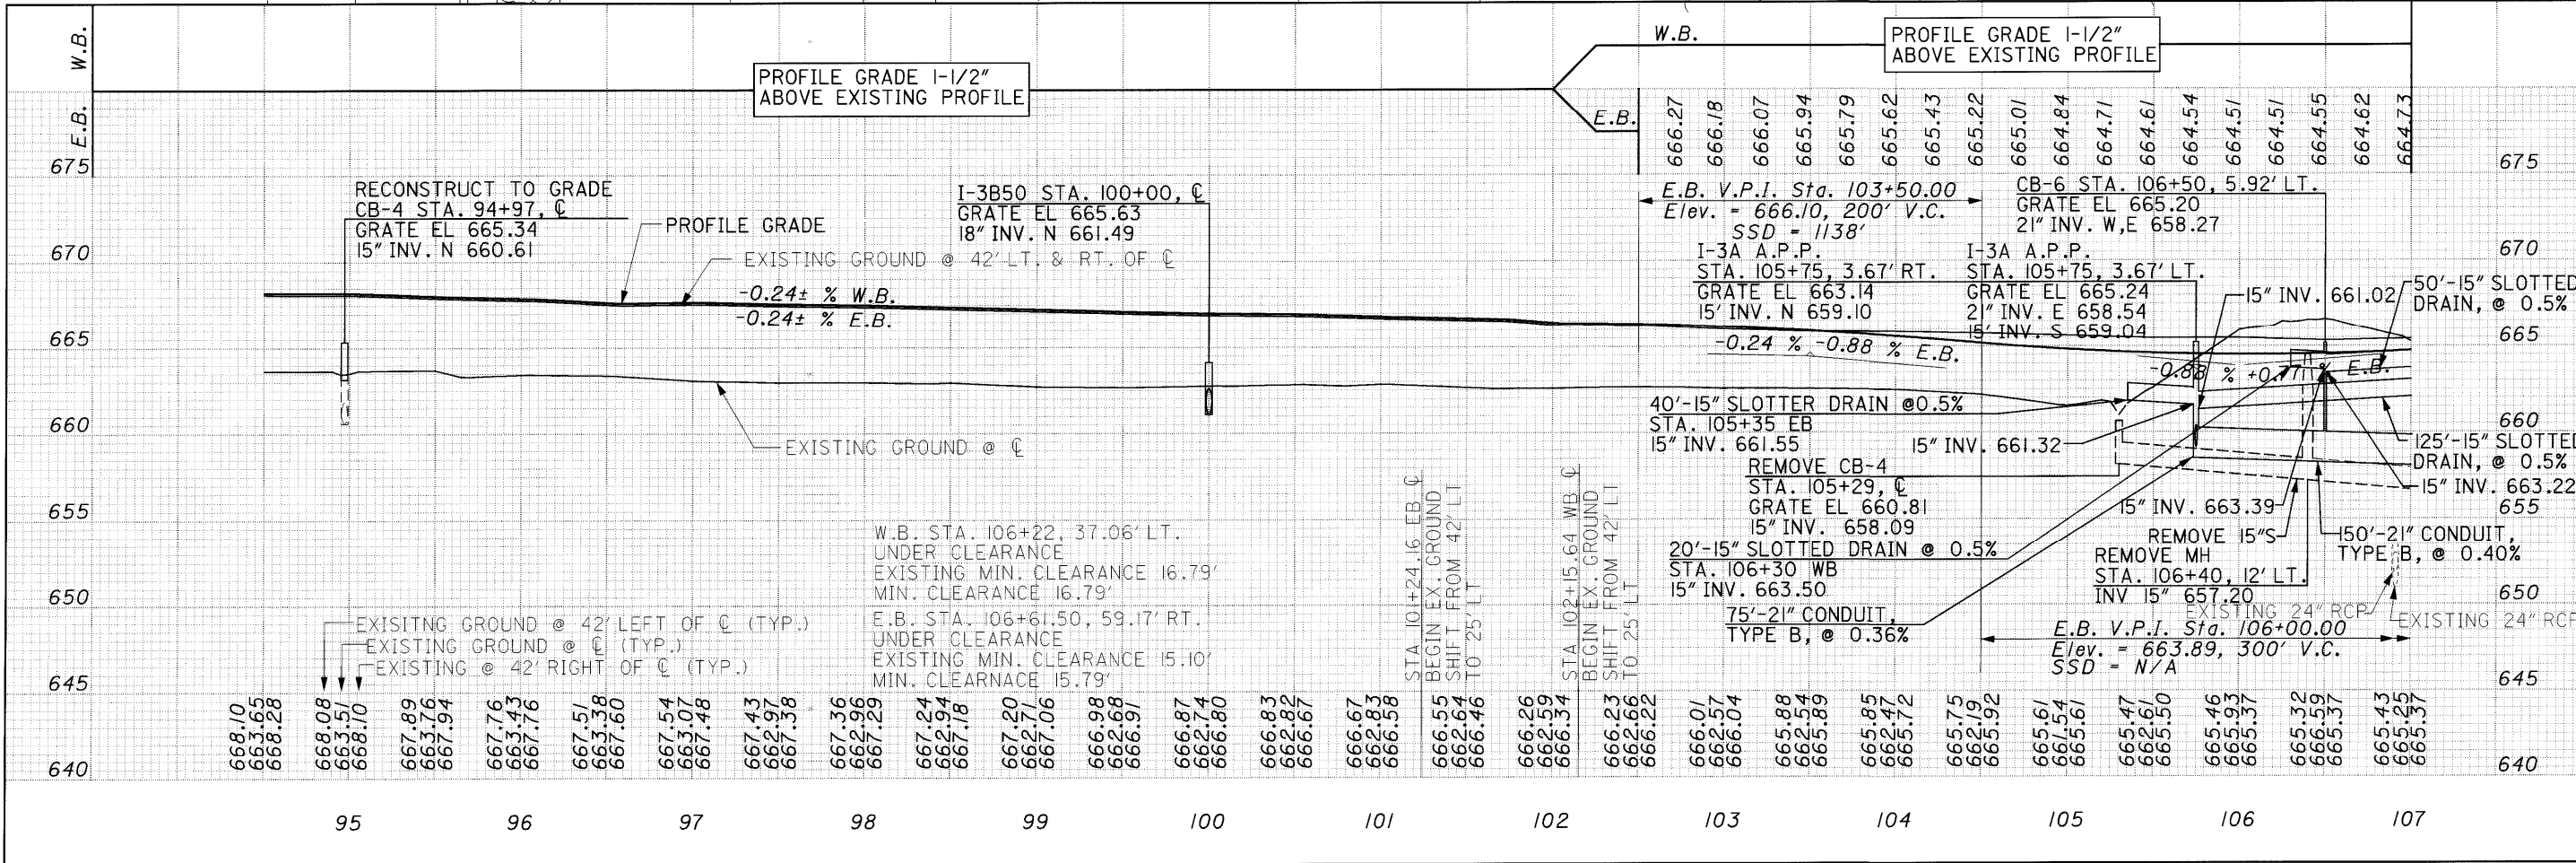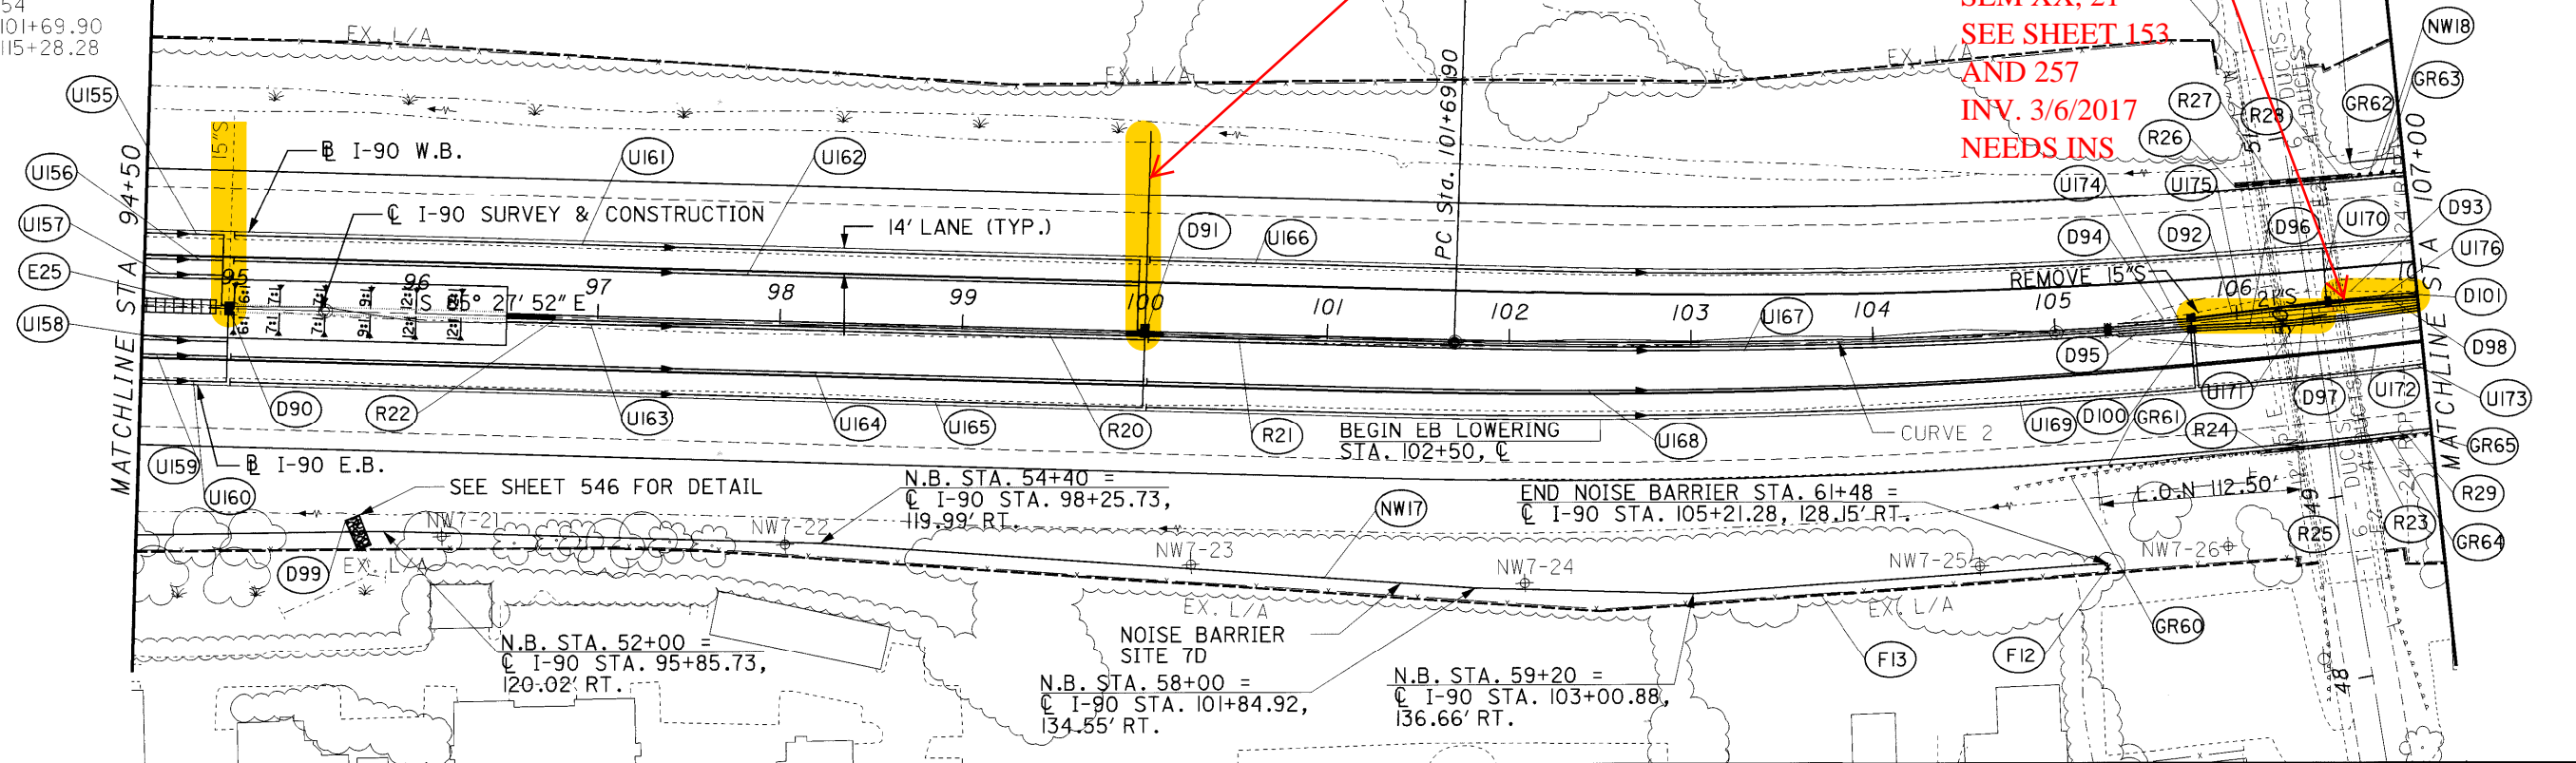

PLAN AND PROFILE
 STA 94+50 TO STA 107+00
 CUY-90-0.00
 150
 582