


FOR MEDIAN BARRIER DETAIL
UNDER BRIDGE SEE SHEET 347
SEE SHEET 354B FOR
SLOTTED DRAIN DETAILS.

CFN XXXXXXXX
SLM 3.54, 18"
MM 159.35
SEE SHEET 301
AND 334
INV. 3/7/2017
NEEDS INS

CFN XXXXXXXX
SLM XX, 18"
SEE SHEET 169
INV. 3/7/2017
NEEDS INS

CFN XXXXXXXX
SLM XX, 21"
SEE SHEET 169
AND 307
INV. 3/7/2017
NEEDS INS

CFN XXXXXXXX
SLM XX, 21"
SEE SHEET 169
AND 307
INV. 3/7/2017
NEEDS INS

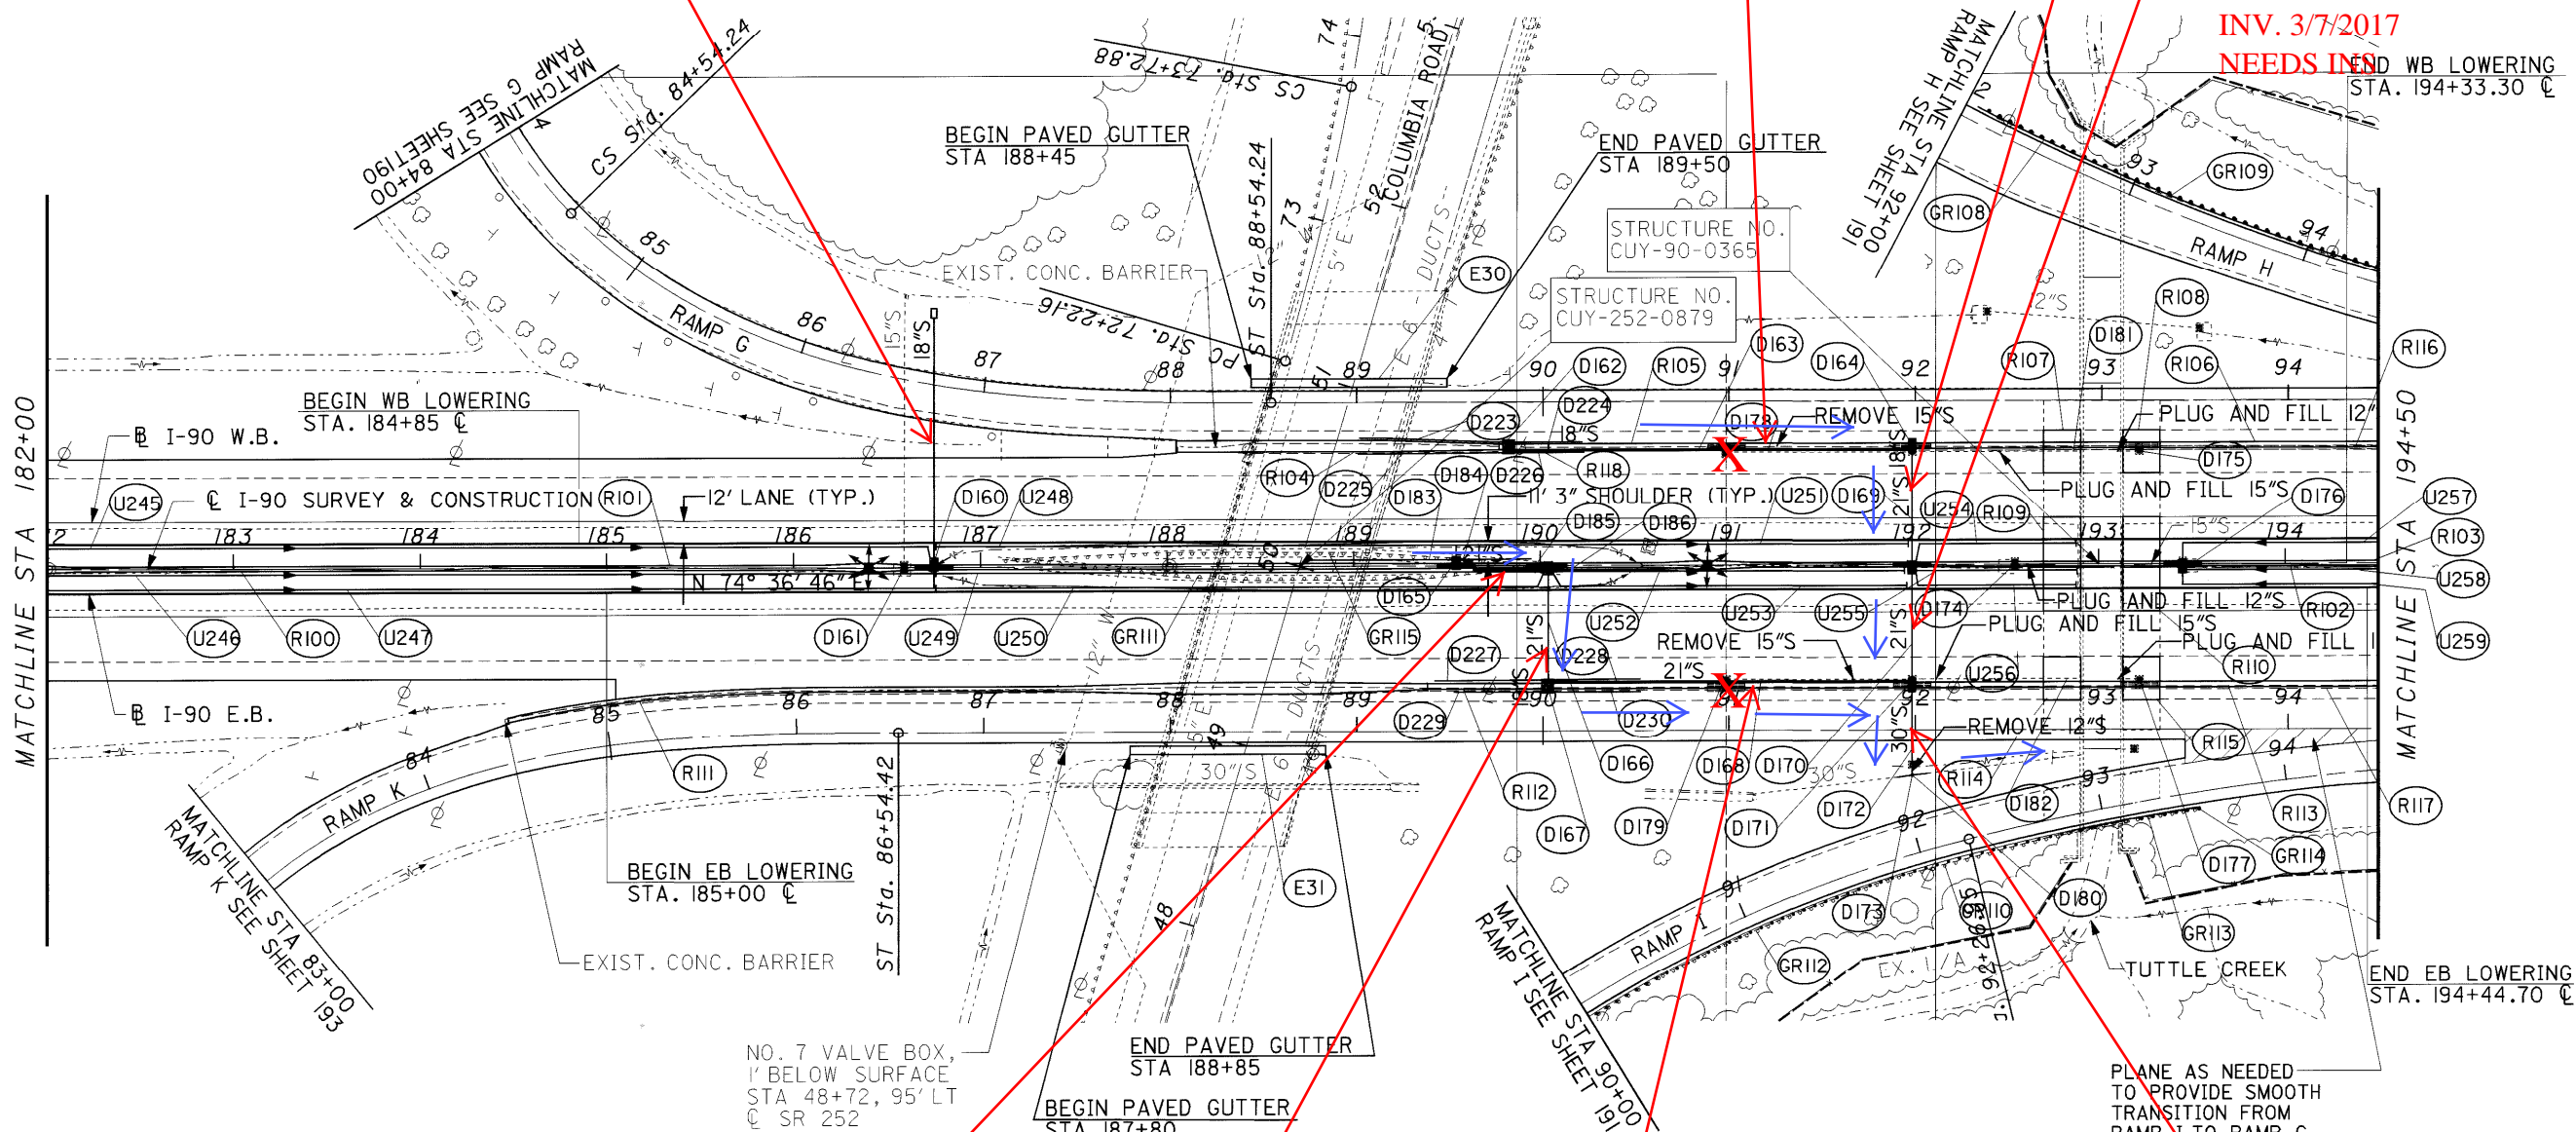


CFN XXXXXXXX
SLM XX, 21"
SEE SHEET 169
(MED INLET TO
MED INLET)
INV. 3/7/2017
NEEDS INS.

CFN XXXXXXXX
SLM XX, 21"
SEE SHEET 169
AND 305
INV. 3/7/2017
NEEDS INV.

CFN XXXXXXXX
SLM XX, 21"
SEE SHEET 169
INV. 3/7/2017
NEEDS INS

CFN XXXXXXXX
SLM XX, 30"
SEE SHEET 169
AND 307
INV. 3/7/2017
NEEDS INS

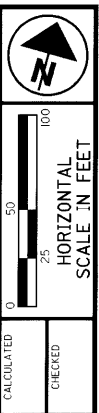

PLAN AND PROFILE
STA 182+00 TO STA 194+50

CUY-90-0.00

I:\PROJECTS\1738\1738.dgn\final\plans\1738GP0.DGN 09-AUG-2000 3:35PM jgrmovse