

CALCULATED
CHECKED

PLAN AND PROFILE
STA 194+50 TO STA 207+00

CUY-90-0.00

174
582



old CFN 180900373
new CFN 1877362
SLM 3.73, 36"
MM 159.54

CFN XXXXXXXX
SLM, XX, 18"
SEE SHEET 311
INV. 3/8/2017
NEEDS INS

old CFN 180900377
new CFN 1877363
SLM 3.77, 45"x29"
HEL, MM 159.58

old CFN 180900386
new CFN 1833034
SLM 3.86, 54"
MM 159.67

CFN XXXXXXXX
SLM XX, 18"
SEE SHEET 311
INV. 3/8/2017
NEEDS INS

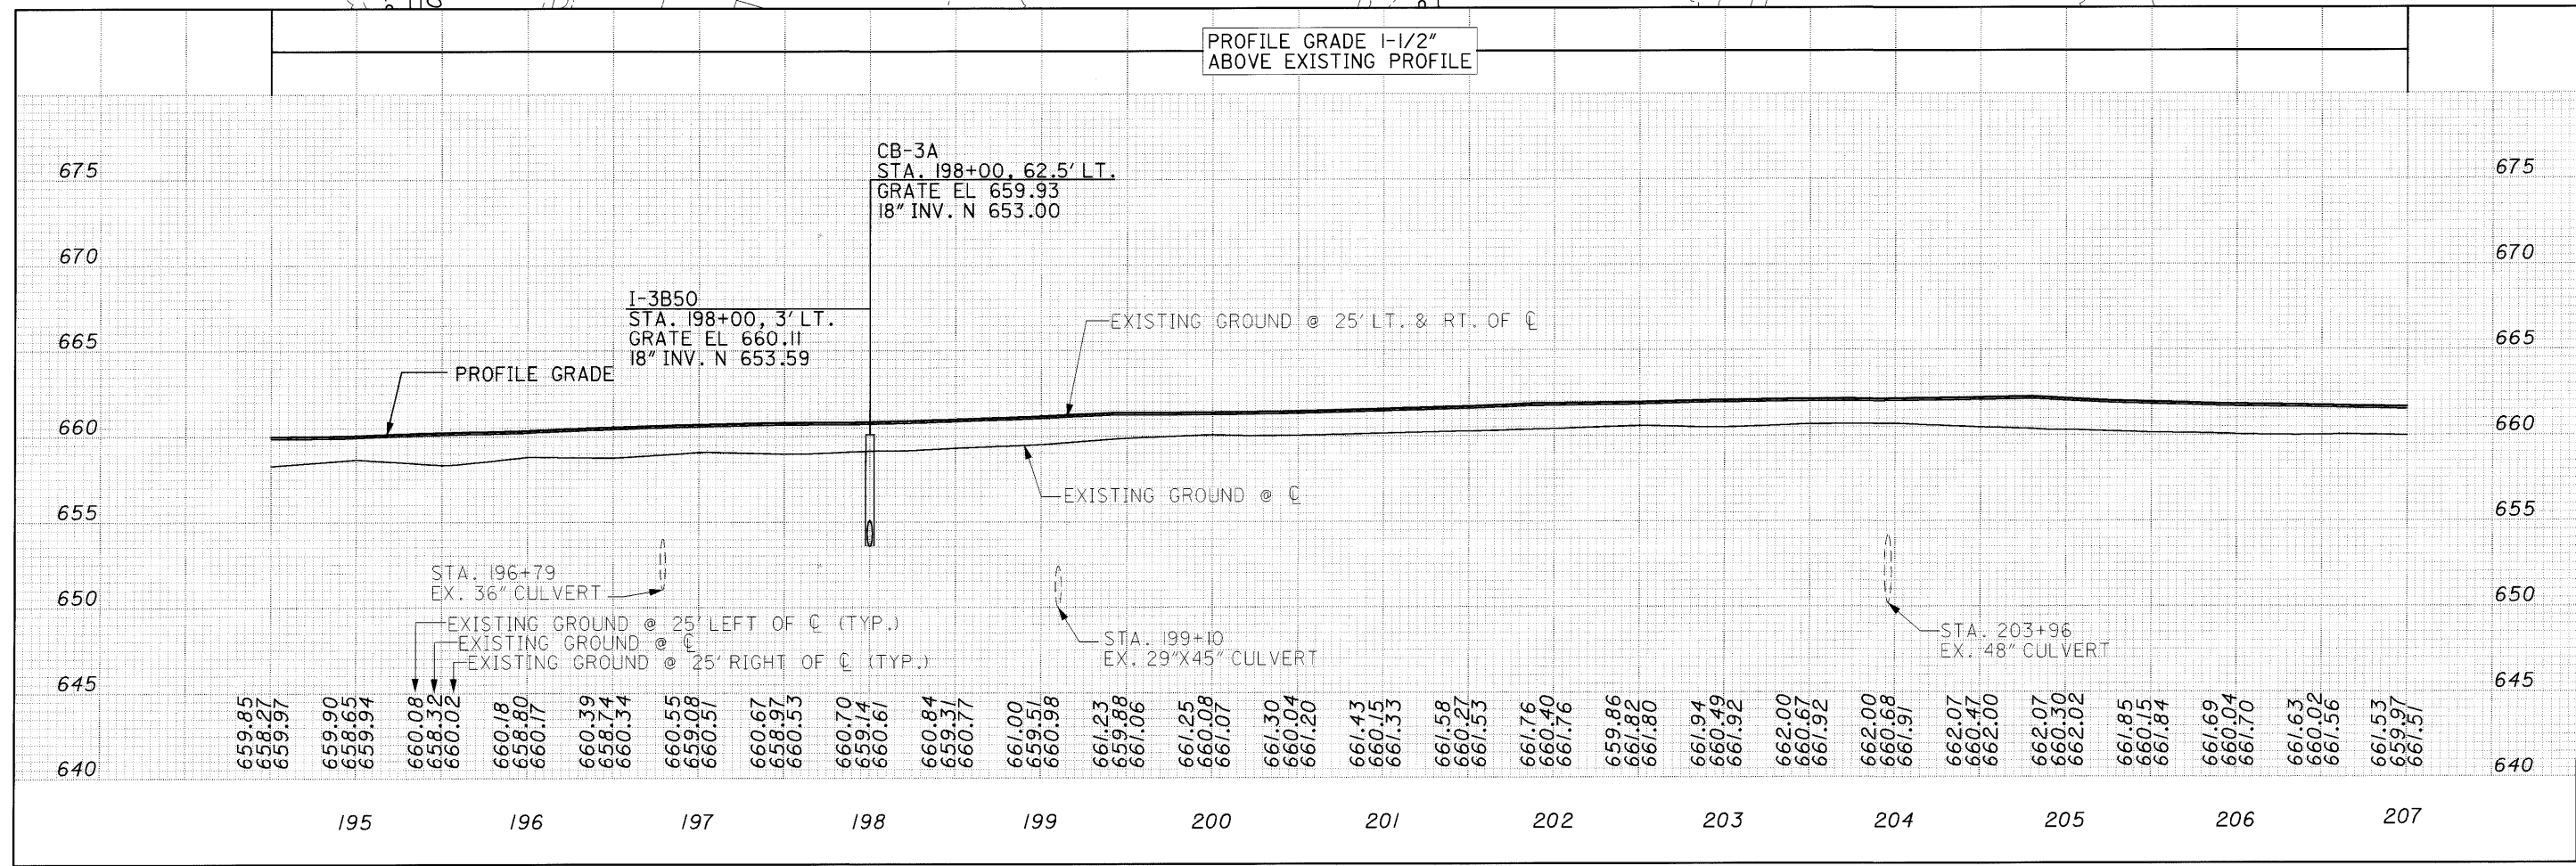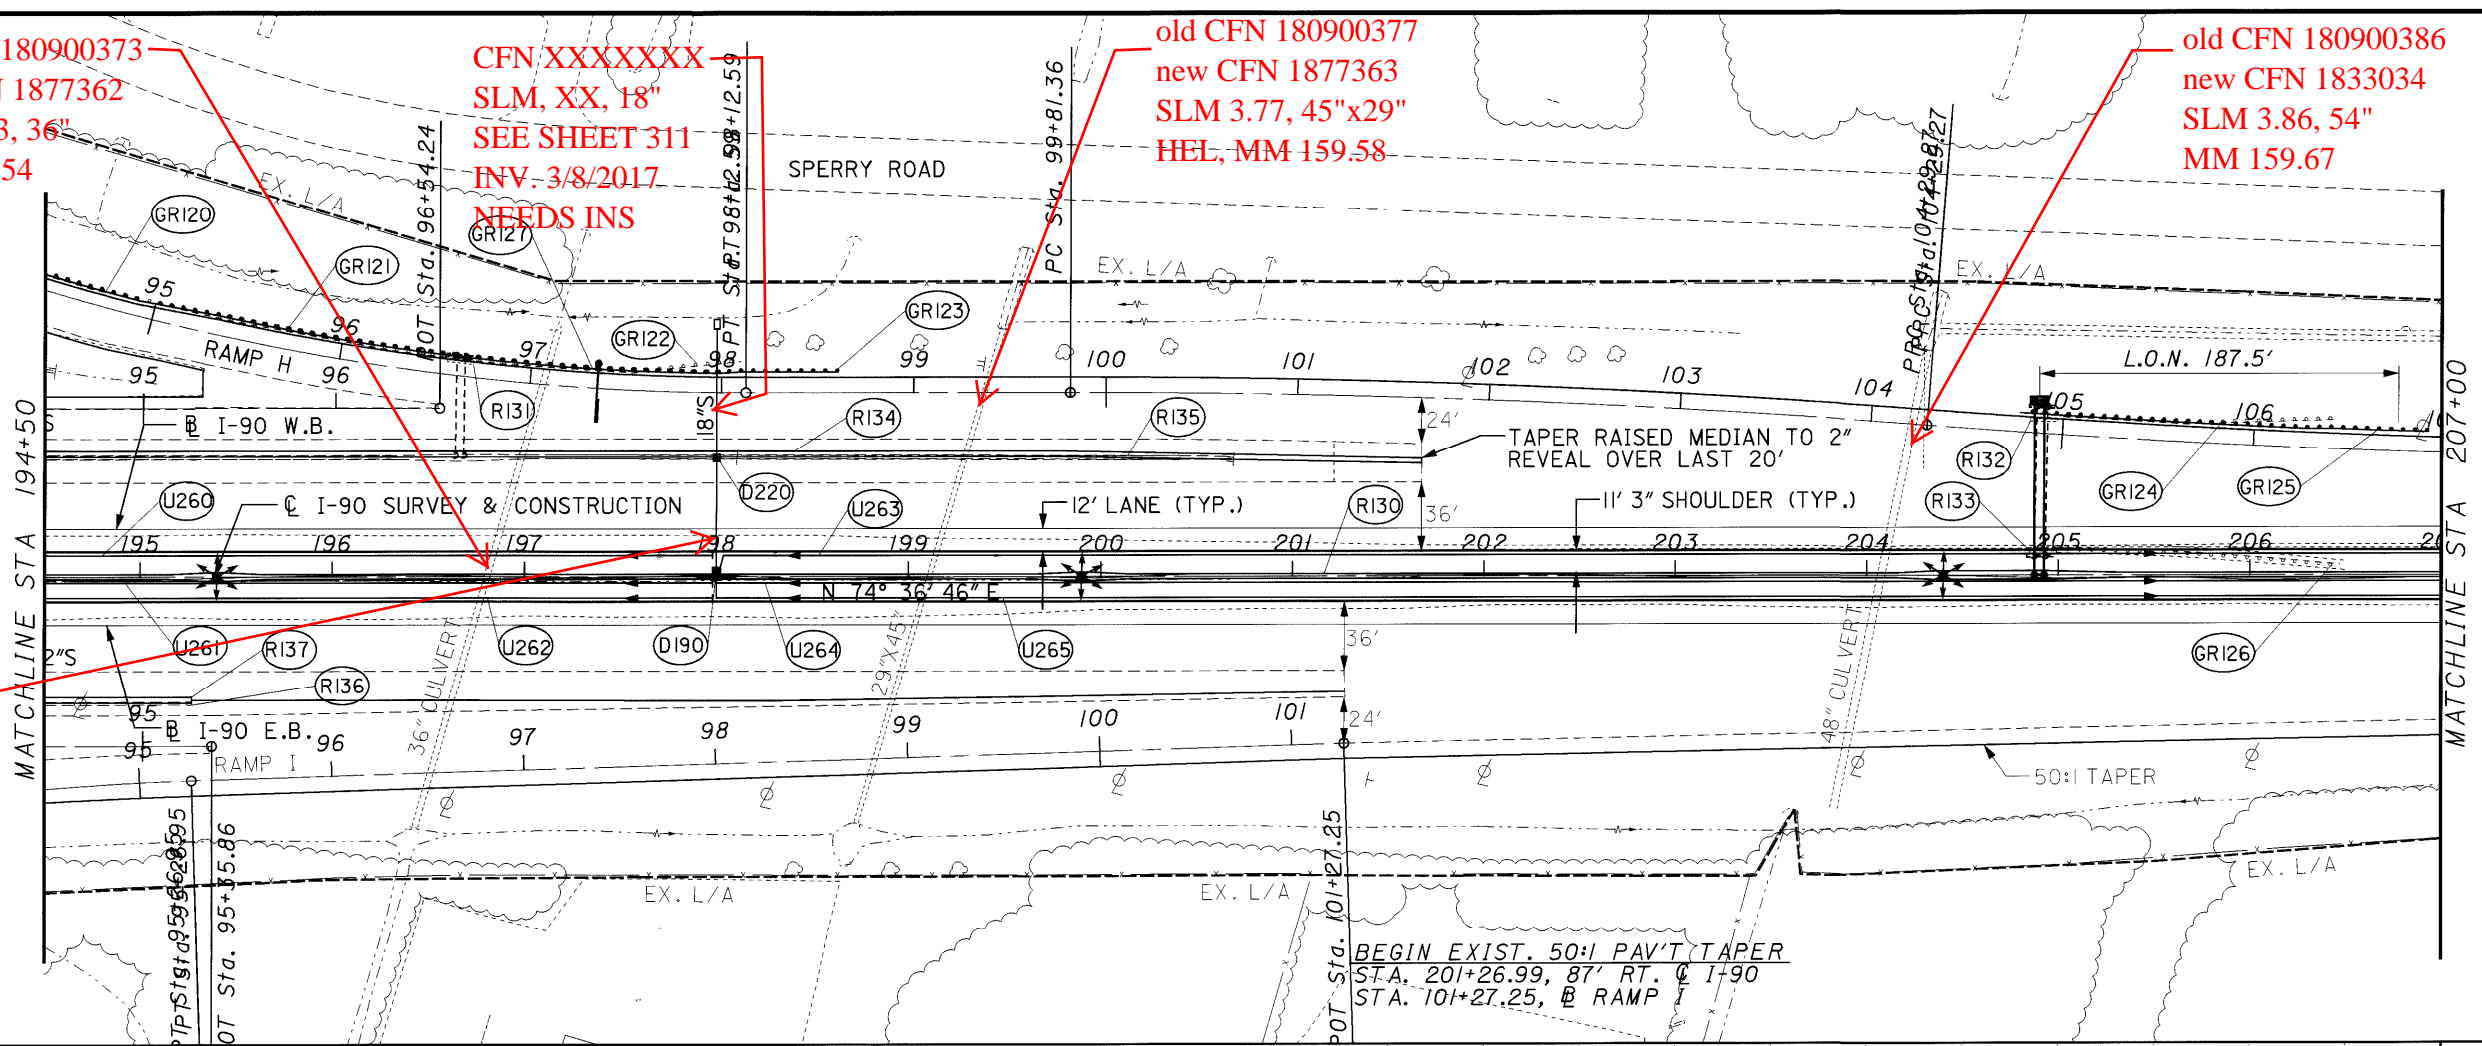

I:\PROJECTS\PI\11738\final\plans\11738GPP.DGN 09-AUG-2000 3:40PM jgrmovse