

old CFN 432710071
 new CFN 1872459
 SLM 0.71, 91"x58"
 SEE SHEET 357

CFN 1971782
 SLM 0.74, 24"
 SEE SHEET 139
 SEE 1993 UPGRADE
 SHTS 36 AND 103

SEE 1993 CUY/LAK-271/90/271X/90X-14.85/2.76/0.00/2.76
 PLANS FOR MODIFICATIONS TO STORM SEWERS



FED. RD. DIVISION	STATE	PROJECT
2	OHIO	I-1102 (6)

44
458

CUYAHOGA & LAKE COUNTIES
 CUY-I-15.91
 LAK-I-0.00

ROADWAY				
Ref. No.	Station		Side	I-15 Guard Rail Dwg. No. & Lta. Ft.
	From	To		
1-R	33+00	39+75	Lt.	675.00
2-R	33+00	39+00	Lt.	600.00
Total:				1275.00

Ref. No.	Station	Side	I-15 Guard Rail Dwg. No. & Lta. Ft.	DRAINAGE	
				Excavation for Structures	Excavation for Structures
E-2				6	6
I-2				180	180
I-4				600	600
I-5				4	4
I-8				1	1
I-10				52	52
S-1				5.4	5.4
S-4				2.18	2.18
S-29				0.60	0.60
I-10				855	855
I-10				190	190
Totals:				6	6

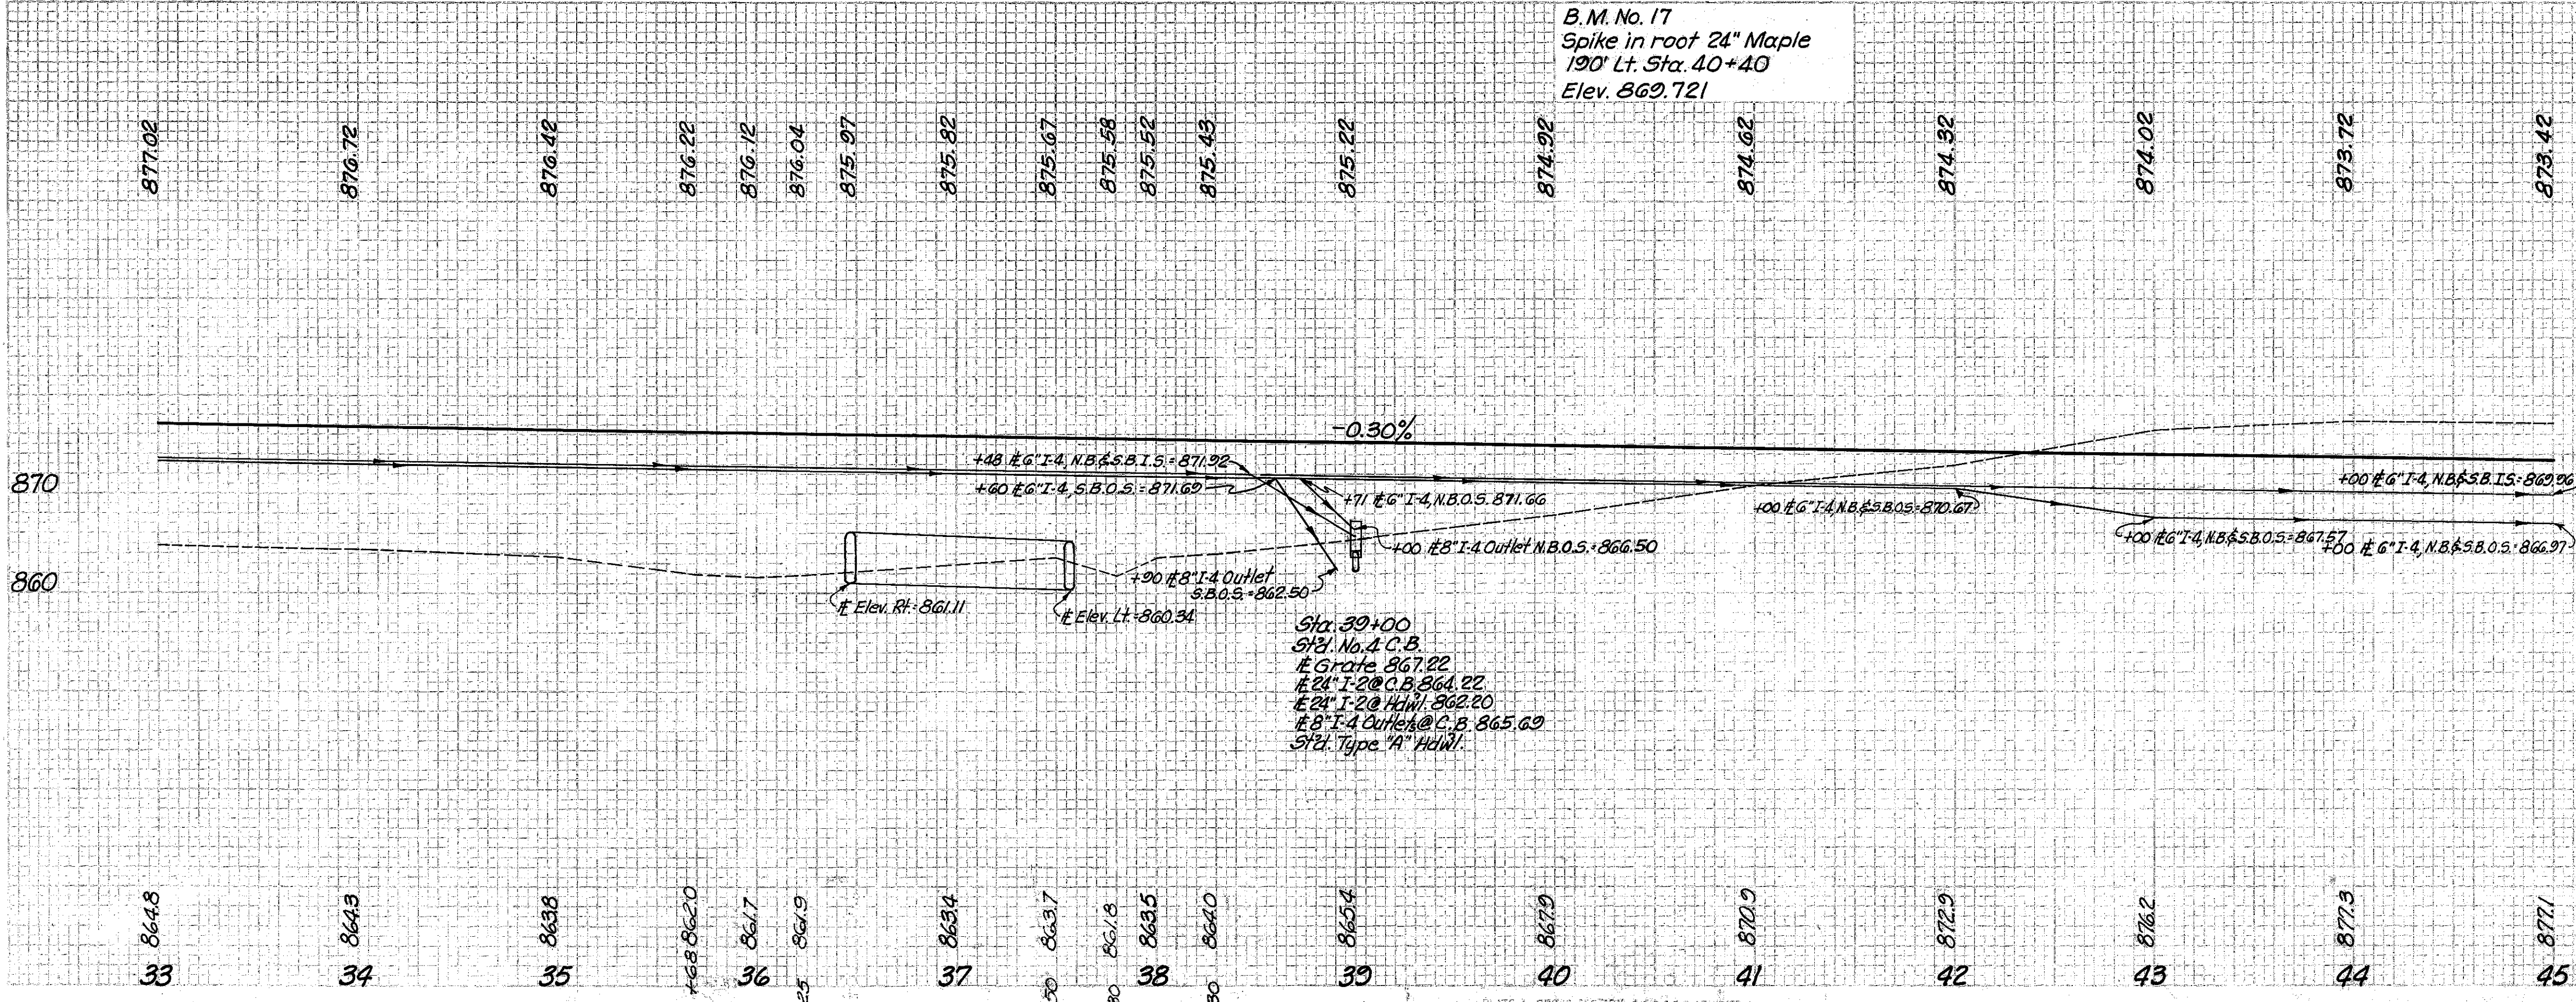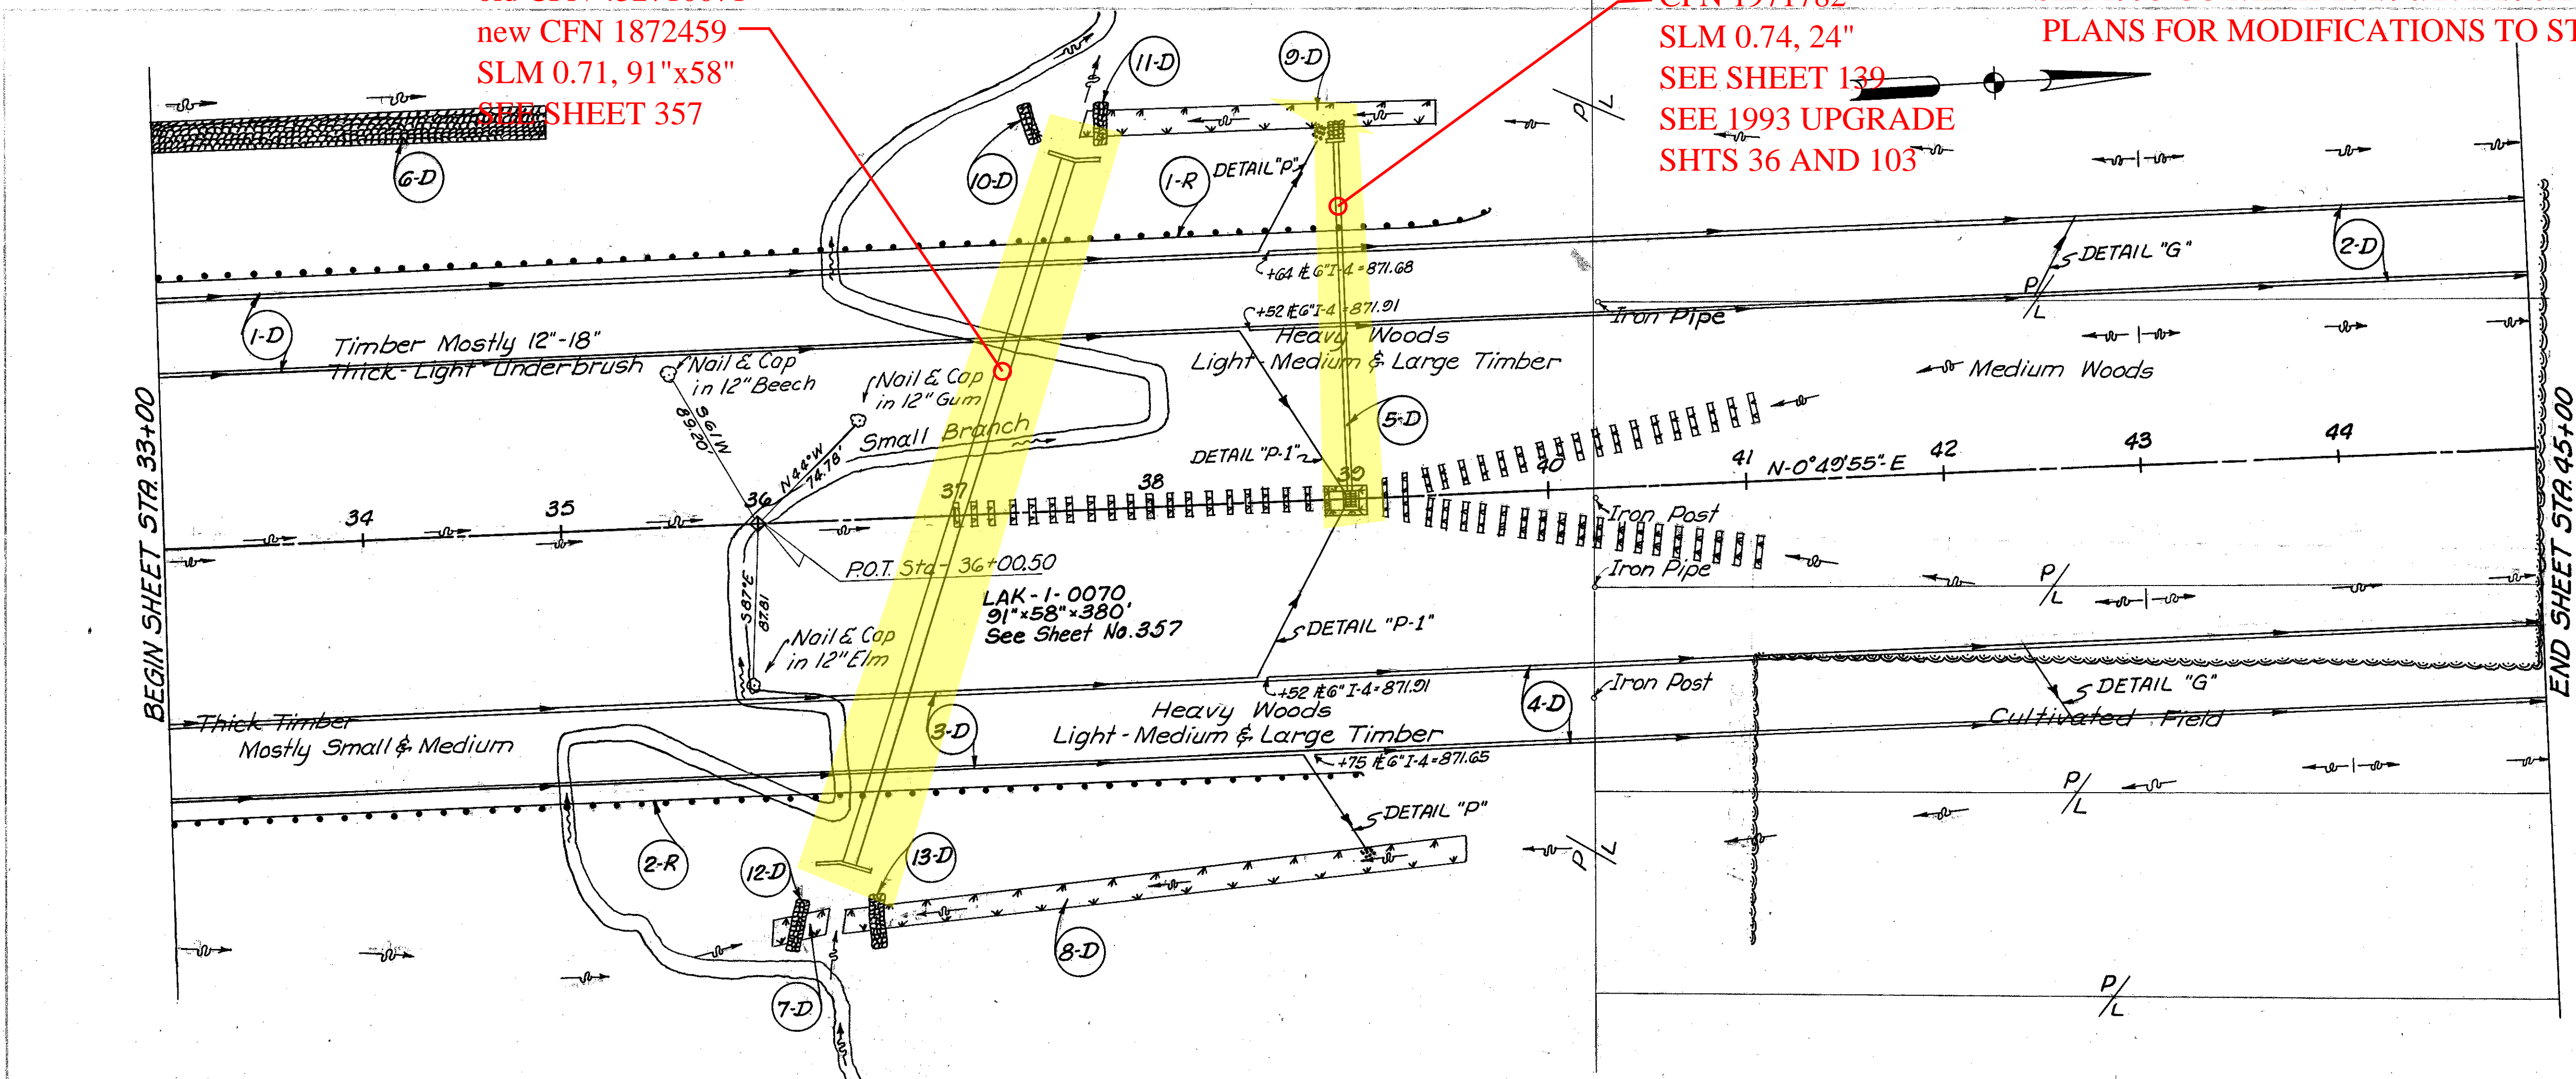

MICHAEL BAKER, JR., CONSULTING ENGINEERS
 ROCHESTER, PENNSYLVANIA
 STATE OF OHIO
 DEPARTMENT OF HIGHWAYS
 STATE HIGHWAY NO. 1
 C-41
 PLAN AND PROFILE
 STA. 33+00 TO STA. 45+00

Designed	Drawn	Traced	Checked	Reviewed	Date	Revised
B.P.	B.P.	K.G.	L.I.			

PLAN & PROFILE STA. 33+00 TO STA. 45+00