


SEEDING 280 260 240 220 200 180 160 140 120 100 80 60 40

END OF ROAD	STEEP	PROJECT	141
2	CHD		306

LAKE COUNTY
LAK-1-10.38

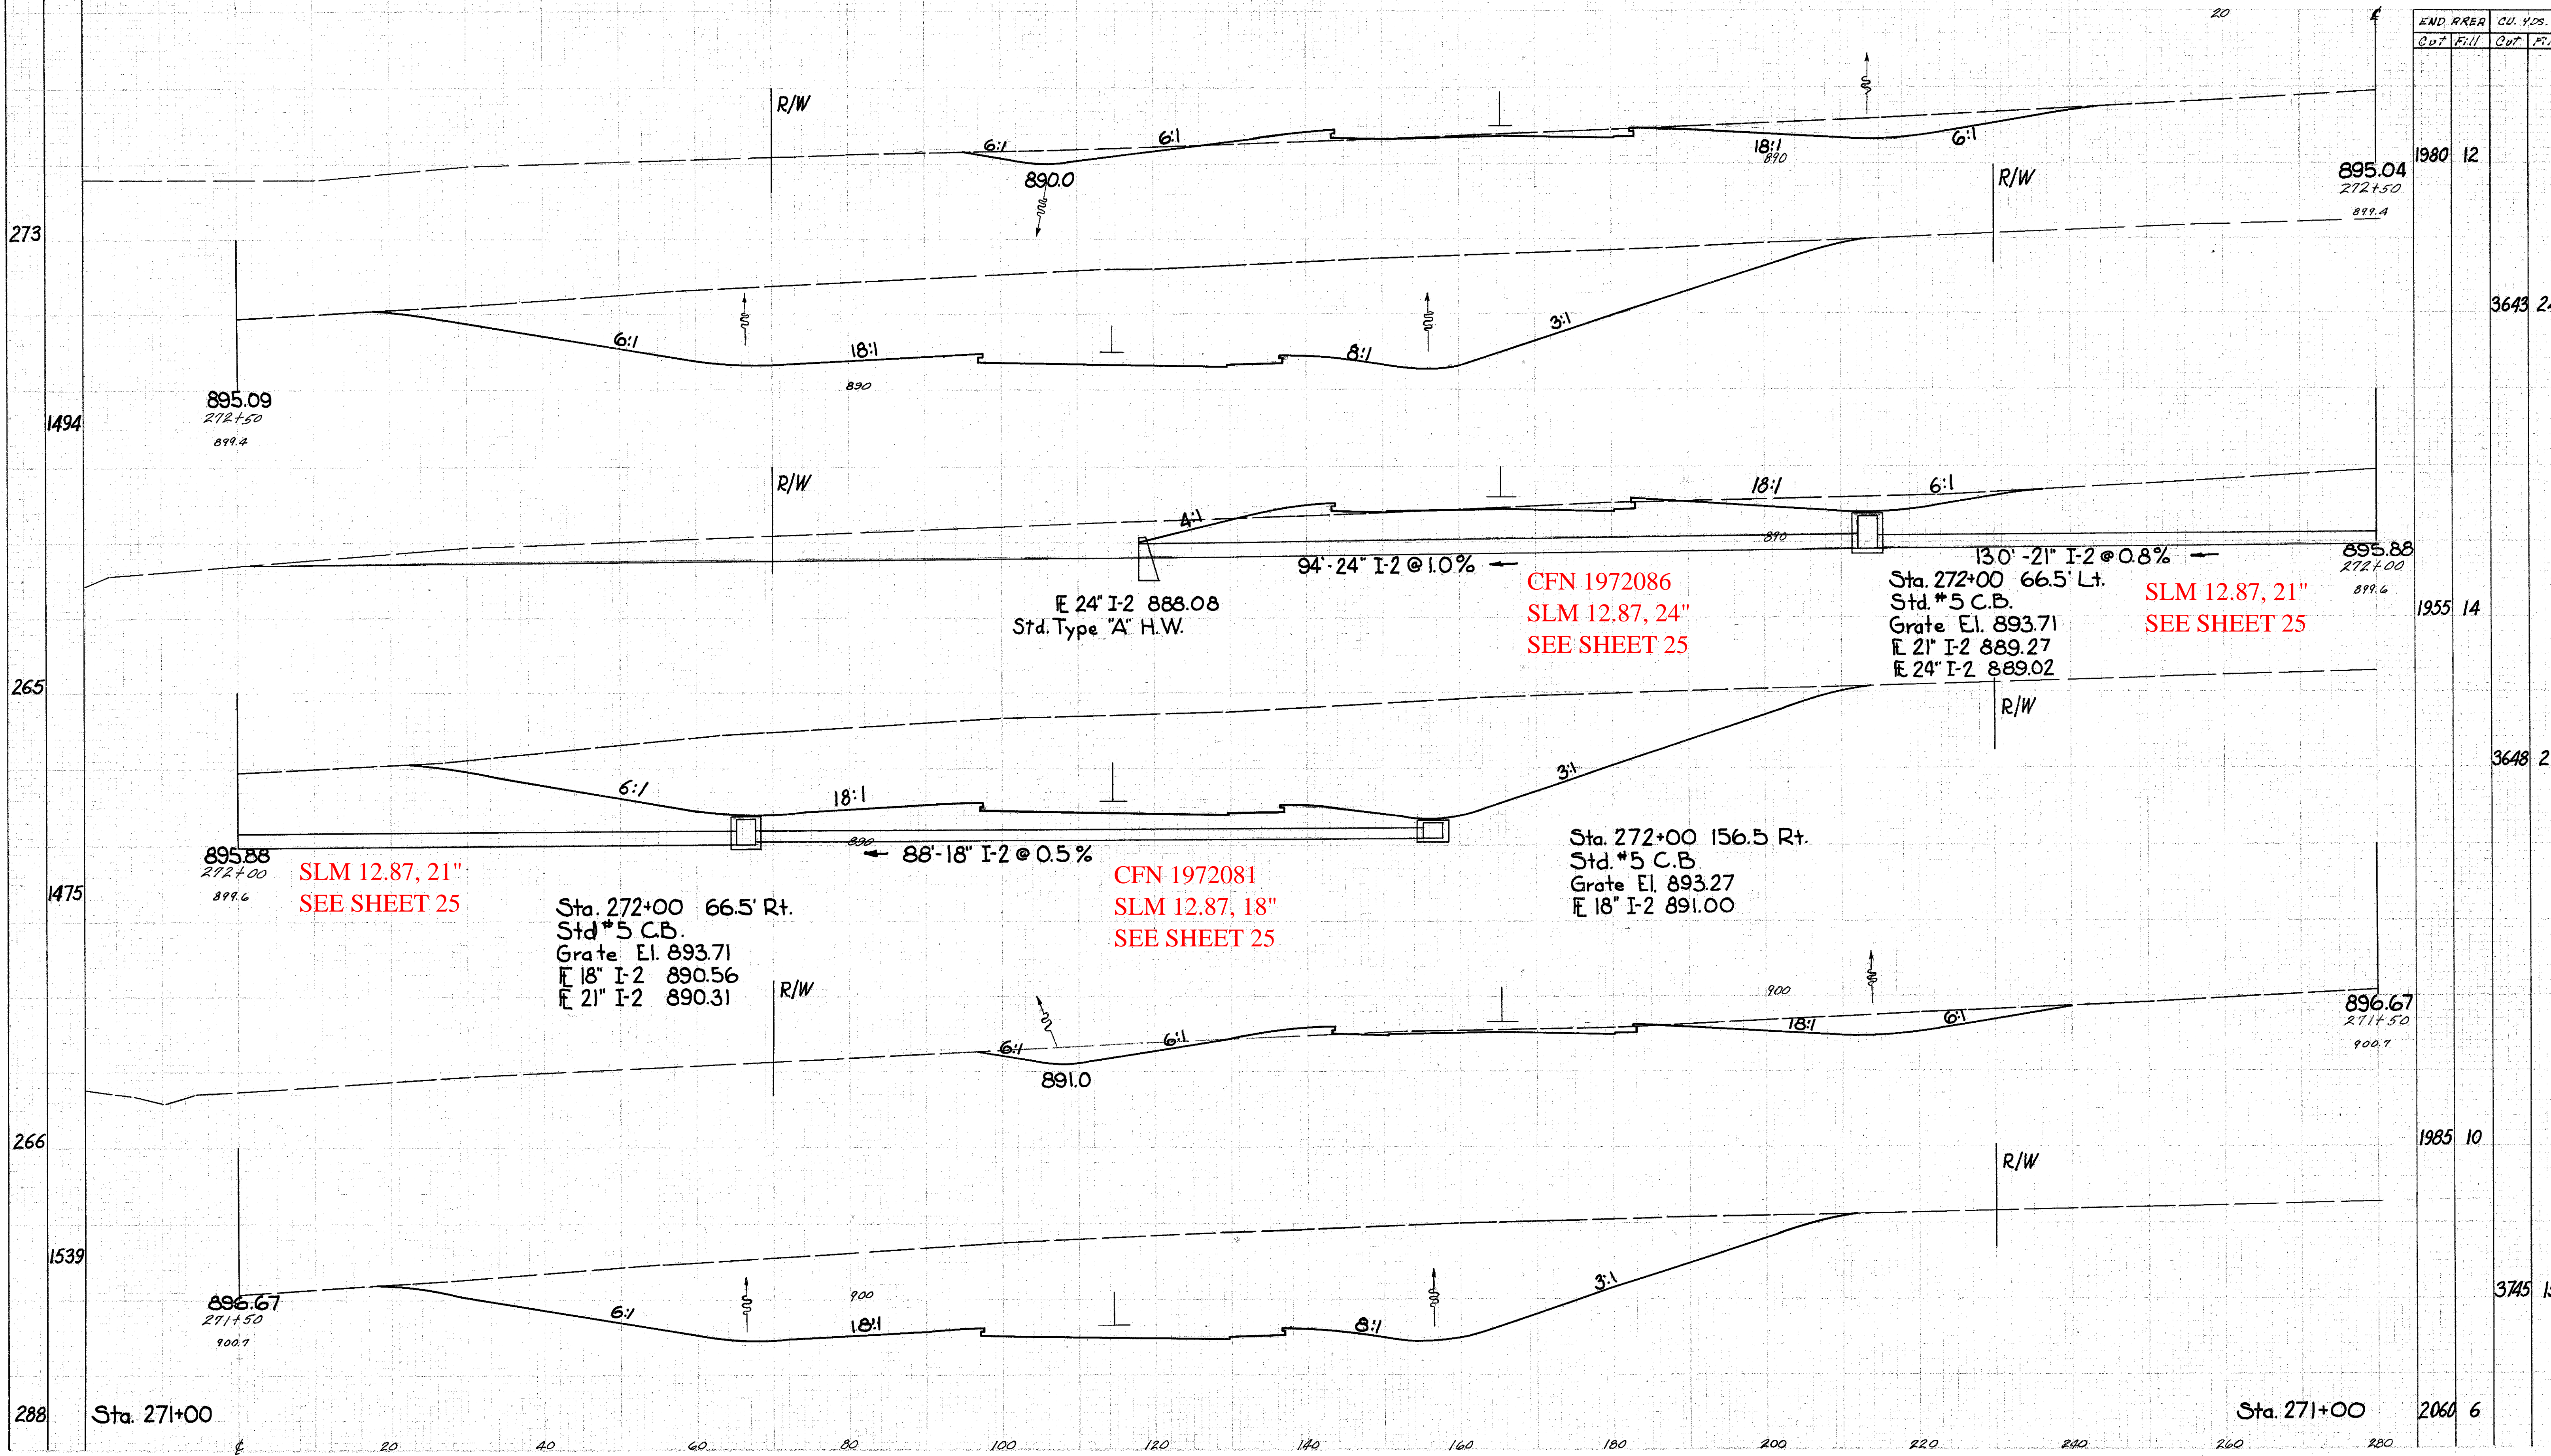

END PKER	CU. YDS.
Cut	Fill

1980 12

3643 24

1955 14

3648 22

1985 10

3745 15

2060 6

Sta. 271+50 to 272+50