
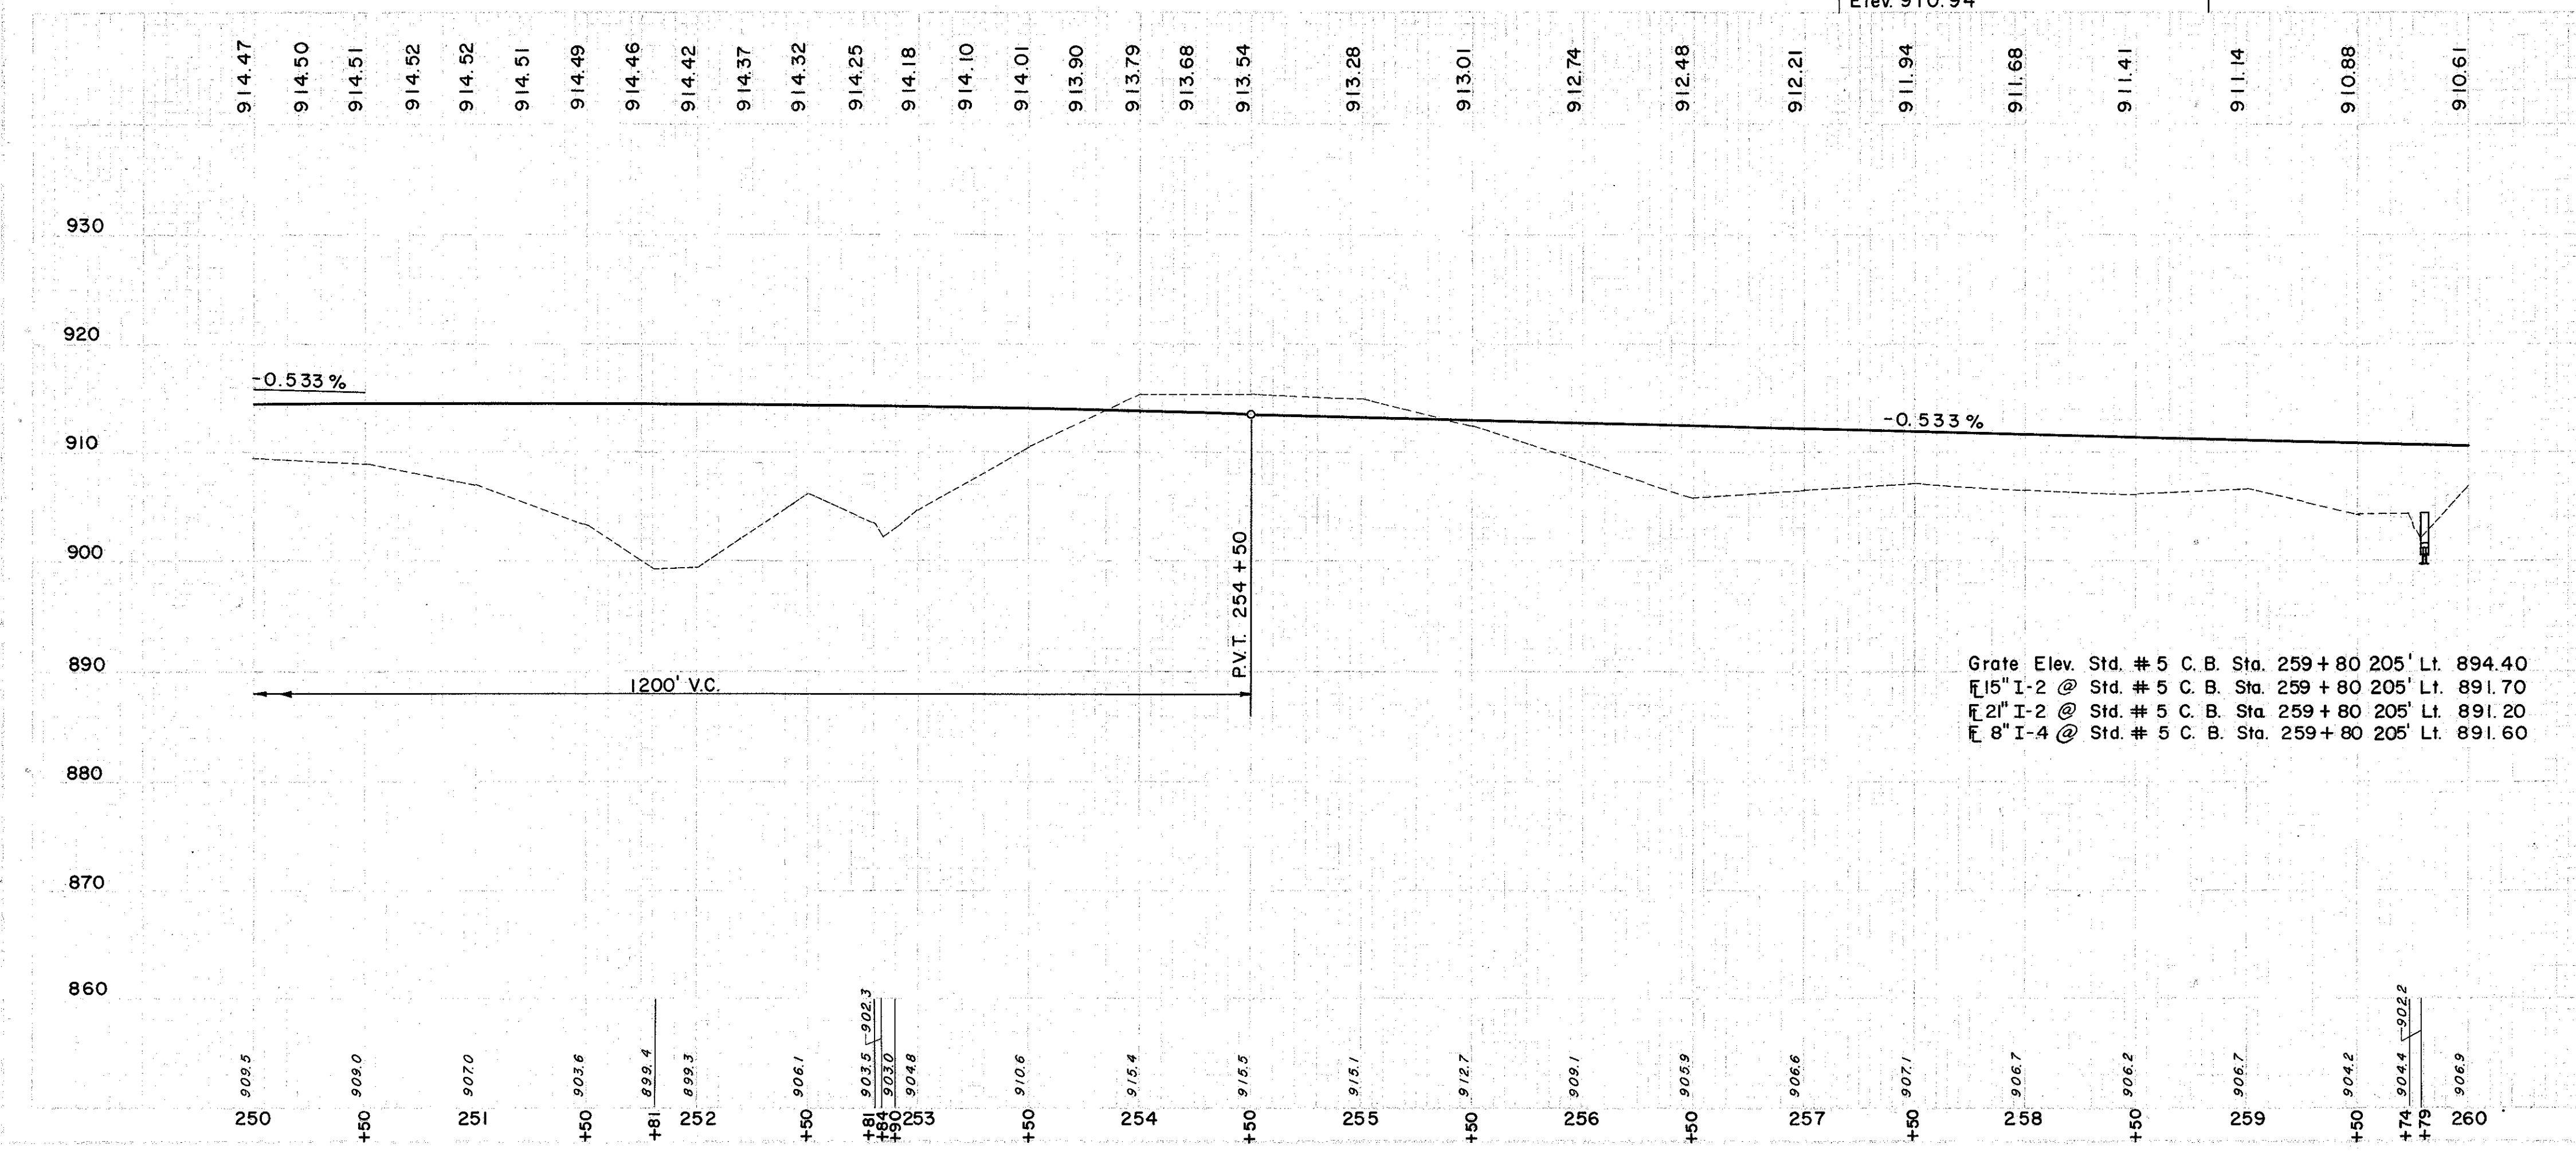


CFN 1972062
SLM 12.70 21"
SEE SHEET 128

LAKE COUNTY
LAK-1-10.38

CFN 1972068
SLM 12.70, 15"
SEE SHEET 128

CFN 1972058
SLM 12.52, 15"
SEE SHEET 118

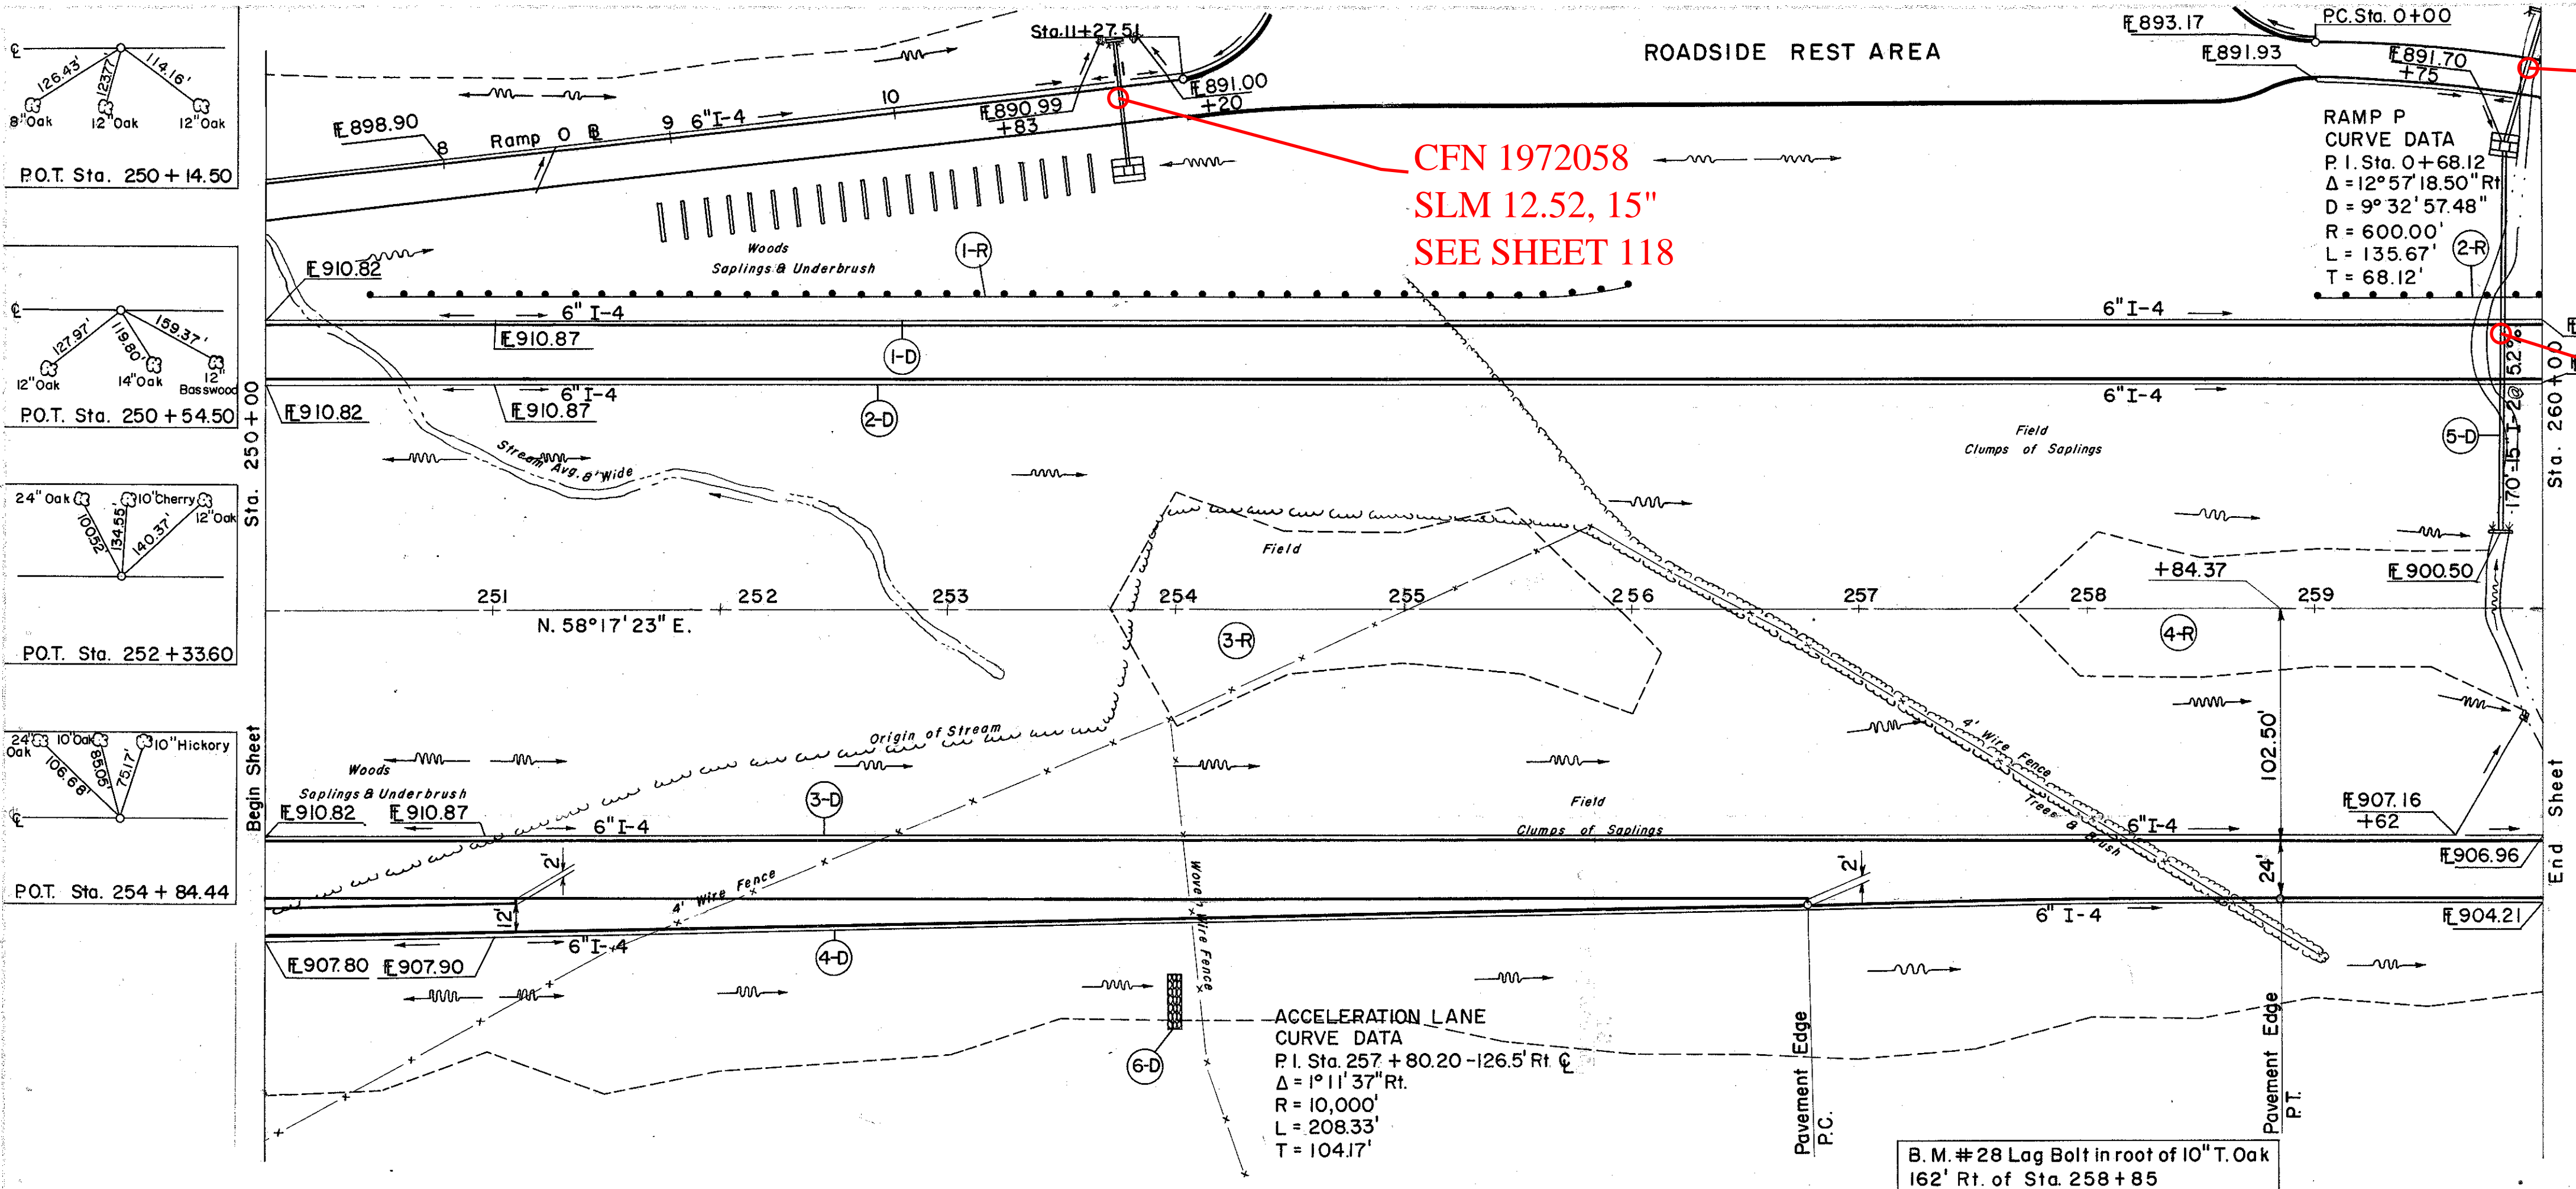

(D) DRAINAGE

REF. NO.	STATION	SIDE	CLASS	TYPE	L.F.	SHA	D	DEEP	EA.	I-5	S-1	S-4	E-2	L-10	S-29	I-10
I-2	250+00	LT	15"	CLASS A	1000	1000	6"	60°	1							
I-4	250+00	LT	8"	PIPE UNDERDRAIN	1000	1042	6.4"	6.4"	10							
I-2	259+80	LT	15"	CLASS A	170											
S-1	259+80	LT							3.1							
S-4	259+80	LT									146					
E-2	259+80	LT										10				
L-10	259+80	LT											2			
S-29	259+80	LT												0.3		
I-10	259+80	LT														14

(R) ROADWAY

REF. NO.	STATION	SIDE	TYPE	UNITS		TOTAL
				FROM	TO	
I-R	250+50	LT	5500	256+00		
2-R	259+00	LT	1000	260+00		
3-R	253+50	LT	15	256+00		15
4-R	257+50	LT	12	260+00		12
						650.00
						27

GRAVEL	28,463 C.Y.
EMBANKMENT	48,036 C.Y.
TOTAL	56,682 C.Y.