


Seeding	
End Width	Sq. Yd.
235	708.42 185+00 751.7
2617	
236	710.27 184+00 751.2
2589	

End Area		Volume	
Cut	Fill	Cut	Fill
10,140	0		
		37,298	0
10,108	0		
		33,036	0

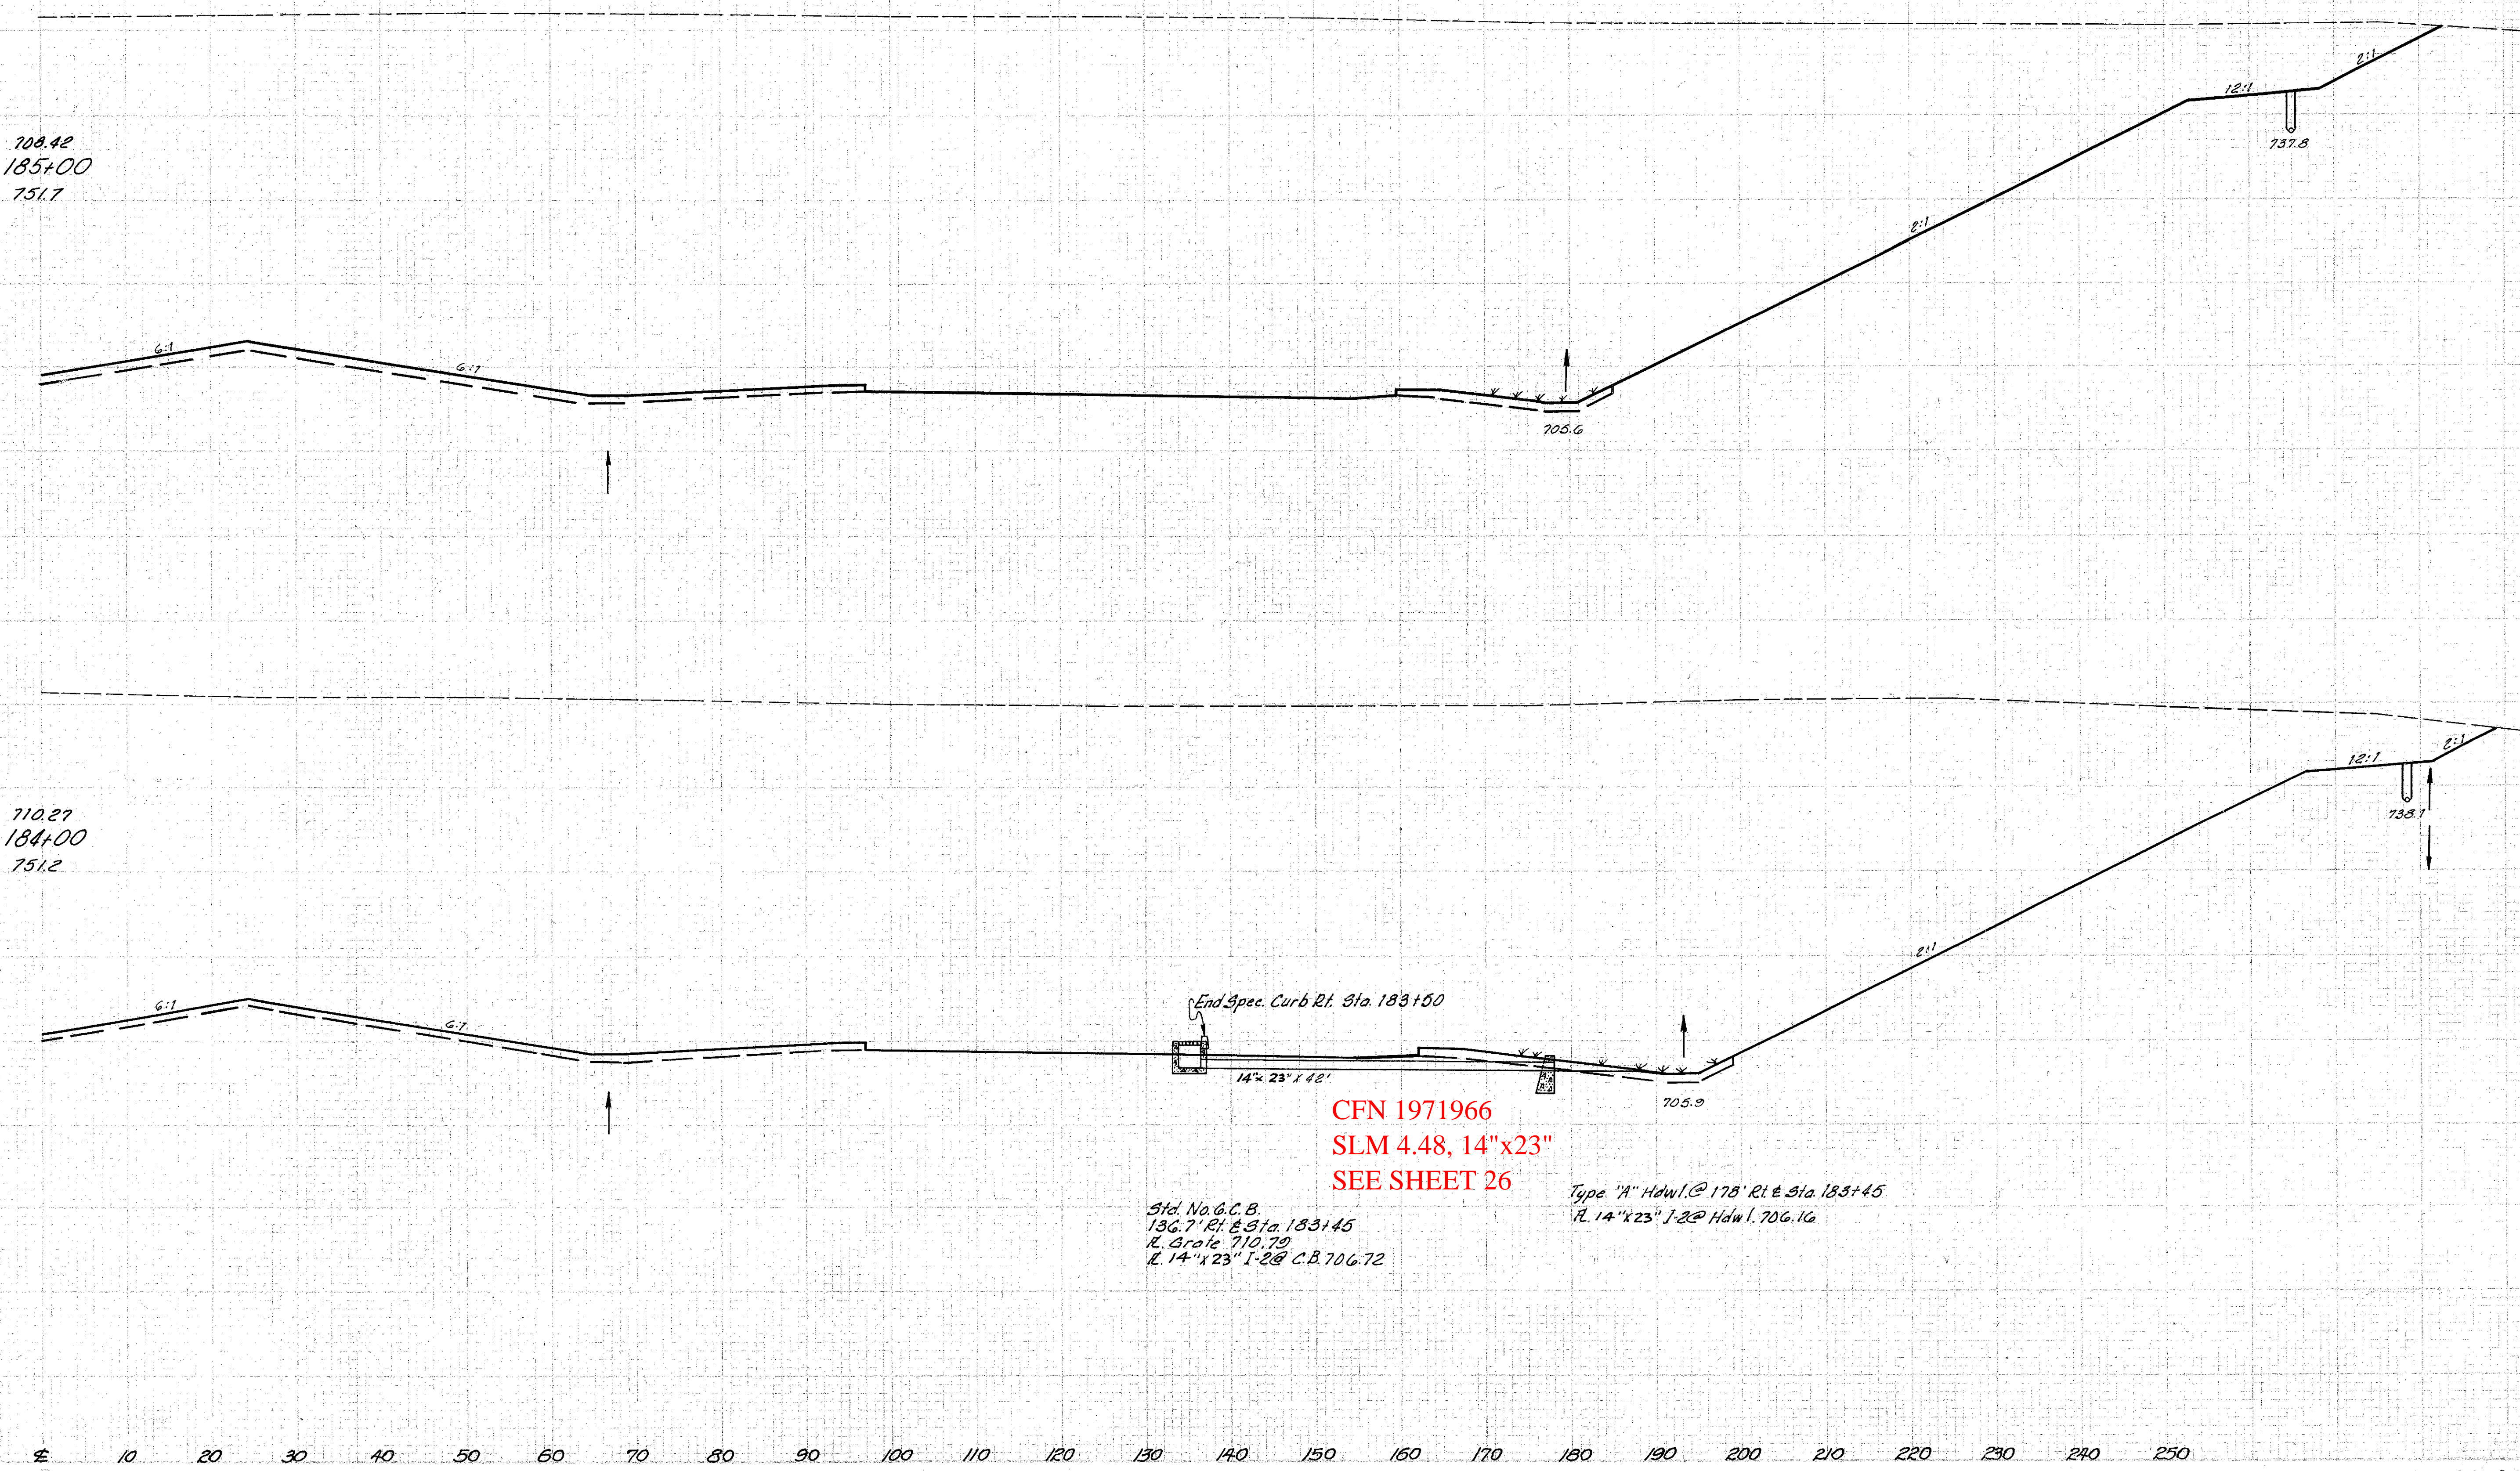

End Spec. Curb Rt. Sta. 183+50
 14" x 23" x 18"
CFN 1971966
SLM 4.48, 14"x23"
SEE SHEET 26
 Std. No. C.B.
 136.7' Rt. @ Sta. 183+45
 R. Grade 710.70
 R. 14" x 23" 1-2 @ C.B. 706.72
 Type "A" Hdwl. @ 178' Rt. @ Sta. 183+45
 R. 14" x 23" 1-2 @ Hdwl. 706.16