


Seeding
End
Width Sq. Yd.

LAKE COUNTY
LAK-1-2.16

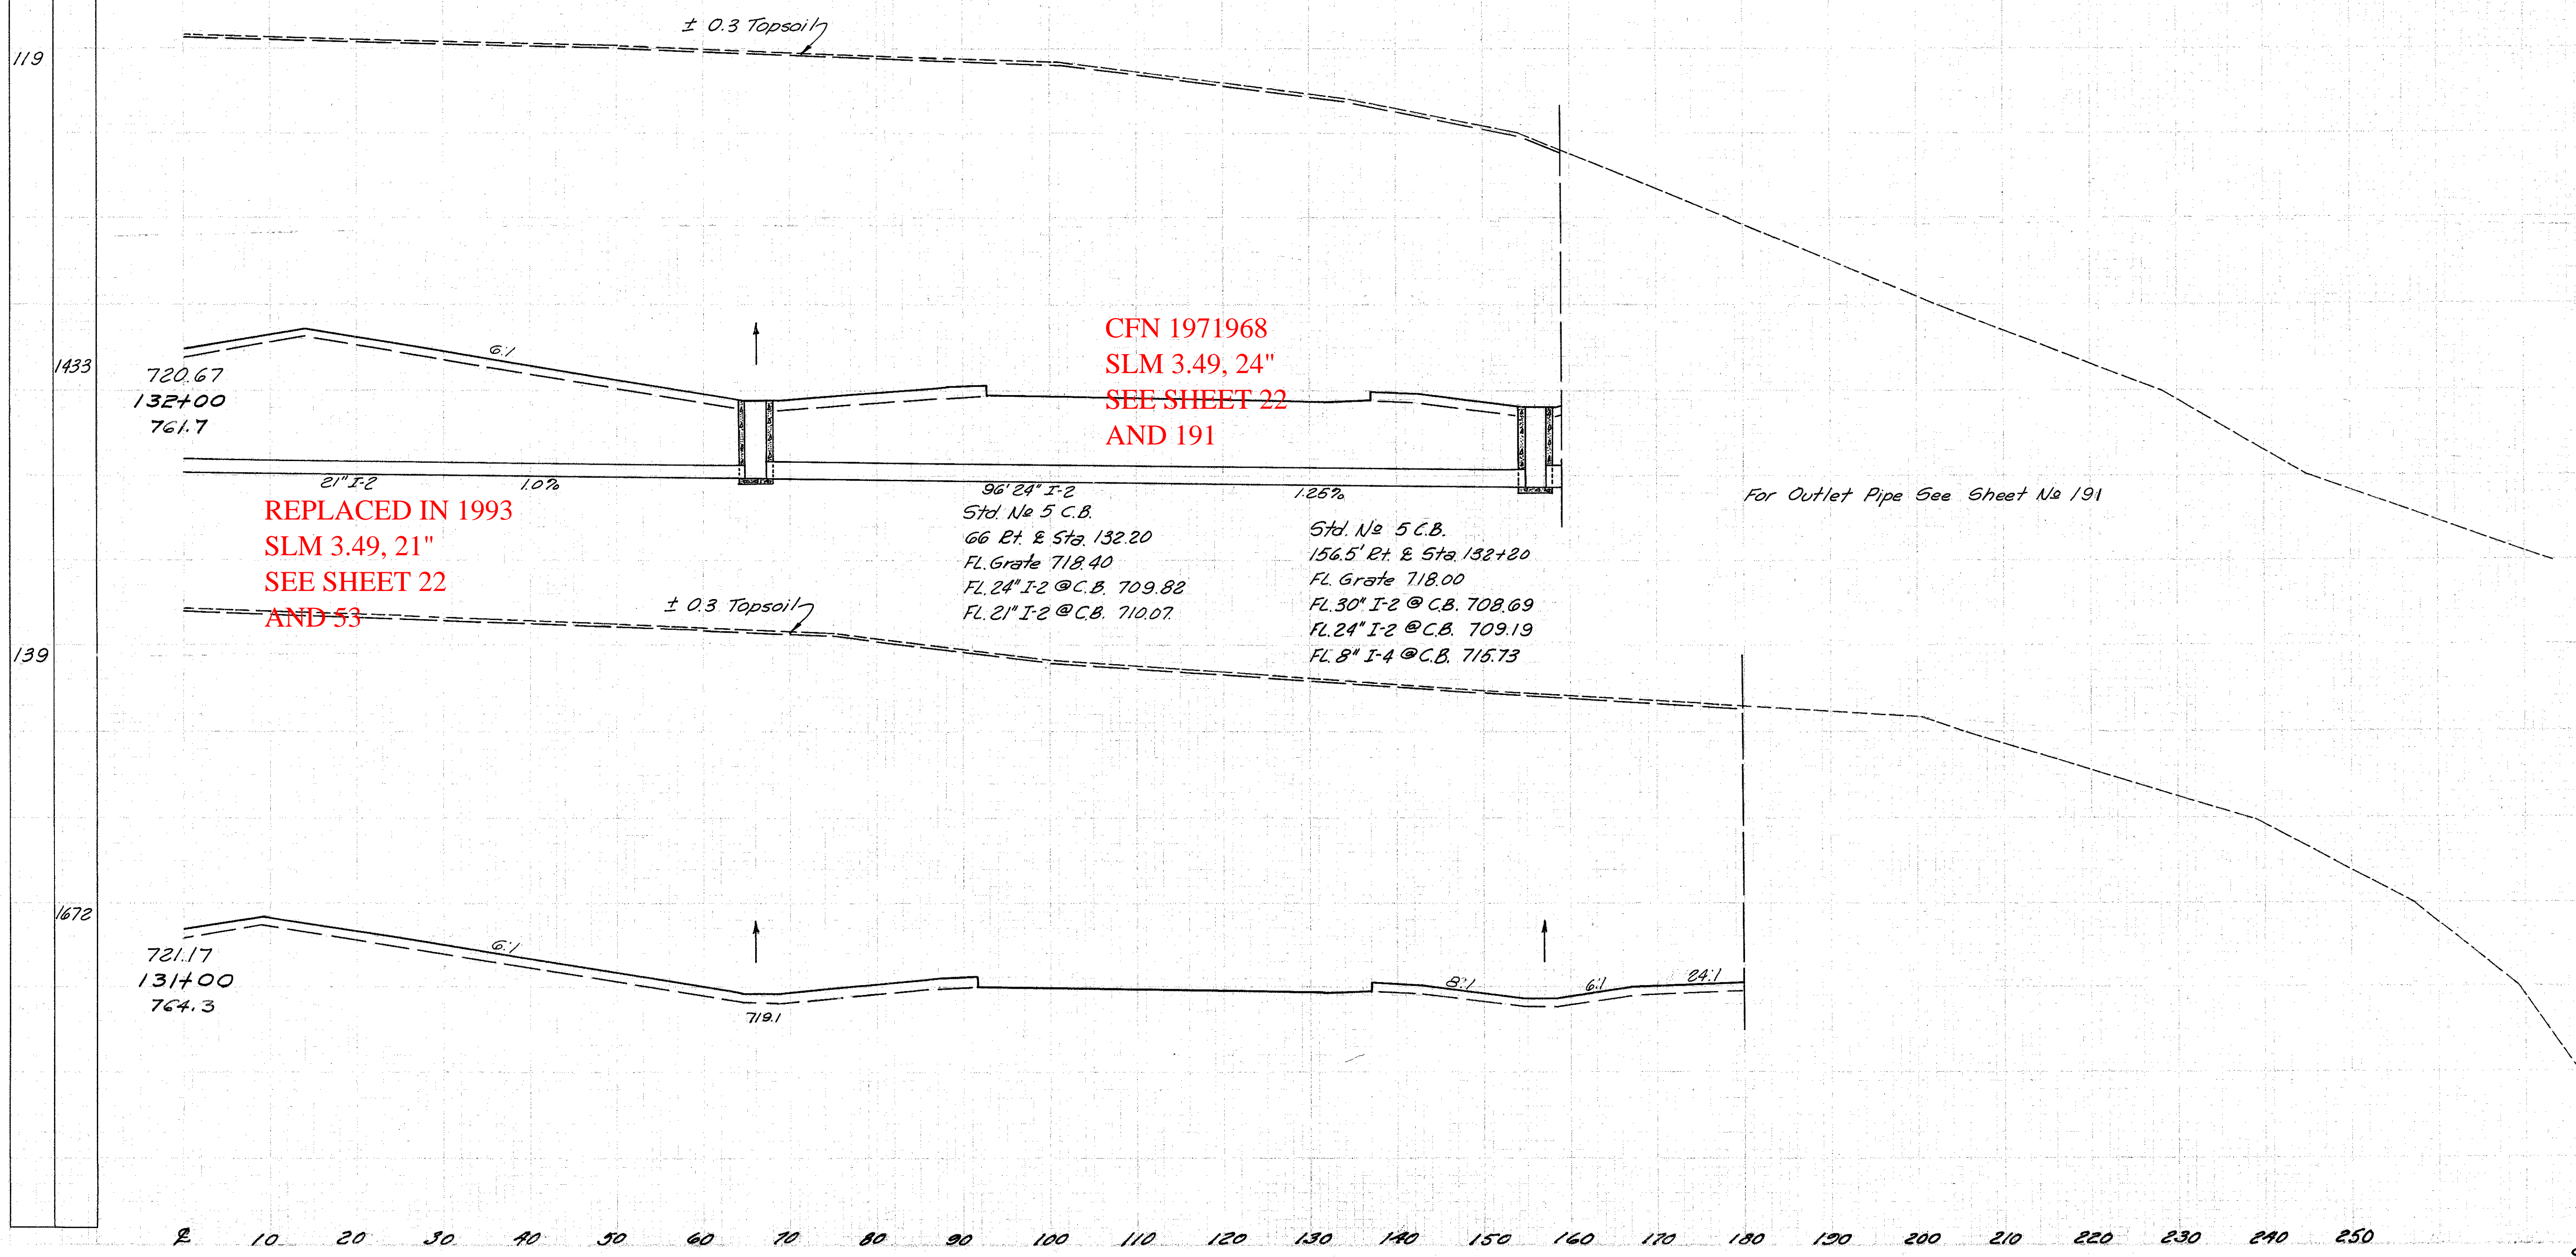

End Area	Volume	
	Cut	Fill
Topsoil 49		
5996	0	
Topsoil 193		
23941	0	
Topsoil 55		
6932	0	
Topsoil 217		
26637	0	

Sta. 131+00 to Sta. 132+00 Ft. &