
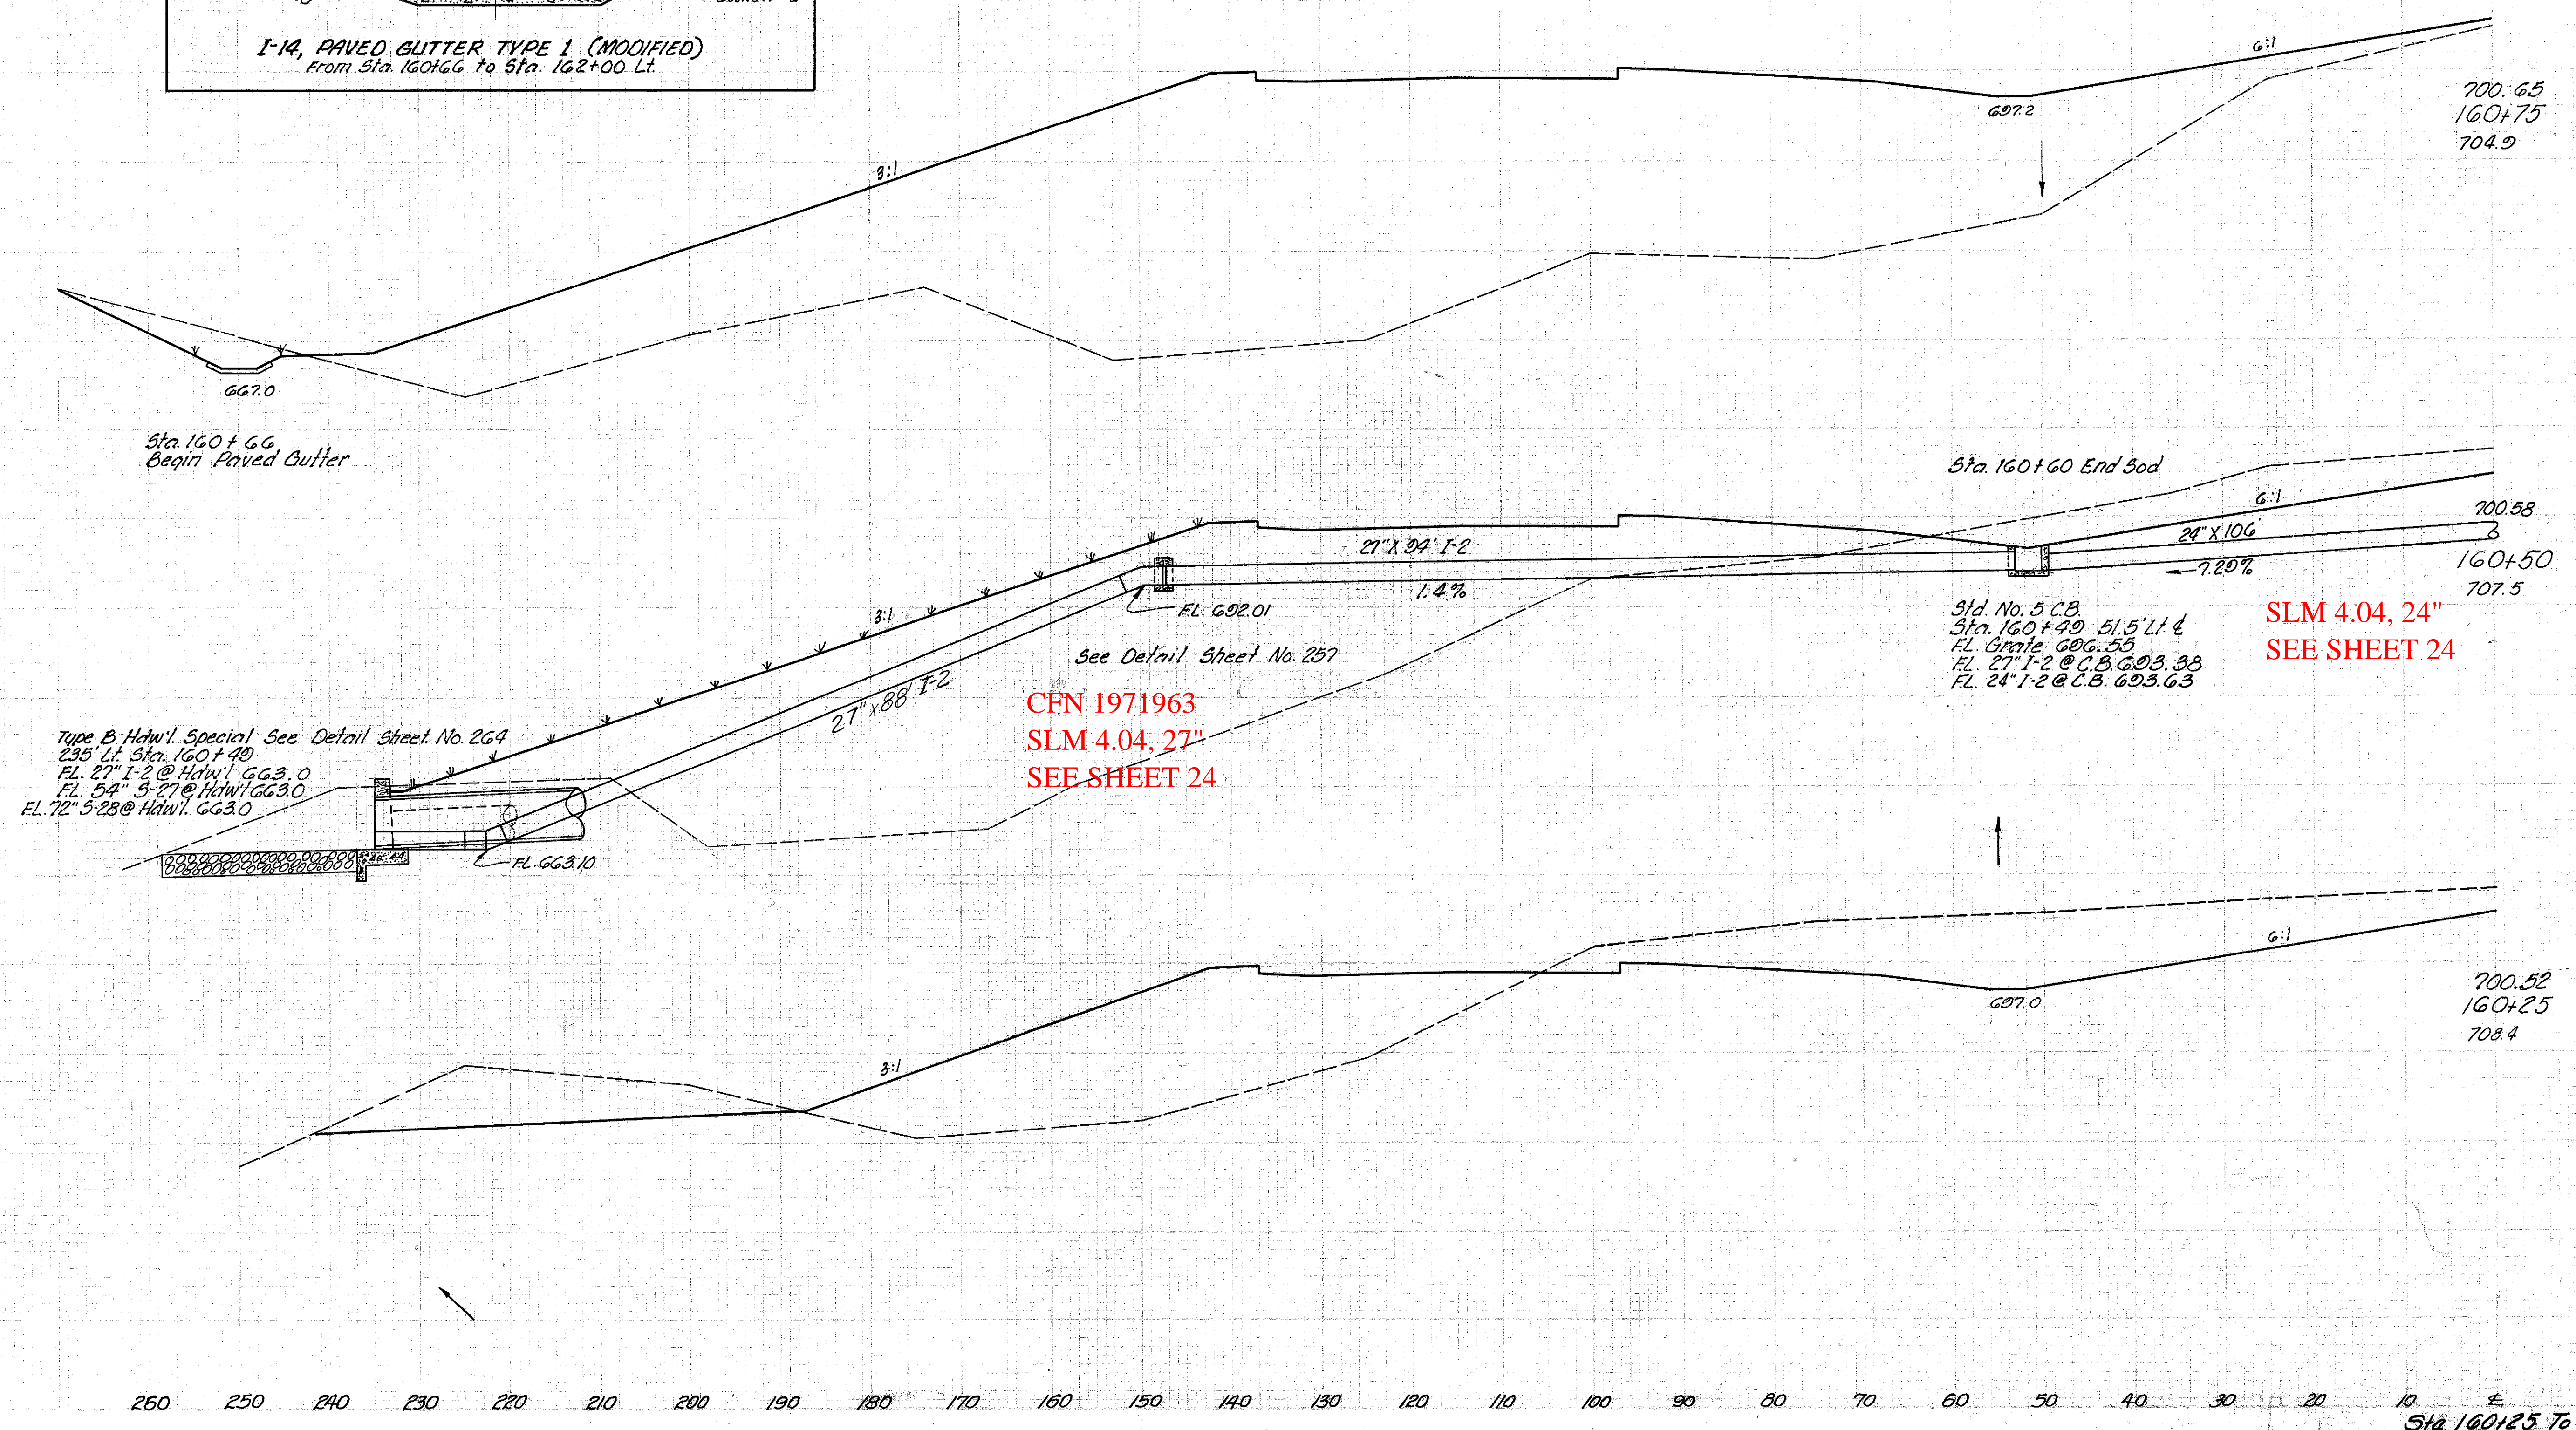


LAKE COUNTY
LAK-1-2.16

Seeding
End Area
Width

243
600
254
710
257
701

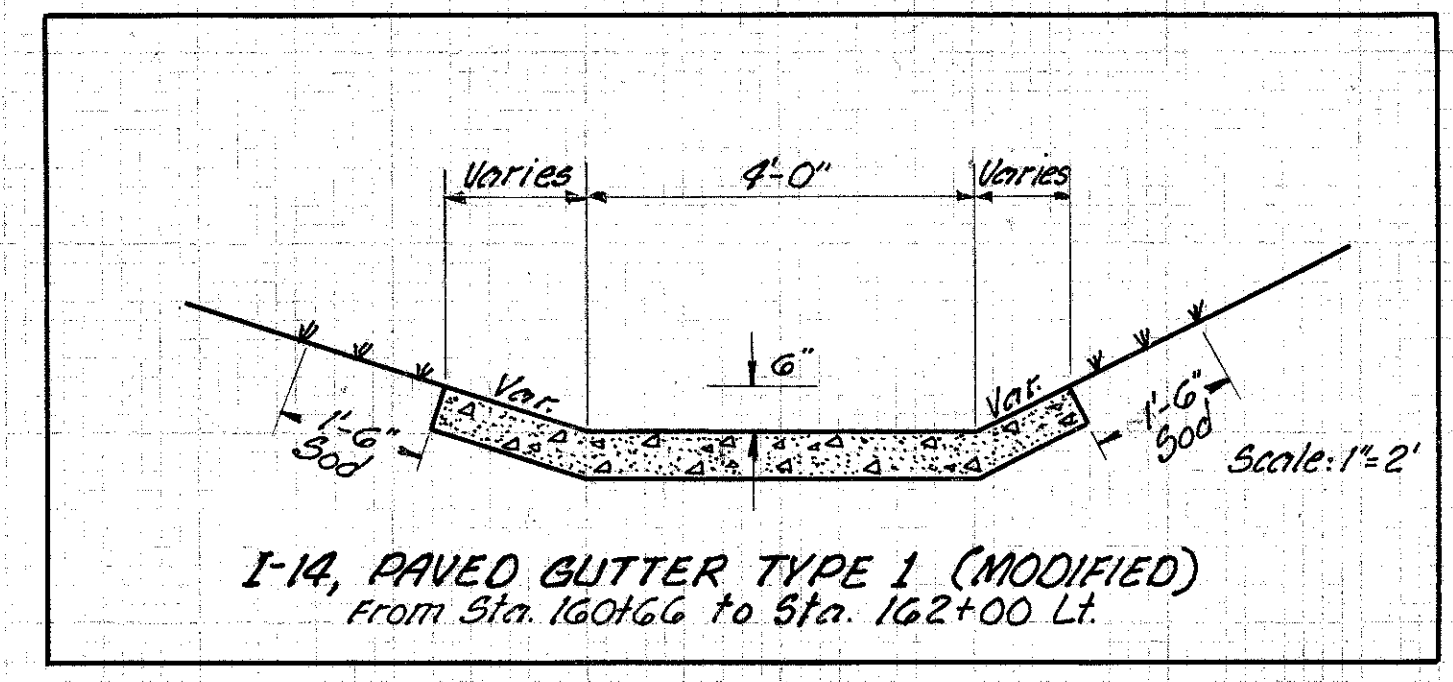

End Area		Volume	
Cut	Fill	Cut	Fill
56	3670		
		128	2745
		220	2290
		463	1320
		780	732
			605
			339

CFN 1971963
SLM 4.04, 27"
SEE SHEET 24

SLM 4.04, 24"
SEE SHEET 24