


Seeding	
End Width	Sq. Yd.
189	
244	
2728	
247	
2811	

LAKE COUNTY
LAK - 1-4.02

End Area		Volume	
Cut	Fill	Cut	Fill
2411	0		
		11,160	
3620	122	13,167	255
3490	16		
		13,465	52

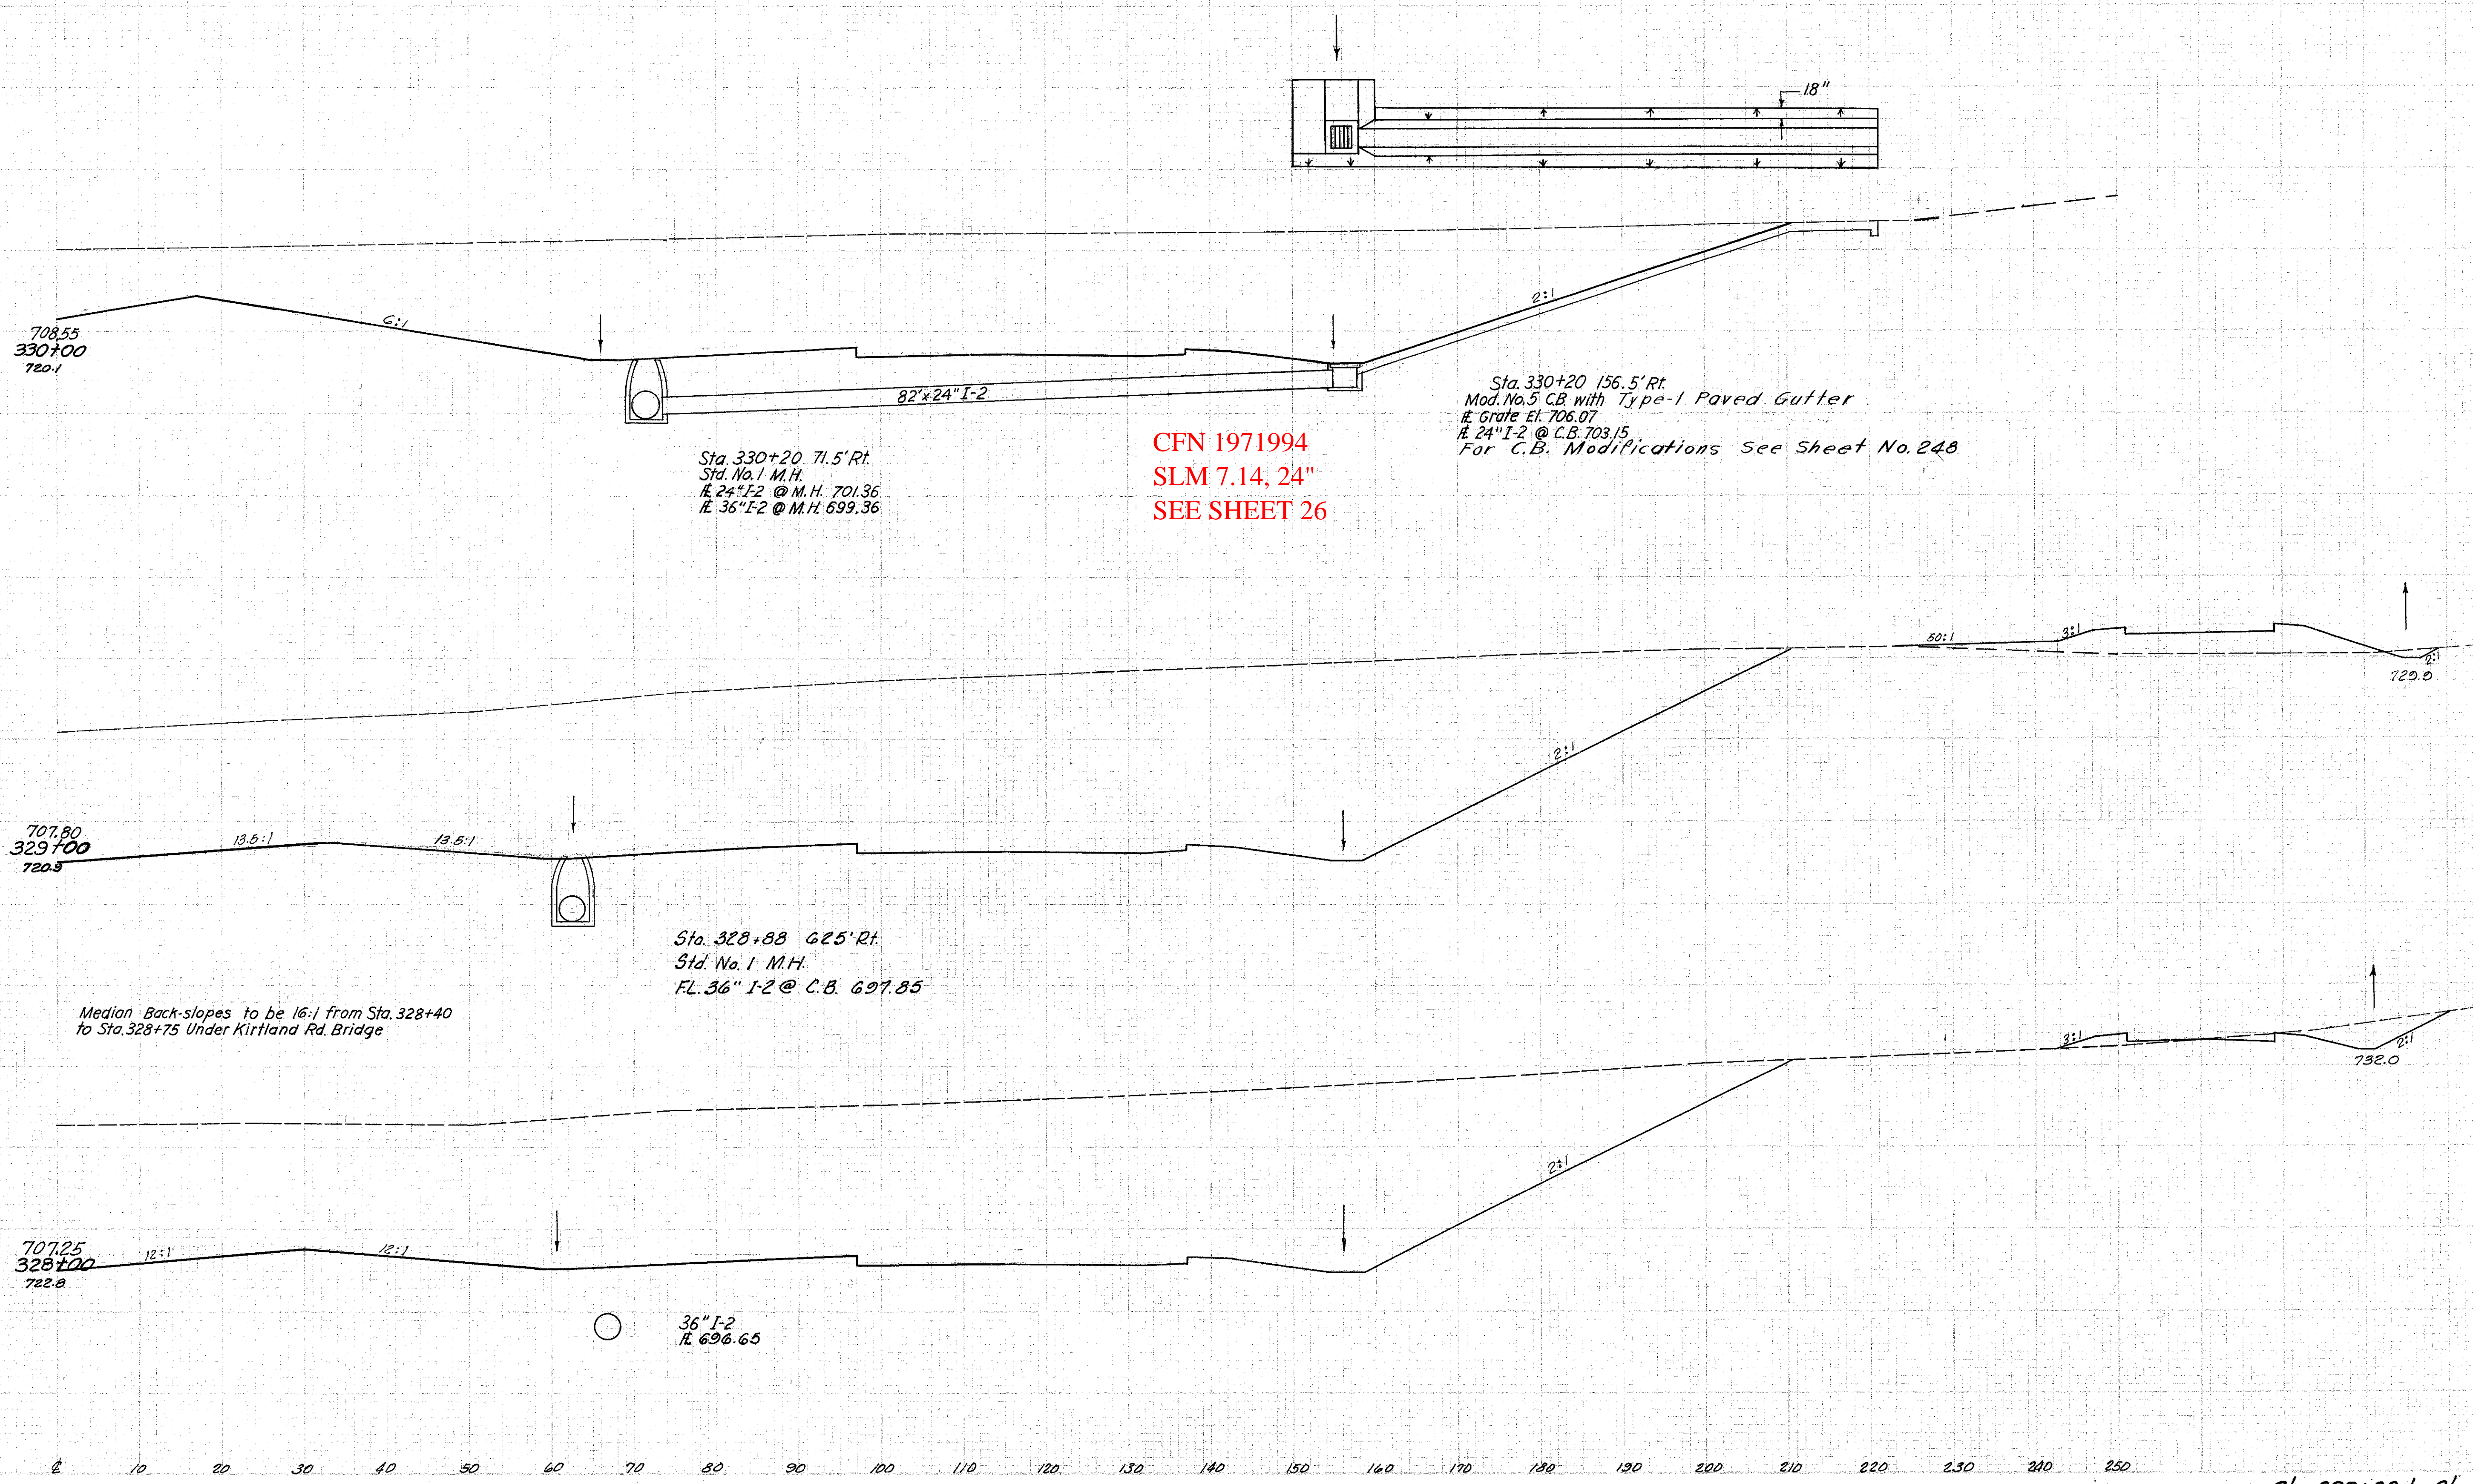

Sta. 328+00 to Sta. 330+00 R/L