

MICROFILMED
SEP 15 1986

old CFN 180901784
new CFN 1882326
SLM 17.86, 54"
SEE BELOW

old CFN 180901786
new CFN 1882333
SLM 17.86, 42"


old CFN 180901786
new CFN 1882333
SLM 17.86, 42"

SLM 17.86, 42"

old CFN 180901805
new CFN 1882338
SLM 18.05, 60"
SEE BELOW

CUYAHOGA COUNTY
CUY-42R-19.78

— PENNSYLVANIA RAILROAD —
PROPOSED STRUCTURE
TYPE: Steel girder bridge with reinf. concrete substructure.
SPANS: 2 @ 63'-9" clear (normal to highway).
WIDTH: 18 Tracks, 269' ± (along highway).
LOADING: Coopers E-7Z
SKEW: Varies

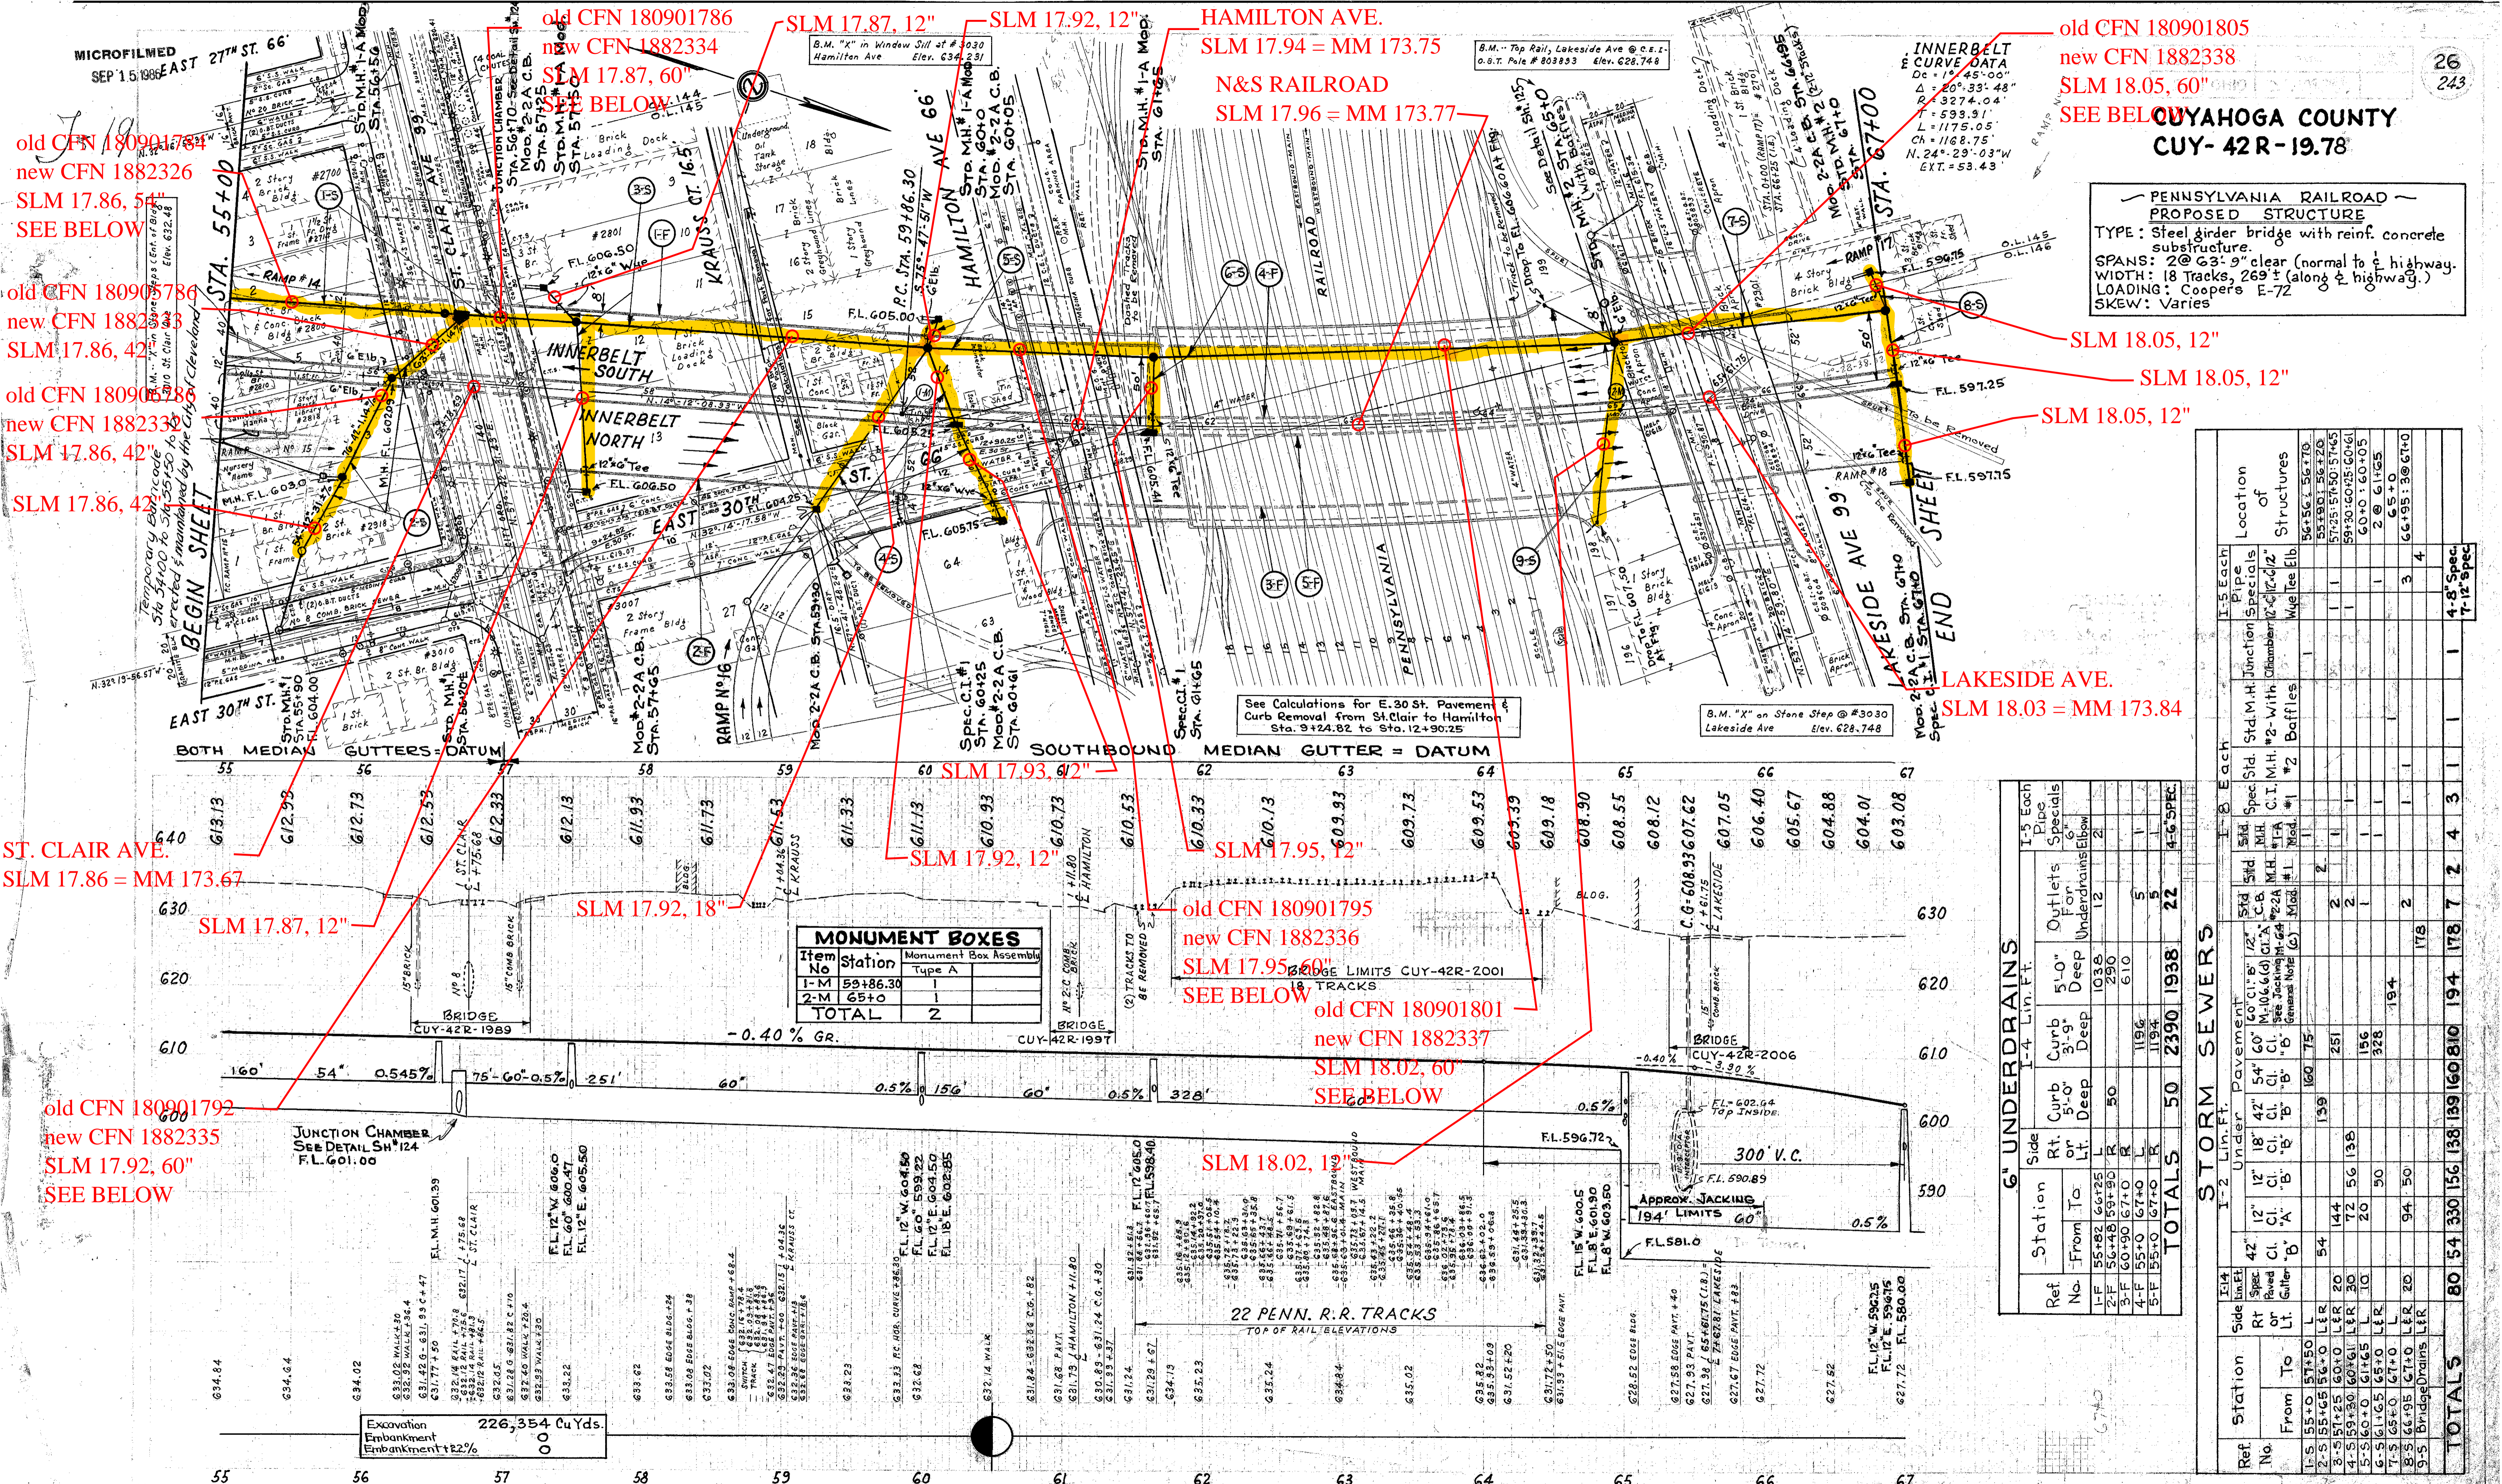

MONUMENT BOXES

Item No	Station	Monument Box Assembly
1-M	59+86.30	Type A
2-M	65+0	
TOTAL		2

6" UNDERDRAINS

Station	Side	From	To	Depth	Notes
55+00	Rt.	55+00	55+00	50	
55+00	Lt.	55+00	55+00	50	
55+00	Rt.	55+00	55+00	50	
55+00	Lt.	55+00	55+00	50	
TOTALS		50	2390	1938	22

STORM SEWERS

Ref. No.	Station	Side	From	To	Depth	Notes
1-5	55+00	Rt.	55+00	55+00	50	
2-5	55+00	Lt.	55+00	55+00	50	
3-5	55+00	Rt.	55+00	55+00	50	
4-5	55+00	Lt.	55+00	55+00	50	
5-5	55+00	Rt.	55+00	55+00	50	
6-5	55+00	Lt.	55+00	55+00	50	
7-5	55+00	Rt.	55+00	55+00	50	
8-5	55+00	Lt.	55+00	55+00	50	
9-5	55+00	Rt.	55+00	55+00	50	
TOTALS			80	54	330	156

PLAN & PROFILE - INNERBELT - STA. 55+00 to STA. 67+00