

CFN 1972003  
SLM 7.45, 15"  
SEE SHEET 156

CFN 1972001  
SLM 7.45, 15"  
SEE SHEET 157


CFN 1971999  
SLM 7.49, 15"  
SEE SHEET 194  
AND 196

Old CFN 430900751  
new CFN 1804056  
SLM 7.57, 53"x34"  
SEE SHEET 253  
AND 307


FED. RD. DIVISION	STATE	PROJECT
2	OHIO	I - 1103 (20) S - 46 (7)

LAKE COUNTY  
LAK -I- 4.02

Station	From		To		Side	Type	Material	Quantity	Unit
	Ref. No.	NG	Ref. No.	NG					
1-0	345	+00	345	+46	L1				
1-56	2-D	345	+08	348	+06	L1			
2-240	4-D	345	+00	347	+00	L1			
3-157	6-D	345	+00	346	+08	R1			
4-157	8-D	345	+00	343	+06	R1			
5-157	10-D	349	+00	349	+00	R1			
6-240	10-D	349	+00	349	+00	R1			
7-244	10-D	349	+05	349	+05	R1			
8-241	17-D	345	+00	345	+06	L1			
<b>Total</b>									

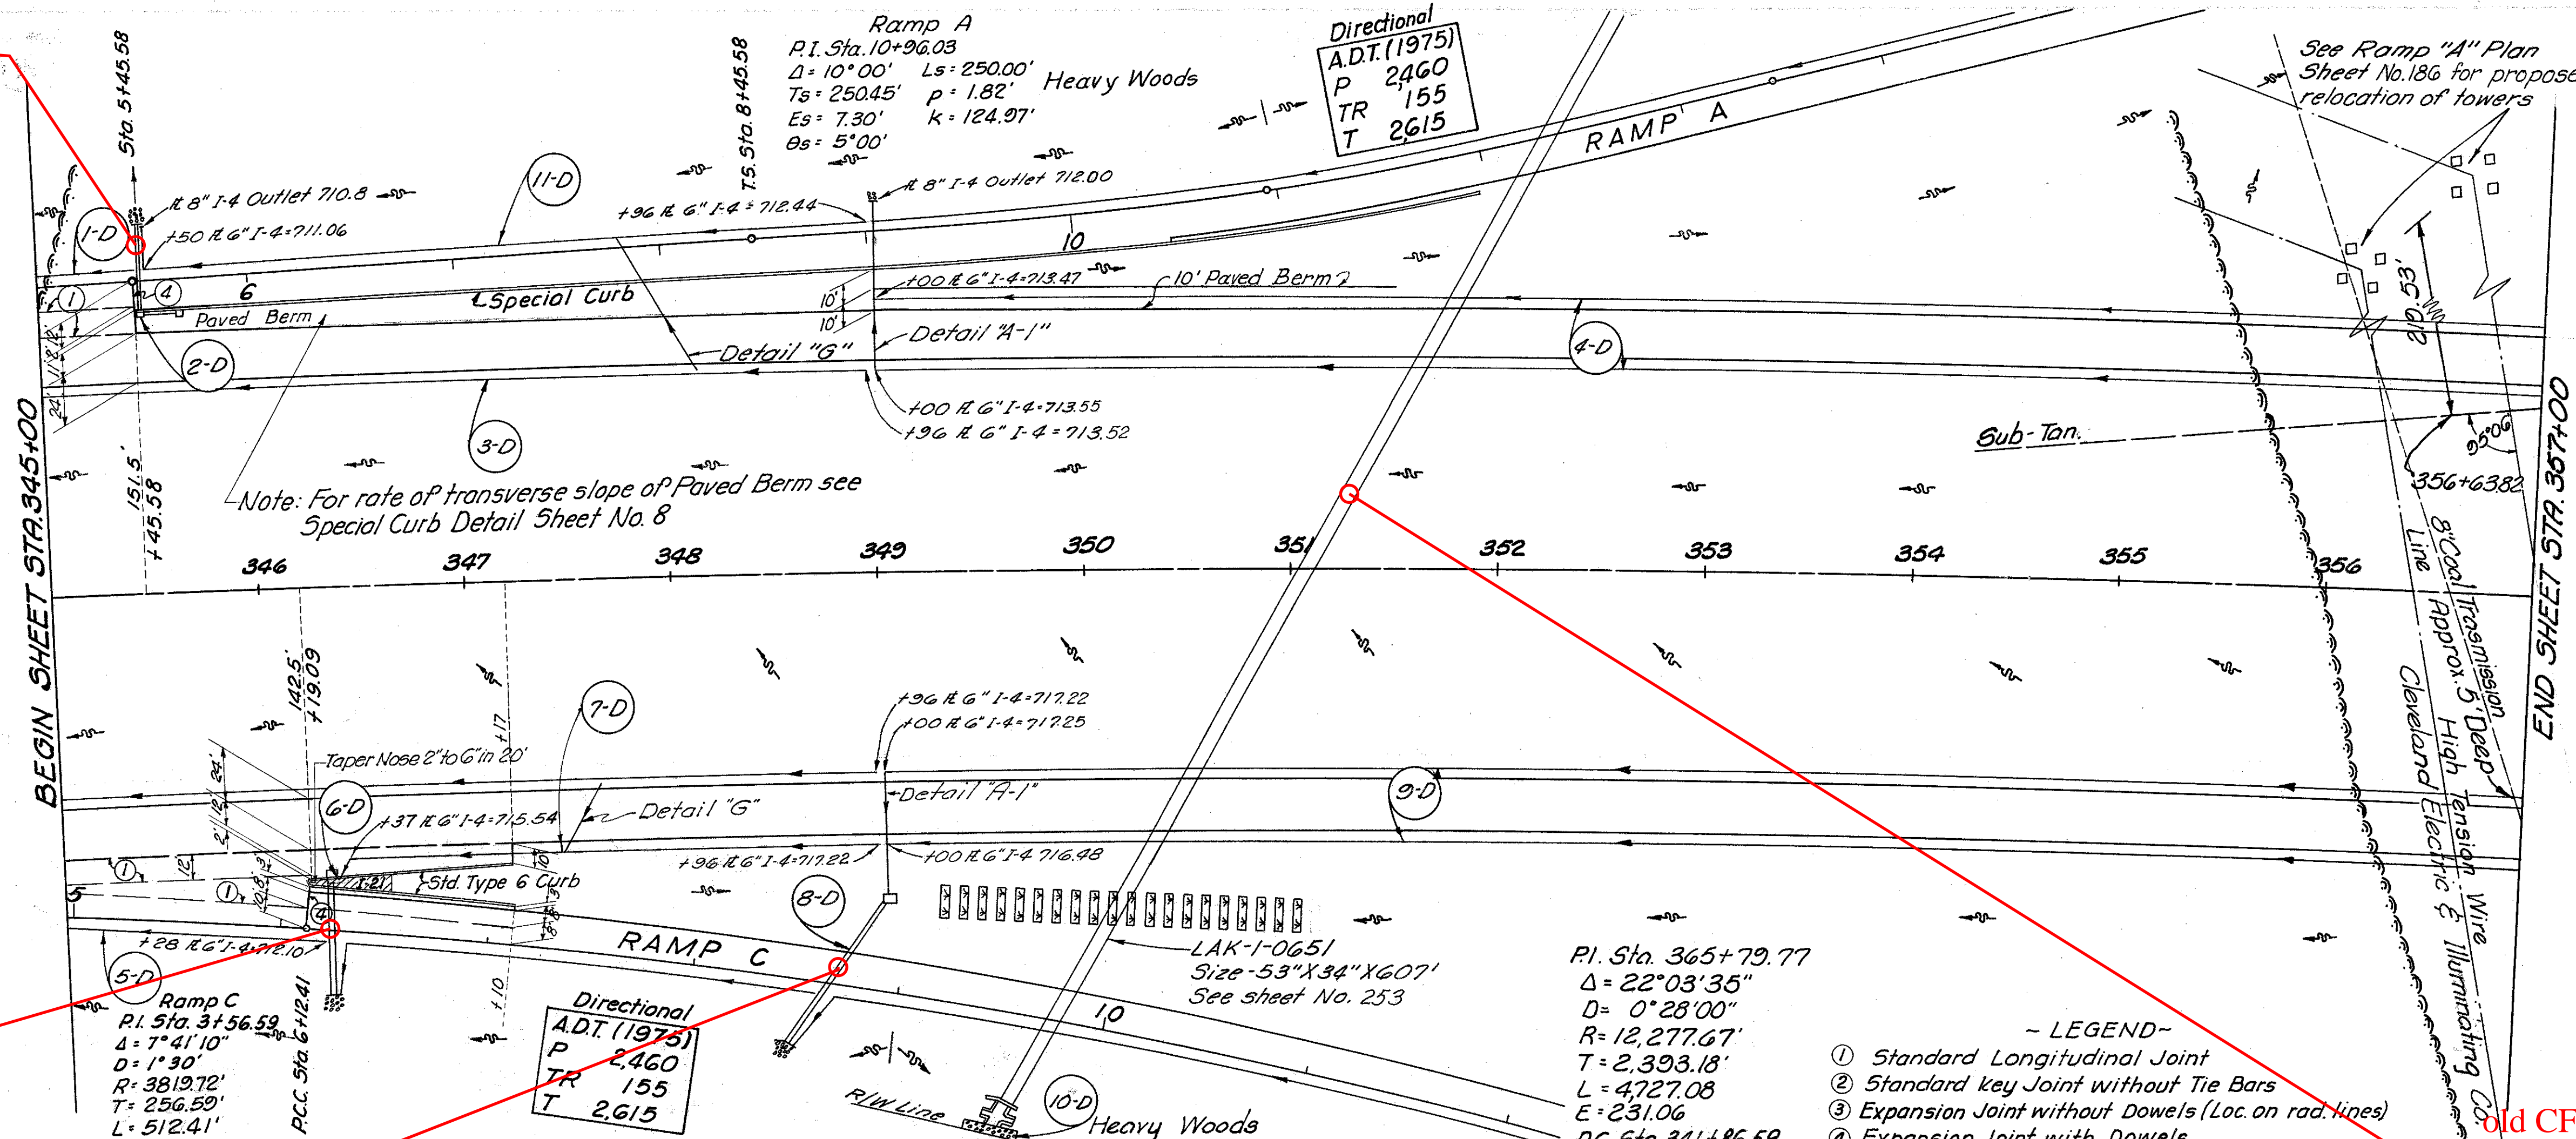

- LEGEND -
- ① Standard Longitudinal Joint
  - ② Standard Key Joint without Tie Bars
  - ③ Expansion Joint without Dowels (Loc. on rad. lines)
  - ④ Expansion Joint with Dowels.

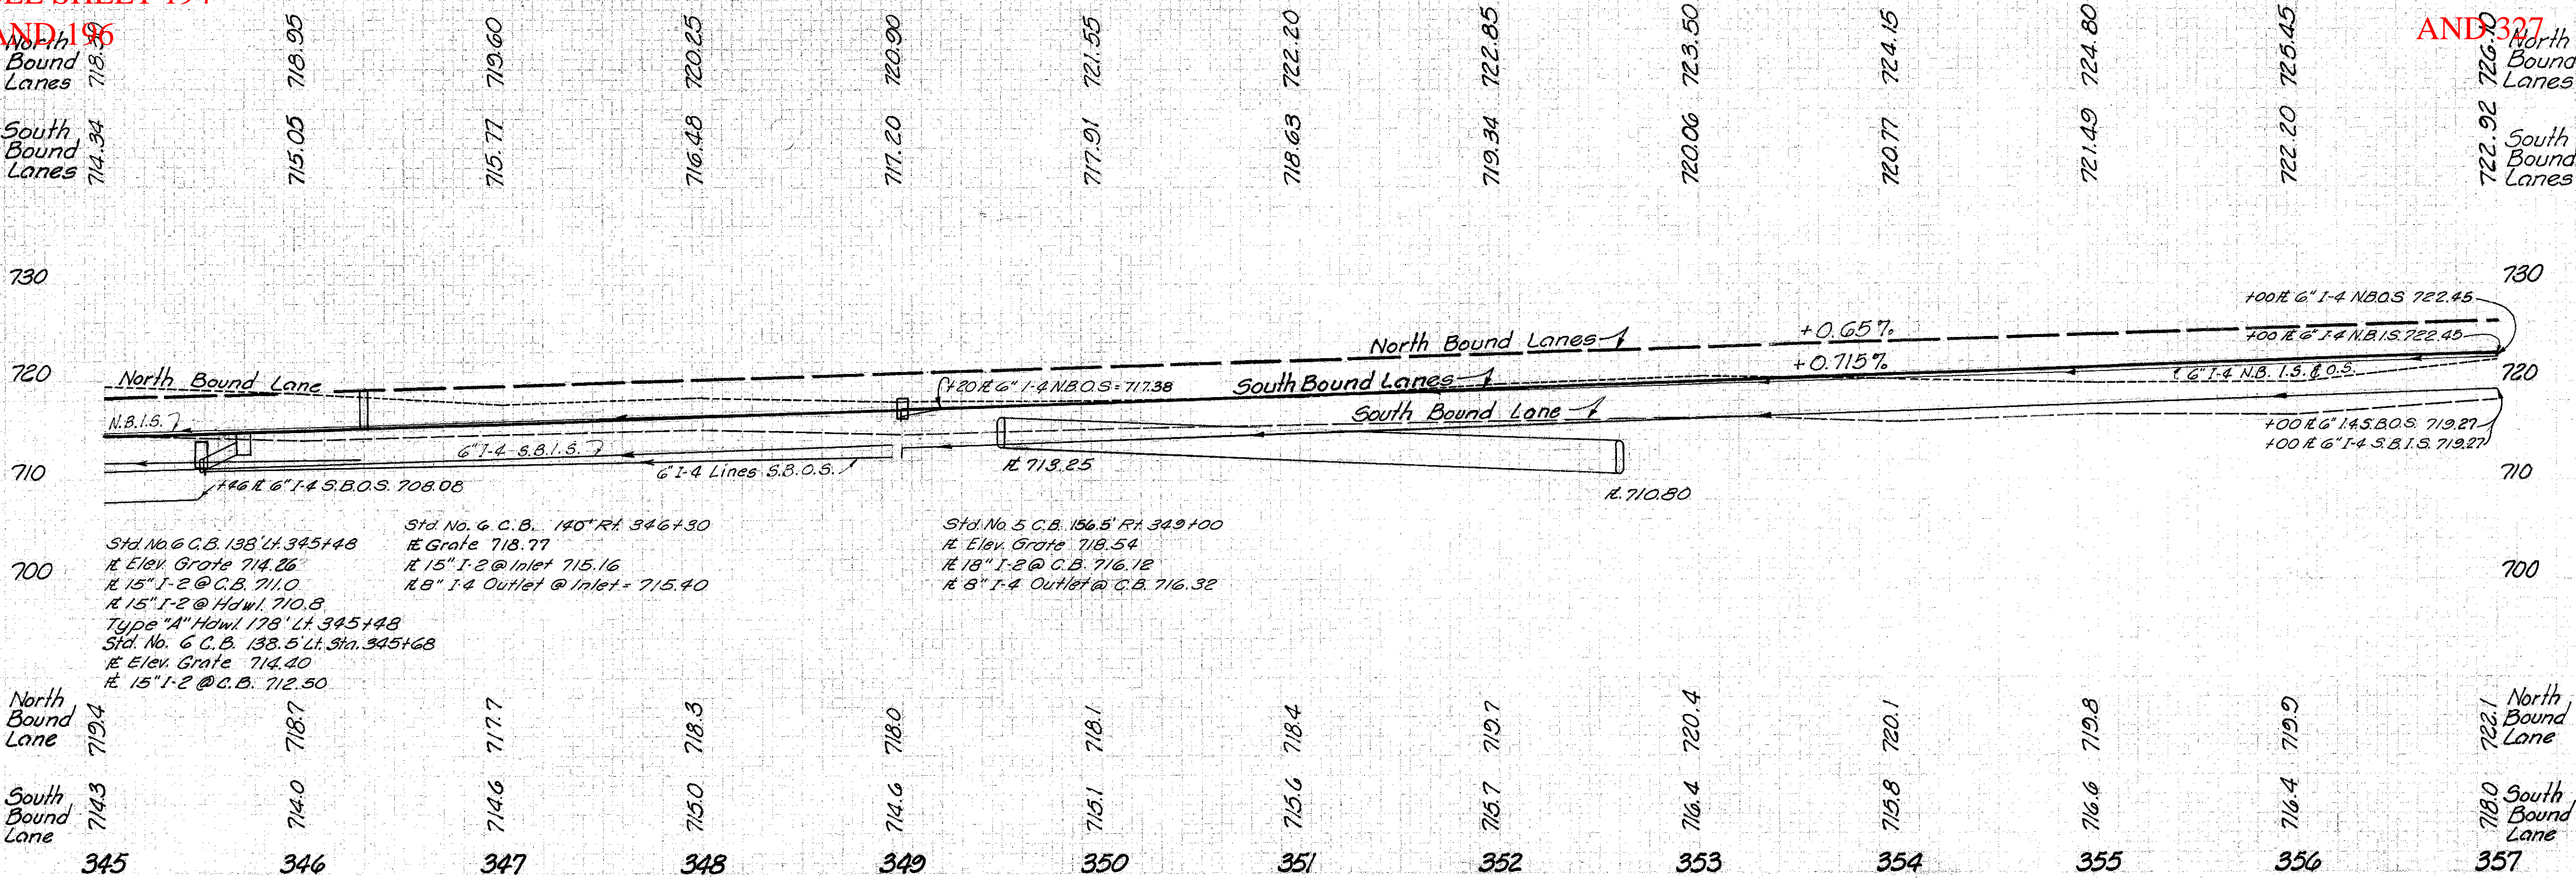

MICHAEL BAKER, JR., CONSULTING ENGINEERS  
ROCHESTER, PENNSYLVANIA

STATE OF OHIO  
DEPARTMENT OF HIGHWAYS  
STATE HIGHWAY NO. 1  
C-44

PLAN AND PROFILE  
STA. 345+00 TO STA. 357+00

Designed	Drawn	Traced	Checked	Reviewed	Date	Revised
R.G.	K.A.	A.H.	B.P.			

PLAN & PROFILE STA. 345+00 - STA. 357+00