



B.M. Top Fire Hydrant, 2nd East of angle S. Side Lakeland Blvd. Sta. 85+49 (Lakeland B/L) ELEV.=643.196

LAK. FWY. W. BOUND
 CURVE DATA
 Dc=10°-15'-00"
 Δ=10°-00'-00"
 R=4583.664'
 T=401.019'
 L=800.00'
 Ch=798.895'
 E=17.509'
 Dc=0°-28'-02.19"
 Δ=9°-48'-00"
 R=12,261.671'
 T=299.669'
 L=599.219'
 Ch=599.159'
 E=3.661'

B.M. Top 1st FIRE HYD., EAST OF ANGLE POINT S. SIDE LAKELAND BLVD, STA. 82+15 ELEV.=644.790

CUYAHOGA COUNTY
 Sec. CUY-2-28.16
 CUY-525-0.00
 LAKE COUNTY
 Sec. LAK-525-0.00

SEE SHT. NO 82 FOR THIS SECTION LAK. W. BOUND

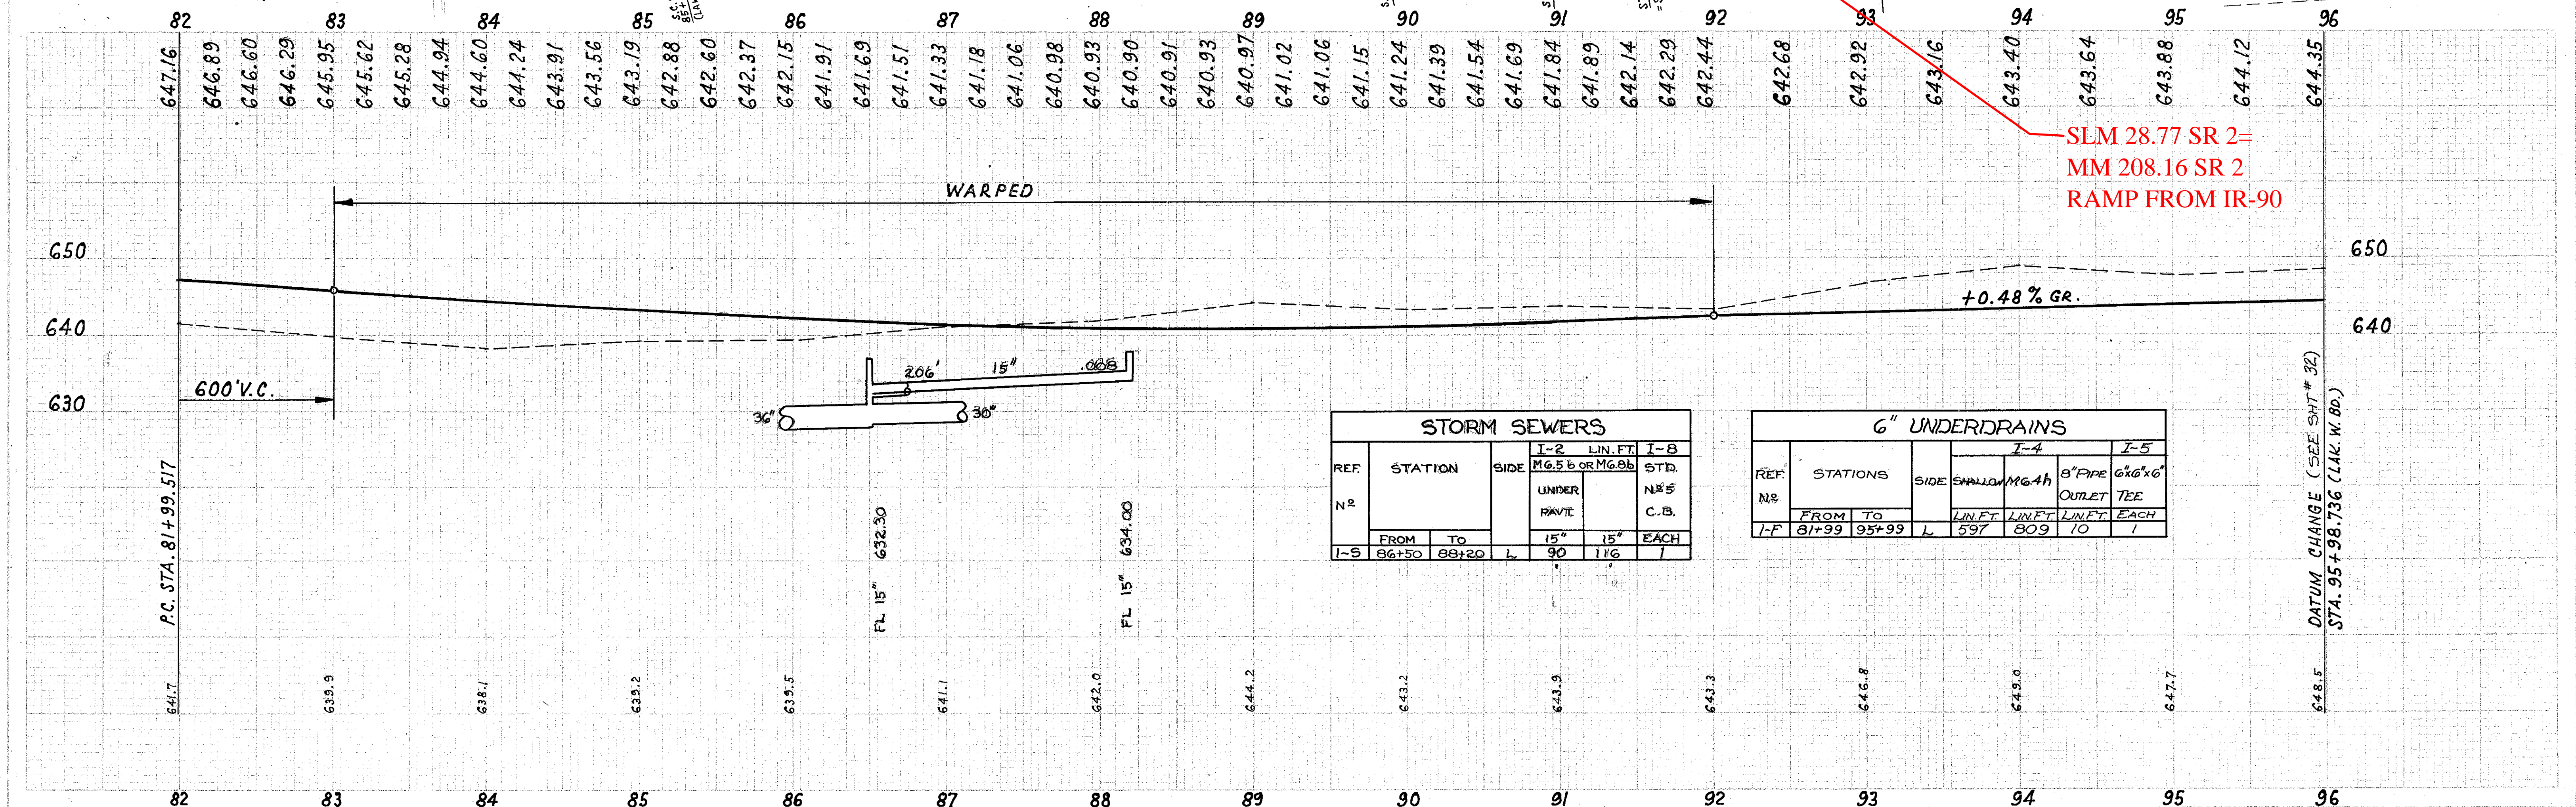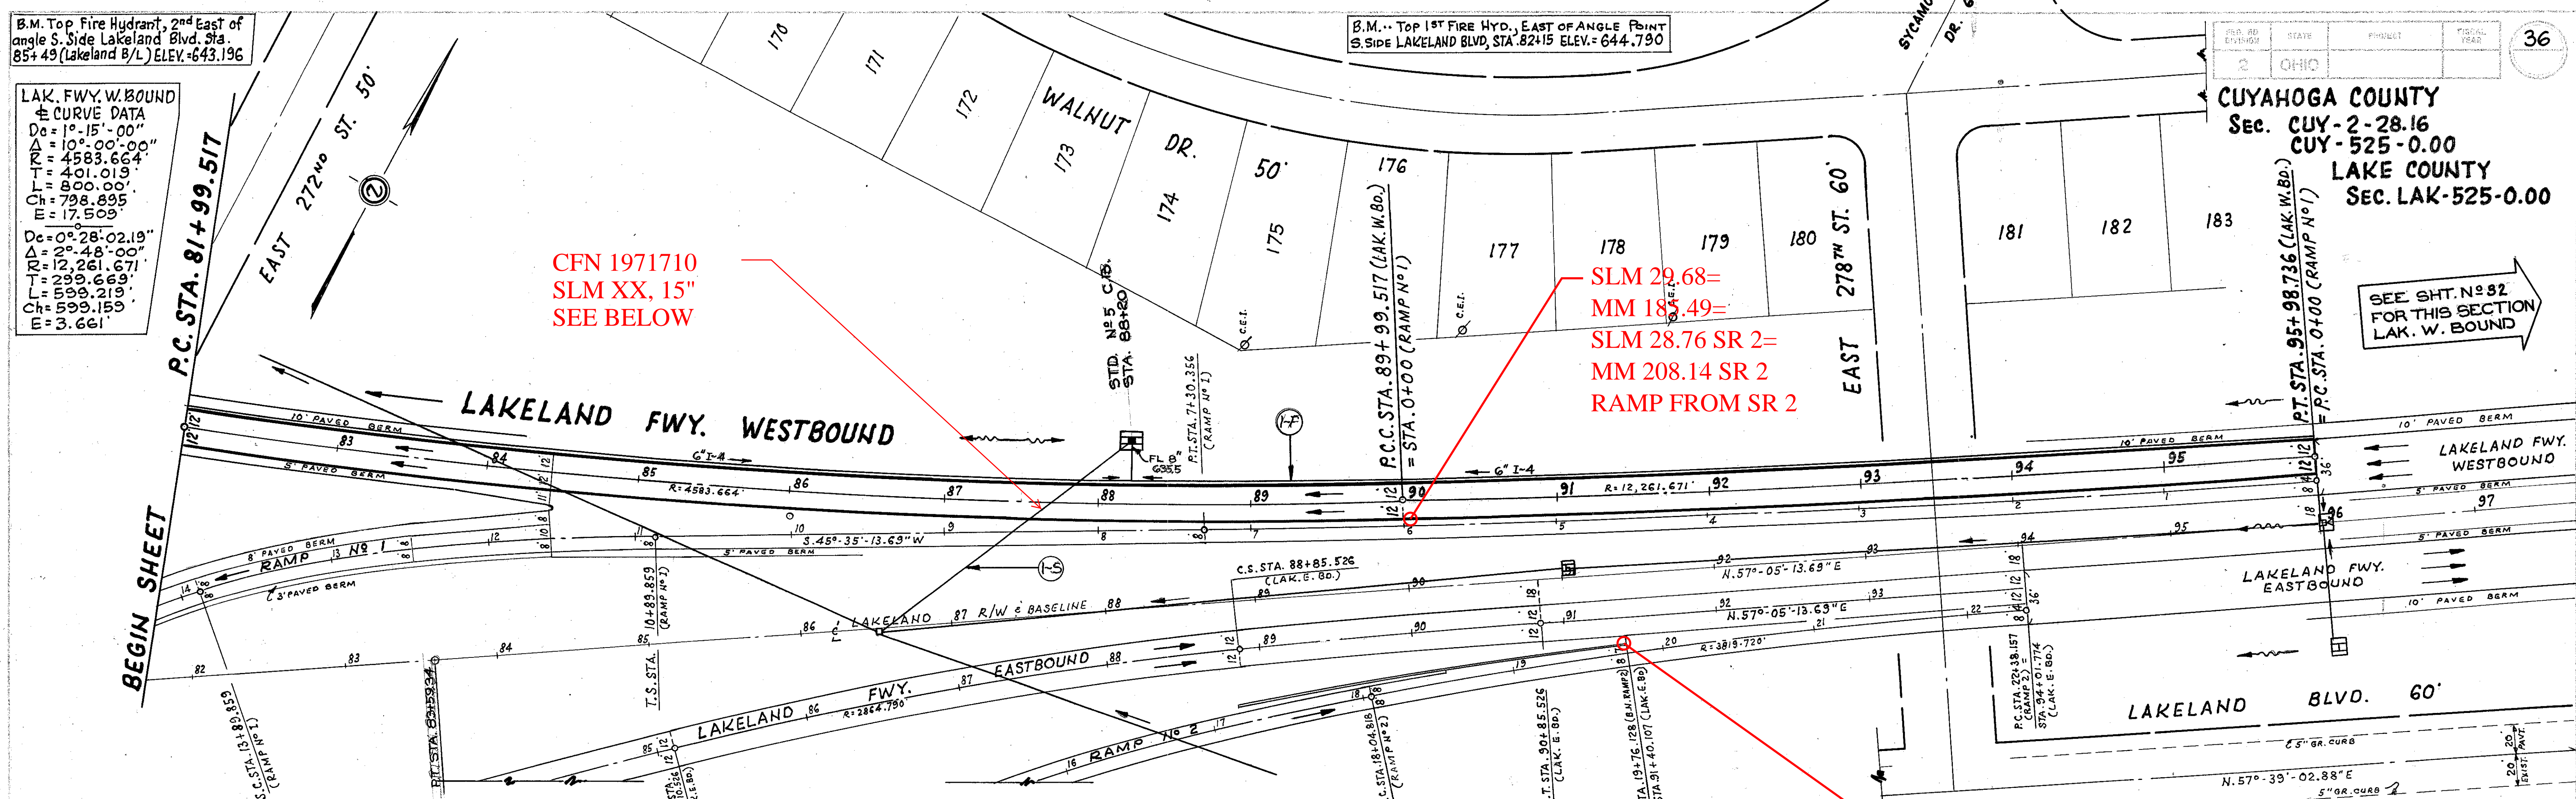

STORM SEWERS					
REF. N ^o	STATION		SIDE	I-2 LIN. FT. I-3	
	FROM	TO		M6.5 b or M6.0b	STD. N ^o 5 C.B.
I-5	86+50	88+20	L	90	116

6" UNDERDRAINS							
REF. N ^o	STATIONS		SIDE	I-4			I-5
	FROM	TO		SHALLOW	M6.4h	8" PIPE OUTLET TEE	
I-F	81+99	95+99	L	597	809	10	1

DATUM CHANGE (SEE SHT # 32) STA. 95+98.736 (LAK. W. BD.)

PLAN & PROFILE ... LAKELAND FWY. WESTBOUND ... P.C. STA. 81+99.517 to P.T. STA. 95+98.736