



CUYAHOGA COUNTY  
CUY-71-10.16

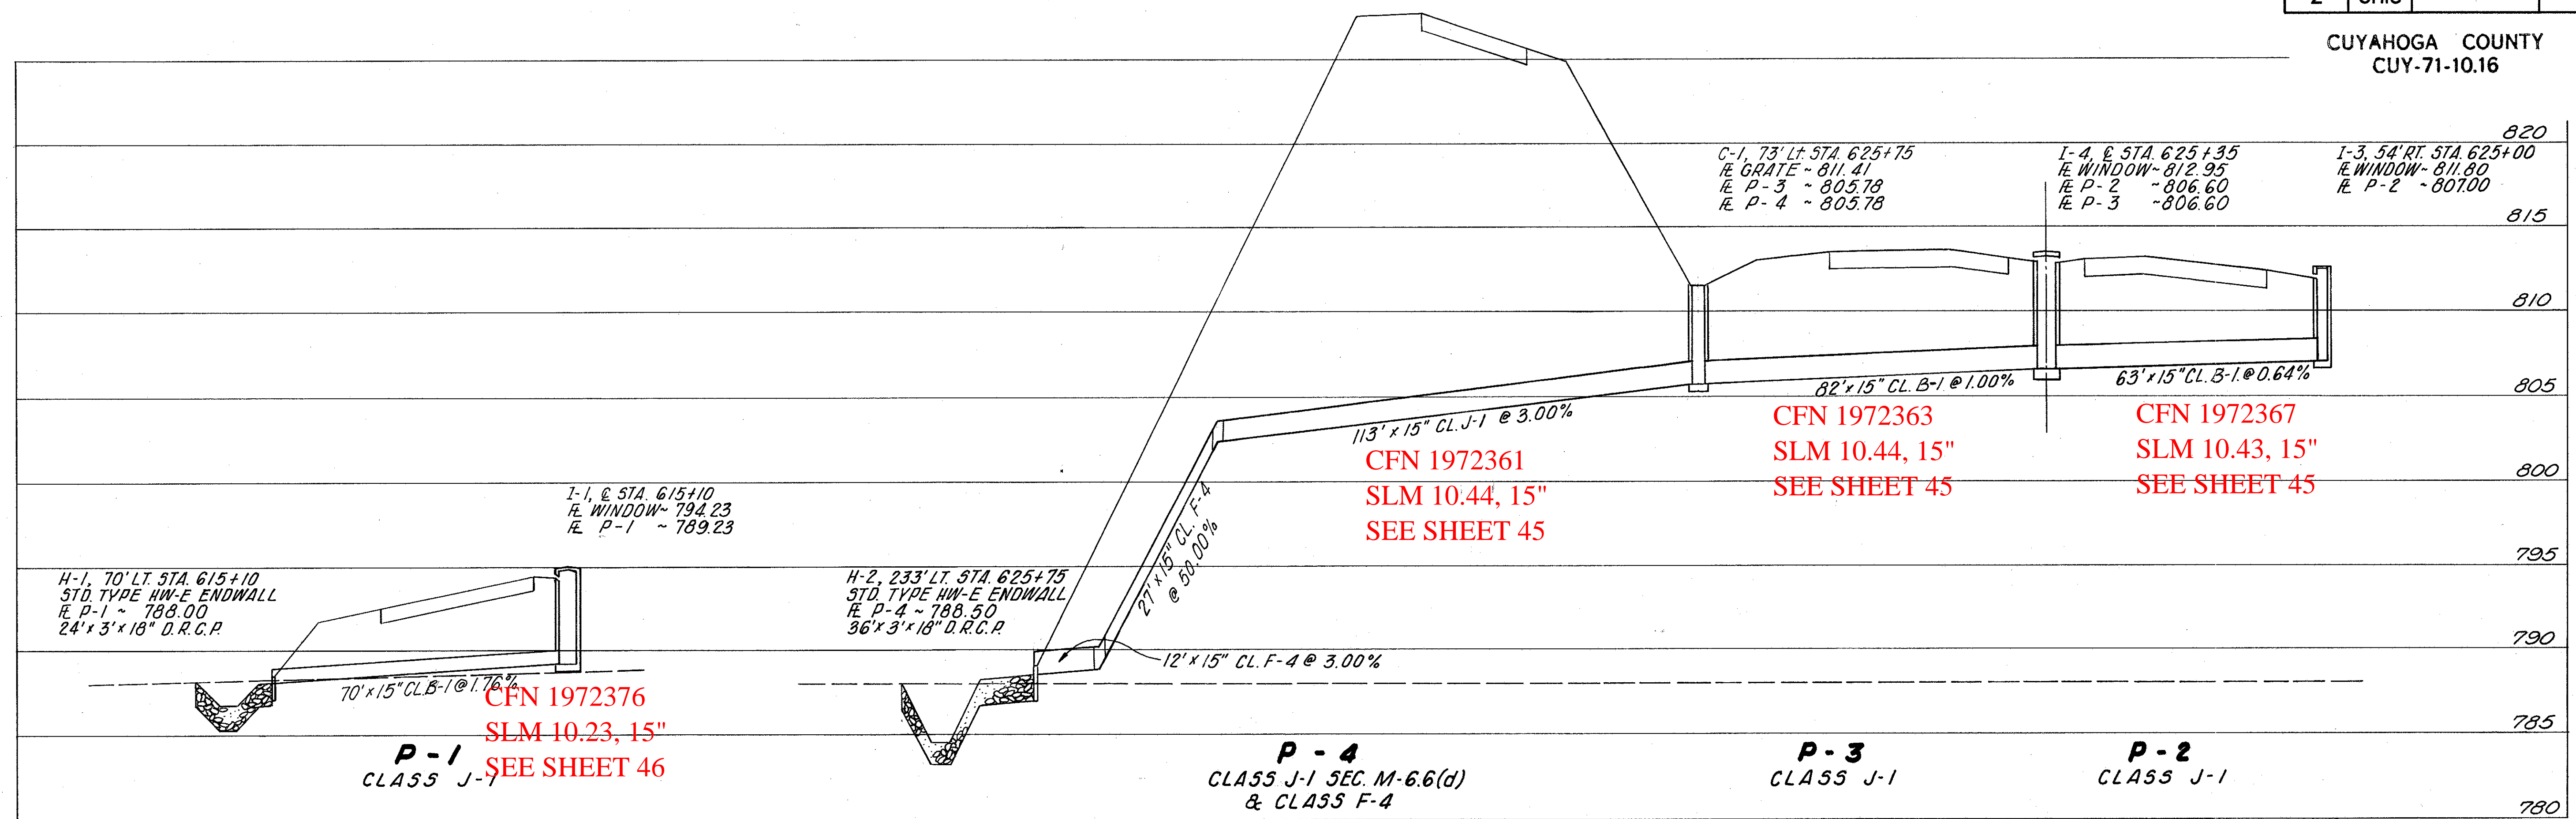

DESCRIPTION	DATE	CHECKED
BY	BY	BY
DATE	DATE	DATE
DATE	DATE	DATE
DATE	DATE	DATE

FOR STORM SEWER PLAN VIEWS, See SHt. No 45

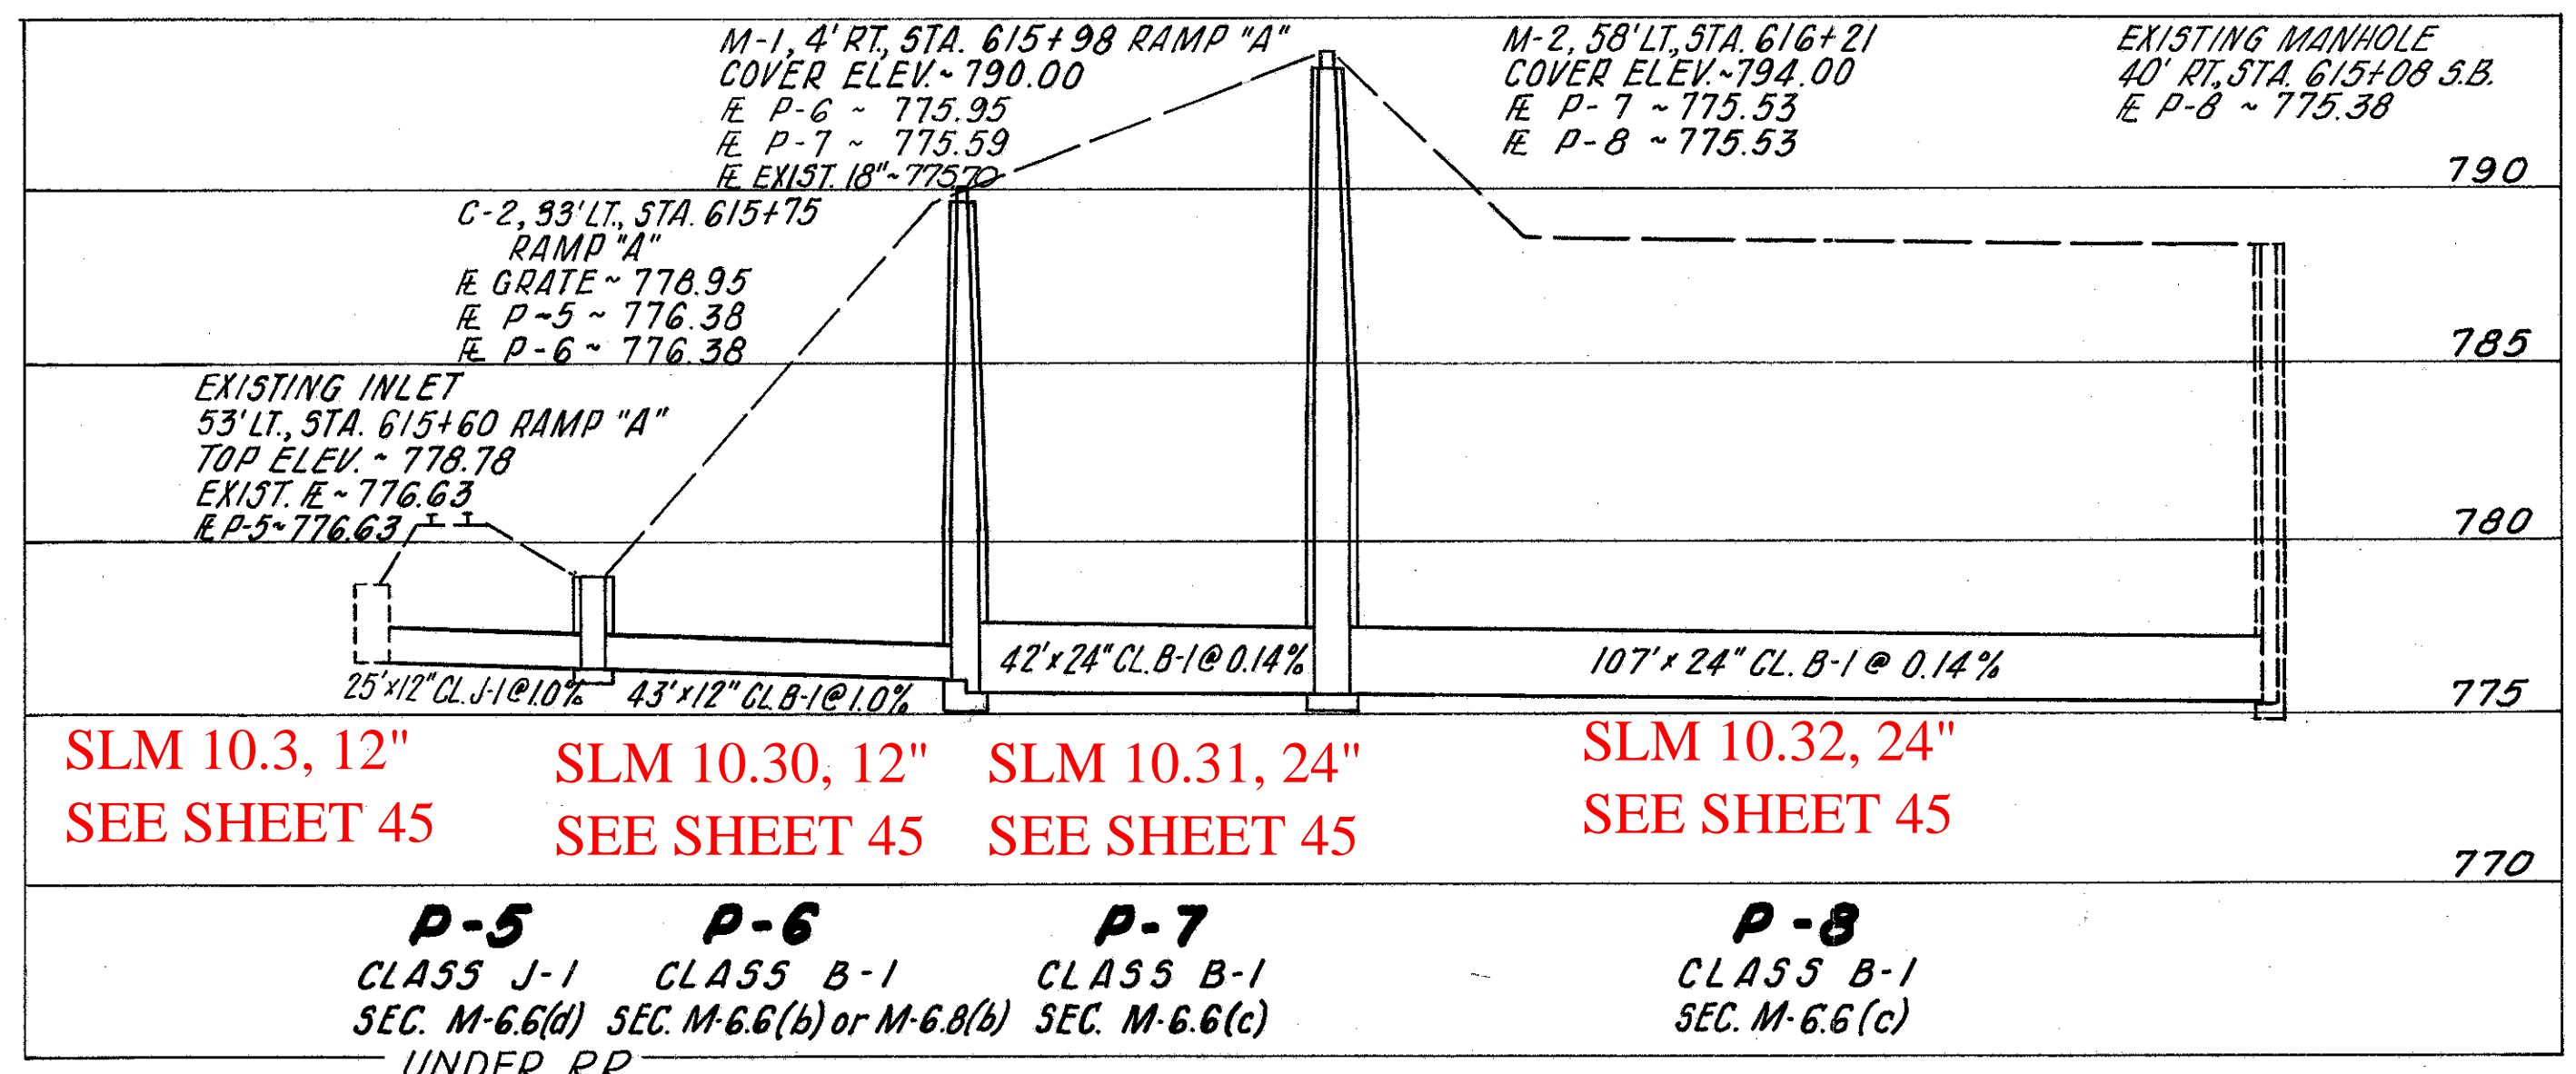

PIPE REF	STRUCTURES INCLUDED	ESTIMATED QUANTITIES												
		I-1 PIPE		I-2 PIPE		I-3 PIPE		I-4 PIPE		I-5 PIPE				
		CL. J-1	CL. B-1	CL. J-1	CLASS B-1	CL. F-4	MASONRY	SPECIAL	STD.	STD. MOD.	STD.	STD.	L-10	I-10
		12" SEC. M-6.6(a)	15" SEC. M-6.6(a)	12" SEC. M-6.6(a)	24" SEC. M-6.6(a)	15" SEC. M-6.6(a)	CU. YDS.	CL. F-4	NO. 2	NO. 2-8	NO. 2-10	NO. 2-8-12	SQ. YDS.	CU. YDS.
P-1	I-1 & H-1		70				0.3						4	4
P-2	I-3		63											
P-3	I-4		82											
P-4	C-1 & H-2			113		39	0.3	2					4	6
P-5		25												
P-6	C-2				43									
P-7	M-1				42				1					
P-8	M-2				107				1					
<b>TOTALS</b>		<b>25</b>	<b>215</b>	<b>113</b>	<b>43</b>	<b>149</b>	<b>0.6</b>	<b>2</b>	<b>2</b>	<b>1</b>	<b>1</b>	<b>1</b>	<b>8</b>	<b>10</b>