


FED. RD. DIVISION	STATE	PROJECT
2	OHIO	

288  
646

CUYAHOGA COUNTY  
CUY-71-1783  
CUY-176-12.76

37  
54

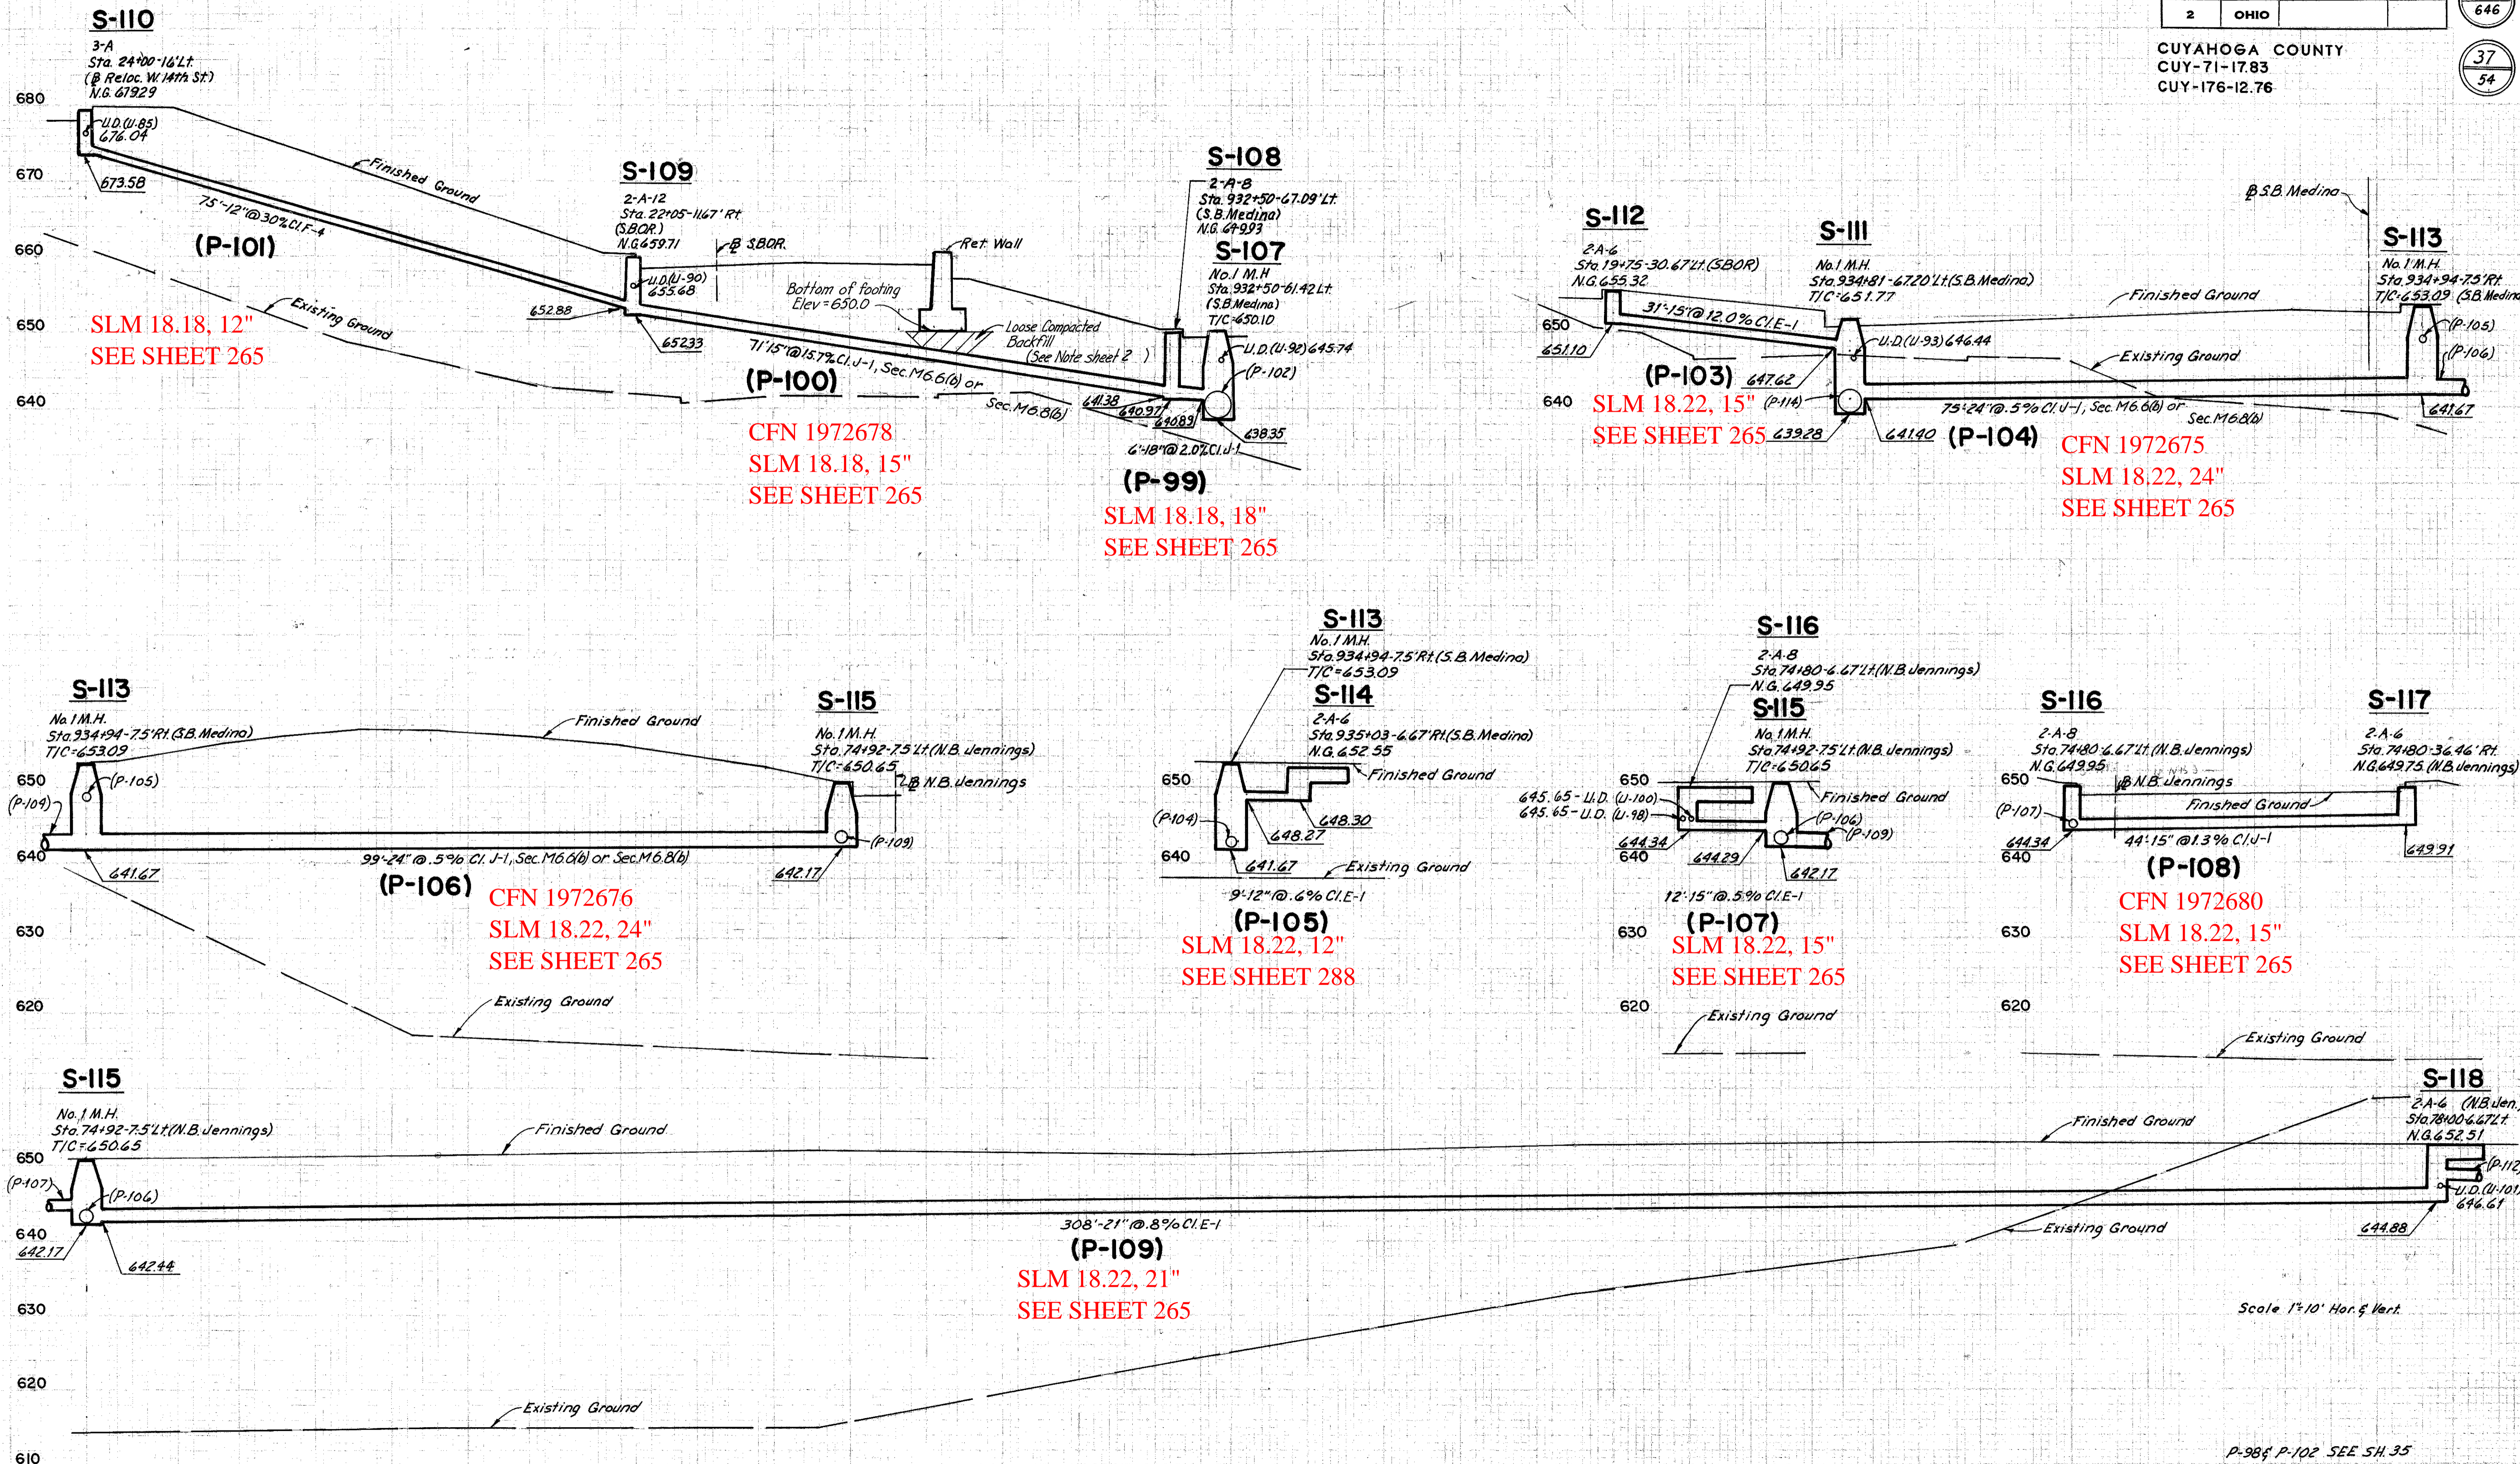

SLM 18.18, 12"  
SEE SHEET 265

CFN 1972678  
SLM 18.18, 15"  
SEE SHEET 265

SLM 18.18, 18"  
SEE SHEET 265

SLM 18.22, 15"  
SEE SHEET 265

CFN 1972675  
SLM 18.22, 24"  
SEE SHEET 265

CFN 1972676  
SLM 18.22, 24"  
SEE SHEET 265

SLM 18.22, 12"  
SEE SHEET 288

SLM 18.22, 15"  
SEE SHEET 265

CFN 1972680  
SLM 18.22, 15"  
SEE SHEET 265

SLM 18.22, 21"  
SEE SHEET 265

Scale 1"=10' Hor. & Vert.

P-98 & P-102 SEE SH. 35

R.D.J. 9-14-64  
L.M.D. 10-23-64