



old CFN 184800860  
new CFN 1884805  
SLM 8.60, 21"  
SEE SHEET 72

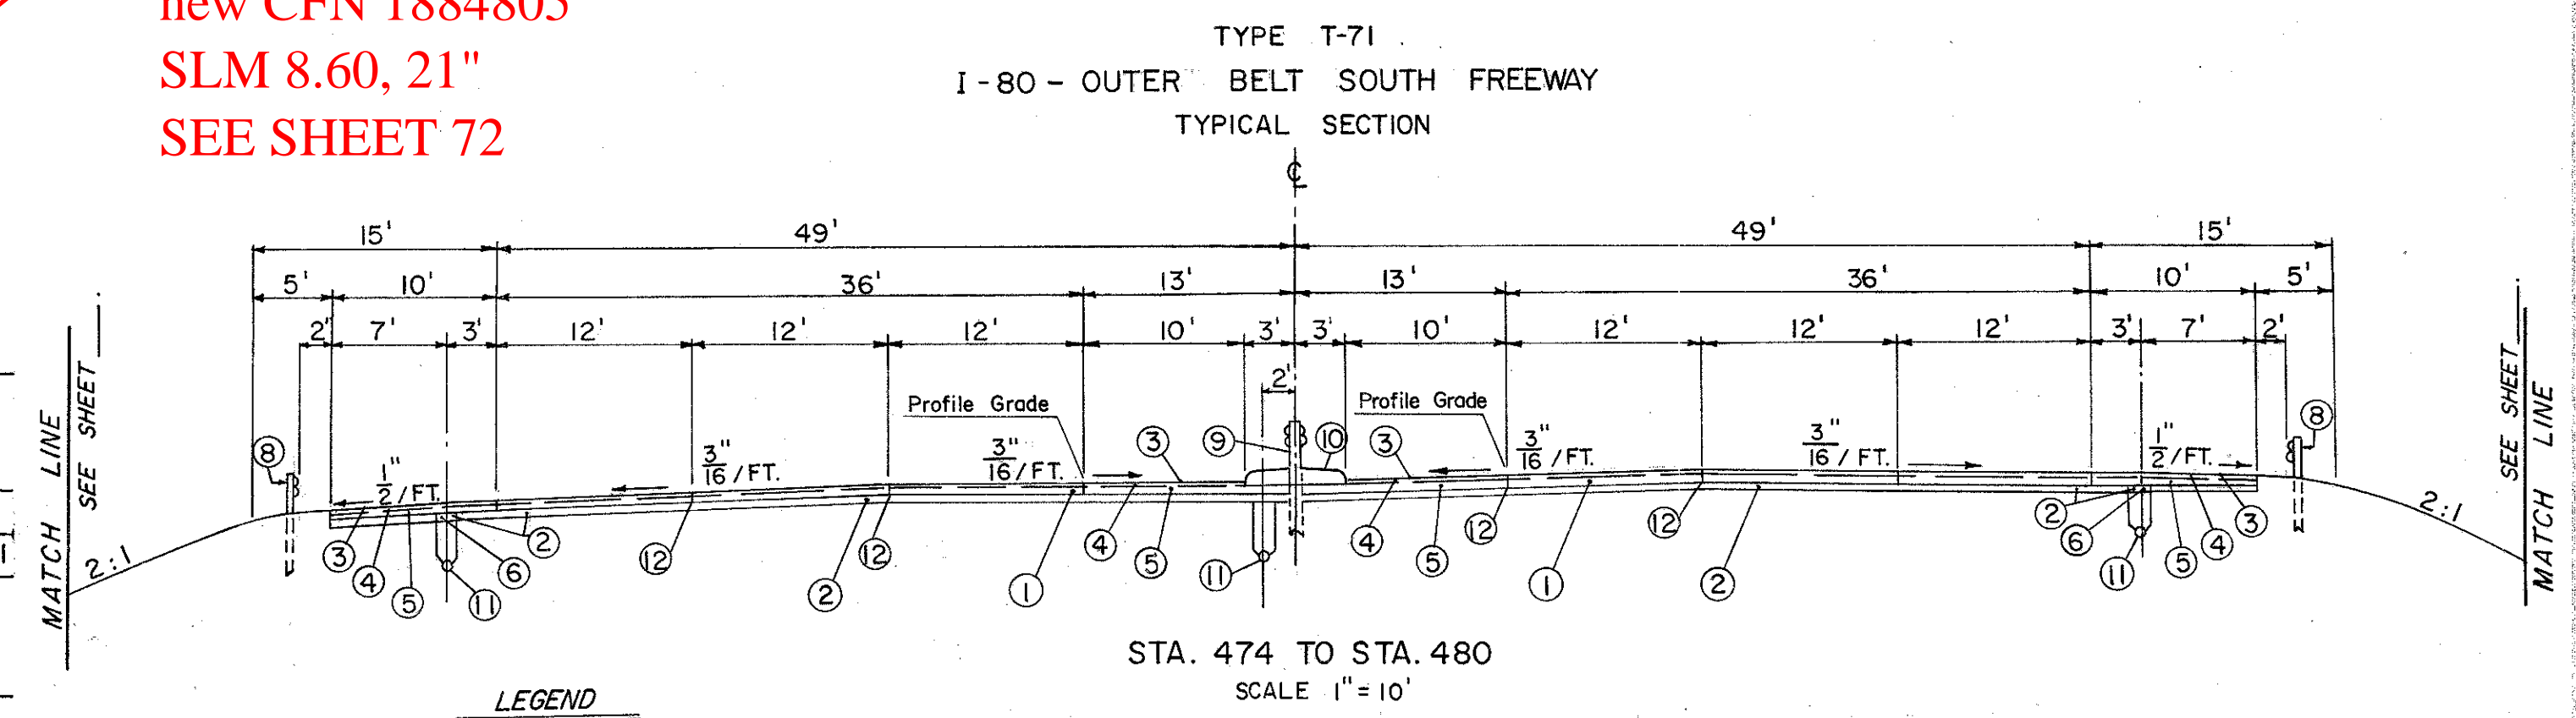

- LEGEND**
- ① T-71 10" REINFORCED PORTLAND CEMENT CONCRETE PAVEMENT
  - ② I-22 6" SUBBASE (GRADING "A" OR "B")
  - ③ T-31 BITUMINOUS SURFACE TREATMENT
  - ④ B-21 3" WATERPROOFED AGGREGATE BASE COURSE
  - ⑤ B-19 POROUS BASE COURSE
  - ⑥ CLASS 3 BACKFILL OR POROUS BASE MATERIAL
  - ⑦ I-12 STANDARD TYPE 6 CURB
  - ⑧ I-15 GUARD RAIL STEEL BERM STANDARD TYPE (DEEP)
  - ⑨ I-15 GUARD RAIL STEEL BERM BARRIER TYPE (DEEP)
  - ⑩ I-21 9" PORTLAND CEMENT CONCRETE MEDIAN
  - ⑪ I-1 6" UNDERDRAIN, CLASS I-3
  - ⑫ STANDARD LONGITUDINAL JOINT

**NOTE:** THIS TYPICAL SECTION TO BE USED FOR TYPICAL SUBGRADE ONLY. PAVEMENT NOT TO BE CONSTRUCTED UNDER THIS CONTRACT.

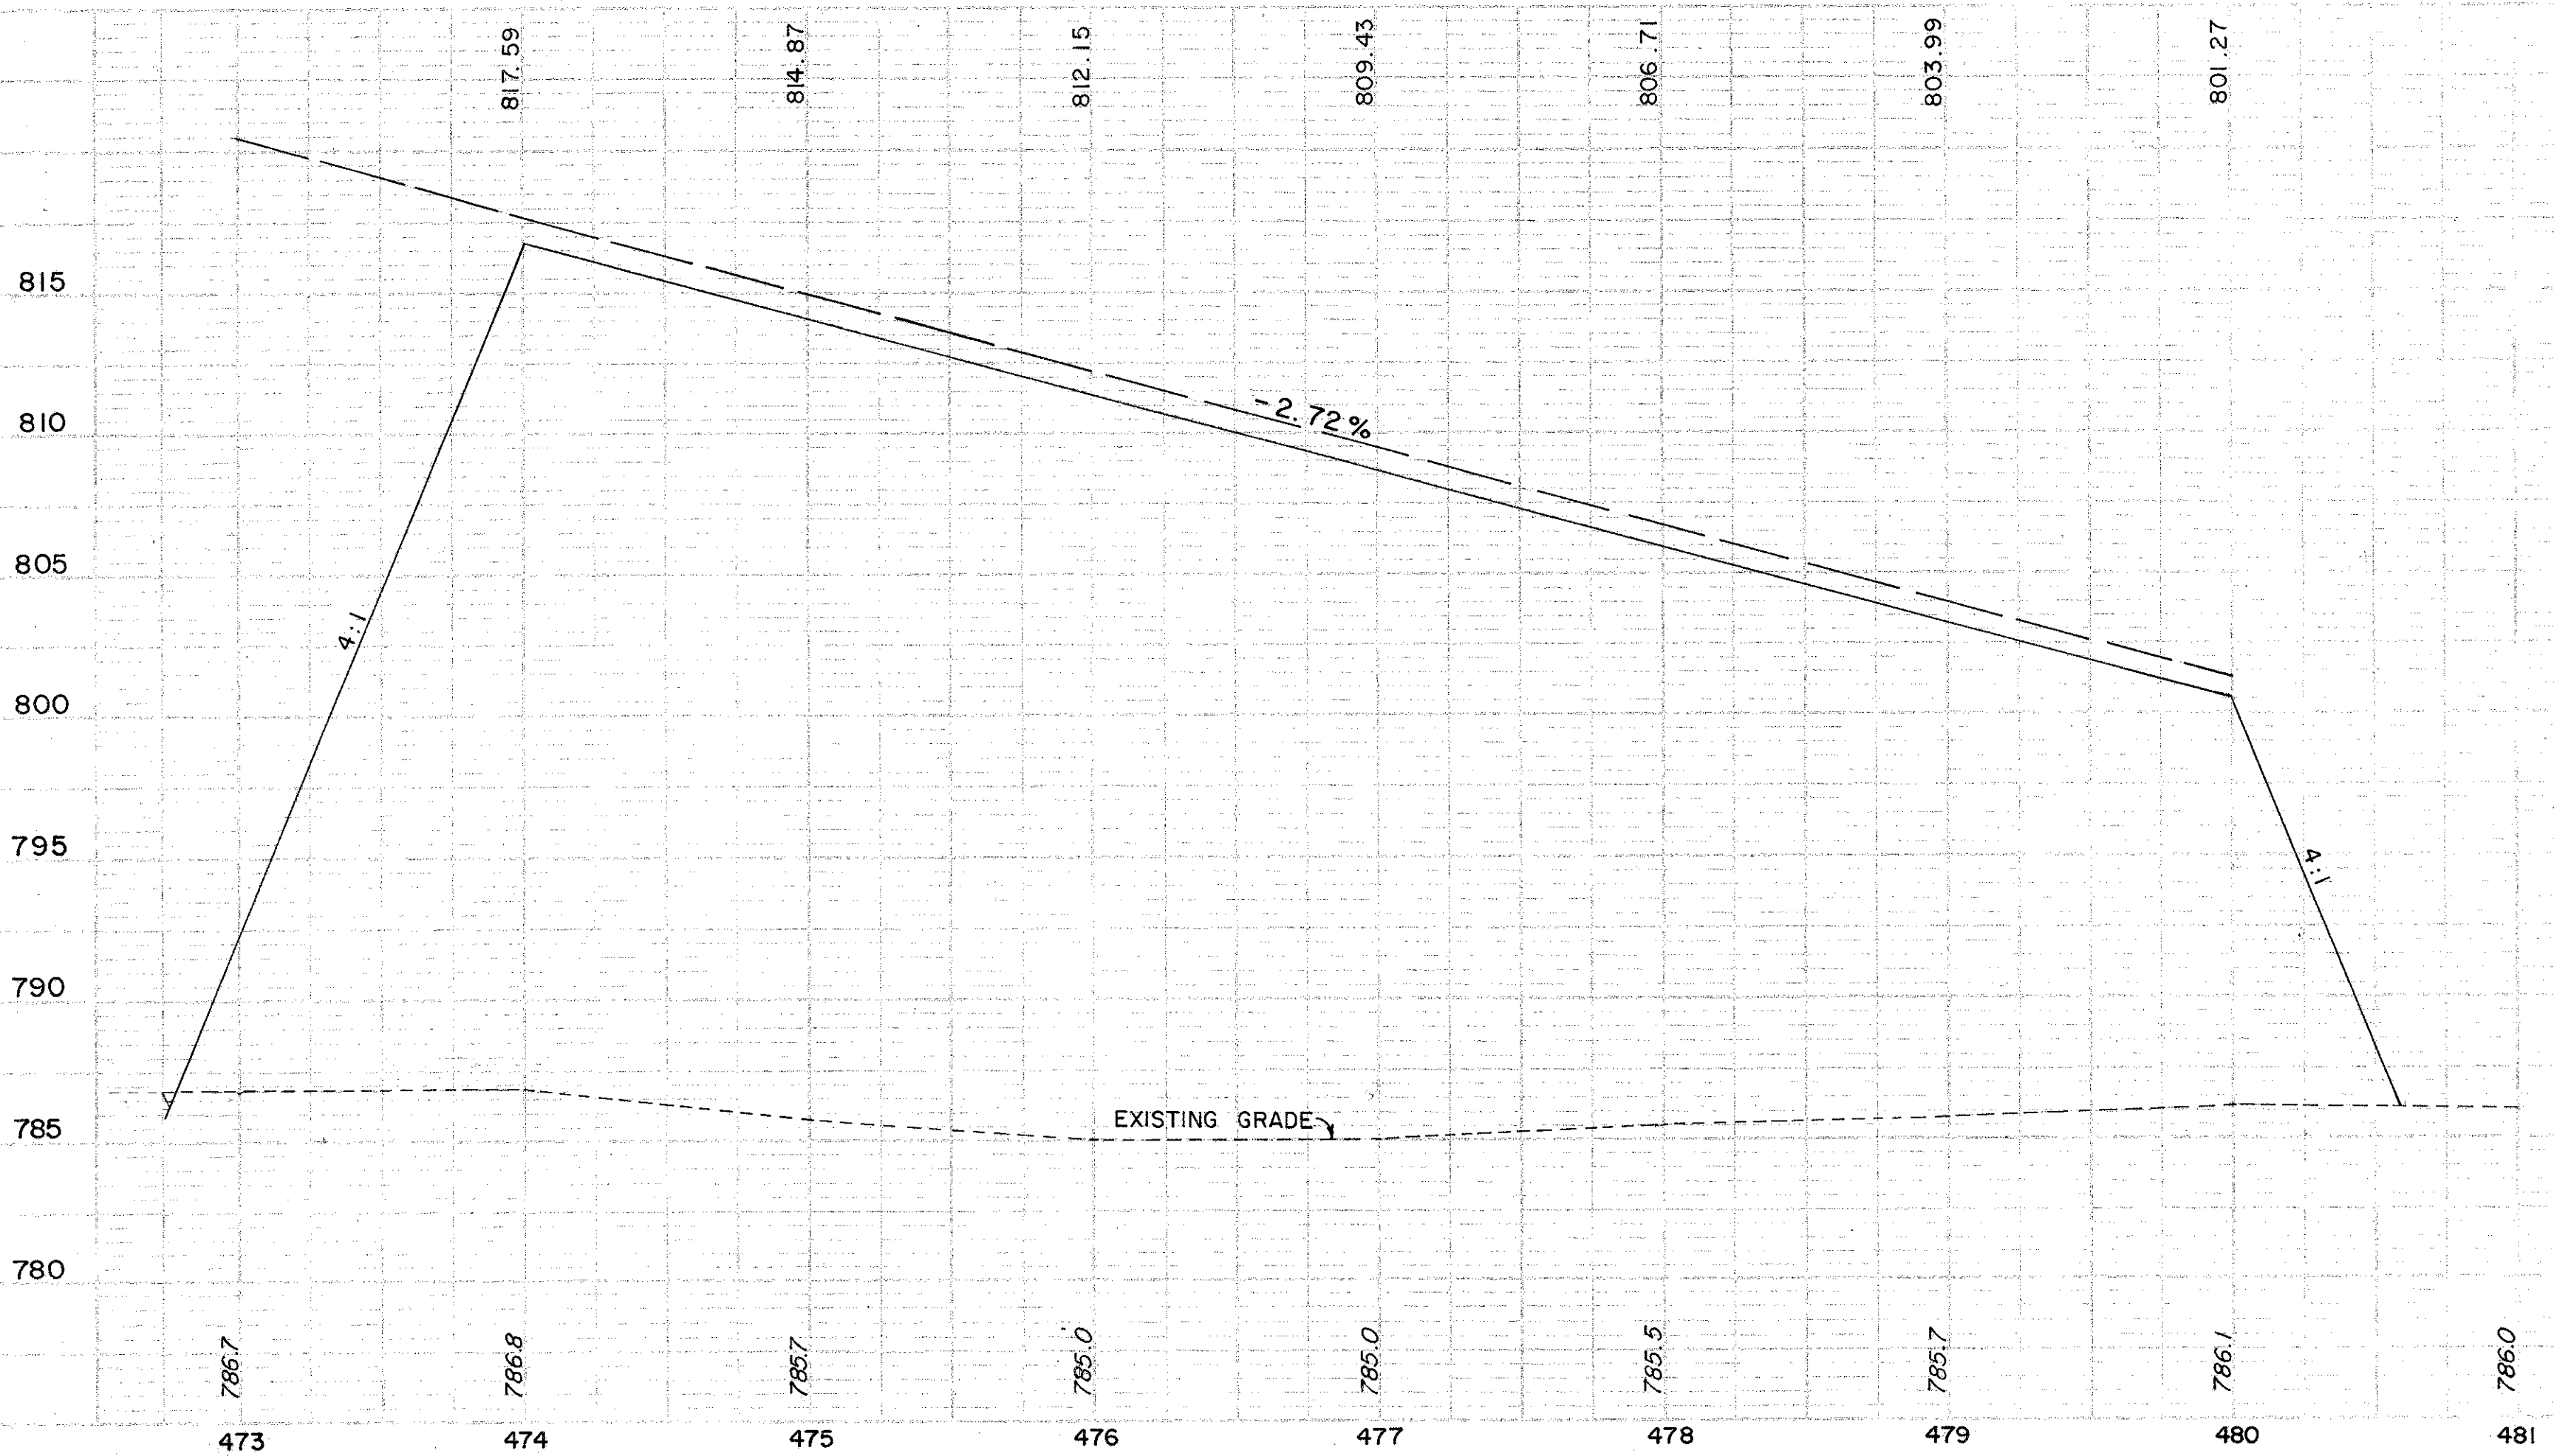

PLAN & PROFILE I-80 - O.B.S. STA. 474+00 TO 480+00

PLANNED  
SURVEYED  
PLOTTED  
ALIGNED  
CHECKED  
NOTE BOOK NO. 411-10-100-1000

PROFILE  
SURVEYED  
PLOTTED  
GRADES CHECKED  
NOTE BOOK NO. 411-10-100-1000